



Alley betw. 3<sup>rd</sup> & 4<sup>th</sup>.  
" " 4<sup>th</sup> & 5<sup>th</sup>.

Size	In Masonry
15"	Begin End
15"	1+78 2+23
15"	1+75 2+00

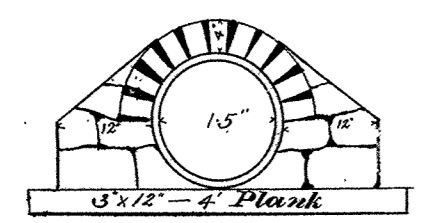

Section of 15" Sewer in Masonry

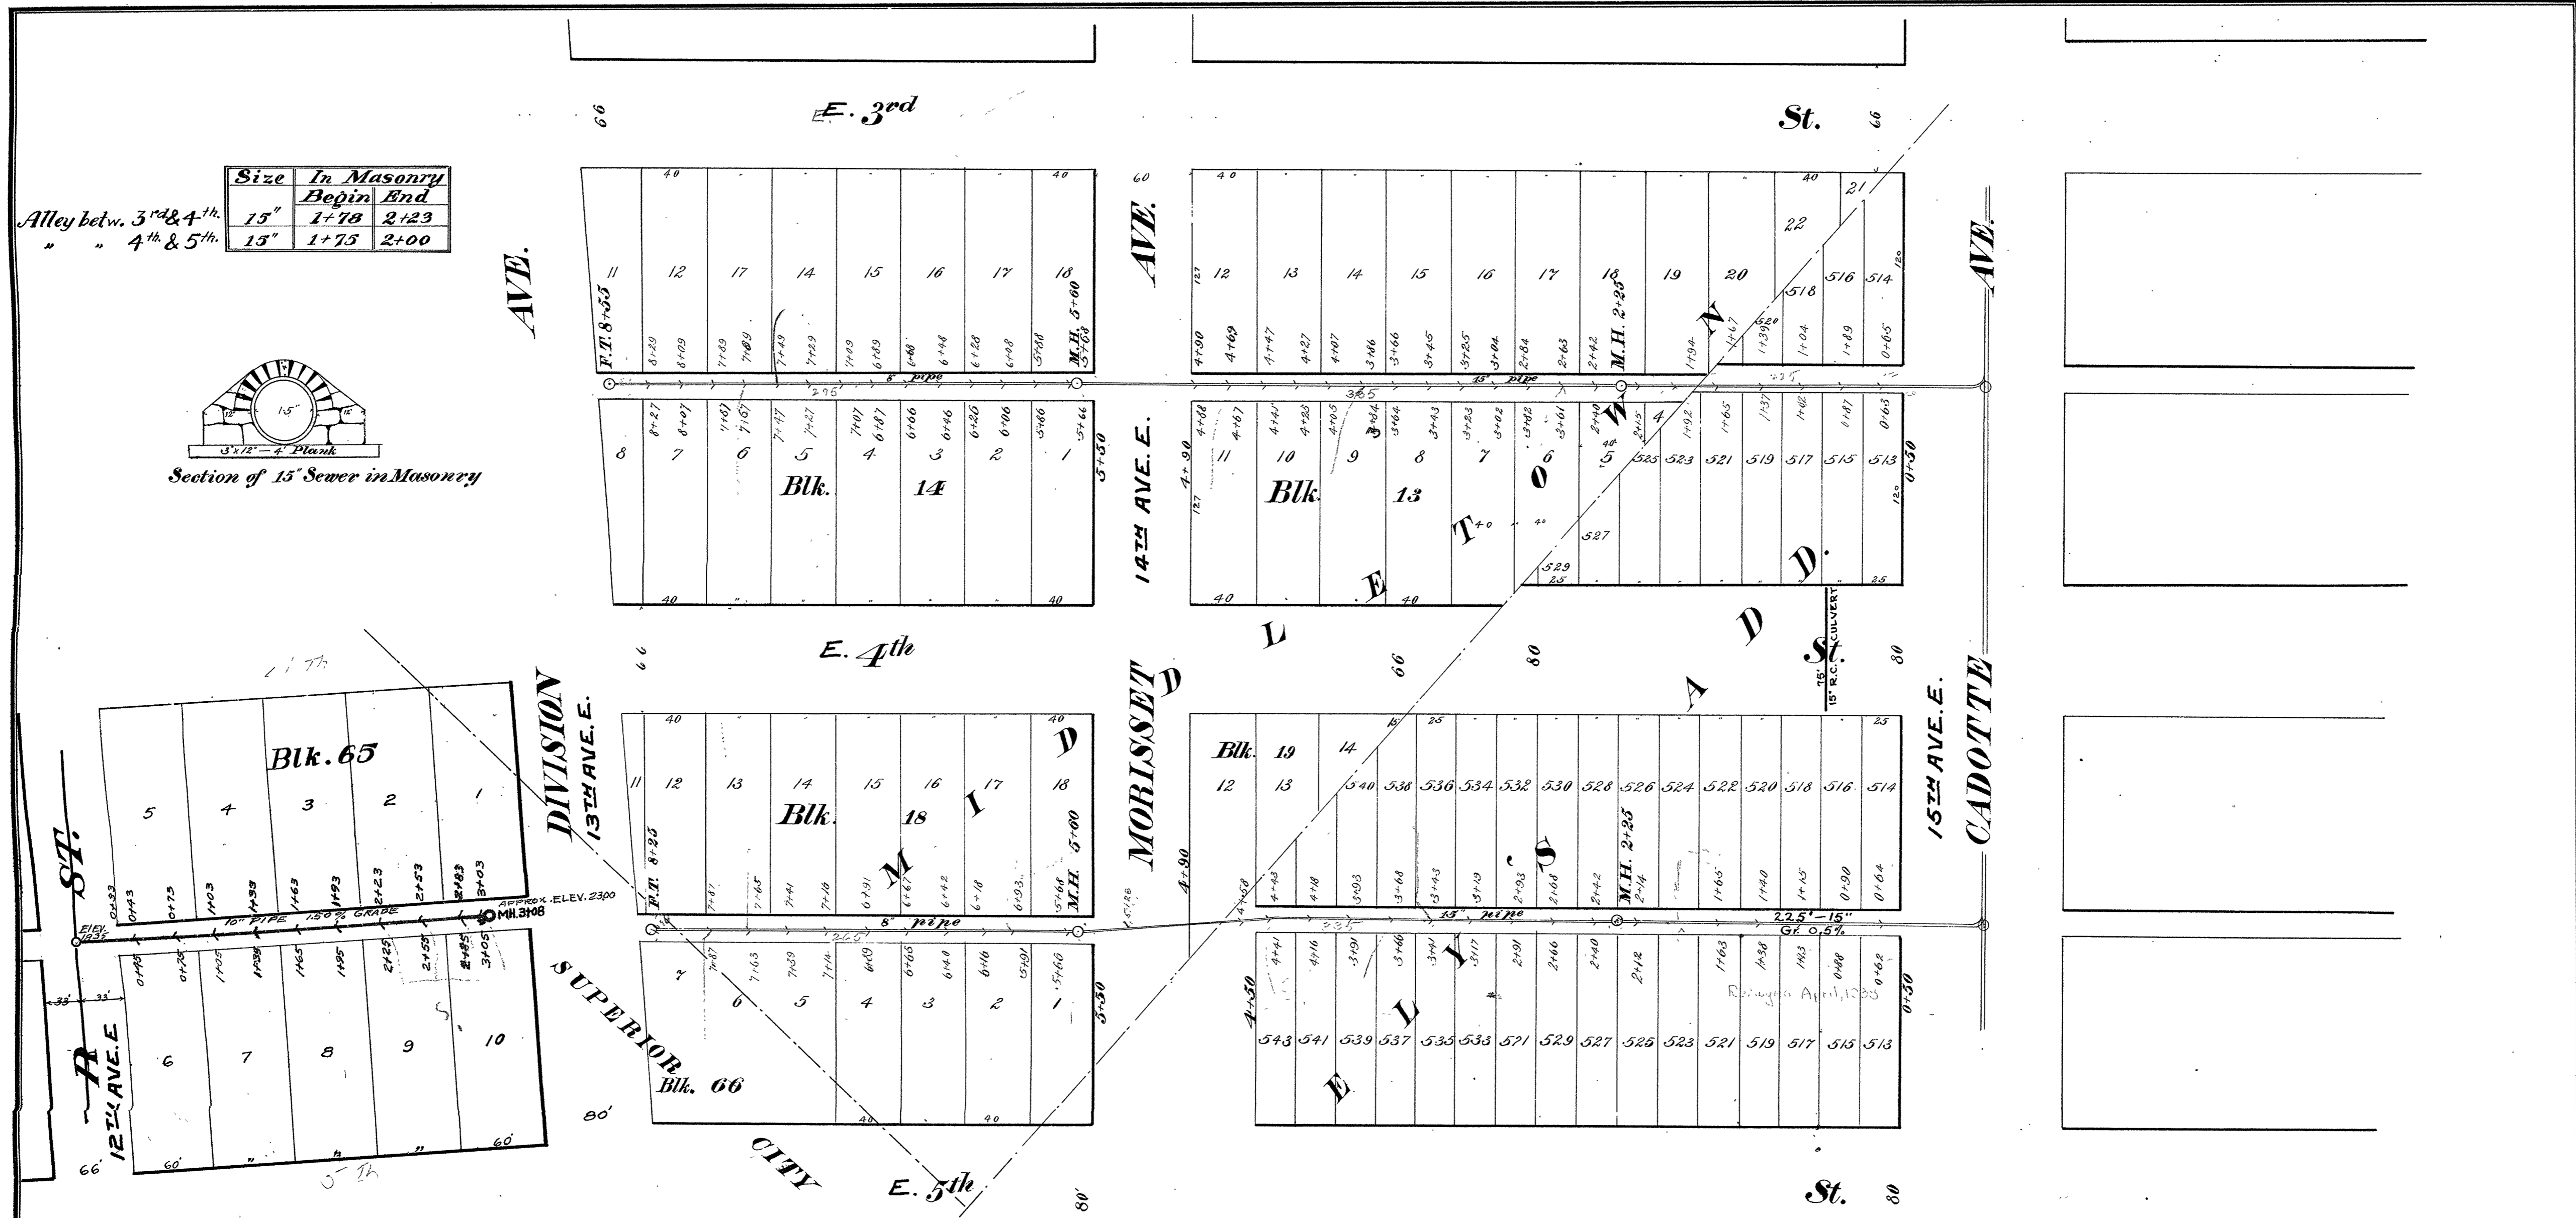

### CITY OF SUPERIOR SEWER PLAN

CONTRACT N<sup>o</sup> 1589  
Sta. 0+0 To 3+08  
Contract Let April 29, 19  
Contract Completed July 19  
J.B. Palmer Contractors  
I.A. Clark Inspectors  
E.B. Banks City Engineer

Contract let April 3, 1891  
completed Aug. 1, 1891  
Kirkland & Starke, Contractor  
G.W. Smith, N.G. West, Inspectors.  
E. B. Banks. City Engineer

Sewer and Established Street Grades

Cadotte Ave. Center	Morisset Ave. W. Side	Morisset Ave. E. Side	M.H. Sta. 2+25 W. Side	M.H. Sta. 5+60 W. Side	F.T. Street Sewer
16.50	16.09	19.72	20.26	17.33	22.00
18.51	18.76	21.42	21.82	19.64	23.22

Alley betw. 3<sup>rd</sup> and 4<sup>th</sup> Sts.  
4<sup>th</sup> and 5<sup>th</sup> "