
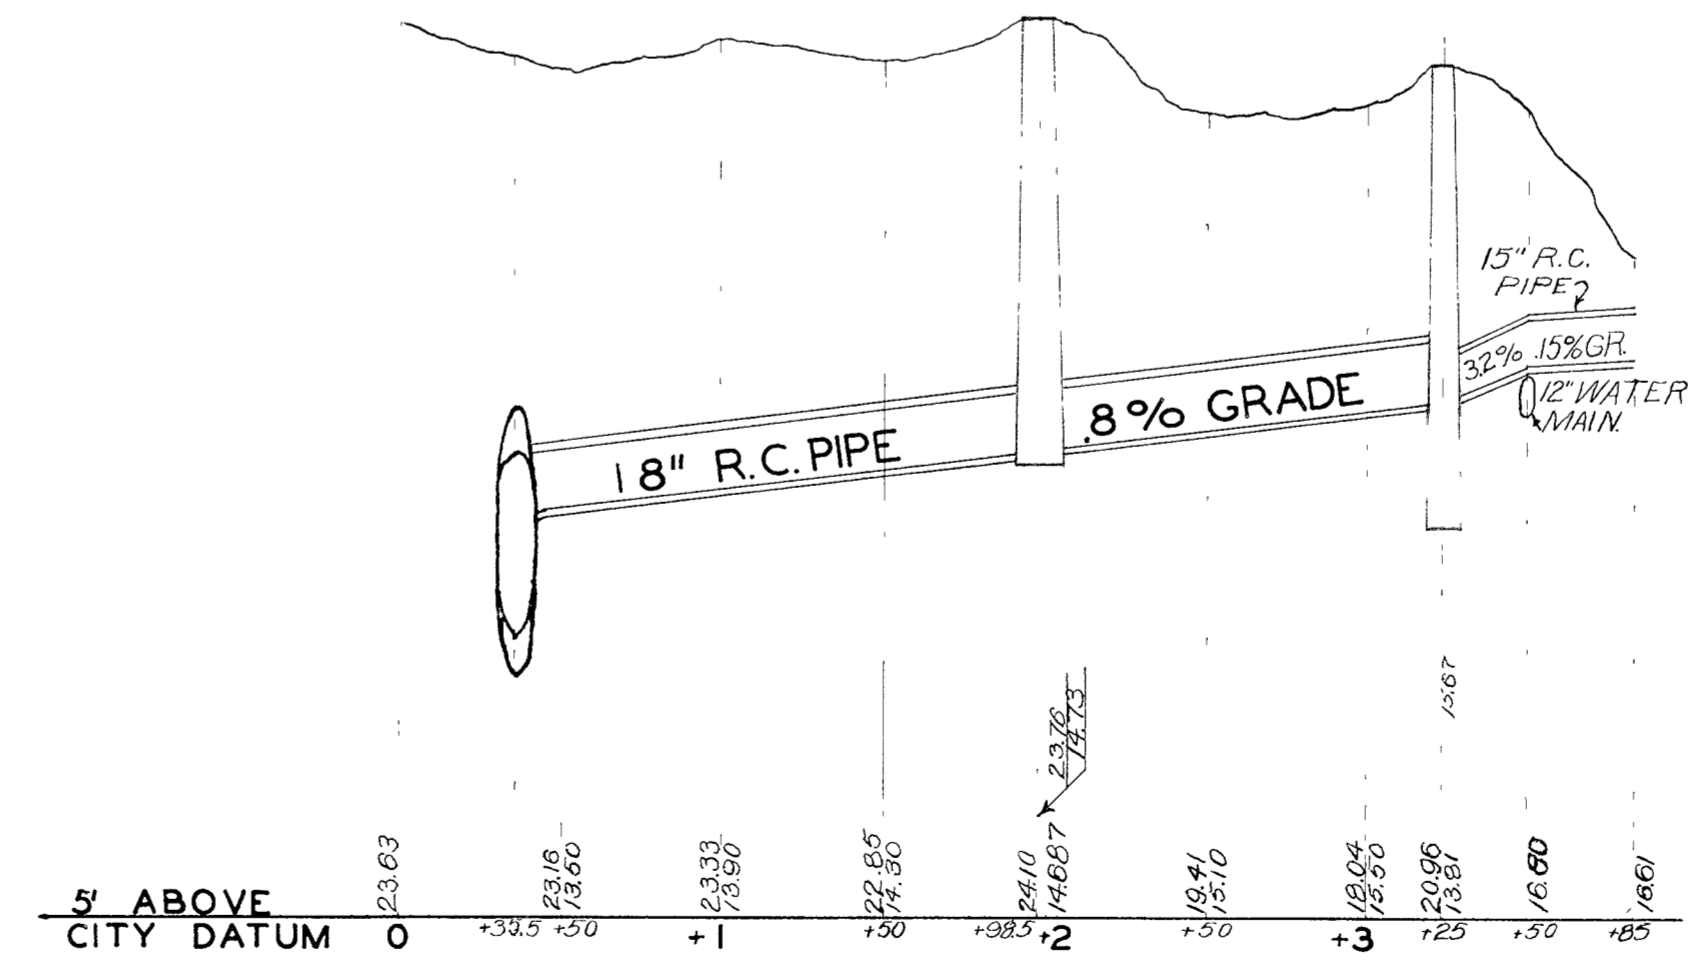


**CITY OF SUPERIOR
SEWER PLAN**

HORIZONTAL SCALE 1" = 60'
 VERTICAL SCALE 1" = 4'

JOB STARTED FEB. 1938
 JOB COMPLETED MAR. 1938
 W.P.A. LABOR
 F. BIRCH INSPECTOR
 T. M. BASTERASH CITY ENGINEER

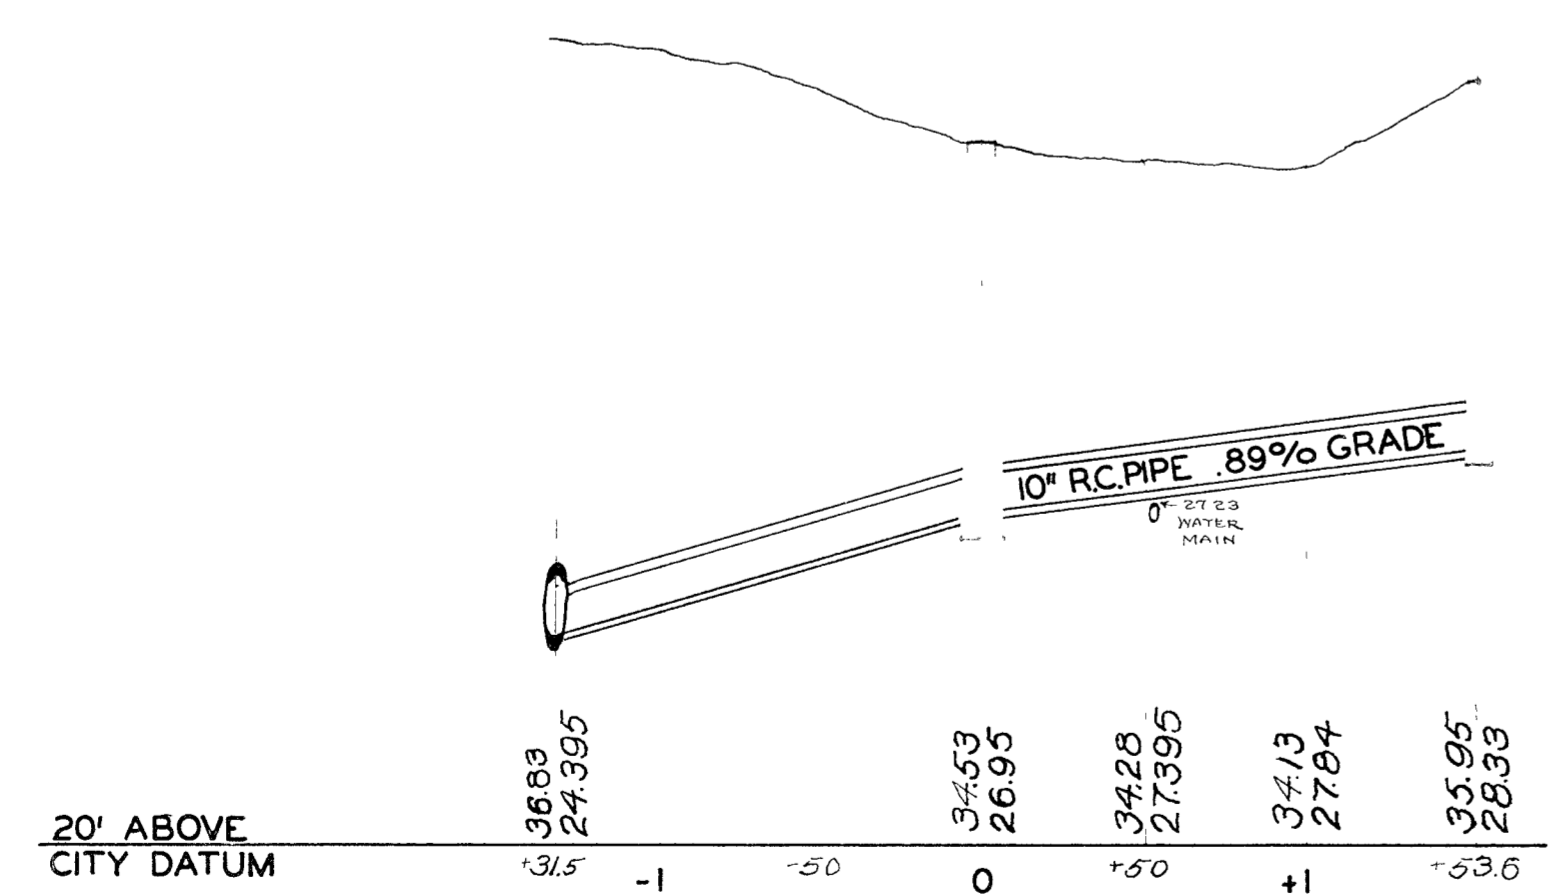

3A-18A