

1907 CITY OF SUPERIOR SEWER PLAN



CONTRACT LET JULY 21ST 1906
COMPLETED AUG. 6TH 1906
CONT. # 932 ANDERSON & JOHNSON
CONTR.

FRANK RICHARDSON
INSPECTOR

E. B. BANKS
CITY ENGR.

CONTRACT NO. 1135. JOHNSON & JOHNSON, CONTRACTORS.
CONTRACT LET APRIL 2, 1909; COMPLETED JULY 1, 1909.
A. SOLIN, INSPECTOR.

SCALE: { HORIZONTAL 1" = 50 FT.
VERTICAL 1" = 4 FT.
SECTION 1" = 2 FT.

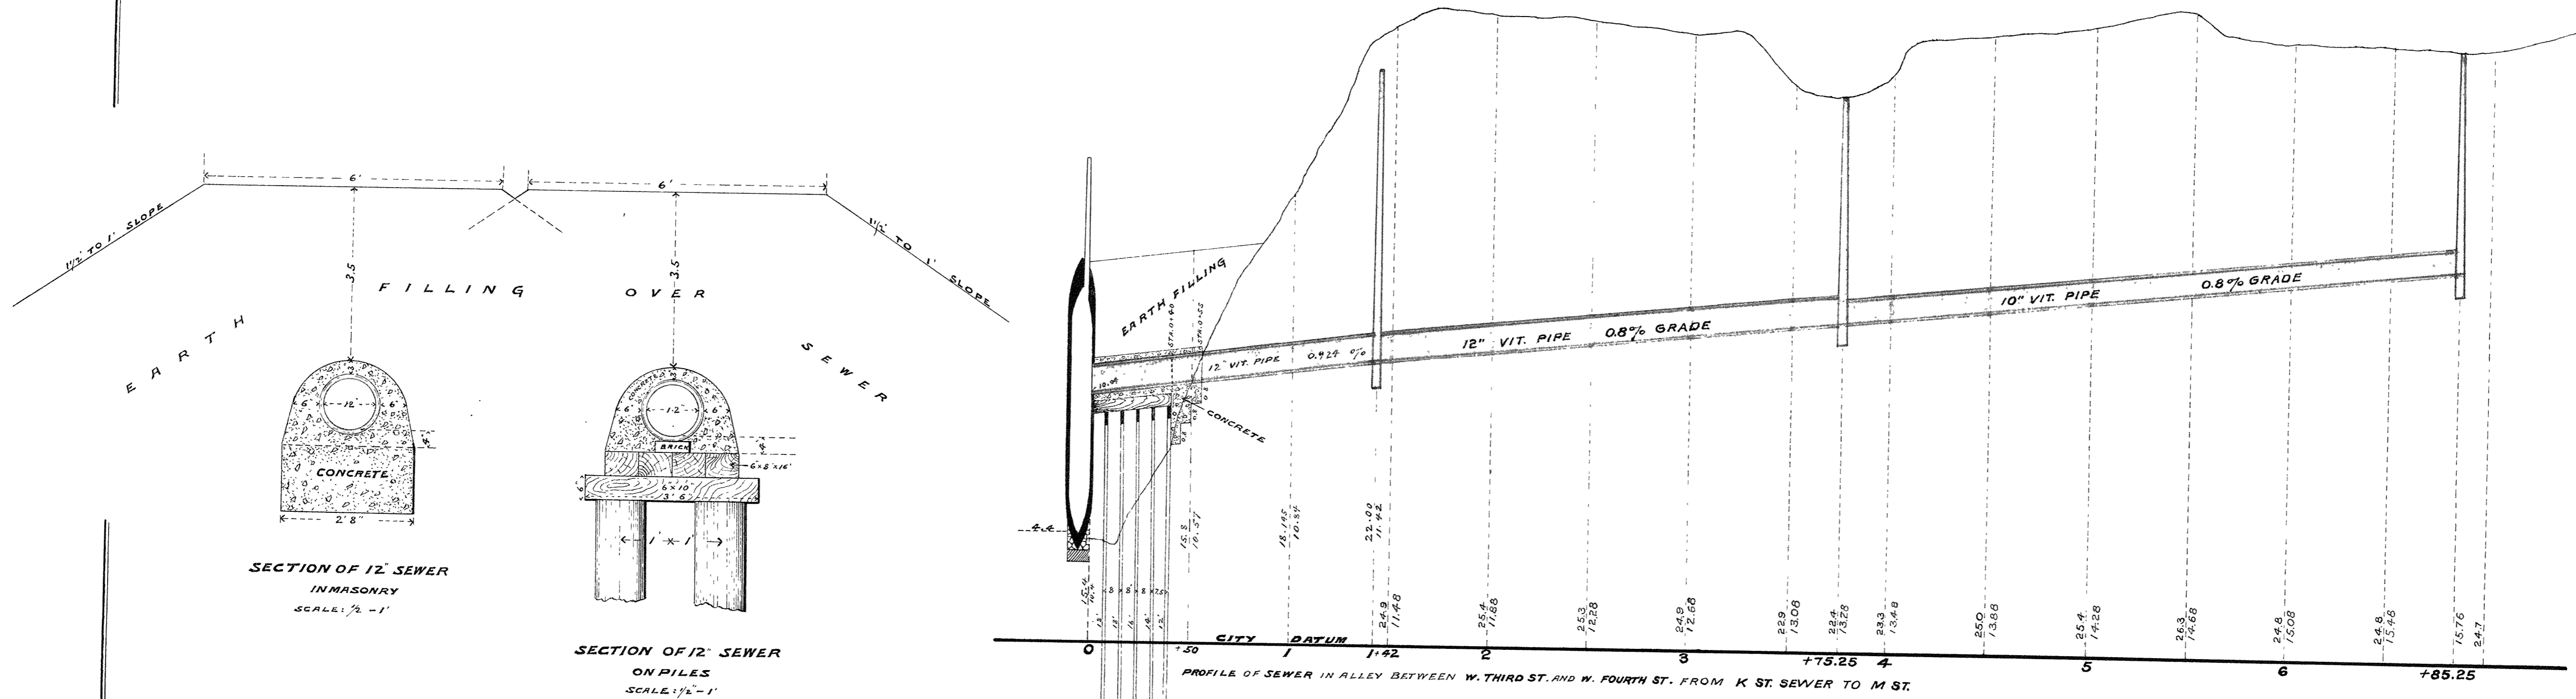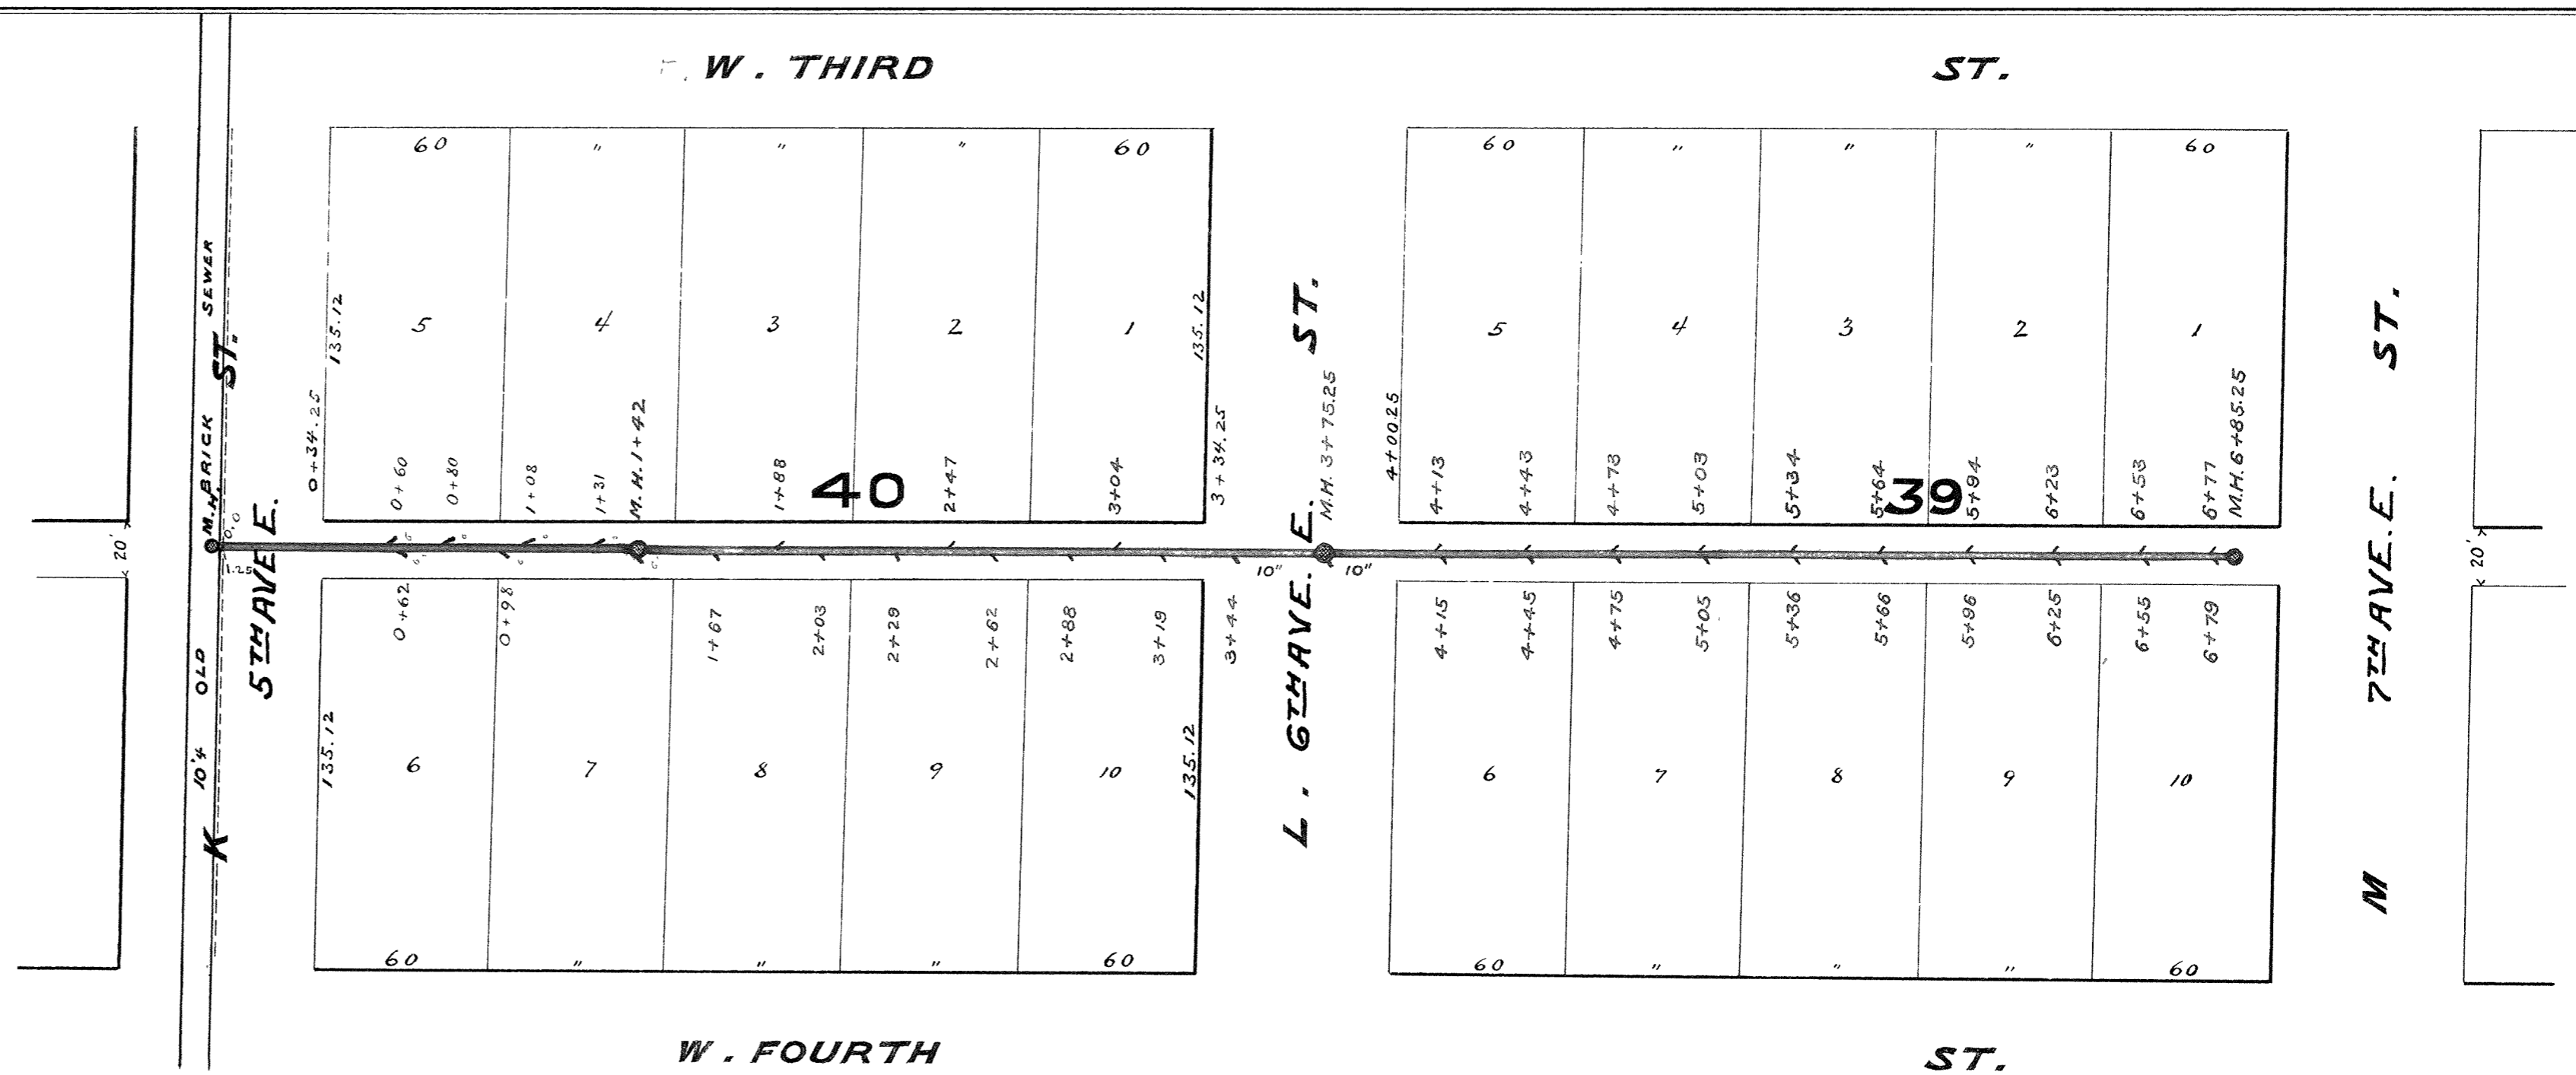

SECTION OF 12" SEWER
IN MASONRY
SCALE: 1/2" = 1'

SECTION OF 12" SEWER
ON PILES
SCALE: 1/2" = 1'

3A-25