
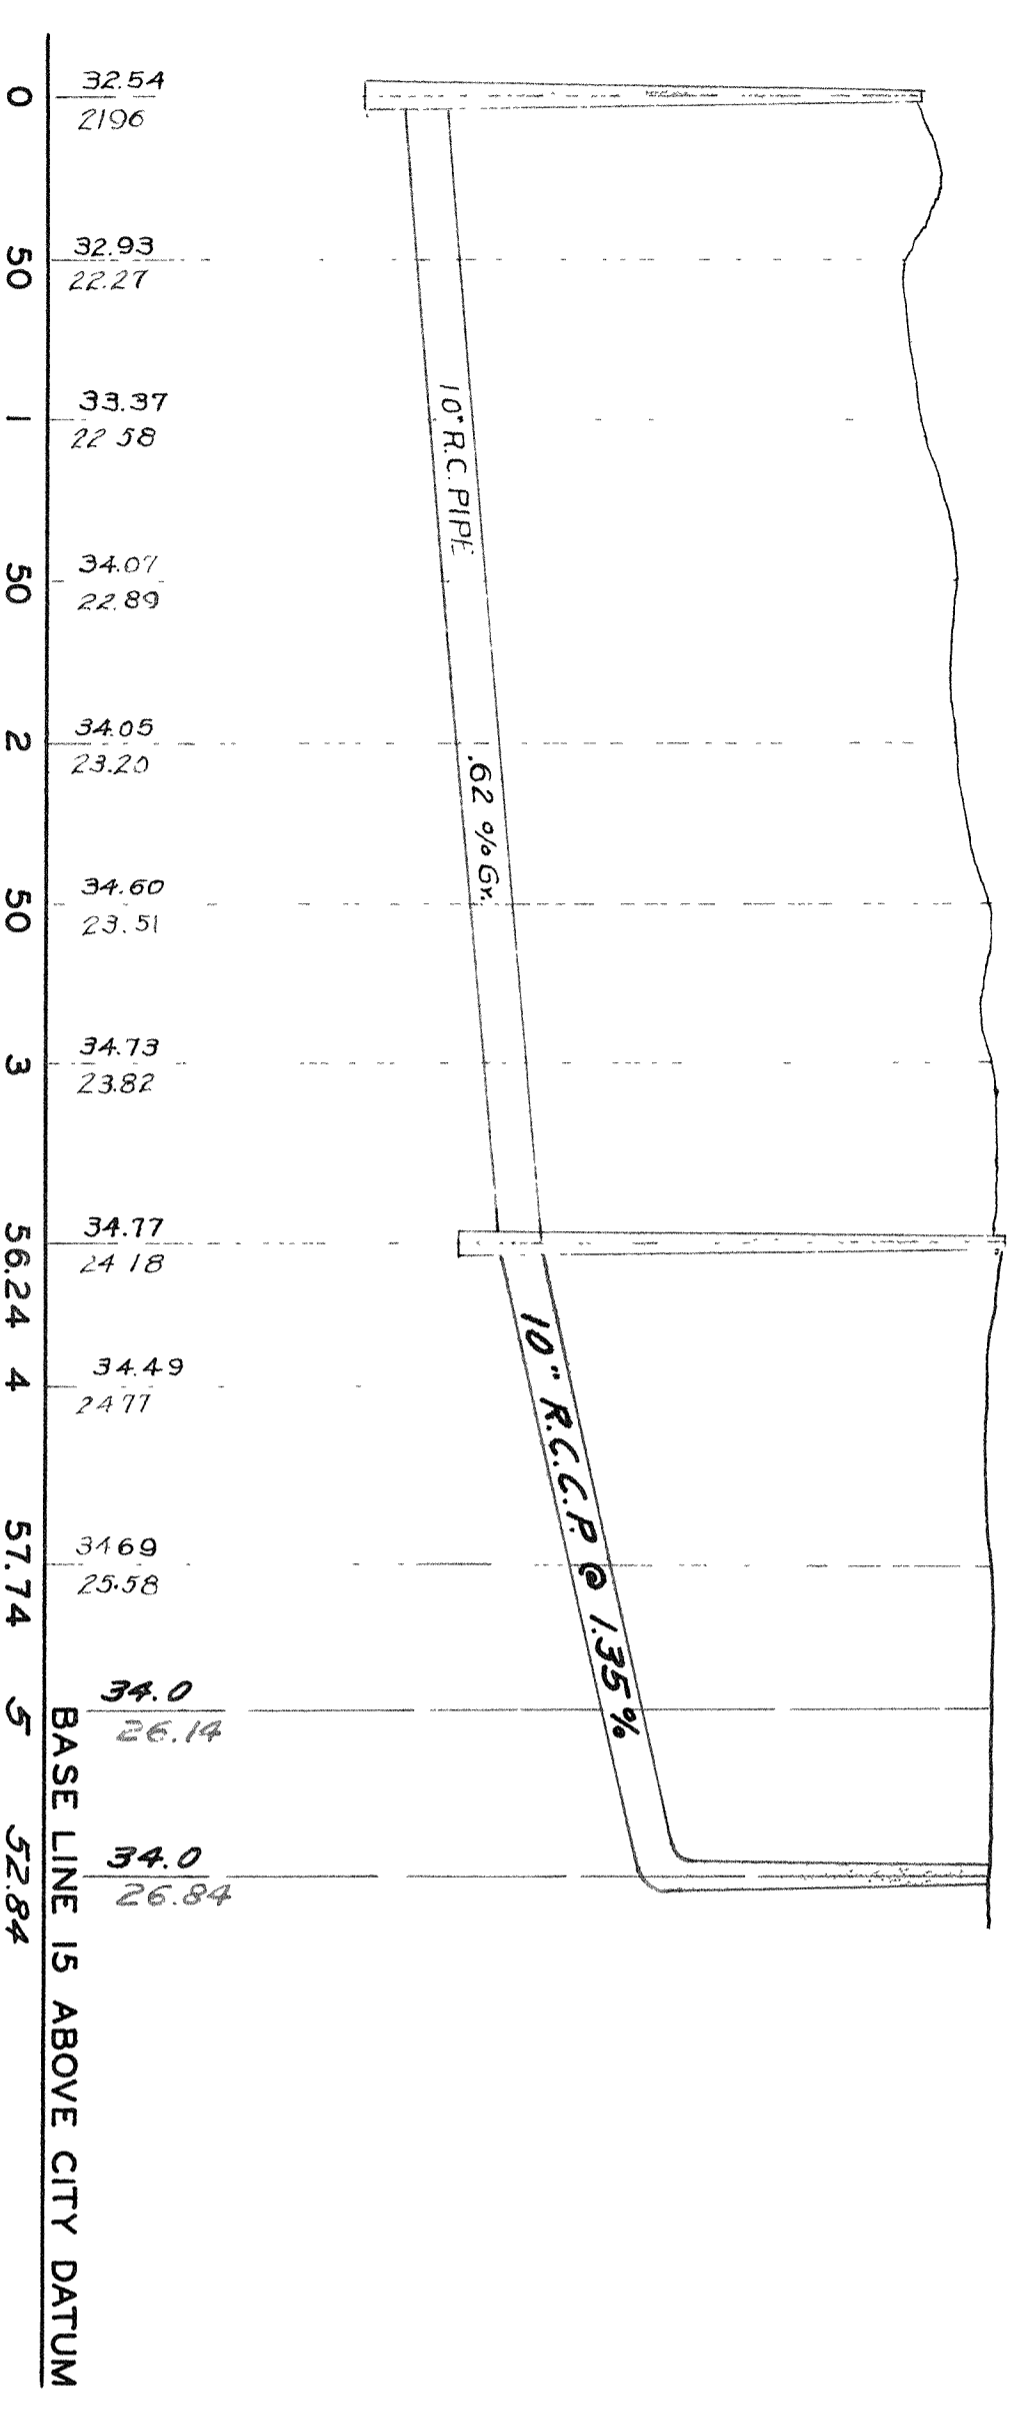


CITY OF SUPERIOR SEWER PLAN

HORIZONTAL SCALE 1" = 60'
VERTICAL SCALE 1" = 4'

JOB STARTED NOV. 191936
JOB COMPLETED
W.P.A. LABOR
M. SKAMSER INSPECTOR
L.W. PELESKE CITY ENGINEER

JOB COMPLETED STA. 4+57.70 STA.
5+52 AUG. 1958
E.W. BERG CITY ENGINEER

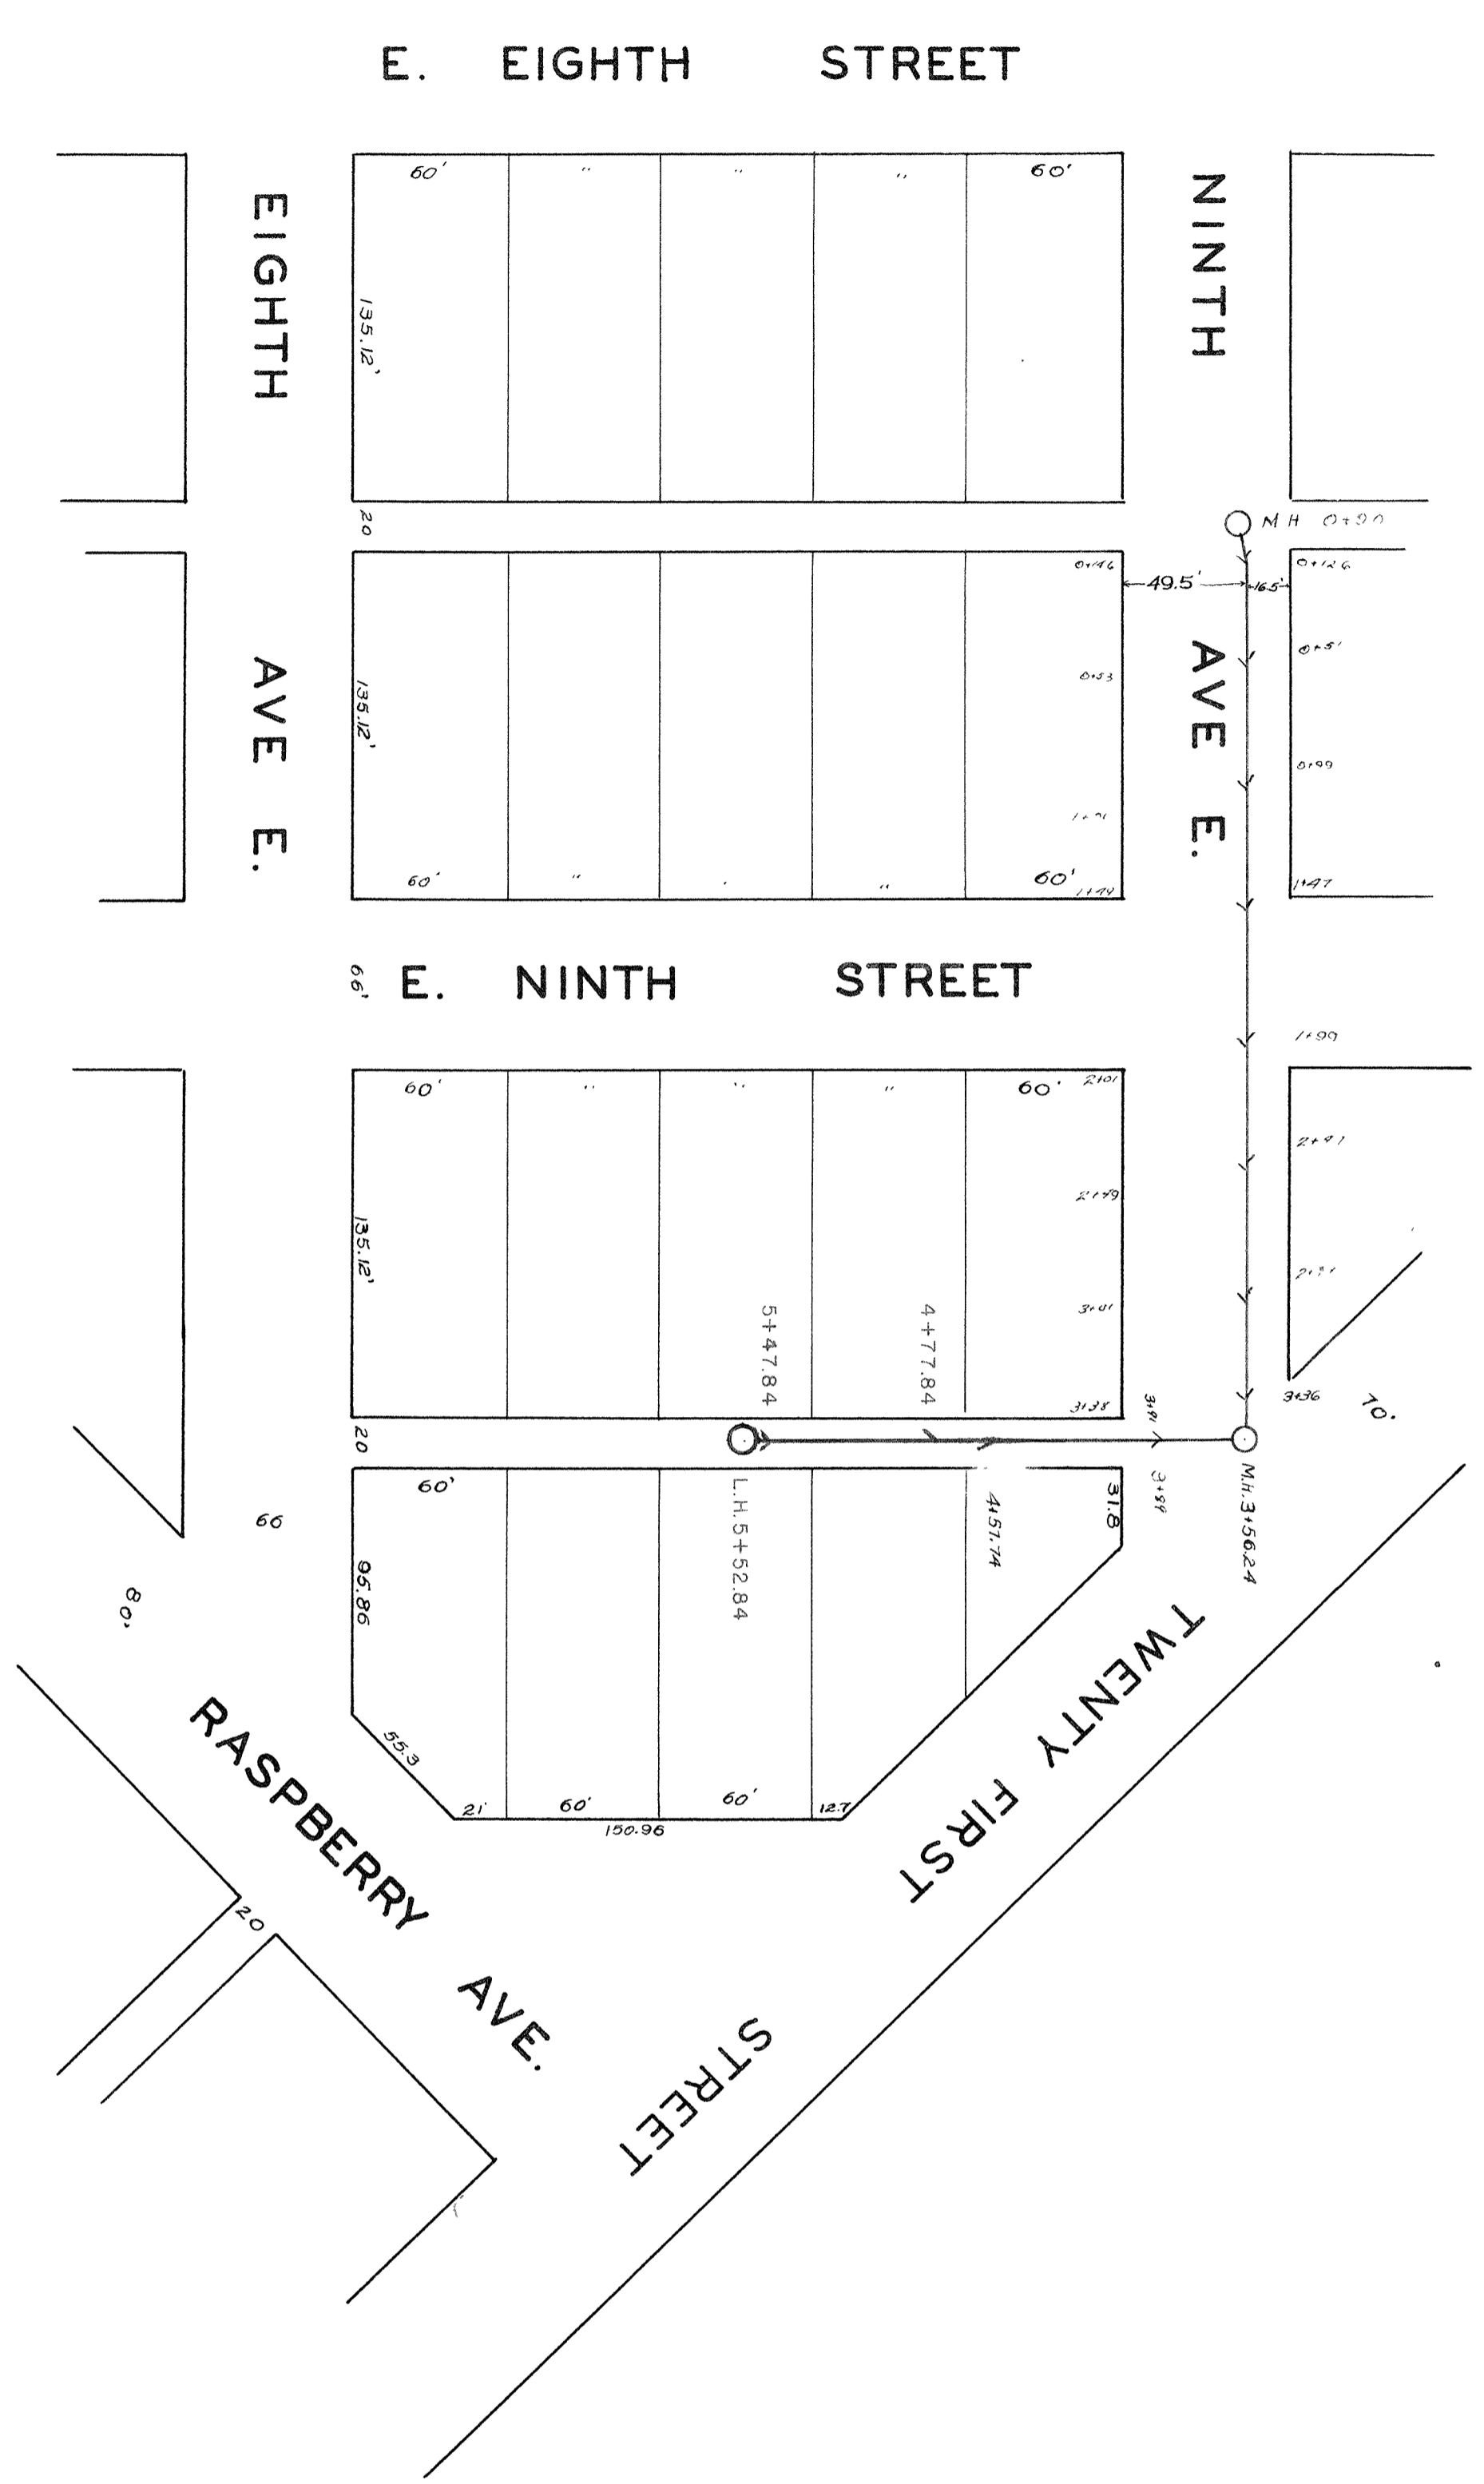

3A-26B