
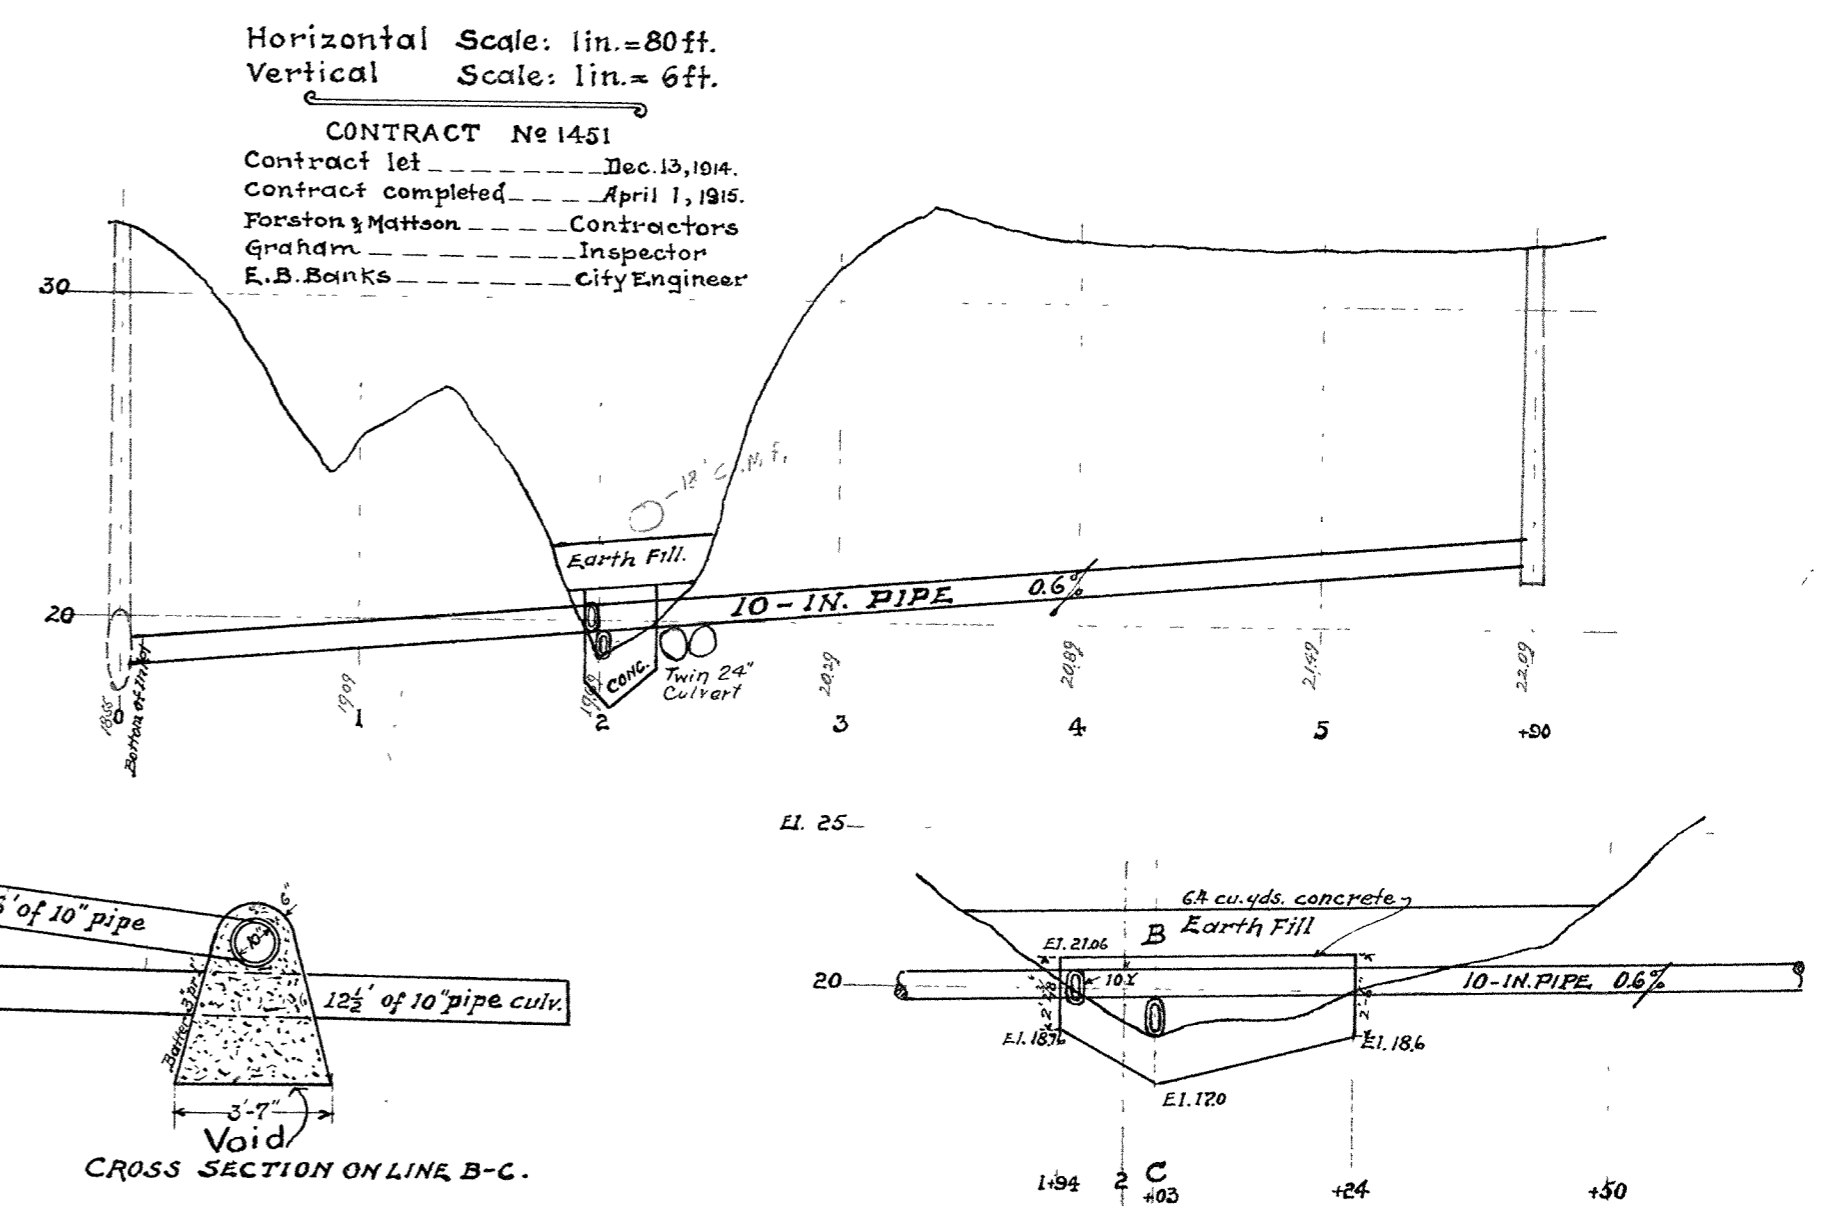


**CITY OF SUPERIOR  
SEWER PLAN**

Horizontal Scale: lin. = 60 ft.  
Vertical Scale: lin. = 4 ft.

→ CONTRACT No 1382 ←

Contract let \_\_\_\_\_ Aug. 8, 13.  
Contract completed \_\_\_\_\_ Jan 28, 14.  
S.A. Riches & Anderson \_\_\_\_\_ Contractors  
Andrew Solin \_\_\_\_\_ Inspector  
E.B. Banks \_\_\_\_\_ City Engineer.

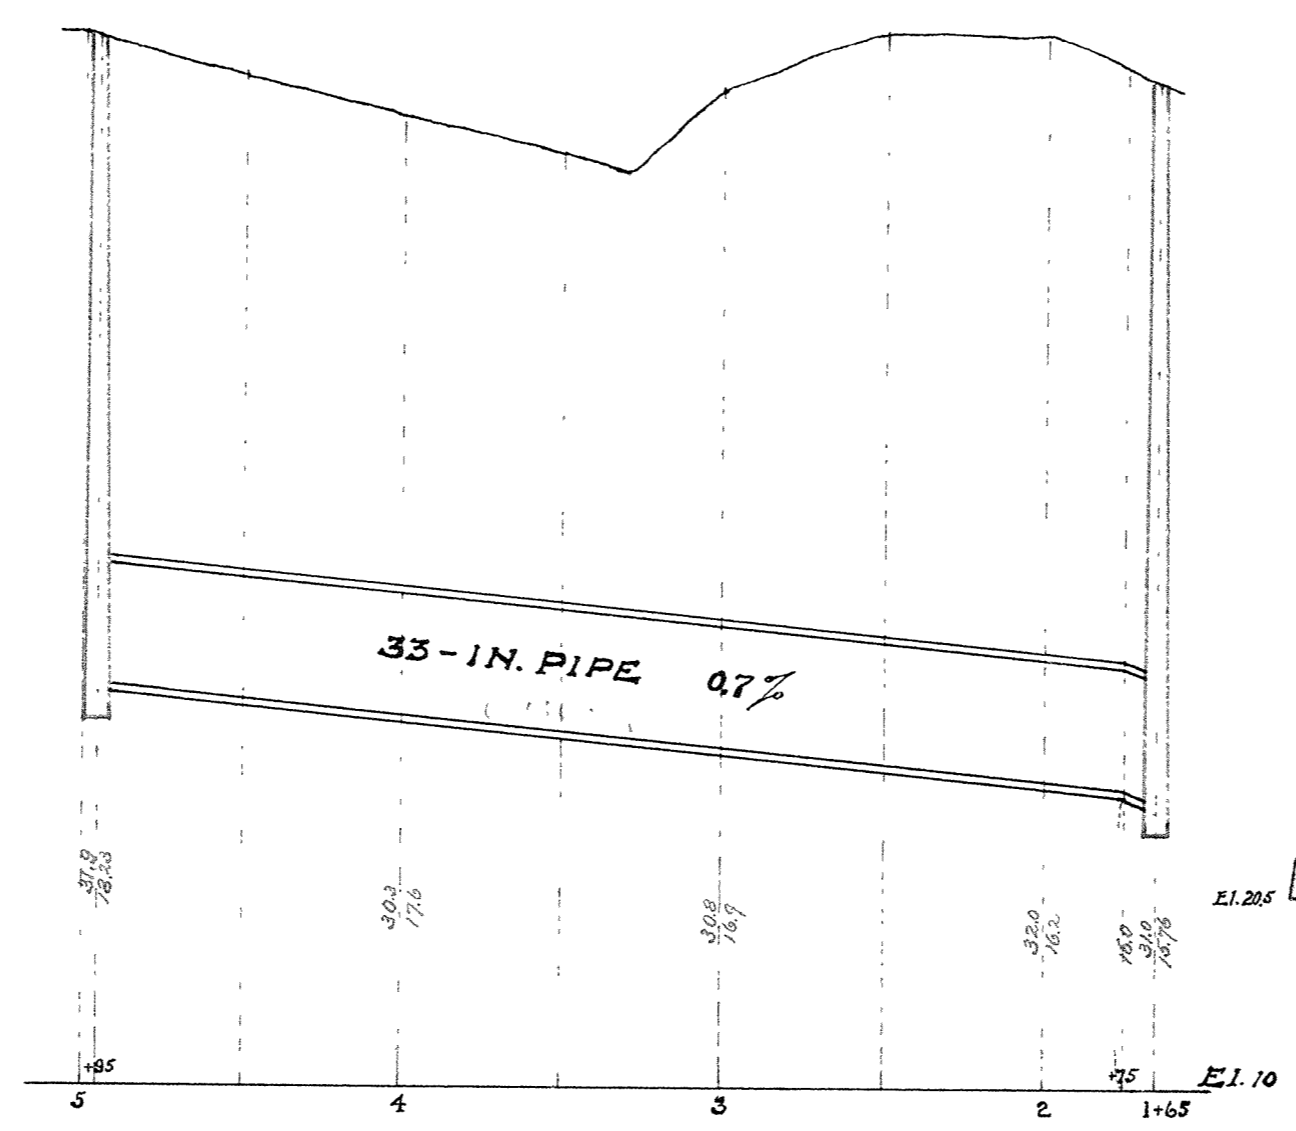

3A-27