
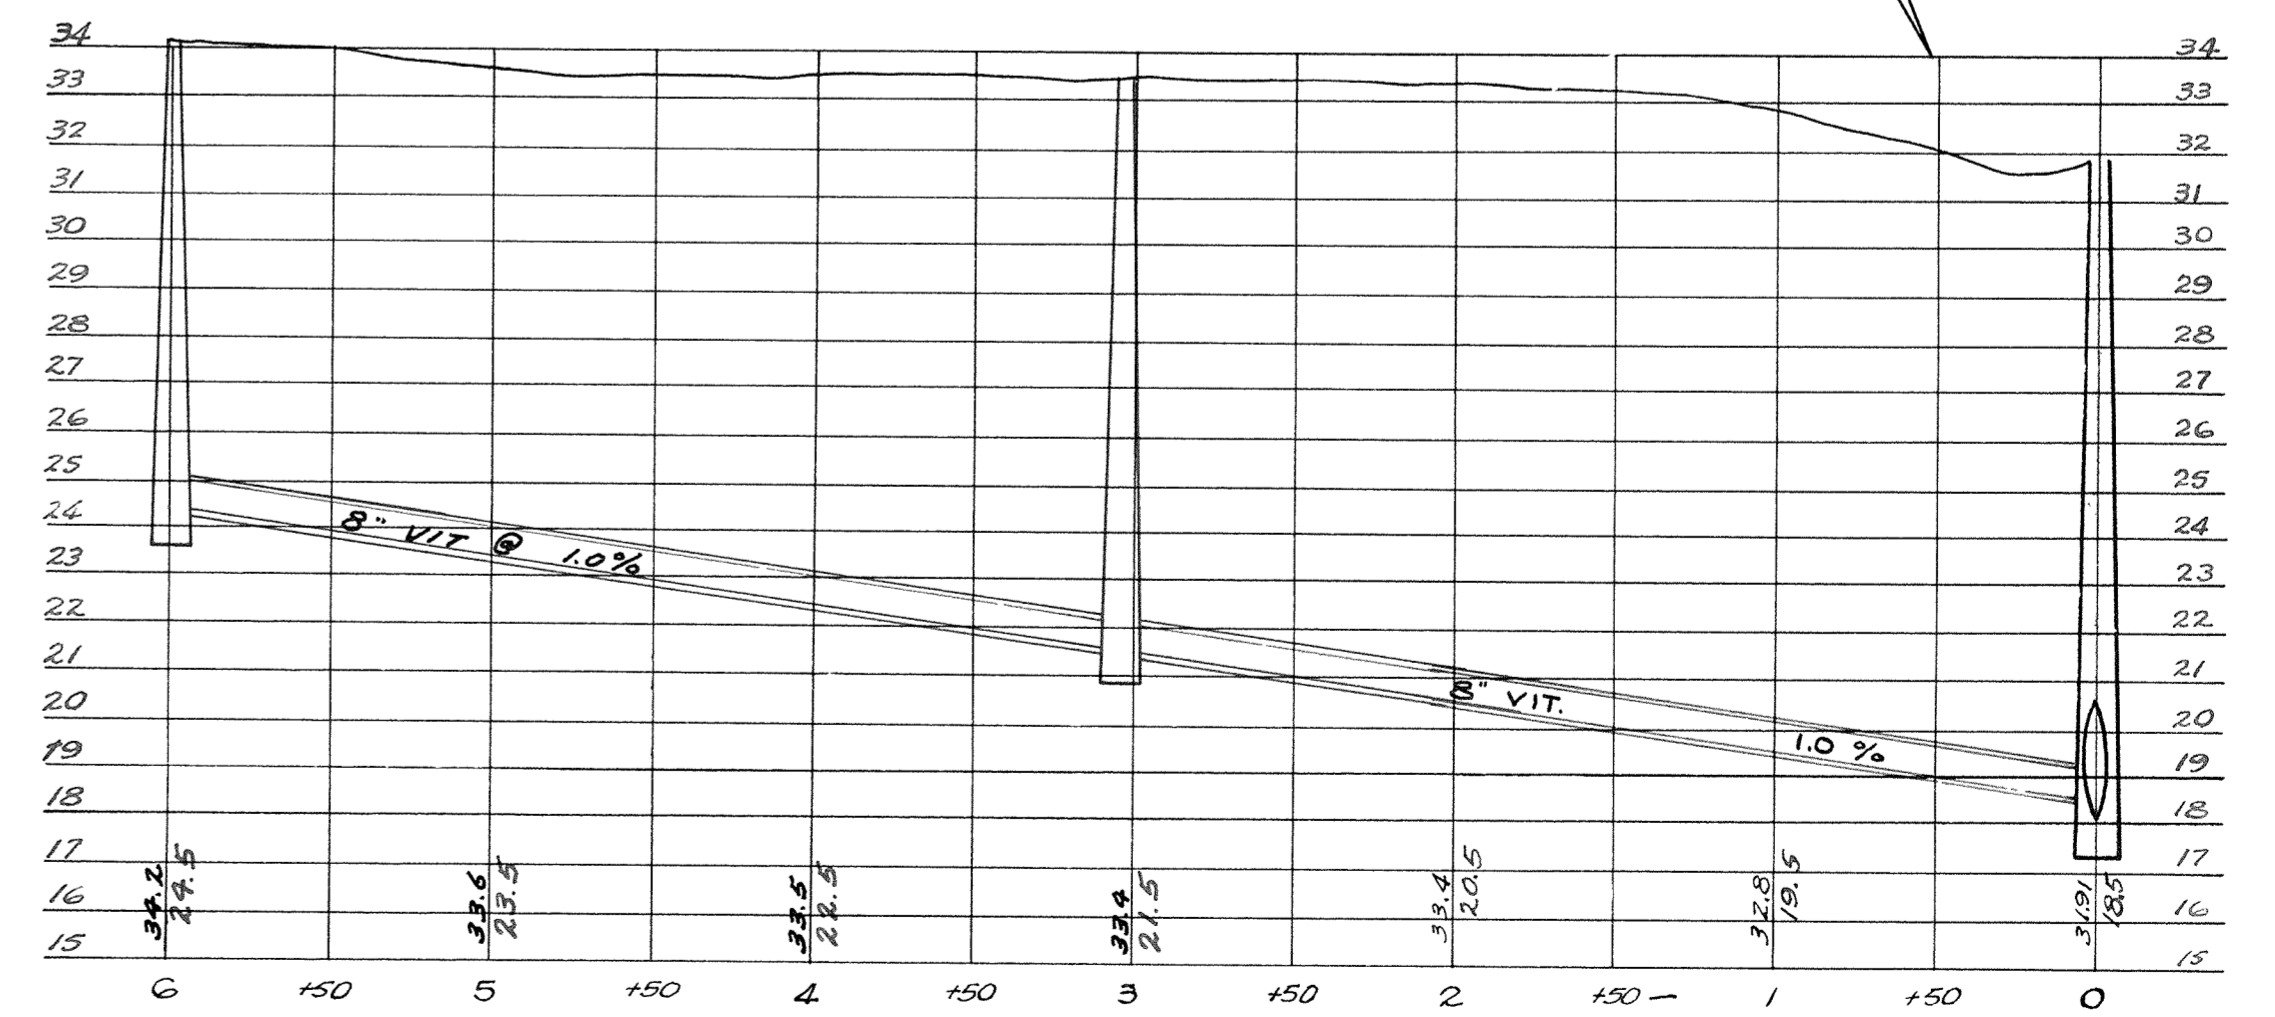


**CITY OF SUPERIOR  
SEWER PLAN**

CONTRACT #1623  
 LET AUG. 16, 1920  
 COMPLETED OCT. 1, 1920  
 OSCAR ANDERSON CONTRACTOR  
 E.M. STEFFENSON INSPECTOR  
 E.B. BANKS CITY ENGINEER

0+00 - 2+07 COMPLETED 1957  
 2+07 - 4+15 COMPLETED 1959  
 4+15 - 6+0 COMPLETED 1960  
 CONTRACTOR - ELLIS PLUMBING  
 HORIZONTAL SCALE - 1" = 60'  
 VERTICAL SCALE - 1" = 5'  
 GEO. DATUM - MORTAR JOINTS

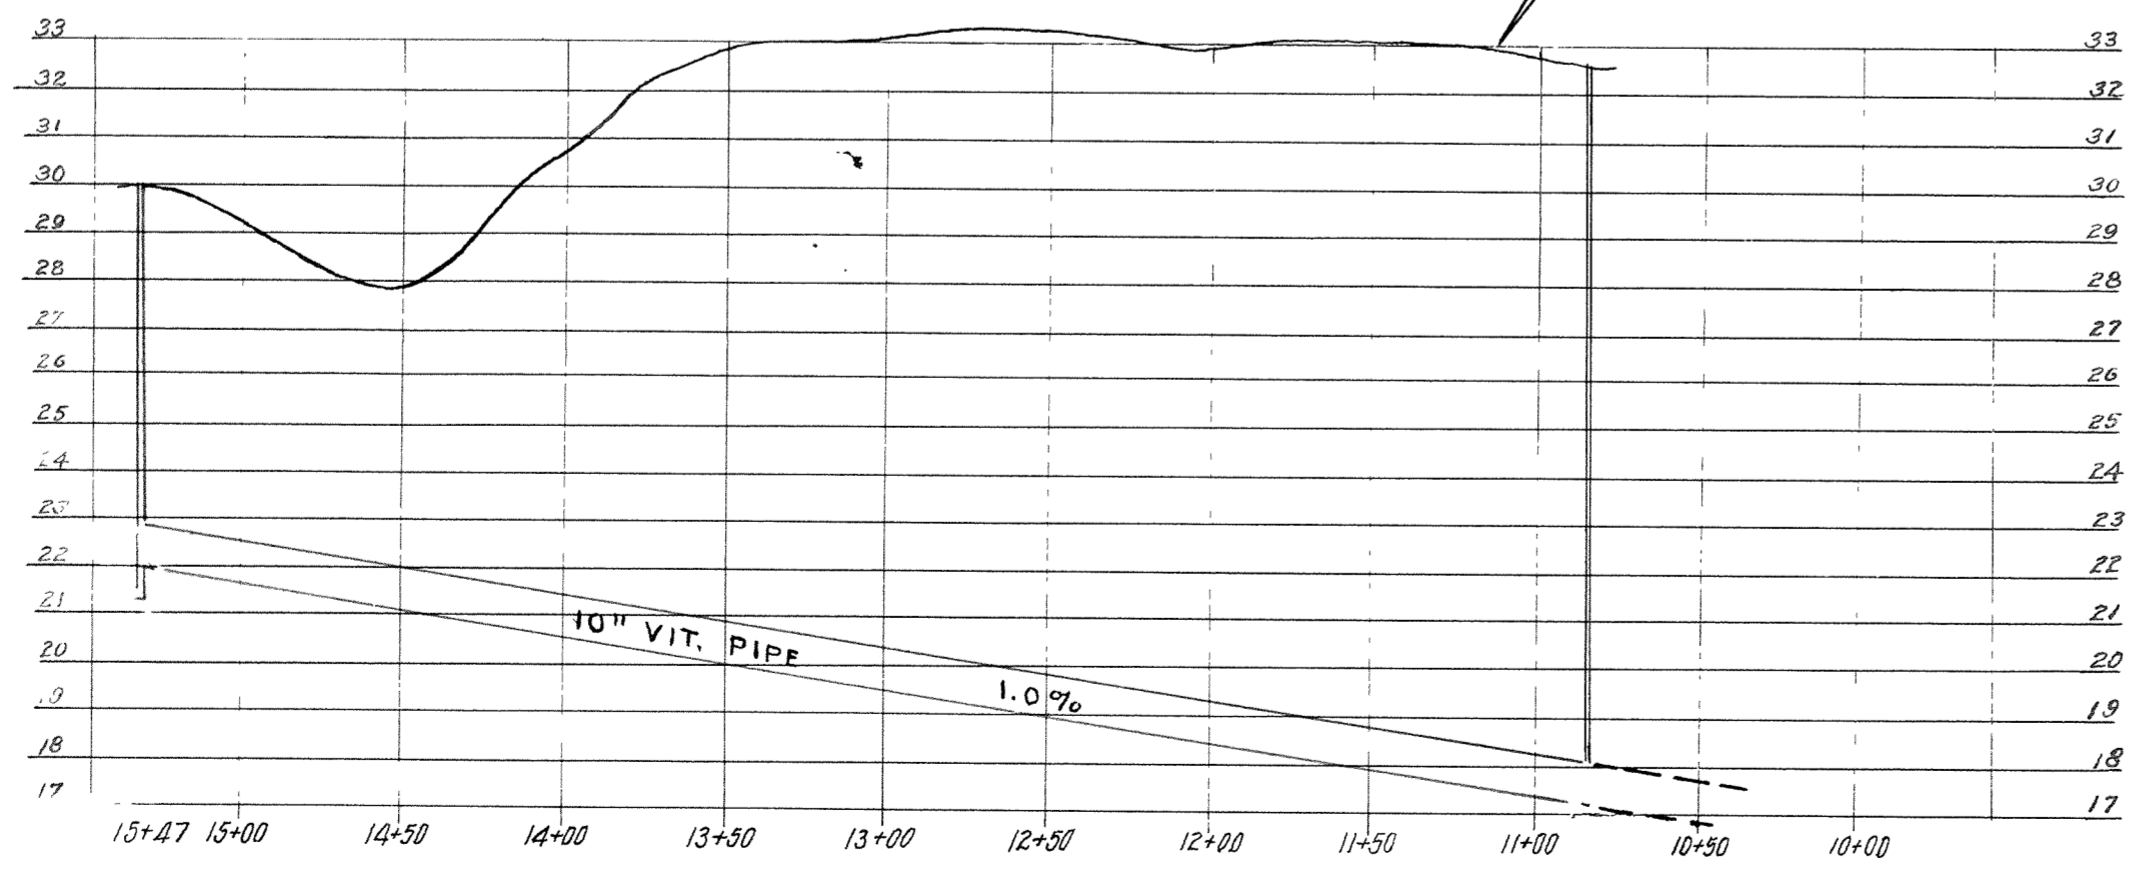

3A-29