


CITY OF SUPERIOR  
SEWER PLAN

HORIZONTAL SCALE: 1" = 60'  
VERTICAL SCALE: 1" = 4'

JOB STARTED JAN. 25, 1936  
JOB COMPLETED 1936  
LABOR W. P. A.  
INSPECTOR R. H. DANN  
CITY ENGINEER L. W. PELESKE

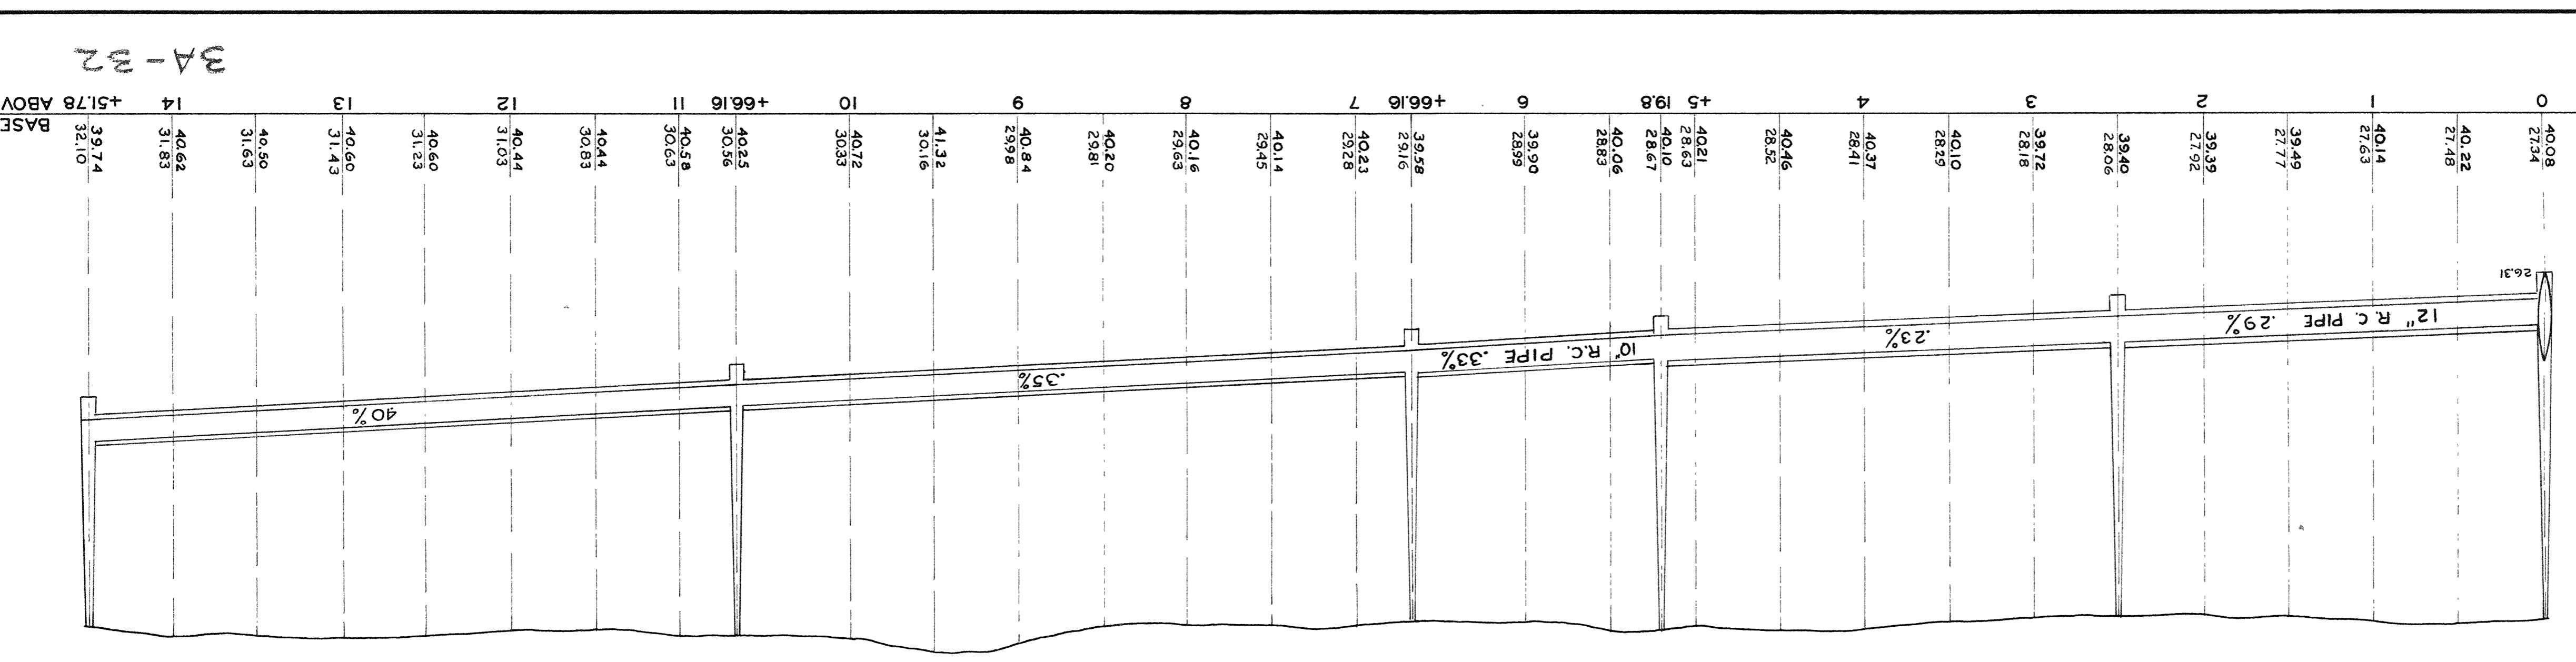

3A-32  
BASE LINE  
+51.78 ABOVE DATUM

