


E. W. EIGHTH ST.
CITY OF SUPERIOR


1895

SEWER PLAN

Contract let May 20, 1892
 completed Aug 17, 1892
 Sang, Nicholson & Co. Contractor
 T. A. King, Inspector
 A. G. Cooper, City Engineer

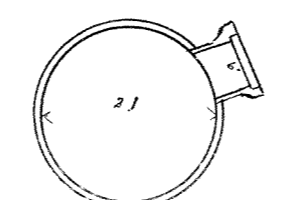

Section of 21" Pipe

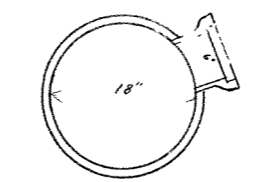


Section of 18" Pipe




Section of 15" Pipe

Scale: { Horizontal 60 ft = 1 inch
 Vertical 4 ft = 1 inch
 Section 2 ft = 1 inch

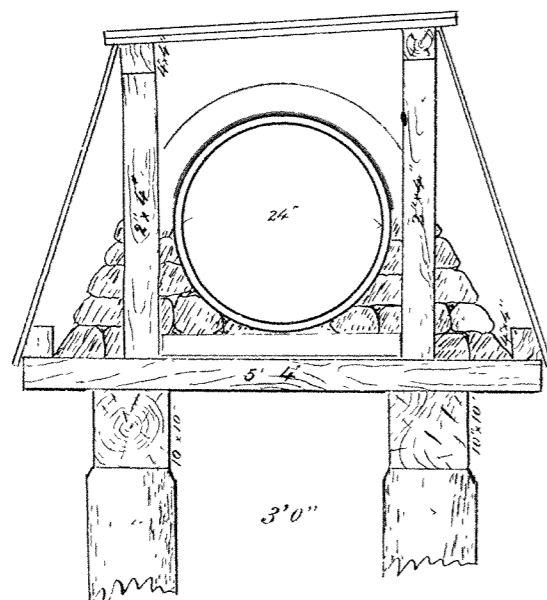

Section of 24" Pipe on Piles

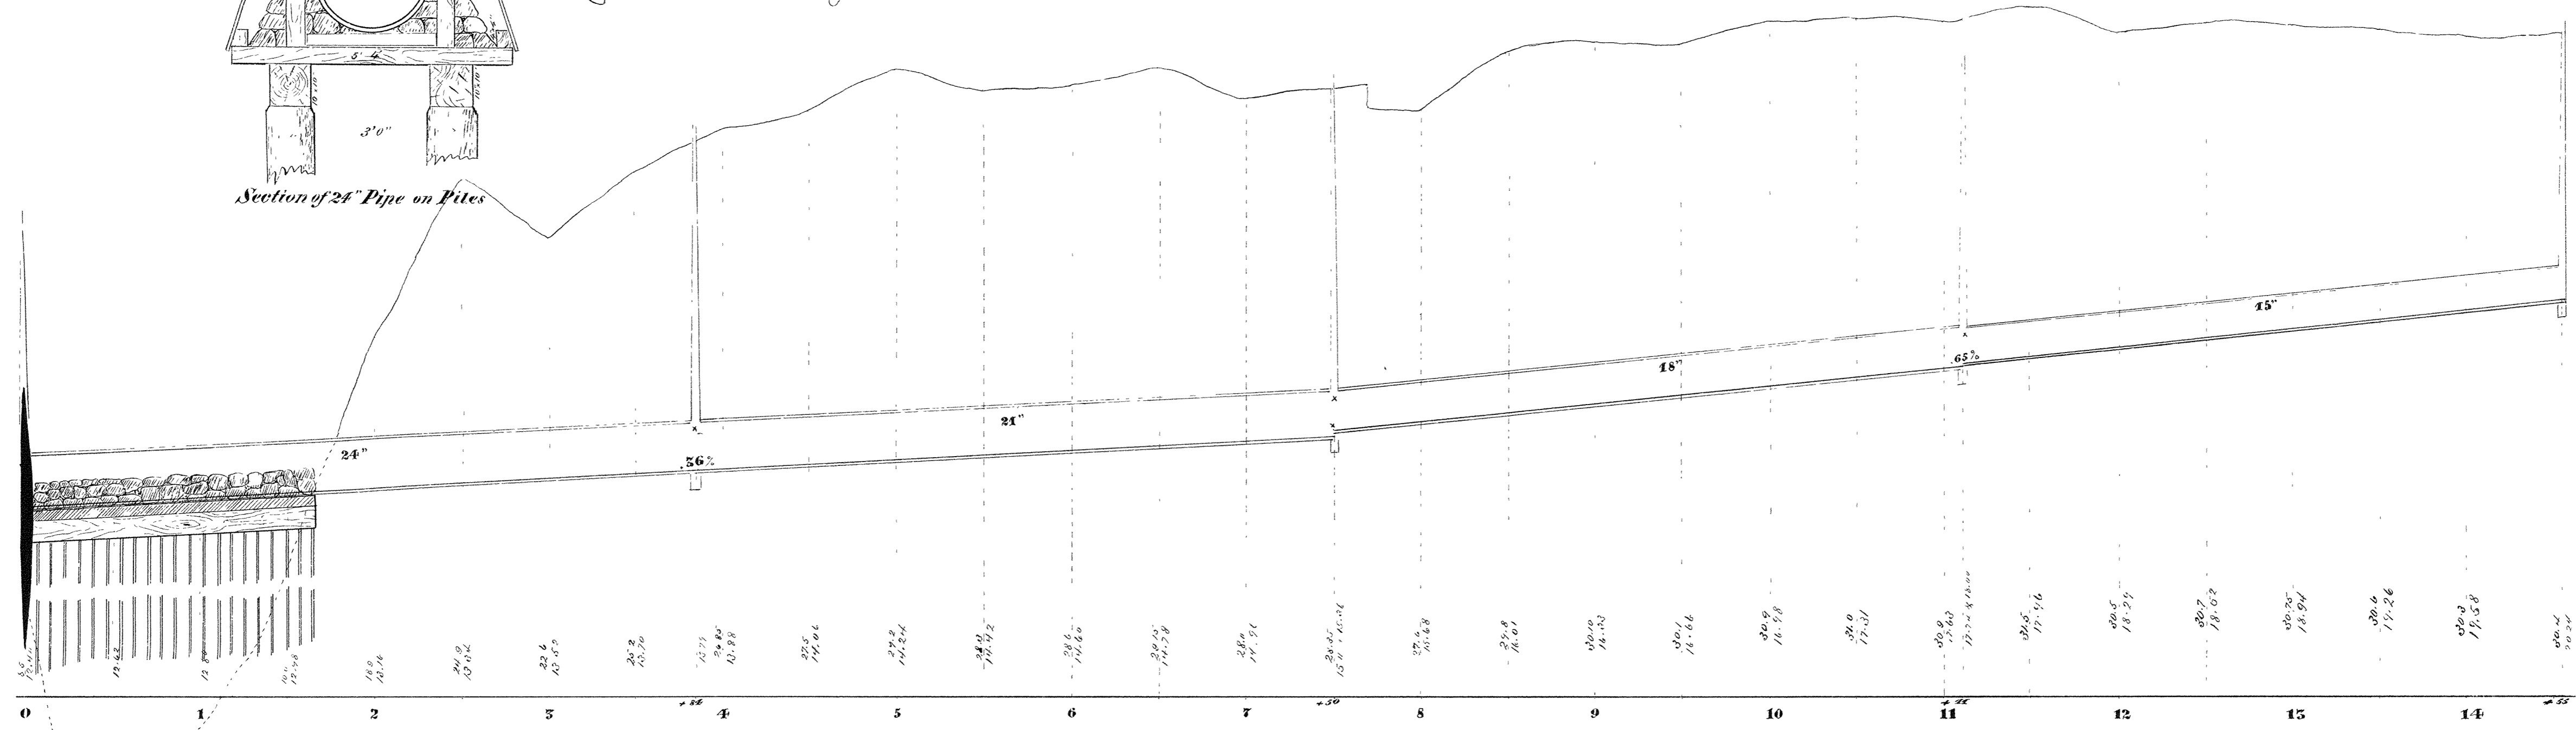

Plan & Profile of Sewer in Alley betw. W. Seventh and W. Eighth Sts. from K St. to O St.

3A-7