

**CITY OF SUPERIOR
SEWER PLAN**

Horizontal Scale: 1 in. = 80 ft.
Vertical Scale: 1 in. = 5 ft.

CONTRACT No 1459

Contract let Feb. 16-1915.


Contract completed

Magnus Pedersen Contractor


Graham Inspector

E. B. Banks City Engineer.

— B LINE —

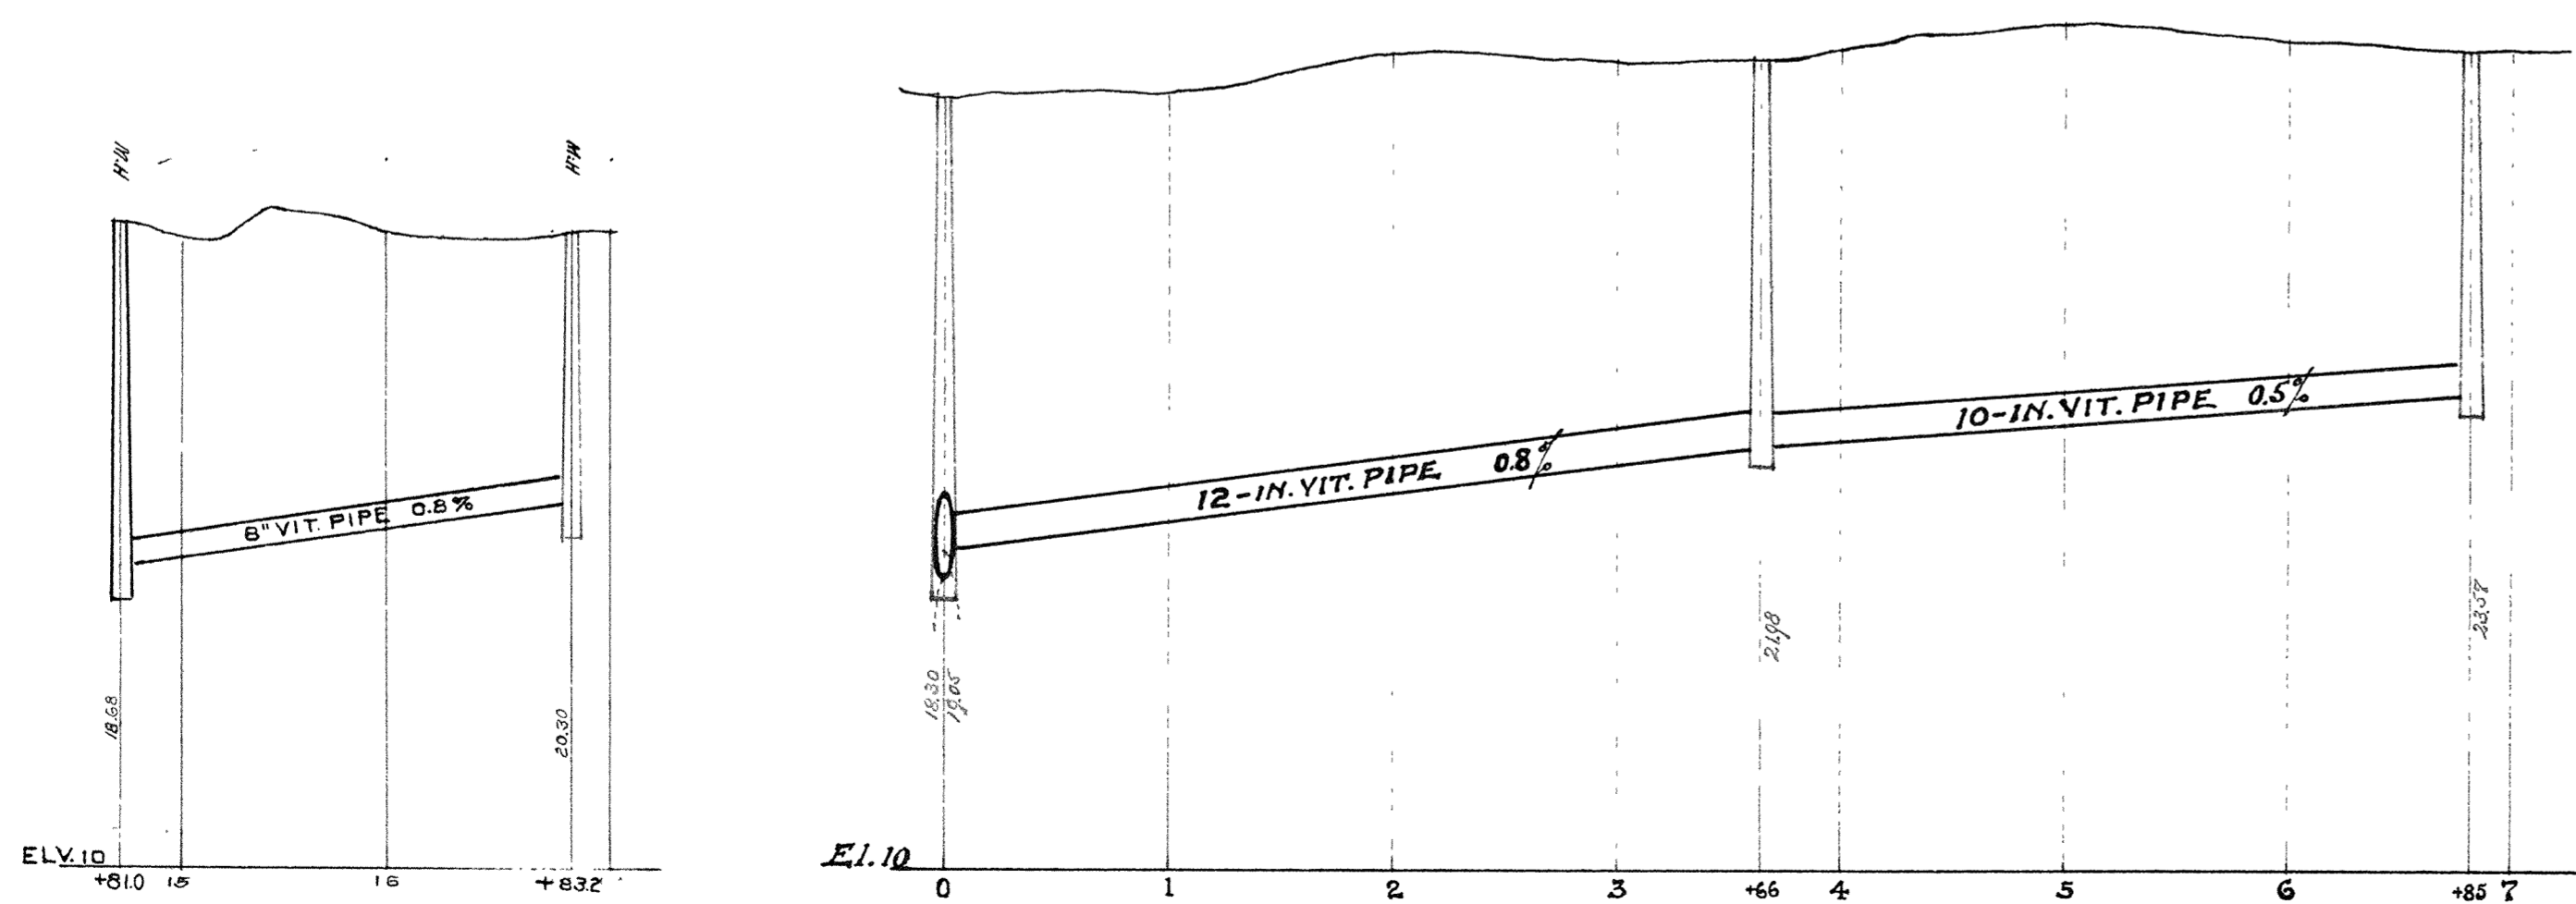

— A LINE —

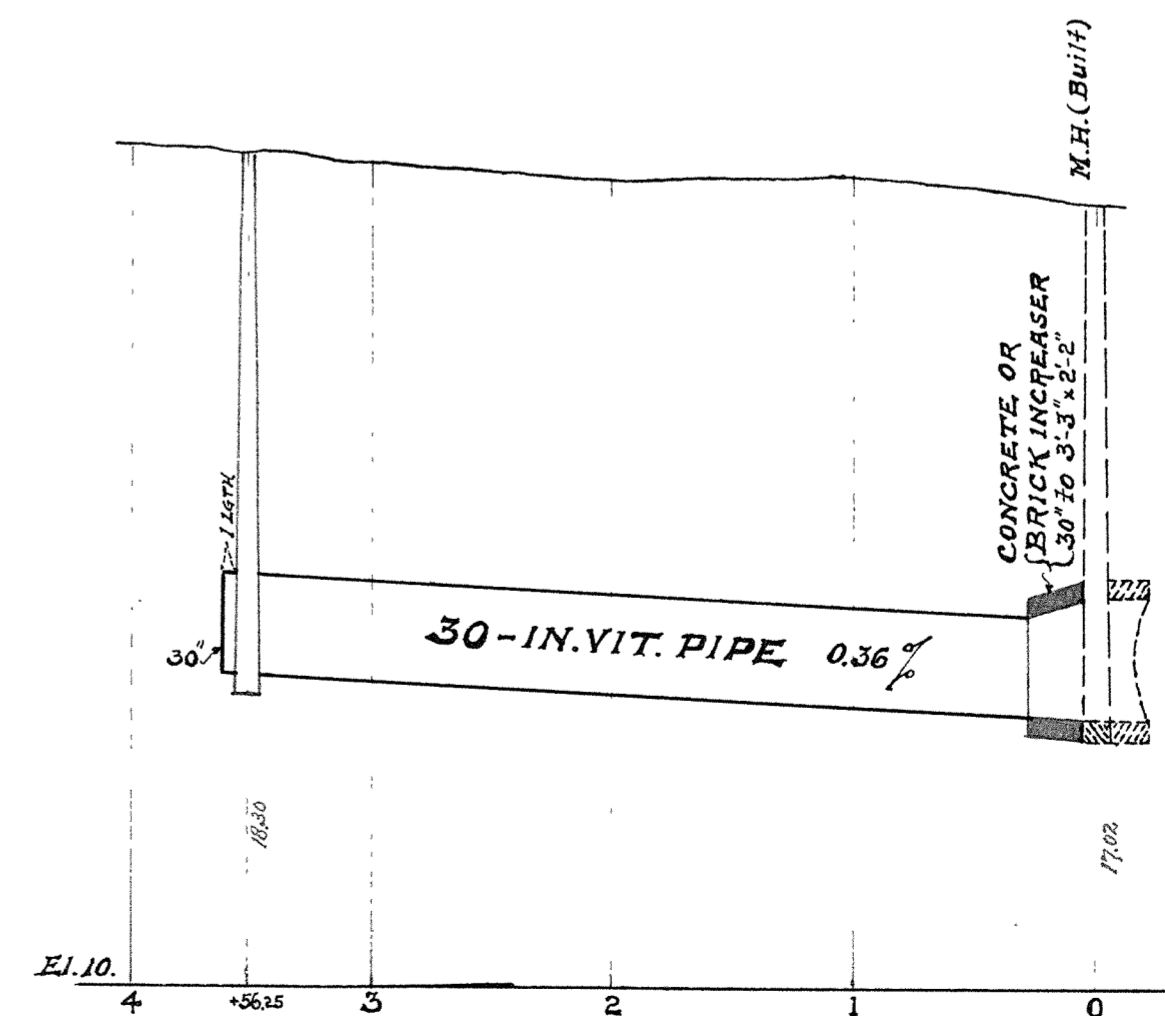

3A-8A