

SUP JUN 11


PROJECT ID: 1190-44-71

COUNTY: DOUGLAS

ORDER OF SHEETS

Section No. 1	Title
Section No. 2	Typical Sections and Details
Section No. 3	Estimate of Quantities
Section No. 3	Miscellaneous Quantities
Section No. 4	Right of Way Plat
Section No. 5	Plan and Profile
Section No. 6	Standard Detail Drawings
Section No. 7	Sign Plates
<del>Section No. 8</del>	<del>Structure Plans</del>
Section No. 9	Computer Earthwork Data
Section No. 9	Cross Sections

TOTAL SHEETS = 158

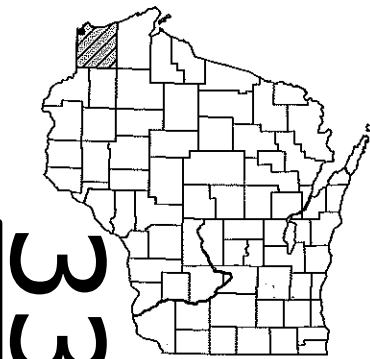

DESIGN DESIGNATION

A.A.D.T. (2005)	=	8950
A.A.D.T. (2030)	=	11200
D.H.V.	=	1288
D.D.	=	58/42
T.	=	4.3
DESIGN SPEED	=	30 MPH
ESALS	=	1,435,753

CONVENTIONAL SYMBOLS

PLAN	PROFILE
CORPORATE LIMITS	GRADE LINE
PROPERTY LINE	ORIGINAL GROUND
LOT LINE	MARSH OR ROCK PROFILE (To be noted as such)
LIMITED HIGHWAY EASEMENT	SPECIAL DITCH
EXISTING RIGHT OF WAY	GRADE ELEVATION
PROPOSED OR NEW R/W LINE	CULVERT (Profile View)
SLOPE INTERCEPT	UTILITIES
REFERENCE LINE	ELECTRIC
EXISTING CULVERT	FIBER OPTIC
PROPOSED CULVERT (Box or Pipe)	GAS
COMBUSTIBLE FLUIDS	SANITARY SEWER
MARSH AREA	STORM SEWER
WOODED OR SHRUB AREA	TELEPHONE
	WATER
	UTILITY PEDESTAL
	POWER POLE
	TELEPHONE POLE


# STATE OF WISCONSIN DEPARTMENT OF TRANSPORTATION

## PLAN OF PROPOSED IMPROVEMENT

# CITY OF SUPERIOR, BELKNAP STREET

### HILL AVENUE - EAST 2ND STREET USH 2 DOUGLAS COUNTY

STATE PROJECT NUMBER  
**1190-44-71**

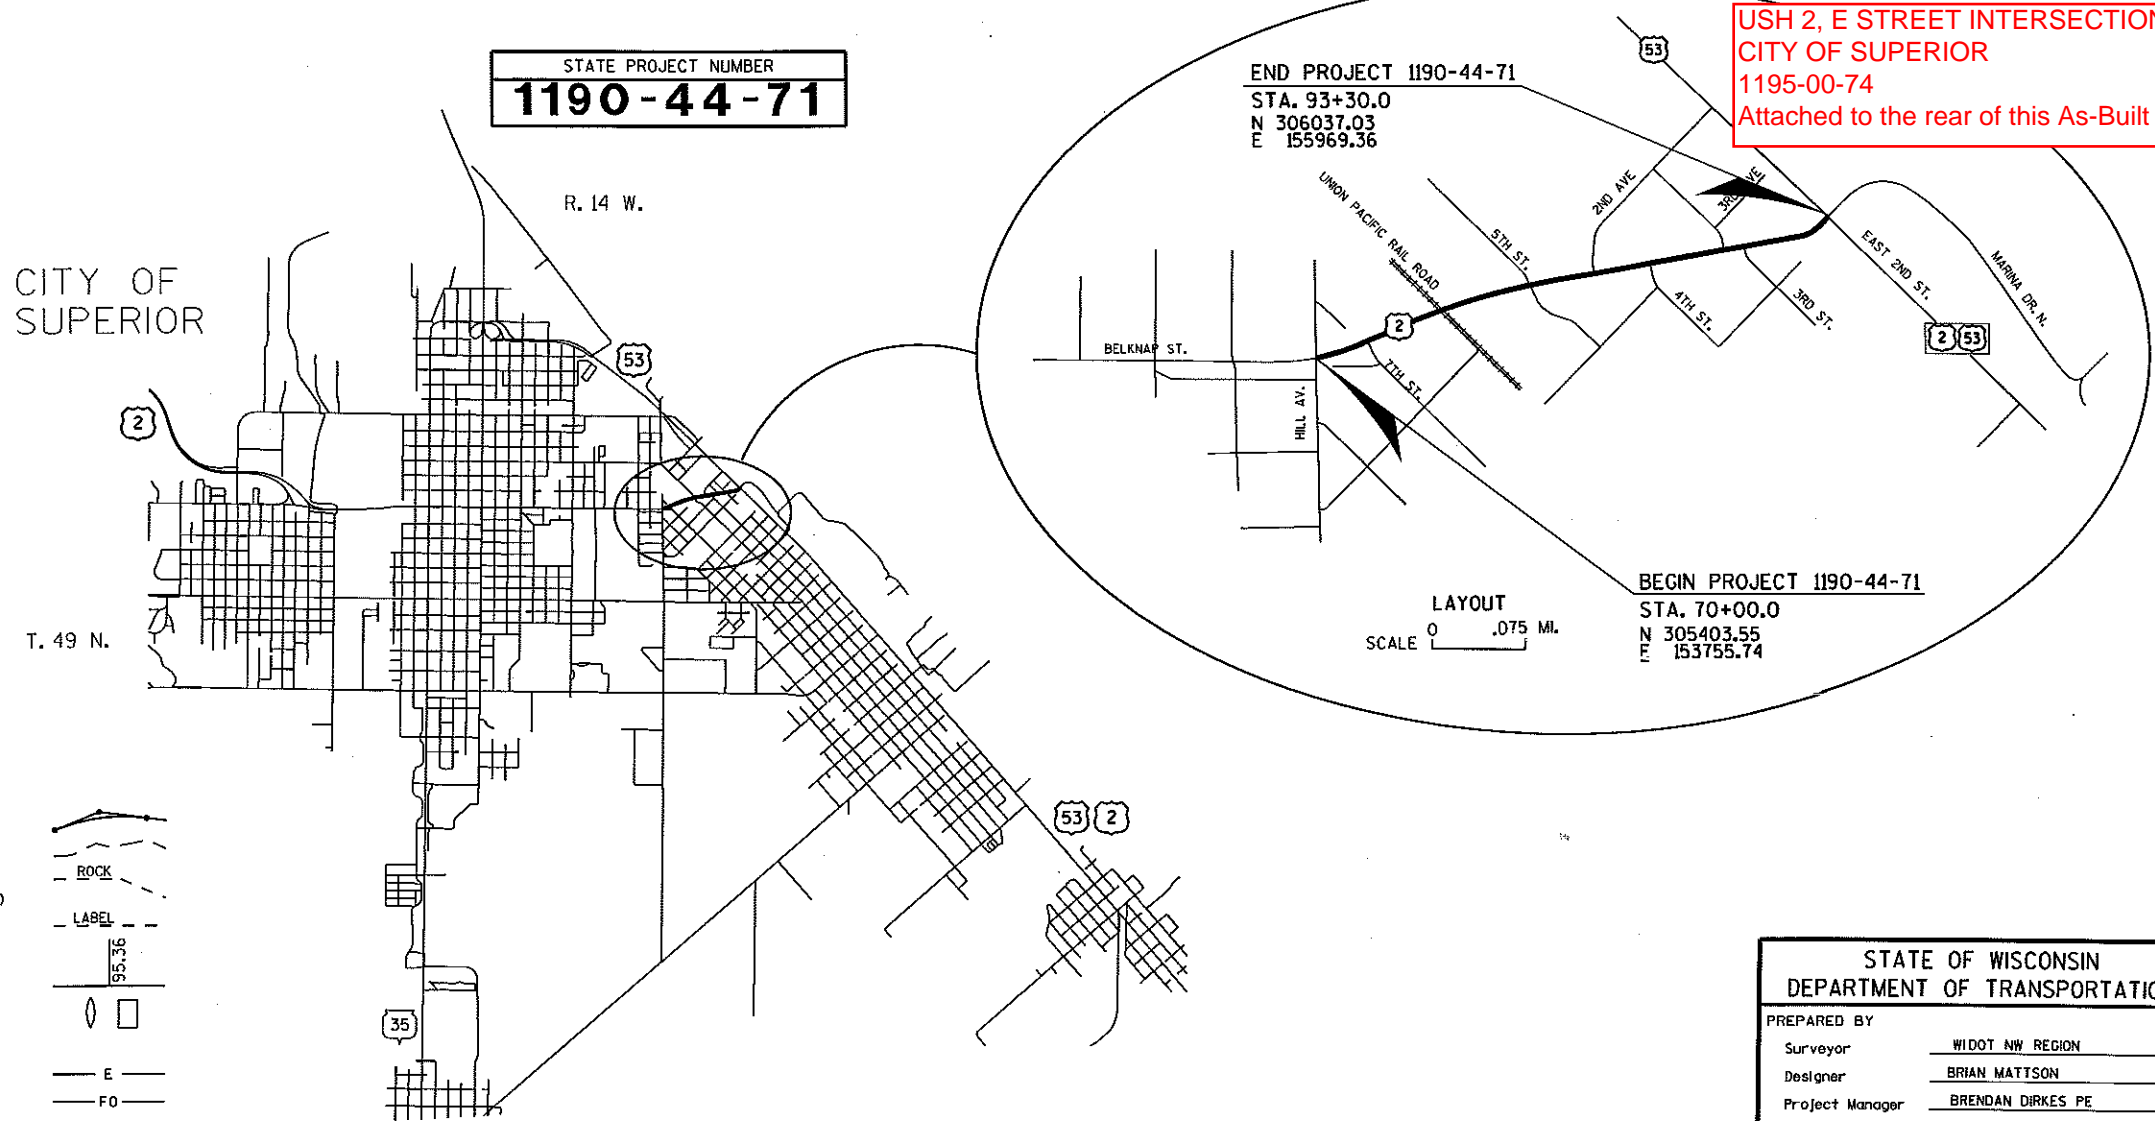

LAYOUT SCALE 0 .45 MI.

TOTAL NET LENGTH OF CENTERLINE = ML

"Coordinates on this plan are referenced to the Wisconsin County Coordinate System (WCCS), DOUGLAS County."

STATE PROJECT	FEDERAL PROJECT	
	PROJECT	CONTRACT
1190-44-71		

## AS-BUILT PLAN

SUPERVISOR : David Ostrowski  
 PROJECT MANAGER: Phil Keppers  
 PROJECT LEADER: Brian Mattson  
 CONTRACTOR: Chippewa Concrete Service  
 WORK STARTED: 8-2-11  
 WORK COMPLETED: 10-28-11

USH 2, E STREET INTERSECTION  
 CITY OF SUPERIOR  
 1195-00-74  
 Attached to the rear of this As-Built

STATE OF WISCONSIN DEPARTMENT OF TRANSPORTATION	
PREPARED BY	
Surveyor	WIDOT NW REGION
Designer	BRIAN MATTSON
Project Manager	BRENDAN DIRKES PE
Regional Examiner	DONALD DAHLE
Regional Supervisor	ROBERT ANDERSON PE
C.O. Examiner	JANE ENGLEBRETSSEN
APPROVED FOR THE DEPARTMENT	
DATE: 11/1/10	<i>David Ostrowski</i> (Signature)

E

**SURVEY POINTS**

CP459  
N305660.06  
E154637.44  
Z626.960

MON2015  
SURVEY NAIL E 4TH ST / F STREET  
306463.59  
154410.06  
Z620.488

MON2016  
SPIKE E 4TH ST / 7TH AVE  
N304678.16  
E156247.35  
Z628.154

MON2017  
BRASS CAP 9TH ST / 3RD AVE  
N304420.99  
E153955.87  
Z631.276

MON2022  
SURVEY NAIL WINTER ST / HILL AVE  
N308023.40  
E153695.32  
616.428

CP1502  
N300885.92  
E158969.85  
Z692.624

CP1694  
N309179.71  
E155183.92  
Z606.256

CP1512  
N310013.34  
154359.50  
Z604.651

CP100  
N305556.17  
E154870.11  
Z719.781

**CITY OF SUPERIOR CONTACT**


TODD JANIGO  
CITY OF SUPERIOR STREET DEPARTMENT  
7417 HILL AVENUE  
SUPERIOR, WI 54880  
PHONE: (715) 394-2575

**DOUGLAS COUNTY CONTACT**

PAUL HALVERSON  
DOUGLAS COUNTY HIGHWAY DEPARTMENT  
7417 COUNTY ROAD E  
PO BOX 174  
HAWTHORNE, WI 54842  
PHONE: (715) 374-2575

**DNR CONTACT**

AMY CRONK  
WDNR - NORTHWEST DISTRICT  
HEADQUARTERS  
810 WEST MAPLE STREET  
SPOONER, WI 54801  
PHONE: (715) 635-4229

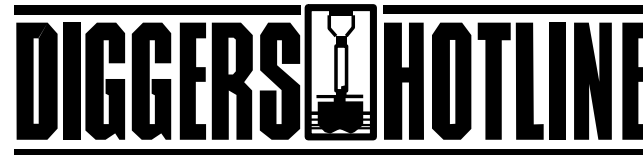

**Toll Free (800) 242-8511**  
**Milwaukee Area (414) 259-1181**  
**Hearing Impaired TDD (800) 542-2289**  
**www.DiggersHotline.com**

**UTILITIES**

CENTURYLINK  
135 N 21ST STREET.  
SUPERIOR, WI 54880  
ATTN: STEVE HAUGE  
PHONE: (715) 566-3879

SUPERIOR WATER LIGHT AND POWER  
2915 HILL AVENUE  
SUPERIOR, WI 54880  
ATTN: AARON ANDERSON  
PHONE: (715) 395-6317

CITY OF SUPERIOR SEWER DEPARTMENT  
(SANITARY AND STORM SEWER)  
51 E 1ST STREET.  
SUPERIOR, WI 54880  
ATTN: CHRIS CARLSON  
PHONE: (715) 394-0392

CHARTER COMMUNICATIONS  
640 GARFIELD AVENUE  
DULUTH, MN 55802  
ATTN: JOHN QUADE  
PHONE: (218) 529-8042

**GENERAL NOTES**

THE STREET LIGHTING ALONG BELKNAP HAS LIGHT BASES VARYING FROM 7" TO 24" BEHIND THE CURB HEAD. SPECIAL PAVING METHODS MAY BE NEEDED AT THESE LOCATIONS.

THE LOCATIONS OF EXISTING AND PROPOSED UTILITY FACILITIES AS SHOWN ON THE PLAN ARE APPROXIMATE. THERE MAY BE OTHER UTILITY FACILITIES WITHIN THE PROJECT AREA THAT ARE NOT SHOWN.

CONTROL POINTS ARE REFERENCED TO THE WISCONSIN COUNTY COORDINATE SYSTEM DOUGLAS COUNTY. BENCHMARK ELEVATIONS ARE REFERENCED TO NGVD 29.

ALL DISTURBED AREAS WITHIN THE RIGHT-OF-WAY, EXCEPT THE IMPERVIOUS AREAS, GRAVEL SURFACES, AND SODDED AREAS SHALL BE FERTILIZED, SEEDED AND EMATED.

NO TREE SHALL BE REMOVED WITHOUT THE APPROVAL OF THE ENGINEER.

THE EXACT LOCATION OF DRIVEWAYS WILL BE DETERMINED BY THE ENGINEER IN THE FIELD.

INLET ELEVATIONS SHOWN ON THE STORM SEWER SHEETS ARE DEPRESSED 0.1 FT FROM GUTTER FLOW LINE ELEVATIONS.


CURB AND GUTTER RADII ARE SHOWN TO THE FLAG OF THE CURB.

**DOT CONTACTS**

TRAFFIC: MORRIS LUKE 715-392-7886  
RAILS: ANNA DAVEY 715-392-7960  
UTILITIES: SUSAN HELLER 715-392-7933  
DESIGN: BRIAN MATTSON 715-395-3035  
1701 NORTH FOURTH STREET  
SUPERIOR, WI 54880

**RAIL ROAD CONTACT**


UNION PACIFIC RAIL ROAD  
ROOM 103  
301 WEST LAKE STREET  
NORTHLAKE, IL 60164  
ATTN: RICHARD ELLISON  
PHONE: (708) 649-5214

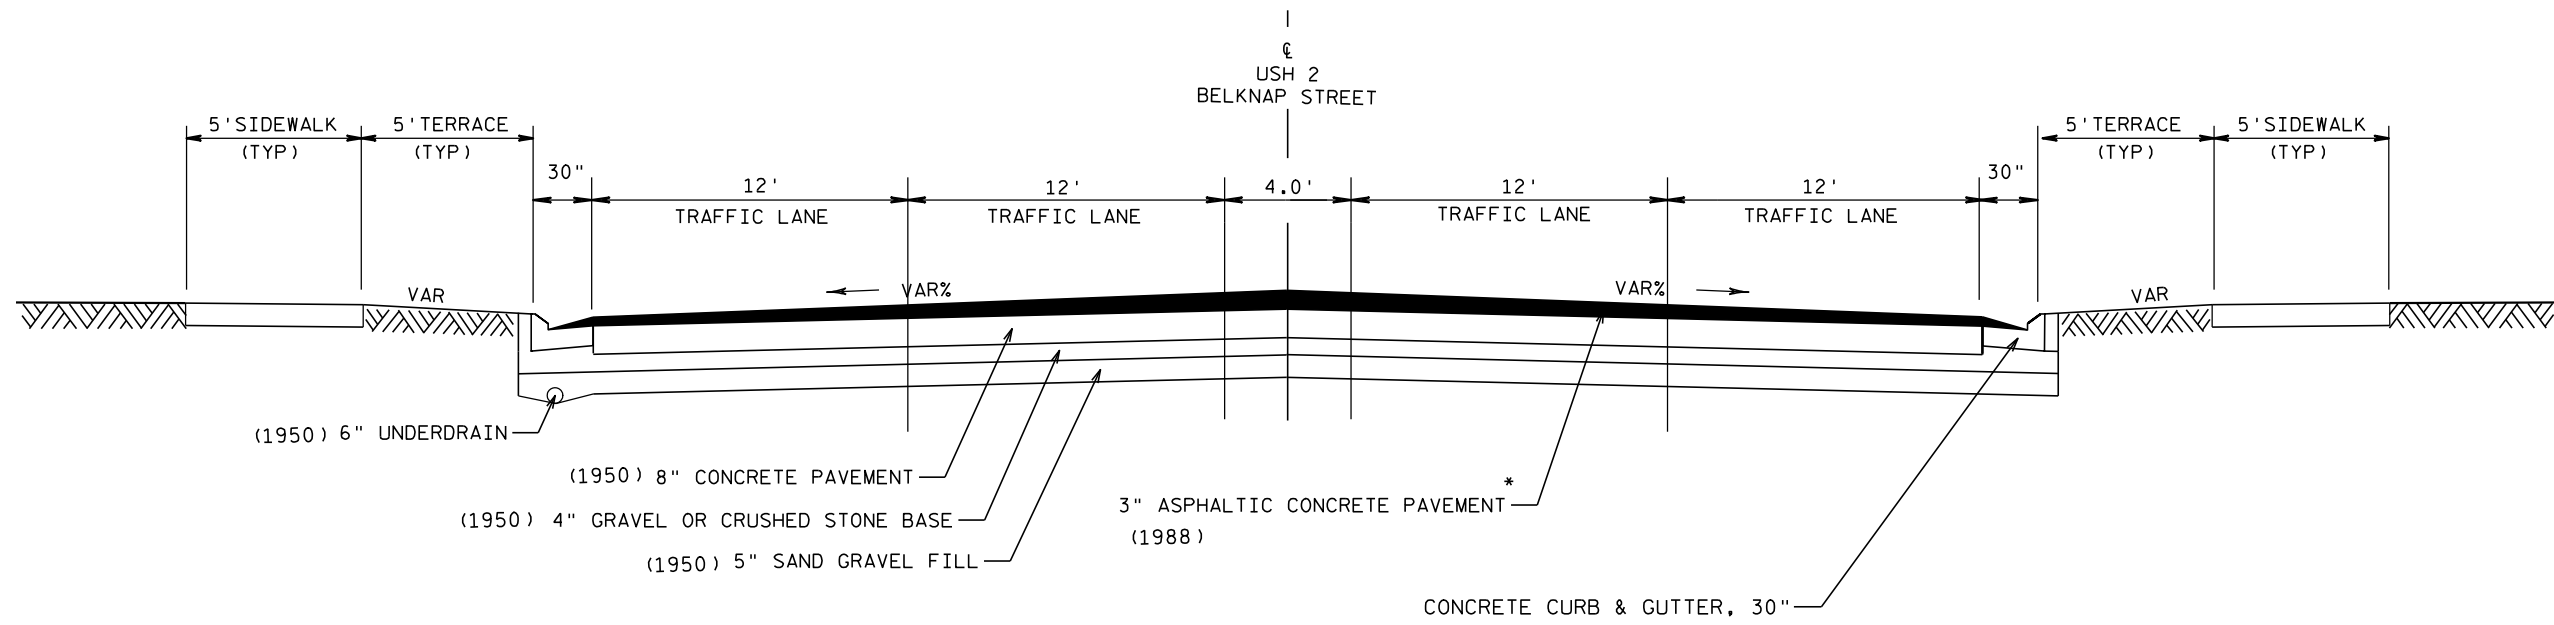

**TYPICAL EXISTING SECTION**

STATIONS 70+00 - 93+00


\* STATION 71+50 - 91+50

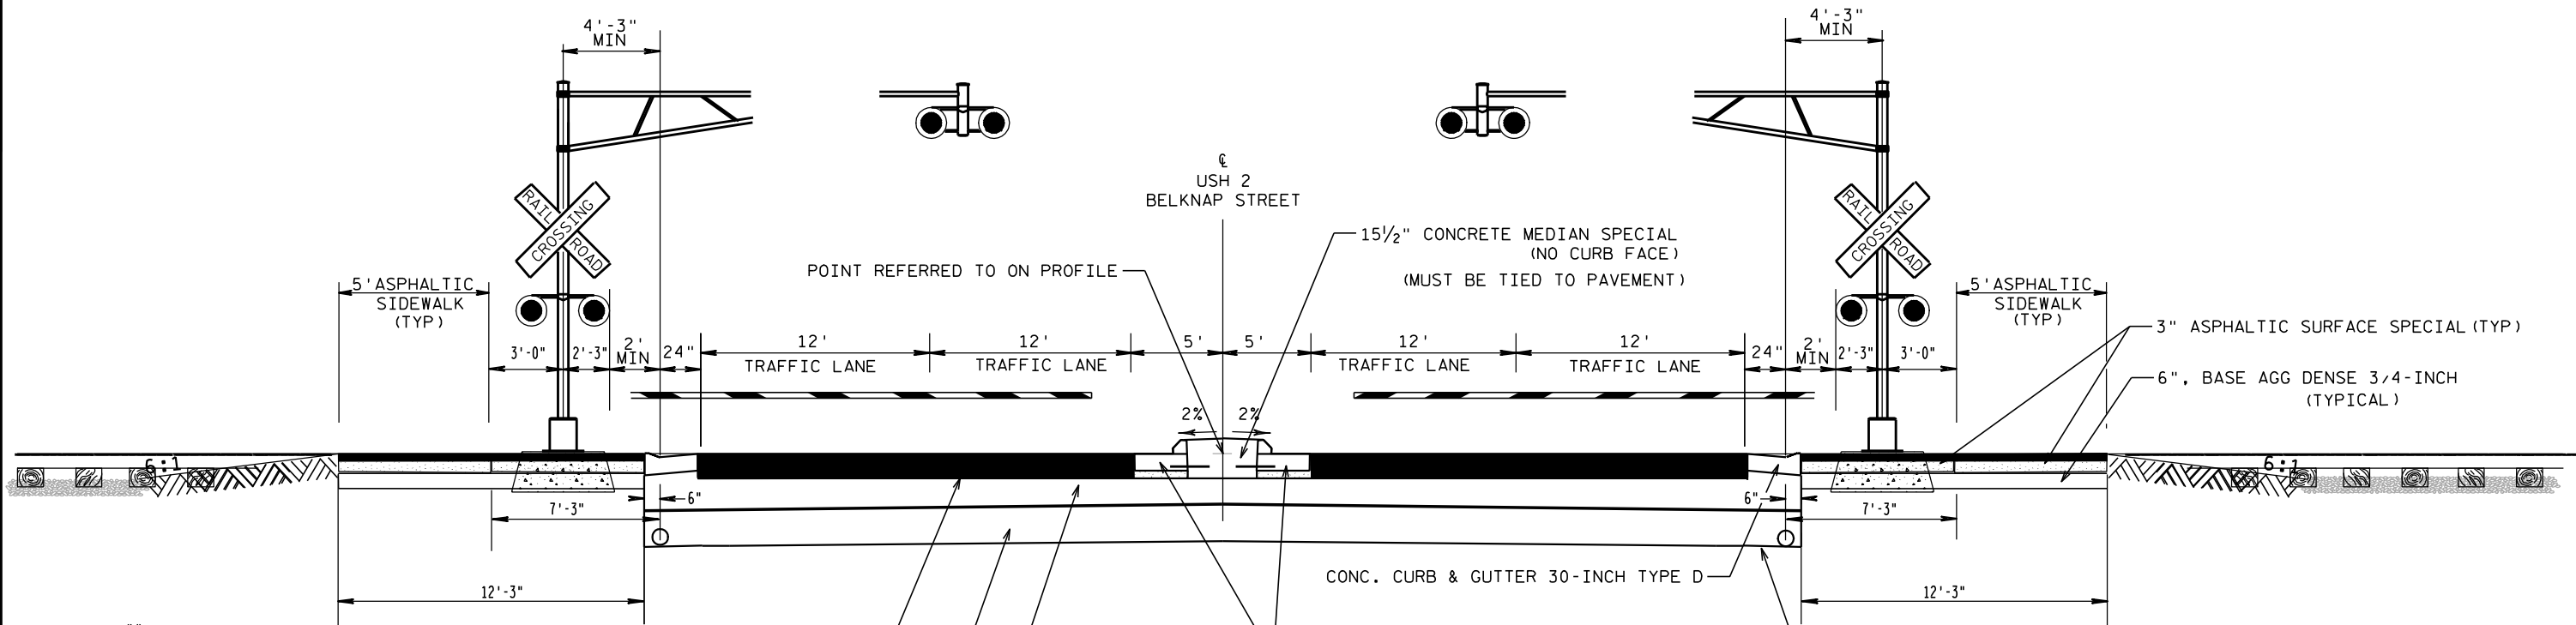

**FINISHED TYPICAL SECTION**

STATIONS 75+24.4 - 75+86.5

\*\* NOTE: TAPER 18" TO 0" AT A 10:1 SLOPE APPROACHING RR CROSSING. SIMILARLY, TAPER BACK TO 18" DEPTH AFTER RAIL CROSSING.

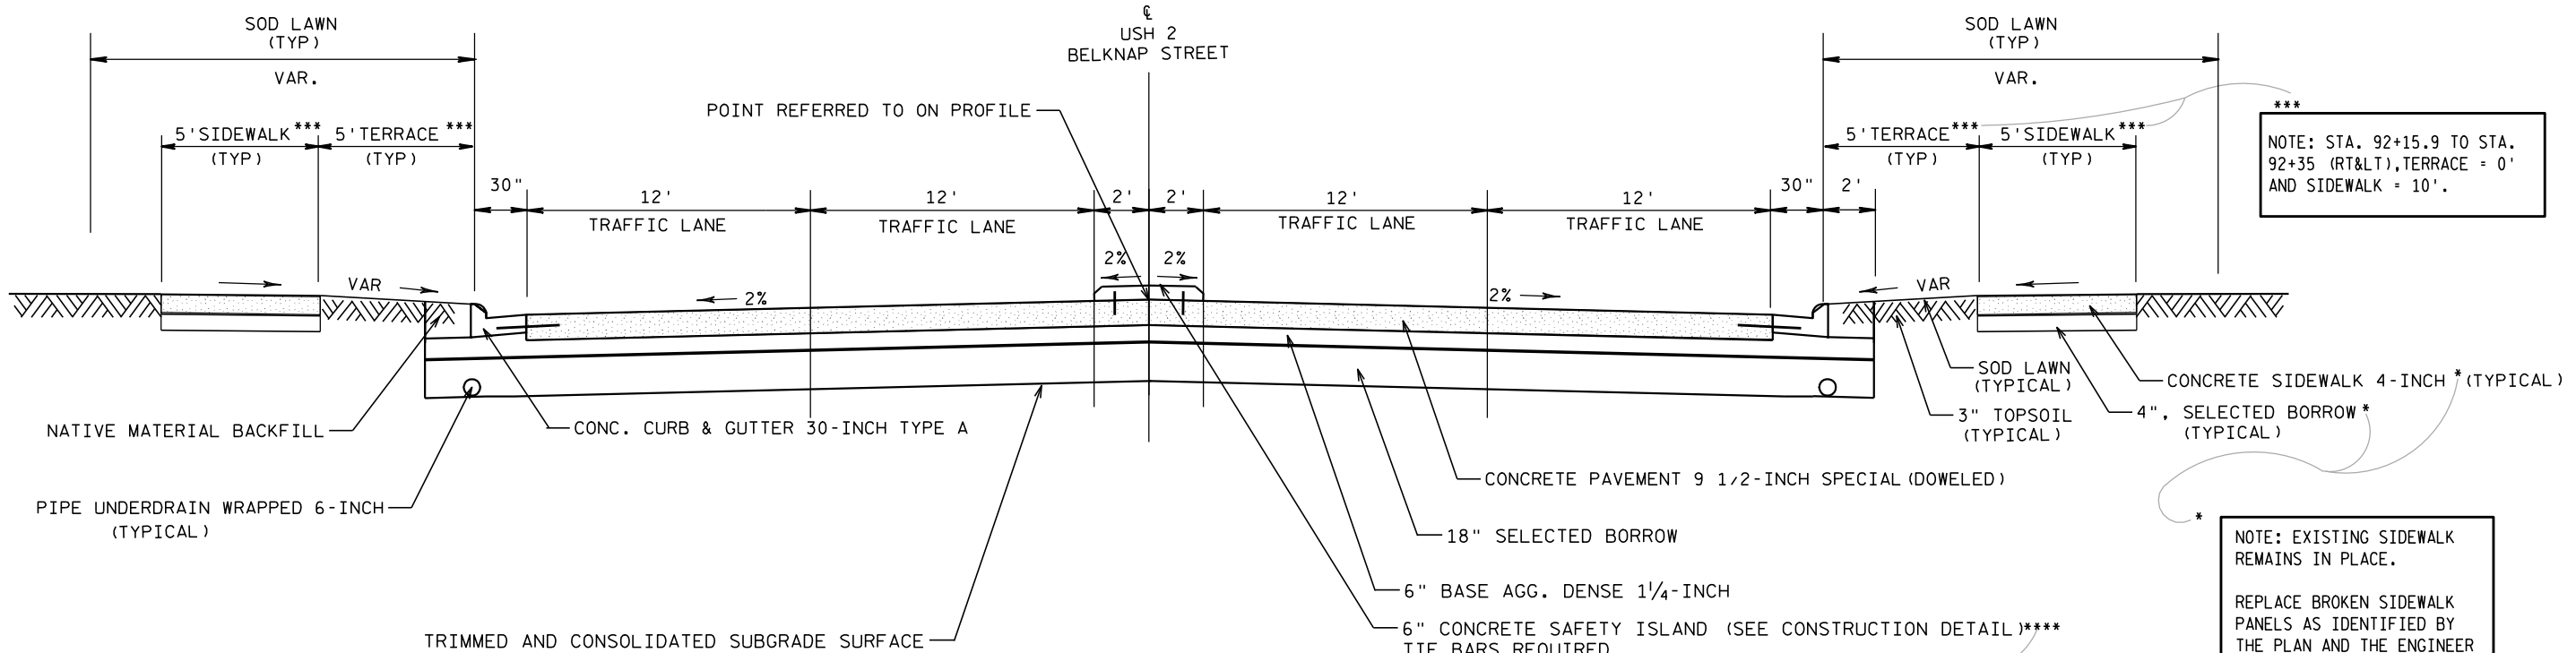



**FINISHED TYPICAL SECTION**


STATIONS 78+70 - 91+38.1  
92+15.9 - 92+38

\*\*\* NOTE: STA. 92+15.9 TO STA. 92+35 (RT&LT), TERRACE = 0' AND SIDEWALK = 10'.

\* NOTE: EXISTING SIDEWALK REMAINS IN PLACE. REPLACE BROKEN SIDEWALK PANELS AS IDENTIFIED BY THE PLAN AND THE ENGINEER IN THE FIELD.

\*\*\*\* NOTE: CONSTRUCT SAFETY ISLAND STA 91+07 - 92+12 ONLY.

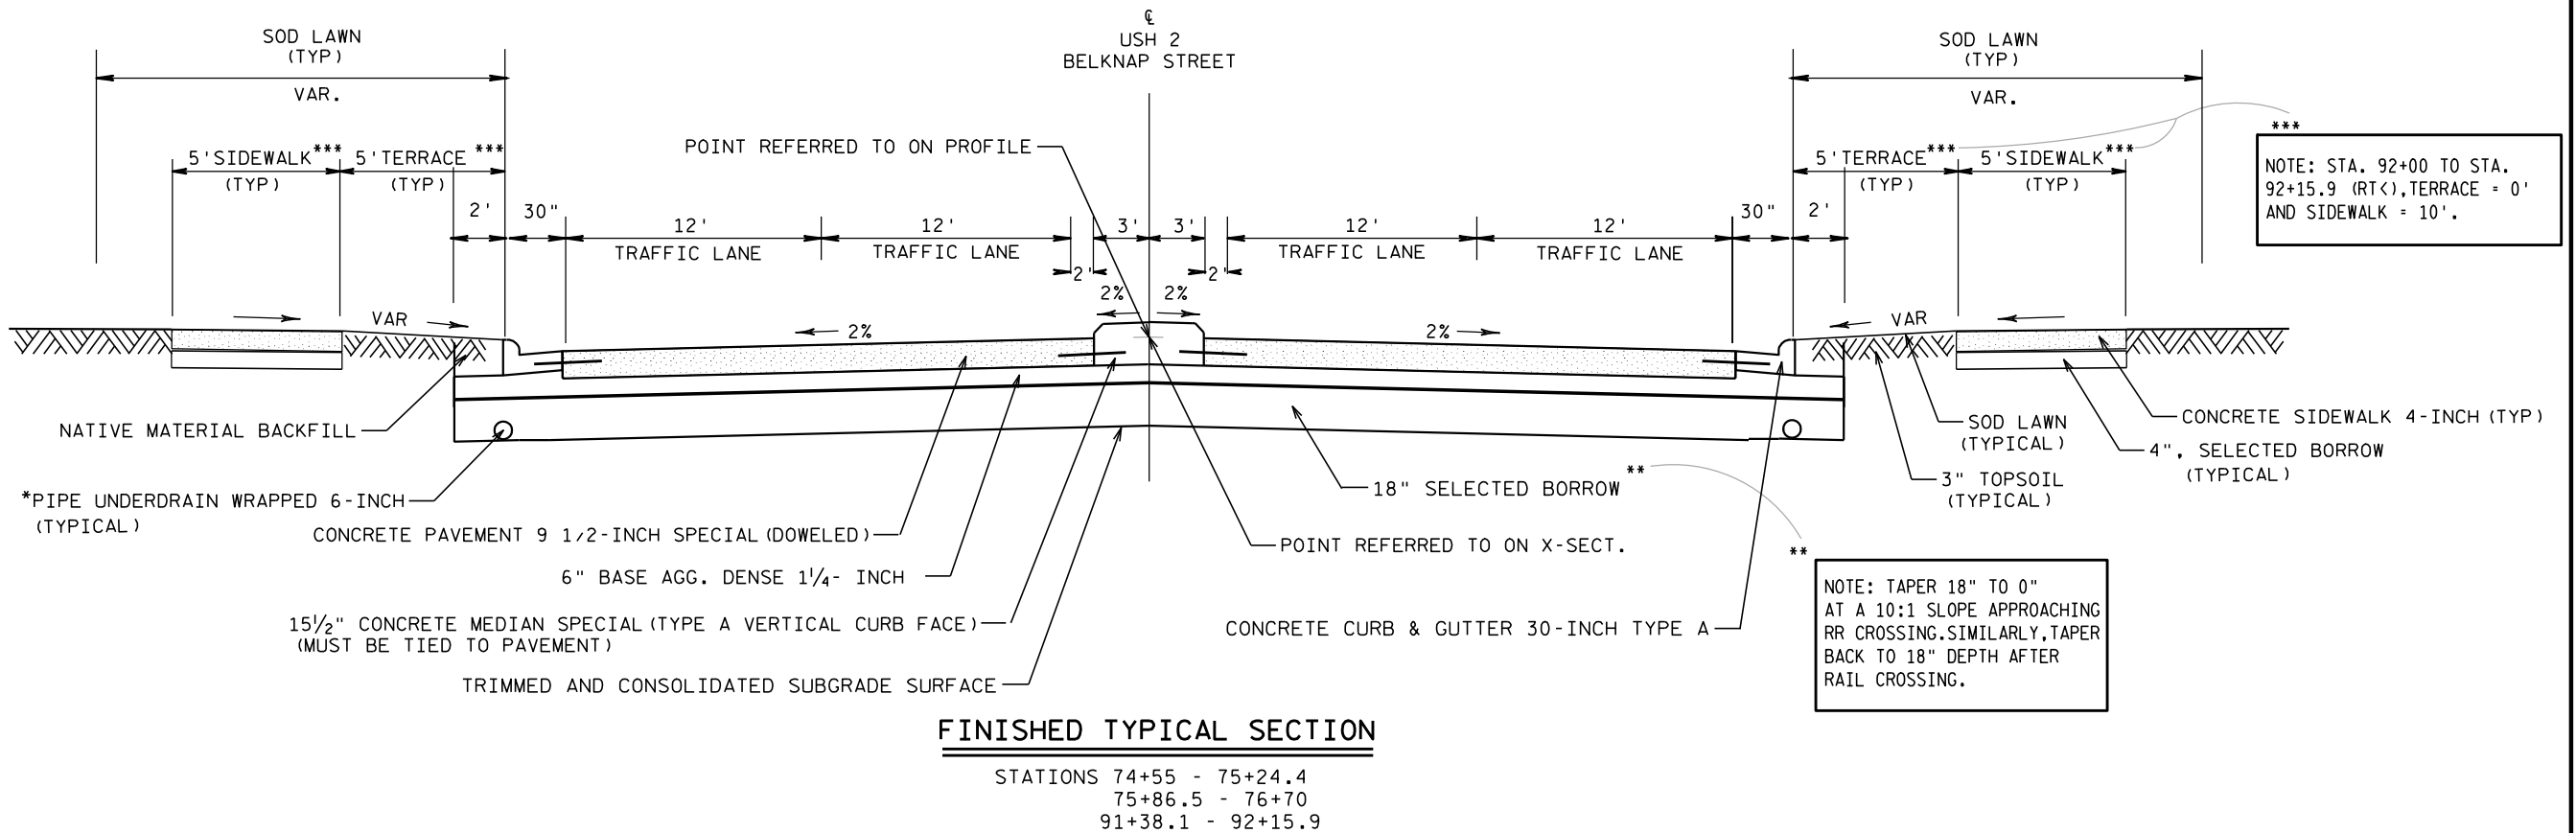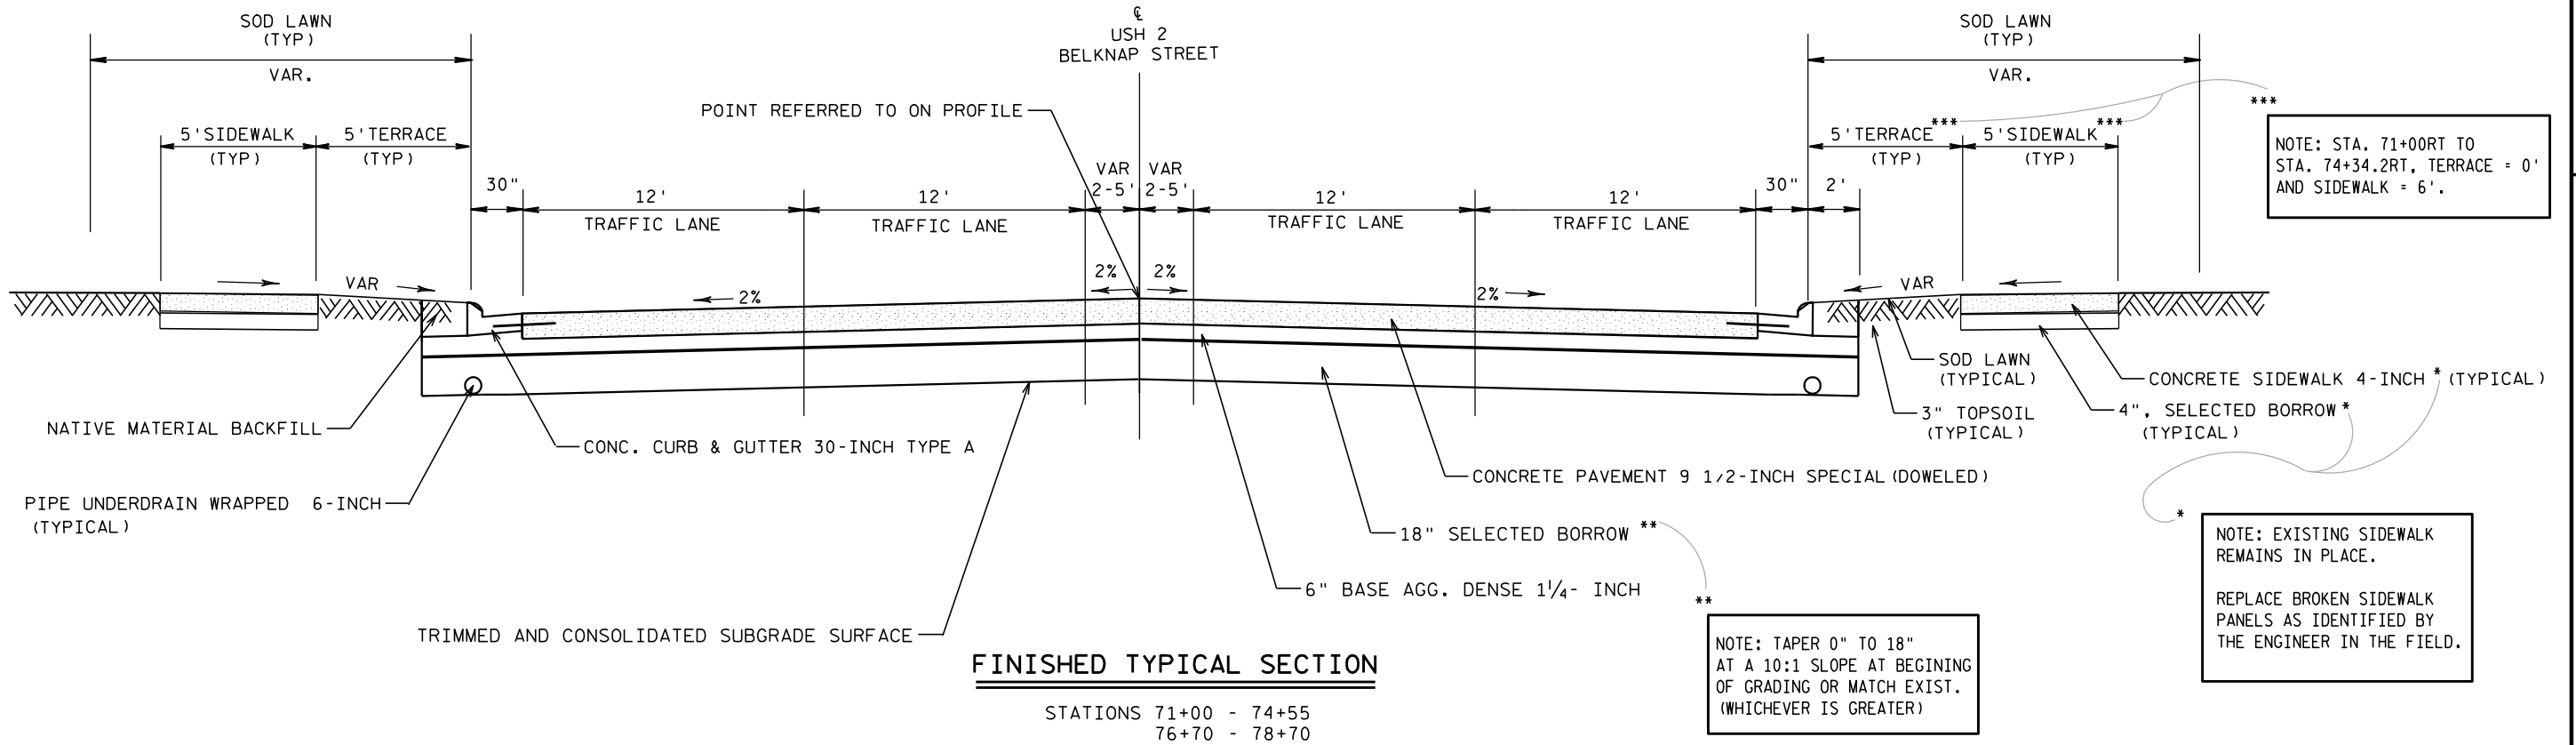

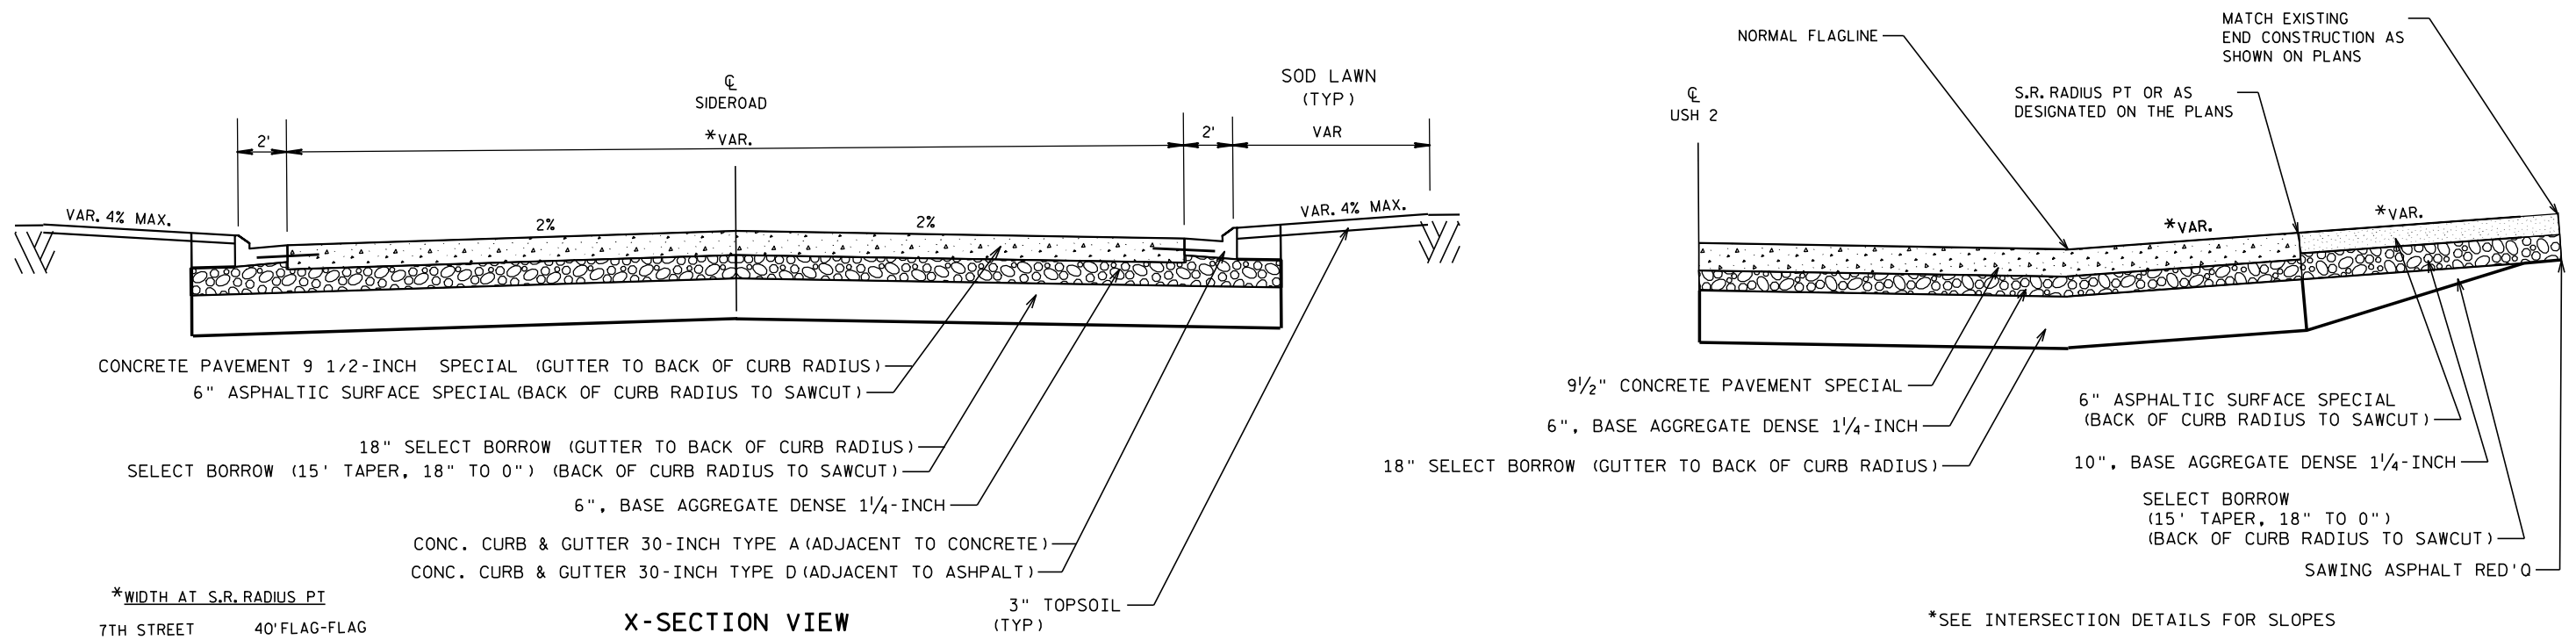


CONCRETE PAVEMENT 9 1/2-INCH SPECIAL (GUTTER TO BACK OF CURB RADIUS)  
 6" ASPHALTIC SURFACE SPECIAL (BACK OF CURB RADIUS TO SAWCUT)  
 18" SELECT BORROW (GUTTER TO BACK OF CURB RADIUS)  
 SELECT BORROW (15' TAPER, 18" TO 0") (BACK OF CURB RADIUS TO SAWCUT)  
 6", BASE AGGREGATE DENSE 1 1/4-INCH  
 CONC. CURB & GUTTER 30-INCH TYPE A (ADJACENT TO CONCRETE)  
 CONC. CURB & GUTTER 30-INCH TYPE D (ADJACENT TO ASPHALT)

9 1/2" CONCRETE PAVEMENT SPECIAL  
 6", BASE AGGREGATE DENSE 1 1/4-INCH  
 18" SELECT BORROW (GUTTER TO BACK OF CURB RADIUS)  
 6" ASPHALTIC SURFACE SPECIAL (BACK OF CURB RADIUS TO SAWCUT)  
 10", BASE AGGREGATE DENSE 1 1/4-INCH  
 SELECT BORROW (15' TAPER, 18" TO 0") (BACK OF CURB RADIUS TO SAWCUT)  
 SAWING ASPHALT RED 'O


\*WIDTH AT S.R. RADIUS PT

7TH STREET	40' FLAG-FLAG
5TH STREET LT	28' FLAG-FLAG
5TH STREET RT	40' FLAG-FLAG
2ND AVENUE	32' FLAG-FLAG
4TH STREET	32' FLAG-FLAG
3RD STREET LT	32' FLAG-FLAG
3RD STREET RT	20' FLAG-FLAG


TYPICAL SIDE ROAD FINISHED SECTION

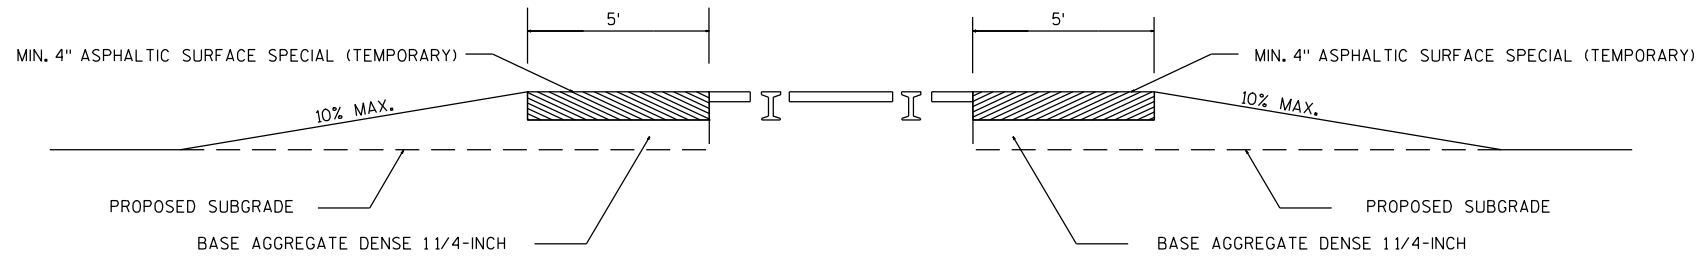

**TEMPORARY RAILROAD CROSSING**

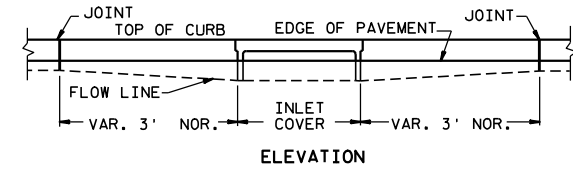


**ELEVATION**



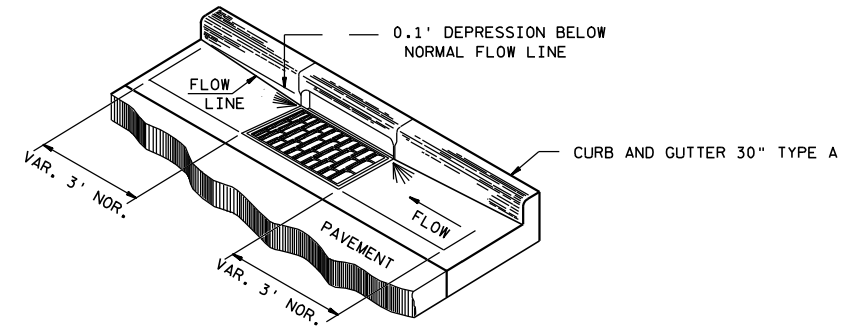


**INLETS AT CURB AND GUTTER**


NOTE: ISLAND TIED TO CONCRETE  
 BASE WITH NO. 5 X 10" EPOXY COATED  
 REINF. BARS 6" INTO BASE & 24" C-C

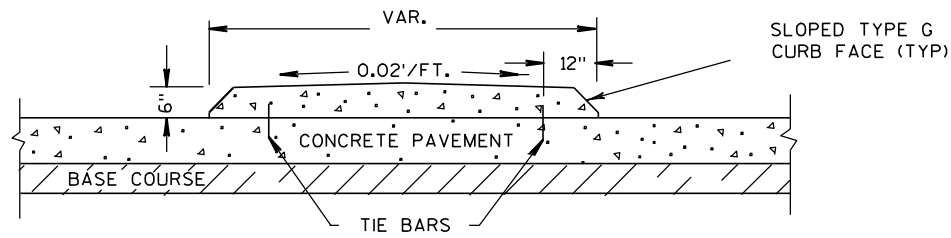

**CONCRETE SAFETY ISLAND**

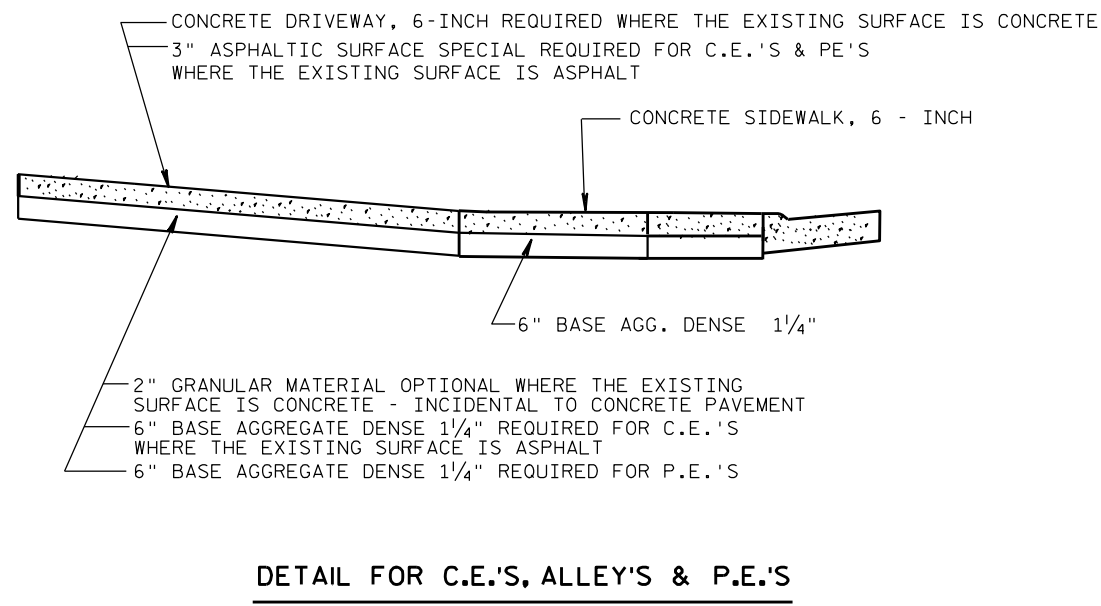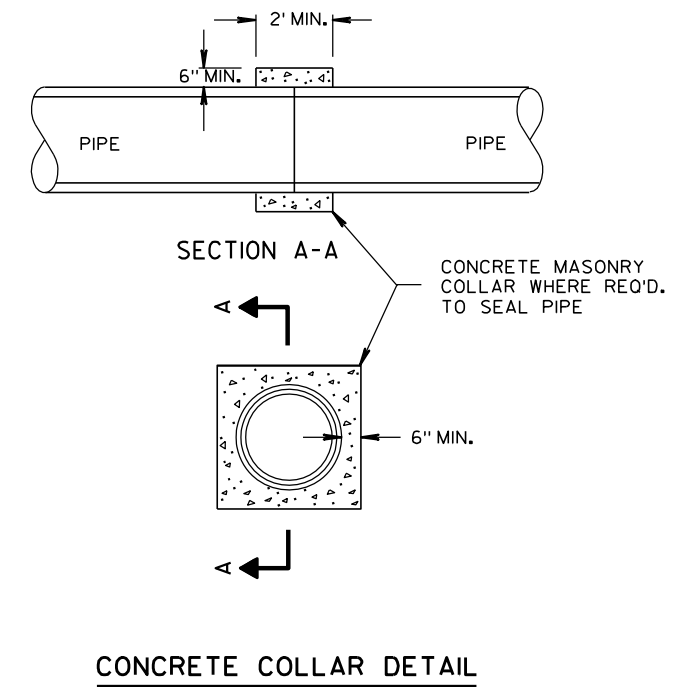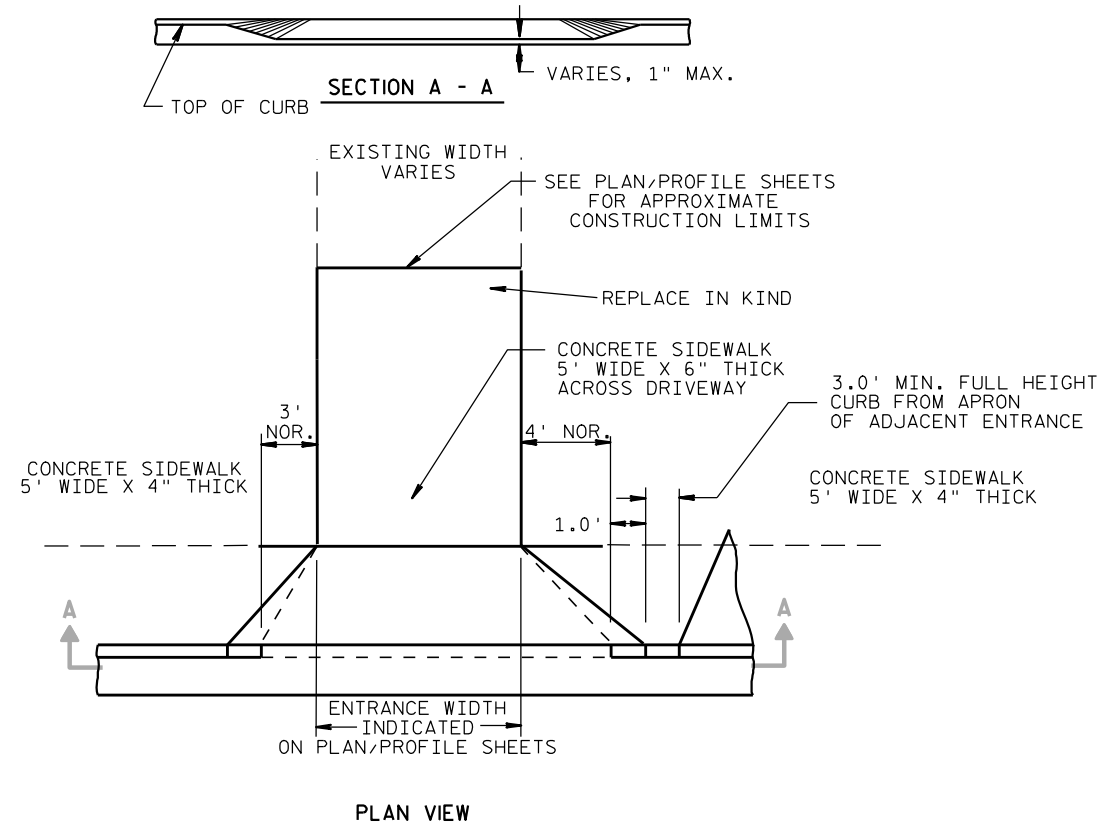




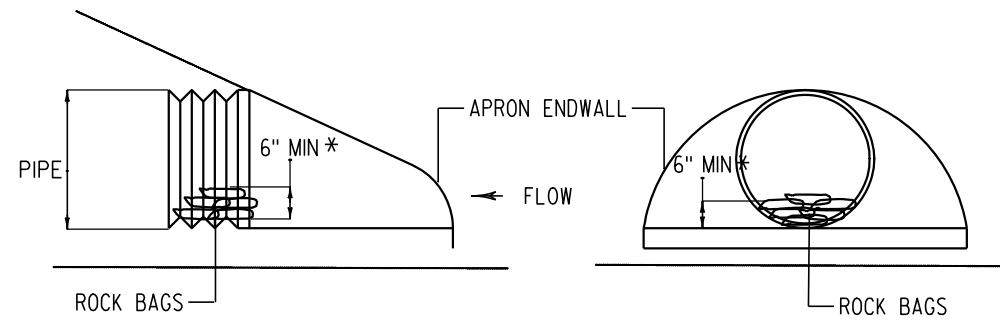


\* OR AS DIRECTED BY THE ENGINEER

**CULVERT PIPE CHECK**

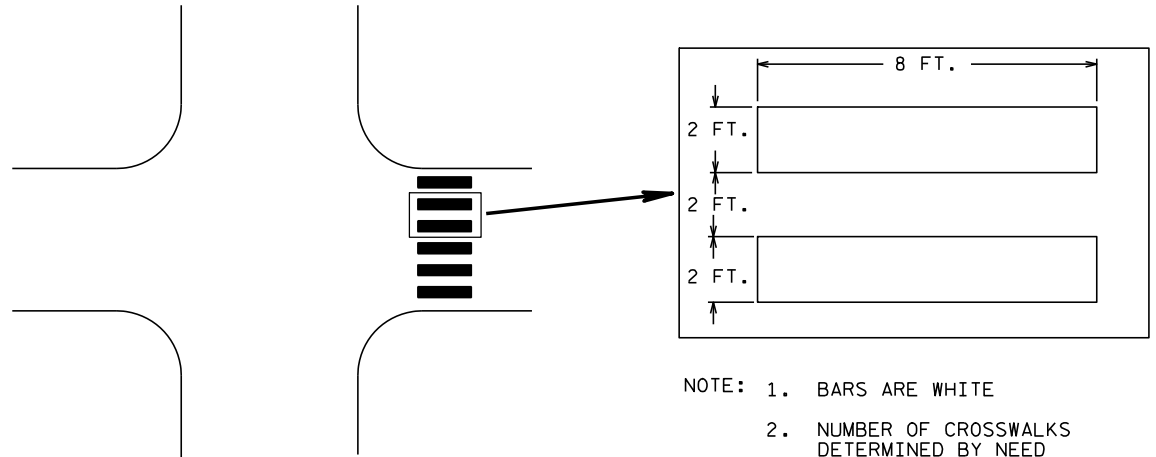

- NOTE: 1. BARS ARE WHITE  
 2. NUMBER OF CROSSWALKS DETERMINED BY NEED  
 3. NUMBER OF BARS IS DETERMINED BY HIGHWAY WIDTH

**DETAIL FOR PAVEMENT MARKING, CROSSWALK, EPOXY SPECIAL**

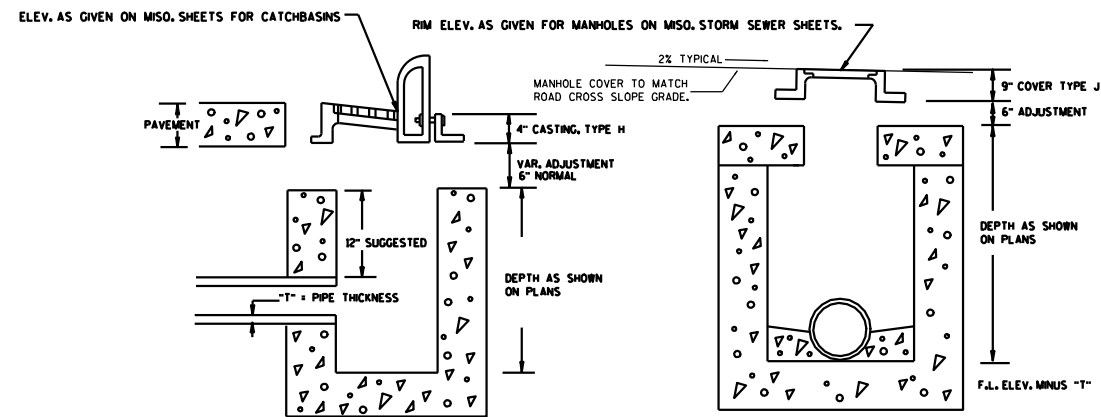


**CATCH BASIN DETAIL**

**MANHOLE DETAIL**


PIPE I.D.	"T"
12"	0.17'
18"	0.21'
21"	0.23'

2

2

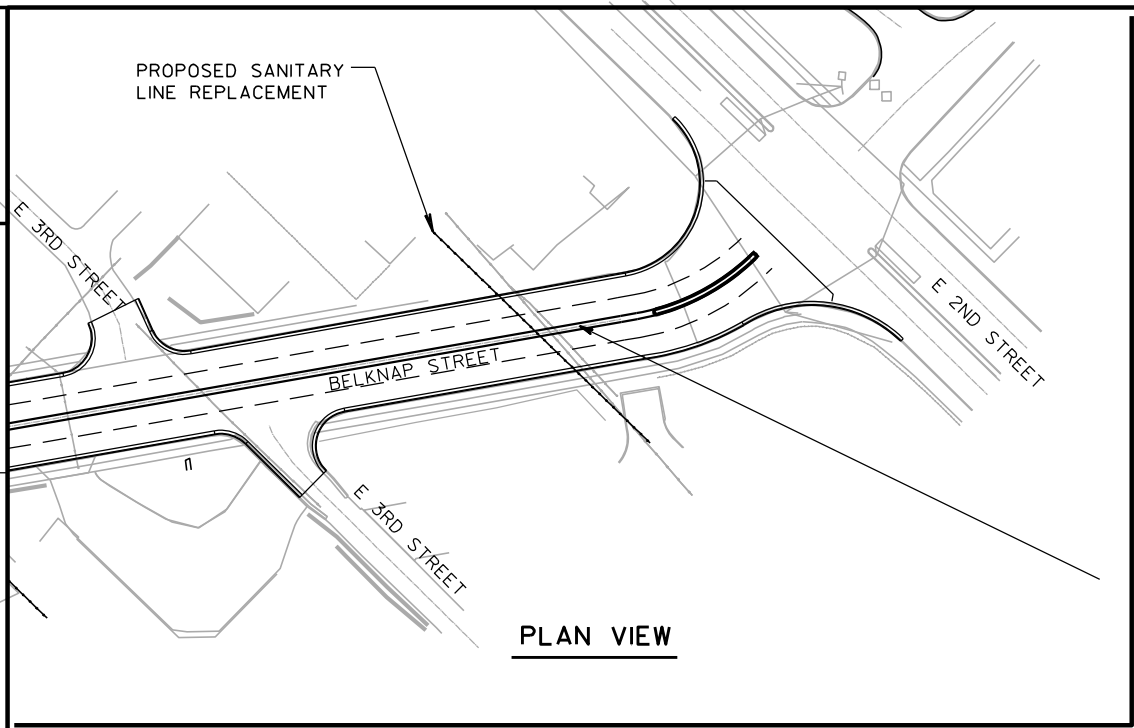


FINISHED ROADWAY  $\phi$  PROFILE

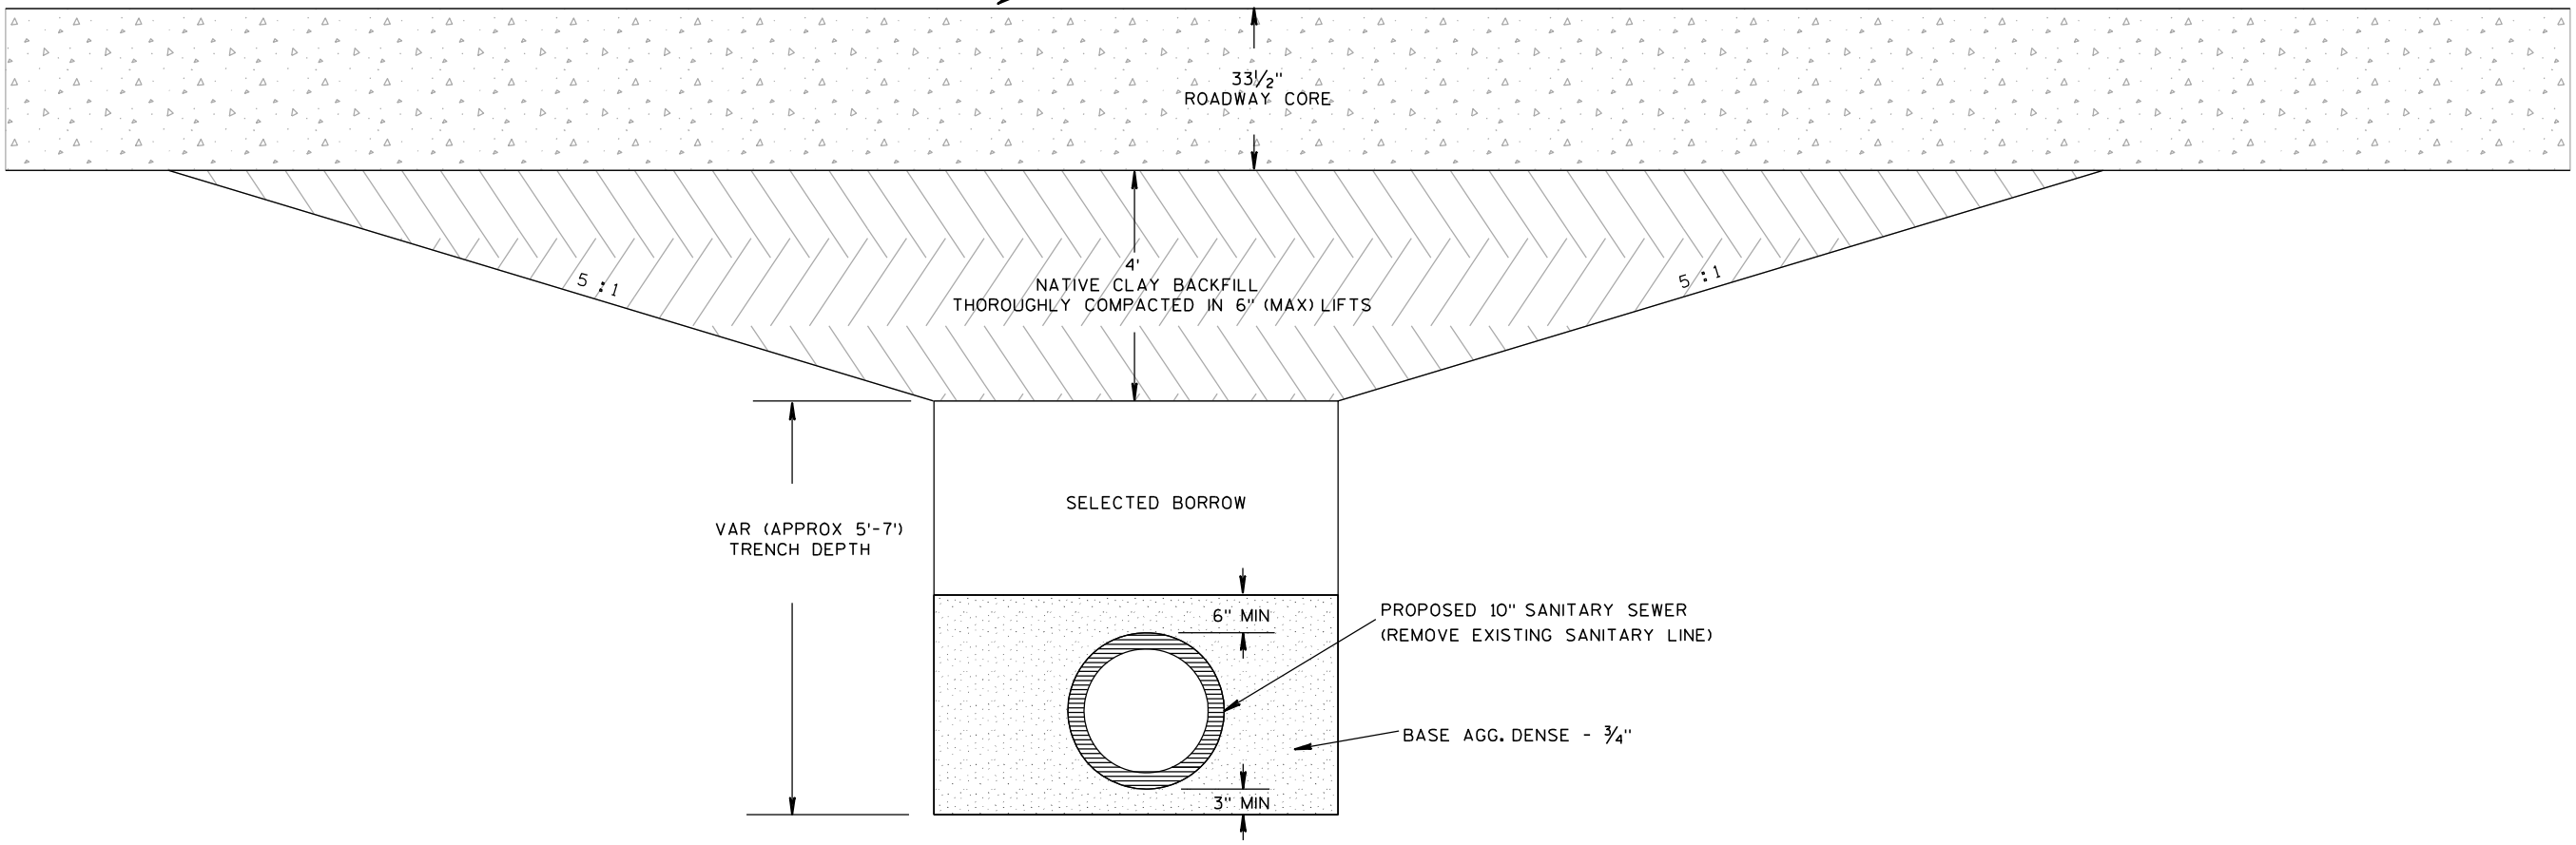


**SANITARY SEWER REPLACEMENT  
CROSS SECTIONAL VIEW**

STATION 90+60

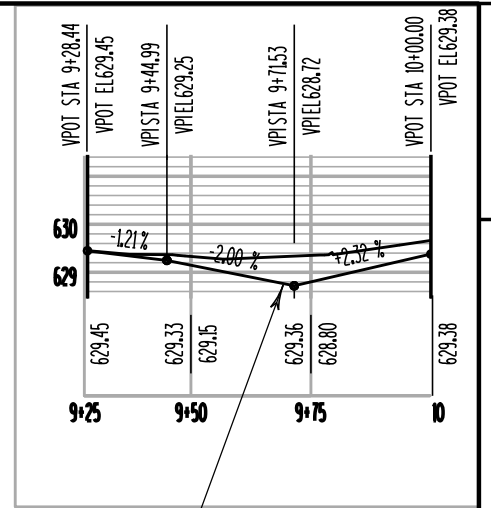


SR3 FINISHED PROFILE

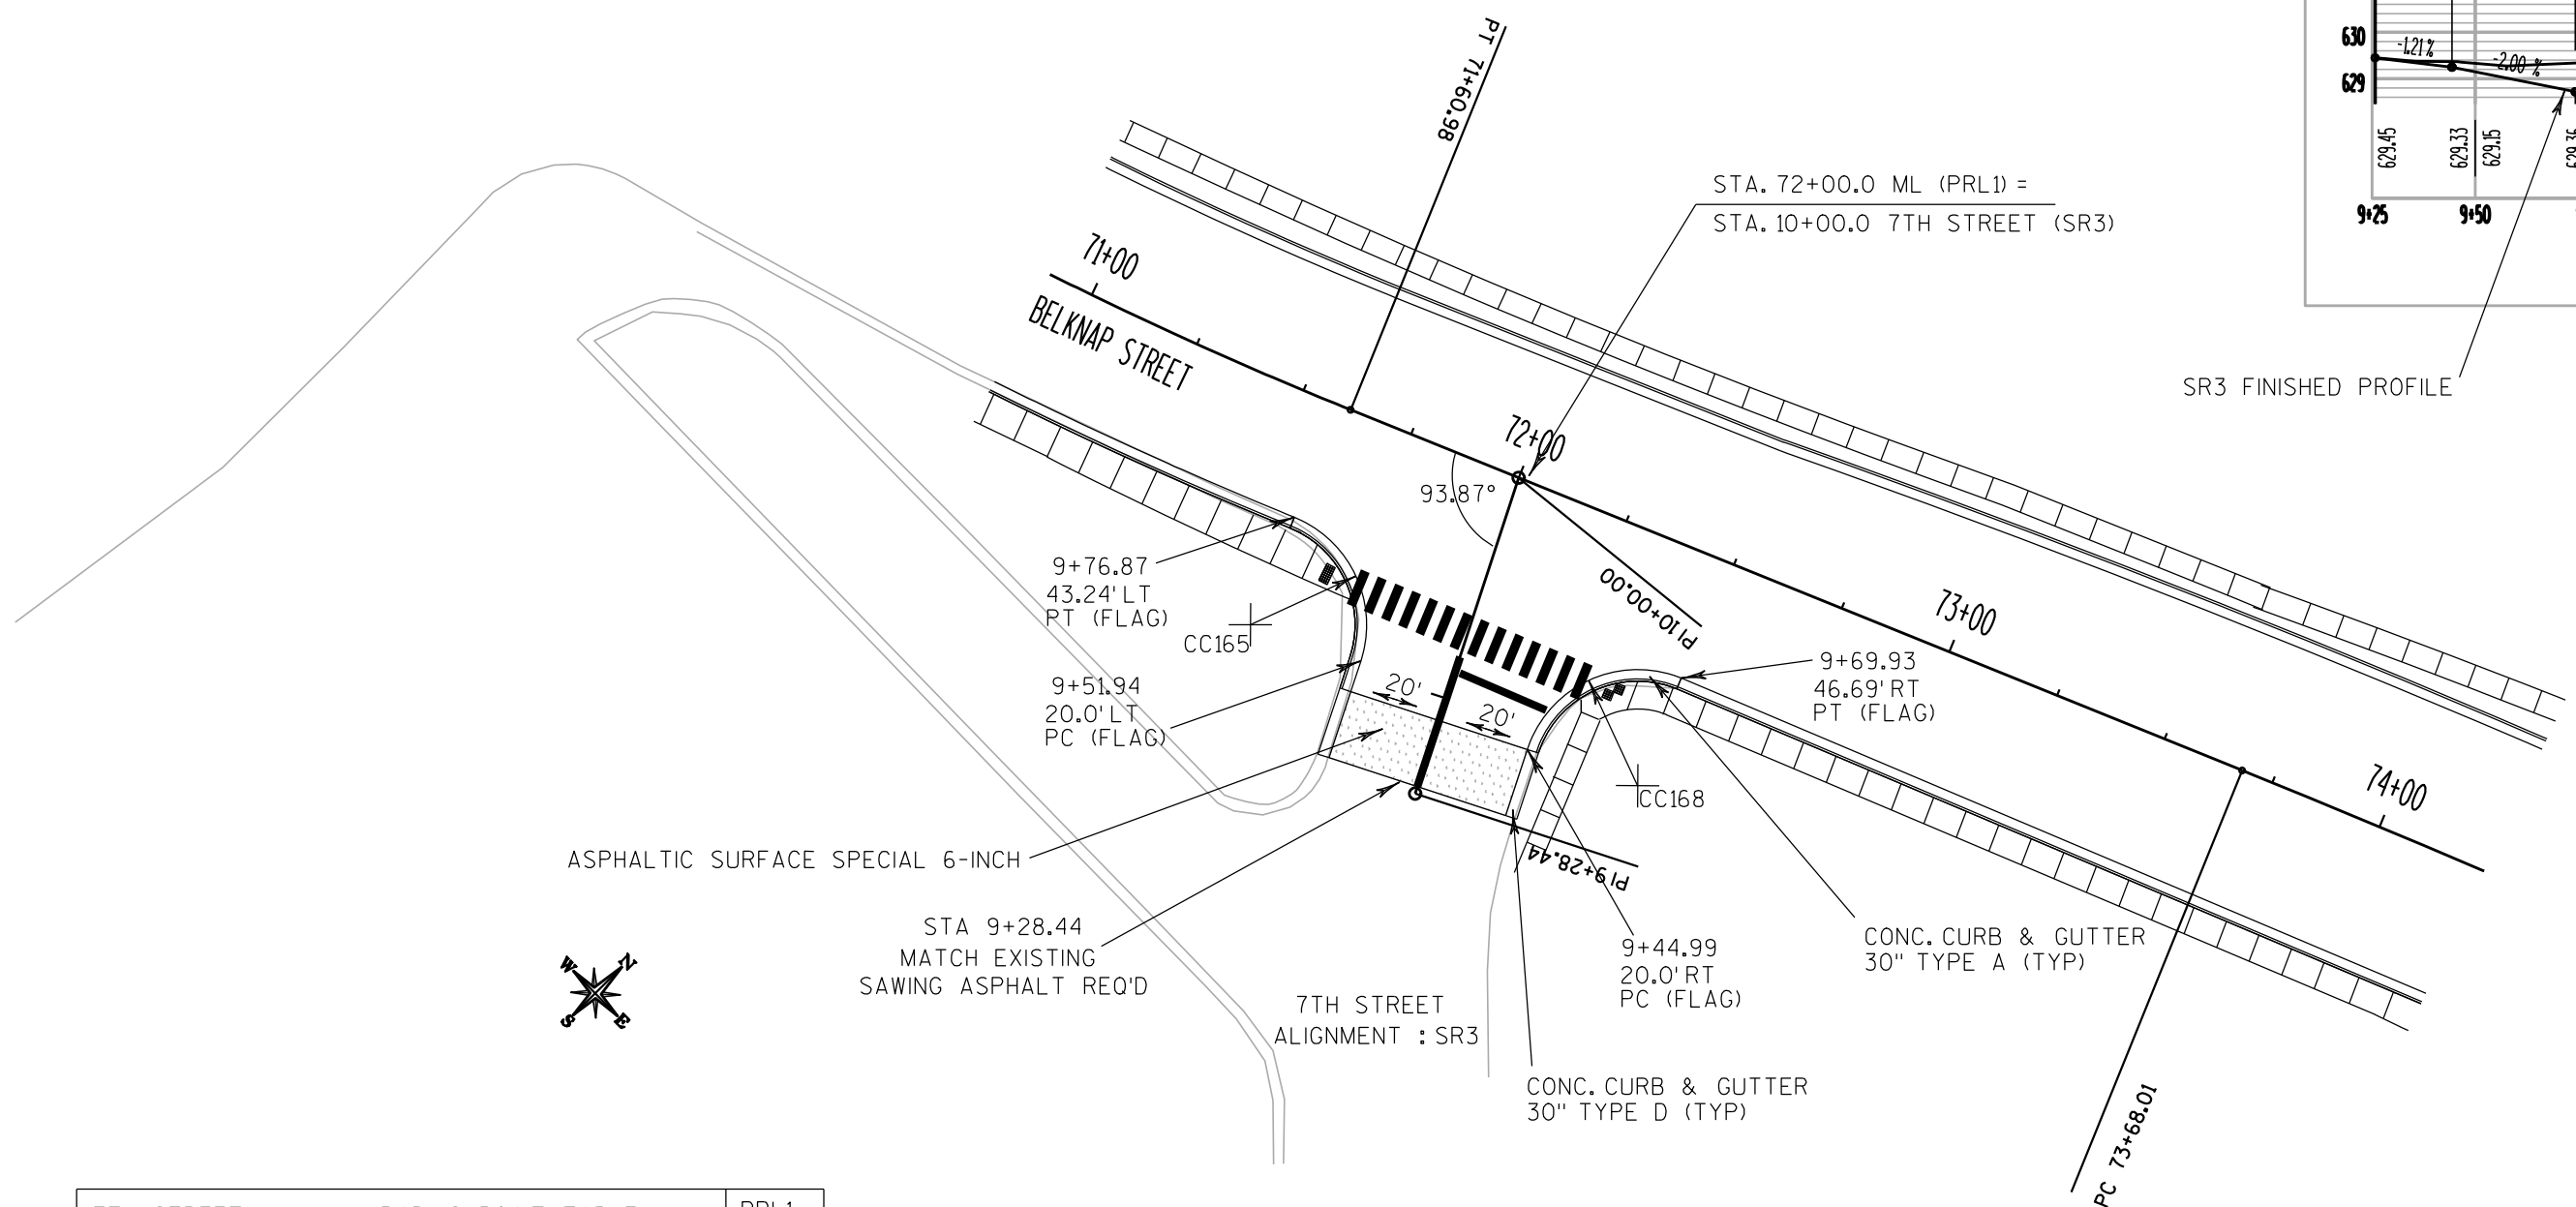



CONSTRUCT TYPE 2 CURB RAMPS LT AND RT AT 7TH ST SIDEWALK CROSSING.

7TH STREET				RADIUS POINT TABLE		PRL1 SR3
POINT	STATION	OFFSET	RADIUS	COORDINATES		
CC165	71+58.49	51.0 RT	25.0'	N	305406.05	
	9+51.94	45.0 LT		E	153926.18	
CC168	72+48.61	51.85 RT	25.0'	N	305440.97	
	9+44.99	45.0 RT		E	154009.42	

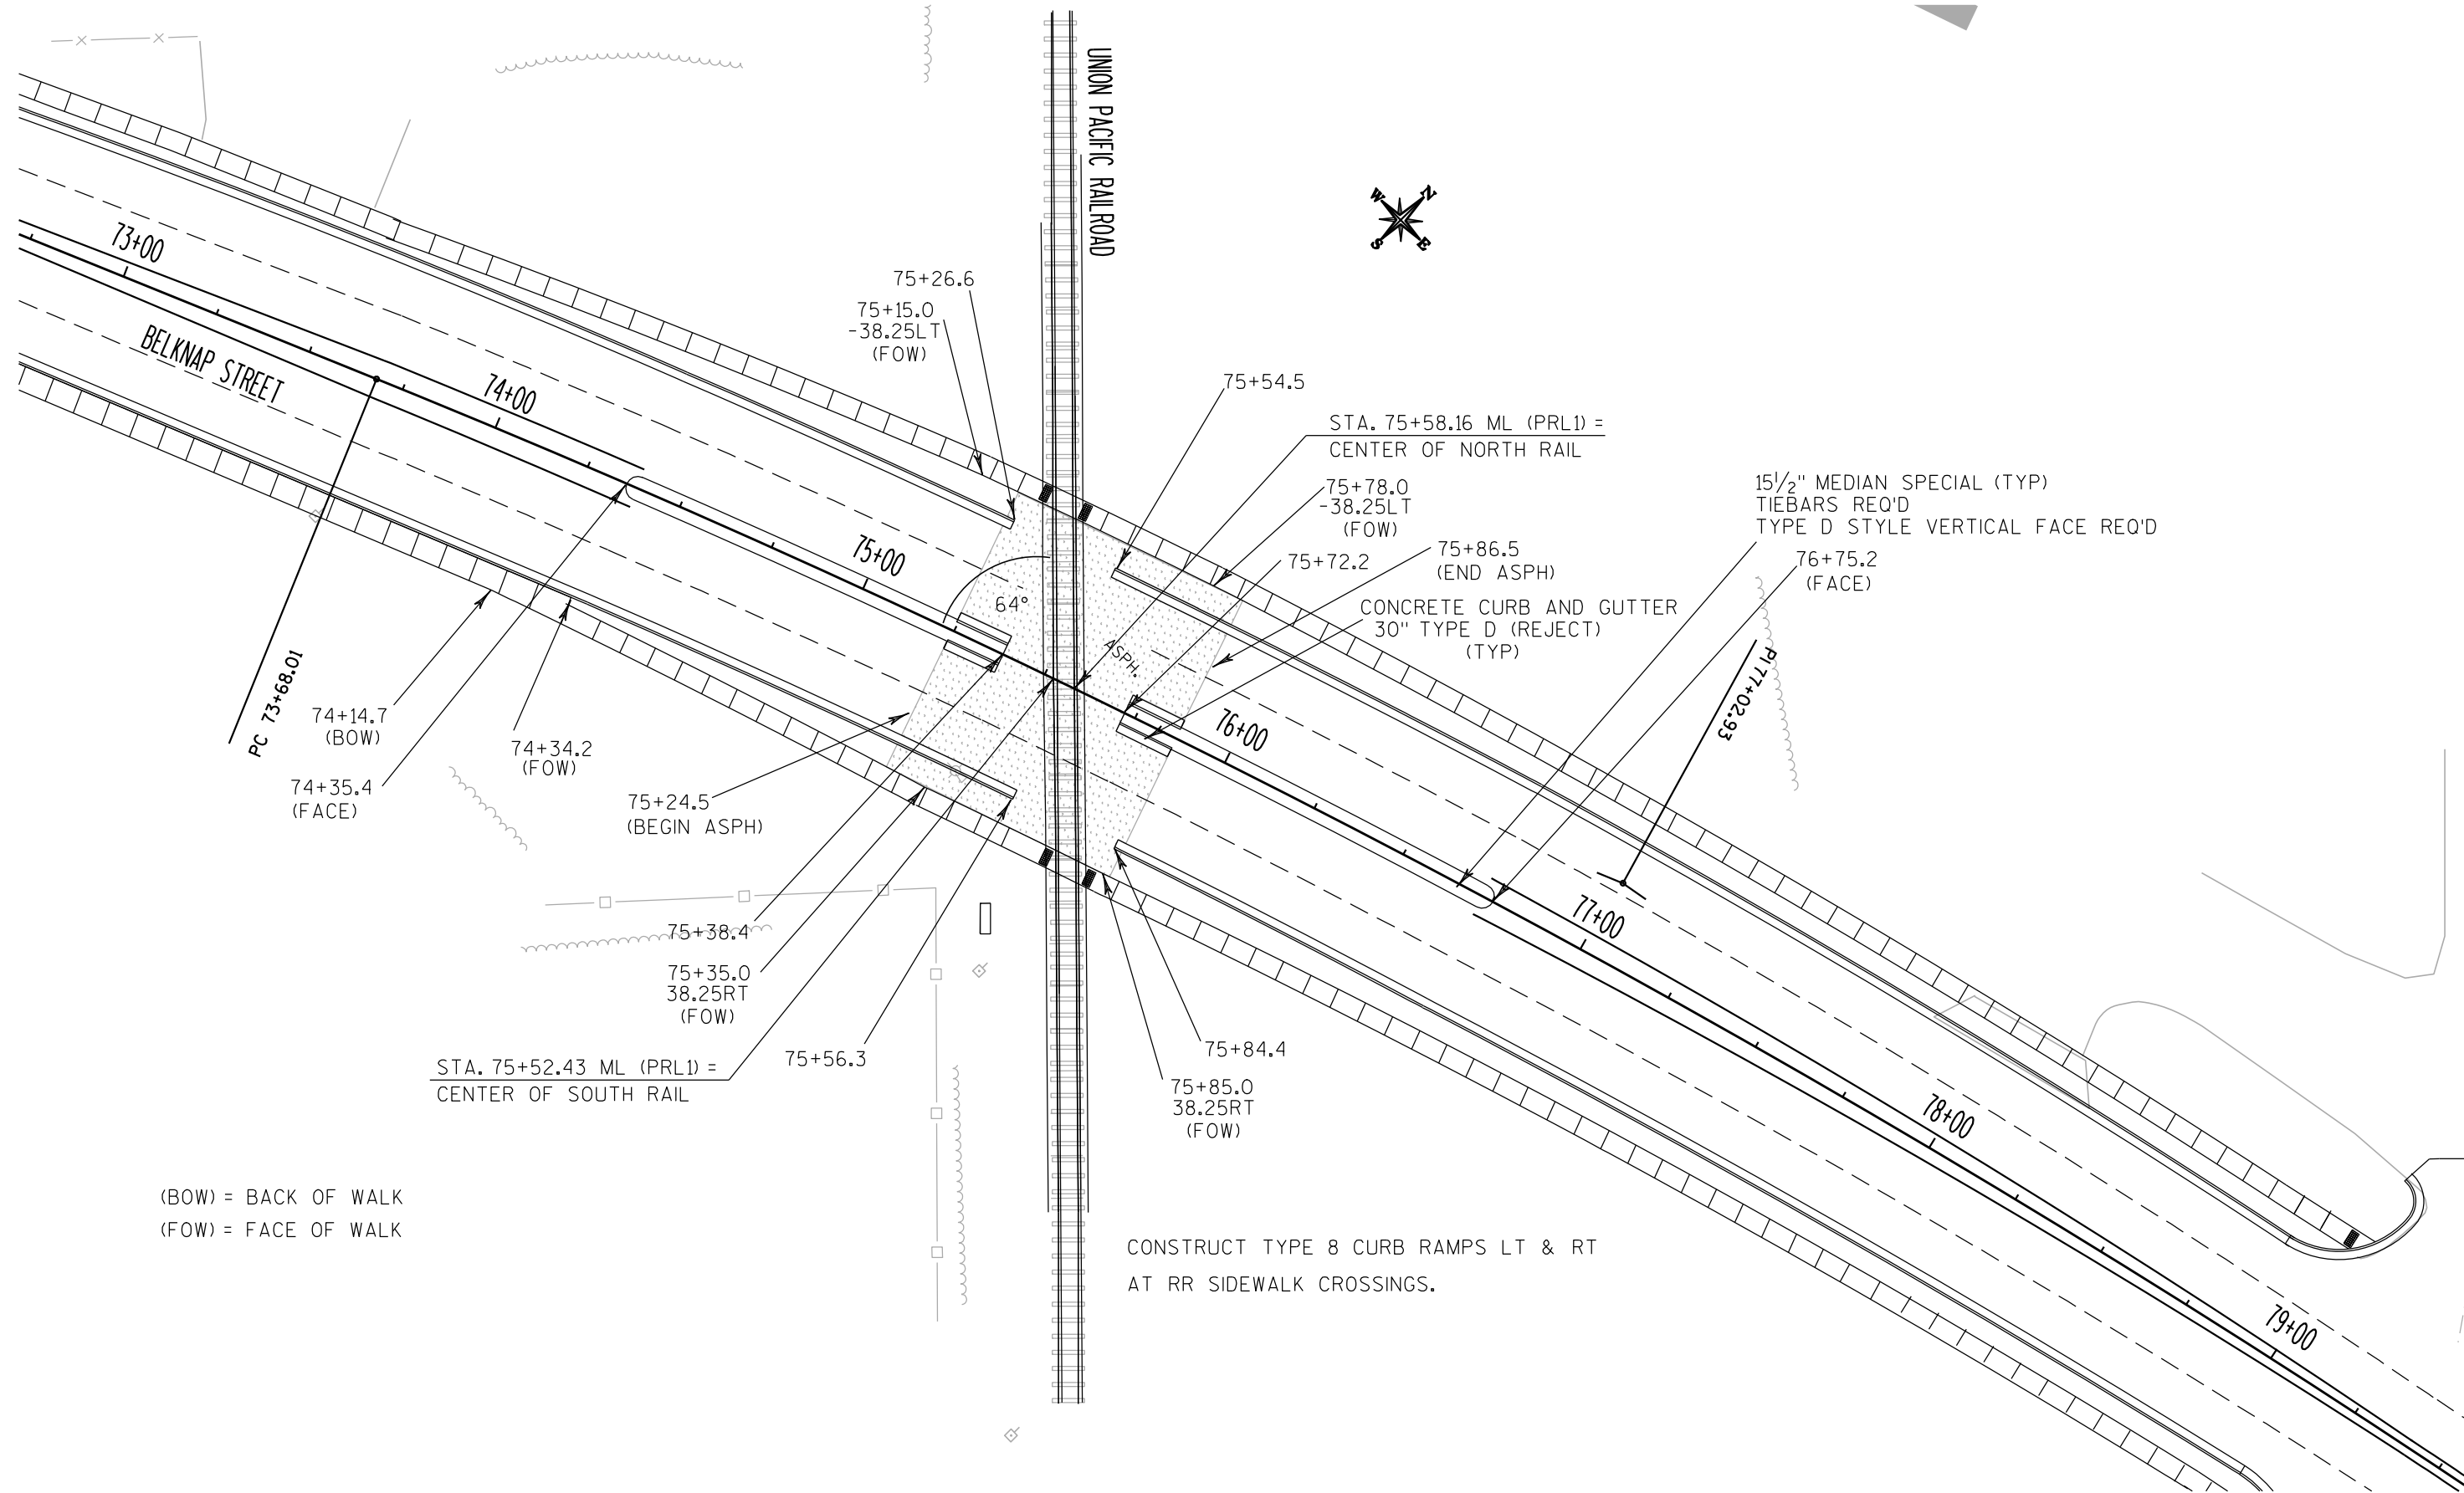

(BOW) = BACK OF WALK  
 (FOW) = FACE OF WALK

CONSTRUCT TYPE 8 CURB RAMPS LT & RT  
 AT RR SIDEWALK CROSSINGS.

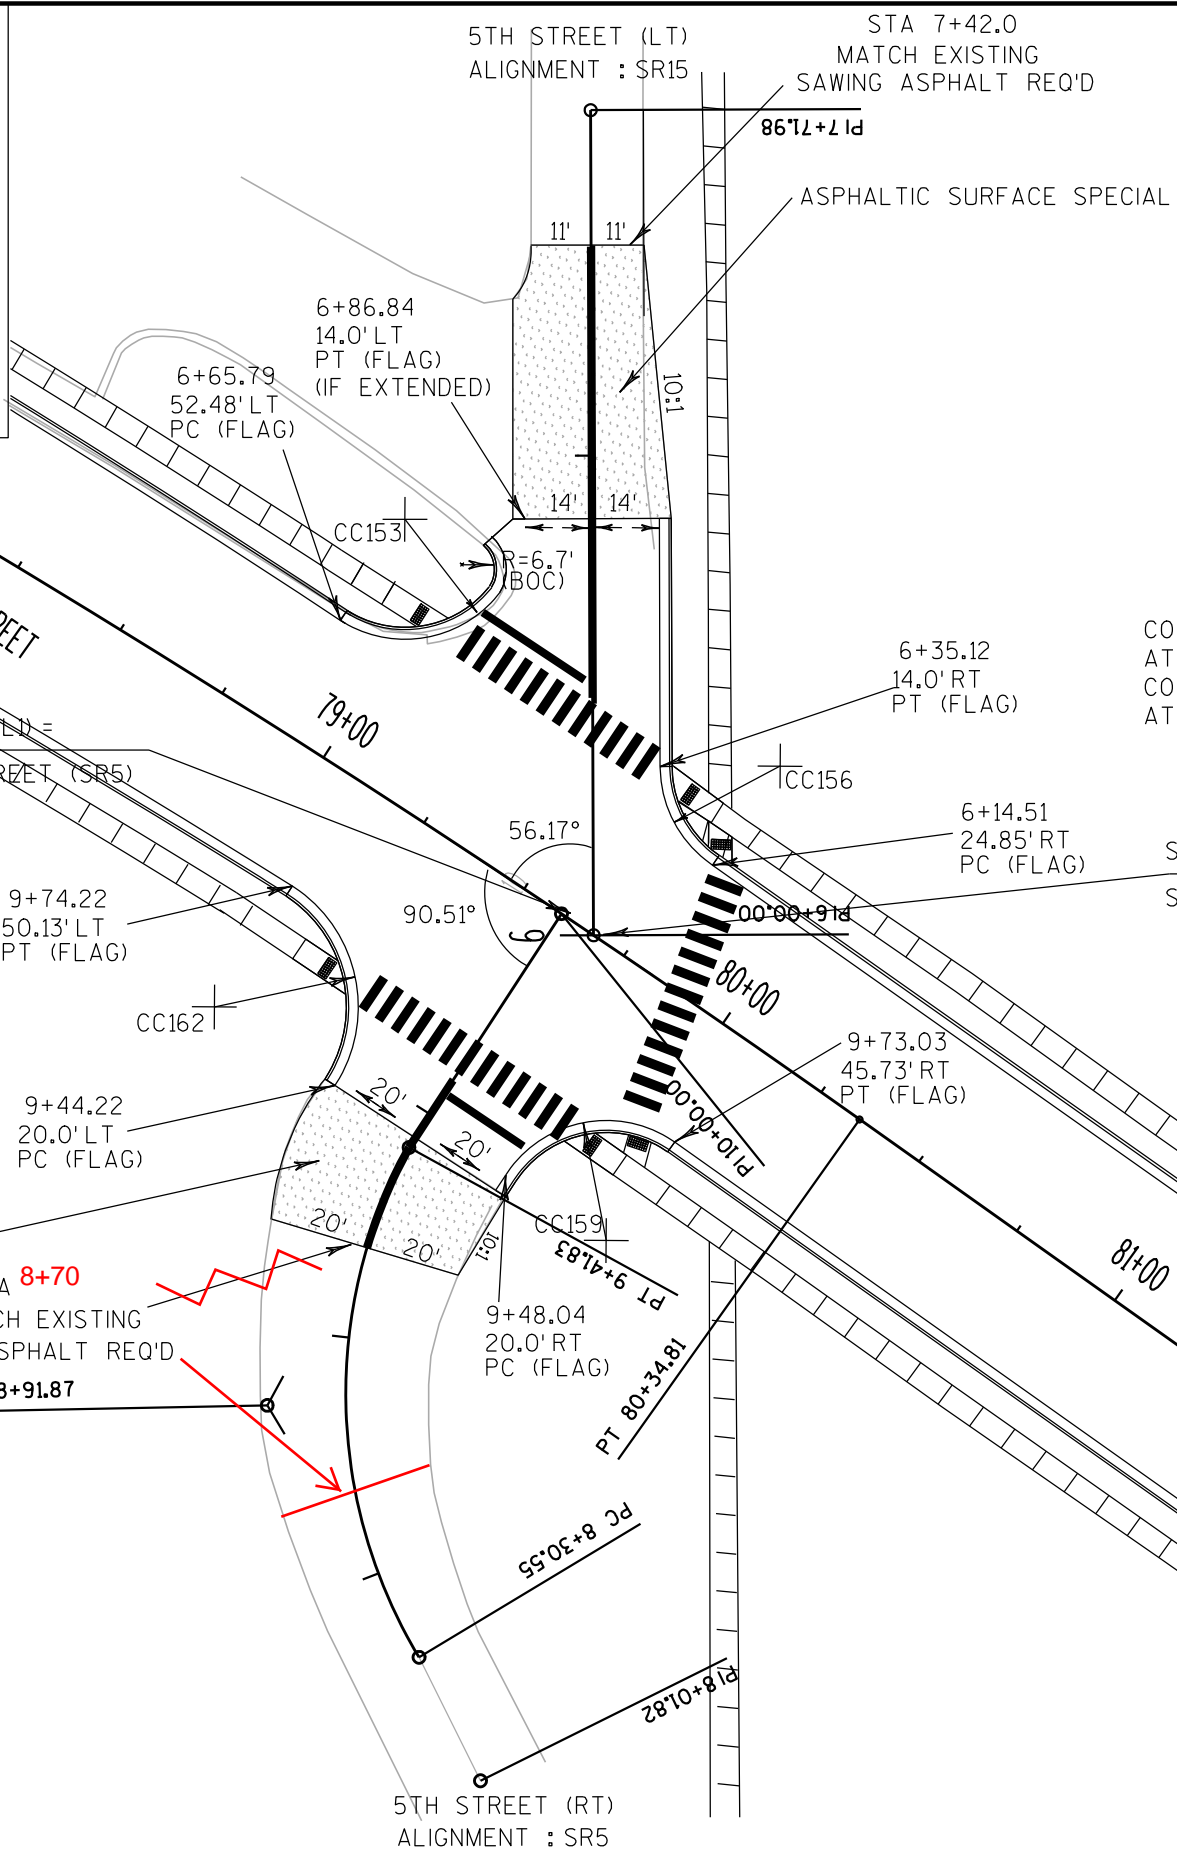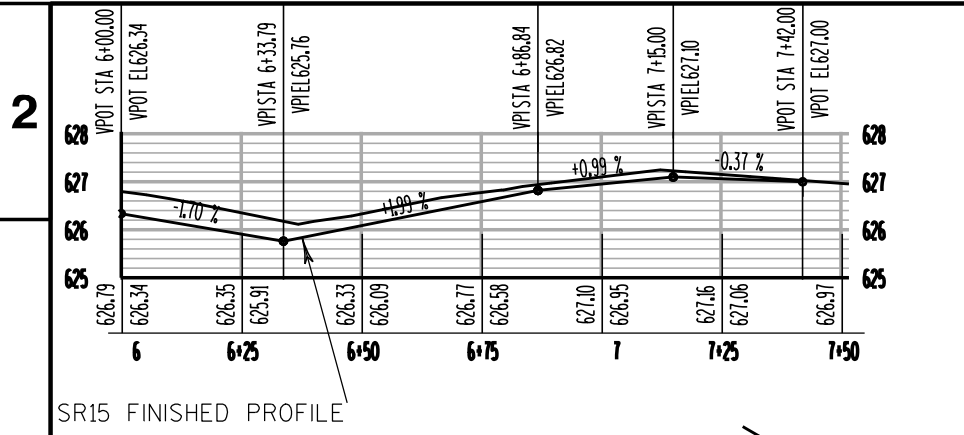


5TH STREET (LT) RADIUS POINT TABLE				PRL1 SR15
POINT	STATION	OFFSET	RADIUS	COORDINATES
CC153	78+87.70	51.0 LT	25.0'	N 305746.79
	6+86.84	39.0 LT		E 154580.47
CC156	79+79.66	51.0 LT	25.0'	N 305766.23
	6+35.12	39.0 RT		E 154672.02

CONSTRUCT TYPE 2 CURB RAMPS LT & RT AT 5TH ST SIDEWALK CROSSINGS.  
CONSTRUCT TYPE 2 CURB RAMPS RT AT USH 2 SIDEWALK CROSSING.



STA. 79+59.33 ML (PRL1) =  
STA. 10+00.0 5TH STREET (SR5)

STA. 79+67.38 ML (PRL1) =  
STA. 6+00.0 5TH STREET (SR15)

5TH STREET (RT) RADIUS POINT TABLE				PRL1 SR5
POINT	STATION	OFFSET	RADIUS	COORDINATES
CC162	79+09.08	56.0 RT	30.0'	N 305647.10
	9+44.22	50.0 LT		E 154624.81
CC159	80+05.84	51.0 RT	25.0'	N 305670.95
	9+48.04	45.0 RT		E 154716.85

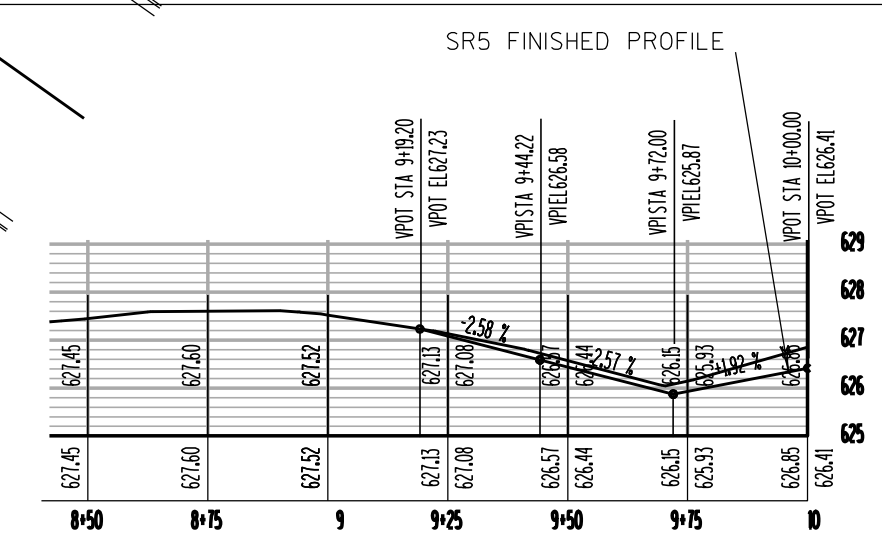

CONSTRUCT TYPE 2 CURB RAMP LT & RT AT 2ND AVE SIDEWALK CROSSING.

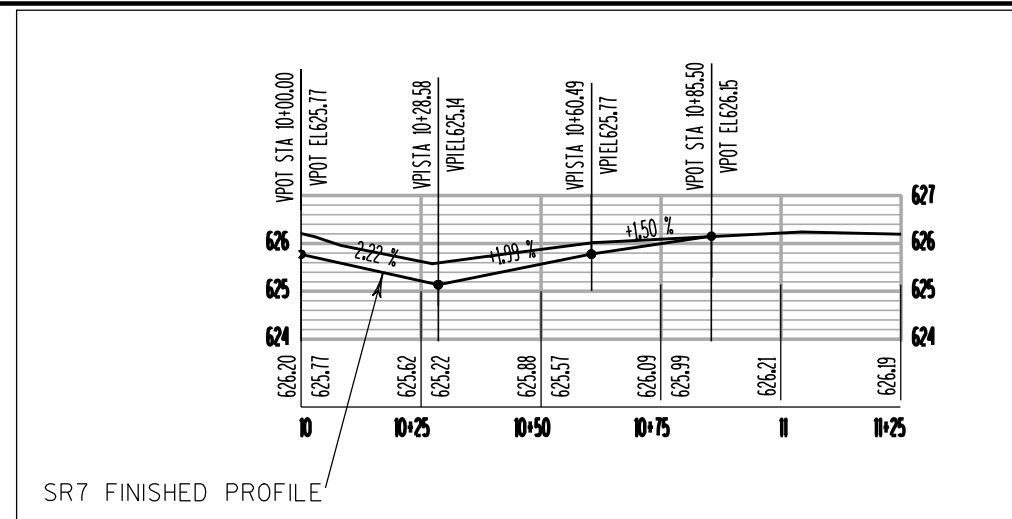
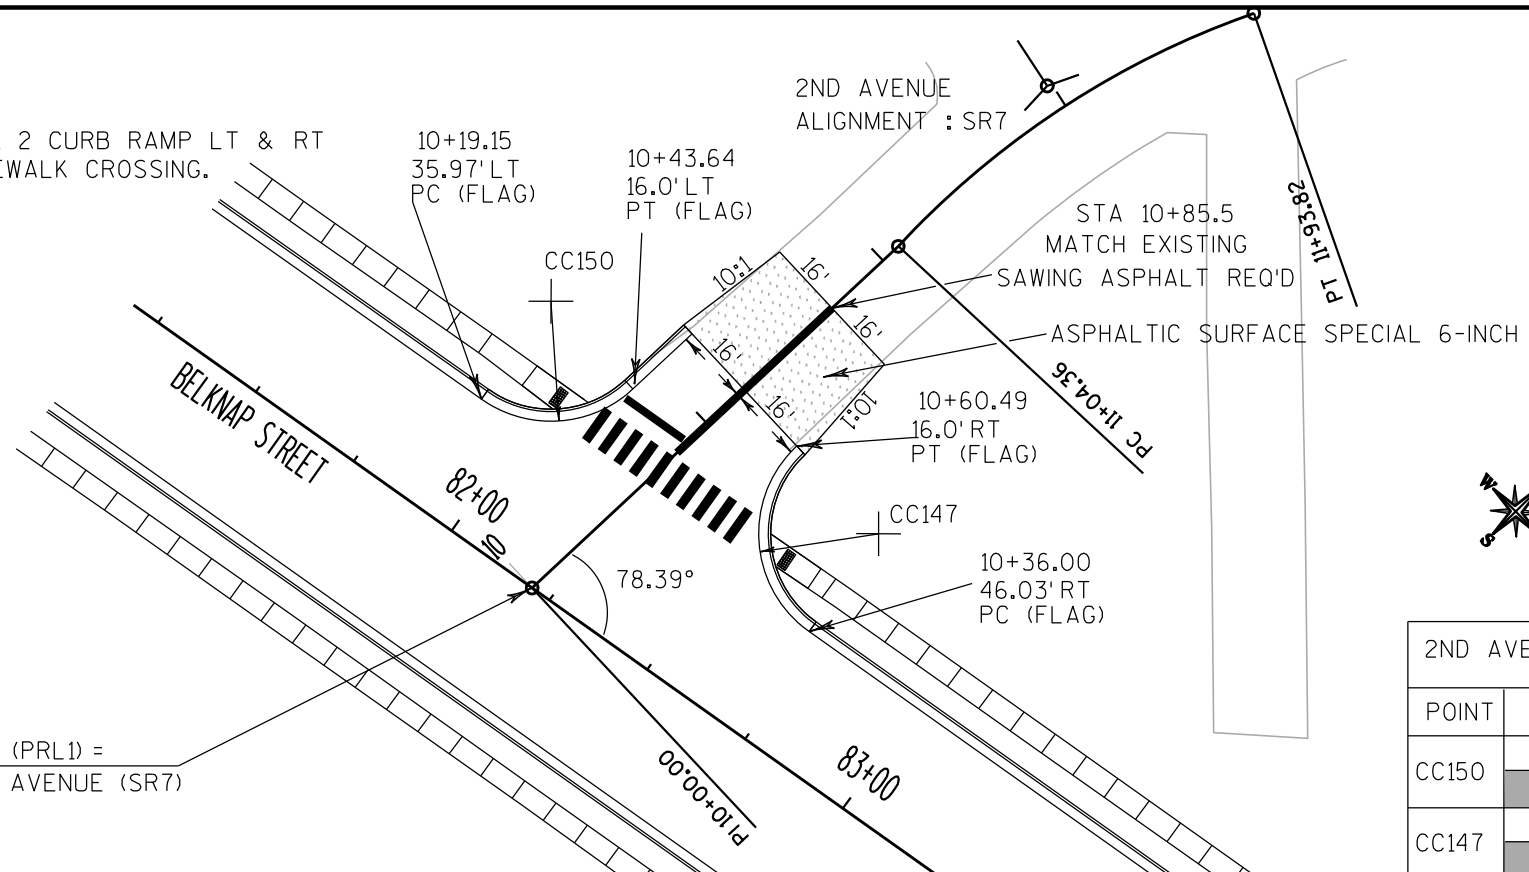


2ND AVENUE RADIUS POINT TABLE				PRL1 SR7
POINT	STATION	OFFSET	RADIUS	COORDINATES
CC150	81+89.21	51.0 LT	25.0'	N 305803.19
	10+43.64	41.0 LT		E 154879.27
CC147	82+72.92	51.0 LT	25.0'	N 305817.67
	10+60.49	41.0 RT		E 154961.73



STA. 82+20.58 ML (PRL1) = STA. 10+00.0 3RD AVENUE (SR7)

4TH STREET RADIUS POINT TABLE				PRL1 SR8
POINT	STATION	OFFSET	RADIUS	COORDINATES
CC144	84+31.57	51.0 RT	25.0'	N 305744.66
	9+49.24	40.0 LT		E 155135.63
CC141	85+11.57	51.0 RT	25.0'	N 305758.51
	9+48.39	40.0 RT		E 155214.43

STA. 84+73.54 ML (PRL1) = STA. 10+00.0 4TH STREET (SR8)

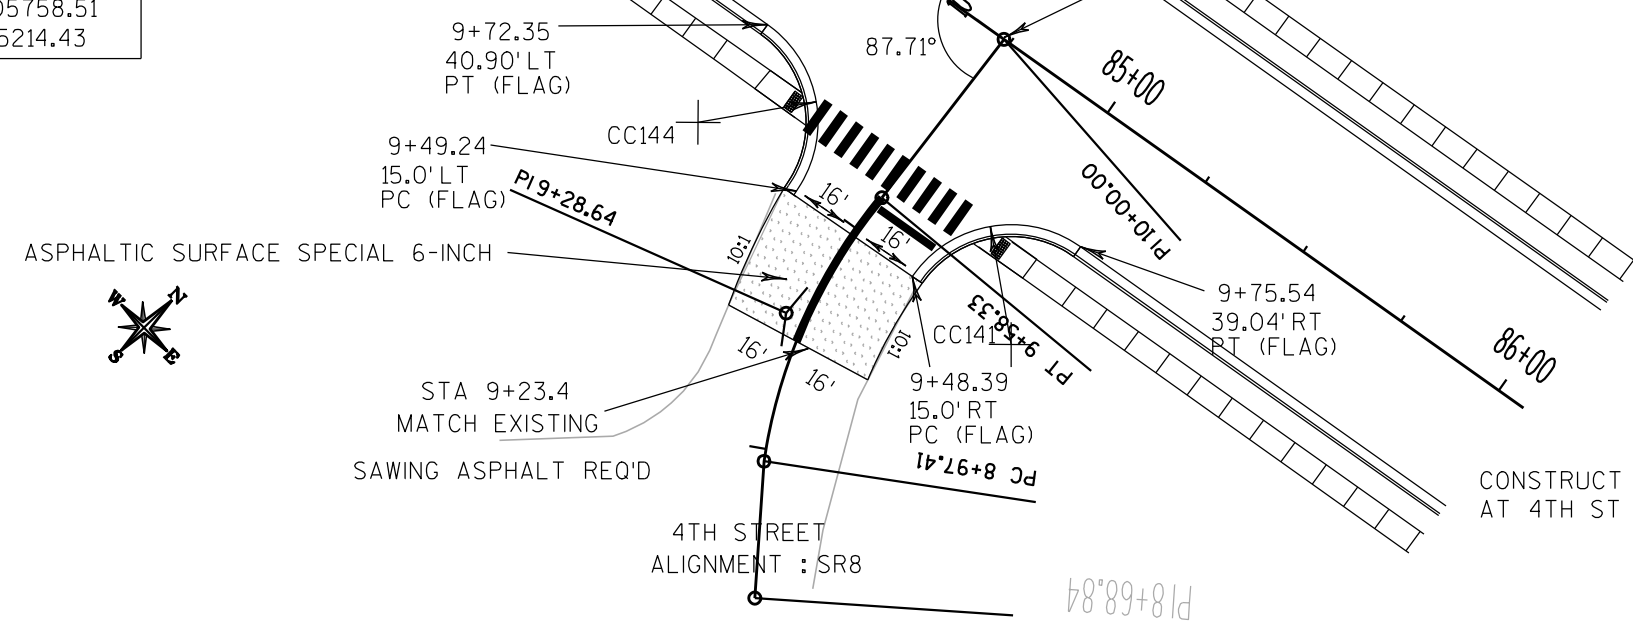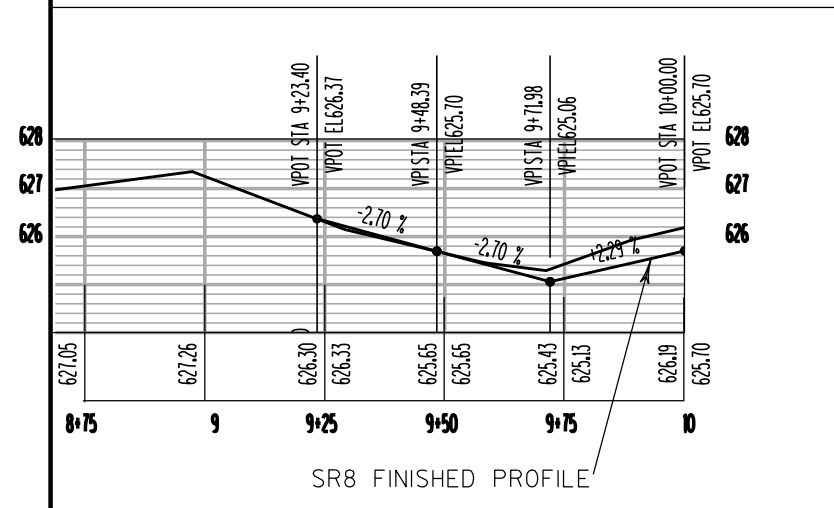

CONSTRUCT TYPE 2 CURB RAMP LT & RT AT 4TH ST SIDEWALK CROSSING.

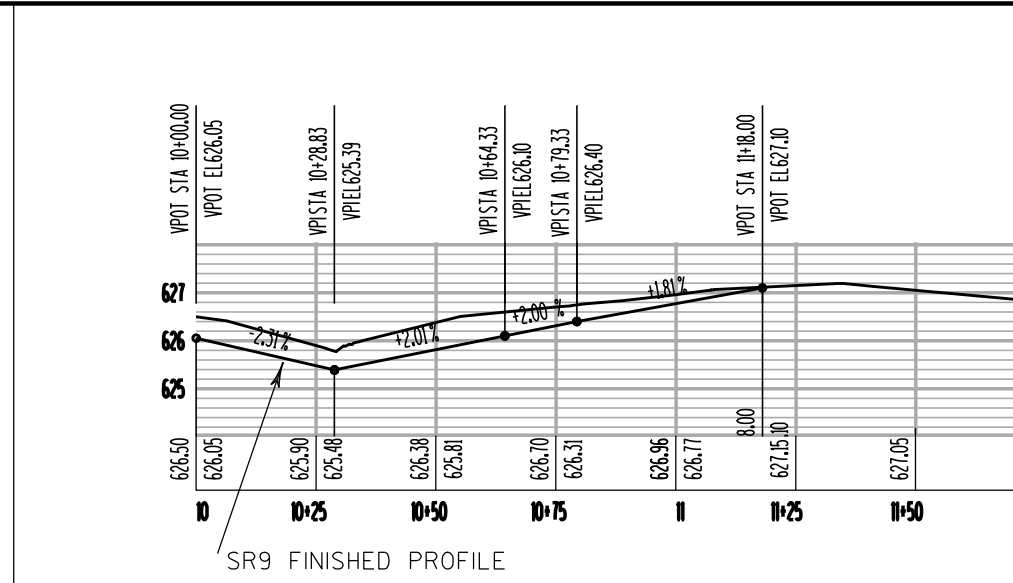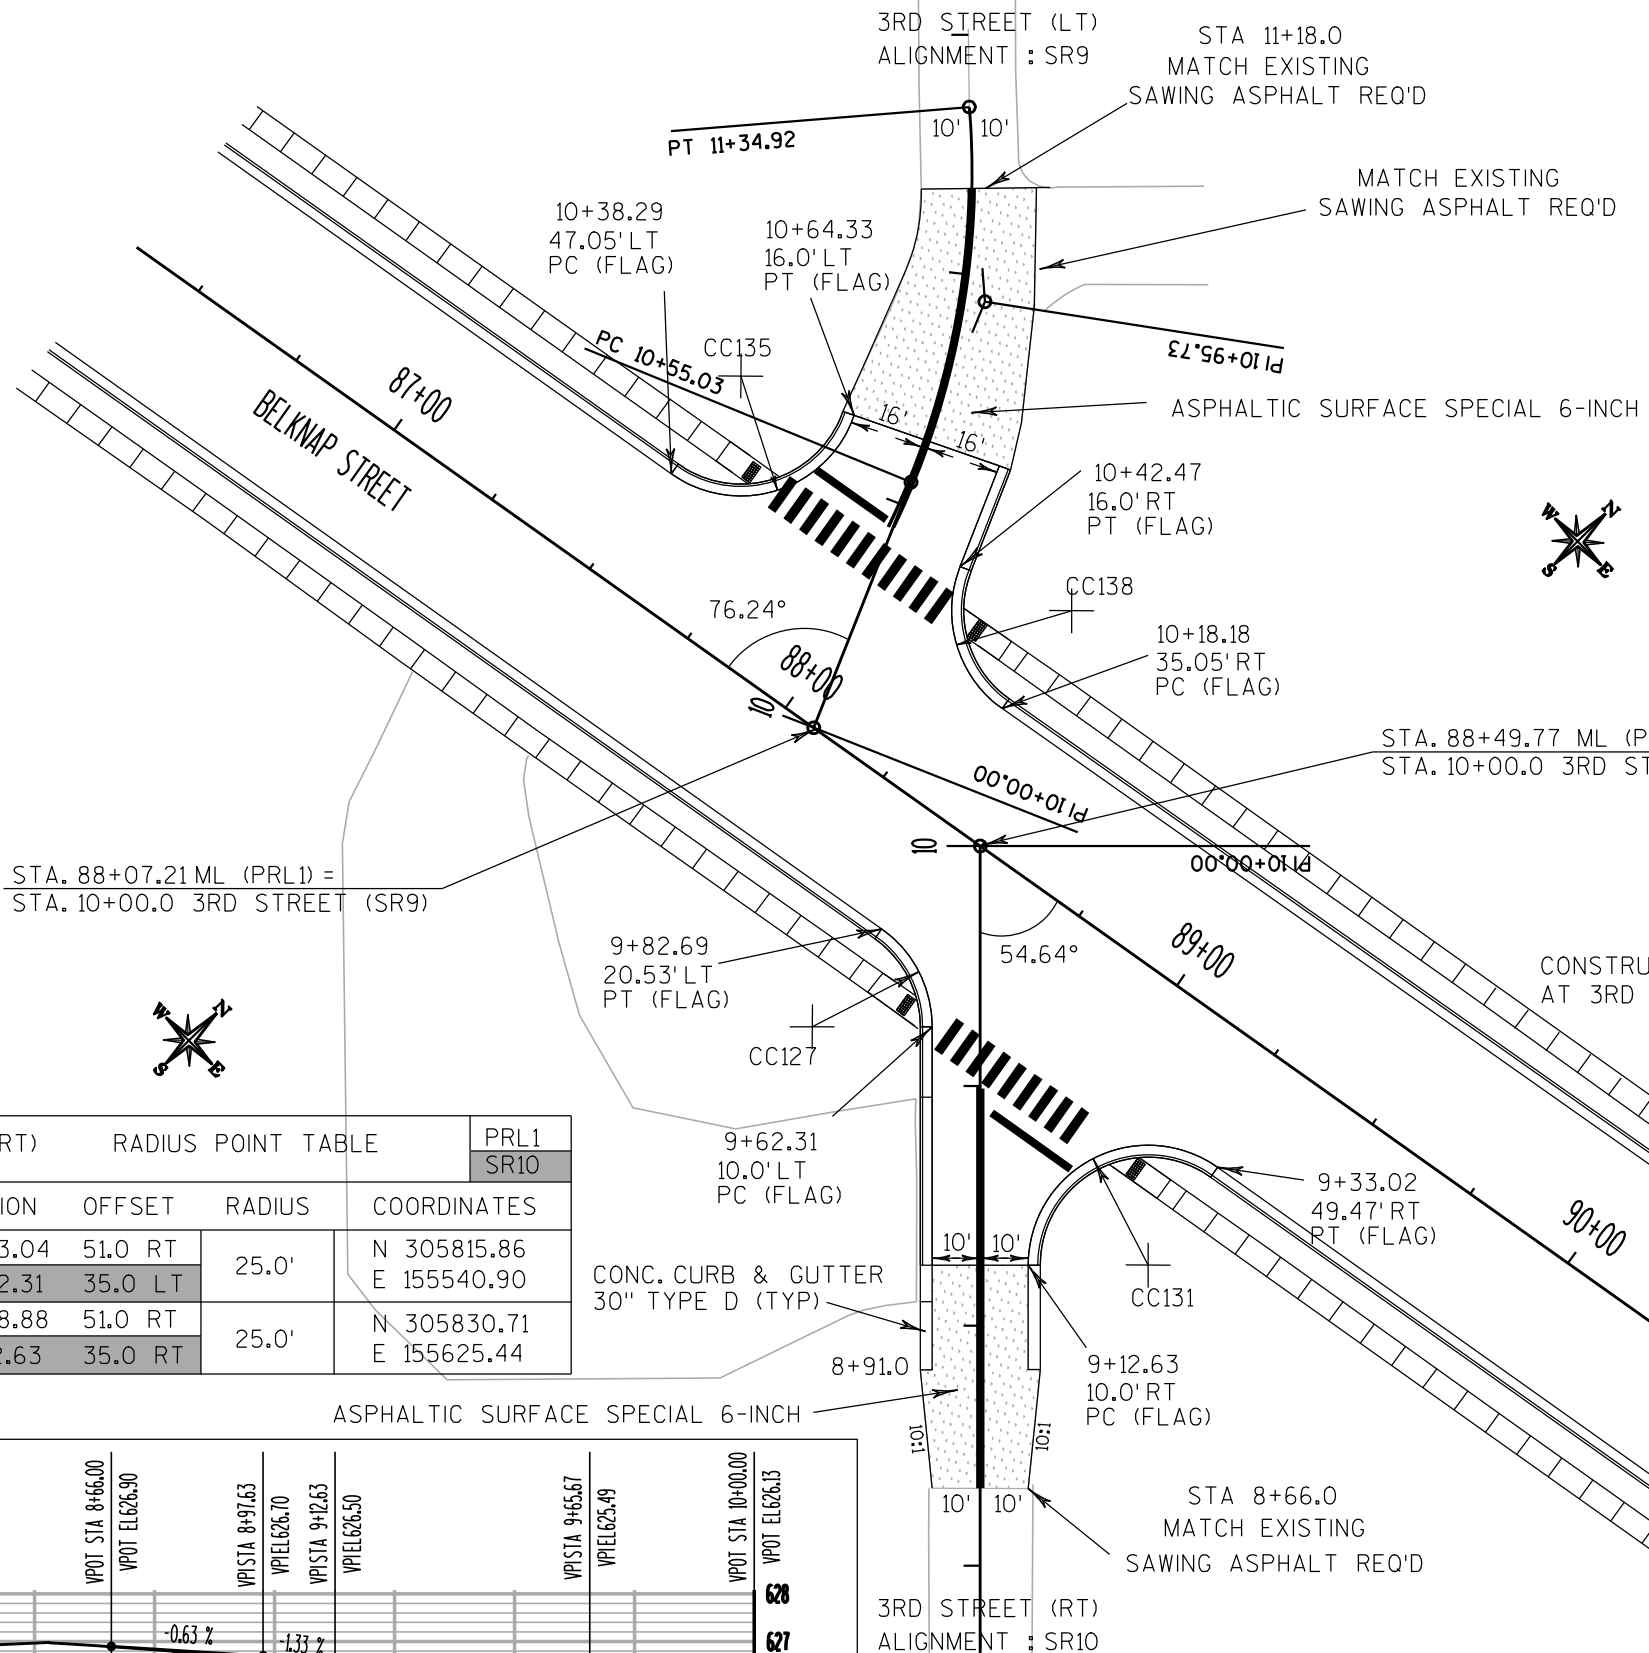


3RD STREET (LT) RADIUS POINT TABLE				PRL1 SR9
POINT	STATION	OFFSET	RADIUS	COORDINATES
CC135	87+52.40	51.0 LT	25.0'	N 305900.64
	10+64.33	41.0 LT		E 155433.97
CC138	88+36.93	51.0 LT	25.0'	N 305915.26
	10+42.47	41.0 RT		E 155517.23


STA. 88+07.21 ML (PRL1) = STA. 10+00.0 3RD STREET (SR9)

STA. 88+49.77 ML (PRL1) = STA. 10+00.0 3RD STREET (SR10)

CONSTRUCT TYPE 2 CURB RAMPS LT & RT AT 3RD ST SIDEWALK CROSSINGS.


3RD STREET (RT) RADIUS POINT TABLE				PRL1 SR10
POINT	STATION	OFFSET	RADIUS	COORDINATES
CC127	88+43.04	51.0 RT	25.0'	N 305815.86
	9+62.31	35.0 LT		E 155540.90
CC131	89+28.88	51.0 RT	25.0'	N 305830.71
	9+12.63	35.0 RT		E 155625.44

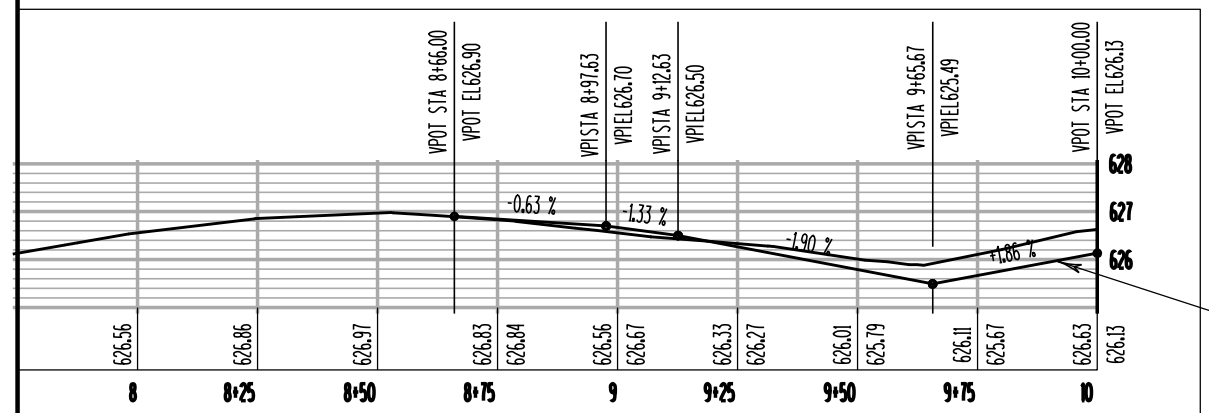

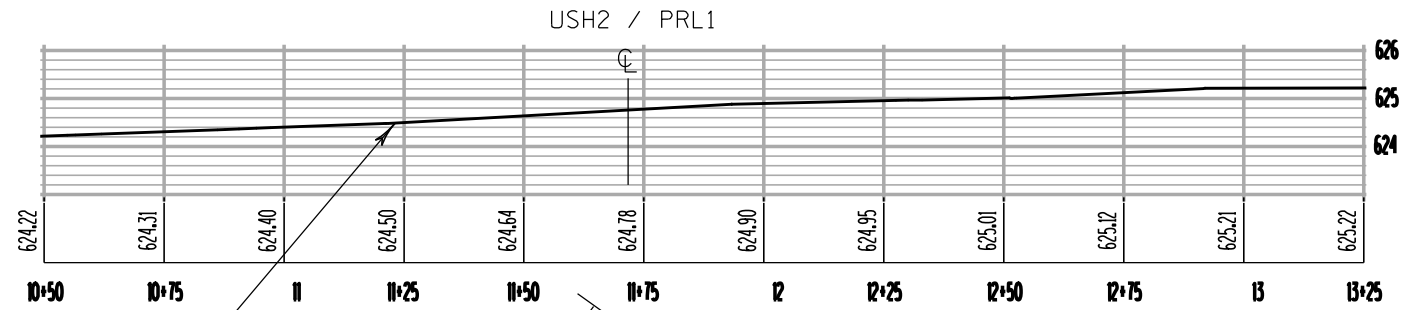

 CONCRETE PAVEMENT  
9 1/2" INCH SPECIAL



SR11 EXISTING PROFILE

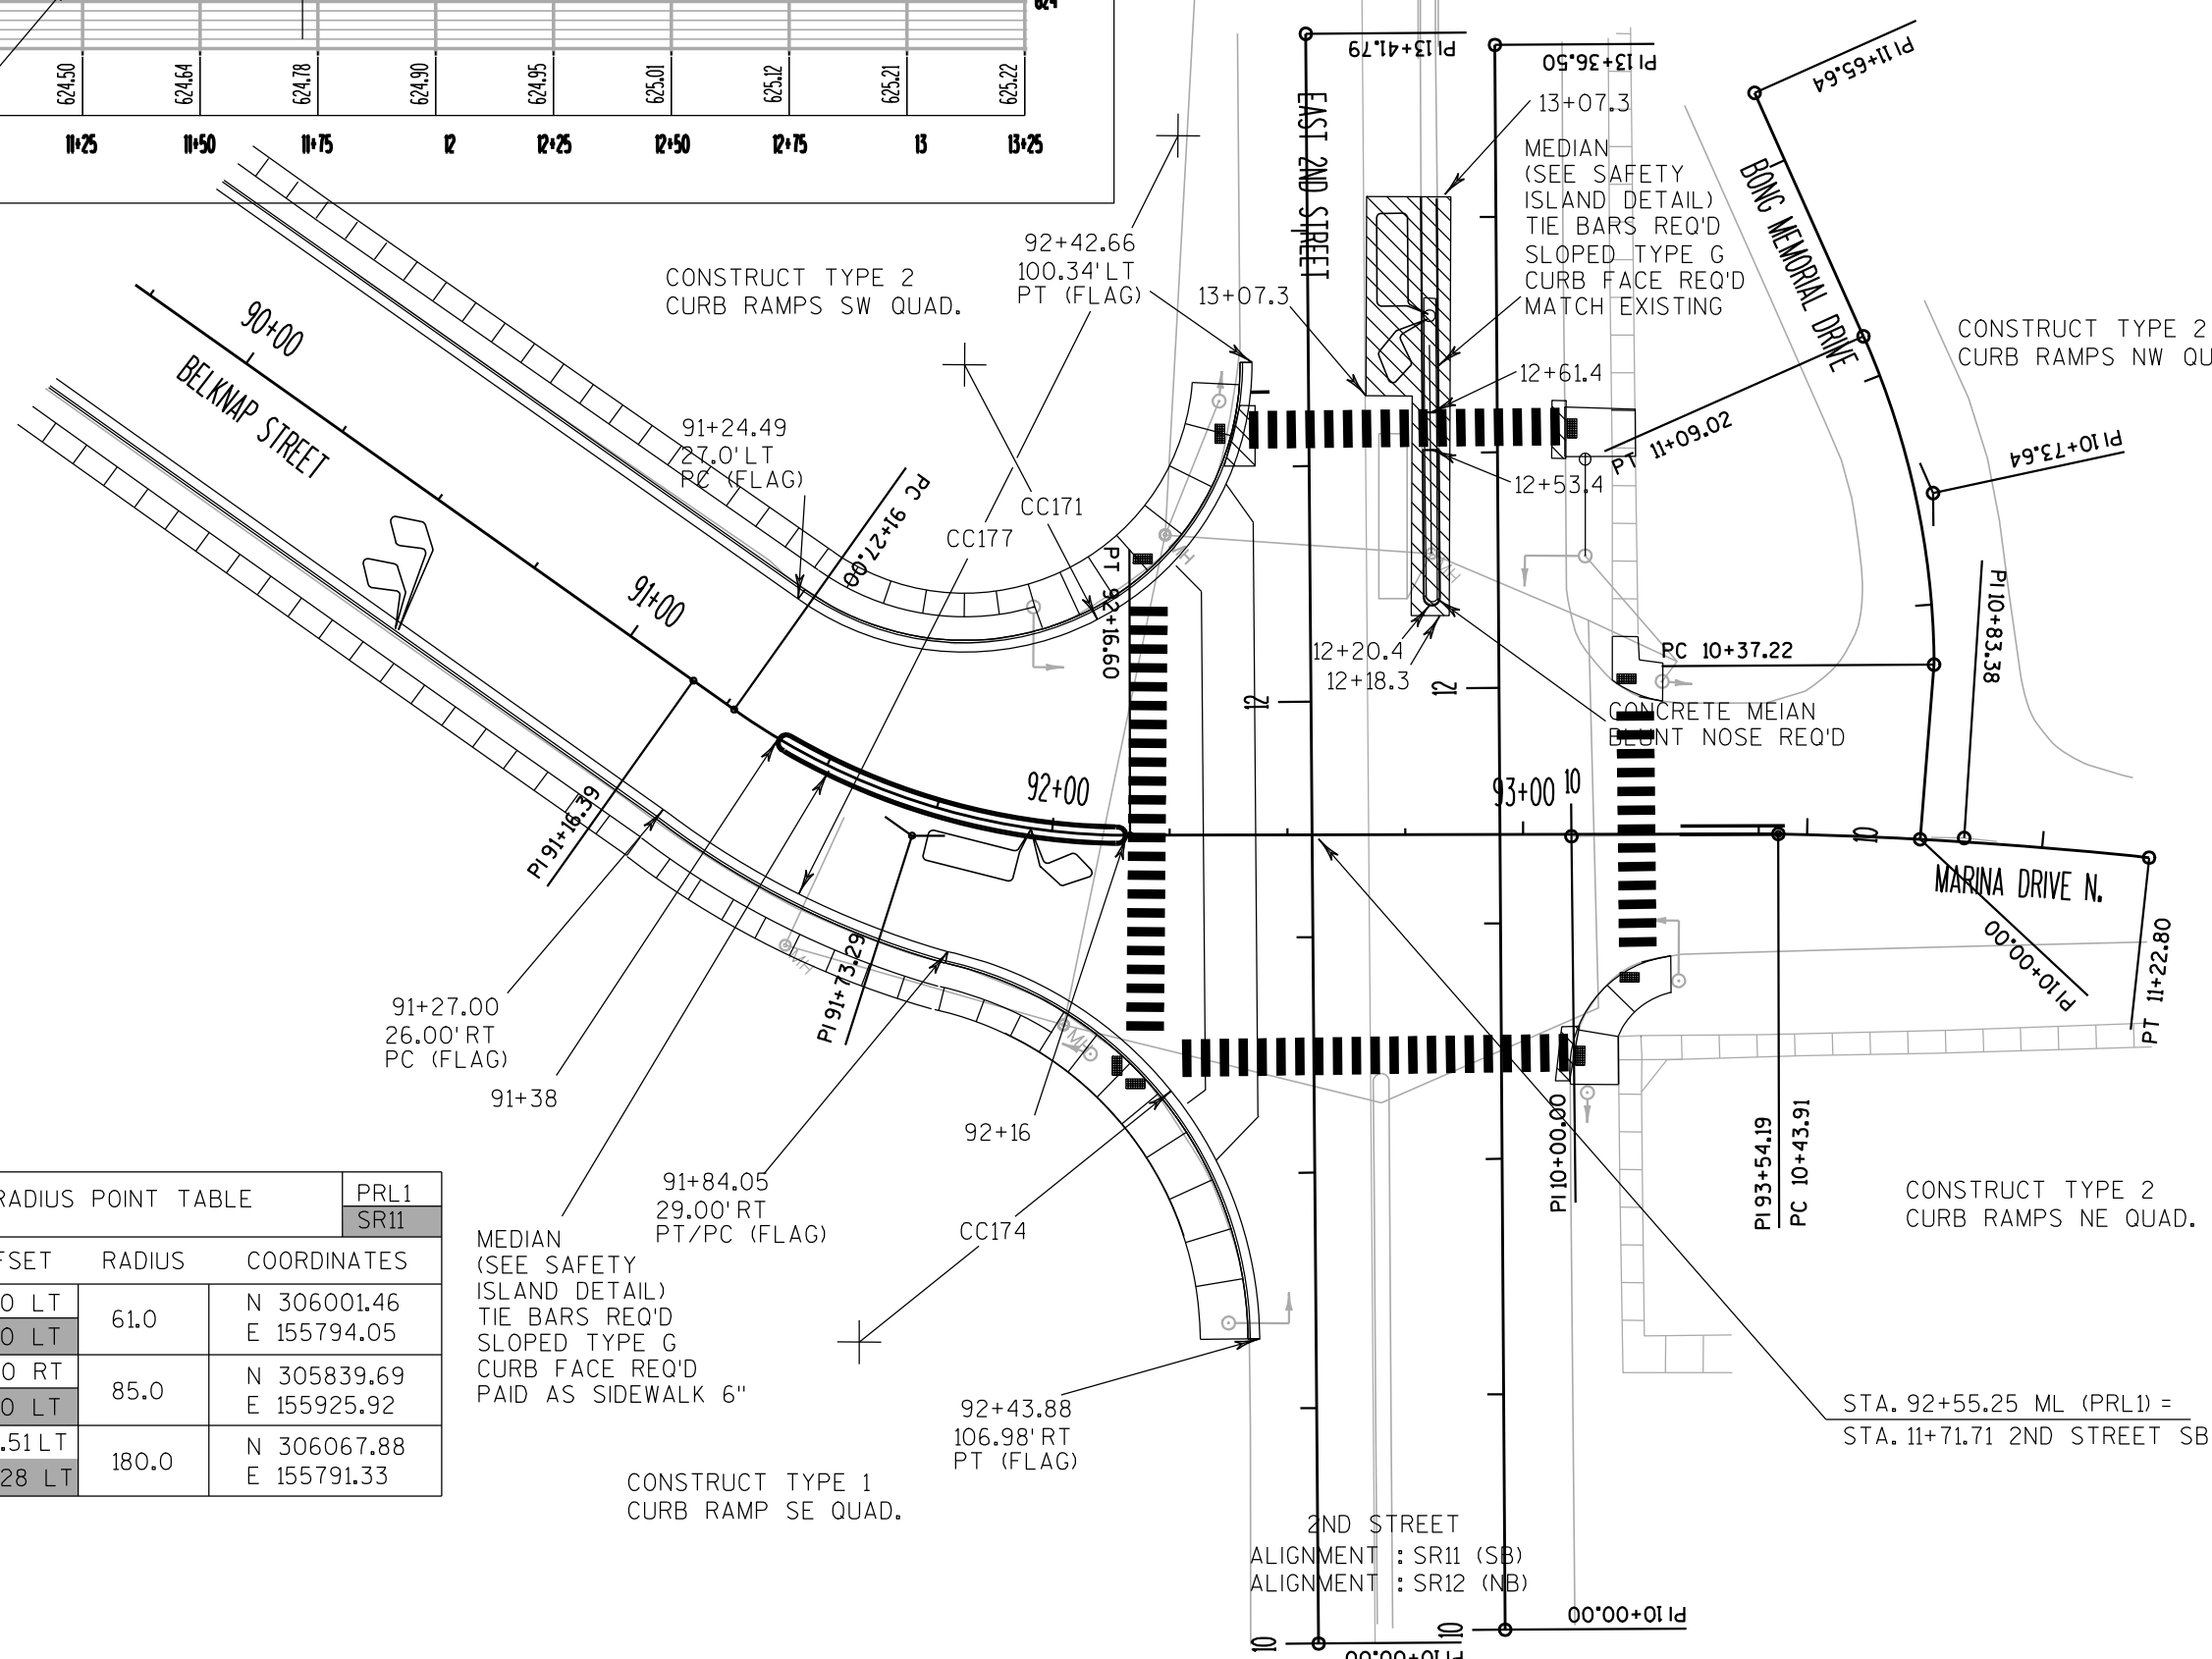


2ND STREET RADIUS POINT TABLE				PRL1 SR11
POINT	STATION	OFFSET	RADIUS	COORDINATES
CC171	91+24.49	88.0 LT	61.0	N 306001.46
	12+72.12	73.0 LT		E 155794.05
CC174	91+84.05	114.0 RT	85.0	N 305839.69
	10+64.80	97.0 LT		E 155925.92
CC177	92+27.09	148.51 LT	180.0	N 306067.88
	13+20.39	27.28 LT		E 155791.33


STA. 92+55.25 ML (PRL1) =  
STA. 11+71.71 2ND STREET SB (SR11)



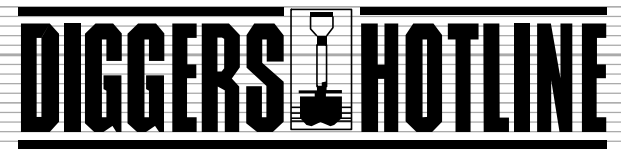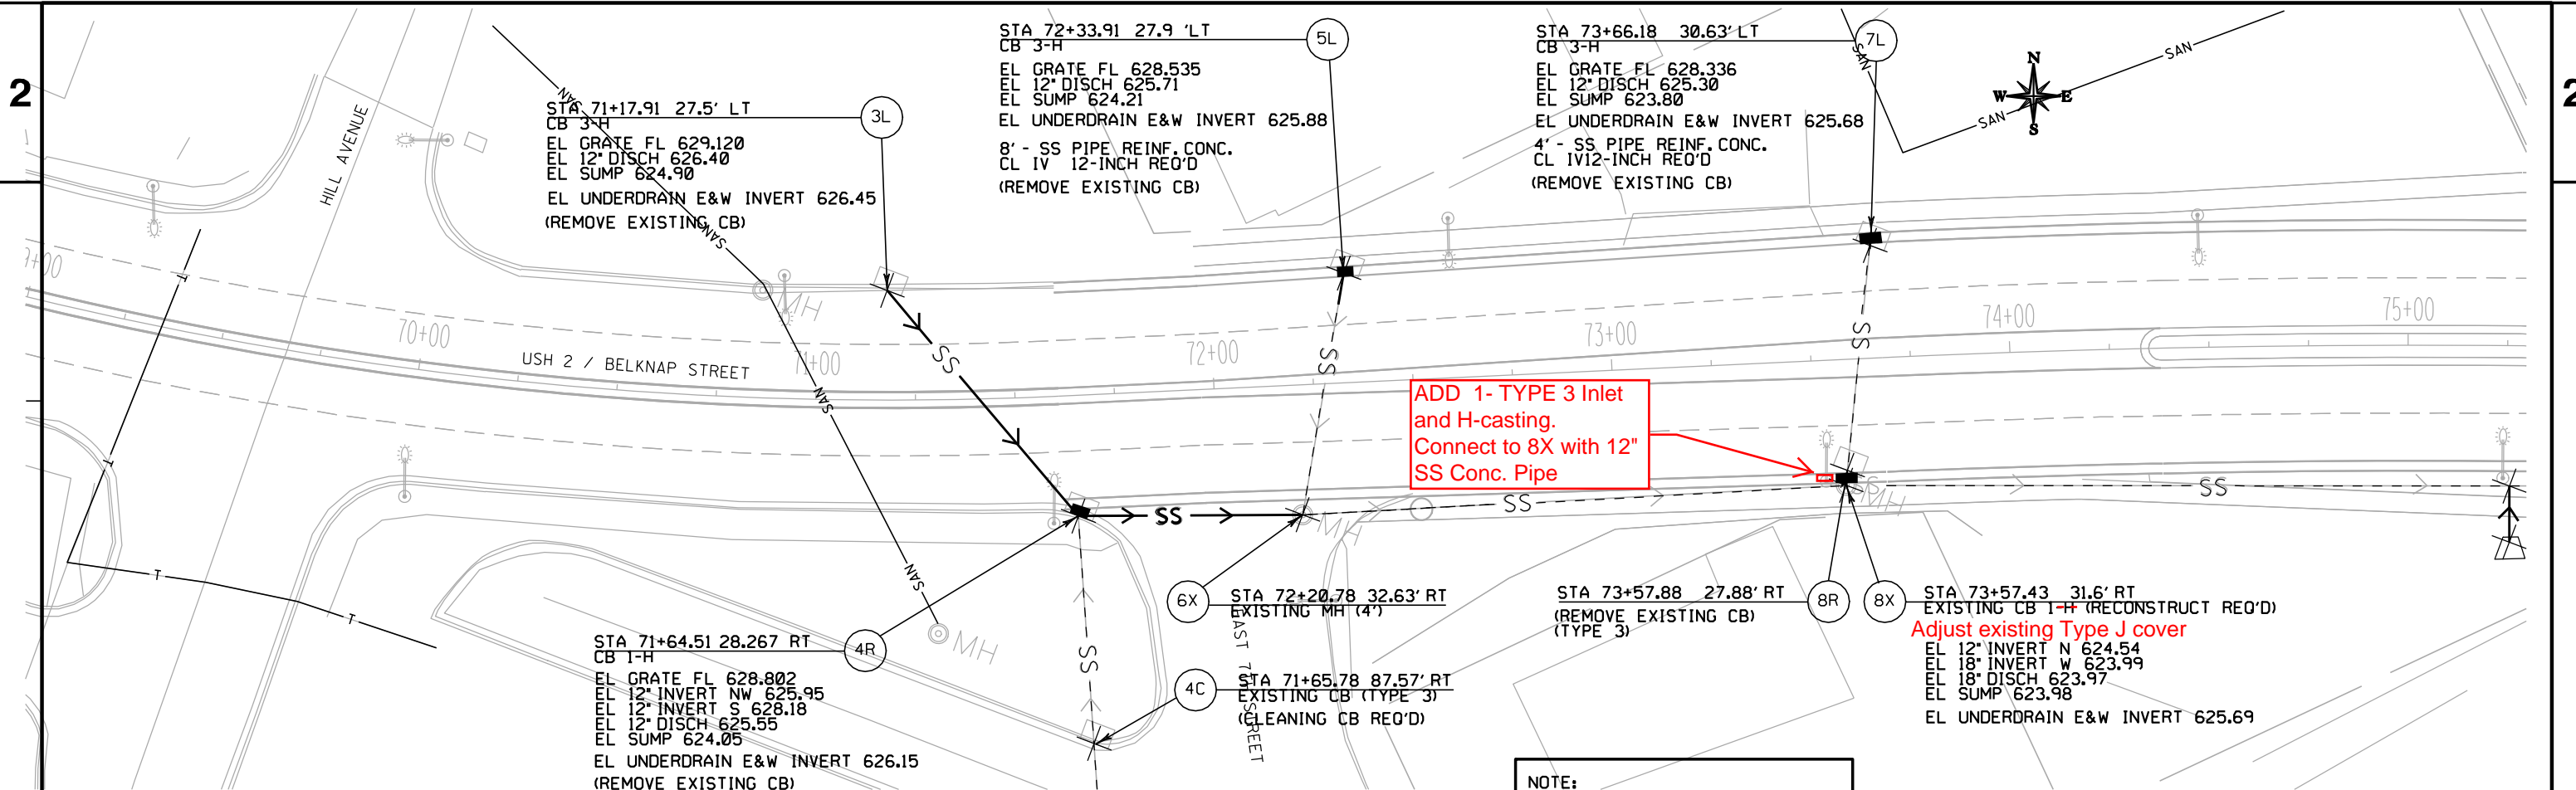



Call 811 3 Work Days Before You Dig  
 or Toll Free (800) 242-8511  
 Hearing Impaired TDD (800) 542-2289  
[www.DiggersHotline.com](http://www.DiggersHotline.com)

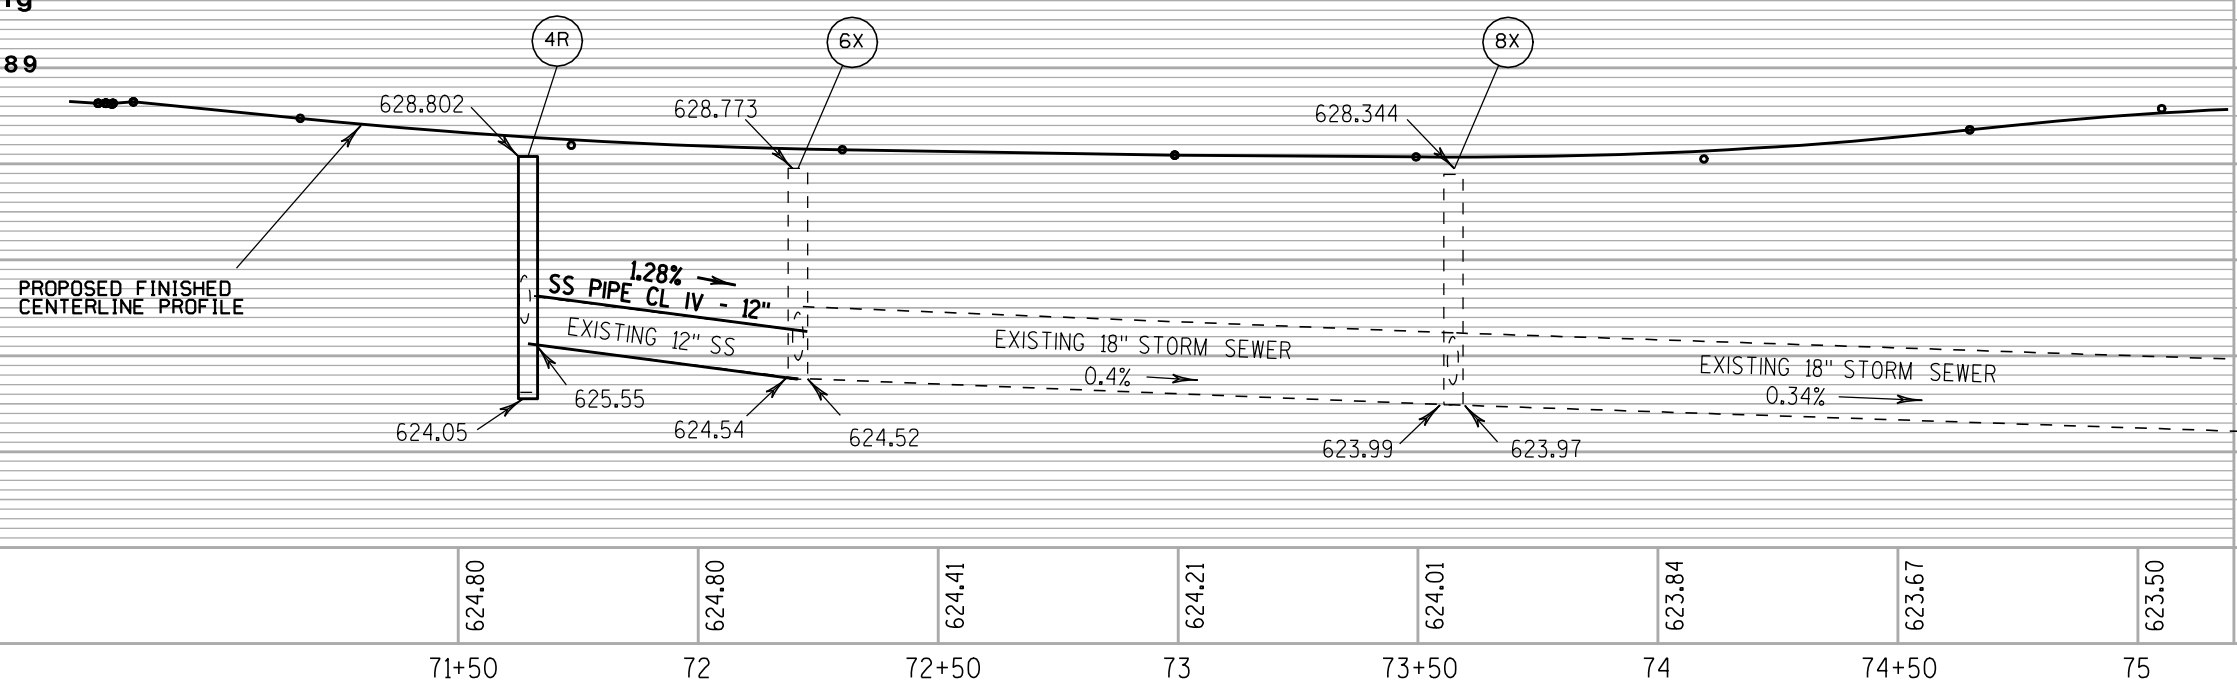

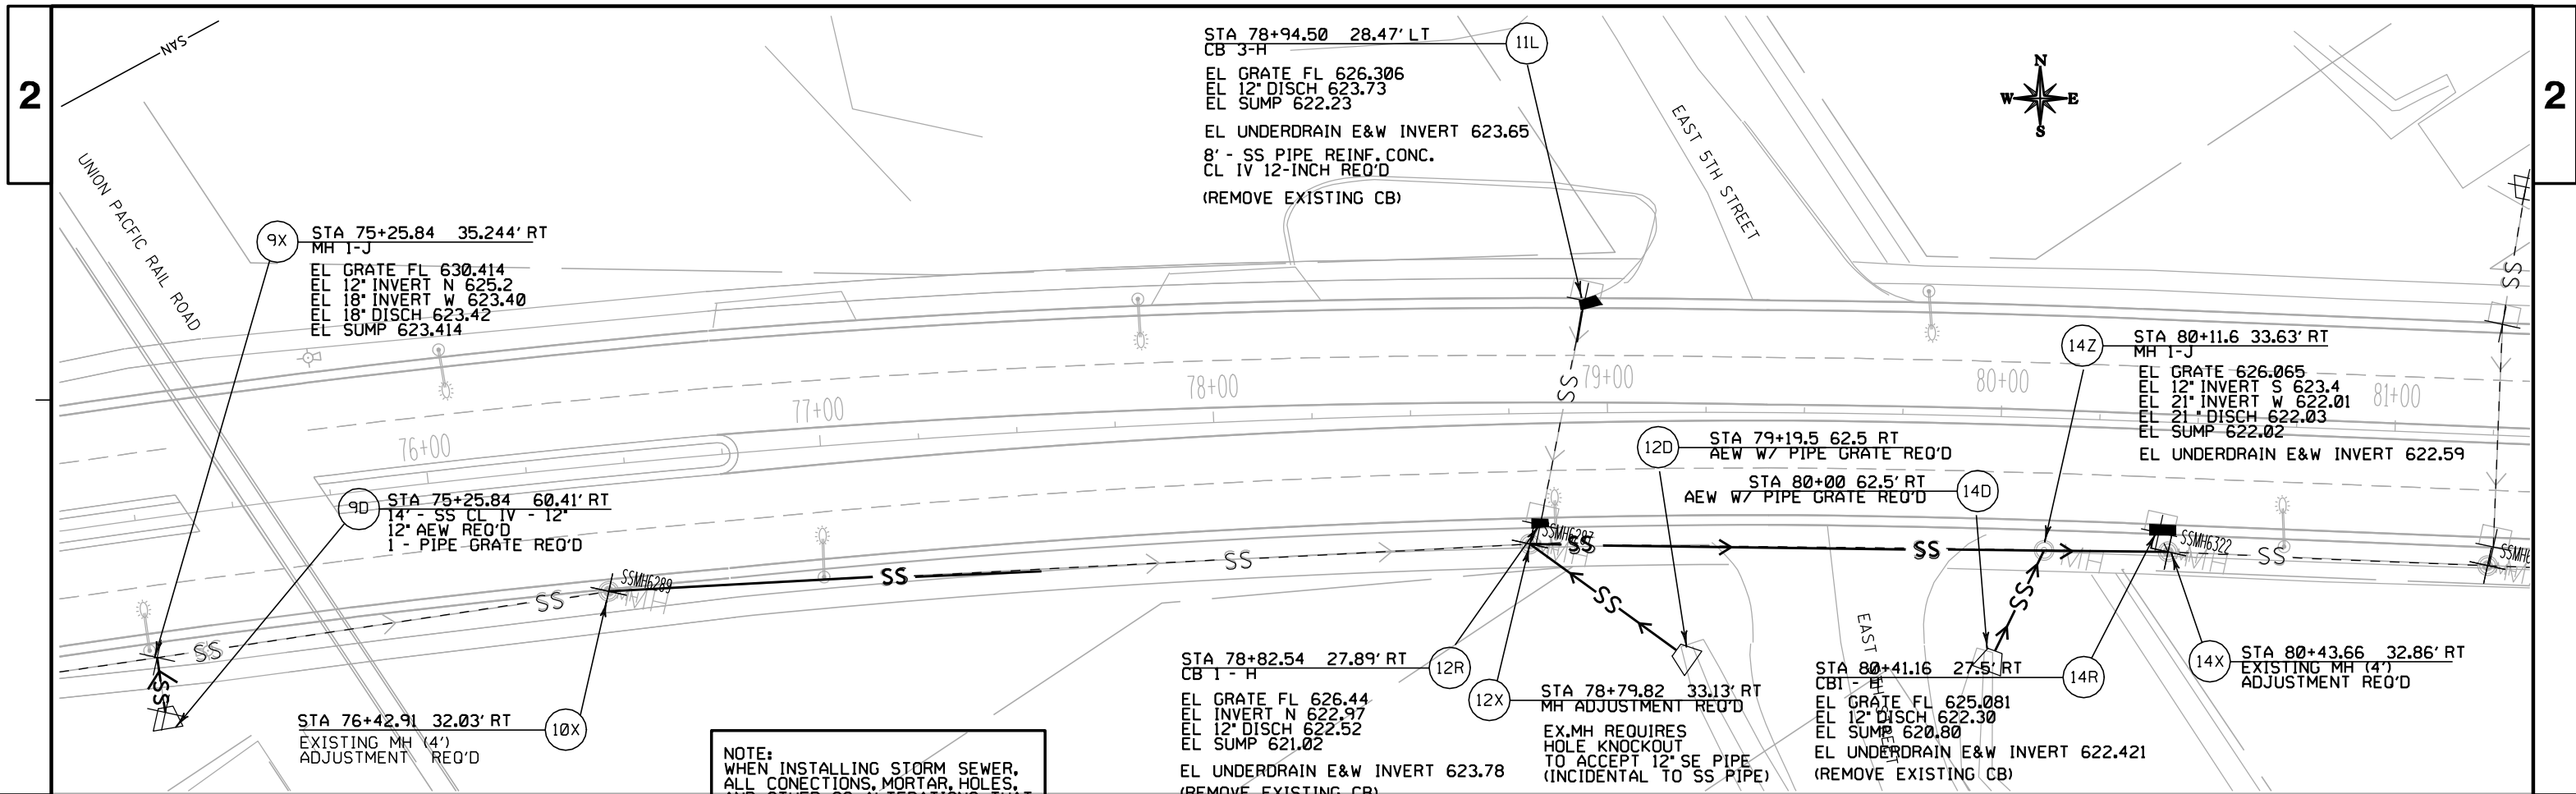


NOTE:  
 WHEN INSTALLING STORM SEWER,  
 ALL CONNECTIONS, MORTAR, HOLES,  
 AND OTHER SS ALTERATIONS THAT  
 ARE NOT ACCOUNTED FOR WITH  
 A BID ITEM ARE INCIDENTAL TO  
 THE ITEM OF STORM SEWER PIPE  
 REINFORCED CONCRETE CLIV.


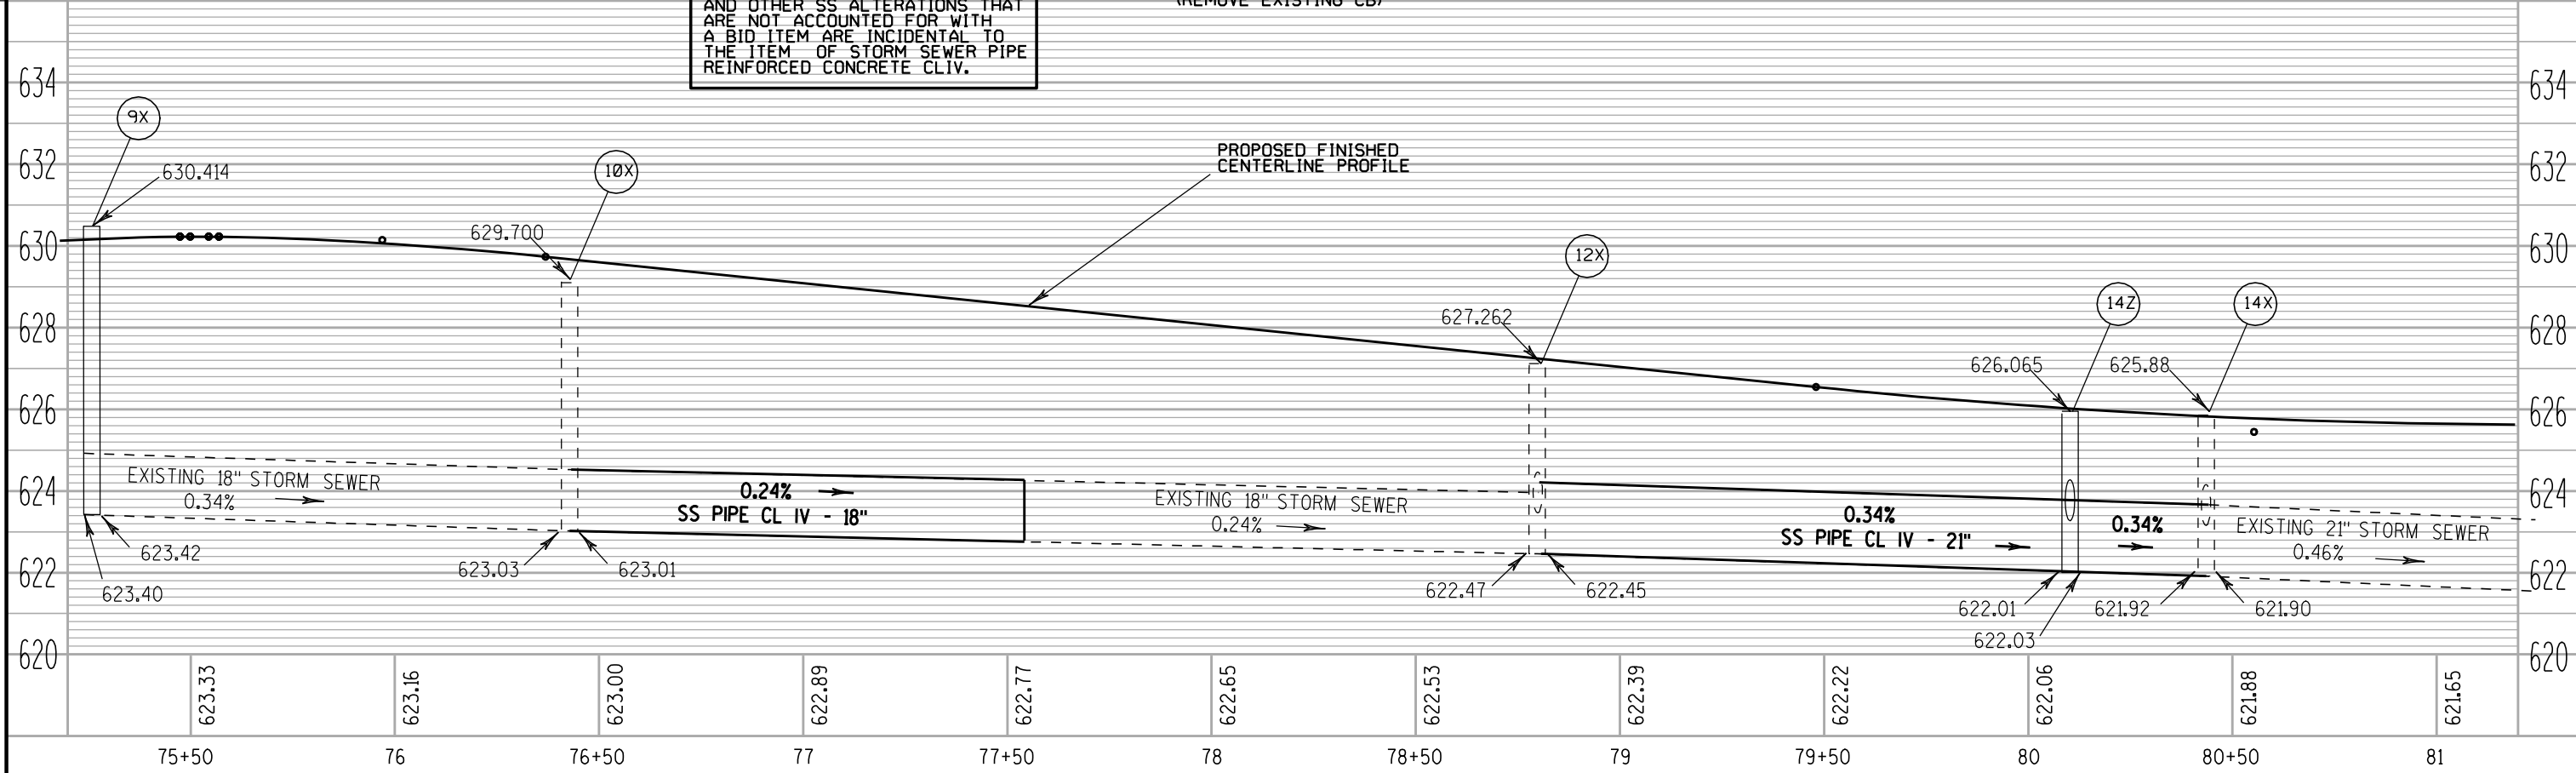


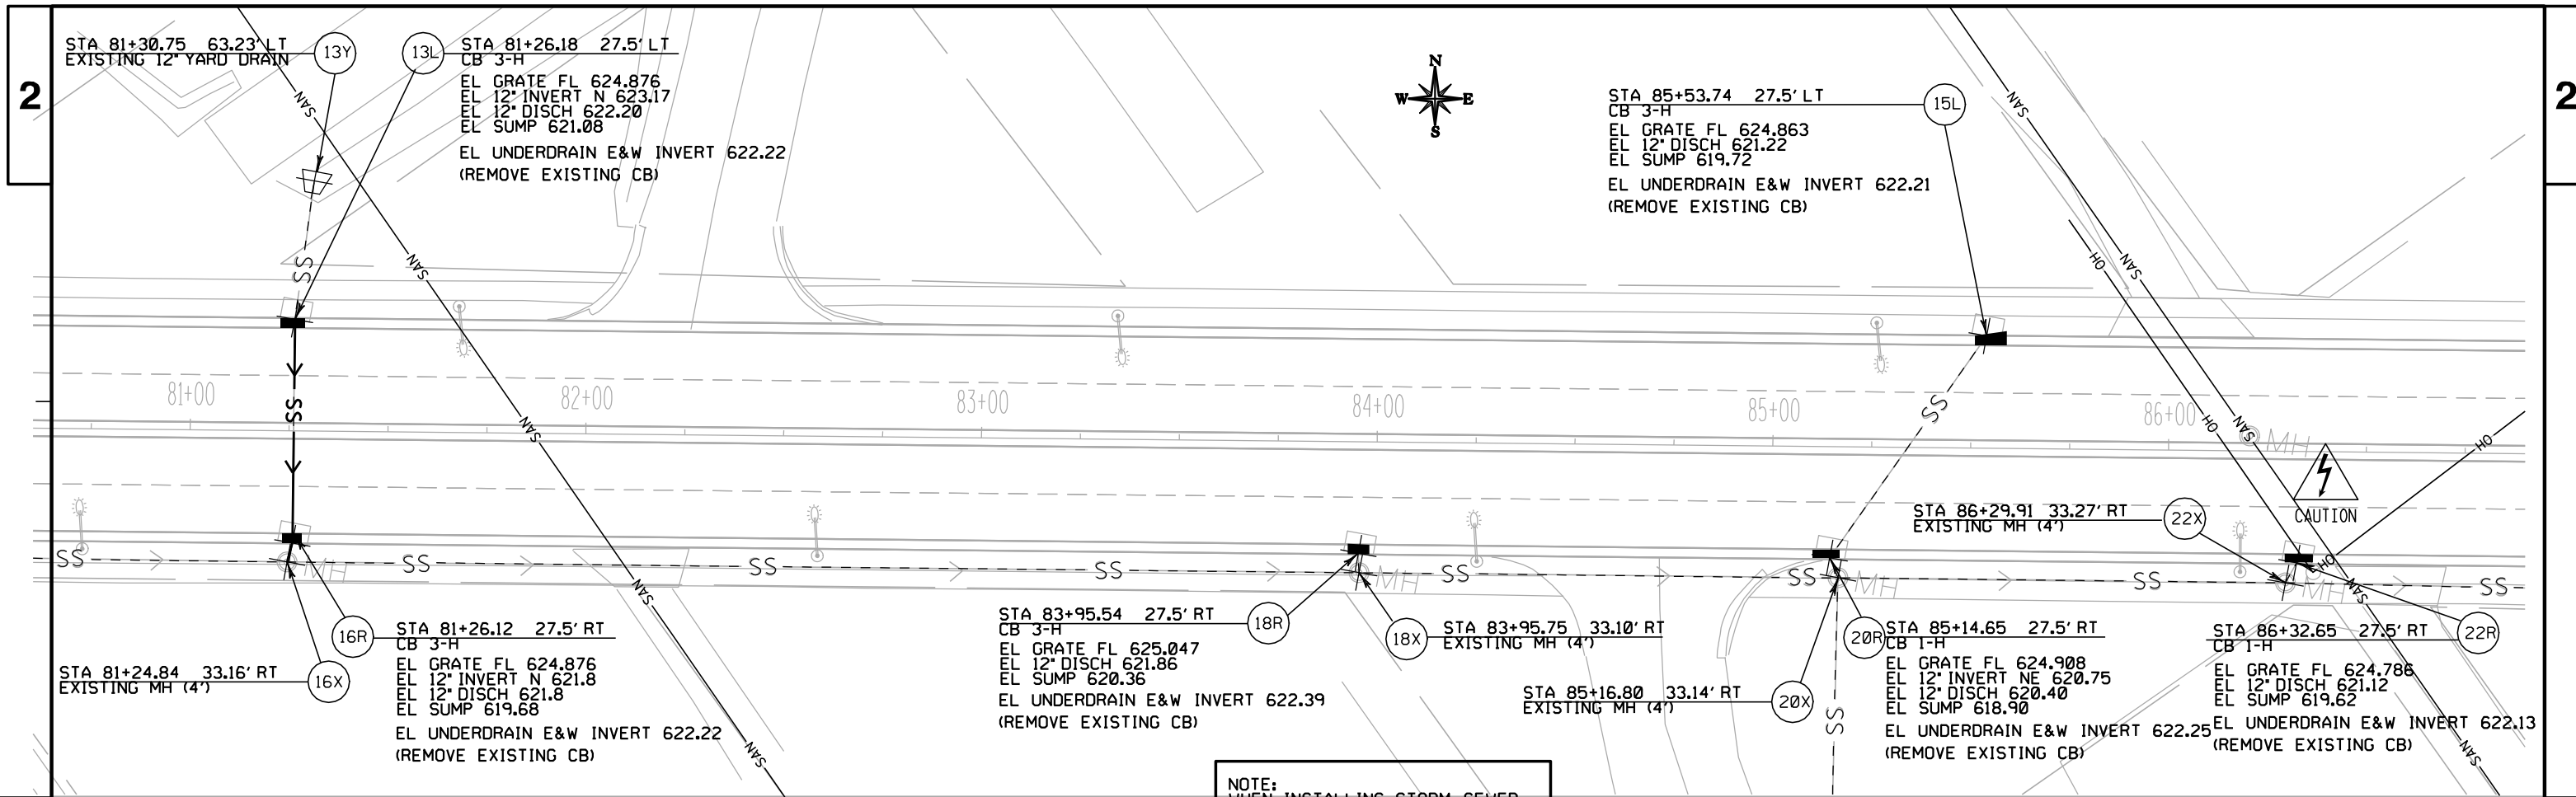


NOTE:  
 WHEN INSTALLING STORM SEWER,  
 ALL CONNECTIONS, MORTAR HOLES,  
 AND OTHER SS ALTERATIONS THAT  
 ARE NOT ACCOUNTED FOR WITH  
 A BID ITEM ARE INCIDENTAL TO  
 THE ITEM OF STORM SEWER PIPE  
 REINFORCED CONCRETE CLIV.

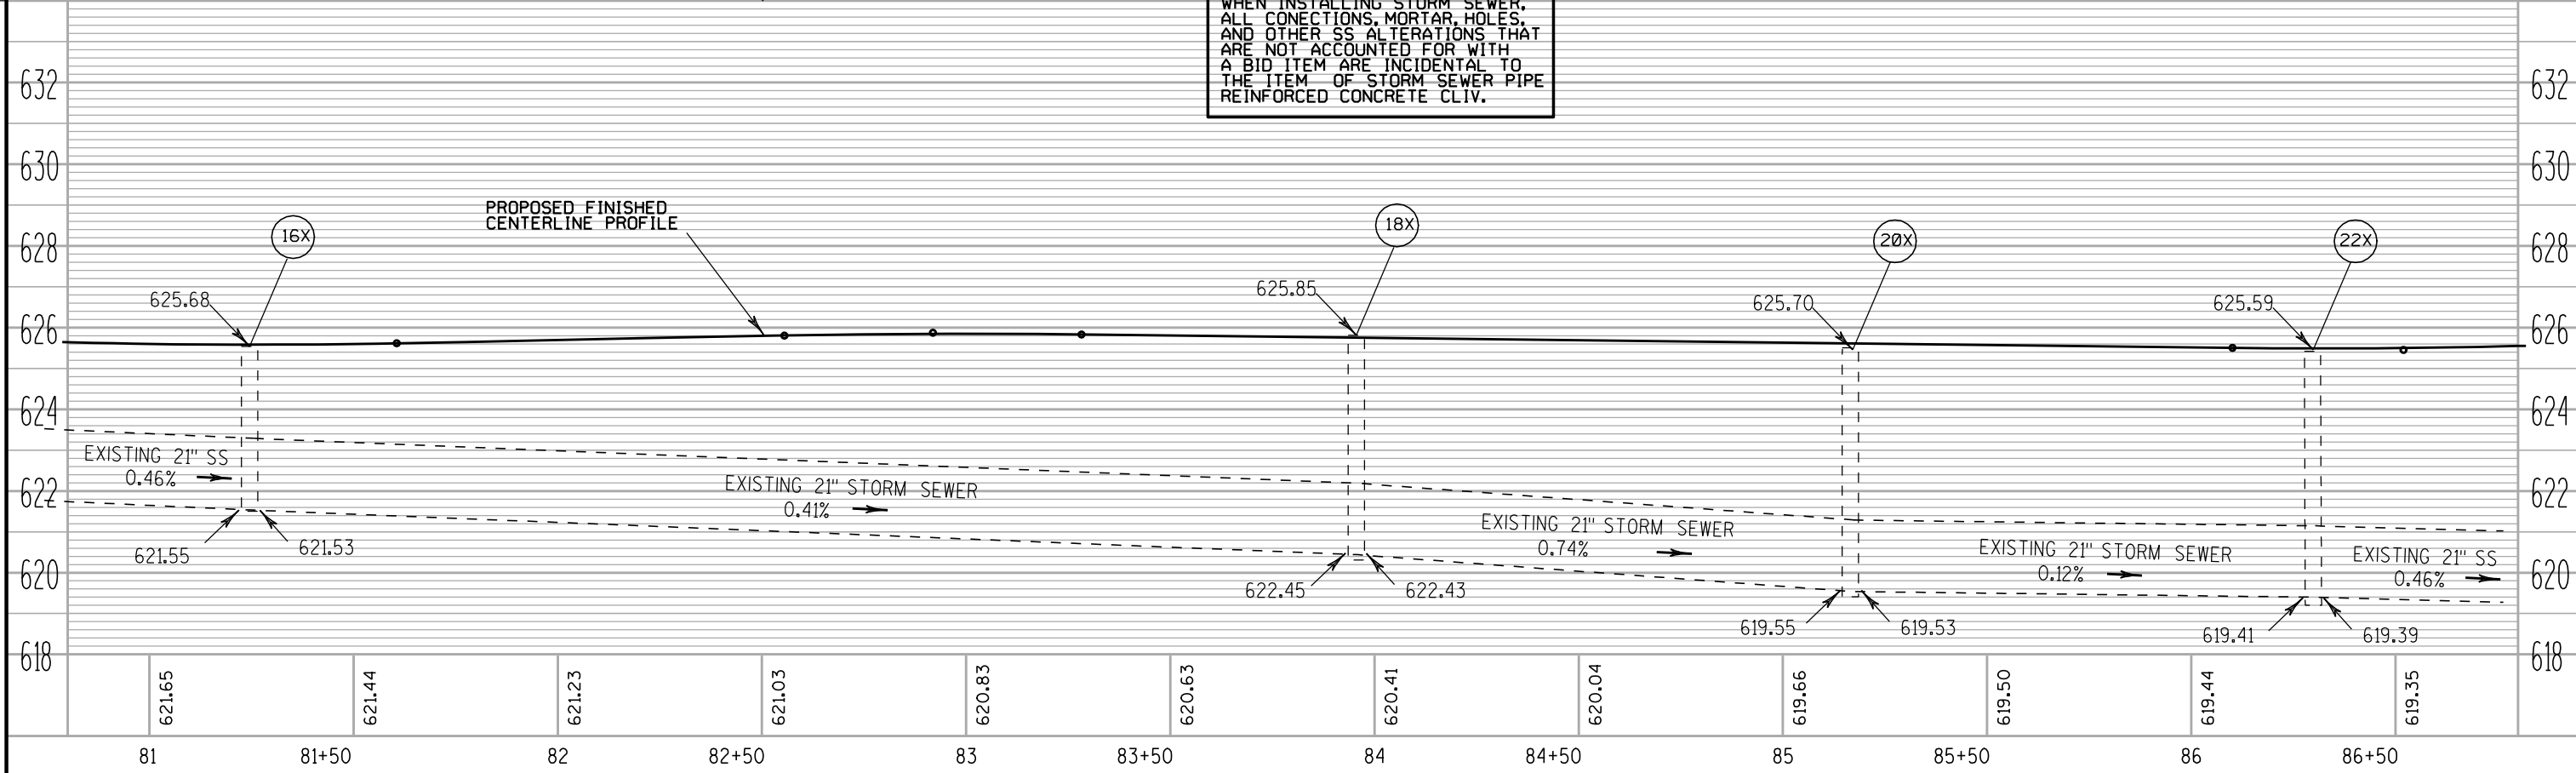


PROJECT NO: 1190-44-71      HWY: USH 2 (BELKNAP ST)      COUNTY: DOUGLAS      STORM SEWER DETAILS      SHEET      E

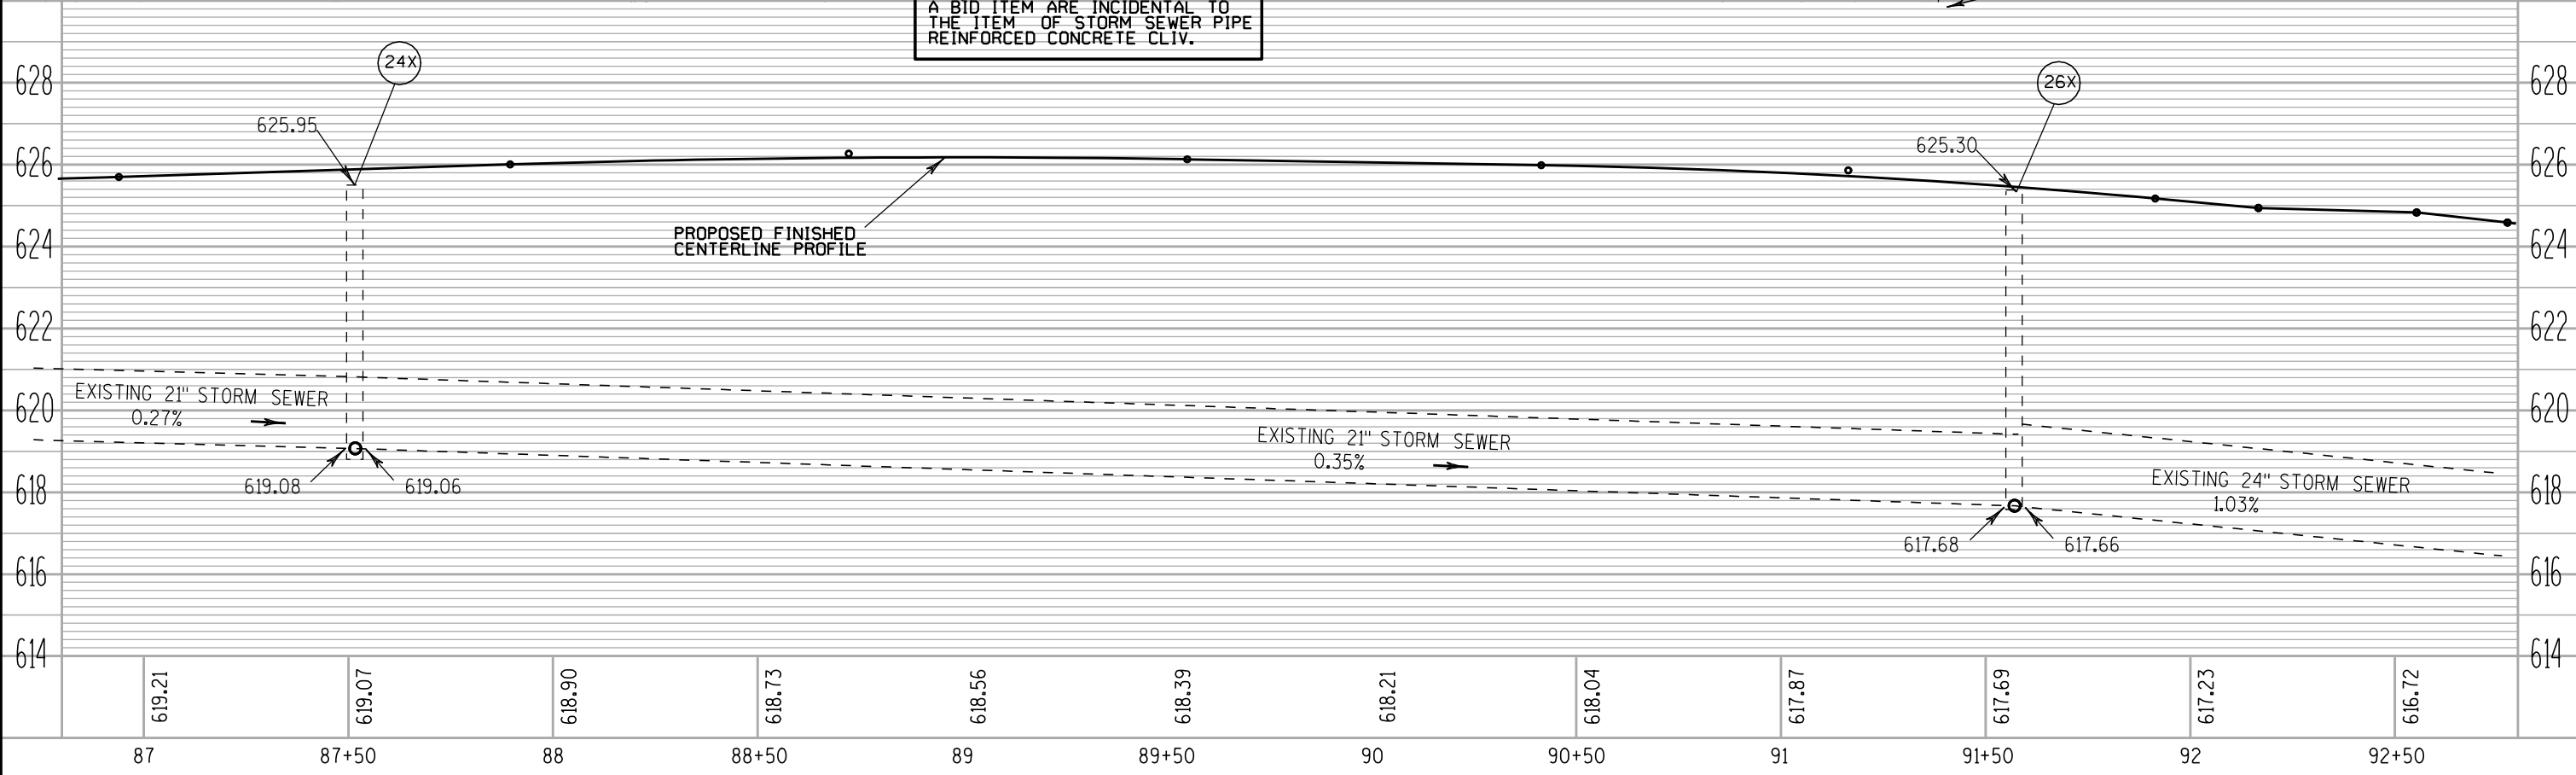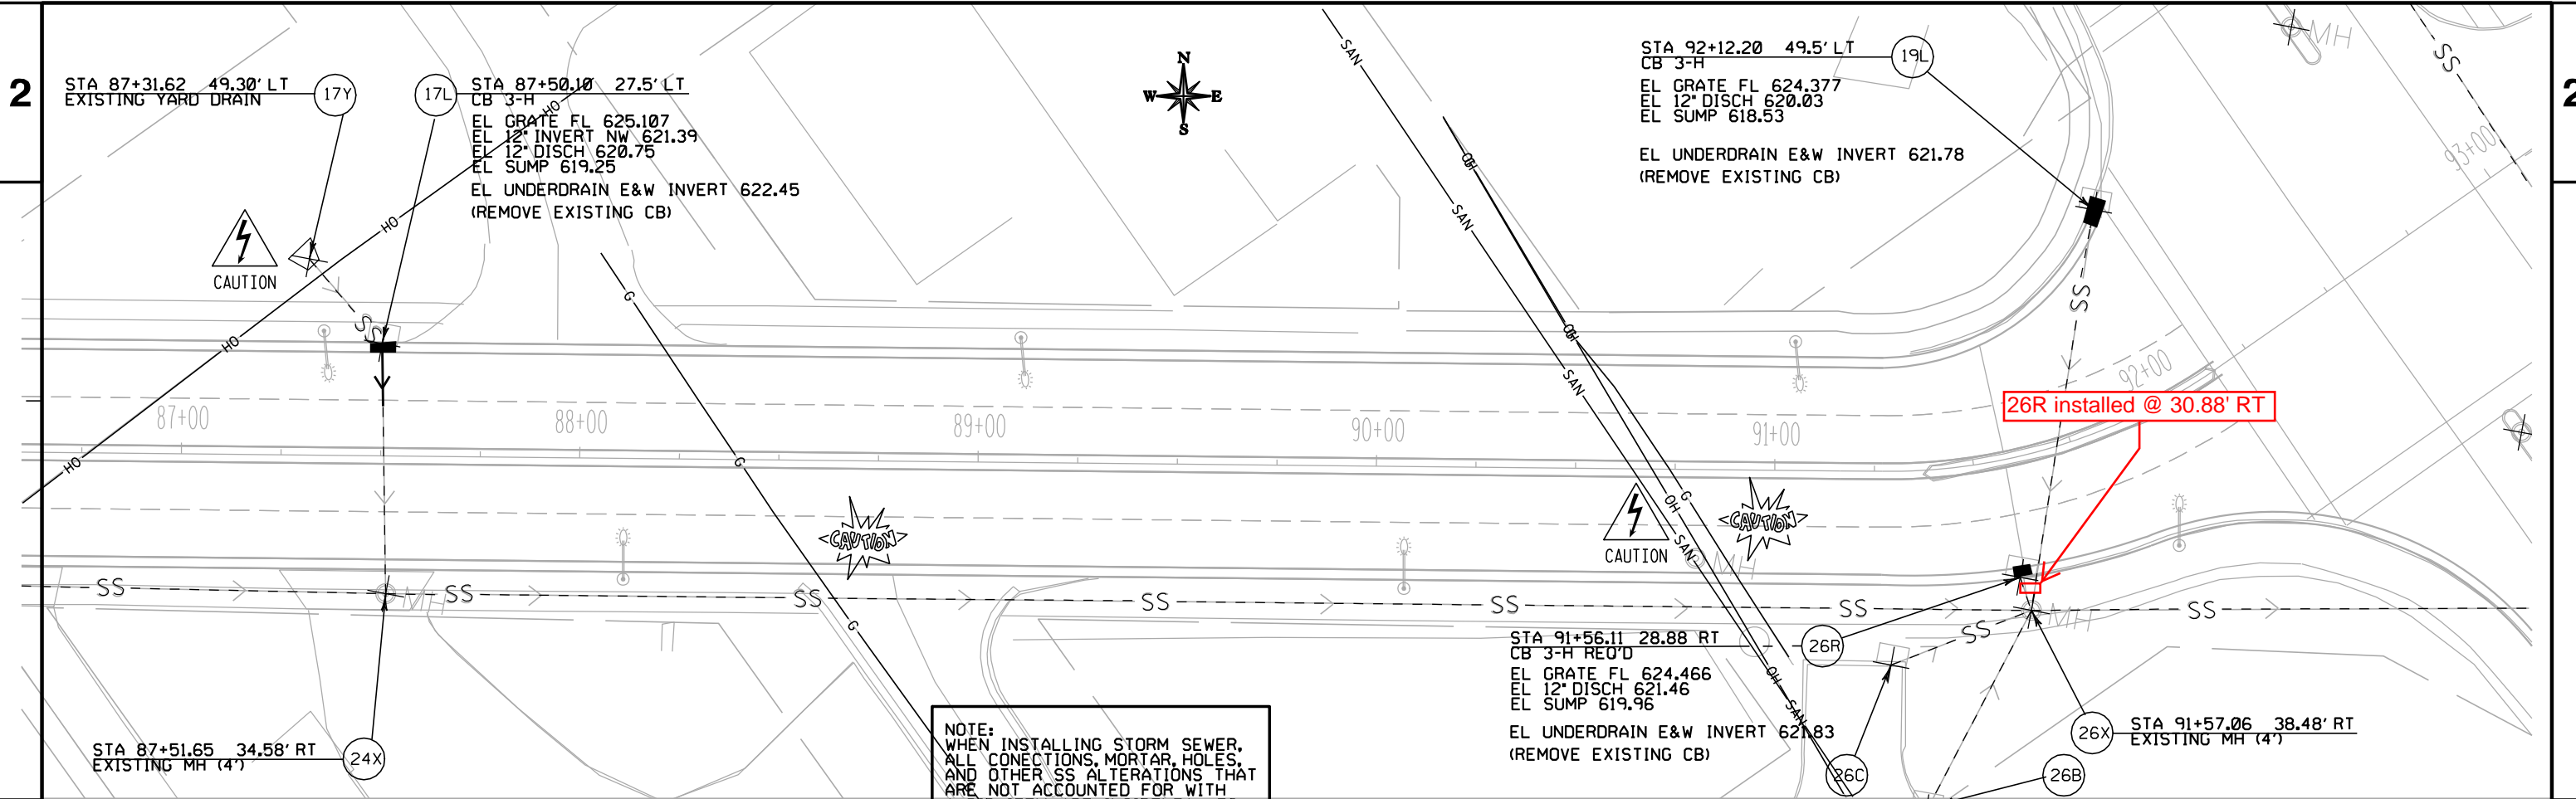


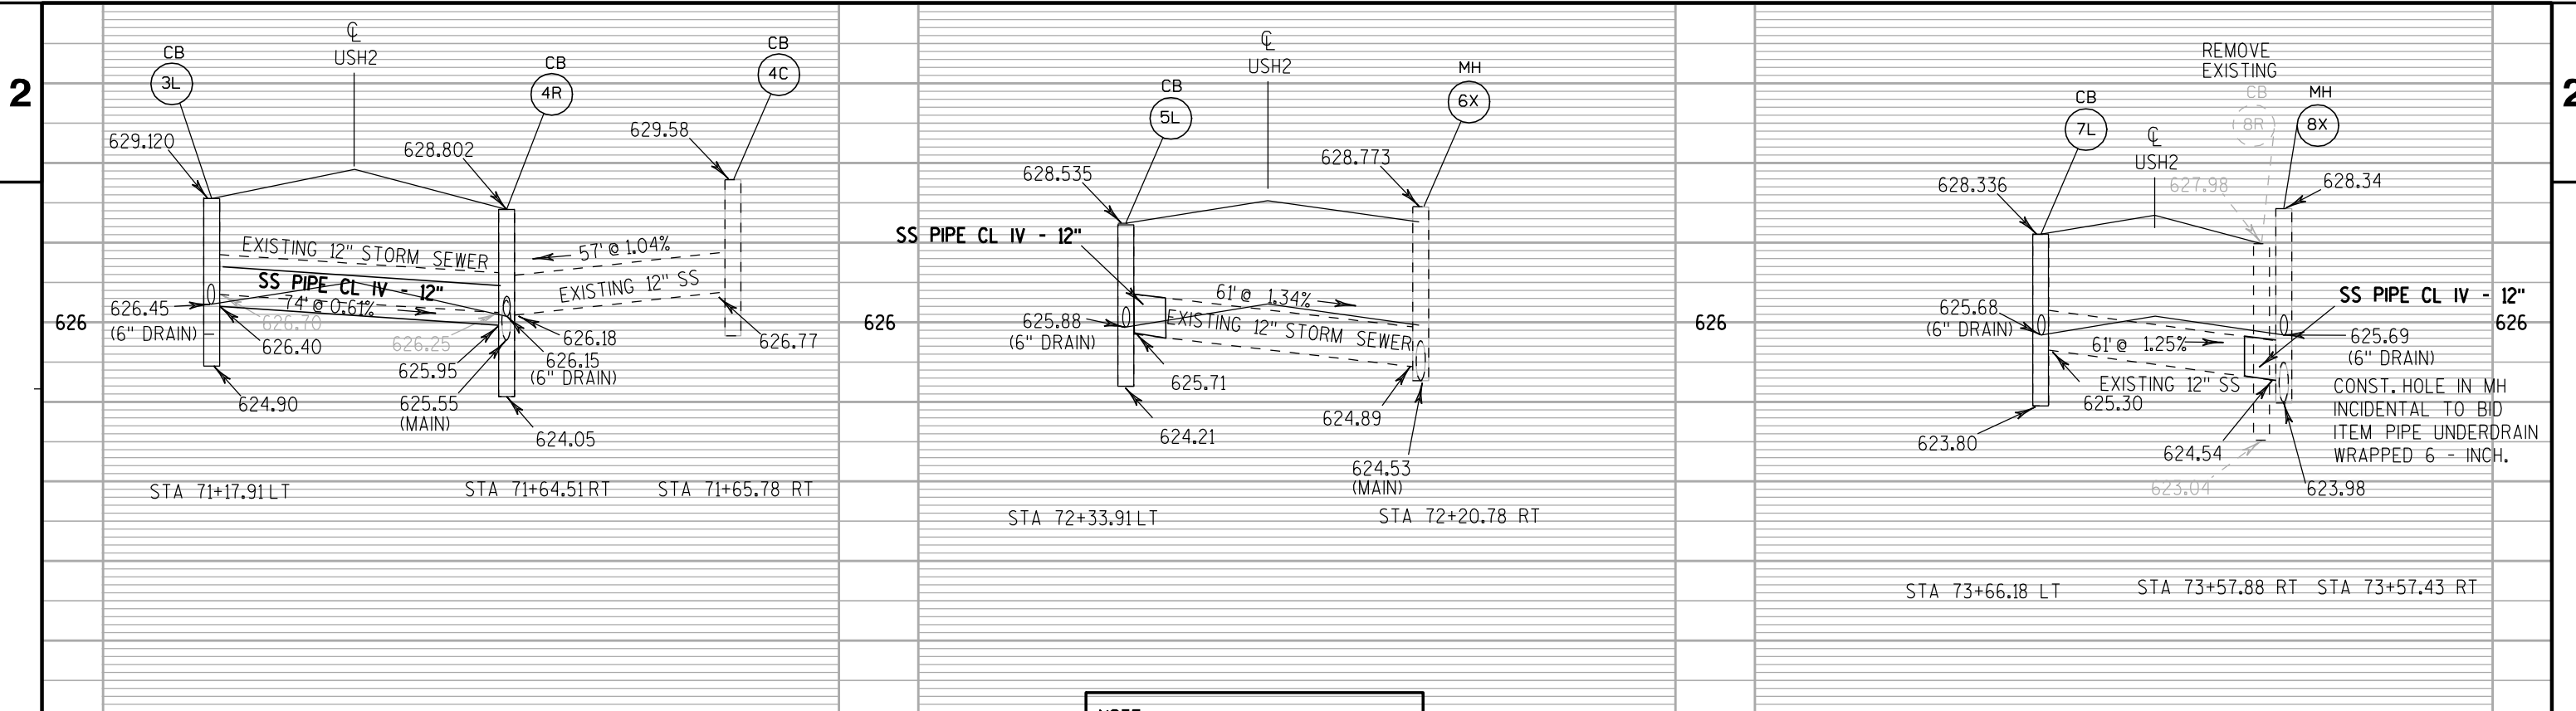


**NOTE:**  
 WHEN INSTALLING STORM SEWER,  
 ALL CONNECTIONS, MORTAR, HOLES,  
 AND OTHER SS ALTERATIONS THAT  
 ARE NOT ACCOUNTED FOR WITH  
 A BID ITEM ARE INCIDENTAL TO  
 THE ITEM OF STORM SEWER PIPE  
 REINFORCED CONCRETE CLIV.

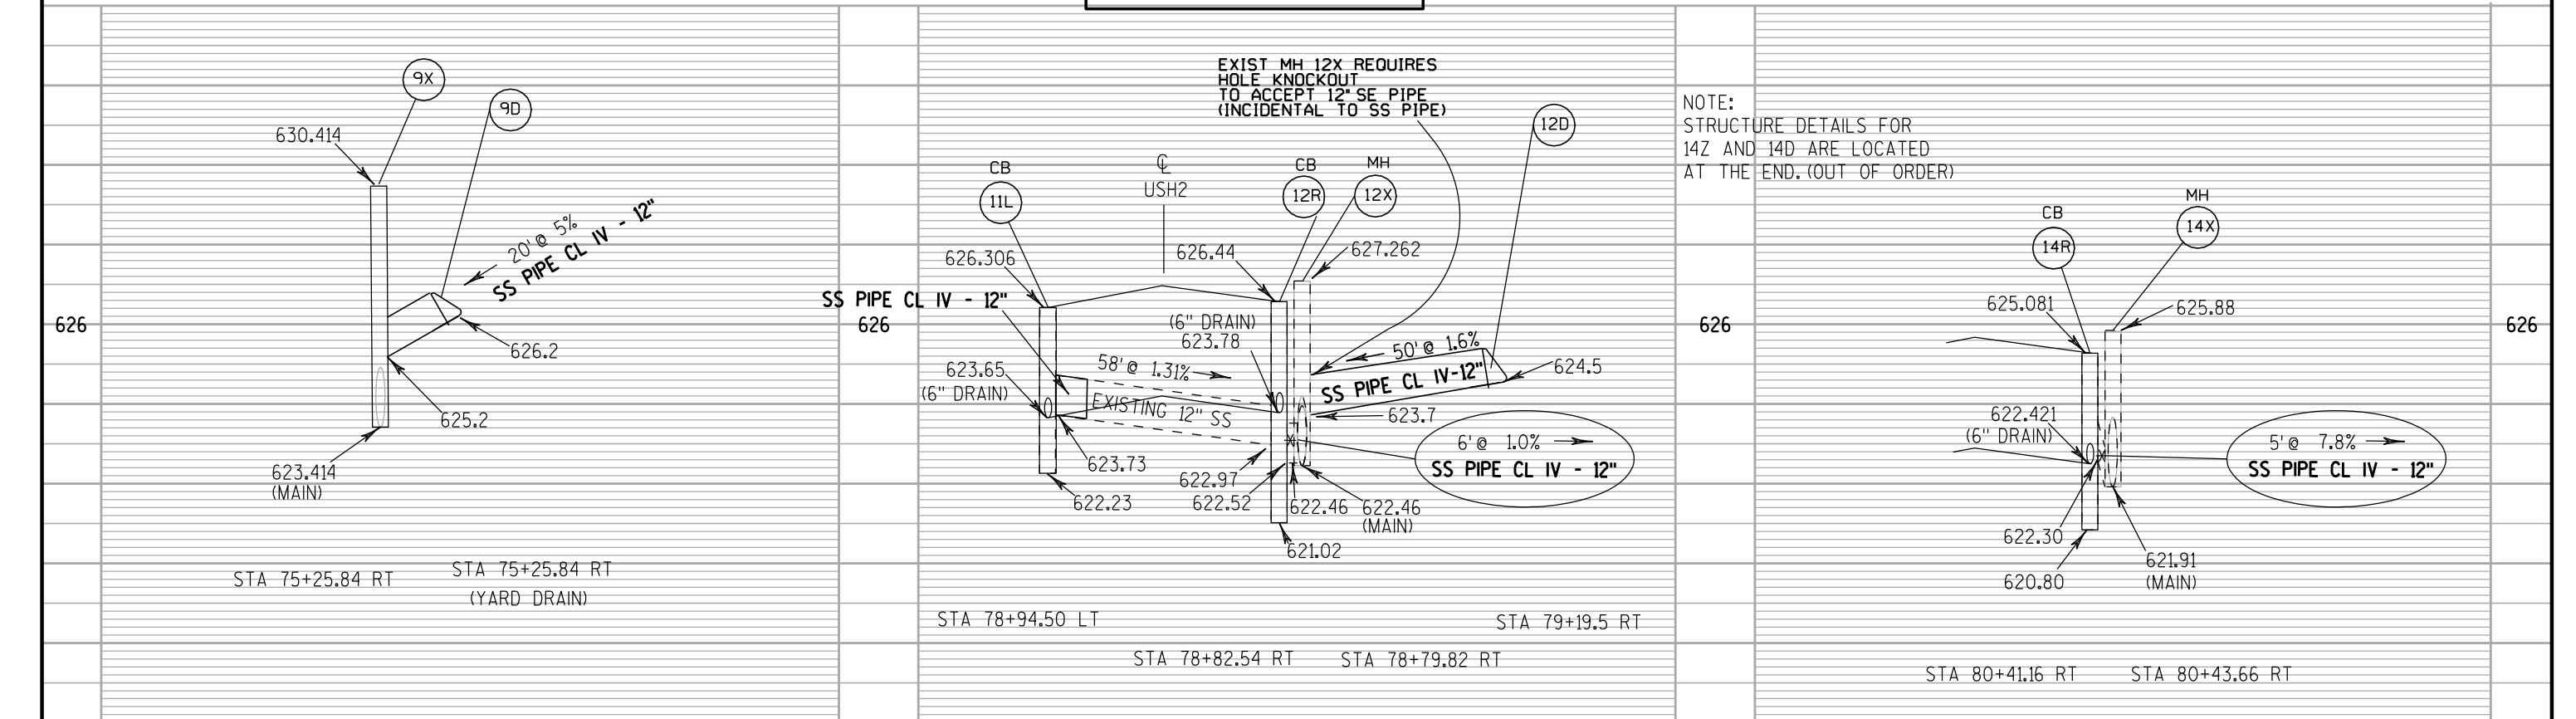


**NOTE:**  
 STRUCTURE DETAILS FOR  
 14Z AND 14D ARE LOCATED  
 AT THE END. (OUT OF ORDER)

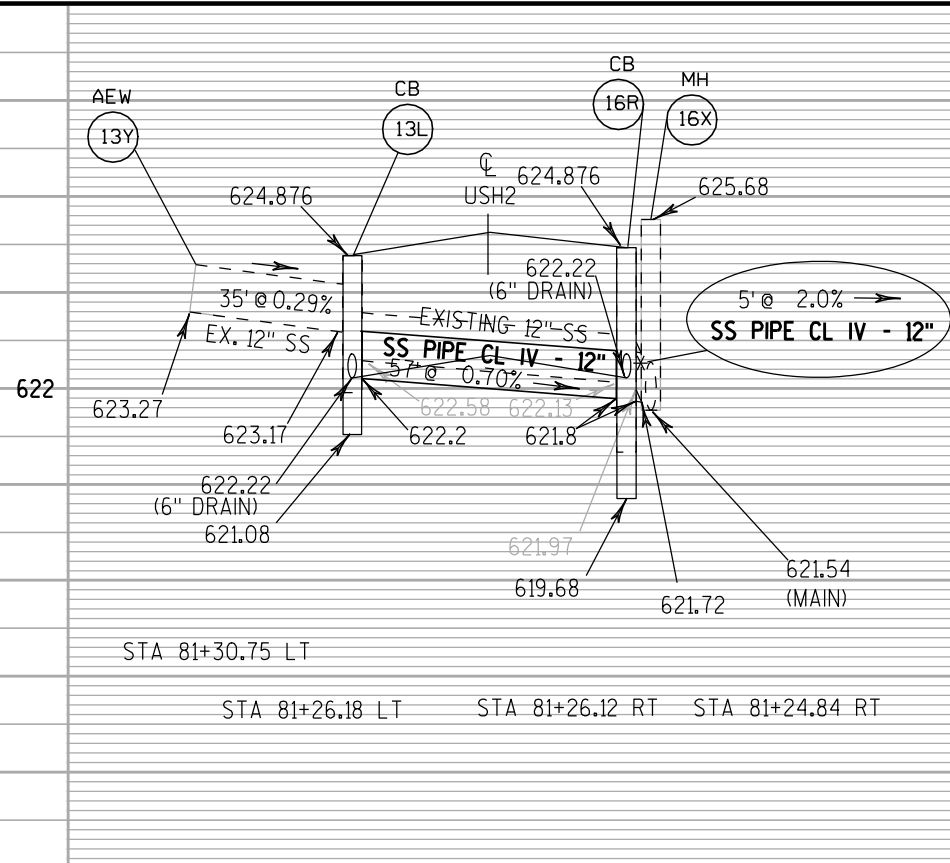

622

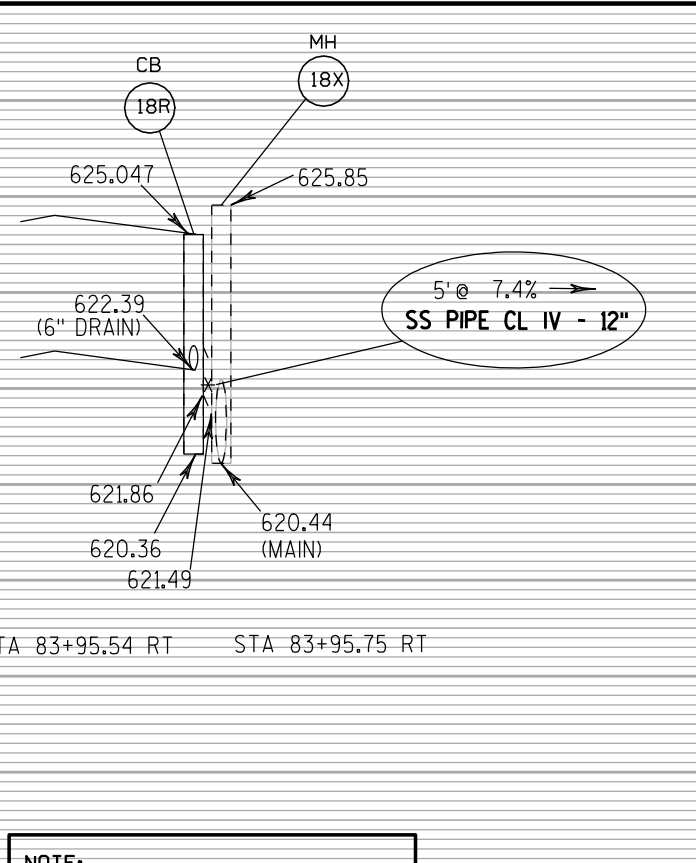


622

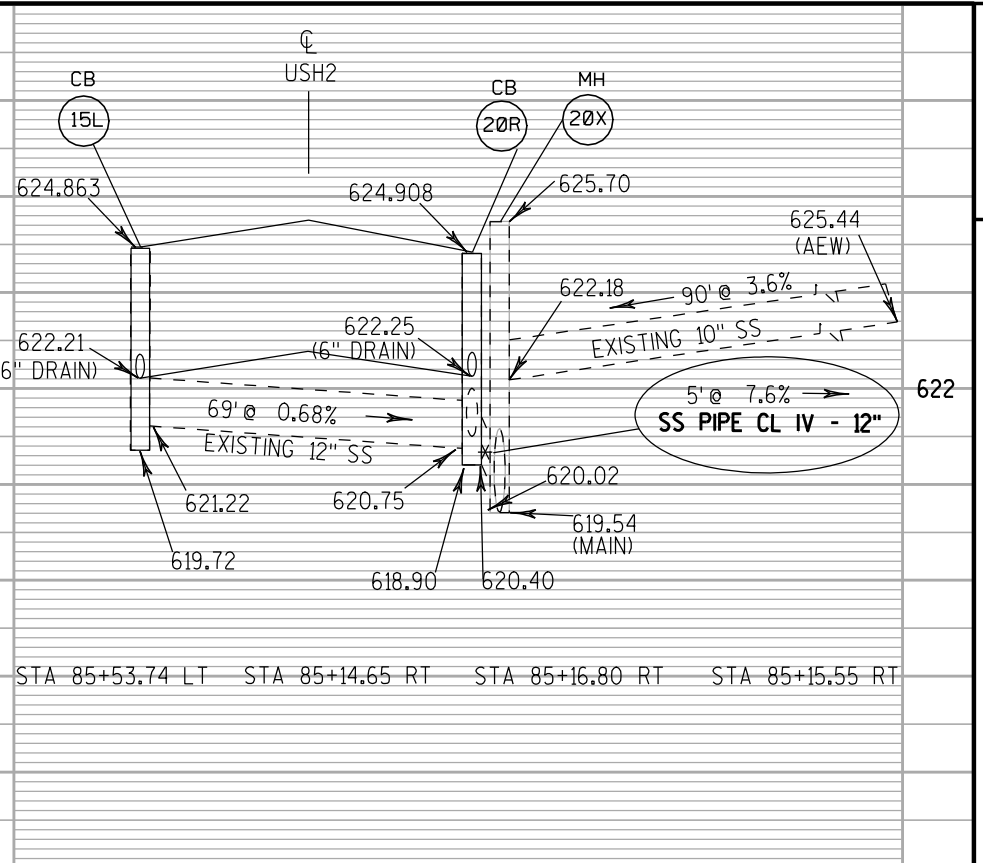


622


**NOTE:**  
 WHEN INSTALLING STORM SEWER,  
 ALL CONNECTIONS, MORTAR, HOLES,  
 AND OTHER SS ALTERATIONS THAT  
 ARE NOT ACCOUNTED FOR WITH  
 A BID ITEM ARE INCIDENTAL TO  
 THE ITEM OF STORM SEWER PIPE  
 REINFORCED CONCRETE CLIV.

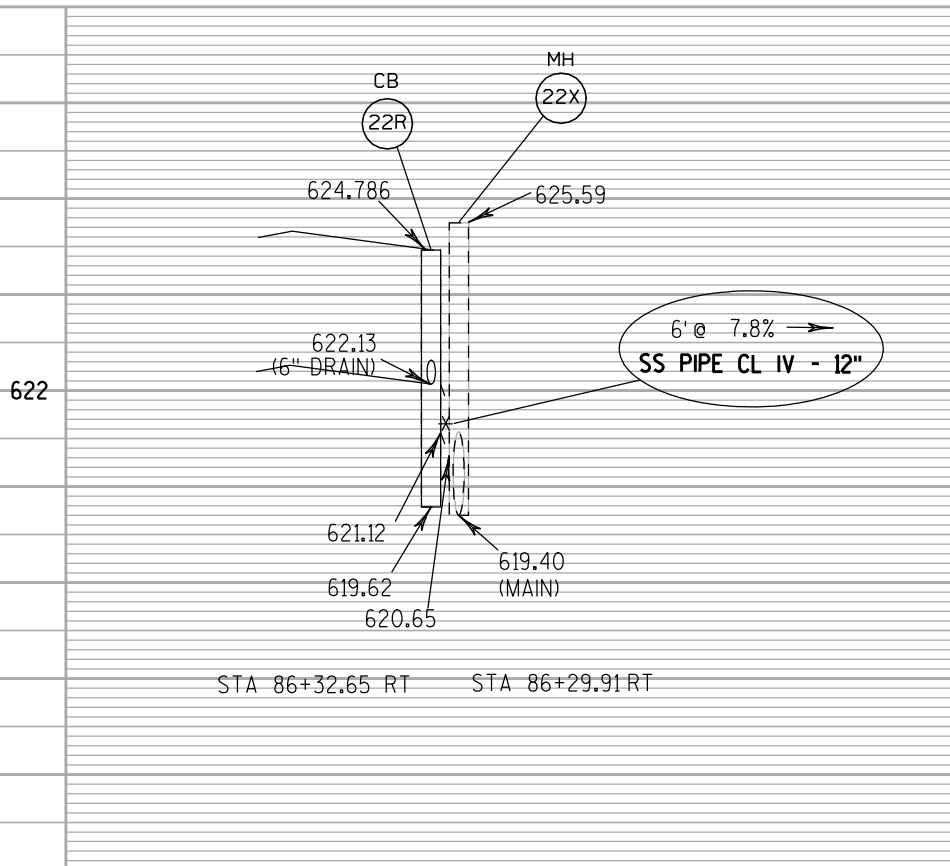


622

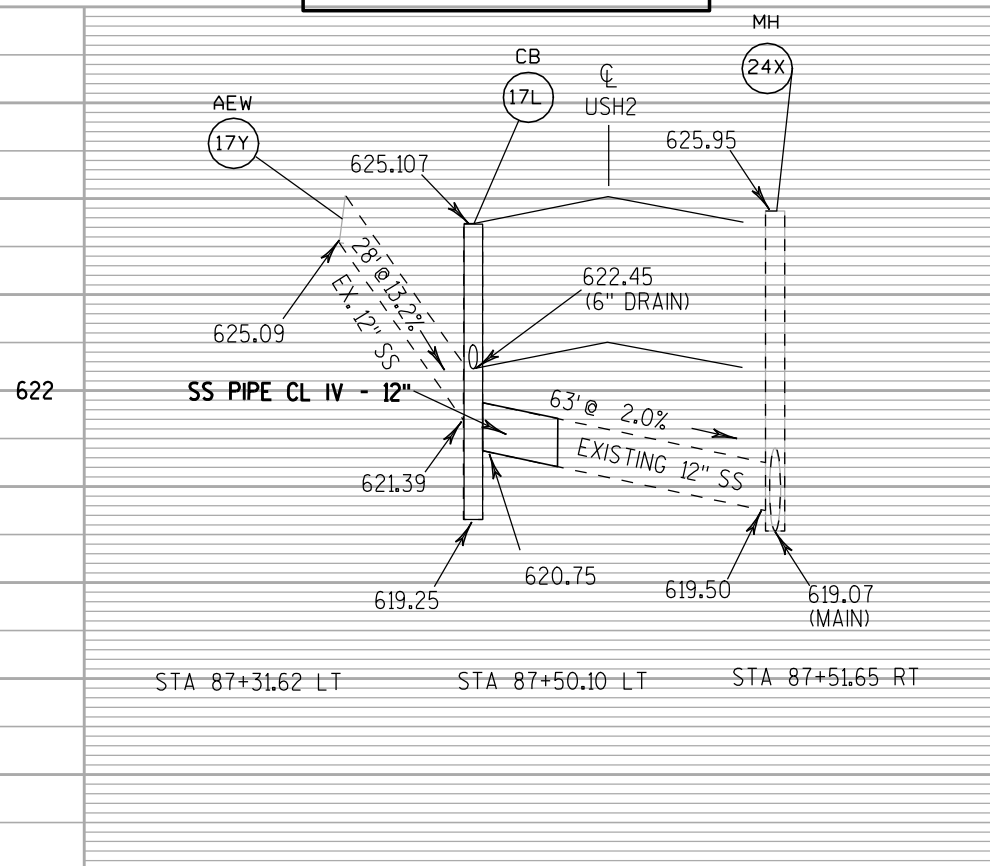

622

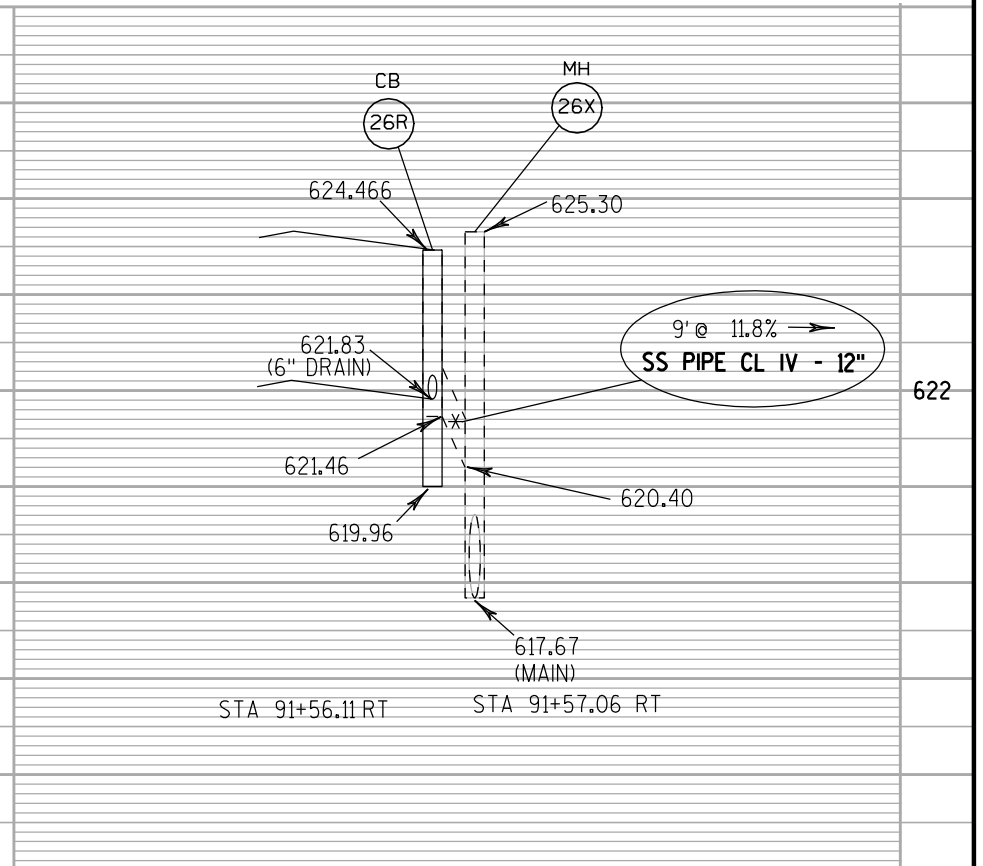


622

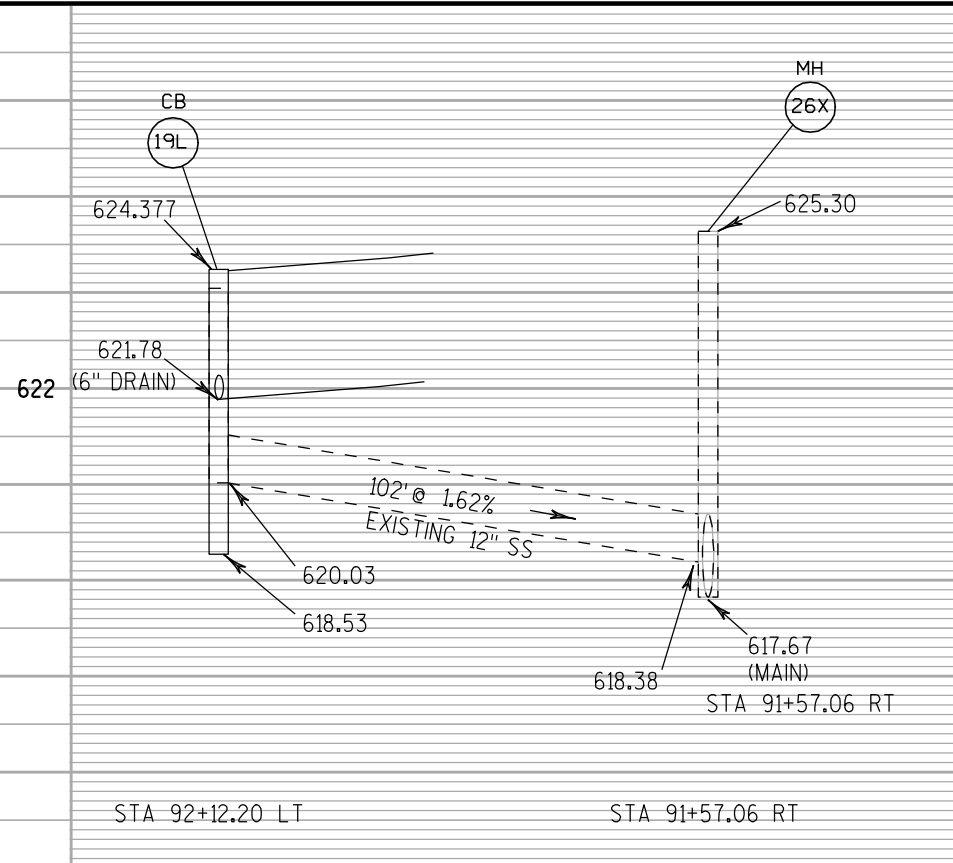


622

626

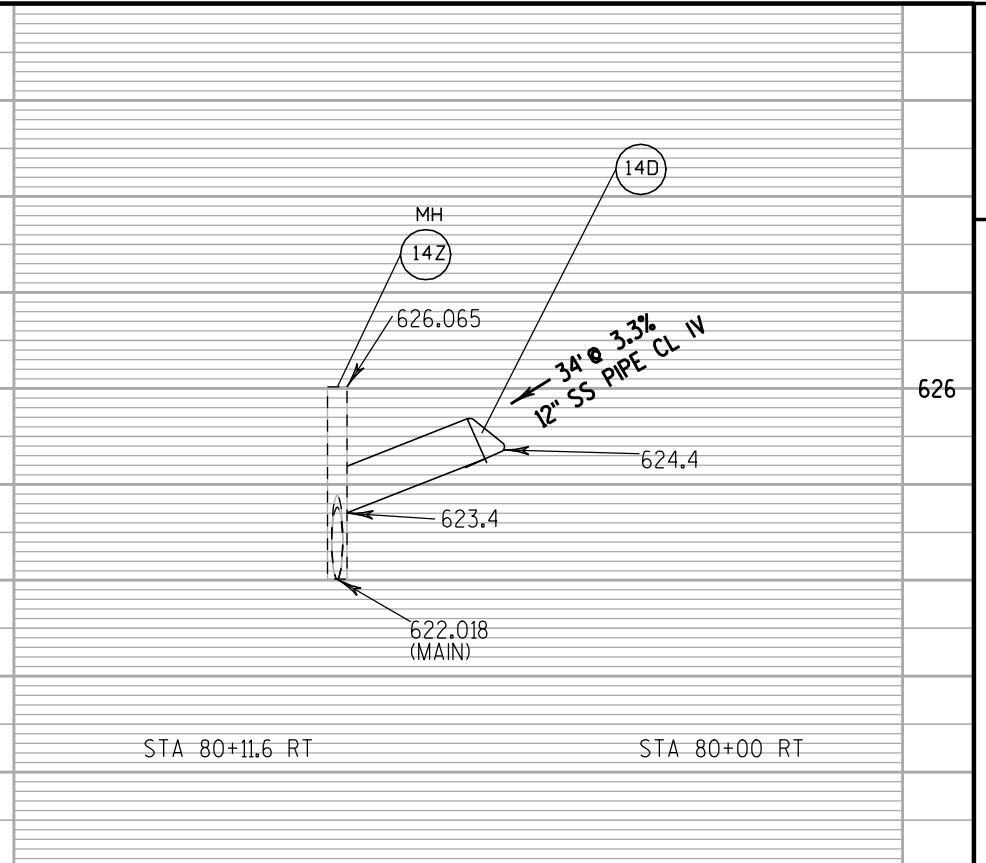

626

**NOTE:**  
 WHEN INSTALLING STORM SEWER,  
 ALL CONNECTIONS, MORTAR, HOLES,  
 AND OTHER SS ALTERATIONS THAT  
 ARE NOT ACCOUNTED FOR WITH  
 A BID ITEM ARE INCIDENTAL TO  
 THE ITEM OF STORM SEWER PIPE  
 REINFORCED CONCRETE CLIV.

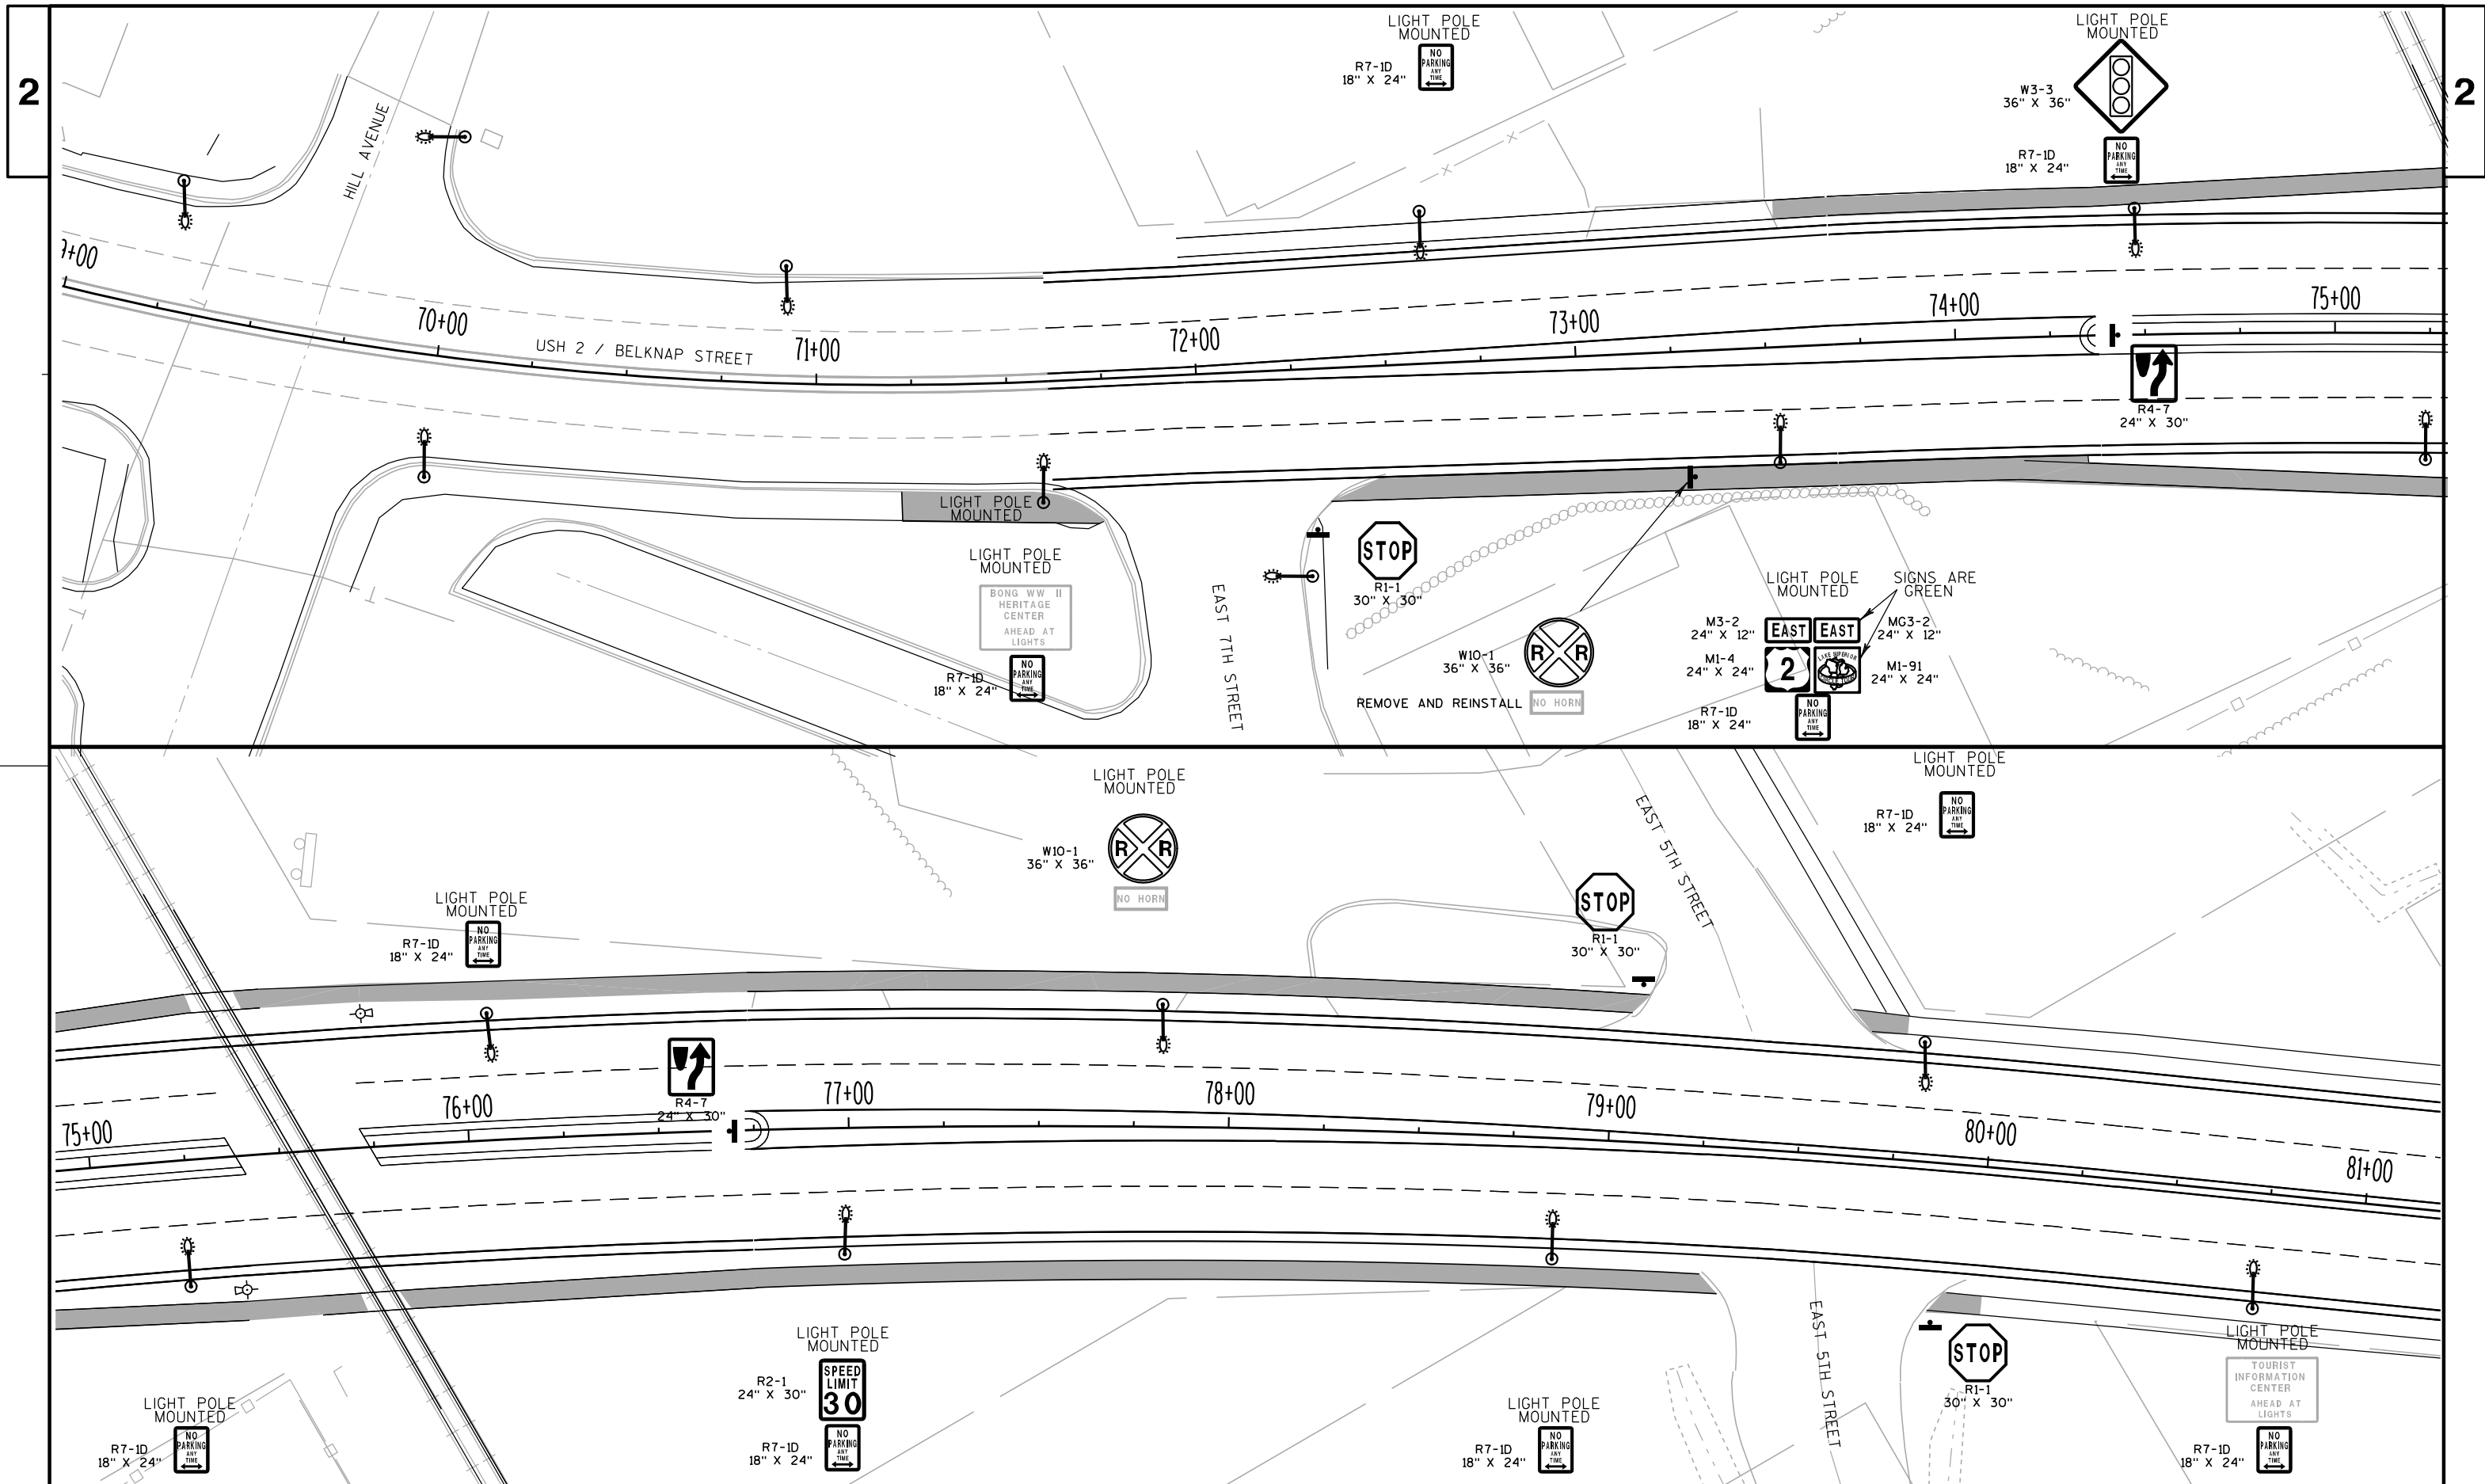

PROJECT NO: 1190-44-71

HWY: USH 2 (BELKNAP ST.)


COUNTY: DOUGLAS

PERMANENT SIGNING PLAN

SHEET

E



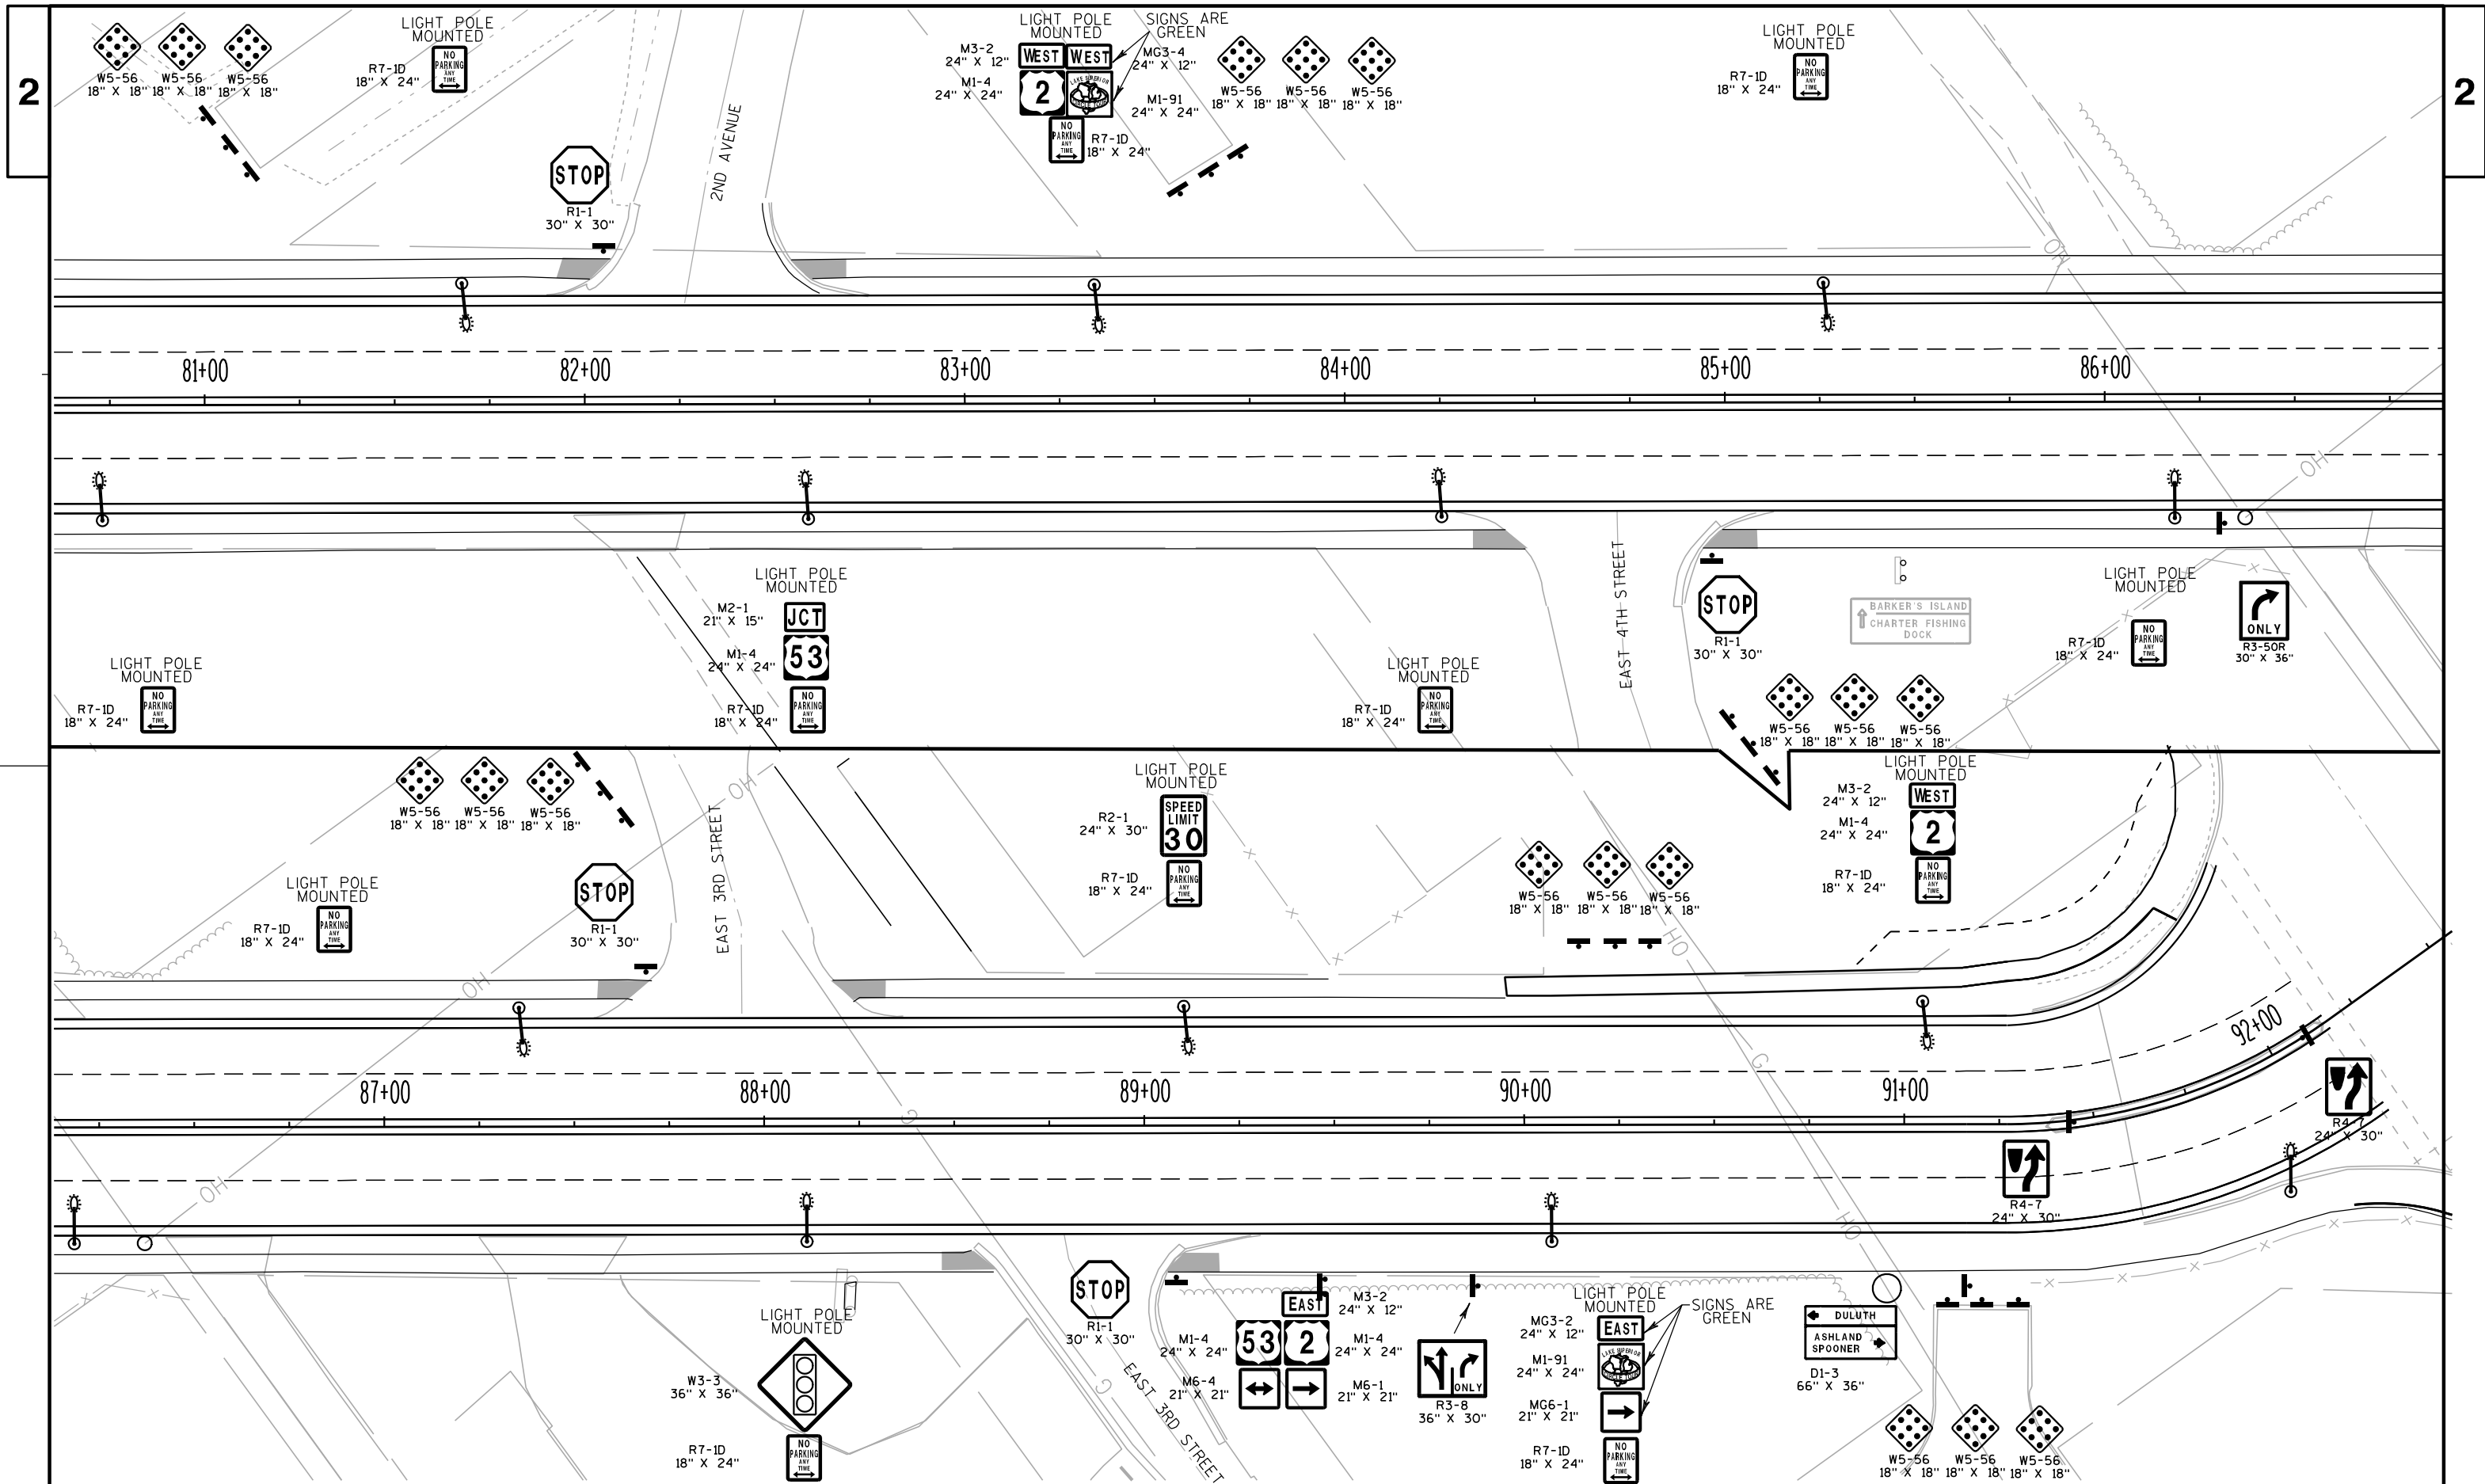

PROJECT NO: 1190-44-71


HWY: USH2 (BELKNAP ST)


COUNTY: DOUGLAS


PERMANENT SIGNING PLAN

SHEET

E

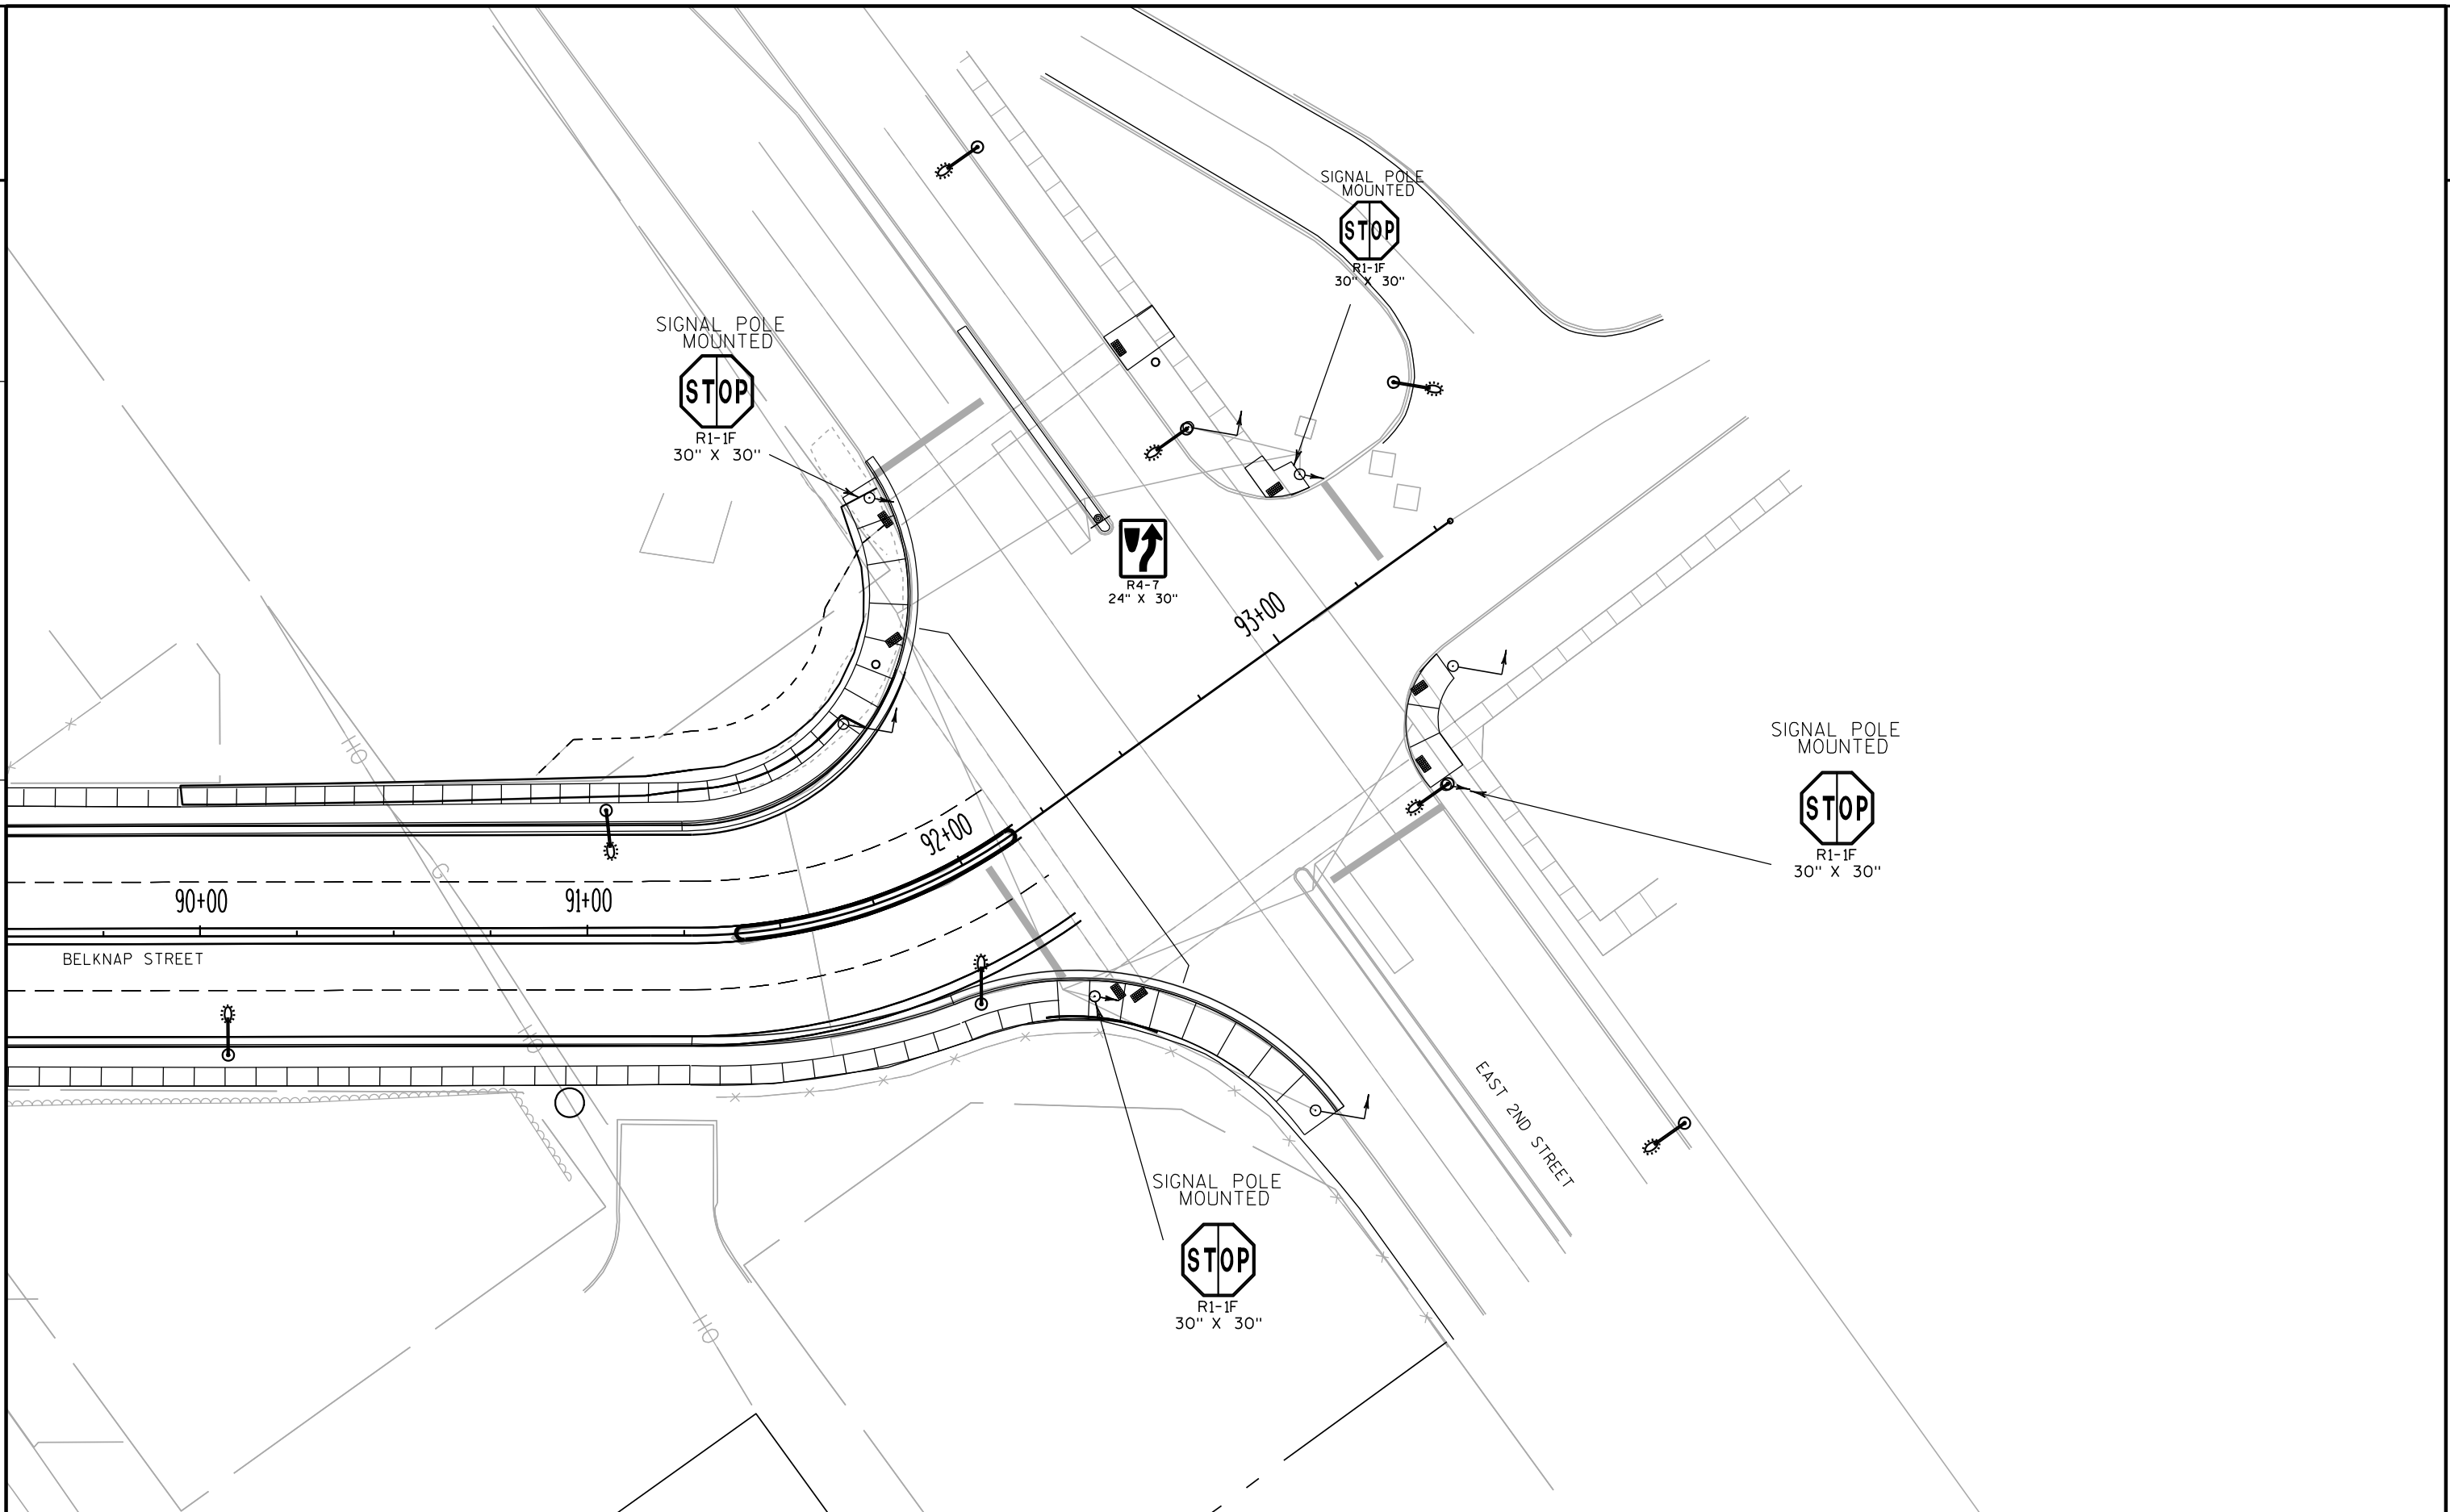

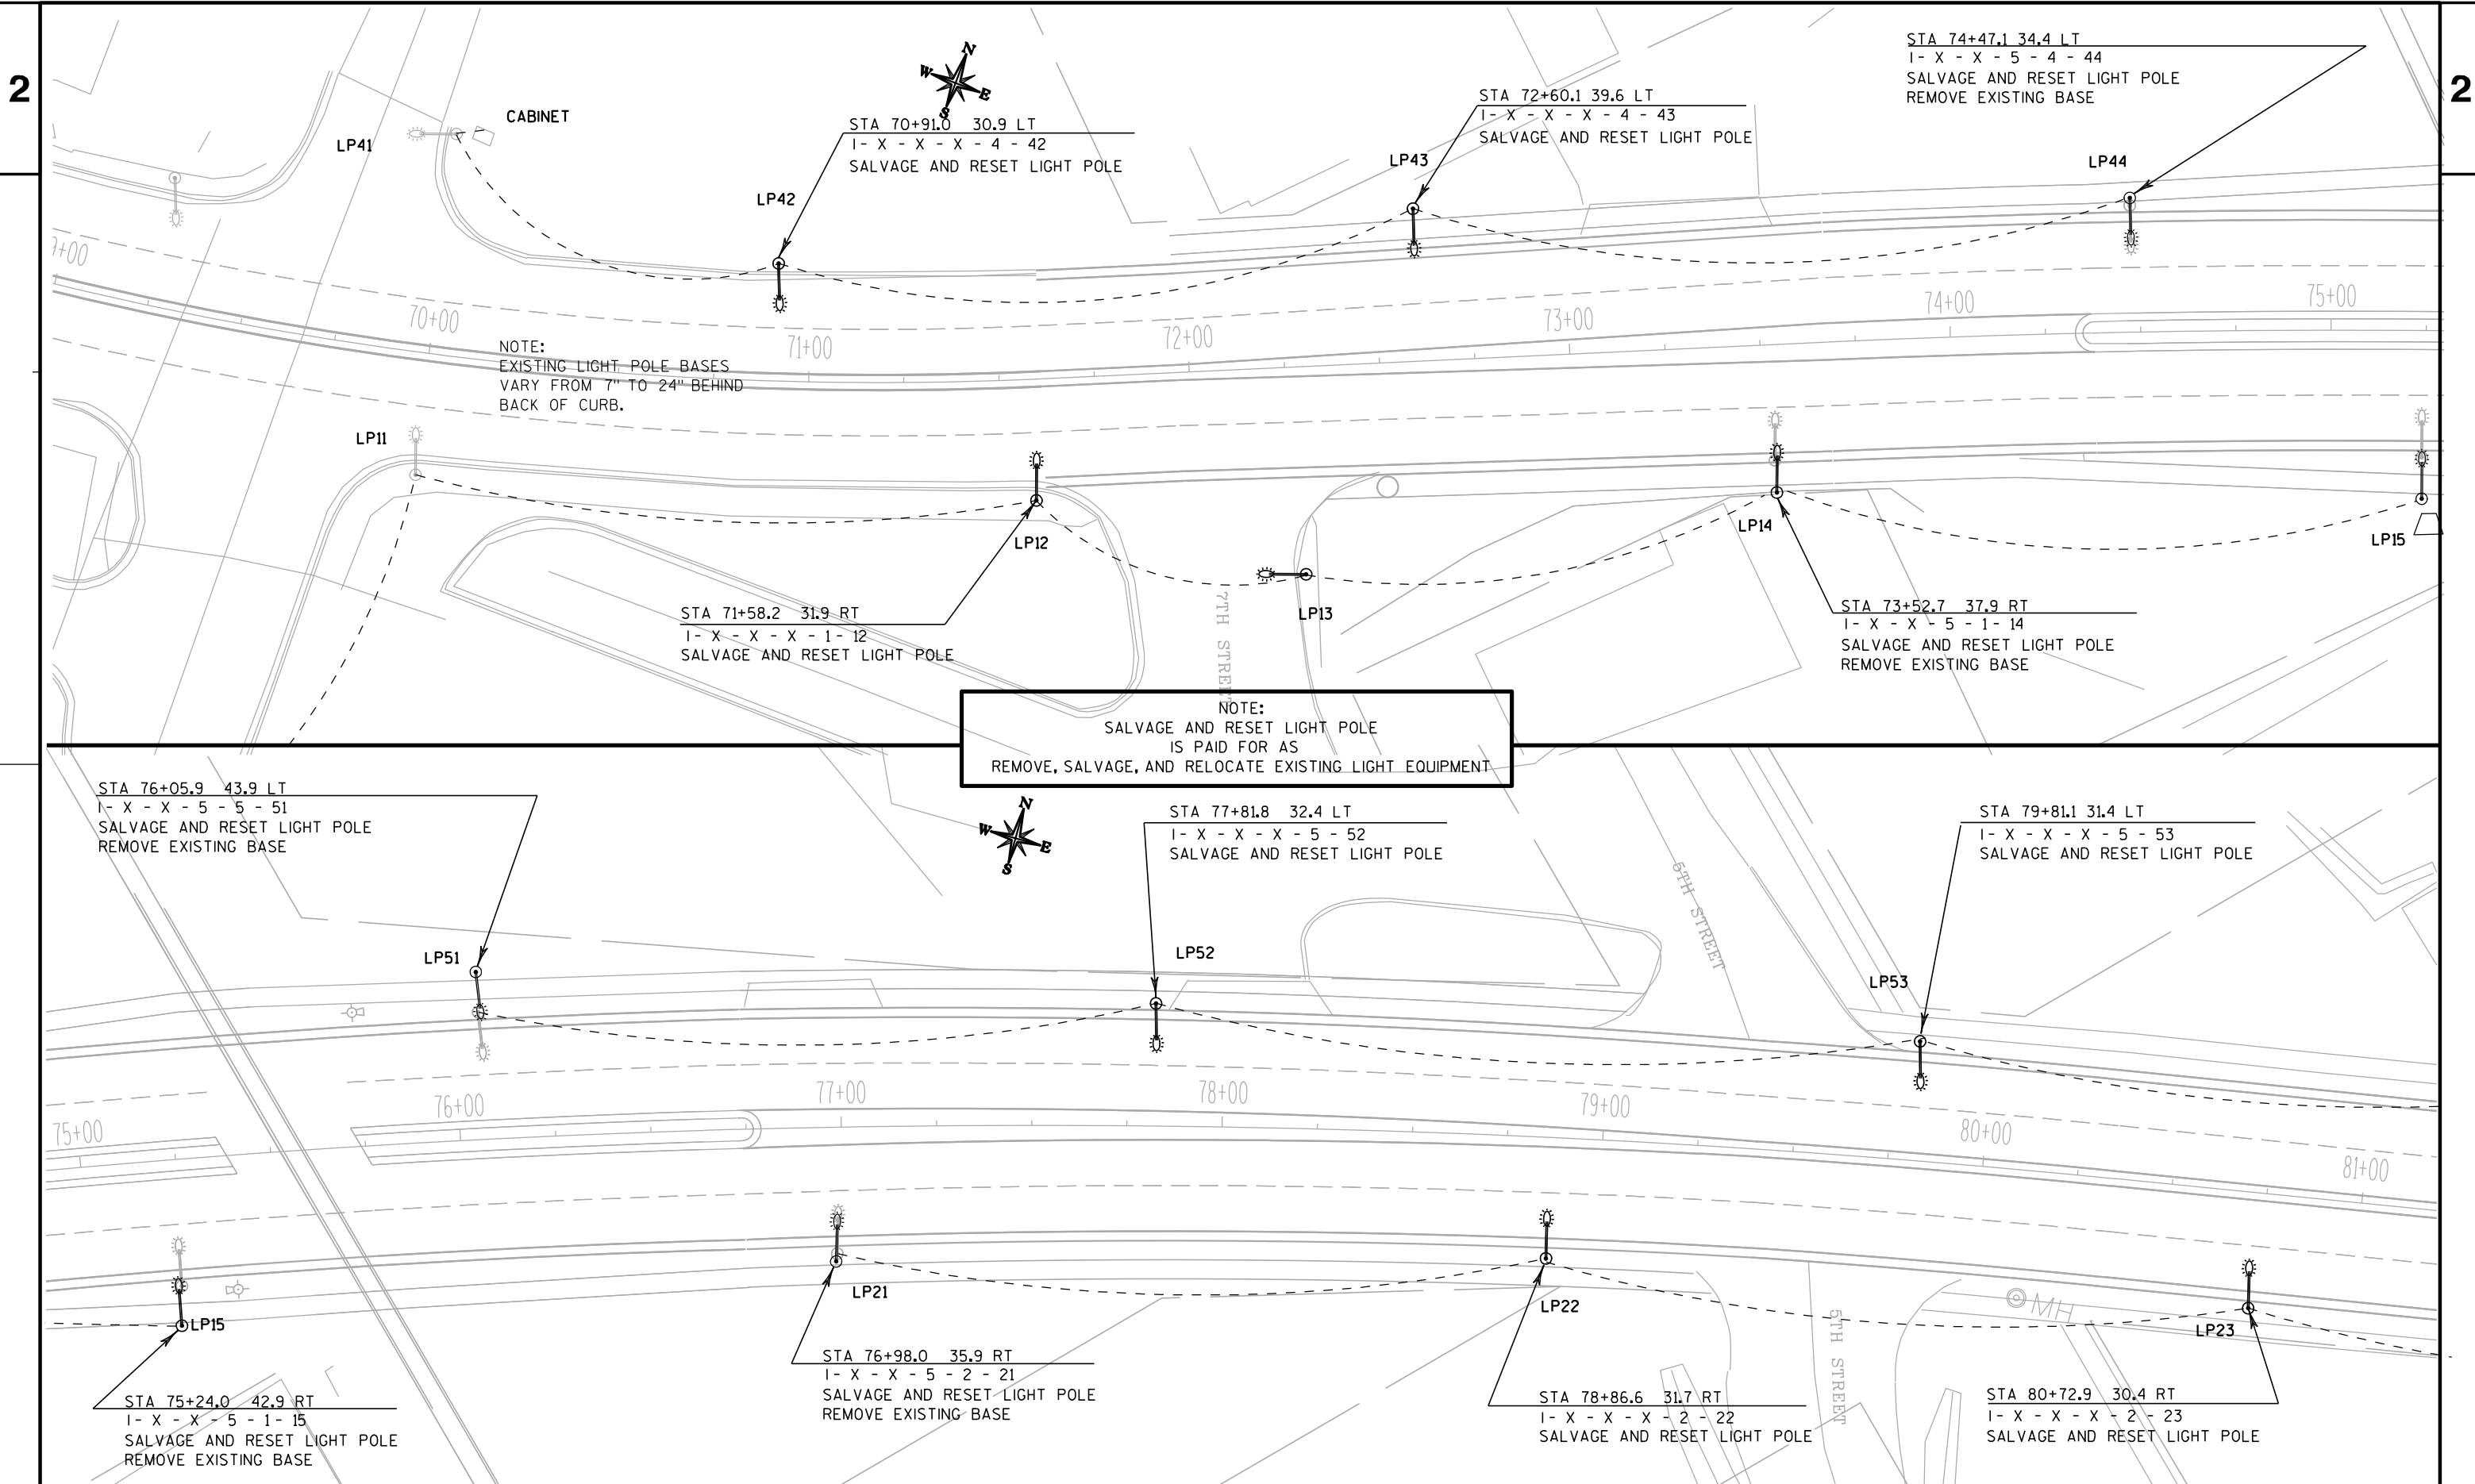
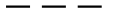


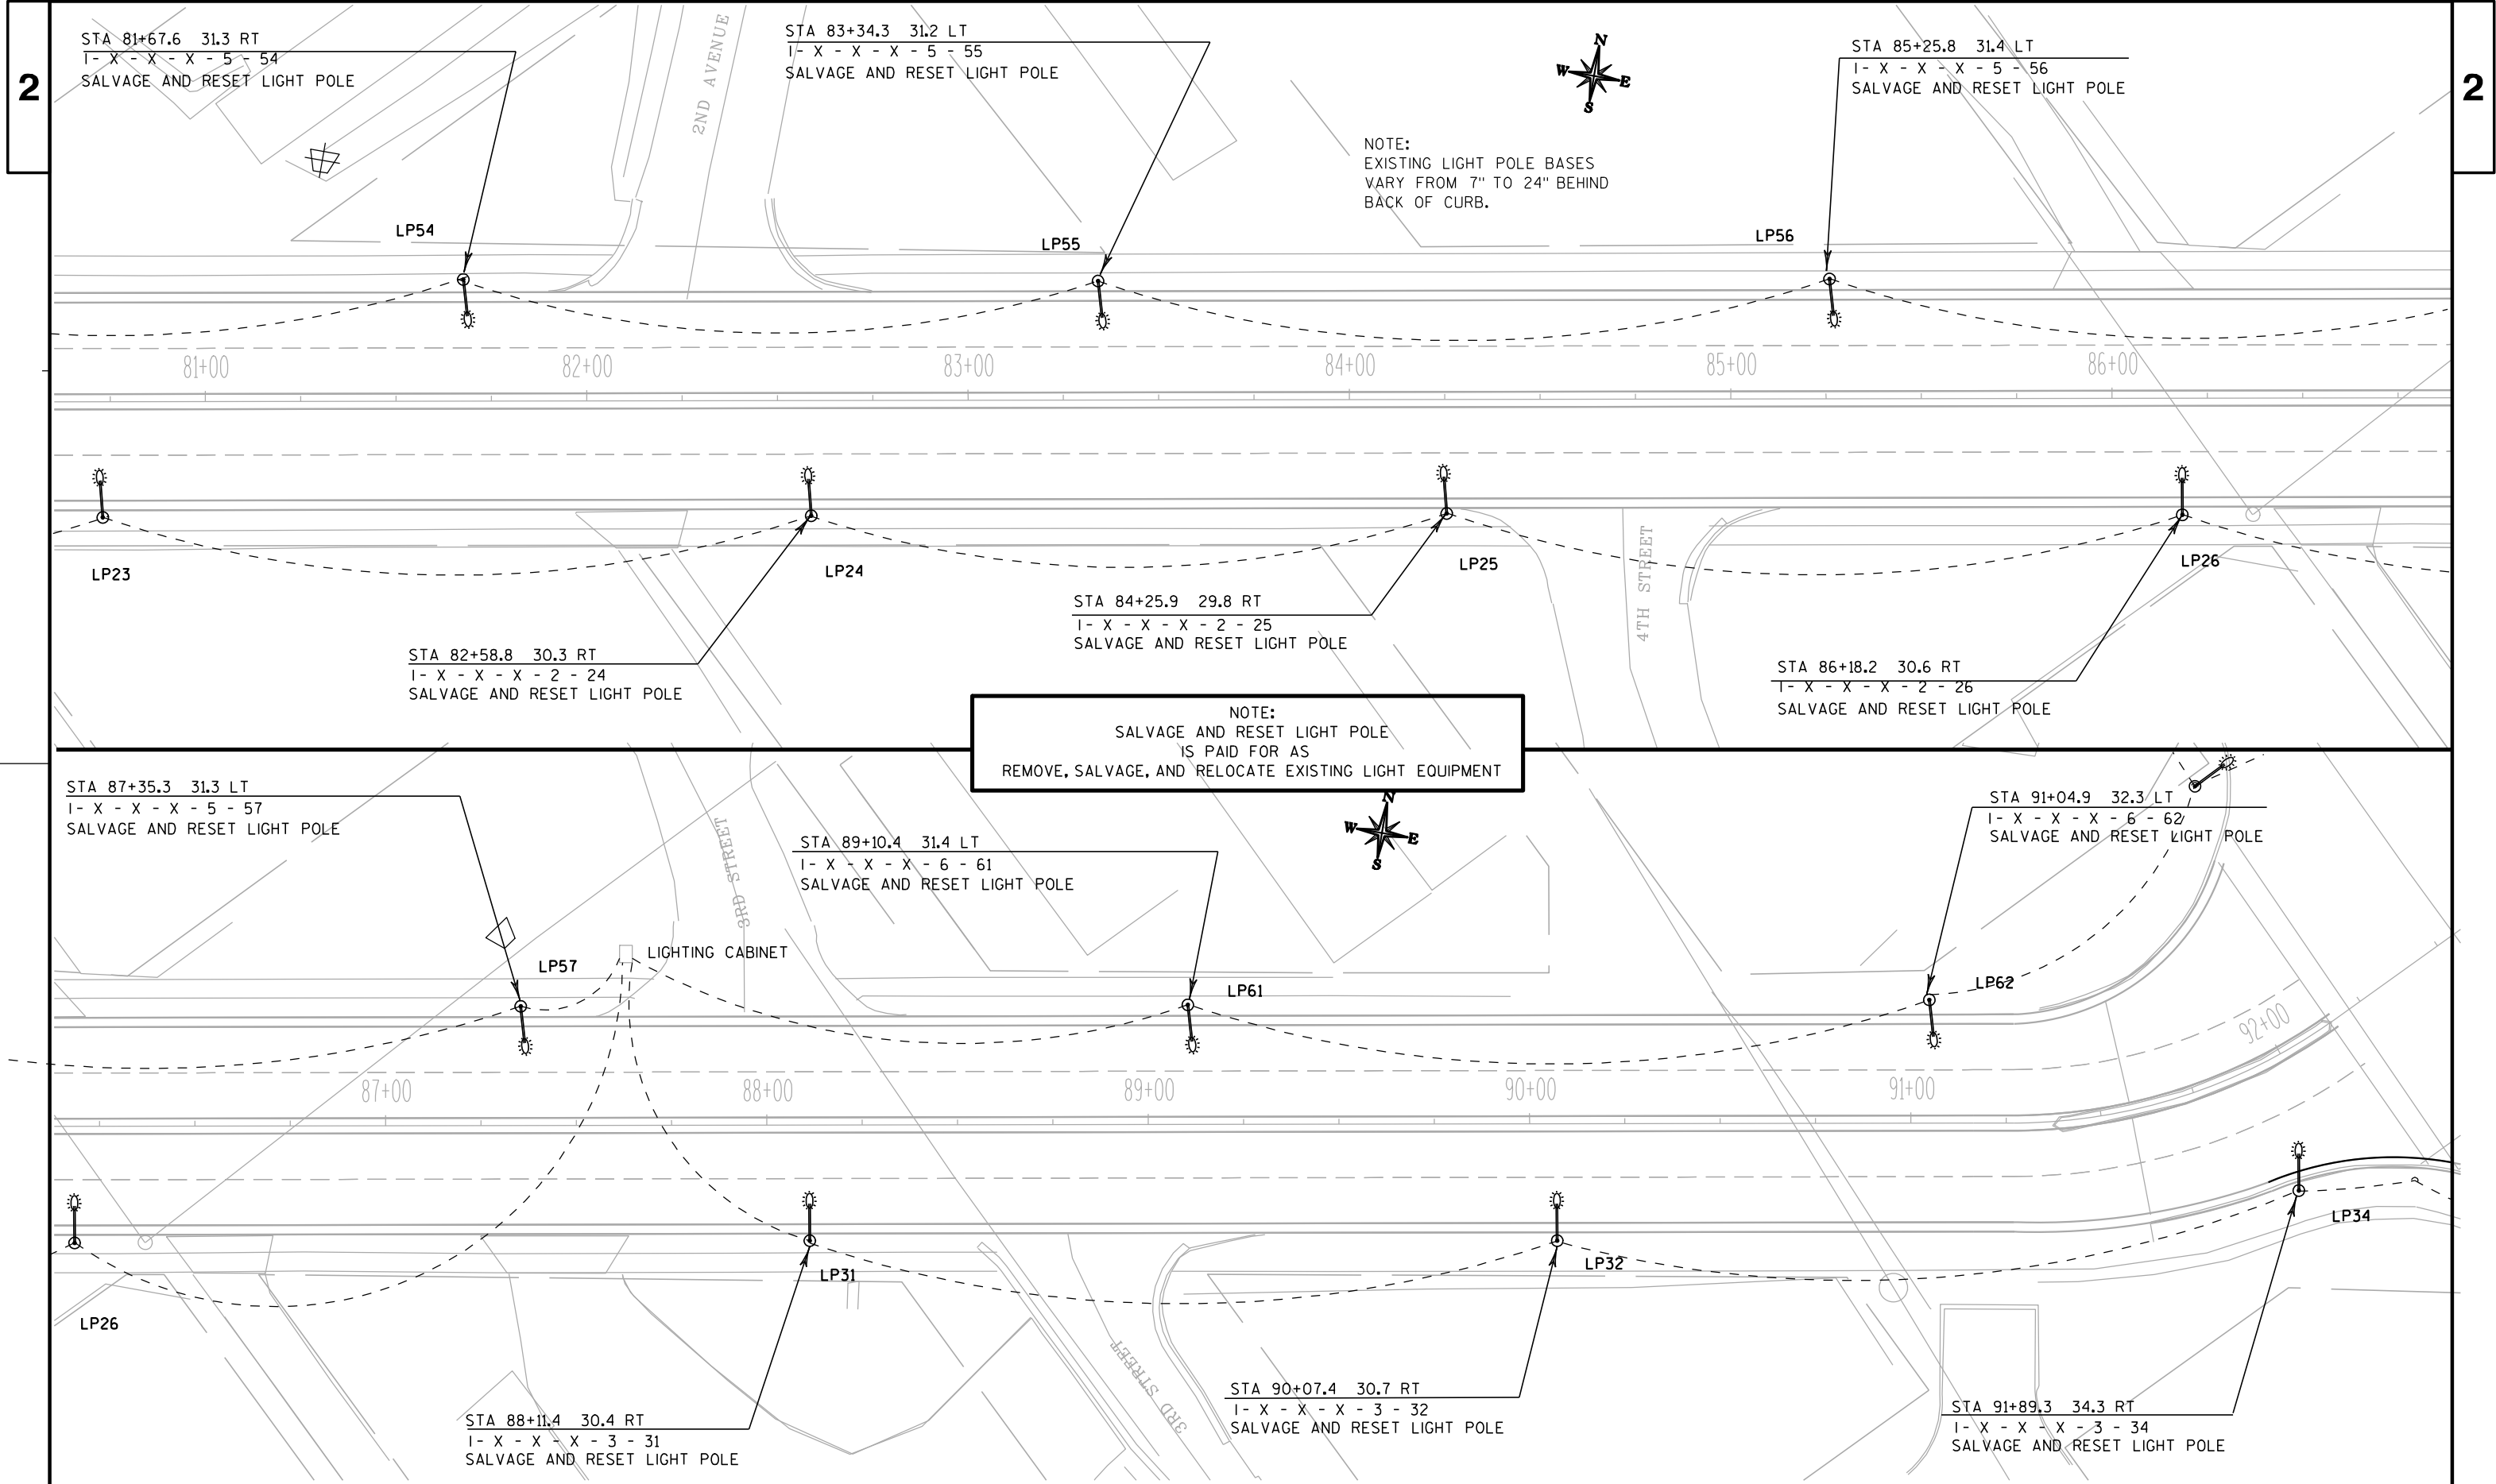









NOTES:

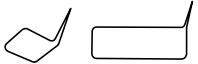



- 1) ENGINEER TO DETERMINE EXACT LOCATION OF ALL SIGNAL SYSTEM COMPONENTS.
- 2) PRIOR TO PLACING CONCRETE, LOOP DETECTOR PLACEMENT MUST BE APPROVED BY DOT TRAFFIC SECTION, DAVE FENSKE, 715-836-2800.
- 3) COORDINATION WITH DOT TRAFFIC SECTION IS REQUIRED TO CONNECT EXISTING WITH NEW FACILITIES, CONTACT DOT TRAFFIC ENGINEER DAVE FENSKE, 715-836-2800.
- 4) SB21 STA 93+16.3 OFF -81.5 LT
- 5) SB22 STA 92+12.4 OFF -57.0 LT
- 6) PB52 STA 93+14 OFF 45.4 LT
- 7) PB55 STA 92+05.5 OFF 40.8 RT
- 8) PB56 STA 92+24.2 OFF 63.7 LT
- 9) PB57 STA 92+80.0 OFF -60 LT
- 10) PB58 STA 92+10.8 OFF -0.0 LT
- 11) PB65 STA 90+60.1 OFF 33.6 RT
- 12) PB67 STA 92+80.6 OFF -111 LT
- 13) PB68 STA 91+95 OFF -0.0 LT


LEGEND

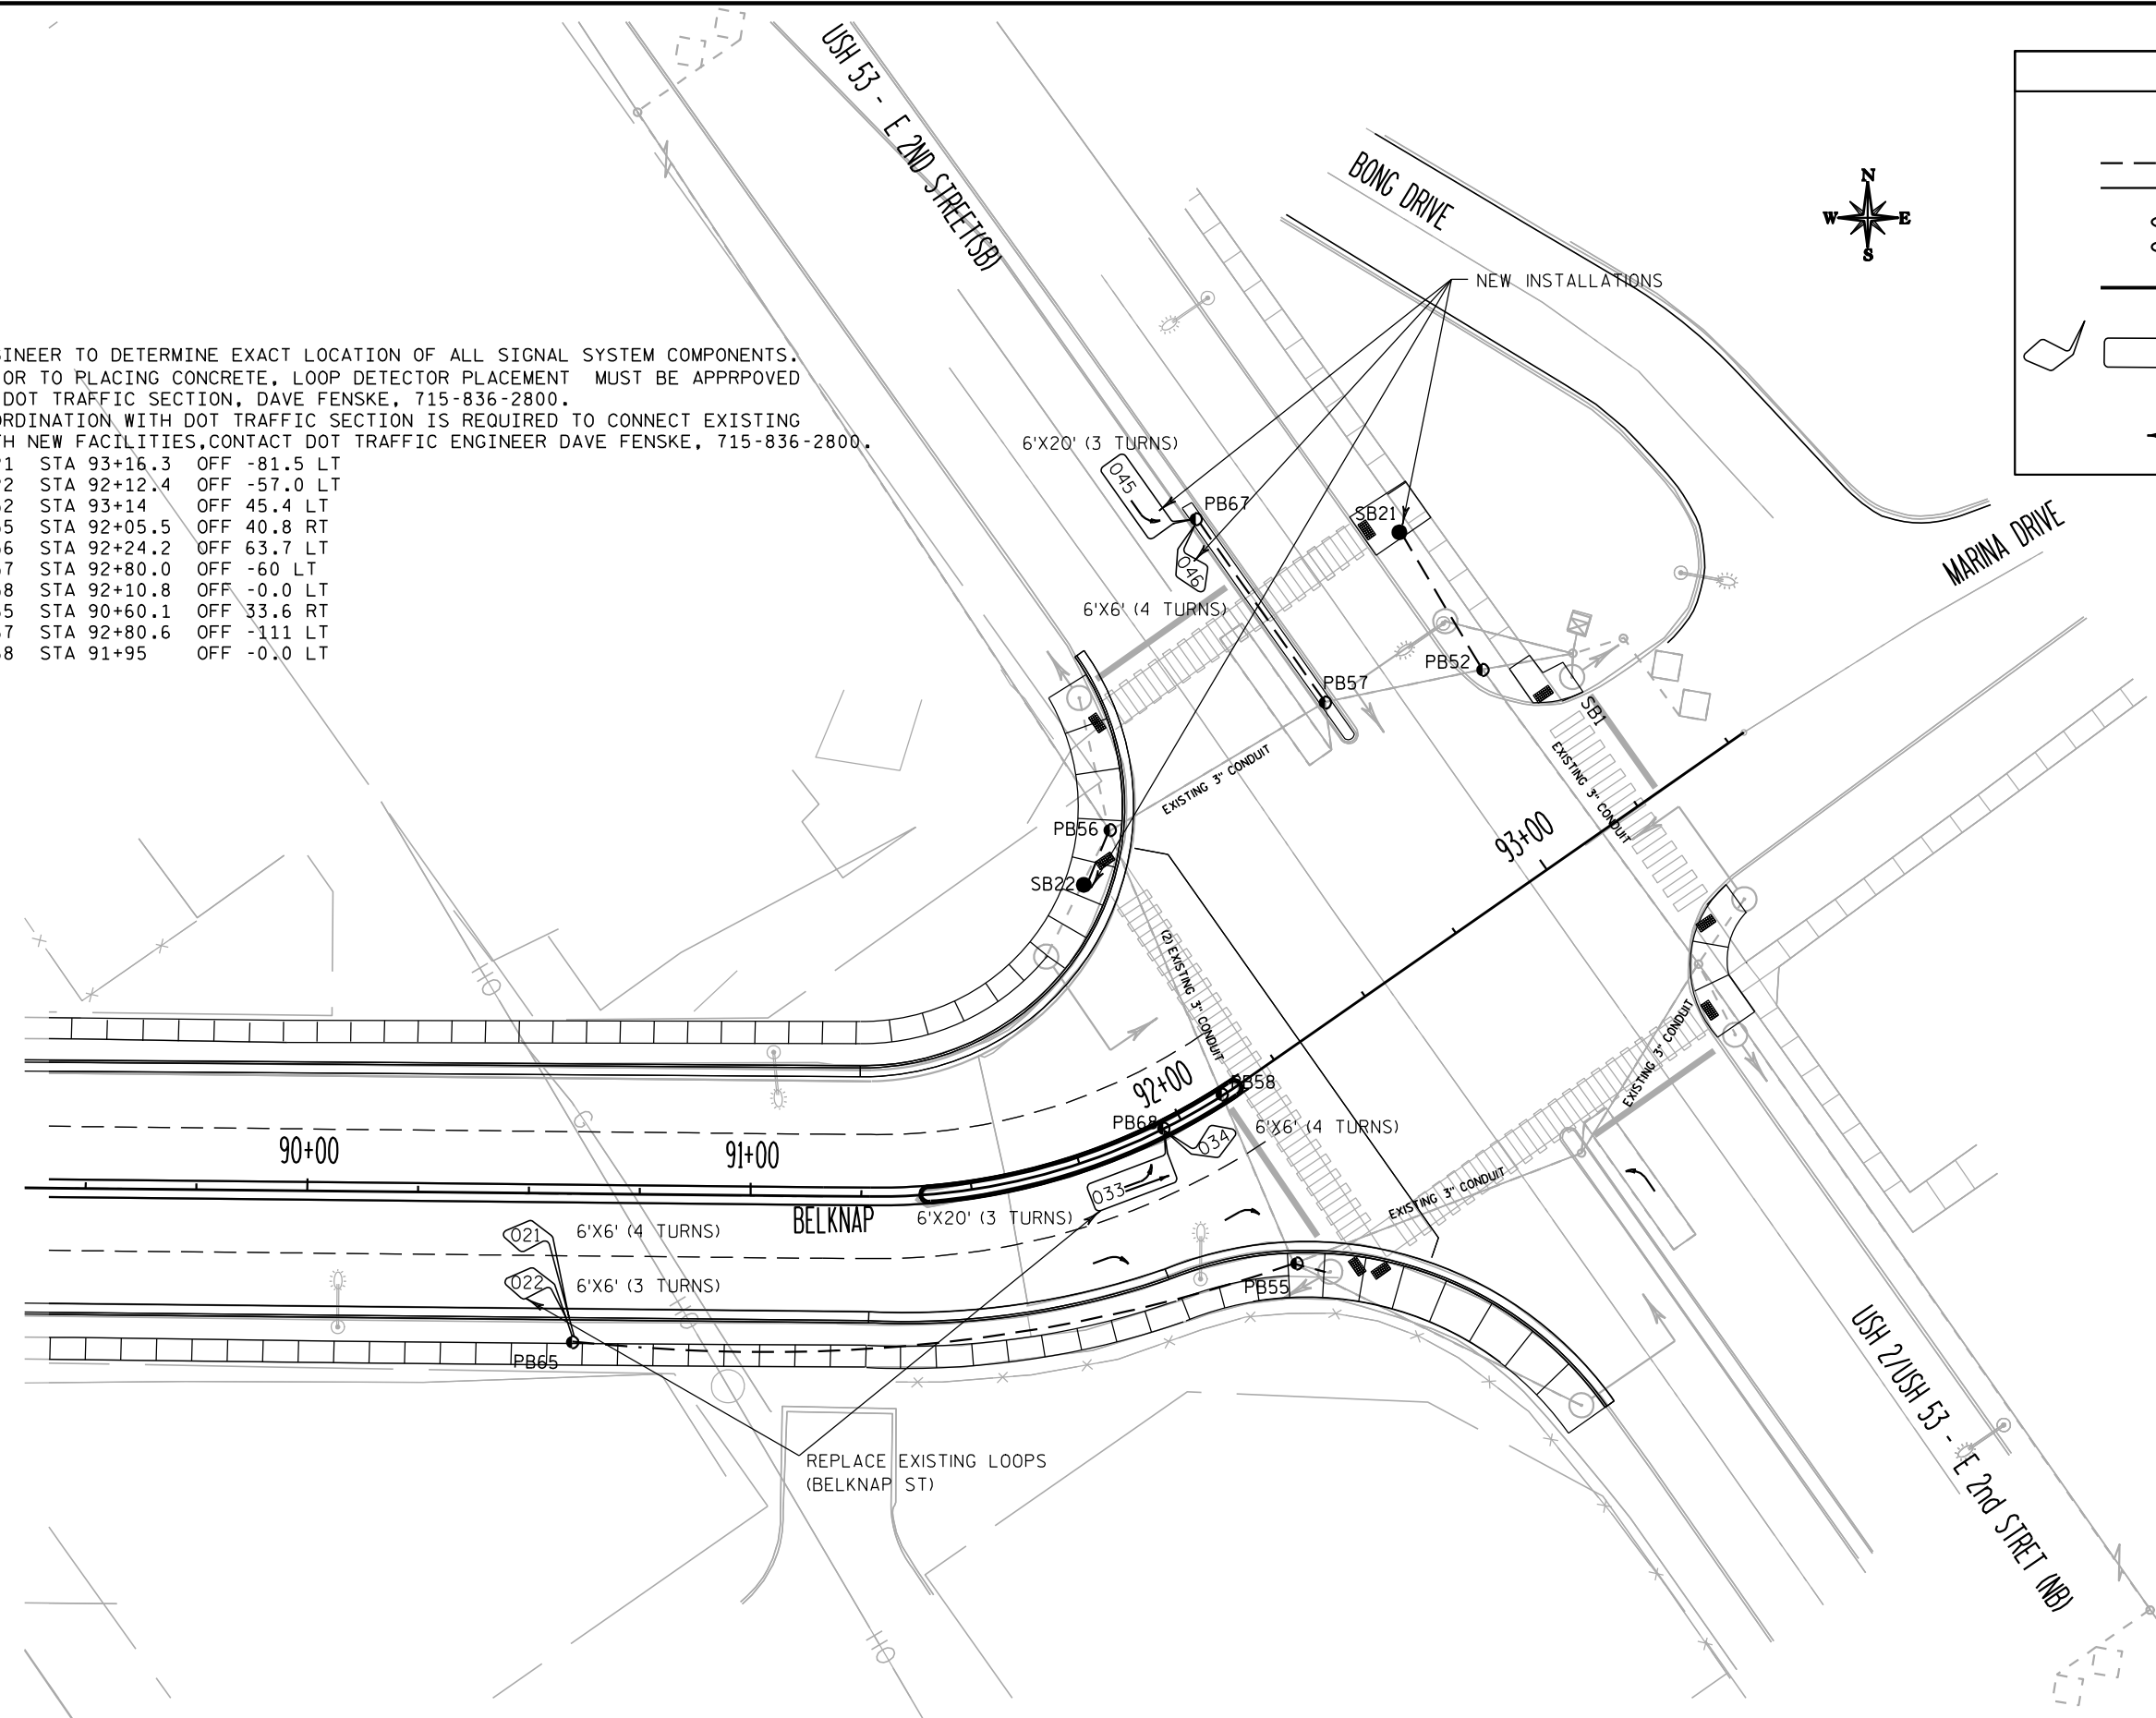-  CONTROL CABINET
-  NONMETALLIC CONDUIT 2", UNLESS OTHERWISE NOTED
-  LOOP DETECTOR CONDUIT 1" NONMETALLIC
-  LUMINAIRE UNDER PERMIT TO LOCAL MUNICIPALITY
-  LUMINAIRE, TRAFFIC POLE, TRANSFORMER BASE
-  LOOP DETECTOR CONDUIT 1" NONMETALLIC
-  LOOP DETECTOR IN 1" NONMETALLIC CONDUIT
-  PULL BOX, 24" X 36"
-  LANE DESIGNATION FOR INFO ONLY



LOOP PLACEMENT DETAIL

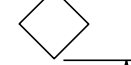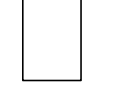-  PEDESTRIAN WALKWAY
-  STOP BAR
-  6x6 LOOP DETECTOR
-  6x20 LOOP DETECTOR

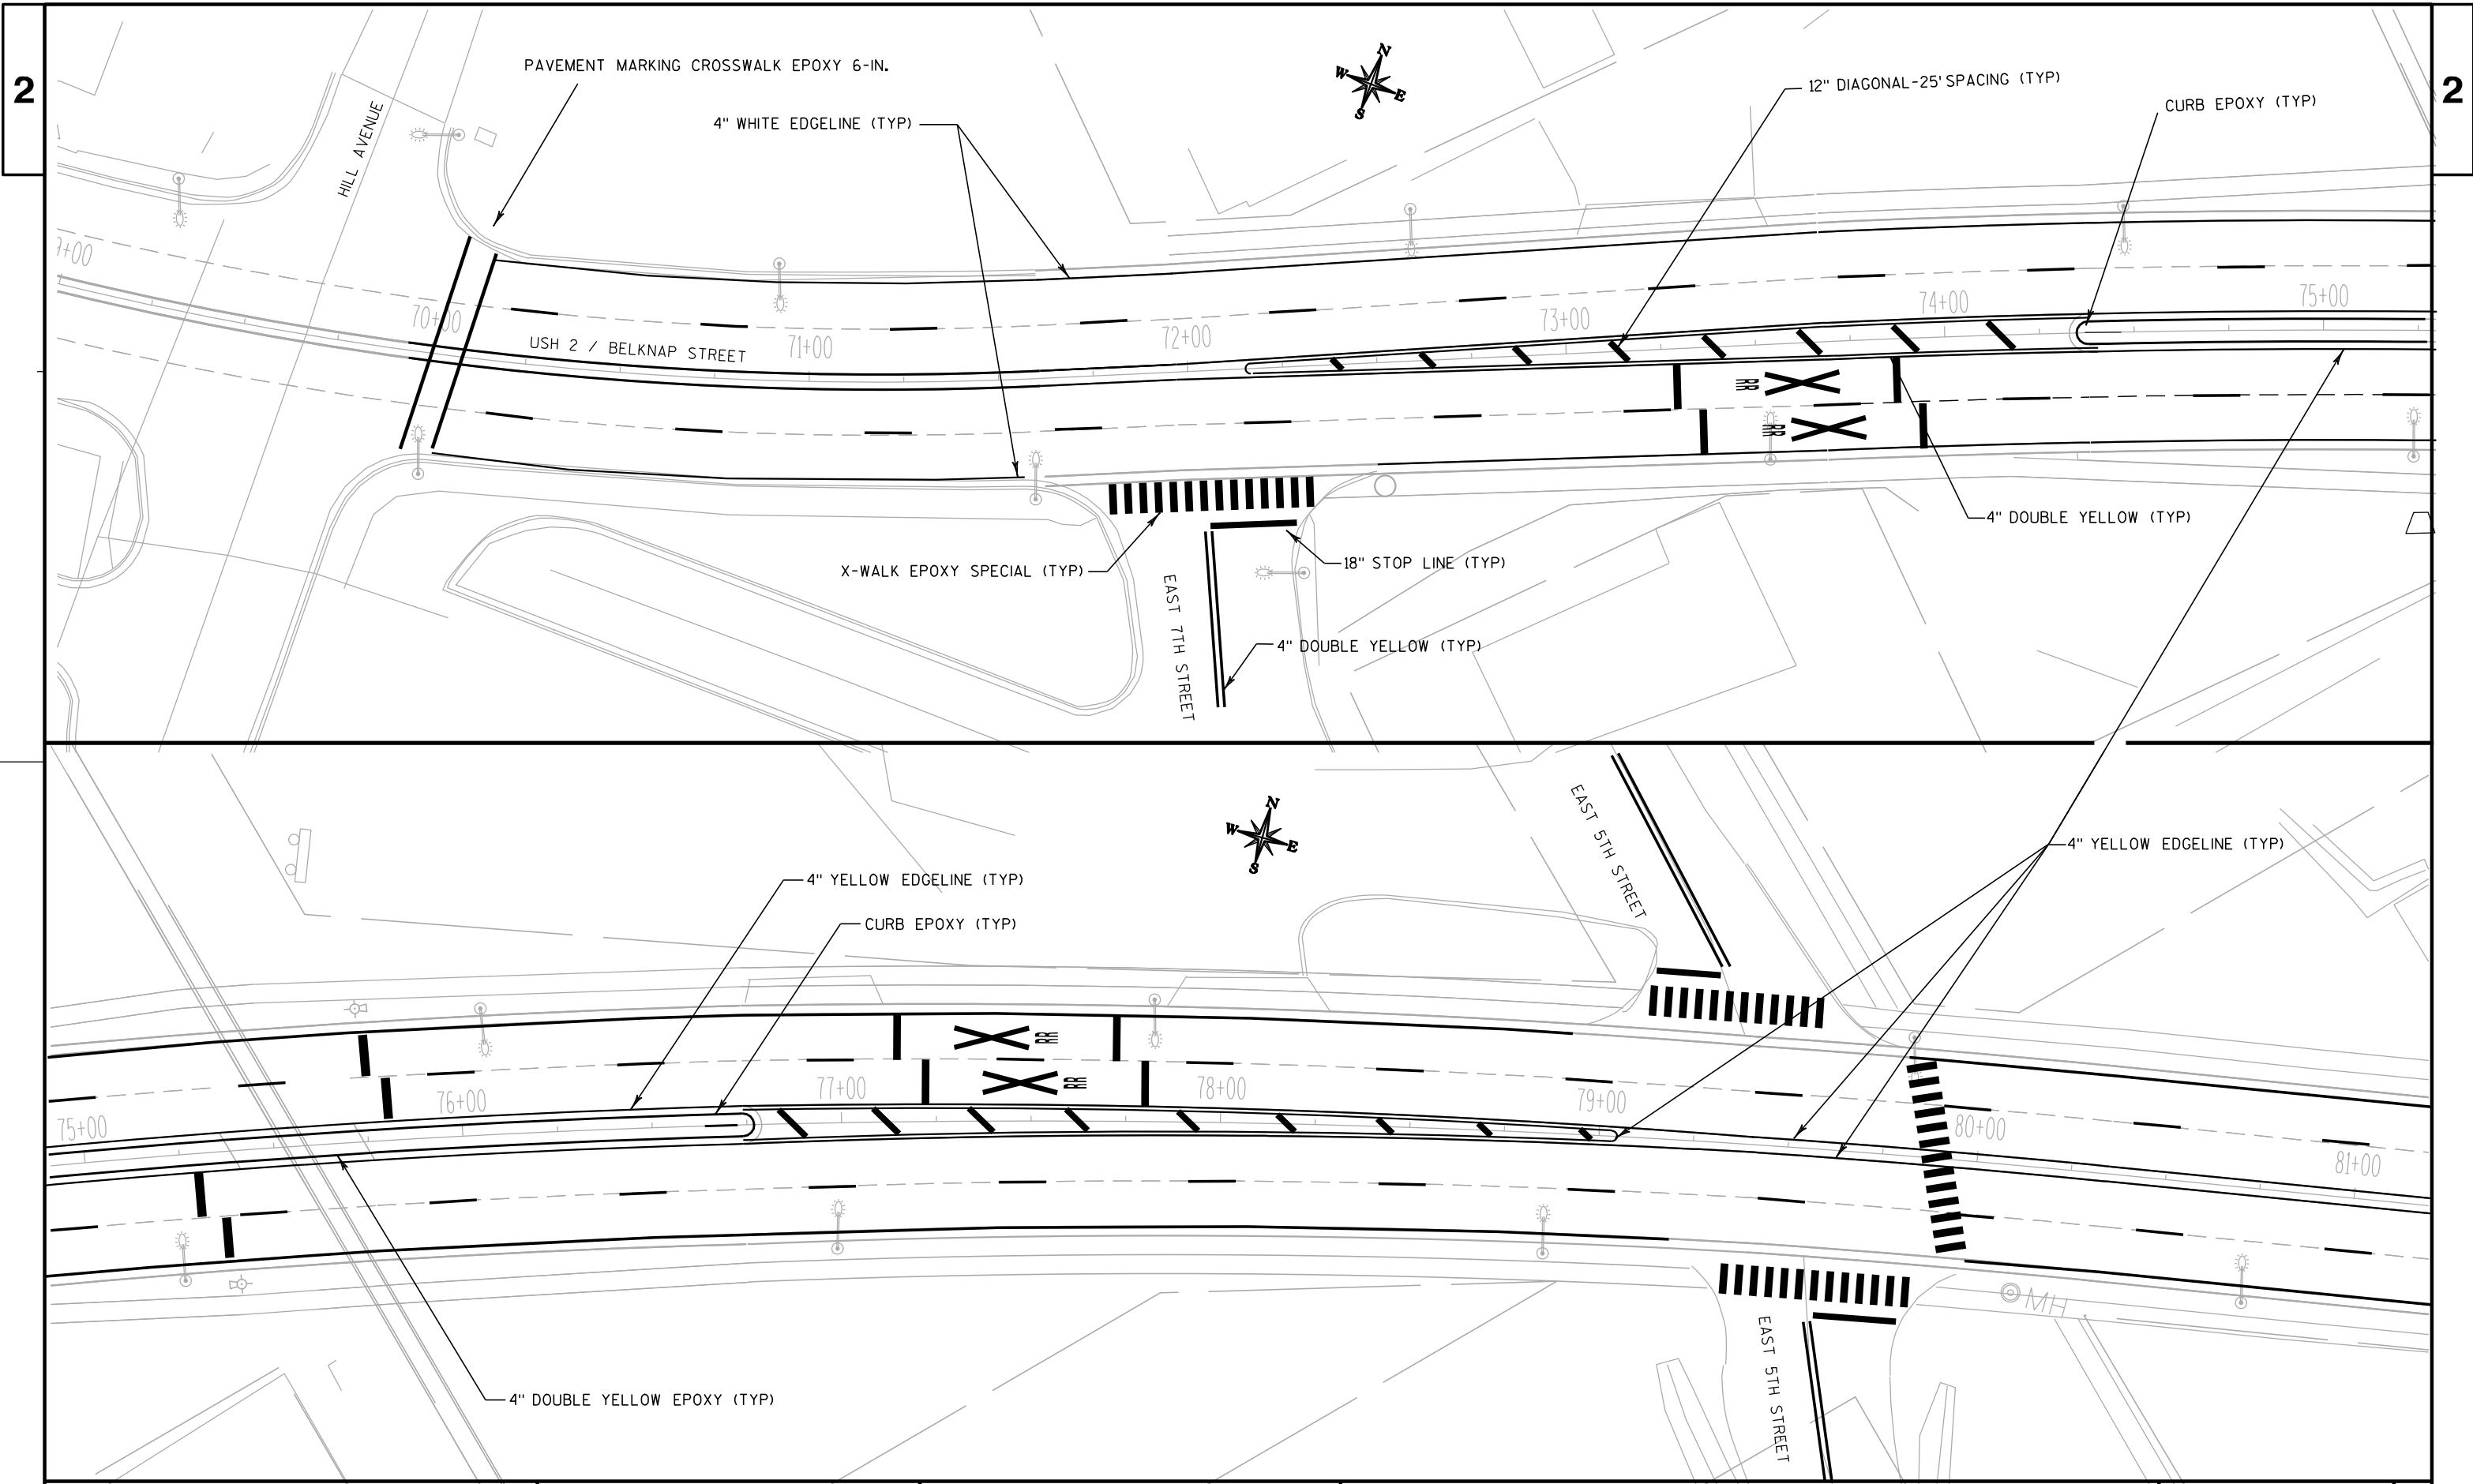

2ND AVE.

18" STOP LINE (TYP)

4" DOUBLE YELLOW (TYP)

X-WALK EPOXY SPECIAL (TYP)



81+00

82+00

83+00

84+00

85+00

86+00

4" WHITE CENTERLINE (TYP)

E. 4TH STREET

E. 3RD STREET

4" YELLOW EDGELINE (TYP)

4" WHITE EDGELINE (TYP)



87+00

88+00

89+00

90+00

91+00

92+00


CURB EPOXY (TYP)

E. 3RD STREET


ARROWS (TYPE 3)

WORDS

ARROWS (TYPE 2)

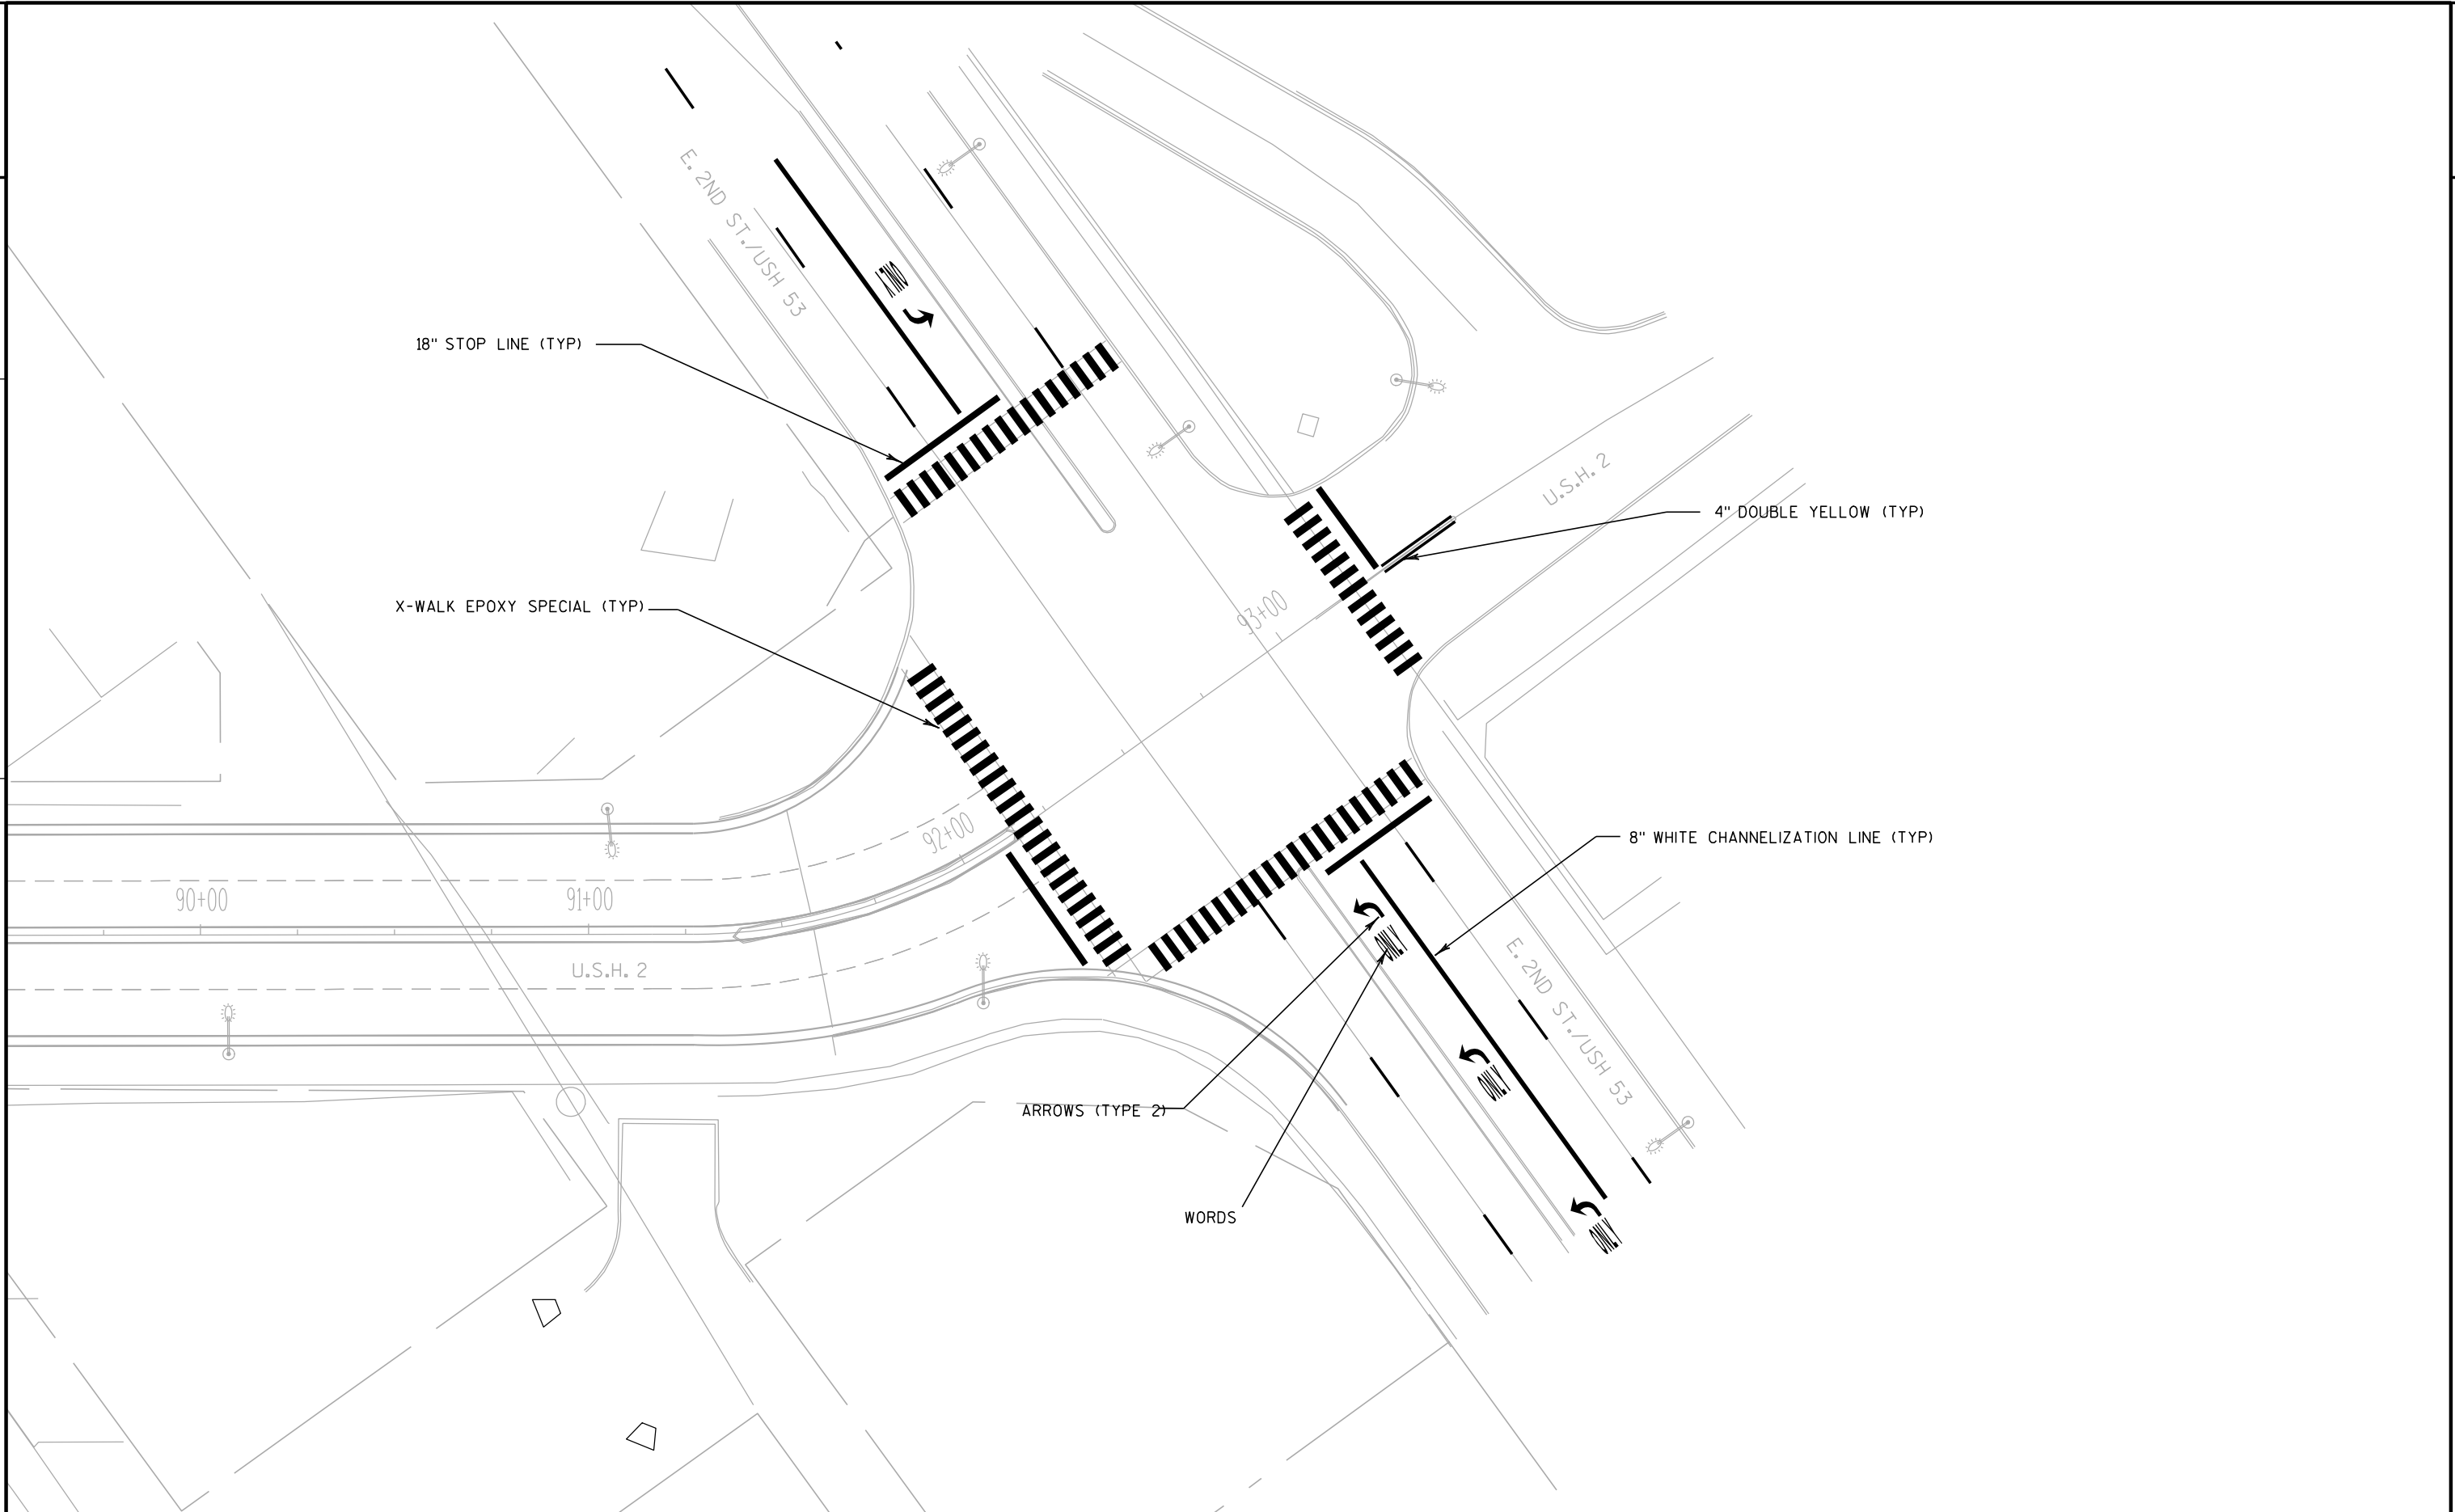



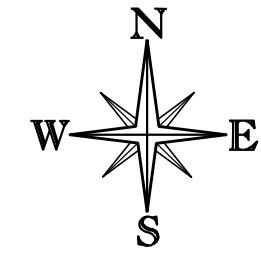

MINNESOTA  
INTERSTATE 35

BLATNIK  
BRIDGE

BONG  
BRIDGE

TOWER AVENUE/  
STH 35



TRAFFIC FLOW  
PROPOSED DETOUR ROUTE

BELKNAP EXTENSION  
PROJECT ID 1190-44-71

E 2ND STREET /  
USH 53


BELKNAP STREET/USH 2

E 2ND STREET

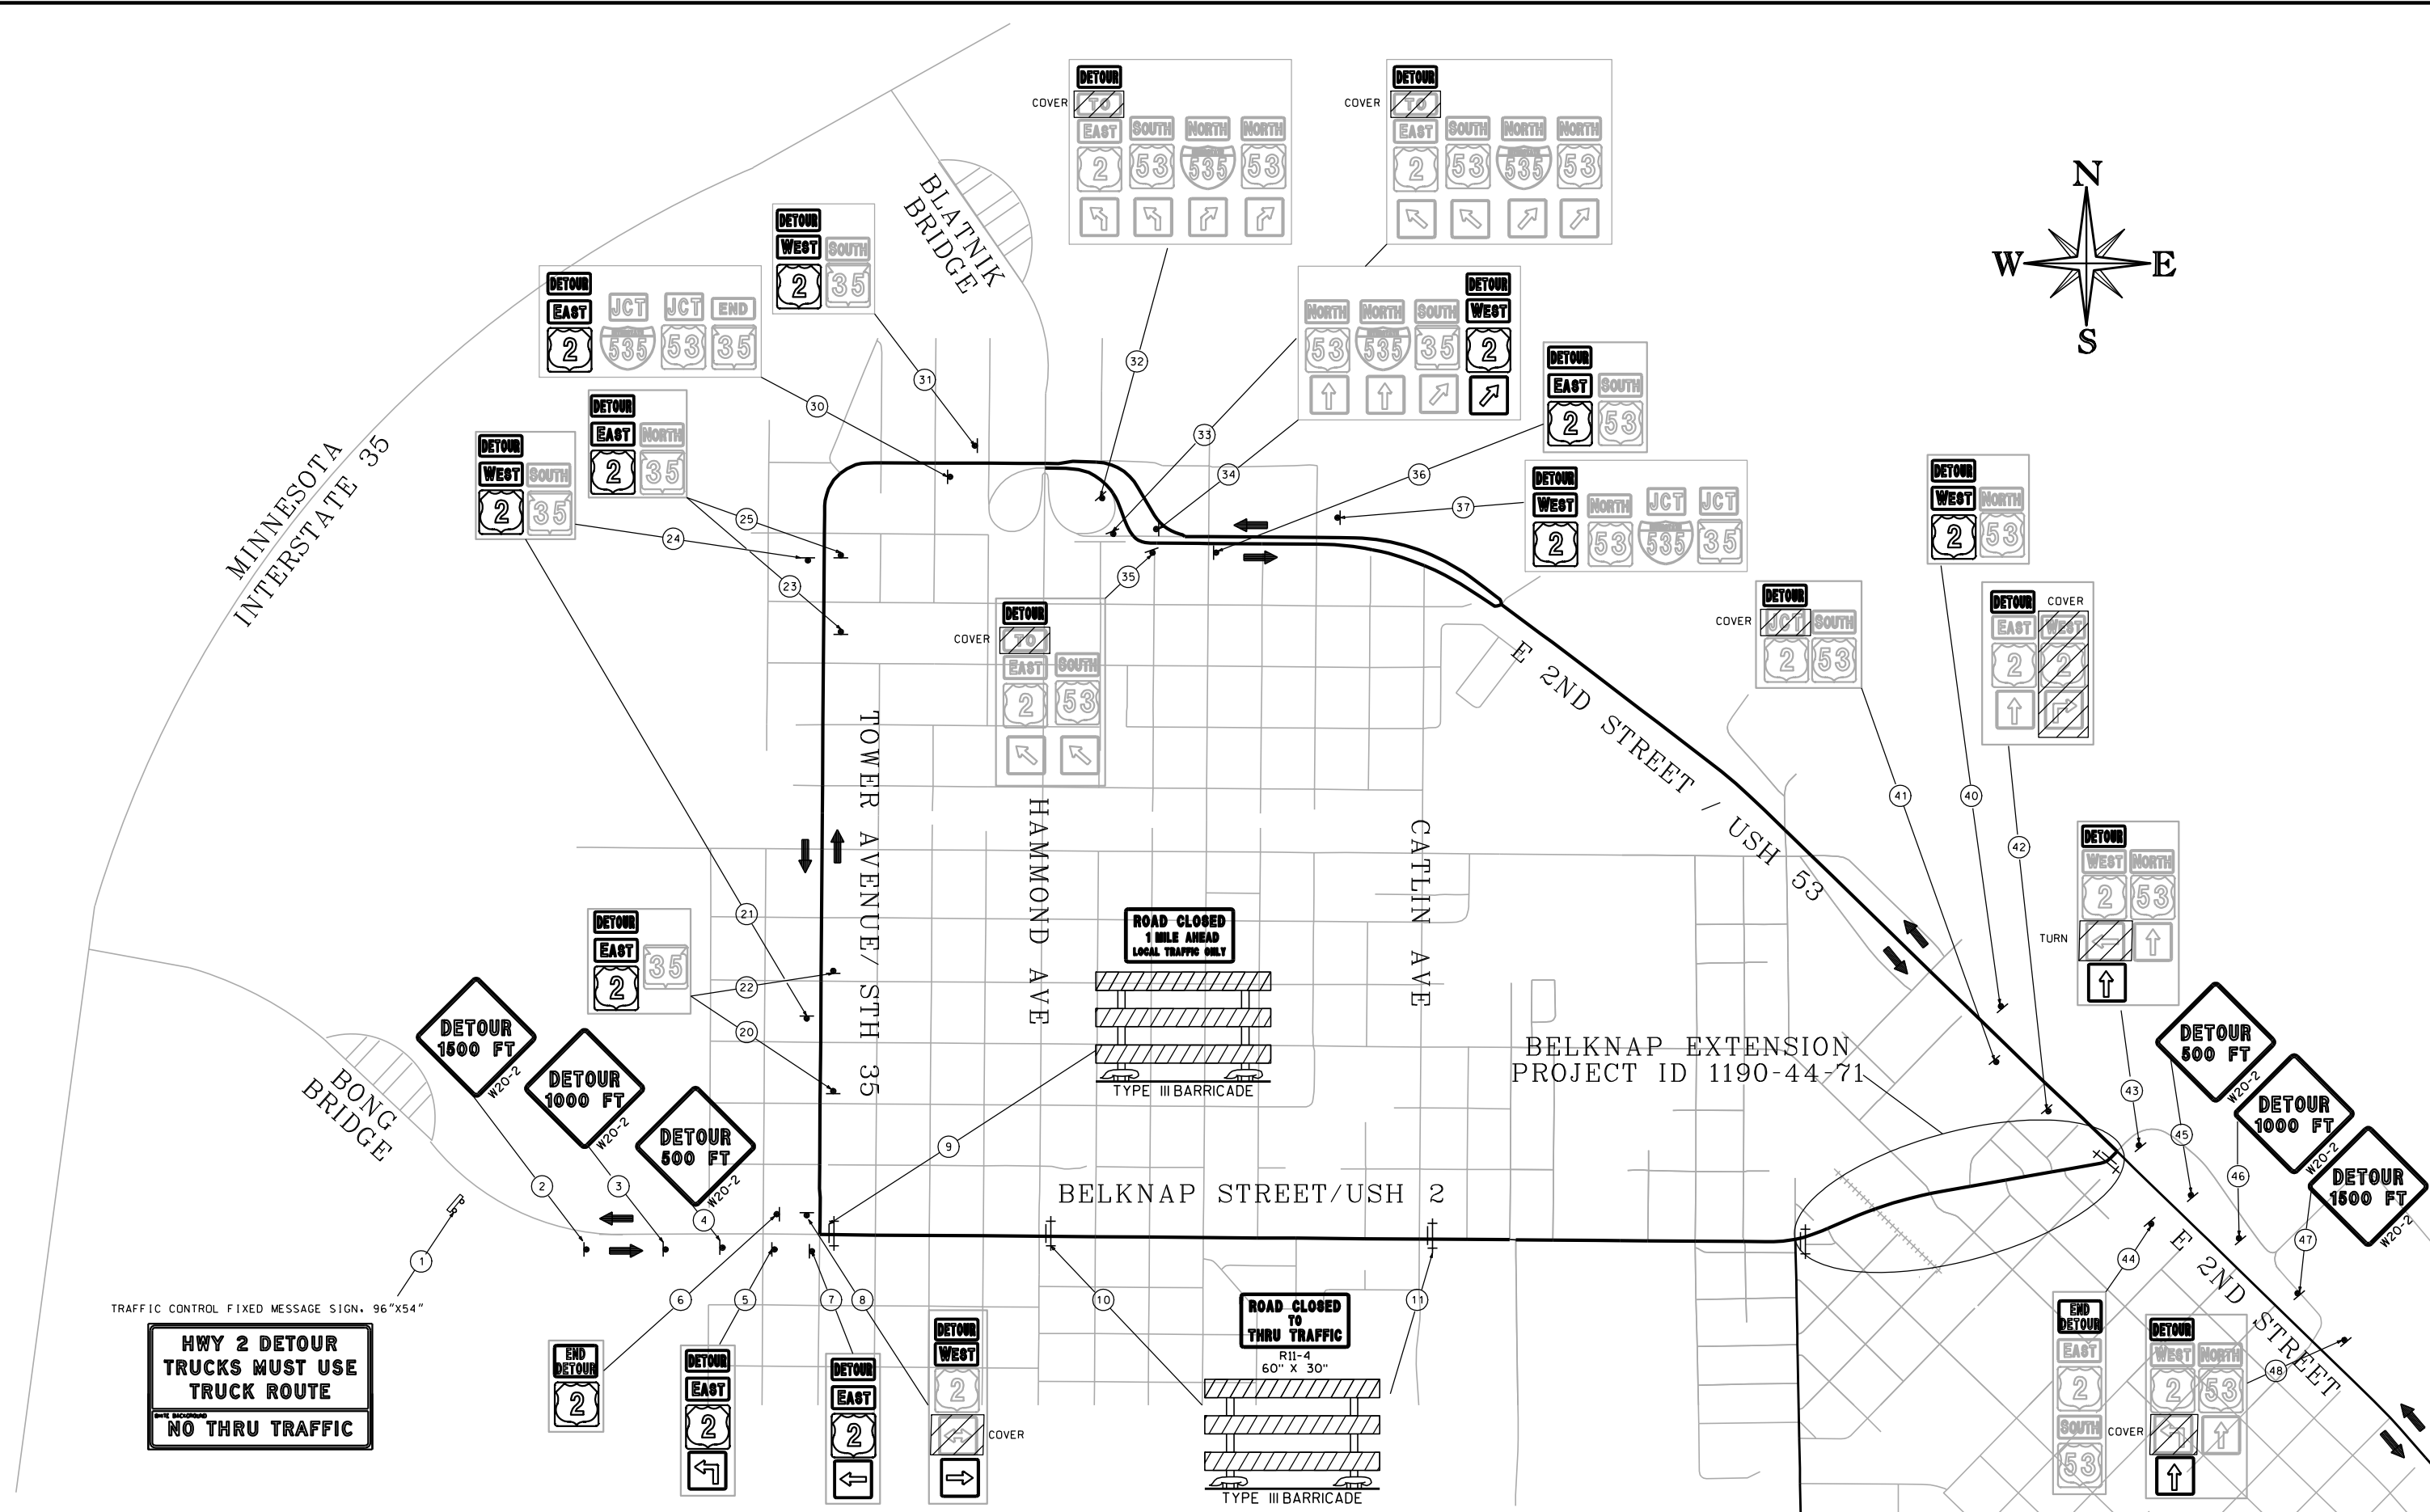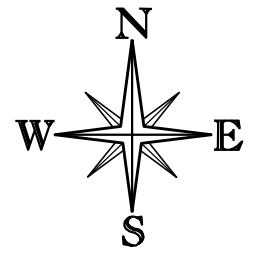

TRAFFIC CONTROL FIXED MESSAGE SIGN, 96"x54"

**HWY 2 DETOUR  
TRUCKS MUST USE  
TRUCK ROUTE  
NO THRU TRAFFIC**

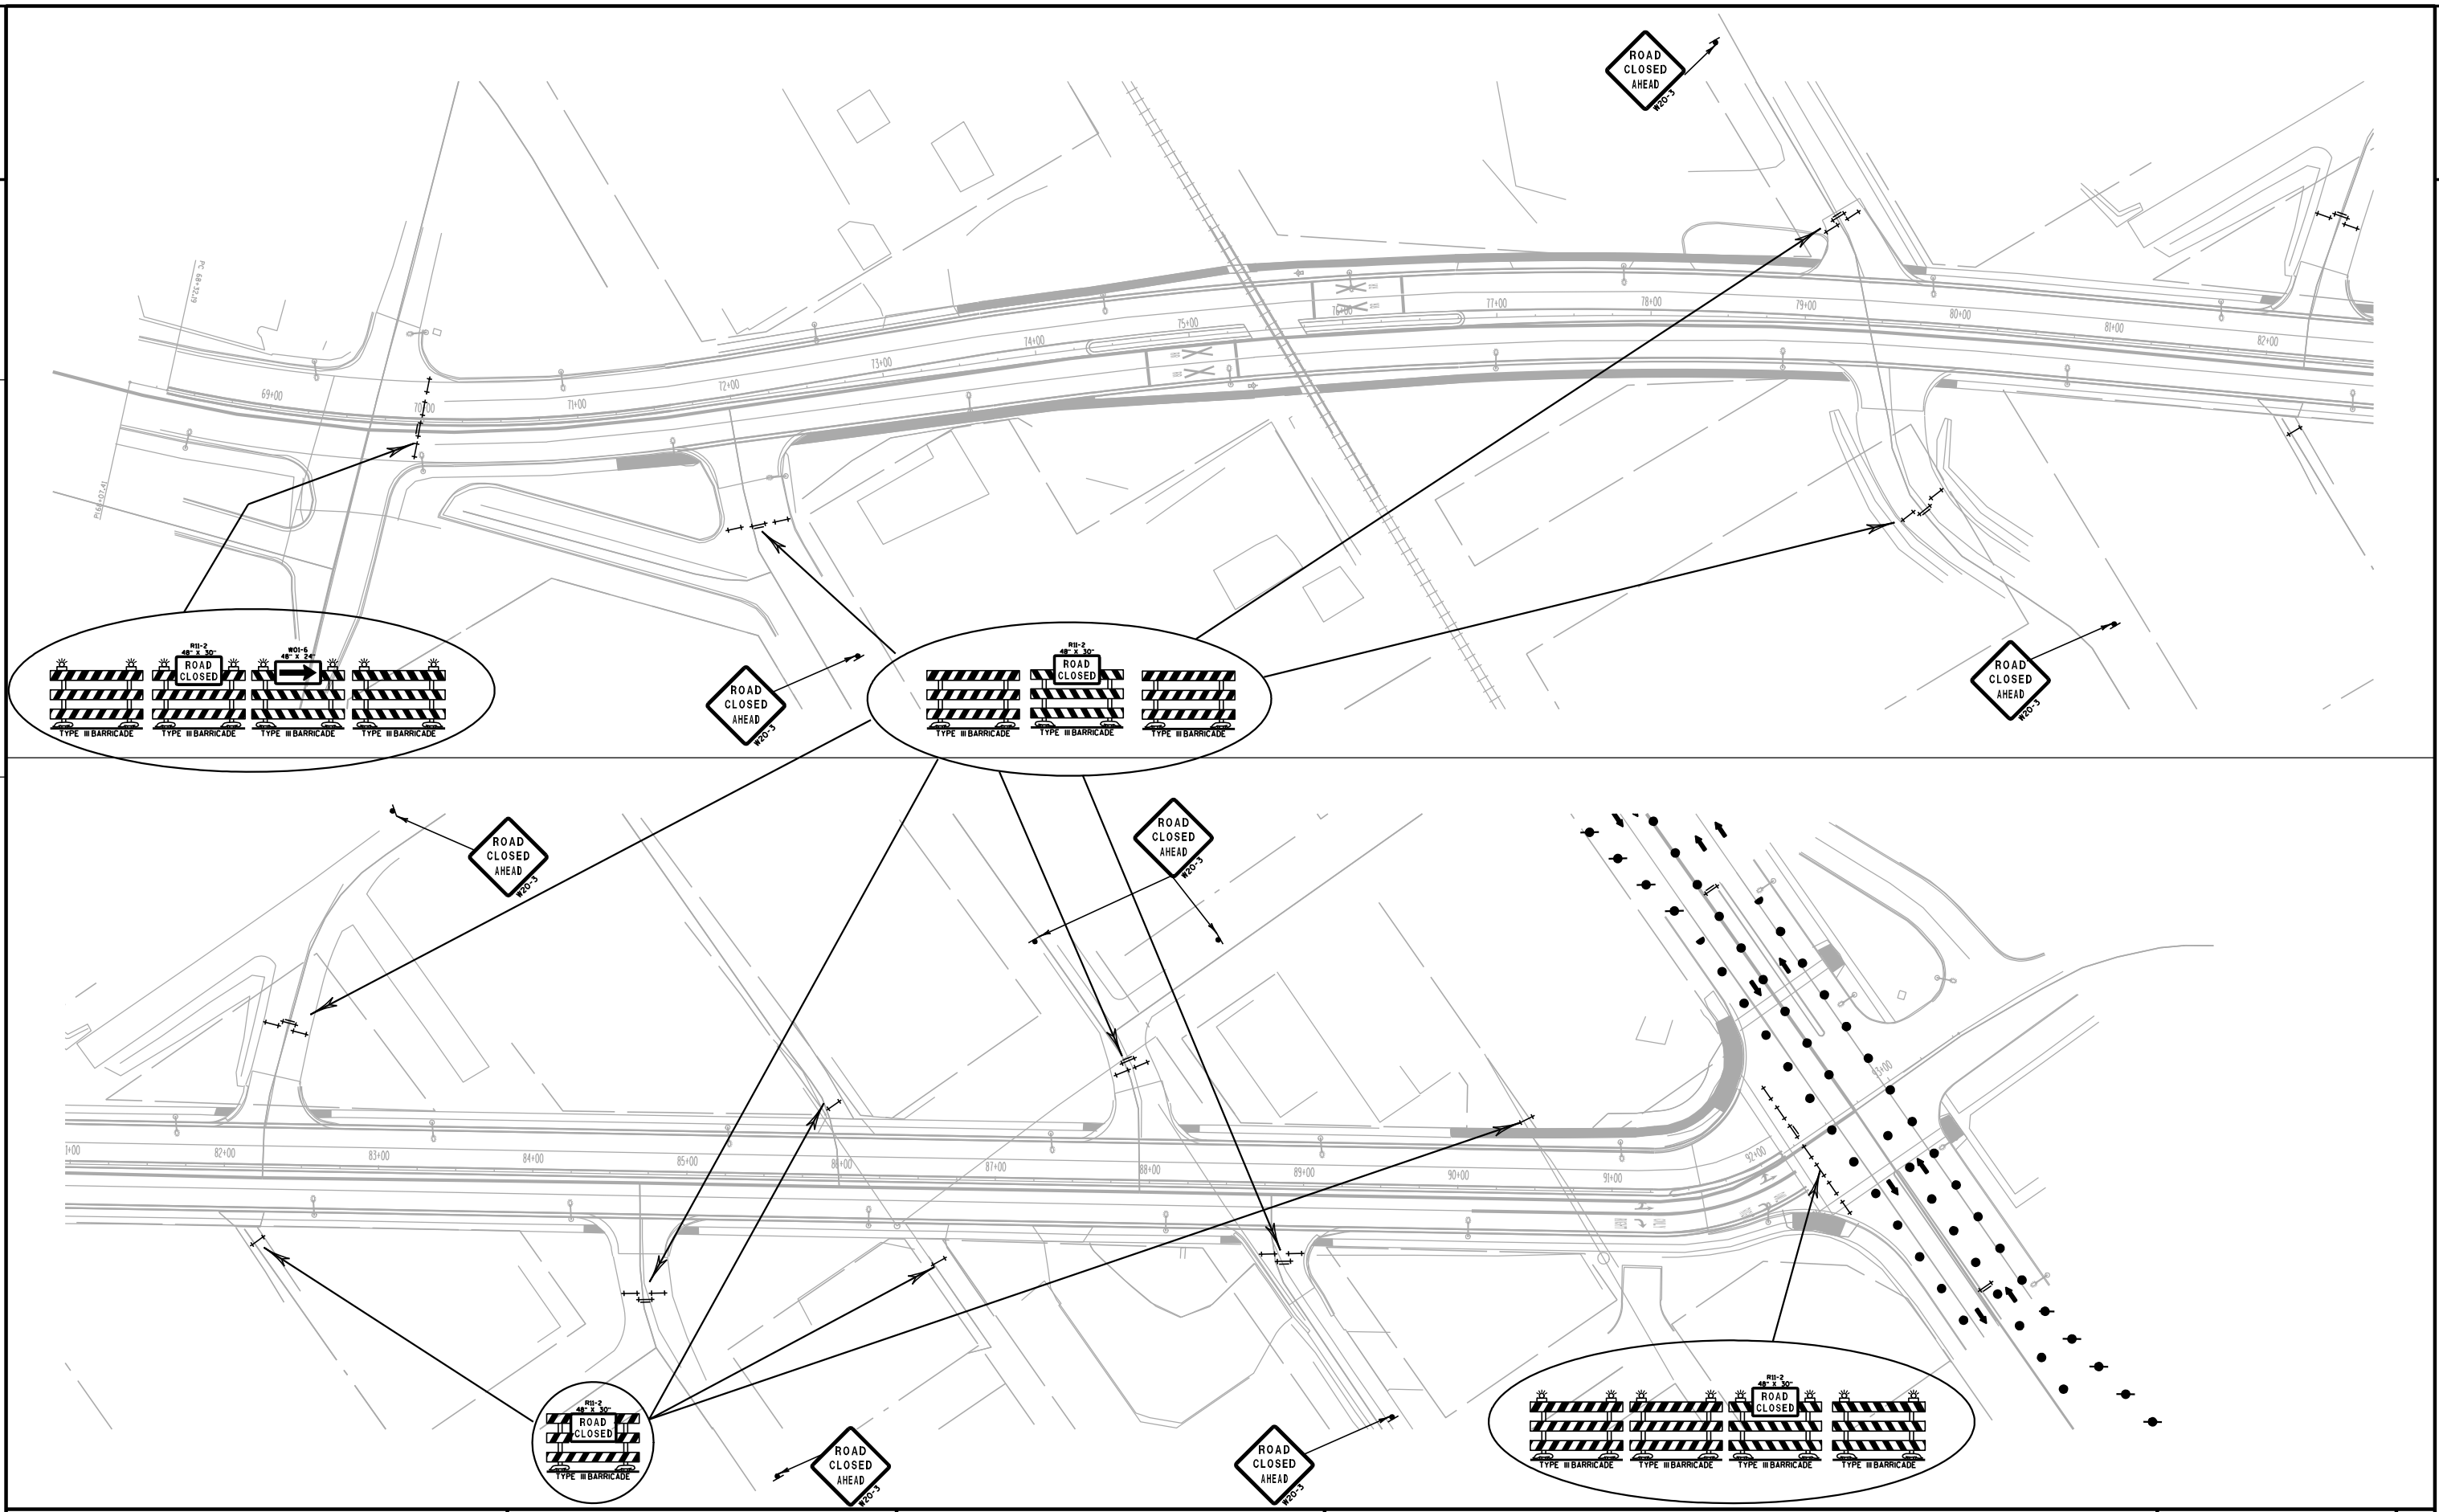

DATE 04APR11

## ESTIMATE OF QUANTITIES

LINE NUMBER	ITEM	ITEM DESCRIPTION	UNIT	TOTAL	1190-44-71 QUANTITY
0010	201.0120	CLEARING	ID	44.000	44.000
0020	201.0220	GRUBBING	ID	44.000	44.000
0030	203.0100	REMOVING SMALL PIPE CULVERTS	EACH	3.000	3.000
0040	204.0100	REMOVING PAVEMENT	SY	13,734.000	13,734.000
0050	204.0110	REMOVING ASPHALTIC SURFACE	SY	808.000	808.000
0060	204.0150	REMOVING CURB & GUTTER	LF	872.000	872.000
0070	204.0155	REMOVING CONCRETE SIDEWALK	SY	1,900.000	1,900.000
0080	204.0195	REMOVING CONCRETE BASES	EACH	5.000	5.000
0090	204.0215	REMOVING CATCH BASINS	EACH	17.000	17.000
0100	204.0245	REMOVING STORM SEWER (SIZE) 01.12-INCH	LF	196.000	196.000
0110	204.0245	REMOVING STORM SEWER (SIZE) 01.18-INCH	LF	113.000	113.000
0120	204.0245	REMOVING STORM SEWER (SIZE) 01.21-INCH	LF	164.000	164.000
0130	204.9165.S	REMOVING (ITEM DESCRIPTION) 01.MEDIAN E 2ND STREET	SF	65.000	65.000
0140	205.0100	EXCAVATION COMMON	CY	18,171.000	18,171.000
0150	208.1100	SELECT BORROW	CY	11,322.000	11,322.000
0160	211.0200	PREPARE FOUNDATION FOR CONCRETE PAVEMENT (PROJECT) 01.1190-44-71	LS	1.000	1.000
0170	213.0100	FINISHING ROADWAY (PROJECT) 01. 1190-44-71	EACH	1.000	1.000
0180	305.0110	BASE AGGREGATE DENSE 3/4-INCH	TON	64.000	64.000
0190	305.0120	BASE AGGREGATE DENSE 1 1/4-INCH	TON	16,213.000	16,213.000
0200	415.2000.S	INCENTIVE STRENGTH CONCRETE PAVEMENT	DOL	14,073.000	14,073.000
0210	416.0160	CONCRETE DRIVEWAY 6-INCH	SY	87.000	87.000
0220	416.0310	CONCRETE ALLEY	SY	28.000	28.000
0230	416.0610	DRI LLED TIE BARS	EACH	89.000	89.000
0240	416.0620	DRI LLED DOWEL BARS	EACH	100.000	100.000
0250	520.8000.S	CULVERT PIPE CONCRETE COLLAR	EACH	5.000	5.000
0260	522.1012	APRON ENDWALLS FOR CULVERT PIPE REINFORCED CONCRETE 12-INCH	EACH	3.000	3.000
0270	601.0409	CONCRETE CURB & GUTTER 30-INCH TYPE A	LF	4,303.000	4,303.000
0280	601.0411	CONCRETE CURB & GUTTER 30-INCH TYPE D	LF	198.000	198.000
0290	602.0405	CONCRETE SIDEWALK 4-INCH	SF	17,093.000	17,093.000
0300	602.0415	CONCRETE SIDEWALK 6-INCH	SF	965.000	965.000
0310	602.0510	CURB RAMP DETECTABLE WARNING FIELD WHITE	SF	224.000	224.000
0320	602.2400	CONCRETE SAFETY ISLANDS	SF	736.000	736.000
0330	608.0412	STORM SEWER PIPE REINFORCED CONCRETE CLASS IV 12-INCH	LF	316.000	316.000
0340	608.0418	STORM SEWER PIPE REINFORCED CONCRETE CLASS IV 18-INCH	LF	113.000	113.000
0350	608.0421	STORM SEWER PIPE REINFORCED CONCRETE CLASS IV 21-INCH	LF	164.000	164.000
0360	611.0101	CATCH BASINS TYPE 1	EACH	5.000	5.000
0370	611.0105	CATCH BASINS TYPE 3	EACH	10.000	10.000
0380	611.0201	MANHOLES TYPE 1	EACH	2.000	2.000
0390	611.0420	RECONSTRUCTING MANHOLES	EACH	1.000	1.000
0400	611.0530	MANHOLE COVERS TYPE J	EACH	2.000	2.000
0410	611.0600	INLET COVERS TYPE A	EACH	1.000	1.000
0420	611.0624	INLET COVERS TYPE H	EACH	16.000	16.000
0430	611.8110	ADJUSTING MANHOLE COVERS	EACH	10.000	10.000
0440	611.9800.S	PIPE GRATES	EACH	3.000	3.000
0450	612.0406	PIPE UNDERDRAIN WRAPPED 6-INCH	LF	4,057.000	4,057.000
0460	616.0700.S	FENCE SAFETY	LF	250.000	250.000
0470	618.0100	MAINTENANCE AND REPAIR OF HAUL ROADS (PROJECT) 01.1190-44-71	EACH	1.000	1.000

DATE 04APR11

## ESTIMATE OF QUANTITIES

LINE NUMBER	ITEM	ITEM DESCRIPTION	UNIT	TOTAL	1190-44-71 QUANTITY
0480	619.1000	MOBILIZATION	EACH	1.000	1.000
0490	620.0200	CONCRETE MEDIAN BLUNT NOSE	SF	94.000	94.000
0500	625.0100	TOPSOIL	SY	2,854.000	2,854.000
0510	628.1504	SILT FENCE	LF	165.000	165.000
0520	628.1520	SILT FENCE MAINTENANCE	LF	165.000	165.000
0530	628.1905	MOBILIZATIONS EROSION CONTROL	EACH	2.000	2.000
0540	628.1910	MOBILIZATIONS EMERGENCY EROSION CONTROL	EACH	2.000	2.000
0550	628.2006	EROSION MAT URBAN CLASS I TYPE A	SY	831.000	831.000
0560	628.7005	INLET PROTECTION TYPE A	EACH	17.000	17.000
0570	628.7015	INLET PROTECTION TYPE C	EACH	17.000	17.000
0580	628.7555	CULVERT PIPE CHECKS	EACH	3.000	3.000
0590	629.0210	FERTILIZER TYPE B	CWT	0.520	0.520
0600	630.0110	SEEDING MIXTURE NO. 10	LB	2.000	2.000
0610	630.0200	SEEDING TEMPORARY	LB	2.000	2.000
0620	631.0300	SOD WATER	MGAL	0.170	0.170
0630	631.1000	SOD LAWN	SY	2,023.000	2,023.000
0640	634.0801	POSTS TUBULAR STEEL 2X2-1NCH X 1.5-FT	EACH	36.000	36.000
0650	634.0803	POSTS TUBULAR STEEL 2X2-1NCH X 3-FT	EACH	36.000	36.000
0660	634.0808	POSTS TUBULAR STEEL 2X2-1NCH X 8-FT	EACH	22.000	22.000
0670	634.0812	POSTS TUBULAR STEEL 2X2-1NCH X 12-FT	EACH	14.000	14.000
0680	637.0202	SIGNS REFLECTIVE TYPE II	SF	329.000	329.000
0690	637.0402	SIGNS REFLECTIVE FOLDING TYPE II	SF	25.000	25.000
0700	638.2102	MOVING SIGNS TYPE II	EACH	4.000	4.000
0710	638.2602	REMOVING SIGNS TYPE II	EACH	62.000	62.000
0720	638.3000	REMOVING SMALL SIGN SUPPORTS	EACH	8.000	8.000
0730	642.5001	FIELD OFFICE TYPE B	EACH	1.000	1.000
0740	643.0200	TRAFFIC CONTROL SURVEILLANCE AND MAINTENANCE (PROJECT) 01.1190-44-71	DAY	60.000	60.000
0750	643.0300	TRAFFIC CONTROL DRUMS	DAY	5,040.000	5,040.000
0760	643.0420	TRAFFIC CONTROL BARRICADES TYPE III	DAY	2,820.000	2,820.000
0770	643.0705	TRAFFIC CONTROL WARNING LIGHTS TYPE A	DAY	1,320.000	1,320.000
0780	643.0715	TRAFFIC CONTROL WARNING LIGHTS TYPE C	DAY	1,200.000	1,200.000
0790	643.0800	TRAFFIC CONTROL ARROW BOARDS	DAY	120.000	120.000
0800	643.0900	TRAFFIC CONTROL SIGNS	DAY	2,760.000	2,760.000
0810	643.0905.S	TRAFFIC CONTROL COVERING SIGNS	EACH	8.000	8.000
0820	643.1000	TRAFFIC CONTROL SIGNS FIXED MESSAGE	SF	36.000	36.000
0830	643.2000	TRAFFIC CONTROL DETOUR (PROJECT) 01.1190-44-71	EACH	1.000	1.000
0840	643.3000	TRAFFIC CONTROL DETOUR SIGNS	DAY	4,140.000	4,140.000
0850	646.0106	PAVEMENT MARKING EPOXY 4-1NCH	LF	11,326.000	11,326.000
0860	646.0126	PAVEMENT MARKING EPOXY 8-1NCH	LF	185.000	185.000
0870	647.0110	PAVEMENT MARKING RAILROAD CROSSINGS EPOXY	EACH	4.000	4.000
0880	647.0166	PAVEMENT MARKING ARROWS EPOXY TYPE 2	EACH	7.000	7.000
0890	647.0176	PAVEMENT MARKING ARROWS EPOXY TYPE 3	EACH	2.000	2.000
0900	647.0356	PAVEMENT MARKING WORDS EPOXY	EACH	6.000	6.000
0910	647.0456	PAVEMENT MARKING CURB EPOXY	LF	568.000	568.000
0920	647.0566	PAVEMENT MARKING STOP LINE EPOXY 18-1NCH	LF	258.000	258.000
0930	647.0726	PAVEMENT MARKING DIAGONAL EPOXY 12-1NCH	LF	120.000	120.000
0940	647.0766	PAVEMENT MARKING CROSSWALK EPOXY 6-1NCH	LF	115.000	115.000
0950	649.0400	TEMPORARY PAVEMENT MARKING REMOVABLE TAPE 4-1NCH	LF	100.000	100.000
0960	650.4000	CONSTRUCTION STAKING STORM SEWER	EACH	32.000	32.000
0970	650.4500	CONSTRUCTION STAKING SUBGRADE	LF	5,291.000	5,291.000

DATE 04APR11

## ESTIMATE OF QUANTITIES

LINE NUMBER	ITEM	ITEM DESCRIPTION	UNIT	TOTAL	1190-44-71 QUANTITY
0980	650.5000	CONSTRUCTION STAKING BASE	LF	513.000	513.000
0990	650.5500	CONSTRUCTION STAKING CURB GUTTER AND CURB & GUTTER	LF	2,325.000	2,325.000
1000	650.7000	CONSTRUCTION STAKING CONCRETE PAVEMENT	LF	2,313.000	2,313.000
1010	650.8500	CONSTRUCTION STAKING ELECTRICAL INSTALLATIONS (PROJECT) 01.1190-44-71	LS	1.000	1.000
1020	650.9910	CONSTRUCTION STAKING SUPPLEMENTAL CONTROL (PROJECT) 01.1190-44-71	LS	1.000	1.000
1030	650.9920	CONSTRUCTION STAKING SLOPE STAKES	LF	2,645.000	2,645.000
1040	652.0225	CONDUIT RIGID NONMETALLIC SCHEDULE 40 2-INCH	LF	497.000	497.000
1050	652.0800	CONDUIT LOOP DETECTOR	LF	450.000	450.000
1060	653.0135	PULL BOXES STEEL 24X36-1NCH	EACH	4.000	4.000
1070	654.0101	CONCRETE BASES TYPE 1	EACH	1.000	1.000
1080	654.0102	CONCRETE BASES TYPE 2	EACH	1.000	1.000
1090	654.0105	CONCRETE BASES TYPE 5	EACH	5.000	5.000
1100	655.0610	ELECTRICAL WIRE LIGHTING 12 AWG	LF	1,171.000	1,171.000
1110	655.0800	LOOP DETECTOR WIRE	LF	1,566.000	1,566.000
1120	690.0150	SAWING ASPHALT	LF	378.000	378.000
1130	690.0250	SAWING CONCRETE	LF	387.000	387.000
1140	999.1500.S	CRACK AND DAMAGE SURVEY	LS	1.000	1.000
1150	SPV.0035	SPECIAL 01. QMP, SELECT BORROW	CY	11,322.000	11,322.000
1160	SPV.0060	SPECIAL 01. REMOVE, SALVAGE, AND RELOCATE EXISTING LIGHT EQUIPMENT	EACH	25.000	25.000
1170	SPV.0060	SPECIAL 02. CLEANING CATCH BASINS	EACH	4.000	4.000
1180	SPV.0060	SPECIAL 03. CONNECT EXISTING SANITARY SEWER	EACH	2.000	2.000
1190	SPV.0090	SPECIAL 01. CONCRETE CURB AND GUTTER CURE AND SEAL TREATMENT	LF	4,501.000	4,501.000
1200	SPV.0090	SPECIAL 02. REMOVING SANITARY SEWER	LF	110.000	110.000
1210	SPV.0090	SPECIAL 03. SANITARY SEWER 10-INCH	LF	110.000	110.000
1220	SPV.0105	SPECIAL 01. CONSTRUCTION STAKING CONCRETE PAVEMENT JOINT LAYOUT	LS	1.000	1.000
1230	SPV.0105	SPECIAL 02. PROJECT CRACK MITIGATION AND REPAIR SPECIAL	LS	1.000	1.000
1240	SPV.0165	SPECIAL 01. PAVEMENT MARKING CROSSWALK EPOXY SPECIAL	SF	2,683.000	2,683.000
1250	SPV.0165	SPECIAL 02. CONCRETE SIDEWALK CURE AND SEAL TREATMENT	SF	20,018.000	20,018.000
1260	SPV.0165	SPECIAL 03. CONCRETE 15 1/2-INCH MEDIAN SPECIAL	SF	1,224.000	1,224.000
1270	SPV.0180	SPECIAL 01. CONCRETE PAVEMENT 9 1/2-INCH SPECIAL	SY	14,073.000	14,073.000
1280	SPV.0195	SPECIAL 01. ASPHALTIC SURFACE SPECIAL	TON	196.000	196.000

**CLEARING AND GRUBBING**

STATION	LOCATION	201.0120 ID	201.0220 ID	REMARKS
91+10	50' LT	26.0	26.0	
91+25	60' LT	10.0	10.0	
93+14	86' LT	8	8	
TOTAL 0010		<u>44</u>	<u>44</u>	

**REMOVING ASPHALTIC SURFACE**

STATION	LOCATION	204.0110 SY	REMARKS
78+06	LT E 5TH ST	71	E 7TH ST
		28	CE
		93	CE
		71	E 5TH ST SE
82+15	RT	51	E 5TH ST NW
		40	ALLEY
		58	2ND AVE
		54	E 4TH ST SE
86+01	LT	47	ALLEY
86+50	RT	43	ALLEY
87+48	RT E 3RD ST	38	E 3RD ST SE
		31	CE
		109	CE
75+55	ML	58	E 3RD ST NW
		17	TEMP RAIL CROSSING
TOTAL 0010		<u>808</u>	

**REMOVING SMALL PIPE CULVERTS**

STATION	LOCATION	203.0100 EACH	REMARKS
75+25	RT	1	12" PVC PIPE
79+25	RT	1	12" PVC PIPE
79+90	RT	1	12" PVC PIPE
TOTAL 0010		<u>3</u>	

**REMOVING PAVEMENT**

STATION TO	STATION	LOCATION	204.0100 SY	REMARKS
71+00	-	92+32	12318	M/L
			157	E 7TH ST
			231	E 5TH ST SE
			167	E 5TH ST NW
			153	2ND AVE
			115	E 4TH ST SE
			185	E 3RD ST SE
			168	E 3RD ST NW
			211	E 2ND ST RADIUS
			29	E 2ND ST LT TURN
TOTAL 0010			<u>13734</u>	

**REMOVING CURB & GUTTER**

LOCATION	204.0150 LF	REMARKS
RT	86	7TH ST RADIUS
RT	91	5TH ST RADIUS
RT	80	4TH ST RADIUS
RT	129	3RD ST RADIUS
RT	61	2ND ST RADIUS
LT	40	CE
LT	91	5TH ST RADIUS
LT	80	2ND AVE RADIUS
LT	129	3RD ST RADIUS
LT	85	2ND ST RADIUS
TOTAL 0010		<u>872</u>

REMOVING CONCRETE SIDEWALK

STATION TO	STATION	LOCATION	204.0155 SY	REMARKS
71+00	- 71+74	RT	49	6 FT WIDTH
72+31	- 79+30	RT	388	5 FT WIDTH
79+92		RT	6	CURB RAMP
84+43		RT	6	CURB RAMP
84+99		RT	6	CURB RAMP
86+60	- 86+72	RT	7	5 FT WIDTH
87+24	- 87+63	RT	22	5 FT WIDTH
88+57		RT	6	CURB RAMP
89+15		RT	8	CURB RAMP
92+05	- 92+38	RT	86	E 2ND RADIUS
93+23		RT	8	CURB RAMP
	UNDISTRIBUTED	RT	475	
73+50	- 79+08	LT	310	5 FT WIDTH
79+69		LT	6	CURB RAMP
82+04		LT	6	CURB RAMP
82+60		LT	6	CURB RAMP
85+90	- 86+15	LT	14	5 FT WIDTH
87+65		LT	6	CURB RAMP
88+23		LT	6	CURB RAMP
93+23		LT	8	CURB RAMP
	UNDISTRIBUTED	LT	475	
TOTAL 0010			1900	

REMOVING MEDIAN E 2ND STREET

TATION TO	STATION	LOCATION	204.9165.S SF	REMARKS
12+18	12+91		65	E 2ND ST LT TURN
TOTAL 0010			65	

REMOVING CONCRETE BASES

STATION	LOCATION	204.0195 EACH	REMARKS
73+53	RT	1	LP14
74+47	LT	1	LP44
75+24	RT	1	LP15
76+05	LT	1	LP51
76+98	RT	1	LP21
TOTAL 0010		5	

REMOVING SS ITEMS

CATEGORY	STRUCT NO.	STATION TO	STATION	LOCATION	CATCH BASINS 204.0215 EACH	SS		SS		REMARKS	
						12-INCH 204.0245 LF	18-INCH 204.0245 LF	21-INCH 204.0245 LF			
0010	3L	71+17.9	-27.5	LT	1						
0010	4R	71+64.51	30.3	RT	1	54					
	4C			RT							
0010	5L	72+33.91	-27.5	LT	1	8					
0010	6X	72+20.78	32.6	RT							
0010	7L	73+66.18	-28.3	LT	1	4					
0010	8X	73+57.43	31.6	RT		4					
0010	9X			RT							
0010	9D			RT		14					
0010	10X	76+42.91	32.0	RT			113				
0010	11L	78+94.5	-28.4	LT	1	8					
0010	12R	78+82.54	28.3	LT	1	4					
0010	12X	78+79.82	33.1	RT					164		
0010	12D	79+19.5	62.5	RT		20					
0010	14R	80+41.16	28.1	RT	1	4					
0010	14X	80+43.66	32.9	RT							
0010	14D	80+00	57.6	RT		20					
0010	14Z	80+11.6	33.7	RT							
0010	13L	81+26.18	-28.2	LT	1	16					
0010	16R	81+26.12	28.4	RT	1	6					
0010	16X	81+26.12	28.4	RT							
0010	18R	83+95.54	28.2	RT	1						
0010	18X	83+95.75	33.1	RT		6					
0010	15L	85+53.74	-28.4	LT	1						
0010	20R	85+14.65	28.1	RT	1						
0010	20X	85+16.8	33.1	RT		6					
0010	22R	86+32.65	28.2	RT	1						
0010	22X	86+29.91	33.3	RT		6					
0010	17L	87+50.1	-28.2	LT	1	16					
0010	24R	87+51.65	34.6	RT	1						
0010	19L	92+12.2	-50.4	LT	1						
0010	26R	91+56.11	29.8	RT	1						
0010	26X	91+57.06	38.5	RT							
TOTAL 0010						17	196	113	164		



### EARTHWORK SUMMARY

3

3

Division	From/To Station	Location	Common Excavation (1)	(item # 205.0100) EBS Excavation (3)	Available Material (5)	Reduced Marsh in Fill (8) Factor 0.60	Reduced EBS in Fill (9) Factor 0.80	Expanded Marsh Backfill (10) Factor 1.50	Expanded EBS Backfill (11) Factor 1.30	Expanded Rock (12) Factor 1.10	Unexpanded Fill	Expanded Fill (13) Factor 1.25	Mass Ordinate +/- (14)	Waste	Borrow	Comment:
1			10,707	7,464	10,707	0	5,971	0	9,703	0	162	203	10,504	10,504	0	
					0	0	0	0	0	0			0	0	0	
					0	0	0	0	0	0			0	0	0	
Division 1 Subtotal			10,707	7,464	10,707	0	5,971	0	9,703	0	162	203	10,504	10,504		
			0	0	0	0	0	0	0	0	0	0	0			
Grand Total			10,707.19	7,464.03	10,707.19	0.00	5,971.23	0.00	9,703.24	0.00	162.42	203.02	10,504.17	10,504.17	0.00	
			Total Common Exc 18,171													

- 1) Common Excavation is the sum of the Cut and EBS Excavation columns. Item number 205.0100
  - 2) Salvaged/Unusable Pavement Material is included in Cut.
  - 3) EBS Excavation to be backfilled with Select Borrow material. Note: this is designers choice, can be backfilled with Borrow, or Cut as well.
  - 4) Salvaged/Unusable Pavement Material
  - 5) Available Material = Cut - Salvaged/Unusable Pavement Material
  - 6) Marsh Excavation - to be backfilled with Select Borrow Material. Note: this is designers choice, can be backfilled with Borrow, or Cut as well. Item number 20505
  - 7) Rock Excavation item number 205.0200
  - 8) Reduced Marsh in Fill - Excavated Marsh material is usable in Fills outside the 1:1 slope. Marsh in Fill Reduction factor = 0.6
  - 9) Reduced EBS in Fill - Excavated EBS material is usable in Fills outside the 1:1 slope. EBS in Fill Reduction factor = 0.8
  - 10) Expanded Marsh Backfill - This is to be filled with Select Borrow material. Marsh Backfill Factor = 1.5. Item number 208.1100
  - 11) Expanded EBS Backfill - This is to be filled with Select Borrow material. EBS Backfill Factor = 1.3. Item number 208.1100
  - 12) Expanded Rock - Factor = 1.1
  - 13) Expanded Fill. Factor = 1.25
- Depending on selections: **Expanded Fill = (Unexpanded Fill - Rock \* Rock Factor - Reduced Marsh - Reduced EBS) \* Fill Factor**
- Or Expanded Fill = (Unexpanded Fill - Rock \* Rock Factor - Reduced EBS) \* Fill Factor
- Or Expanded Fill = (Unexpanded Fill - Rock \* Rock Factor - Reduced Marsh) \* Fill Factor
- Or Expanded Fill = (Unexpanded Fill - Rock \* Rock Factor) \* Fill Factor
- 14) The Mass Ordinate + or - Qty calculated for the Division. Plus quantity indicates an excess of material within the Division. Minus indicates a shortage of material within the Division.
  - 15) Use 111,764 CY of material from Division 1. Borrow Excavation item number 208.0100

**SELECT BORROW SUMMARY**

OMP  
 SELECT BORROW 208. 1100  
 SELECT BORROW SPV. 0035. 01

STATION TO	STATION	LOCATION	CY	CY	REMARKS
71+00 -	92+32		9703 *	9703	ROAD BASE M/L
			146	146	ROAD BASE E 7TH ST
			153	153	ROAD BASE E 5TH ST SE
			195	195	ROAD BASE E 5TH ST NW
	82+15		43	43	ROAD BASE ALLEY
			141	141	ROAD BASE 2ND AVE
			110	110	ROAD BASE E 4TH ST SE
	86+01		43	43	ROAD BASE ALLEY
	86+50		43	43	ROAD BASE ALLEY
			158	158	ROAD BASE E 3RD ST SE
			152	152	ROAD BASE E 3RD ST NW
			137	137	ROAD BASE E 2ND ST
			37	37	SI DEWALK 6" SW
			260	260	SI DEWALK 4" SW
TOTAL 0010			11322	11322	

\* ALSO SHOWN ON EARTHWORK SUMMARY.

**BASE AGGREGATE DENSE 3/4-INCH**

STATION	LOCATION	305. 0110 TON	REMARKS
86+01	LT	8	ALLEY
75+55	LT & RT	56	RR TERRACE ASPH & SI DEWALK
TOTAL 0010		64	

**BASE AGGREGATE DENSE 1 1/4-INCH**

STATION TO	STATION	LOCATION	305. 0120 TON	REMARKS
71+00 -	92+32		14089	M/L
72+00	79+25		236	MEDIAN FLARE AREA
			220	E 7TH ST
			229	E 5TH ST SE
			293	E 5TH ST NW
	82+15		33	ALLEY
			211	2ND AVE
			165	E 4TH ST SE
	86+01		33	ALLEY
	86+50		33	ALLEY
			237	E 3RD ST SE
			228	E 3RD ST NW
			206	E 2ND ST
TOTAL 0010			16213	

**CONCRETE SAFETY ISLAND SUMMARY**

SAFETY ISLAND 602. 2400 SF  
 SI DEWALK CURE & SEAL SPV. 0165(02) SF

STATION TO	STATION	LOCATION	SF	SF	REMARKS
91+07 -	92+12	CL	420	420	4 FT WIDTH
12+20 -	12+53	CL	132	132	4 FT WIDTH
12+61 -	13+07	CL	184	184	4 FT WIDTH
TOTAL 0010			736	736	**

\*\* ADDITIONAL QUANTITY SHOWN WITH CAT 0010 SI DEWALK, CAT 0020 SI DEWALK, AND 15 1/2" MEDIAN SPECIAL.

**SPECIAL (01. CONCRETE PAVEMENT 9 1/2- INCH SPECIAL)**

STATION TO	STATION	LOCATION	SPV. 0180(01) SY	REMARKS
71+00 -	92+32		12318	M/L
72+00	79+25		242	MEDIAN FLARE AREA
			157	E 7TH ST
			231	E 5TH ST SE
			167	E 5TH ST NW
			153	2ND AVE
			115	E 4TH ST SE
			185	E 3RD ST SE
			168	E 3RD ST NW
			211	E 2ND ST RADIUS
			126	E 2ND ST LT TURN/MEDIAN
TOTAL 0010			14073	

**FINISHING ROADWAY (1190-44-71)**

LOCATION	213. 0100 EACH	REMARKS
	1	
TOTAL 0010	1	

**CONCRETE ALLEY**

STATION	LOCATION	416. 0310 SY	REMARKS
82+15	RT	9	ALLEY
86+01	LT	9	ALLEY
86+50	RT	9	ALLEY
TOTAL 0010		28	

**CONCRETE DRIVEWAY 6-INCH**

STATION	LOCATION	416. 0160 SY	REMARKS
73+17	LT	16	
73+40	LT	16	
76+90	LT	19	
78+06	LT	18	
87+48	RT	18	
TOTAL 0010		87	

**DRILLED TIE BARS**

STATION	LOCATION	416.0610 EACH	REMARKS
93+00	LT	60	E 2ND ST LT TURN/MEDI AN
		29	2ND ST CURB RAMPS
TOTAL 0010		<u>89</u>	

**DRILLED DOWEL BARS**

STATION	LOCATION	416.0620 EACH	REMARKS
71+00		29	
92+32		53	
12+18		4	
12+63		5	
12+91		9	
TOTAL 0010		<u>100</u>	

**PIPE UNDERDRAIN WRAPPED 6-INCH**

STATION TO	STATION	LOCATION	612.0406 LF	REMARKS
71+17.9	- 75+25	LT	407	3L TO RR
71+17.9	- 75+50	RT	432	START TO RR
75+60	- 92+12	LT	1652	RR TO 19L
75+90	- 91+56	RT	1566	RR O 26R
TOTAL 0010			<u>4057</u>	

**CULVERT PIPE CONCRETE COLLAR**

STATION	LOCATION	520.8000.S EACH	REMARKS
77+56	RT	1	
72+30	LT	1	
73+57	RT	1	
78+94	LT	1	
87+50	LT	1	
TOTAL 0010		<u>5</u>	

**CONCRETE CURB AND GUTTER SUMMARY**

STATION TO	STATION	LOCATION	C&G TYPE A 601.0409 LF	C&G TYPE D 601.0411 LF	CURE & SEAL TREATMENT SPV.0090.01 LF	REMARKS
71+00	- 71+59	RT	59		59	
9+28	9+45	SR		34	34	7TH STREET ASPH.
		RT	86		86	7TH ST RADIUS
72+49	- 75+25	RT	276		276	
		RT	91		91	5TH ST RADIUS
75+25	- 75+56	RT		32	32	C&G IN ASPHALT
75+87	- 79+09	RT	323		323	
80+06	- 84+32	RT	426		426	
		RT	80		80	4TH ST RADIUS
85+12	- 88+43	RT	331		331	
8+91	9+13	SR		44	44	3RD STREET ASPH.
		RT	129		129	3RD ST RADIUS
89+29	- 91+84	RT	255		255	
		RT	61		61	2ND ST RADIUS
71+00	- 75+25	LT	425		425	
75+55	75+87	LT		32	32	C&G IN ASPHALT
75+87	78+88	LT	302		302	
		LT	40		40	CE
		LT	91		91	5TH ST RADIUS
79+80	- 81+89	LT	209		209	
		LT	80		80	2ND AVE RADIUS
82+73	- 87+52	LT	479		479	
		LT	129		129	3RD ST RADIUS
88+37	- 91+25	LT	288		288	
		LT	85		85	2ND ST RADIUS
			60		60	2ND ST CURB RAMPS
75+25	- 75+38	MEDI AN		28	28	MEDI AN IN ASPHALT
75+72	- 75+87	MEDI AN		29	29	MEDI AN IN ASPHALT
TOTAL 0010			<u>4303</u>	<u>198</u>	<u>4501</u>	

**CONCRETE SIDEWALK**

STATION TO	STATION	LOCATION	SI DEWALK 4-INCH 602.0405 SF	SI DEWALK 6-INCH 602.0415 SF	SI DEWALK CURE & SEAL SPV. 0165(02) SF	REMARKS
71+00 - 71+74		RT	444		444	6 FT WIDTH
72+31 - 79+30		RT	3495		3495	5 FT WIDTH
79+92		RT	50		50	CURB RAMP
79+75 - 82+07		RT	1160		1160	5 FT WIDTH
82+07 - 82+23		RT		80	80	ALLEY
84+43		RT	50		50	CURB RAMP
84+99		RT	50		50	CURB RAMP
86+60 - 86+72		RT		60	60	ALLEY
87+24 - 87+63		RT		195	195	CE
88+57		RT	50		50	CURB RAMP
89+15		RT	75		75	CURB RAMP
92+05 - 92+38		RT	86		86	E 2ND RADIUS
93+23		RT	75		75	CURB RAMP
UNDI STRIBUTED		RT	2000		2000	
73+05 - 73+52		LT		235	235	PE
76+72 - 77+07		LT		175	175	FE
77+92 - 78+20		LT		140	140	CE
73+50 - 79+08		LT	2615		2615	5 FT WIDTH
79+69		LT	50		50	CURB RAMP
79+75 - 82+00		LT	1125		1125	5 FT WIDTH
82+04		LT	50		50	CURB RAMP
82+60		LT	50		50	CURB RAMP
85+93 - 86+09		LT		80	80	ALLEY
85+90 - 91+25		LT	2595		2595	5 FT WIDTH
87+65		LT	50		50	CURB RAMP
88+23		LT	50		50	CURB RAMP
93+23		LT	75		75	CURB RAMP
UNDI STRIBUTED		LT	2000		2000	
TOTAL 0010			16195**	965	17160*	

\*ADDITIONAL QUANTITY SHOWN WITH 15 1/2" MEDIUM SPECIAL, SAFETY ISLAND, AND CATEGORY 0020 SIDEWALK  
 \*\*ADDITIONAL QUANTITY IN CATEGORY 0020

**CURB RAMP DETECTABLE WARNING FIELD WHITE**

STATION	LOCATION	602.0510 SF	REMARKS
71+71	RT	8	7TH ST
72+32	RT	8	7TH ST
75+30	LT	8	RR
75+44	LT	8	RR
75+70	RT	8	RR
75+82	RT	8	RR
79+00	LT	8	5TH ST
79+70	LT	8	5TH ST
79+26	RT	8	5TH ST
79+89	RT	8	5TH ST
79+79	LT	8	SW
80+00	RT	8	SW
82+03	LT	8	2ND AVE
82+61	LT	8	2ND AVE
84+45	RT	8	4TH ST
84+97	RT	8	4TH ST
87+65	LT	8	3RD ST
88+24	LT	8	3RD ST
88+57	RT	8	3RD ST
89+16	RT	8	3RD ST
92+16	LT & RT	24	2ND ST
92+35	LT	8	2ND ST
93+10	LT & RT	16	2ND ST
93+21	LT & RT	16	2ND ST
TOTAL 0010		224	

**CONCRETE SIDEWALK**

STATION TO	STATION	LOCATION	SI DEWALK 4-INCH 602.0405 SF	SI DEWALK CURE & SEAL SPV. 0165(02) SF	REMARKS
91+25 - 92+44		LT	898	898	
TOTAL 0020			898	898	***

\*\*\*ADDITIONAL QUANTITY SHOWN WITH 15 1/2" MEDIUM SPECIAL, SAFETY ISLAND, AND CATEGORY 0010 SIDEWALK

**FENCE SAFETY**

LOCATION	616.0700. S LF	REMARKS
SIDEWALK	250	UNDISTRIBUTED LOCATIONS
TOTAL 0010	<u>250</u>	

**CONCRETE MEDIAN BLUNT NOSE**

STATION	LOCATION	620.0200 SF	REMARKS
74+35		28	
76+75		28	
91+38		13	
92+16		13	
12+91		13	E 2ND ST
TOTAL 0010		<u>94</u>	

**GARDENING ITEMS**

STATION TO	STATION	LOCATION	TOPSOIL 625.0100 SY	FERTILIZER TYPE B 629.0210 CWT	SEEDING NO. 10 630.0110 LB	SEEDING TEMP 630.0200 LB	EMAT URBAN CL 1 TYPE A 628.2006 SY	REMARKS
74+50	- 75+60	RT	61.11	0.04	0.83	0.83	61.11	
90+00	- 92+32	LT	769.67	0.48	0.83	0.83	769.67	
TOTAL 0010			<u>831 *</u>	<u>0.52</u>	<u>2</u>	<u>2</u>	<u>831</u>	

\* ADDITIONAL QUANTITY SHOWN WITH SOD ITEMS.

**TRAFFIC CONTROL DETOUR (PROJECT)**

LOCATION	643.2000 EACH	REMARKS
	1	
TOTAL 0010	<u>1</u>	

**TRAFFIC CONTROL SURVEILLANCE AND MAINTENANCE (PROJECT)**

LOCATION	643.0200 DAYS	REMARKS
	60	
TOTAL 0010	<u>60</u>	

**SPECIAL (03. CONCRETE 15 1/2 - INCH MEDIAN SPECIAL)**

STATION TO	STATION	LOCATION	SPV. 0165(03) SF	SPV. 0165(02) SF	REMARKS
74+37	- 75+38		606	606	RR CROSSING
75+72	- 76+75		618	618	RR CROSSING
TOTAL 0010			<u>1224</u>	<u>1224 **</u>	

\*\* ADDITIONAL QUANTITY SHOWN WITH CAT 0010 SIDEWALK, CAT 0020 SIDEWALK, AND SAFETY ISLANDS.

**MAINTENANCE AND REPAIR OF HAUL ROADS (1190-44-71)**

LOCATION	618.0100 EACH	REMARKS
PROJECT	1	
TOTAL 0010	<u>1</u>	

**MOBILIZATION**

LOCATION	619.1000 EACH	REMARKS
PROJECT	1	
TOTAL 0010	<u>1</u>	

**EROSION CONTROL DEVICES**

CAT.	STRUCTURE NUMBER	STATION	OFFSET	LOCATION	SILT FENCE	SILT FENCE MAINT.	CULVERT PIPE CHECK	INLET PROTECTION TYPE A	INLET PROTECTION TYPE C	CLEANING CATCH BASINS	REMARKS
					628. 1504 LF	628. 1504 LF	628. 7555 EACH	628. 7005 EACH	628. 7015 EACH	SPV. 0060. 02 EACH	
0010	3L	71+17.9	-27.5	LT				1	1		
0010	4R	71+64.51	30.3	RT				1	1		
0010	4C	71+65.78	87.6	RT						1	
0010	4B	71+66.47	120.8	RT						1	
0010	5L	72+33.91	-27.5	LT				1	1		
0010	6X	72+20.78	32.6	RT							
0010	7L	73+66.18	-28.3	LT				1	1		
0010	8X	73+57.43	31.6	RT							
0010	9X			RT							
0010	9D			RT	65	65	1				TOE OF SLOPE
0010	10X	76+42.91	32.0	RT							
0010		77+50	150.0	RT	100	100					WETLAND
0010	11L	78+94.5	-28.4	LT				1	1		
0010	12R	78+82.54	28.3	LT				1	1		
0010	12X	78+79.82	33.1	RT							
0010	12D	79+19.5	62.5	RT			1				
0010	14R	80+41.16	28.1	RT				1	1		
0010	14X	80+43.66	32.9	RT							
0010	14D	80+00	57.6	RT			1				
0010	14Z	80+11.6	33.7	RT							
0010	13L	81+26.18	-28.2	LT				1	1		
0010	16R	81+26.12	28.4	RT				1	1		
0010	16X	81+26.12	28.4	RT							
0010	18R	83+95.54	28.2	RT				1	1		
0010	18X	83+95.75	33.1	RT							
0010	15L	85+53.74	-28.4	LT				1	1		
0010	20R	85+14.65	28.1	RT				1	1		
0010	20X	85+16.8	33.1	RT							
0010	22R	86+32.65	28.2	RT				1	1		
0010	22X	86+29.91	33.3	RT							
0010	17L	87+50.1	-28.2	LT				1	1		
0010	24R	87+51.65	34.6	RT				1	1		
0010	19L	92+12.2	-50.4	LT				1	1		
0010	26B	91+34.37	85.9	RT						1	
0010	26C	91+29.01	48.7	RT						1	
0010	26R	91+56.11	29.8	RT				1	1		
0010	26X	91+57.06	38.5	RT							

TOTAL 0010    165    165    3    17    17    4

**SOD ITEMS**

STATION TO	STATION	LOCATION	TOPSOIL	SOD LAWN	SOD WATER	REMARKS
			625. 0100 SY	631. 1000 SY	631. 0300 MGAL	
71+00	- 73+05	LT	114	114	0.00958	
73+57	- 75+25	LT	93	93	0.00785	
75+56	- 76+77	LT	67	67	0.00566	
77+10	- 77+88	LT	43	43	0.00365	
78+27	- 79+00	LT	41	41	0.00341	
		LT	63	63	0.00526	5TH ST
79+81	- 82+00	LT	122	122	0.01024	
		LT	28	28	0.00234	2ND AVE
82+64	- 85+86	LT	179	179	0.01505	
86+20	- 87+60	LT	78	78	0.00655	
		LT	28	28	0.00234	3RD ST
88+27	- 92+00	LT	207	207	0.01744	
		RT	56	56	0.00468	E7TH
74+35	- 75+54	RT	66	66	0.00556	
		RT	56	56	0.00468	5TH ST
75+92	- 79+22	RT	183	183	0.01543	
80+02	- 81+97	RT	108	108	0.00912	
82+25	- 84+41	RT	120	120	0.01010	
		RT	56	56	0.00468	4TH ST
85+03	- 86+44	RT	78	78	0.00659	
86+69	- 87+26	RT	32	32	0.00266	
87+62	- 88+53	RT	51	51	0.00425	
89+19	- 92+00	RT	156	156	0.01314	
TOTAL 0010			2023 *	2023	0.17	

\* ADDITIONAL QUANTITY SHOWN ON GARDENING SUMMARY

**MOBILIZATIONS EROSION CONTROL**

LOCATION	628. 1905 EACH	REMARKS
	2	
TOTAL 0010	2	

**MOBILIZATIONS EMERGENCY EROSION CONTROL**

LOCATION	628. 1910 EACH	REMARKS
	2	
TOTAL 0010	2	

3

3

**STORM SEWER SUMMARY**

STRUCTU CAT.	RIM NUMBER	SUMP FEET	DEPTH FEET	STATION	OFFSET	LOCATION	RCP	AEW FOR	PIPE	RCP	RCP	ADJUST	RECONST.	MH COVER	CATCH	CATCH	MANHOLE	INLET	INLET	CONST.	REMARKS	
							CLASS IV	RCP	GRATES	CLASS IV	CLASS IV	MH COVERS	MANHOLES	TYPE J	BASIN	BASIN	TYPE 1	TYPE A	TYPE H	SS		
							608.0412	522.1012	611.9800.S	608.0418	608.0421	611.8110	611.0420	611.0530	611.0101	611.0105	611.0201	611.0600	611.0624	650.4000		
0010	3L	629.12	624.9	3.39	71+17.9	-27.5	LT									1			1	1		
0010	4R	628.8	624.05	3.92	71+64.51	28.3	RT	74							1				1	1		
0010	4C	629.58	UNKNOWN	-	71+65.78	87.6	RT															
0010	5L	628.535	624.21	3.49	72+33.91	-27.9	LT	8								1			1	1		
0010	6X	628.773	624.53	4.24	72+20.78	32.6	RT					1									1	
0010	7L	628.336	623.8	3.70	73+66.18	-30.6	LT	4								1			1	1		
0010	8X	628.444	623.98	4.46	73+57.43	31.6	RT	4					1				1			1	REALIGN LID OFFSET	
0010	9X	630.414	623.414	5.96	75+25.84	35.2	RT							1			1				1	
0010	9D	626.2	-	-	75+25.84	60.4	RT	20	1	1											1	
0010	10X	629.7	623.02	6.68	76+42.91	32.0	RT				113			1							1	
0010	11L	626.306	622.23	3.24	78+94.5	-28.5	LT	8								1			1	1		
0010	12R	626.44	621.02	4.59	78+82.54	27.9	RT	6							1				1	1		
0010	12X	627.262	622.46	4.80	78+79.82	33.1	RT				164		1								1	
0010	12D	624.5	-	-	79+19.5	62.5	RT	50	1	1											1	
0010	14R	625.081	620.8	3.45	80+41.16	27.5	RT	5							1				1	1		
0010	14X	625.88	621.91	3.97	80+43.66	32.9	RT						1								1	
0010	14D	624.4	-		80+00	62.5	RT	34	1	1											1	
0010	14Z	626.065	622.02	3.04	80+11.6	33.6	RT							1			1				1	
0010	13L	624.876	621.08	2.96	81+26.18	-27.5	LT												1	1		
0010	16R	624.876	619.68	4.36	81+26.12	27.5	RT	57								1			1	1		
0010	16X	625.68	621.54	4.14	81+24.84	33.2	RT	5					1								1	
0010	18R	625.047	620.36	3.85	83+95.54	27.5	RT									1			1	1		
0010	18X	625.85	620.44	5.41	83+95.75	33.1	RT	5					1								1	
0010	15L	624.863	619.72	4.31	85+53.74	-27.5	LT									1			1	1		
0010	20R	624.908	618.9	5.18	85+14.65	27.5	RT								1				1	1		
0010	20X	625.7	619.54	6.16	85+16.8	33.1	RT	5					1								1	
0010	22R	624.786	619.62	4.33	86+32.65	27.5	RT								1				1	1		
0010	22X	625.59	619.4	6.19	86+29.91	33.3	RT	6					1								1	
0010	17L	625.107	619.25	5.02	87+50.1	-27.5	LT	16								1			1	1		
0010	24X	625.95	619.07	6.88	87+51.65	34.6	RT						1								1	
0010	19L	624.377	618.53	5.01	92+12.2	-49.5	LT									1			1	1		
0010	26R	624.466	619.96	3.67	91+56.11	28.9	RT									1			1	1		
0010	26X	625.3	617.67	7.63	91+57.06	38.5	RT	9					1								1	
TOTAL								316	3	3	113	164	10	1	2	5	10	2	1	16	32	

**PERMANENT SIGNING SUMMARY**

STATION	LOCATION	POSTS				MOVING SIGNS TYPE II 638.2102	SIGNS				REMARKS
		TUBULAR STEEL 2X2-INCH X 1.5-FT 634.0801	TUBULAR STEEL 2X2-INCH X 3-FT 634.0803	TUBULAR STEEL 2X2-INCH X 8-FT 634.0808	TUBULAR STEEL 2X2-INCH X 12-FT 634.0812		SIGN CODE	SIZE	REFLECTIVE TYPE II	AREA	
		EACH	EACH	EACH	EACH				637.0202 MESSAGE	S. F.	
73+25	RT	1	1		1	W10-1	36"X36"	RR CROSSING	7.07		
73+25	RT						24"X30"	NO HORN	5.00	(REUSE EXISTING SIGN)	
71+60	RT					R7-1D	18"X24"	NO PARKING	3.00	ON LIGHT POLE	
71+60	RT						30"X36"	BONG HERITAGE CENTER	7.50	(REUSE EXISTING SIGN)	
72+25	E 7TH ST	1	1		1	R1-1	30"X30"	STOP	6.25	EAST 7TH STREET (RT)	
72+60	LT					R7-1D	18"X24"	NO PARKING	3.00	ON LIGHT POLE	
73+50	RT					MG3-2	24"X12"	EAST	2.00	ON LIGHT POLE	
73+50	RT					M1-93	24"X24"	LK SUPERIOR CIRCLE TOUR	4.00	ON LIGHT POLE	
73+50	RT					M3-2	24"X12"	EAST	2.00	ON LIGHT POLE	
73+50	RT					M1-4	24"X24"	USH 2	4.00	ON LIGHT POLE	
73+50	RT					R7-1D	18"X24"	NO PARKING	3.00	ON LIGHT POLE	
74+35	MEDIAN	1	1	1		R4-7	24"X30"	KEEP RIGHT	5.00	ON LIGHT POLE	
74+50	LT					W3-3	36"X36"	(STOP LIGHT)	9.00	ON LIGHT POLE	
74+50	LT					R7-1D	18"X24"	NO PARKING	3.00	ON LIGHT POLE	
75+25	RT					R7-1D	18"X24"	NO PARKING	3.00	ON LIGHT POLE	
76+10	LT					R7-1D	18"X24"	NO PARKING	3.00	ON LIGHT POLE	
76+70	MEDIAN	1	1	1		R4-7	24"X30"	KEEP RIGHT	5.00		
77+00	RT					R2-1	24"X30"	SPEED LIMIT 30	5.00	ON LIGHT POLE	
77+00	RT					R7-1D	18"X24"	NO PARKING	3.00	ON LIGHT POLE	
78+85	RT					R7-1D	18"X24"	NO PARKING	3.00	ON LIGHT POLE	
79+00	LT	1	1	1		R1-1	30"X30"	STOP	6.25	EAST 5TH STREET (LT)	
79+80	RT	1	1	1		R1-1	30"X30"	STOP	6.25	EAST 5TH STREET (RT)	
77+85	LT					W10-1	36"X36"	RR CROSSING	7.07	ON LIGHT POLE	
77+85	LT						24"X30"	NO HORN	5.00	(REUSE EXISTING SIGN)	
79+80	LT					R7-1D	18"X24"	NO PARKING	3.00	ON LIGHT POLE	
80+70	RT							TOURIST INFO CENTER	6.25	(REUSE EXISTING SIGN)	
80+70	RT					R7-1D	18"X24"	NO PARKING	3.00	ON LIGHT POLE	
81+00	LT	1	1	1		W5-56	18"X18"	(DOTS)	2.25		
81+00	LT	1	1	1		W5-56	18"X18"	(DOTS)	2.25		
81+00	LT	1	1	1		W5-56	18"X18"	(DOTS)	2.25		
81+70	LT					R7-1D	18"X24"	NO PARKING	3.00	ON LIGHT POLE	
82+00	LT	1	1	1		R1-1	30"X30"	STOP	6.25	EAST 2ND AVE (LT)	
82+60	RT					M2-1	21"X15"	JCT	3.00	ON LIGHT POLE	
82+60	RT					M1-4	24"X24"	USH 53	3.00	ON LIGHT POLE	
82+60	RT					R7-1D	18"X24"	NO PARKING	3.00	ON LIGHT POLE	
83+30	LT					MG3-2	24"X12"	WEST	2.00	ON LIGHT POLE	
83+30	LT					M1-93	24"X24"	LK SUPERIOR CIRCLE TOUR	4.00	ON LIGHT POLE	
83+30	LT					M3-2	24"X12"	WEST	2.00	ON LIGHT POLE	
83+30	LT					M1-4	24"X24"	USH 2	4.00	ON LIGHT POLE	
83+30	LT					R7-1D	18"X24"	NO PARKING	3.00	ON LIGHT POLE	
83+70	LT	1	1	1		W5-56	18"X18"	(DOTS)	2.25		
83+70	LT	1	1	1		W5-56	18"X18"	(DOTS)	2.25		
83+70	LT	1	1	1		W5-56	18"X18"	(DOTS)	2.25		
84+25	RT					R7-1D	18"X24"	NO PARKING	3.00	ON LIGHT POLE	
85+00	RT	1	1	1		R1-1	30"X30"	STOP	6.25	EAST 4TH STREET (RT)	
85+15	RT	1	1	1		W5-56	18"X18"	(DOTS)	2.25		
85+15	RT	1	1	1		W5-56	18"X18"	(DOTS)	2.25		
85+15	RT	1	1	1		W5-56	18"X18"	(DOTS)	2.25		

CONTINUED ON FOLLOWING PAGE



**PERMANENT SIGNING SUMMARY**

STATION	LOCATION	POSTS	POSTS	POSTS	POSTS	MOVING SIGNS TYPE II 638.2102	SIGNS			REMARKS	
		TUBULAR STEEL 2X2-1NCH X 1.5-FT 634.0801	TUBULAR STEEL 2X2-1NCH X 3-FT 634.0803	TUBULAR STEEL 2X2-1NCH X 8-FT 634.0808	TUBULAR STEEL 2X2-1NCH X 12-FT 634.0812		REFLECTIVE TYPE II		AREA		
		EACH	EACH	EACH	EACH		SIGN CODE	SIZE	637.0202 MESSAGE		S. F.
85+25	LT					-	R7-1D	18"X24"	NO PARKING	3.00	ON LIGHT POLE
86+20	RT					-	R7-1D	18"X24"	NO PARKING	3.00	ON LIGHT POLE
86+30	RT	1	1			1	R3-50R	30"X36"	ARROW RT - ONLY	7.50	
87+30	LT					-	R7-1D	18"X24"	NO PARKING	3.00	ON LIGHT POLE
87+55	LT	1	1	1			W5-56	18"X18"	(DOTS)	2.25	
87+55	LT	1	1	1			W5-56	18"X18"	(DOTS)	2.25	
87+55	LT	1	1	1			W5-56	18"X18"	(DOTS)	2.25	
87+70	LT	1	1			1	R1-1	30"X30"	STOP	6.25	EAST 3RD STREET (LT)
88+10	RT					-	W3-3	36"X36"	(STOP LIGHT)	9.00	ON LIGHT POLE
88+10	RT					-	R7-1D	18"X24"	NO PARKING	3.00	ON LIGHT POLE
89+10	LT					-	R2-1	24"X30"	SPEED LIMIT 30	5.00	ON LIGHT POLE
89+10	LT					-	R7-1D	18"X24"	NO PARKING	3.00	ON LIGHT POLE
89+10	RT	1	1			1	R1-1	30"X30"	STOP	6.25	EAST 3RD STREET (RT)
89+40	RT	2	2			2	M1-4	24"X24"	USH 53	4.00	
89+40	RT						M3-2	24"X12"	EAST		
89+40	RT					-	M6-4	21"X21"	DOUBLE ARROW	3.06	
89+40	RT					-	M1-4	24"X24"	USH 2	4.00	
89+40	RT					-	M6-1	21"X21"	ARROW	3.06	
89+80	RT	1	1			1	R3-8	36"X30"	LANE ARROWS	7.50	
90+10	RT					-	MG3-2	24"X12"	EAST	2.00	ON LIGHT POLE
90+10	RT					-	M1-93	24"X24"	LK SUPERIOR CIRCLE TOUR	4.00	ON LIGHT POLE
90+10	RT					-	MG6-1	21"X21"	ARROW	3.06	ON LIGHT POLE
90+10	RT					-	R7-1D	18"X24"	NO PARKING	3.00	ON LIGHT POLE
90+25	LT	1	1	1			W5-56	18"X18"	(DOTS)	2.25	
90+25	LT	1	1	1			W5-56	18"X18"	(DOTS)	2.25	
90+25	LT	1	1	1			W5-56	18"X18"	(DOTS)	2.25	
91+10	LT					-	M3-2	24"X12"	WEST	2.00	ON LIGHT POLE
91+10	LT					-	M1-4	24"X24"	USH 2	4.00	ON LIGHT POLE
91+10	LT					-	R7-1D	18"X24"	NO PARKING	3.00	ON LIGHT POLE
91+15	RT	2	2			2	D1-3	66"X36"	DULUTH /ASHLAND SPOONER	16.50	
91+20	RT	1	1	1			W5-56	18"X18"	(DOTS)	2.25	
91+20	RT	1	1	1			W5-56	18"X18"	(DOTS)	2.25	
91+20	RT	1	1	1			W5-56	18"X18"	(DOTS)	2.25	
91+40	MEDI AN	1	1	1			R4-7	24"X30"	KEEP RI GHT	5.00	
92+10	MEDI AN	1	1	1			R4-7	24"X30"	KEEP RI GHT	5.00	
12+24	MEDI AN	1	1	1			R4-7	24"X30"	KEEP RI GHT	5.00	EAST 2ND STREET
TOTALS		36	36	22	14	4				329	

3

3

**SIGN REMOVAL SUMMARY**

STATION	LOCATION	REMOVING SMALL SIGN SUPPORTS	REMOVING SIGNS TYPE II	MESSAGE	REMARKS
		638.3000 EACH	638.2602 EACH		
71+60	RT		1	RR CROSSING	ON LIGHT POLE
71+60	RT		1	NO PARKING	ON LIGHT POLE
72+60	LT		1	NO PARKING	ON LIGHT POLE
73+50	RT		1	EAST	ON LIGHT POLE
73+50	RT		1	LK SUPERIOR CIRCLE TOUR	ON LIGHT POLE
73+50	RT		1	EAST	ON LIGHT POLE
73+50	RT		1	USH 2	ON LIGHT POLE
73+50	RT		1	NO PARKING	ON LIGHT POLE
74+35	MEDIAN	1	1	KEEP RIGHT	ON LIGHT POLE
74+50	LT		1	(STOP LIGHT)	ON LIGHT POLE
74+50	LT		1	NO PARKING	ON LIGHT POLE
75+25	RT		1	NO PARKING	ON LIGHT POLE
76+10	LT		1	NO PARKING	ON LIGHT POLE
76+70	MEDIAN	1	1	KEEP RIGHT	
77+00	RT		1	SPEED LIMIT 30	ON LIGHT POLE
77+00	RT		1	NO PARKING	ON LIGHT POLE
77+85	LT		1	NO PARKING	ON LIGHT POLE
78+85	RT		1	NO PARKING	ON LIGHT POLE
79+00	LT		1	STOP	EAST 5TH STREET (LT)
79+80	RT	1	1	STOP	EAST 5TH STREET (RT)
79+80	LT		1	RR CROSSING	ON LIGHT POLE
79+80	LT		1	NO PARKING	ON LIGHT POLE
80+70	RT		1	NO PARKING	ON LIGHT POLE
81+70	LT		1	NO PARKING	ON LIGHT POLE
82+00	LT		1	STOP	EAST 2ND AVE (LT)
82+60	RT		1	NO PARKING	ON LIGHT POLE
83+30	LT		1	WEST	ON LIGHT POLE
83+30	LT		1	LK SUPERIOR CIRCLE TOUR	ON LIGHT POLE
83+30	LT		1	WEST	ON LIGHT POLE
83+30	LT		1	USH 2	ON LIGHT POLE
83+30	LT		1	NO PARKING	ON LIGHT POLE
84+25	RT		1	NO PARKING	ON LIGHT POLE
85+00	RT		1	STOP	EAST 4TH STREET (RT)
85+25	LT		1	NO PARKING	ON LIGHT POLE
86+20	RT		1	NO PARKING	ON LIGHT POLE
86+75	RT		1	STOP	
87+30	LT		1	NO PARKING	ON LIGHT POLE
87+70	LT	1	1	STOP	EAST 3RD STREET (LT)
88+10	RT		1	(STOP LIGHT)	ON LIGHT POLE
88+10	RT		1	NO PARKING	ON LIGHT POLE
89+10	LT		1	SPEED LIMIT 30	ON LIGHT POLE
89+10	LT		1	NO PARKING	ON LIGHT POLE
89+10	RT	1	1	STOP	EAST 3RD STREET (RT)
89+40	RT		1	USH 53	
89+40	RT		1	DOUBLE ARROW	
89+40	RT		1	USH 2	
89+40	RT		1	ARROW	
89+80	RT		1	LANE ARROWS	
90+10	RT		1	EAST	ON LIGHT POLE
90+10	RT		1	LK SUPERIOR CIRCLE TOUR	ON LIGHT POLE
90+10	RT		1	ARROW	ON LIGHT POLE
90+10	RT		1	NO PARKING	ON LIGHT POLE
91+10	LT		1	WEST	ON LIGHT POLE
91+10	LT		1	USH 2	ON LIGHT POLE
91+10	LT		1	NO PARKING	ON LIGHT POLE
91+15	RT	1	1	DULUTH /ASHLAND SPOONER	
91+40	MEDIAN	1	1	KEEP RIGHT	
91+90	LT		1	FOLDING STOP	EAST 2ND ST (SIGNAL LT)
92+10	MEDIAN	1	1	KEEP RIGHT	
92+25	RT		1	FOLDING STOP	EAST 2ND ST (SIGNAL RT)
93+15	RT		1	FOLDING STOP	EAST 2ND ST (SIGNAL LT)
93+30	LT		1	FOLDING STOP	EAST 2ND ST (SIGNAL RT)
TOTALS		8	62		

**SIGNS REFLECTIVE FOLDING TYPE II**

STATION	LOCATION	637.0402		REMARKS
		SF		
91+90	LT	6.25		EAST 2ND ST (SIGNAL LT)
92+25	RT	6.25		EAST 2ND ST (SIGNAL RT)
93+15	RT	6.25		EAST 2ND ST (SIGNAL LT)
93+30	LT	6.25		EAST 2ND ST (SIGNAL RT)
TOTAL 0010		25		

**TRAFFIC CONTROL SIGNS FIXED MESSAGE**

LOCATION	SIZE	643.2000		MESSAGE	REMARKS
		SF			
DETOUR PLAN	96" X 54"	36		HWY 2 DETOUR TRUCKS MUST USE TRUCK ROUTE NO THRU TRAFFIC	SIGN # 1
TOTAL 0010		36			

3

**LOOP DETECTOR SUMMARY**

CATEGORY	STATION	REMARKS	CONDUIT	24" X 36"	LOOP DETCT.
			LOOP DETCT.	PULL BOX	WIRE
			652. 0800	653. 0135	655. 0800
			LF	EACH	LF
0010	90+50 ADVANCE	021 4TURN	70	1	280
0010	90+50 ADVANCE	022 3TURN	50		150
0010	91+75 LT/THRU	033 3TURN	122	1	366
0010	92+00 LT/THRU	034 4TURN	112		448
0010	12+75 LT TURN	045 3TURN	62	1	186
0010	12+75 LT TURN	046 4TURN	34		136
TOTAL			450	3 *	1566

\* ADDITIONAL QUANTITY SHOWN WITH TRAFFIC SIGNAL ITEMS.

**LIGHTING ITEMS**

LIGHTING UNIT NO.	STATION	LOCATION	BASES	ELECTRICAL	REM. SALV.	CONDUIT
			TYPE 5	WIRE	& RELOCATE	NON-MET.
			654. 0105	LTG 12AWG	EX. LIGHTING	SCH 40
			EACH	655. 0610	EQUIP.	2 INCH
				LF	SPV. 0060. 01	652. 0225
					EACH	LF
LP12	71+58	RT		40	1	
LP13		RT		40	1	
LP14	73+53	RT	1	40	1	20
LP15	75+24	RT	1	211	1	171
LP21	76+98	RT	1	40	1	20
LP22	78+87	RT		40	1	
LP23	80+73	RT		40	1	
LP24	82+59	RT		40	1	
LP25	84+26	RT		40	1	
LP26	86+18	RT		40	1	
LP31	88+11	RT		40	1	
LP32	90+07	RT		40	1	
LP33	91+89	RT		40	1	
LP42	70+91	LT		40	1	
LP43	72+60	LT		40	1	
LP44	74+47	LT	1	40	1	20
LP51	76+06	LT	1	40	1	20
LP52	77+82	LT		40	1	
LP53	79+81	LT		40	1	
LP54	81+68	LT		40	1	
LP55	83+34	LT		40	1	
LP56	85+26	LT		40	1	
LP57	87+35	LT		40	1	
LP61	89+10	LT		40	1	
LP62	91+05	LT		40	1	
TOTAL 0010			5	1171	25	251 ****

\*\*\*\* ADDITIONAL QUANTITY SHOWN WITH SIGNAL ITEMS.

**TRAFFIC SIGNAL SUMMARY**

CATEGORY	UNIT NUMBER	STATION	LOCATION	CONC	CONC	CONDUIT
				BASES	BASES	NON-MET.
				TYPE 1	TYPE 2	SCH 40
				654. 0101	654. 0102	2 INCH
				EACH	EACH	PULL BOX
						653. 0135
						652. 0225
						LF
0010	PB52	93+30	32' LT			36
0010	PB55	93+32	31' RT			165
0010	PB56	93+14	55' RT			14
0010	PB57	92+37	104' RT			51
0010	PB58	92+10	47' RT			16
0010	SB21	93+17	82' LT		1	
0010	SB22	92+13	57' LT	1		
TOTAL				1	1	1 **
						246 ***

NOTE: STATIONING & LOCATION APPROXIMATE.

\*\*ADDITIONAL QUANTITY SHOWN WITH LOOP DETECTOR ITEMS.

\*\*\* ADDITIONAL QUANTITY SHOWN WITH LIGHTING ITEMS.

**FIELD OFFICE TYPE B (1190-44-71)**

LOCATION	642. 5001	REMARKS
	EACH	
	1	
TOTAL 0010	1	

PROJECT NO: 1190-44-71

HWY: USH 2

COUNTY: DOUGLAS

MISCELLANEOUS QUANTITIES

SHEET:

E

FILE NAME: \_\_\_\_\_

PLOT DATE: \_\_\_\_\_

PLOT BY: \_\_\_\_\_

PLOT NAME: \_\_\_\_\_

PLOT SCALE: 1:1

3

**TRAFFIC CONTROL ITEMS**

**SIGNS**

DETOUR SIGN GROUP	ARROW BOARDS		DRUMS		LIGHTS TYPE C		BARRICADES TYPE III		LIGHTS TYPE A		COVERING SIGNS	DETOUR 643.3000		TRAFFIC CONTROL 643.0900		SIGN CODE	SIZE	MESSAGE
	EACH	DAYS	EACH	DAYS	EACH	DAYS	EACH	DAYS	EACH	DAYS	EACH	DAYS	EACH	DAYS				
1												0	0					TRUCKS MUST USE T-ROUTE
2												1	60			W20-2	48"X48"	DETOUR 1500 FT
3												1	60			W20-2	48"X48"	DETOUR 1000 FT
4												1	60			W20-2	48"X48"	DETOUR 500 FT
5												1	60			M4-8	24"X12"	DETOUR
5												1	60			M3-2	24"X12"	EAST
5												1	60			M14	24"X24"	USH 2
5												1	60			MO5-1L	21"X21"	ADVANCED LEFT ARROW
6												1	60			M4-8A	24"X18"	END DETOUR
6												1	60			M14	24"X24"	USH 2
7												1	60			M4-8	24"X12"	DETOUR
7												1	60			M3-2	24"X12"	EAST
7												1	60			M14	24"X24"	USH 2
7												1	60			MO6-1	21"X21"	ARROW
8											1	1	60			M4-8	24"X12"	DETOUR
8												1	60			M3-4	24"X12"	WEST
8												1	60			MO6-1	21"X21"	ARROW
9								1	60			1	60			R11-3	60"X30"	ROAD CLOSED X MILE AHEAD
10								1	60			1	60			R11-4	60"X30"	ROAD CLOSED TO THRU TRAFFIC
11								1	60			1	60			R11-4	60"X30"	ROAD CLOSED TO THRU TRAFFIC
20												1	60			M4-8	24"X12"	DETOUR
20												1	60			M3-2	24"X12"	EAST
20												1	60			M14	24"X24"	USH 2
21												1	60			M4-8	24"X12"	DETOUR
21												1	60			M3-4	24"X12"	WEST
21												1	60			M14	24"X24"	USH 2
22												1	60			M4-8	24"X12"	DETOUR
22												1	60			M3-2	24"X12"	EAST
22												1	60			M14	24"X24"	USH 2
23												1	60			M4-8	24"X12"	DETOUR
23												1	60			M3-2	24"X12"	EAST
23												1	60			M14	24"X24"	USH 2
24												1	60			M4-8	24"X12"	DETOUR
24												1	60			M3-4	24"X12"	WEST
24												1	60			M14	24"X24"	USH 2
25												1	60			M4-8	24"X12"	DETOUR
25												1	60			M3-2	24"X12"	EAST
25												1	60			M14	24"X24"	USH 2
30												1	60			M4-8	24"X12"	DETOUR
30												1	60			M3-2	24"X12"	EAST
30												1	60			M14	24"X24"	USH 2
31												1	60			M4-8	24"X12"	DETOUR
31												1	60			M3-4	24"X12"	WEST
31												1	60			M14	24"X24"	USH 2
32											1	1	60			M4-8	24"X12"	DETOUR
33											1	1	60			M4-8	24"X12"	DETOUR

CONTINUED ON FOLLOWING PAGE

**TRAFFIC CONTROL ITEMS**

**SIGNS**

DETOUR SIGN GROUP	ARROW BOARDS		DRUMS		LIGHTS TYPE C		BARRICADES TYPE III		LIGHTS TYPE A		COVERING SIGNS	DETOUR 643.3000		TRAFFIC CONTROL 643.0900		SIGN CODE	SIZE	MESSAGE		
	643.0800	643.0300	643.0715	643.0420	643.0705	643.0905.S	EACH	DAYS	EACH	DAYS		EACH	DAYS	EACH	DAYS					
	EACH	DAYS	EACH	DAYS	EACH	DAYS	EACH	DAYS	EACH	DAYS		EACH	DAYS	EACH	DAYS					
34												1	60			M4-8	24"X12"	DETOUR		
34												1	60			M3-4	24"X12"	WEST		
34												1	60			M14	24"X24"	USH 2		
34												1	60			MO6-2	21"X21"	TILTED ARROW		
35											1	1	60			M4-8	24"X12"	DETOUR		
36												1	60			M4-8	24"X12"	DETOUR		
36												1	60			M3-2	24"X12"	EAST		
36												1	60			M14	24"X24"	USH 2		
37												1	60			M4-8	24"X12"	DETOUR		
37												1	60			M3-4	24"X12"	WEST		
37												1	60			M14	24"X24"	USH 2		
40												1	60			M4-8	24"X12"	DETOUR		
40												1	60			M3-4	24"X12"	WEST		
40												1	60			M14	24"X24"	USH 2		
41											1	1	60			M4-8	24"X12"	DETOUR		
42											1	1	60			M4-8	24"X12"	DETOUR		
43											1	1	60			M4-8	24"X12"	DETOUR		
43												1	60			MO6-1	21"X21"	ARROW		
44												1	60			M4-8A	24"X18"	END DETOUR		
45												1	60			W20-2	48"X48"	DETOUR 500 FT		
46												1	60			W20-2	48"X48"	DETOUR 1000 FT		
47												1	60			W20-2	48"X48"	DETOUR 1500 FT		
48											1	1	60			M4-8	24"X12"	DETOUR		
48												1	60			MO6-1	21"X21"	ARROW		
								2	120	4	240					1	60	R11-2	48"X30"	ROAD CLOSED
								2	120	4	240					1	60	W01-6	48"X24"	ARROW
								3	180							1	60	R11-2	48"X30"	ROAD CLOSED
								3	180							1	60	W20-3	48"X48"	ROAD CLOSED AHEAD
								3	180							1	60	R11-2	48"X30"	ROAD CLOSED
								3	180							1	60	W20-3	48"X48"	ROAD CLOSED AHEAD
								3	180							1	60	R11-2	48"X30"	ROAD CLOSED
								1	60							1	60	W20-3	48"X48"	ROAD CLOSED AHEAD
								3	180							1	60	R11-2	48"X30"	ROAD CLOSED
								1	60							1	60	R11-2	48"X30"	ROAD CLOSED
								1	60							1	60	R11-2	48"X30"	ROAD CLOSED
								3	180							1	60	R11-2	48"X30"	ROAD CLOSED
								3	180							2	120	W20-3	48"X48"	ROAD CLOSED AHEAD
								3	180							1	60	R11-2	48"X30"	ROAD CLOSED
								1	60							1	60	W20-3	48"X48"	ROAD CLOSED AHEAD
								1	60							1	60	R11-2	48"X30"	ROAD CLOSED
								7	420	14	840					1	60	R11-2	48"X30"	ROAD CLOSED
																1	60	R11-2	48"X30"	ROAD CLOSED

CONTINUED ON FOLLOWING PAGE

**TRAFFIC CONTROL ITEMS**

TRAFFIC CONTROL ITEMS											SIGN				REMARKS	
DETOUR SIGN GROUP	ARROW BOARDS	DRUMS	LIGHTS TYPE C	BARRICADES TYPE III	LIGHTS TYPE A	COVERING SIGNS	DETOUR SIGN GROUP	TRAFFIC CONTROL	SIGN CODE	SIZE	MESSAGE					
	643.0800	643.0300	643.0715	643.0420	643.0705	643.0905.S	643.3000	643.0900								
EACH	DAYS	EACH	DAYS	EACH	DAYS	EACH	EACH	DAYS	EACH	DAYS						
-									4	240	W20-1 48"X48" ROAD WORK AHEAD	LANE CLOSURE (E2ND ST)				
-									4	120	W20-5L 48"X48" LEFT LANE CLOSED AHEAD	LANE CLOSURE (E2ND ST)				
-									4	120	W20-5R 48"X48" RIGHT LANE CLOSED AHEAD	LANE CLOSURE (E2ND ST)				
-									4	120	W04-2L 48"X48" SYMBOL LT LANE CLOSURE	LANE CLOSURE (E2ND ST)				
-									4	120	W04-2R 48"X48" SYMBOL LT LANE CLOSURE	LANE CLOSURE (E2ND ST)				
-	2	120	10	600								LANE CLOSURE (E2ND ST)				
-			20	1,200	20	1,200						LANE CLOSURE (E2ND ST)				
-			28	1,680			2	120			R11-2(MOD) 48"X30"	LANE CLOSURE (E2ND ST)				
-			10	600								LANE CLOSURE (E2ND ST)				
-							4	240			G20-2A 48"X24"	LANE CLOSURE (E2ND ST)				
-							4	240			R9-9 24"X12"	UNDI ST. SW CLOSURE				
-			16	960			2	120			R11-2(MOD) 48"X30"	TURN LANE CLOSURES				
<hr/>																
	2	120	84	5,040	20	1,200	47	2,820	22	1,320	8	69	4,140	54	2,760	

**PAVEMENT MARKING SUMMARY**

PAVEMENT MARKING	CHANNELIZING	STOP LINE	DIAGONAL	CROSSWALK	CROSSWALK	ARROWS	ARROWS	TEMPORARY			
4 INCH	8 INCH	CURB	18 INCH	12 INCH	6 INCH	EPOXY	TYPE 2	TYPE 3	WORDS	RR CROSSING	REM. TAPE
<u>EPOXY</u>	<u>EPOXY</u>	<u>EPOXY</u>	<u>EPOXY</u>	<u>EPOXY</u>	<u>EPOXY</u>	<u>SPECIAL</u>	<u>EPOXY</u>	<u>EPOXY</u>	<u>EPOXY</u>	<u>EPOXY</u>	<u>4-INCH</u>
646.0106	646.0126	647.0456	647.0566	647.0726	647.0766	SPV.0165.01	647.0166	647.0176	647.0356	647.0110	649.0400

STATION	TO	STATION	LOCATION	LF	LF	LF	LF	LF	LF	SF	EACH	EACH	EACH	EACH	LF	REMARKS
		70+05	ML						115							
70+00	-	92+15	ML	1175												C. L. WHITE DASH
70+00	-	92+15	LT & RT	3880												WHITE EDGELINE
70+00	-	92+15	C. L.	4430												YELLOW EDGELINE
		72+00	RT	95			23			224						E. 7TH ST.
		73+78	RT											2		
72+15	-	74+17	C. L.	440				60								
		74+37	C. L.													
74+35	-	75+38	MEDI AN L&R			206										
75+38	-	75+72	MEDI AN L&R	70												
75+72	-	76+75	MEDI AN L&R			206										
		76+75	C. L.													
76+85	-	79+00	C. L.	440				60								
		77+43	LT											2		
		79+30	LT	130			17			192						E. 5TH ST.
		79+50	RT	130			22			208						E. 5TH ST.
		79+90	ML							208						USH 2/BELKNAP
		82+30	LT	70			15			160						2ND AVE.
		84+70	RT	95			15			160						E. 4TH ST.
		88+00	LT	110			20			176						E. 3RD ST.
		88+80	RT	80			16			144						E. 3RD ST.
		91+15	RT								1		1			
		91+32	RT								1	1	1			
91+38	-	92+16	MEDI AN L&R			156										
		92+04	RT								1	1				
		92+20	ML				35			368						U. S. H. 2
		92+67	LT		80		35			272						E. 2ND. ST. /USH 53
		92+72	LT								1		1		50	E. 2ND. ST. /USH 53
		92+80	RT		105		35			363	3		3		50	E. 2ND. ST. /USH 53
		93+23	ML	44			25			208						U. S. H. 2
		92+55	LT & RT	75												E. 2ND. ST. /USH 53
		92+95	LT & RT	62												E. 2ND. ST. /USH 53
TOTALS =				11326	185	568	258	120	115	2683	7	2	6	4	100	

**CONSTRUCTION STAKING ITEMS**

STATION TO	STATION	LOCATION	SUBGRADE 650. 4500 LF	BASE 650. 5000 LF	CURB & GUTTER 650. 5500 LF	CONC. PAVEMENT 650. 7000 LF	SLOPE STAKES 650. 9920 LF	REMARKS
71+00	- 92+32		4264	-	2132	2132	2132	
9+28	- 9+60		63	32	32	16	32	7TH STREET
9+19	- 9+70		102	51	-	25	51	5TH STREET SE
6+35	- 7+42		214	107	51	51	107	5TH STREET NW
10+20	- 10+86		131	66	17	17	66	2ND AVENUE
9+23	- 9+70		93	47	-	-	47	4TH STREET
8+66	- 9+80		228	114	71	50	114	3RD STREET SE
10+20	- 11+18		196	98	22	22	98	3RD STREET NW
TOTAL 0010			5291	* 513	2325	2313	2645	

\* INCLUDES SETTING STAKES FOR SELECT BORROW SUBBASE.

**CONSTRUCTION STAKING ELECTRICAL INSTALLATIONS (PROJECT)**

LOCATION	650. 8500 LS	REMARKS
	1	LIGHTING AND SIGNAL ITEMS
TOTAL 0010	1	

**SAWING ASPHALT**

STATION	LOCATION	690. 0150 LF	REMARKS
78+06	LT	40	E 7TH ST
	CE	31	CE
	E 5TH ST	45	CE
82+15	RT	40	E 5TH ST SE
	ALLEY	22	E 5TH ST NW
	2ND AVE	13	ALLEY
	E 4TH ST SE	32	2ND AVE
86+50	RT	32	E 4TH ST SE
	ALLEY	13	ALLEY
87+48	RT	20	E 3RD ST SE
	CE	35	CE
	E 3RD ST	35	CE
		20	E 3RD ST NW
TOTAL 0010		378	

**SPECIAL (01. ASPHALTIC SURFACE SPECIAL)**

STATION	LOCATION	SPV. 0195(01) TON	REMARKS
78+06	LT	16	E 7TH ST
	RR	15	RR
	E 5TH ST	6	CE
82+15	RT	21	CE
	ALLEY	16	E 5TH ST SE
	2ND AVE	11	E 5TH ST NW
	E 4TH ST SE	9	ALLEY
86+01	LT	13	2ND AVE
	RT	10	E 4TH ST SE
86+50	RT	10	ALLEY
	CE	8	ALLEY
87+48	RT	7	E 3RD ST SE
	E 3RD ST	24	CE
75+55	ML	13	CE
		4	E 3RD ST NW
TOTAL 0010		196	30' WIDE TEMP RAIL X-ING

**CONSTRUCTION STAKING SUPPLEMENTAL CONTROL (05. 1190-44-71)**

LOCATION	650. 9910 LS	REMARKS
	1	PROJECT
TOTAL 0010	1	

**SAWING CONCRETE**

STATION TO	STATION	LOCATION	690. 0250 LF	REMARKS
12+18	- 12+91	ML	52	BEGIN GRADING
			182	E 2ND ST LT TURN/MEDIAN
	93+08	LT	17	CURB RAMP
	93+08	RT	17	CURB RAMP
	92+32	ML	102	END GRADING
	92+40	LT	17	CURB RAMP
TOTAL 0010			387	



SANITARY SEWER SUMMARY

STATION	LOCATION	REMOVING SAN. SEWER SPV. 0090(02) LF	SAN. SEWER 10 INCH SPV. 0090(03) LF	CONNECT EX. SAN. SEWER SPV. 0060(03) EA	REMARKS
90+60		110.0	110.0	2.0	LOCATED IN ALLEY APPROX 14' DEPTH
	TOTAL 0030	<u>110.0</u>	<u>110.0</u>	<u>2.0</u>	

CURVE DATA USH 2  
 PISTA 69+98.37  
 Y 305388.19  
 X 153755.78  
 PC STA 68+32.19  
 TAN 166.19'  
 LChord 327.02'  
 N 76°59'39" E  
 Radius 915.00'  
 D 6°15'43"  
 DELTA -20°35'17"  
 L 328.79'  
 PT STA 71+60.98

PISTA 77+02.93  
 Y 305668.29  
 X 154406.17  
 PC STA 73+68.01  
 TAN 334.91'  
 LChord 665.30'  
 N 73°22'05" E  
 Radius 2864.79'  
 D 2°00'00"  
 DELTA 13°20'10"  
 L 666.80'  
 PT STA 80+34.81



SECTION LINE  
 2646.28' N 0°35'56" W BETWEEN CORNERS  
 HILL AVENUE

BEGIN RELOCATION ORDER

STA 69+66.27  
 Y 305396.45  
 X 153722.78



IP2021  
 IRON BAR  
 W/ CAP  
 Y 305377.27  
 X 153722.98  
 69+62.85  
 18.86'



IP2013  
 REROD HILL/21ST  
 Y 302727.42  
 X 153775.38

OWNER NAMES ARE SHOWN FOR REFERENCE PURPOSES ONLY AND ARE SUBJECT TO CHANGE PRIOR TO THE TRANSFER OF LAND INTERESTS TO THE DEPARTMENT

PARCEL NUMBER	OWNER (S)	INTEREST REQUIRED	R/W REQUIRED
			NEW SQ. FT
2	JOHN SUR	FEE	1305.73
3	FREDERICK L. & NANCY K. PAINE	FEE	137.03


SUZY KOTTS

CITY

OF

ROY'S ADDITION

SW-SW  
 13-49-14

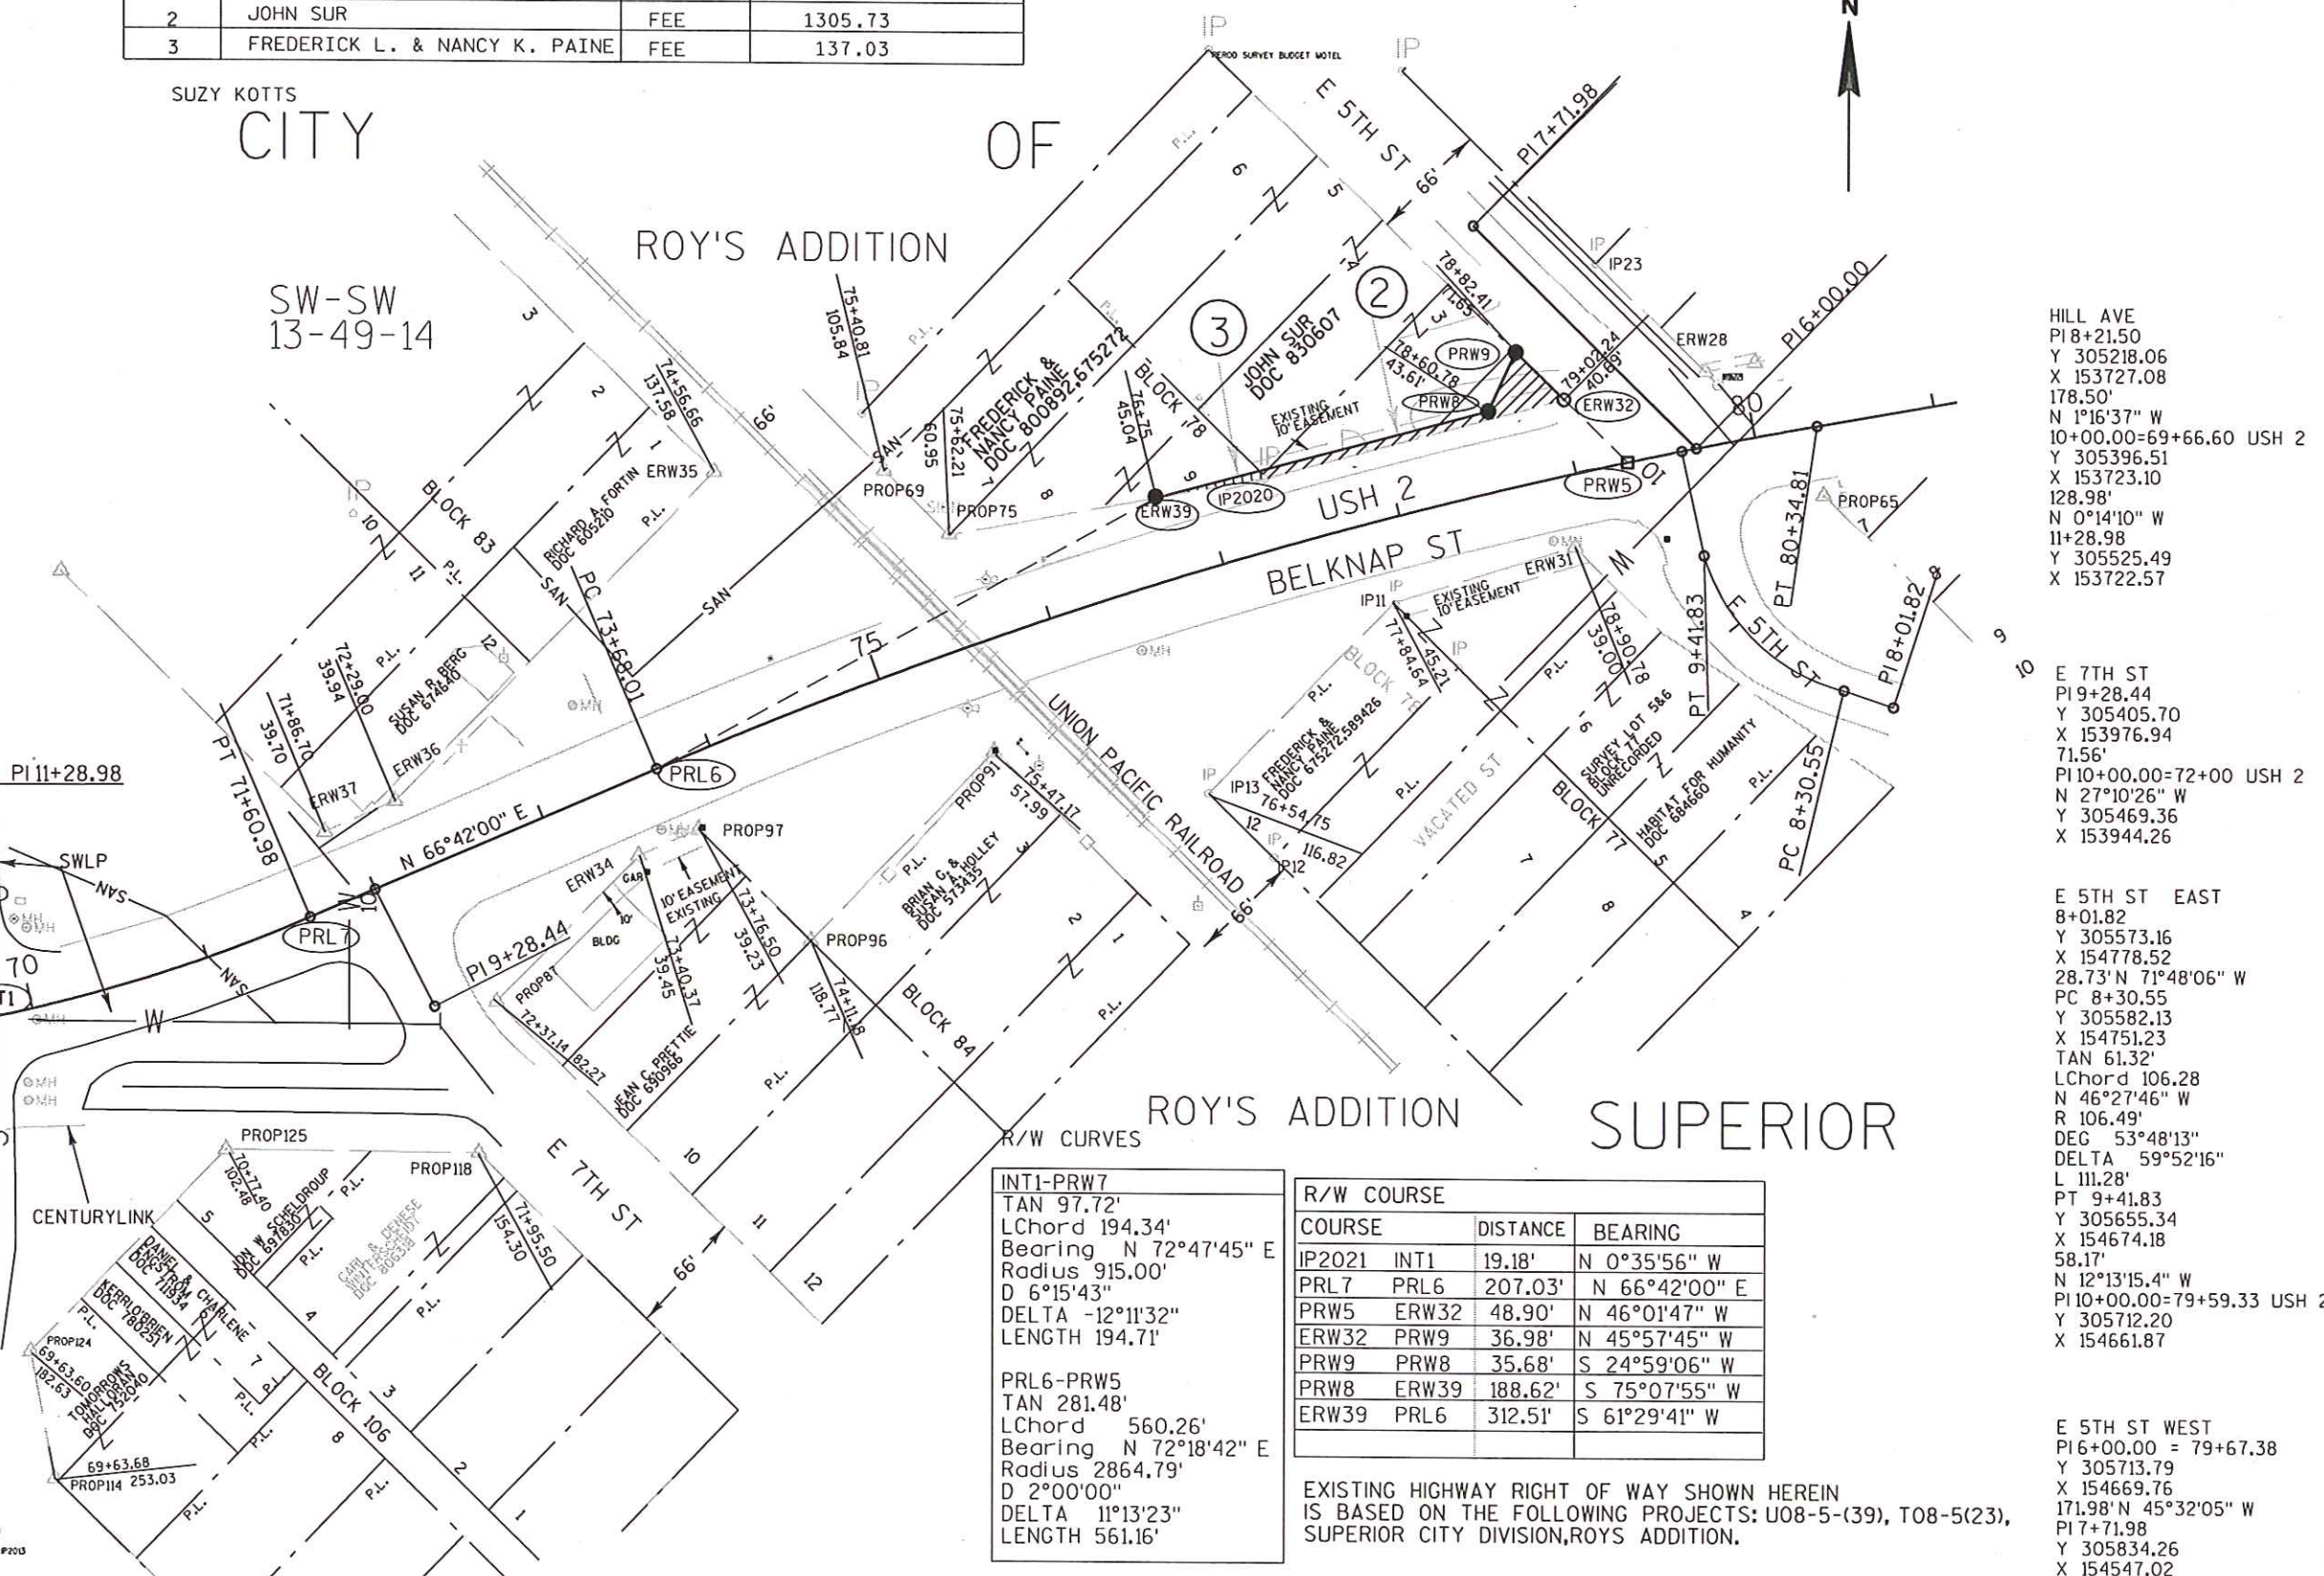

HILL AVE  
 PI 8+21.50  
 Y 305218.06  
 X 153727.08  
 178.50'  
 N 1°16'37" W  
 10+00.00=69+66.60 USH 2  
 Y 305396.51  
 X 153723.10  
 128.98'  
 N 0°14'10" W  
 11+28.98  
 Y 305525.49  
 X 153722.57

E 7TH ST  
 PI 9+28.44  
 Y 305405.70  
 X 153976.94  
 71.56'  
 PI 10+00.00=72+00 USH 2  
 N 27°10'26" W  
 Y 305469.36  
 X 153944.26

E 5TH ST EAST  
 8+01.82  
 Y 305573.16  
 X 154778.52  
 28.73' N 71°48'06" W  
 PC 8+30.55  
 Y 305582.13  
 X 154751.23  
 TAN 61.32'  
 LChord 106.28  
 N 46°27'46" W  
 R 106.49'  
 DEG 53°48'13"  
 DELTA 59°52'16"  
 L 111.28'  
 PT 9+41.83  
 Y 305655.34  
 X 154674.18  
 58.17'  
 N 12°13'15.4" W  
 PI 10+00.00=79+59.33 USH 2  
 Y 305712.20  
 X 154661.87

E 5TH ST WEST  
 PI 6+00.00 = 79+67.38  
 Y 305713.79  
 X 154669.76  
 171.98' N 45°32'05" W  
 PI 7+71.98  
 Y 305834.26  
 X 154547.02



INT1-PRW7  
 TAN 97.72'  
 LChord 194.34'  
 Bearing N 72°47'45" E  
 Radius 915.00'  
 D 6°15'43"  
 DELTA -12°11'32"  
 LENGTH 194.71'



PRL6-PRW5  
 TAN 281.48'  
 LChord 560.26'  
 Bearing N 72°18'42" E  
 Radius 2864.79'  
 D 2°00'00"  
 DELTA 11°13'23"  
 LENGTH 561.16'

R/W COURSE		
COURSE	DISTANCE	BEARING
IP2021 INT1	19.18'	N 0°35'56" W
PRL7 PRL6	207.03'	N 66°42'00" E
PRW5 ERW32	48.90'	N 46°01'47" W
ERW32 PRW9	36.98'	N 45°57'45" W
PRW9 PRW8	35.68'	S 24°59'06" W
PRW8 ERW39	188.62'	S 75°07'55" W
ERW39 PRL6	312.51'	S 61°29'41" W


EXISTING HIGHWAY RIGHT OF WAY SHOWN HEREIN IS BASED ON THE FOLLOWING PROJECTS: U08-5-(39), T08-5(23), SUPERIOR CITY DIVISION, ROYS ADDITION.

REVISION DATE	DATE 07-07-2010	SCALE, FEET 0 100	HWY: USH 2	STATE R/W PROJECT NUMBER 1190-44-20	PLAT SHEET 4. 02
	GRID FACTOR N/A		COUNTY: DOUGLAS	CONSTRUCTION PROJECT NUMBER 1190-44-71	PS&E SHEET E

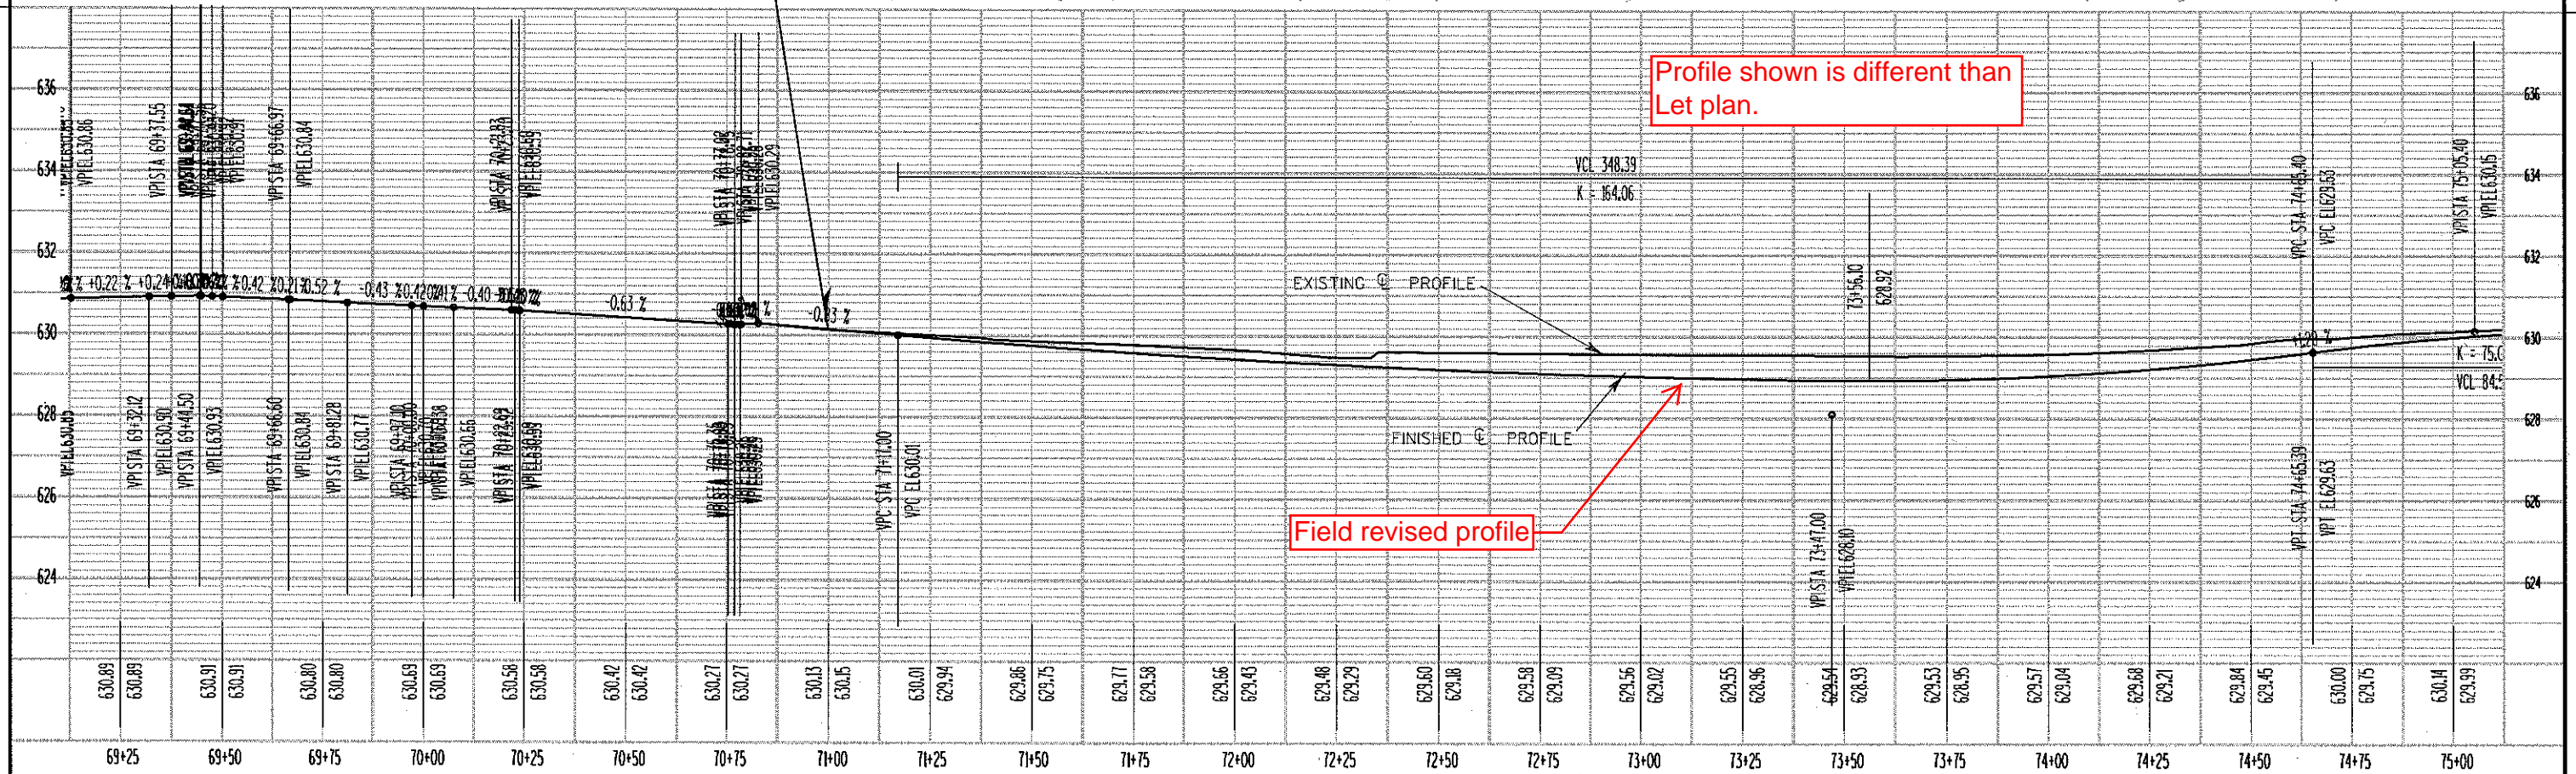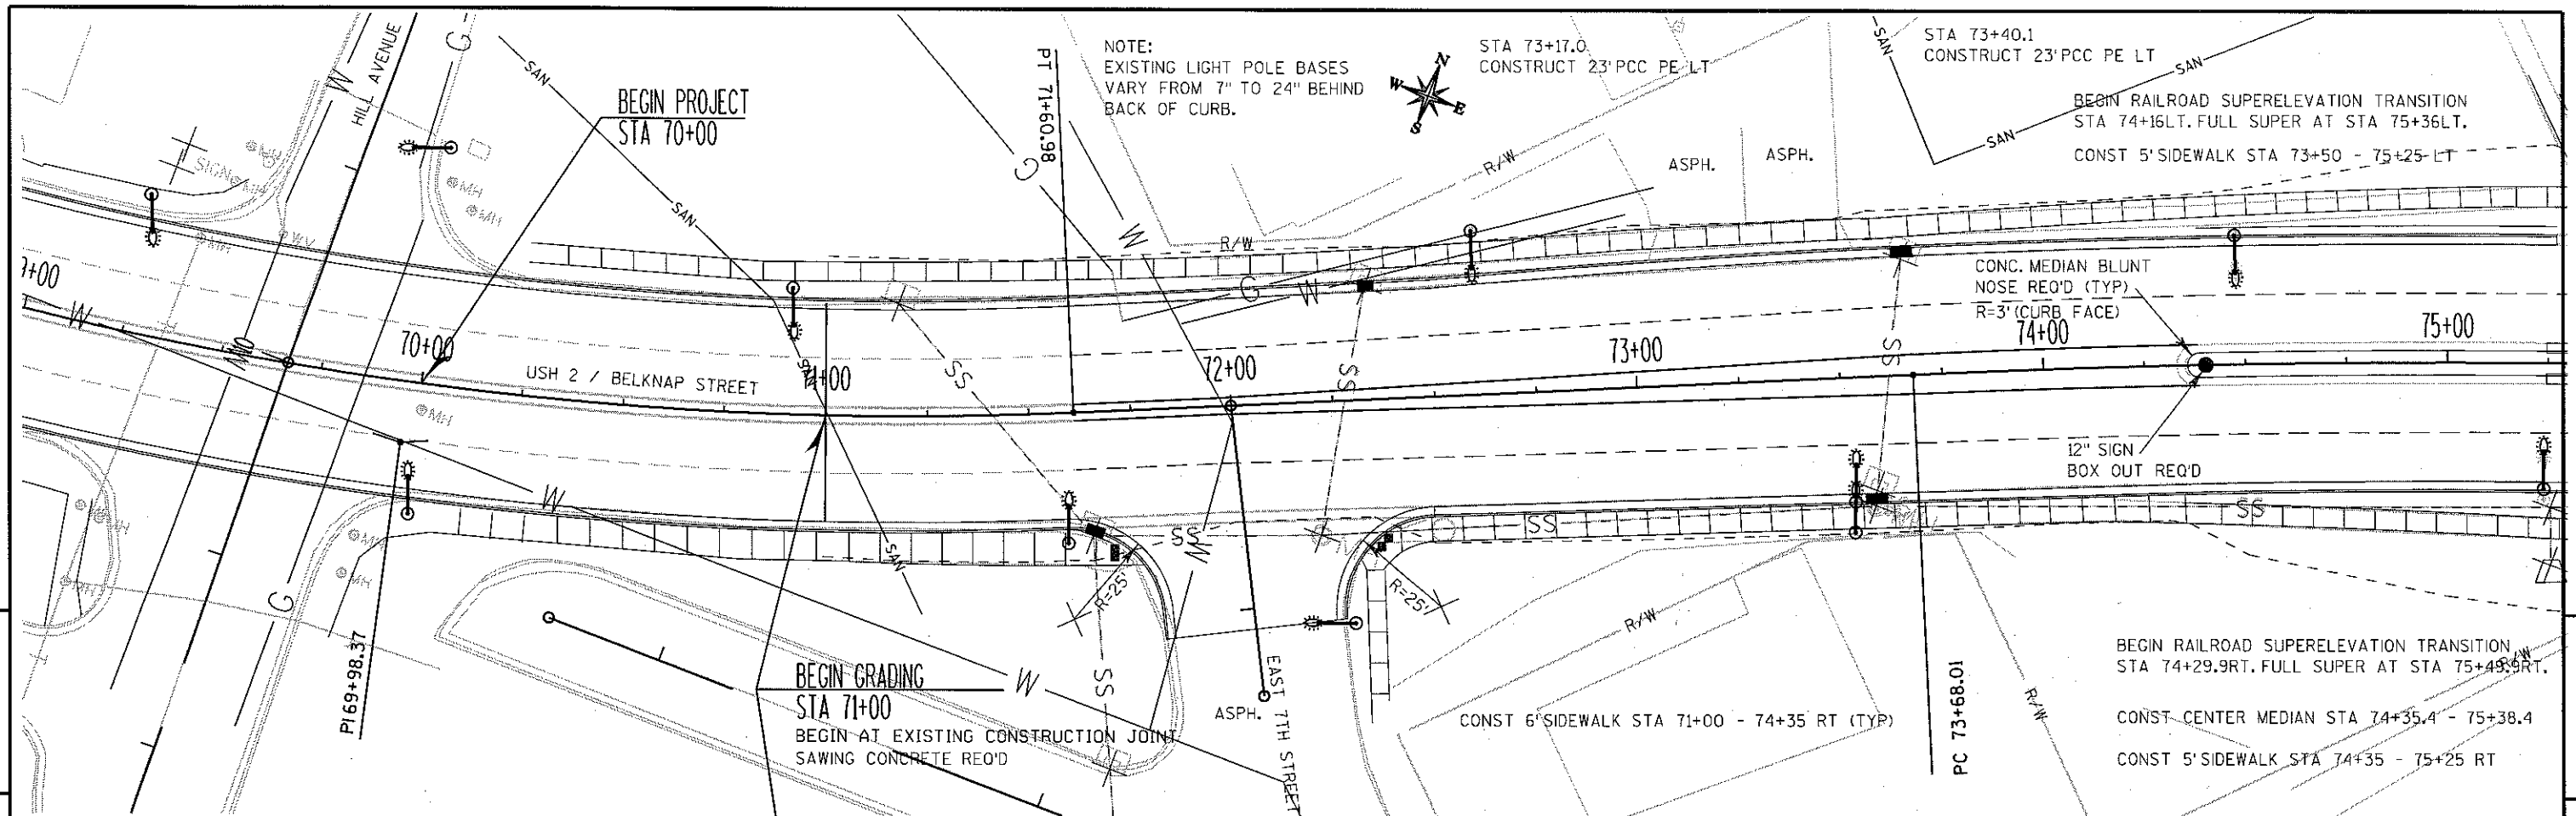

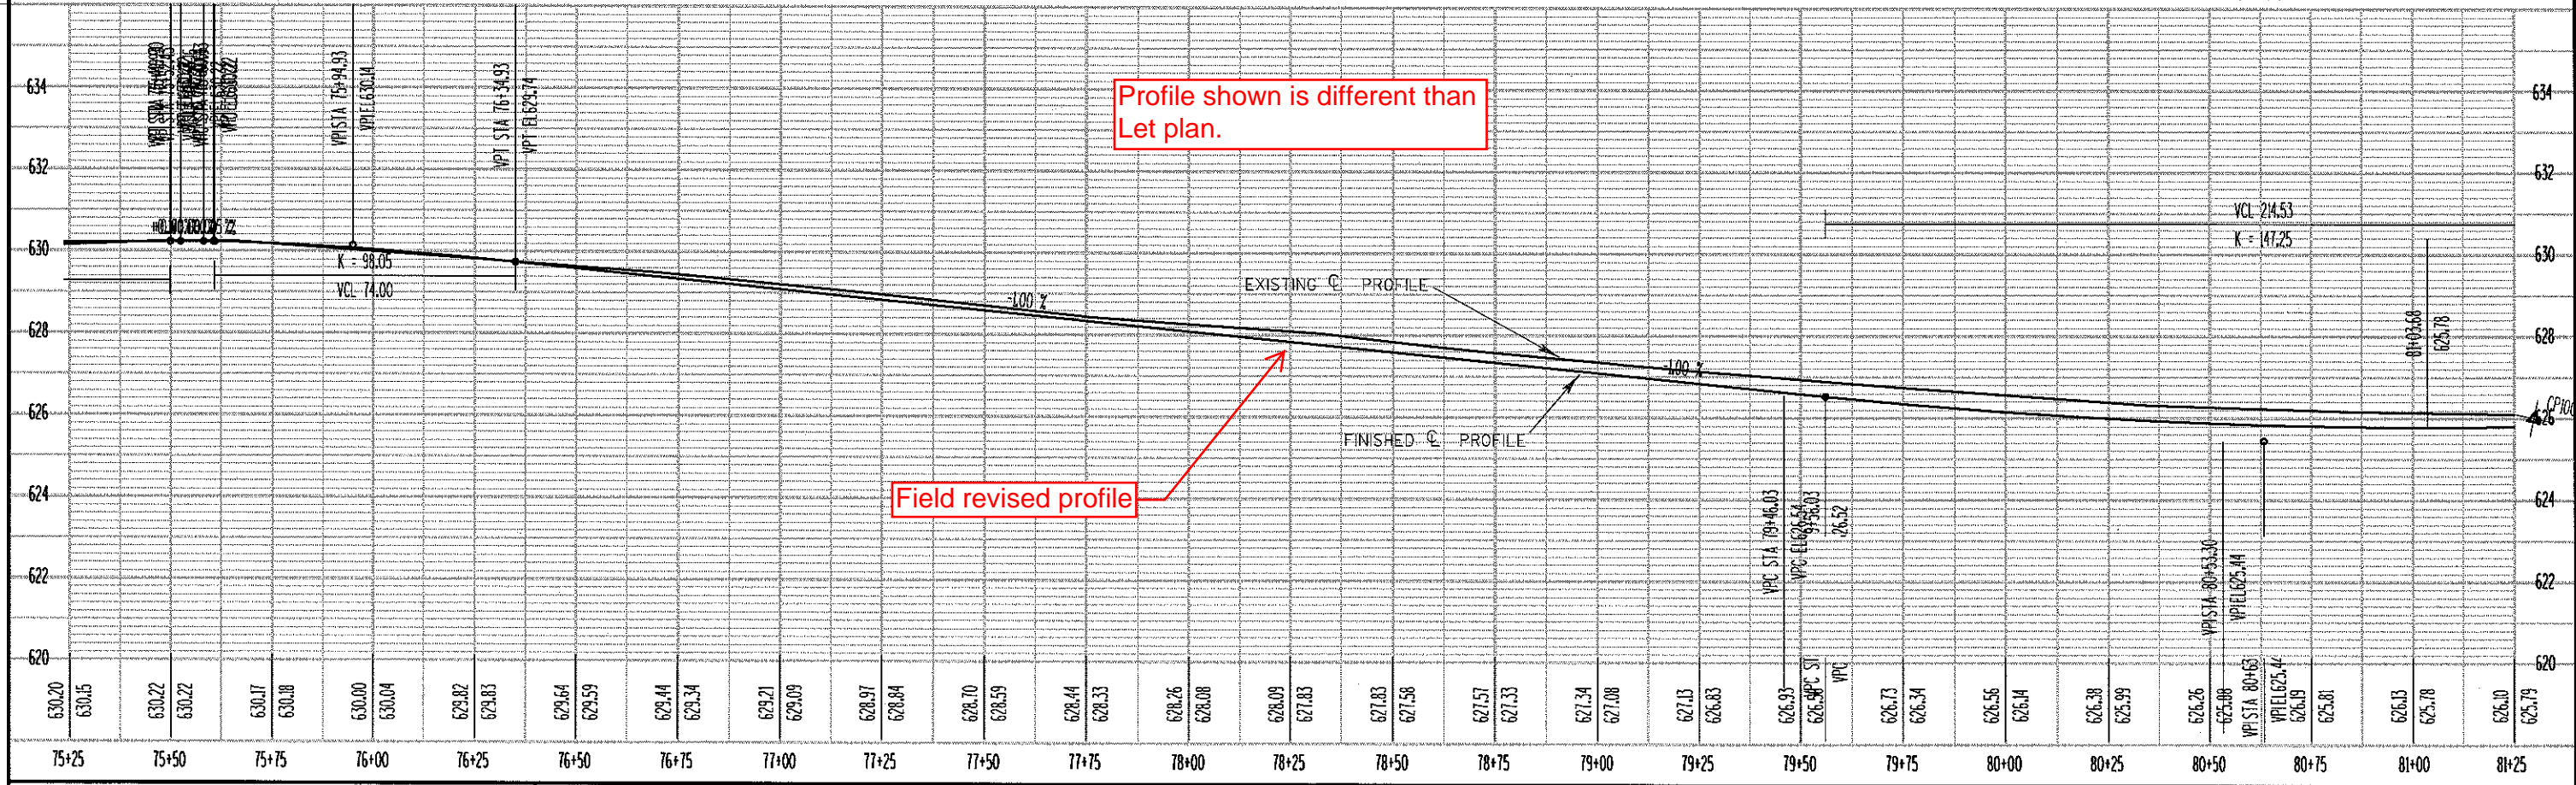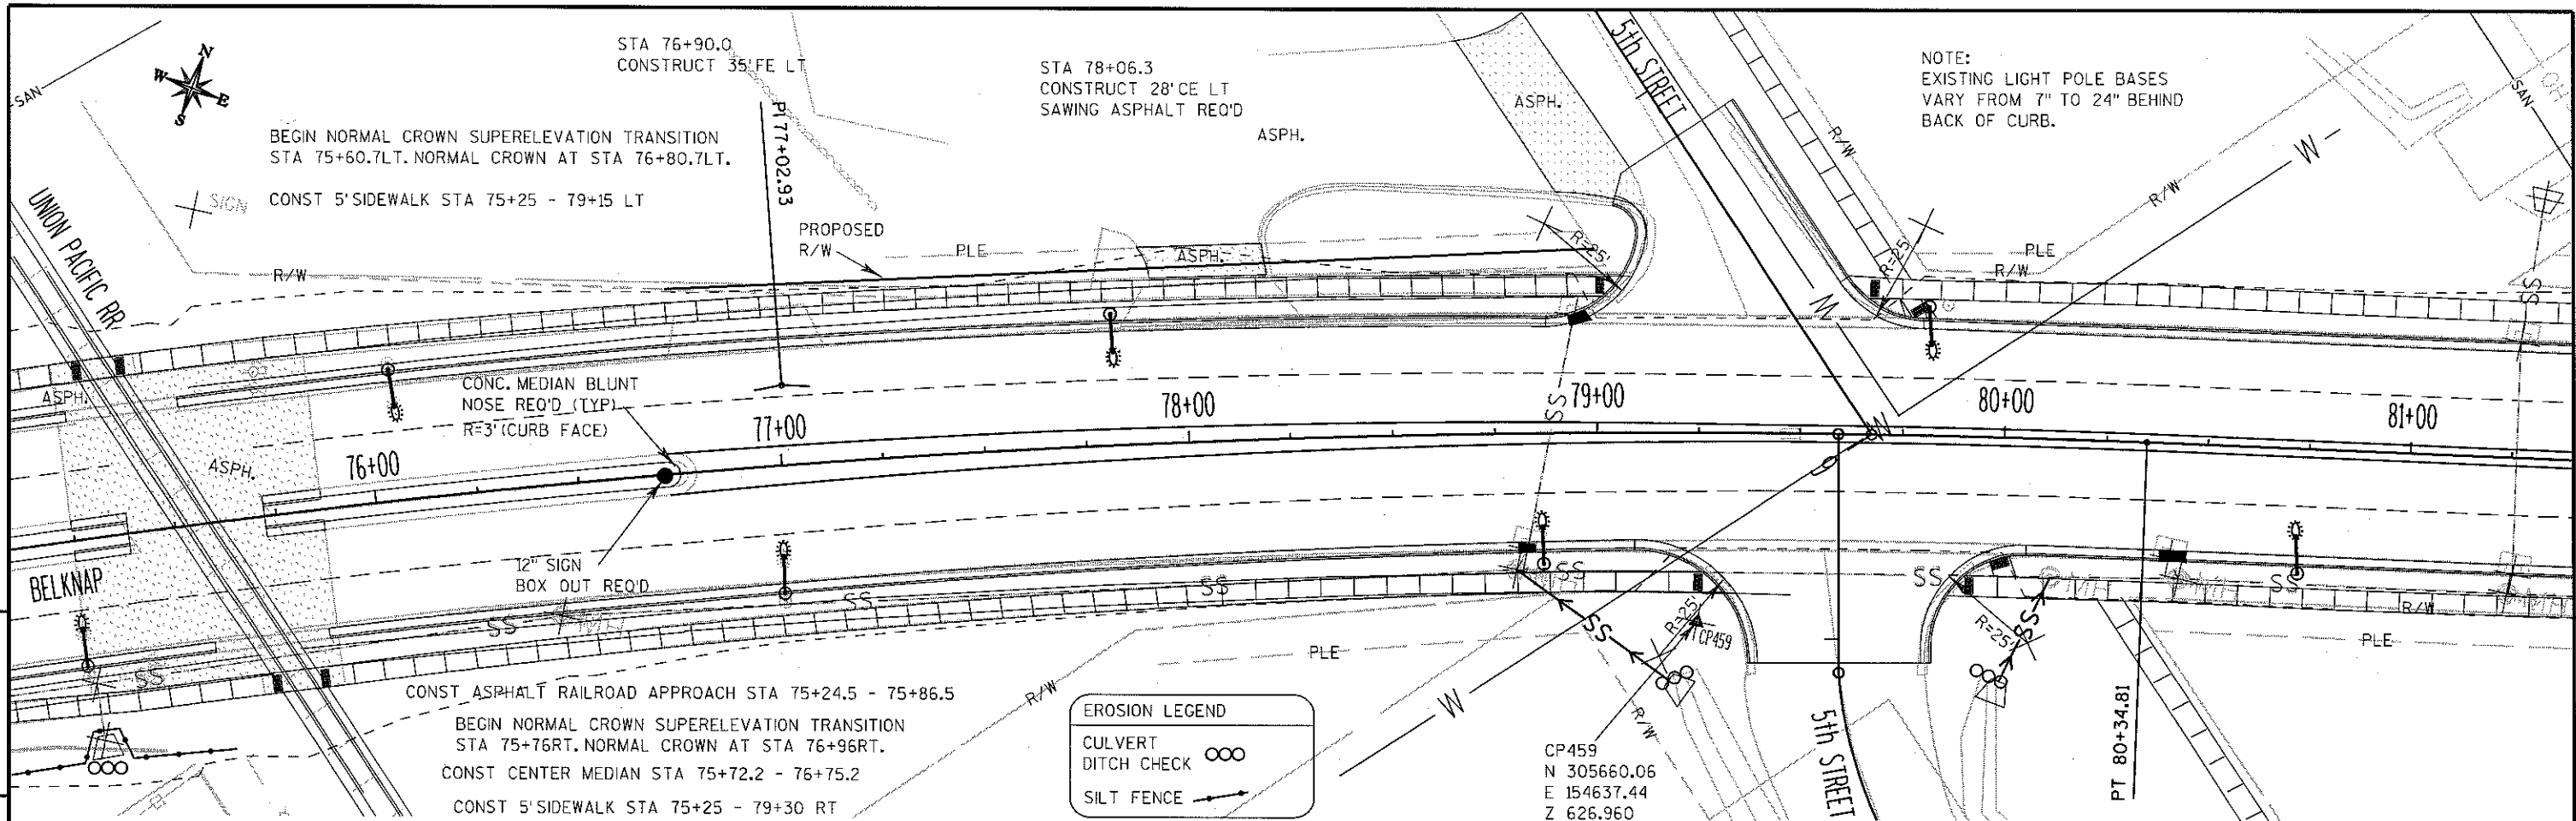

PROJECT NO: 1190-44-71    HWY: USH 2    COUNTY: DOUGLAS    PLAN & PROFILE    SHEET E

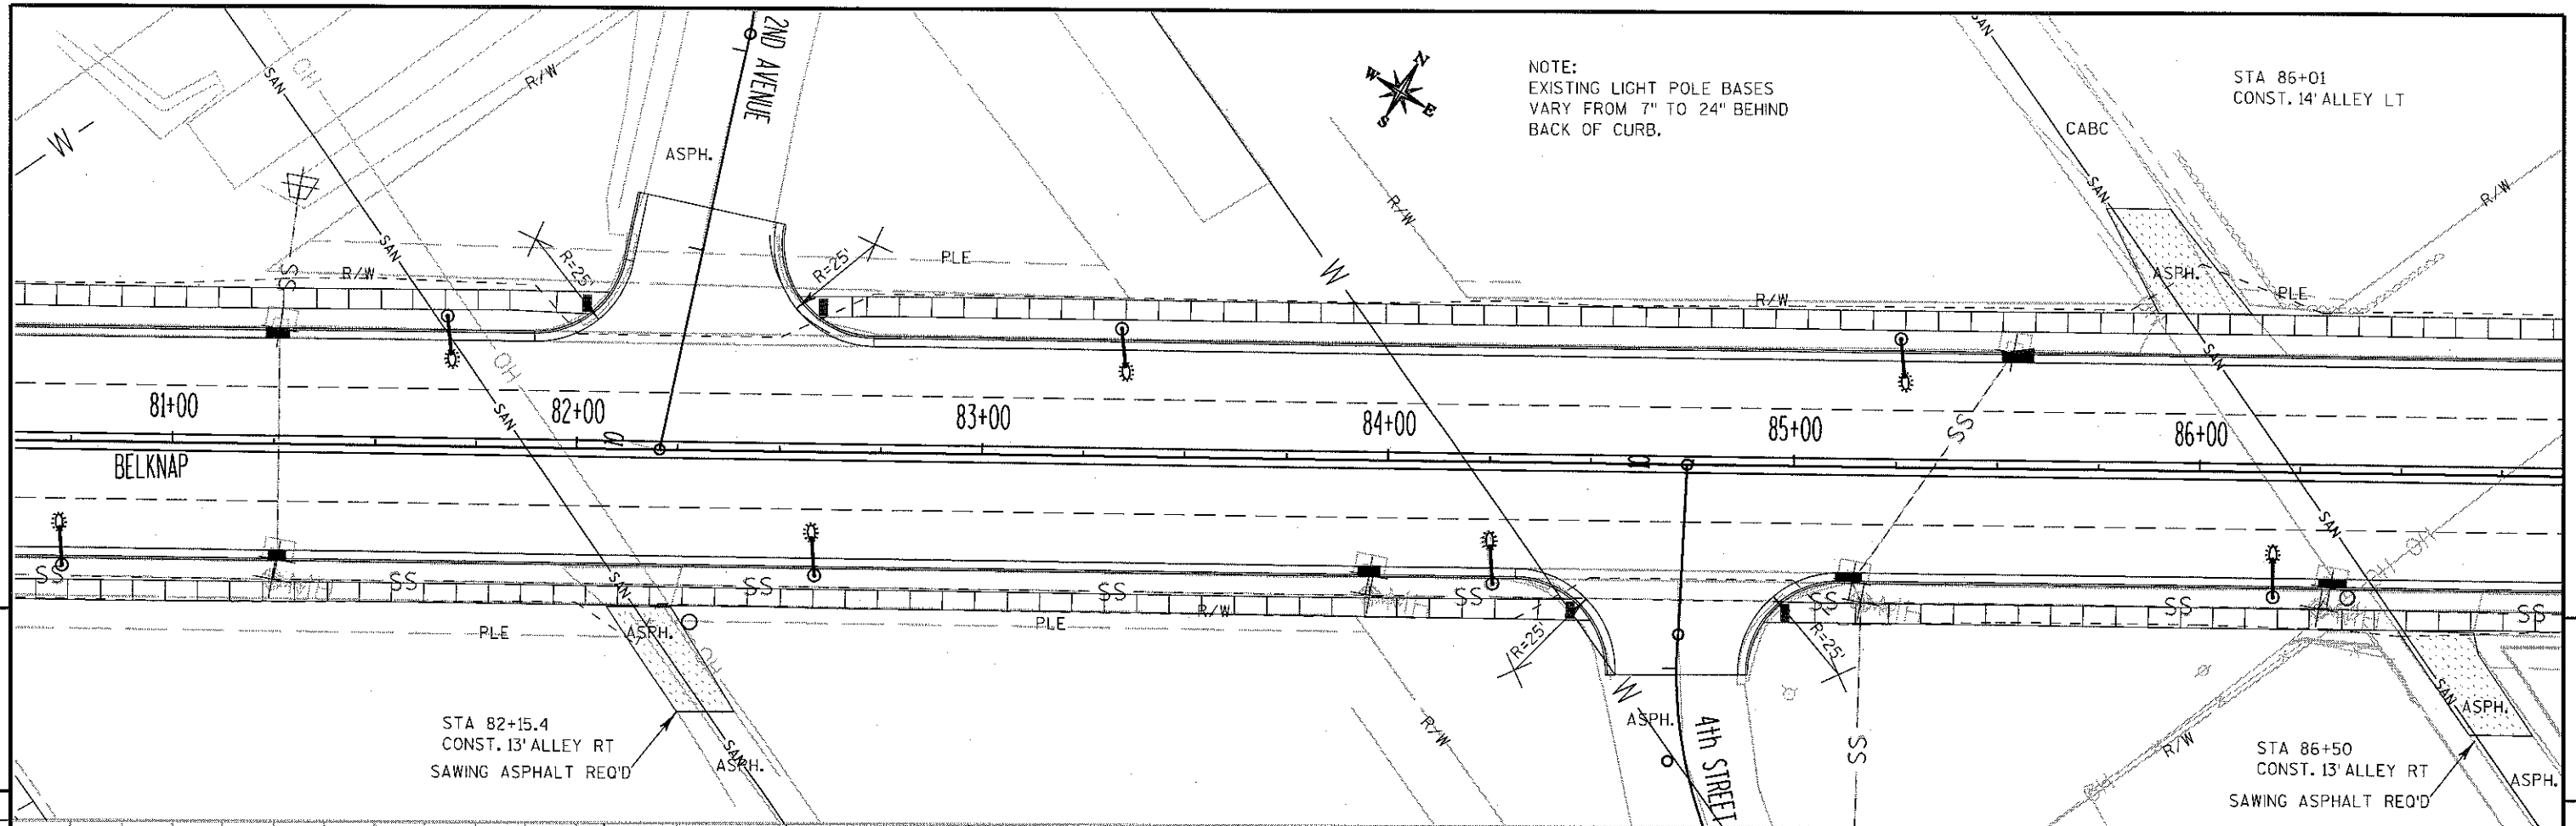


NOTE:  
EXISTING LIGHT POLE BASES  
VARY FROM 7" TO 24" BEHIND  
BACK OF CURB.

STA 86+01  
CONST. 14' ALLEY LT

5

5

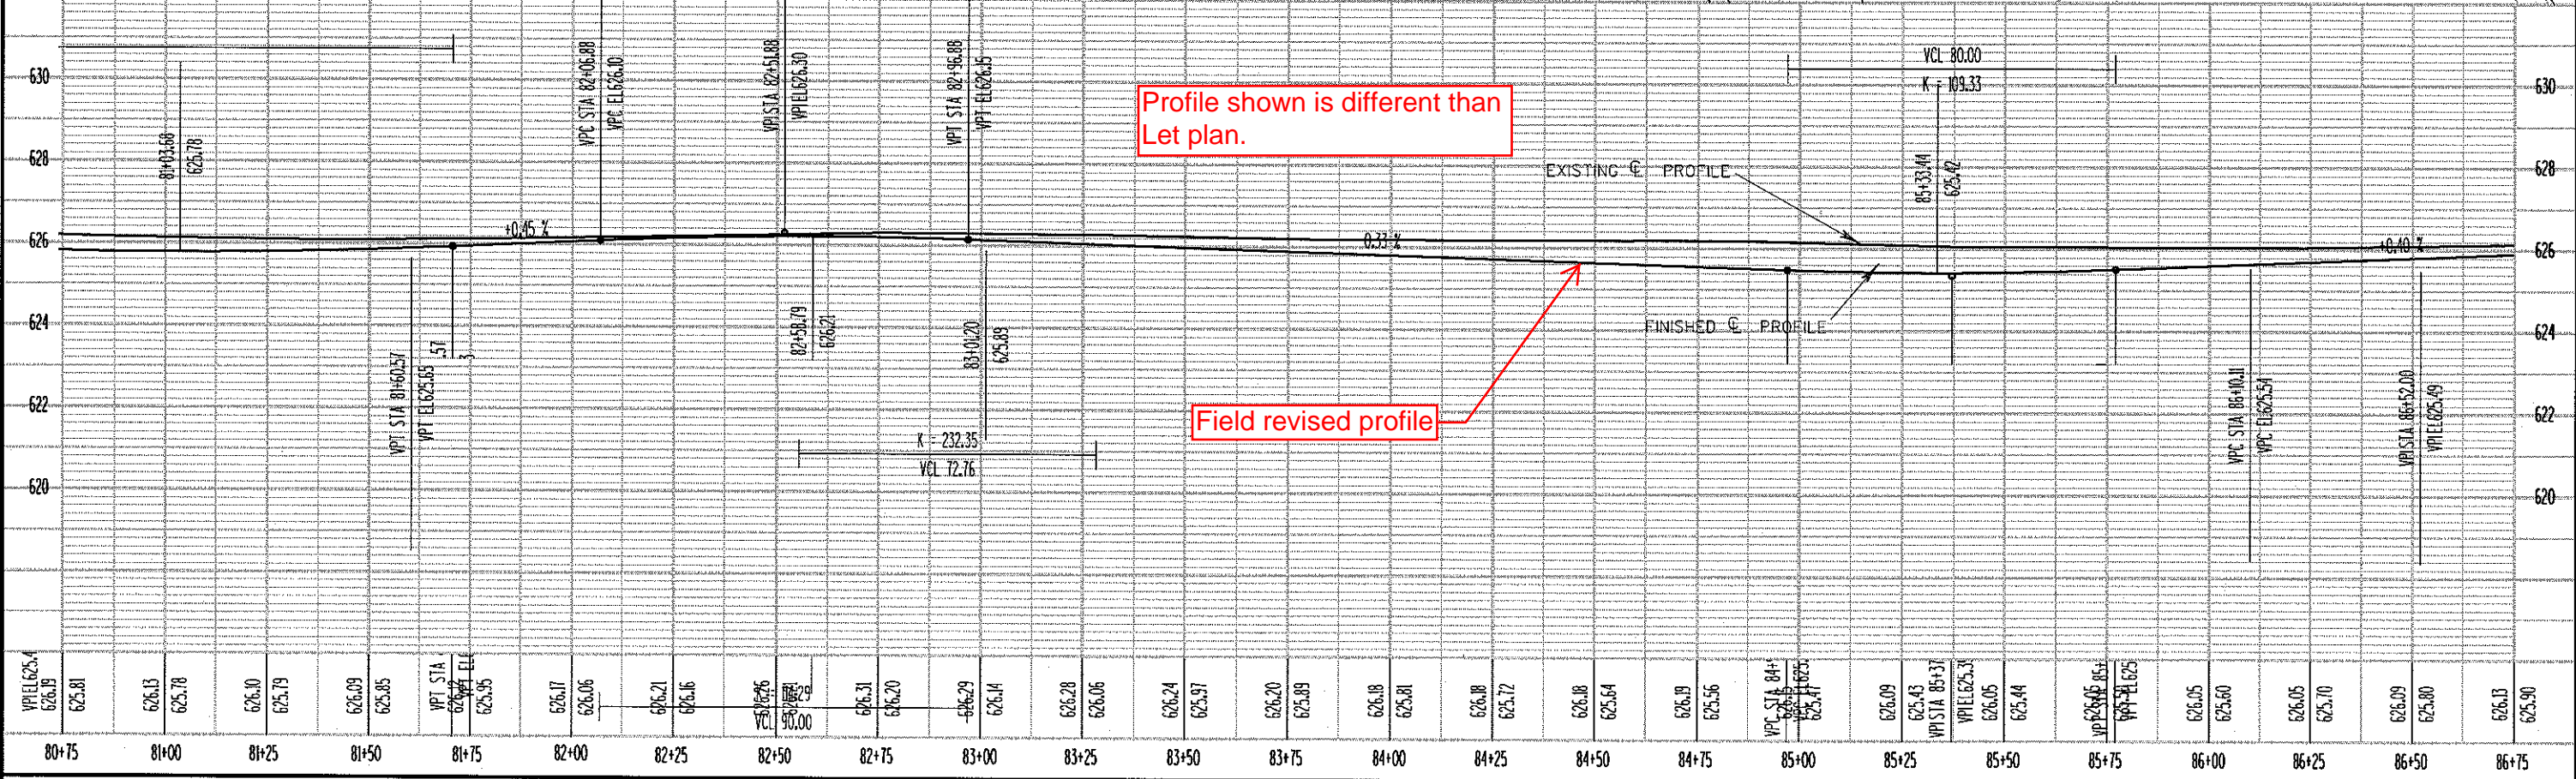


Profile shown is different than  
Let plan.

Field revised profile


NOTE:  
EXISTING LIGHT POLE BASES  
VARY FROM 7" TO 24" BEHIND  
BACK OF CURB.

CONST. 5' SIDEWALK STA 90+00 - 92+35 LT  
CONST. SIDEWALK TERRACE STA 92+00 - 92+35 LT  
CONST CENTER MEDIAN STA 91+38.1 - 92+15.9


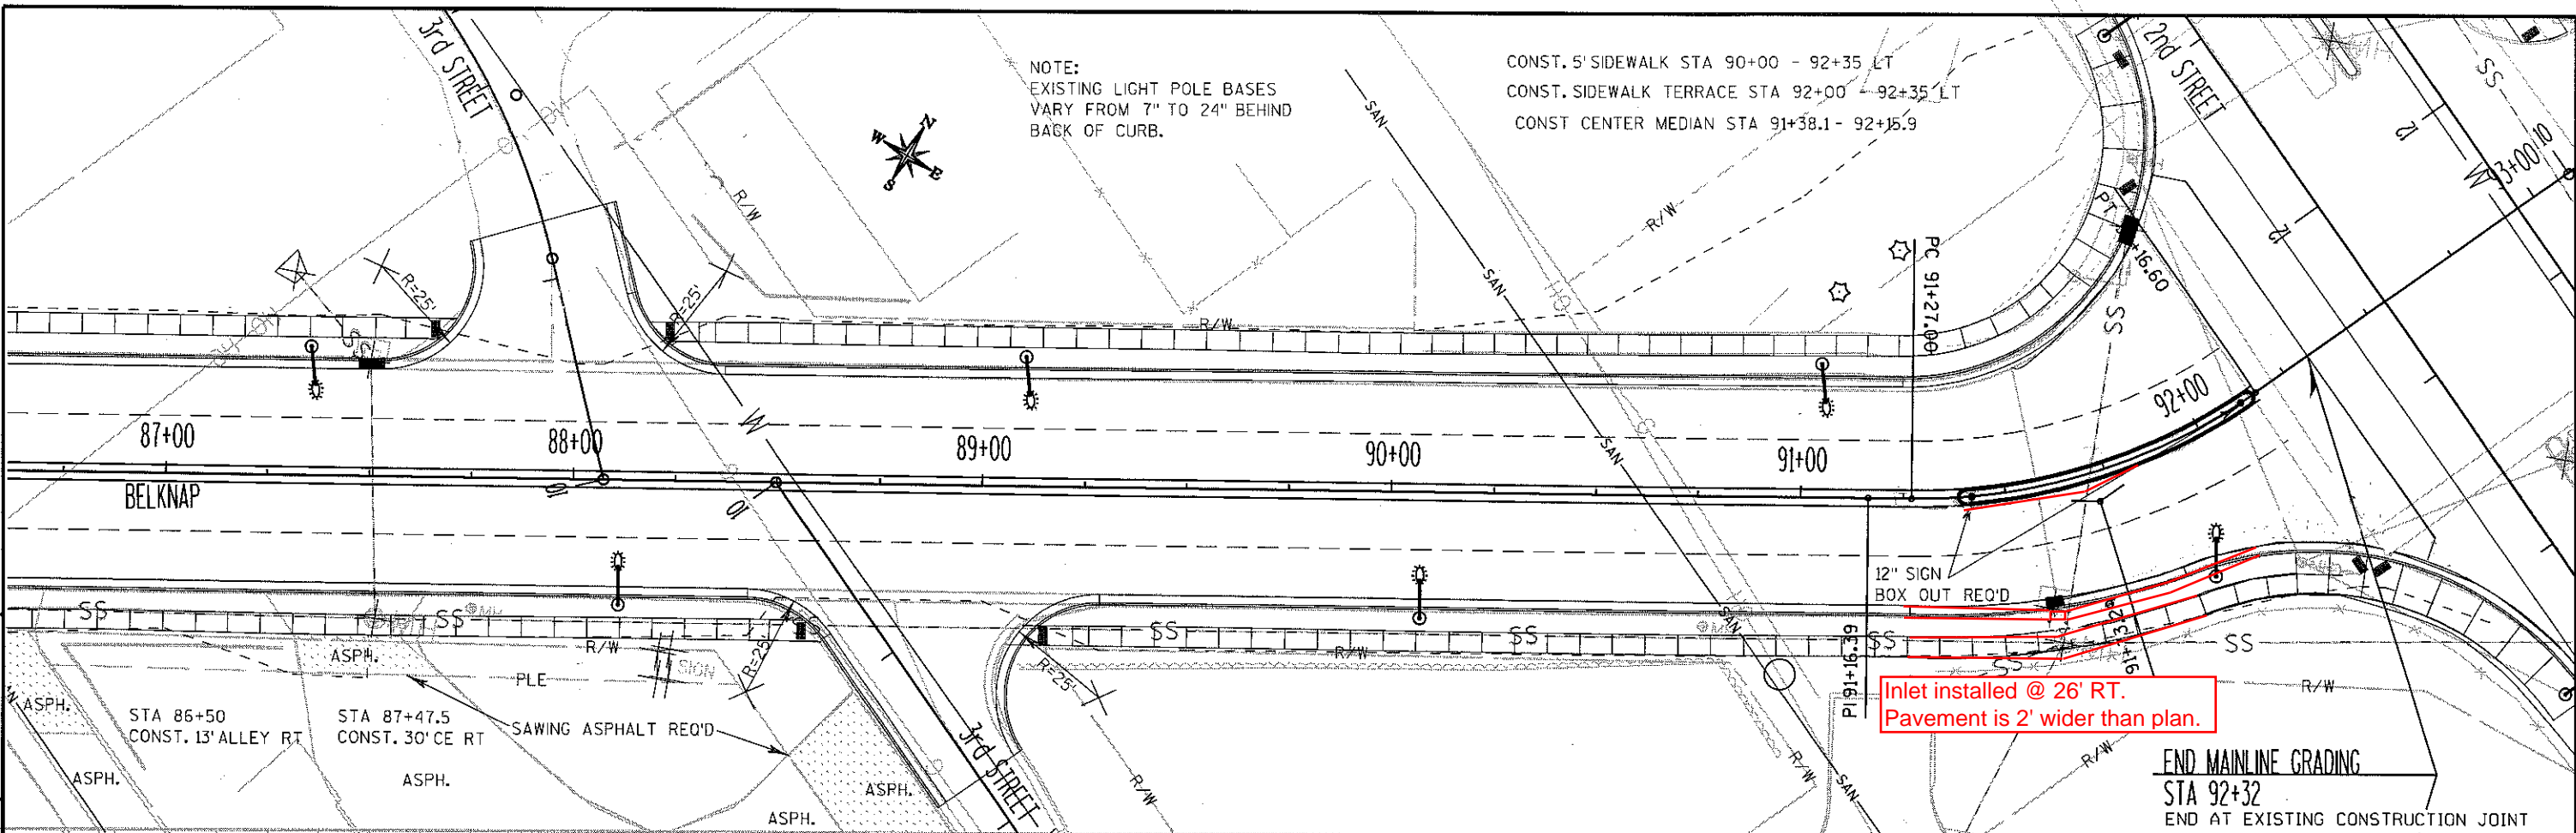


Inlet installed @ 26' RT.  
Pavement is 2' wider than plan.



END MAINLINE GRADING  
STA 92+32  
END AT EXISTING CONSTRUCTION JOINT

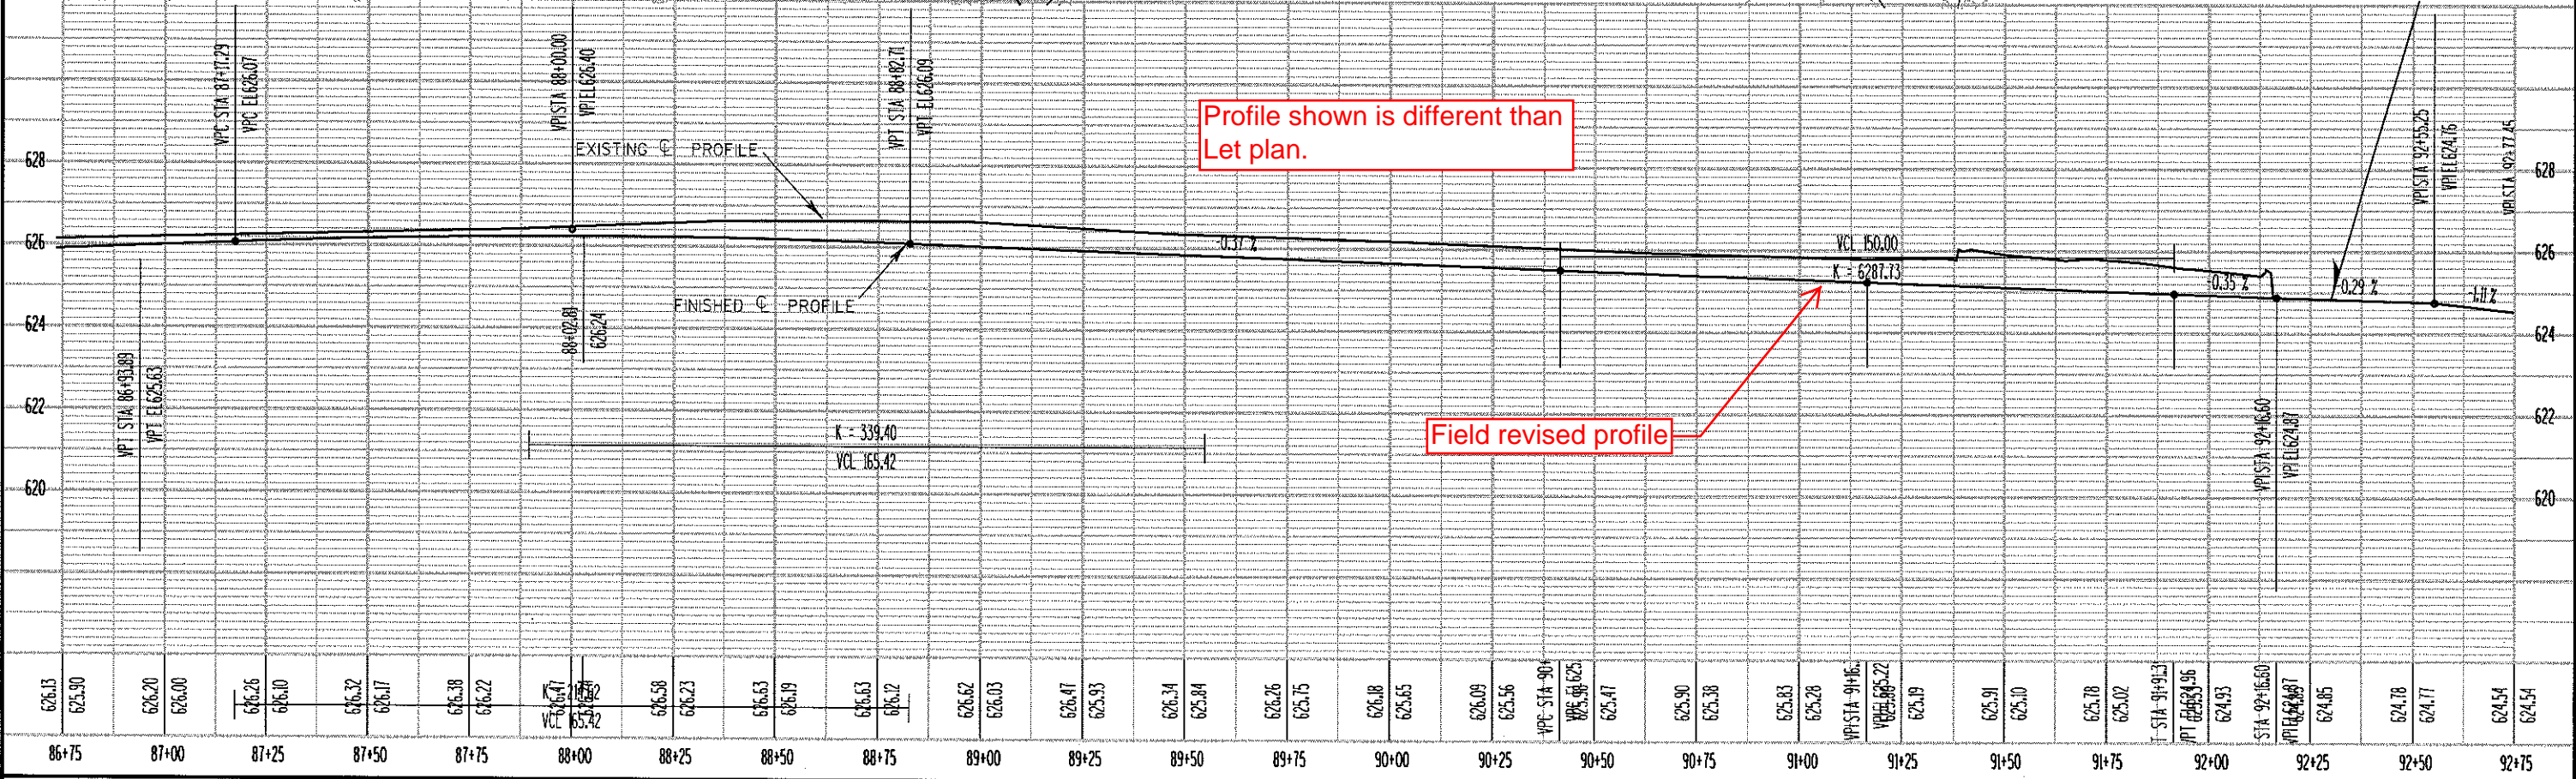

PROJECT NO: 1190-44-71	HWY: USH 2	COUNTY: DOUGLAS	PLAN & PROFILE	SHEET	<b>E</b>
------------------------	------------	-----------------	----------------	-------	----------

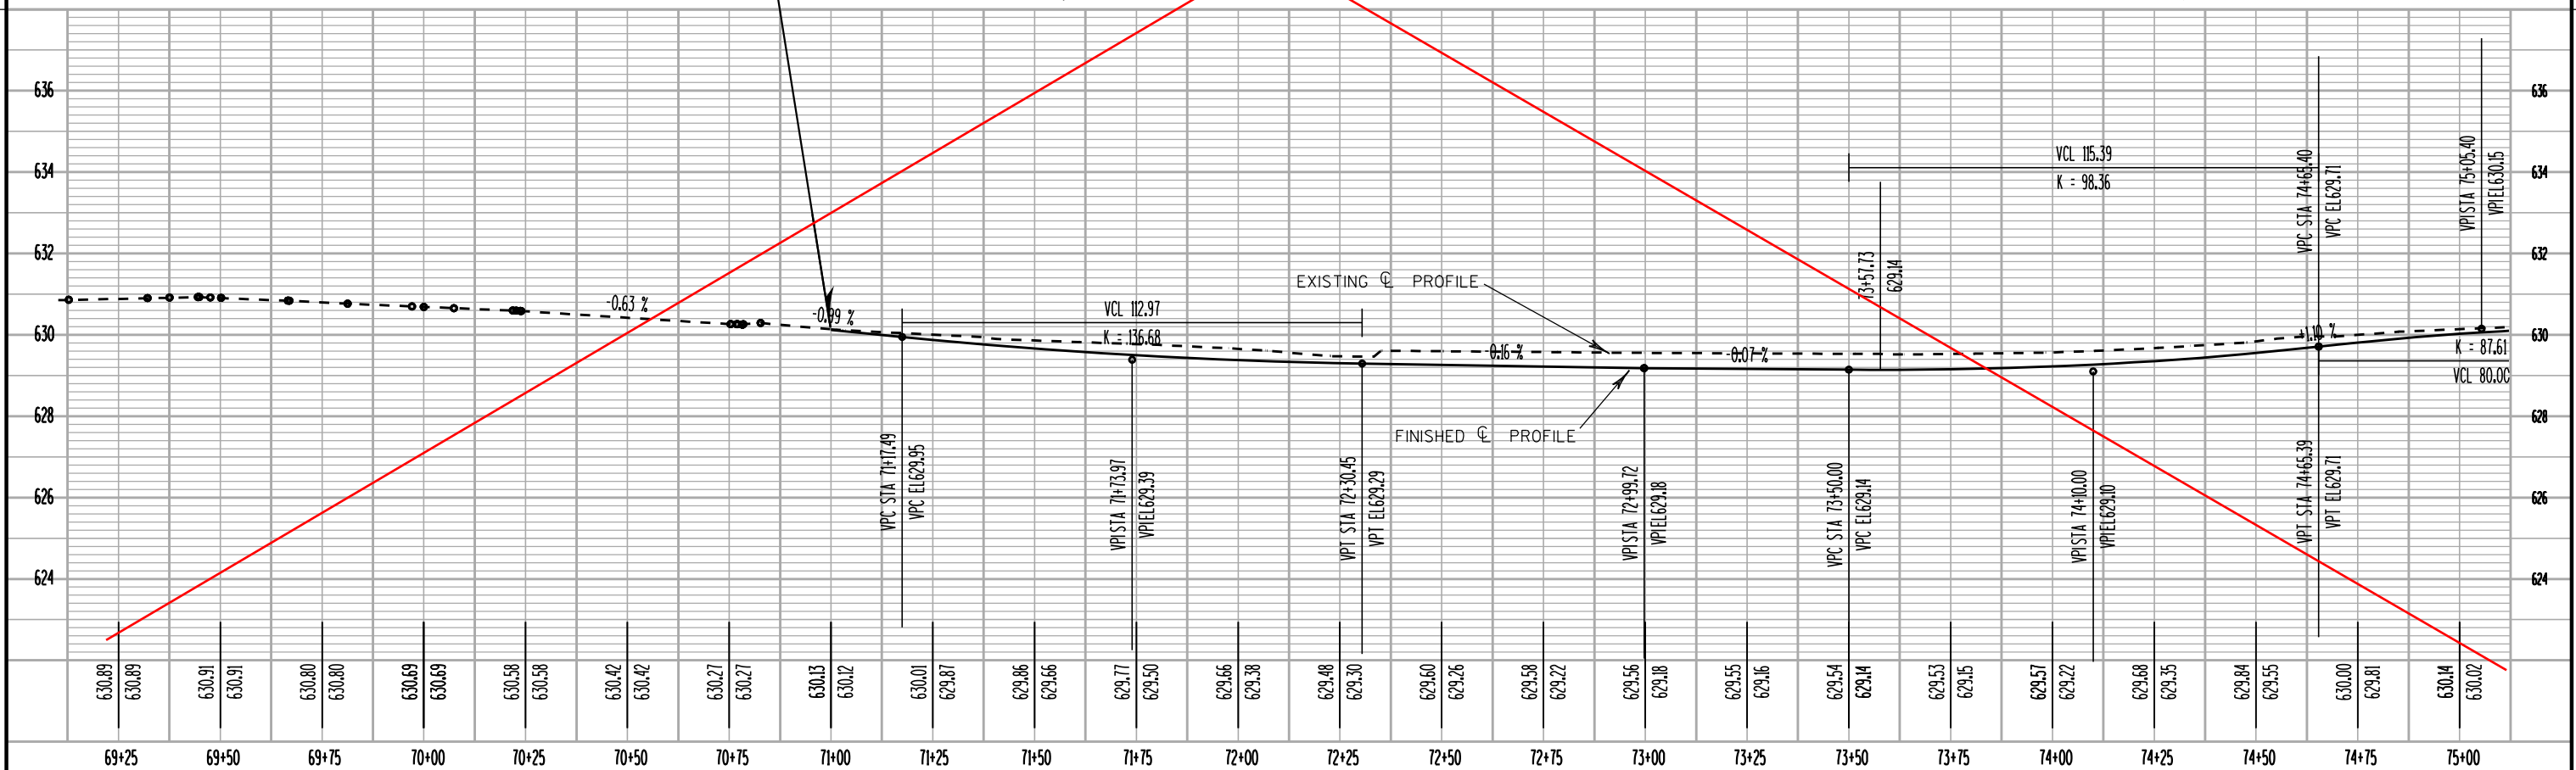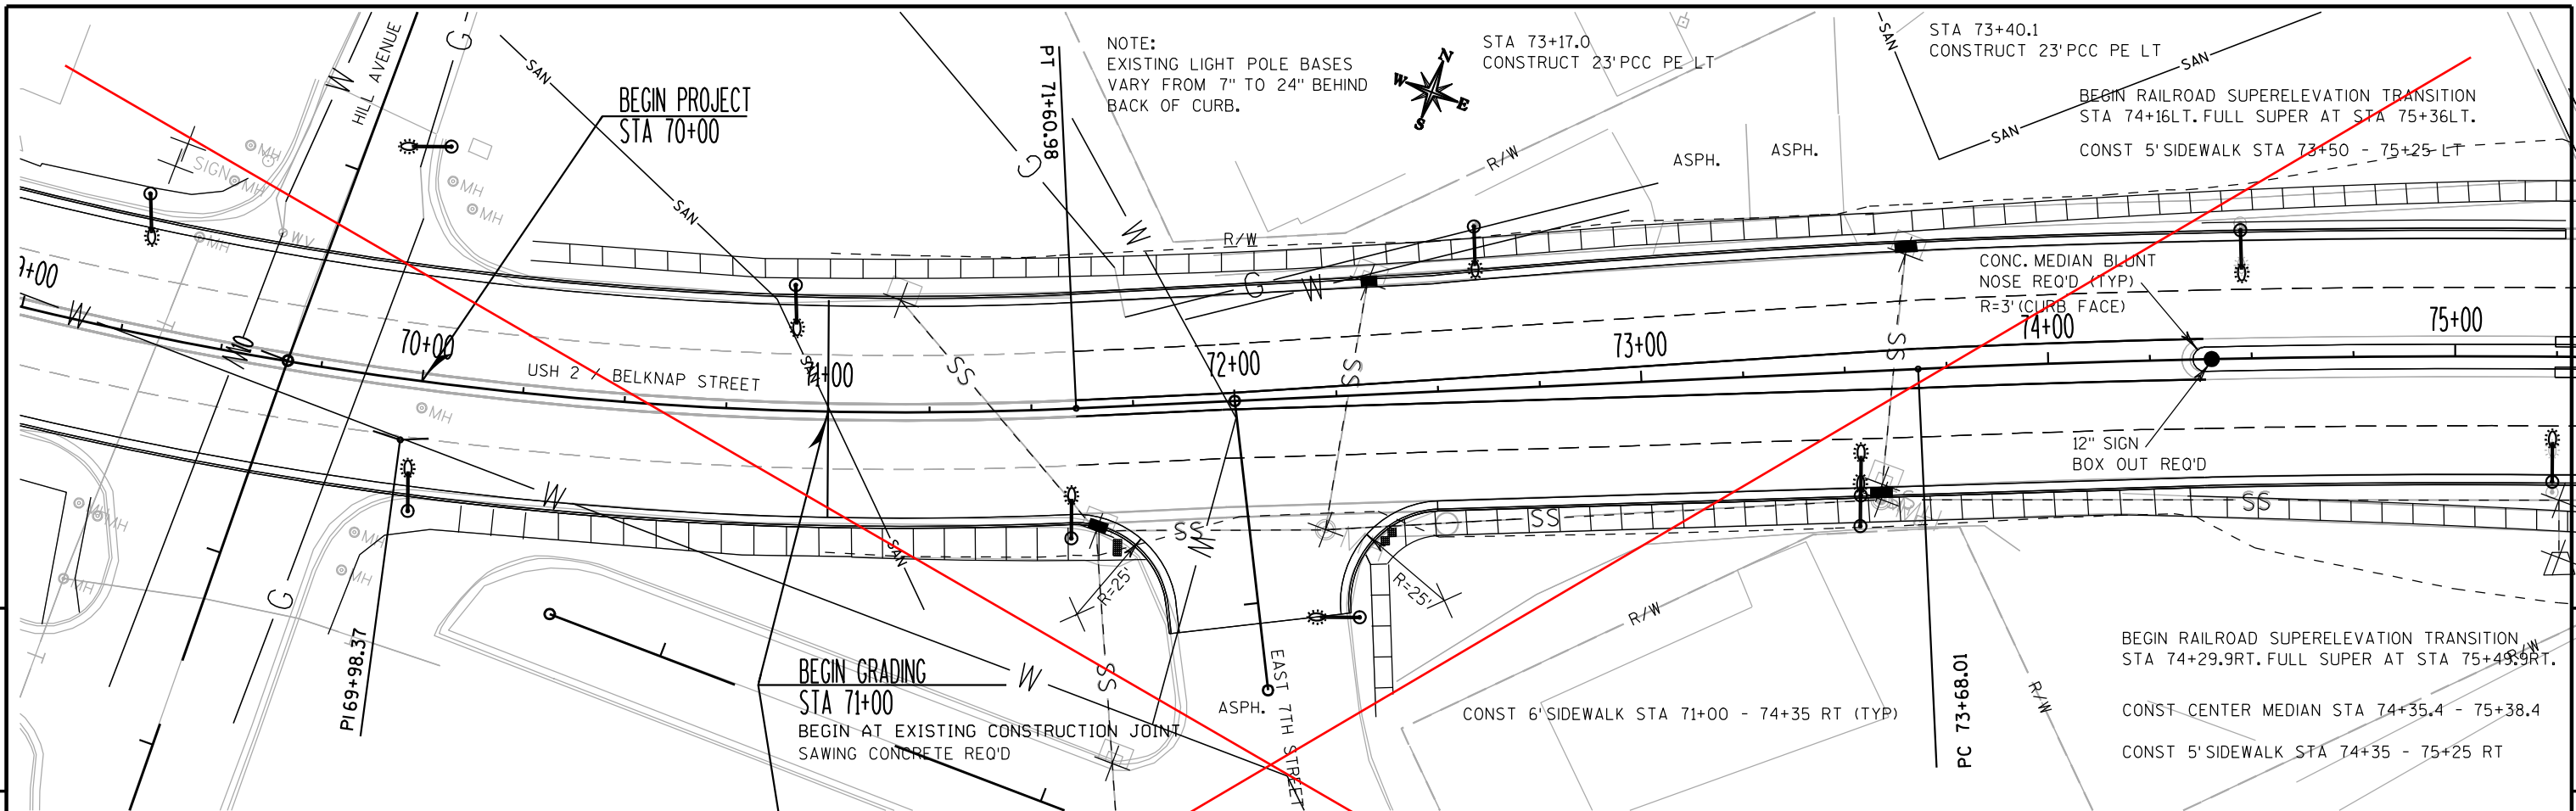


PROJECT NO: 1190-44-71	HWY: USH 2	COUNTY: DOUGLAS	PLAN & PROFILE	SHEET E
------------------------	------------	-----------------	----------------	---------

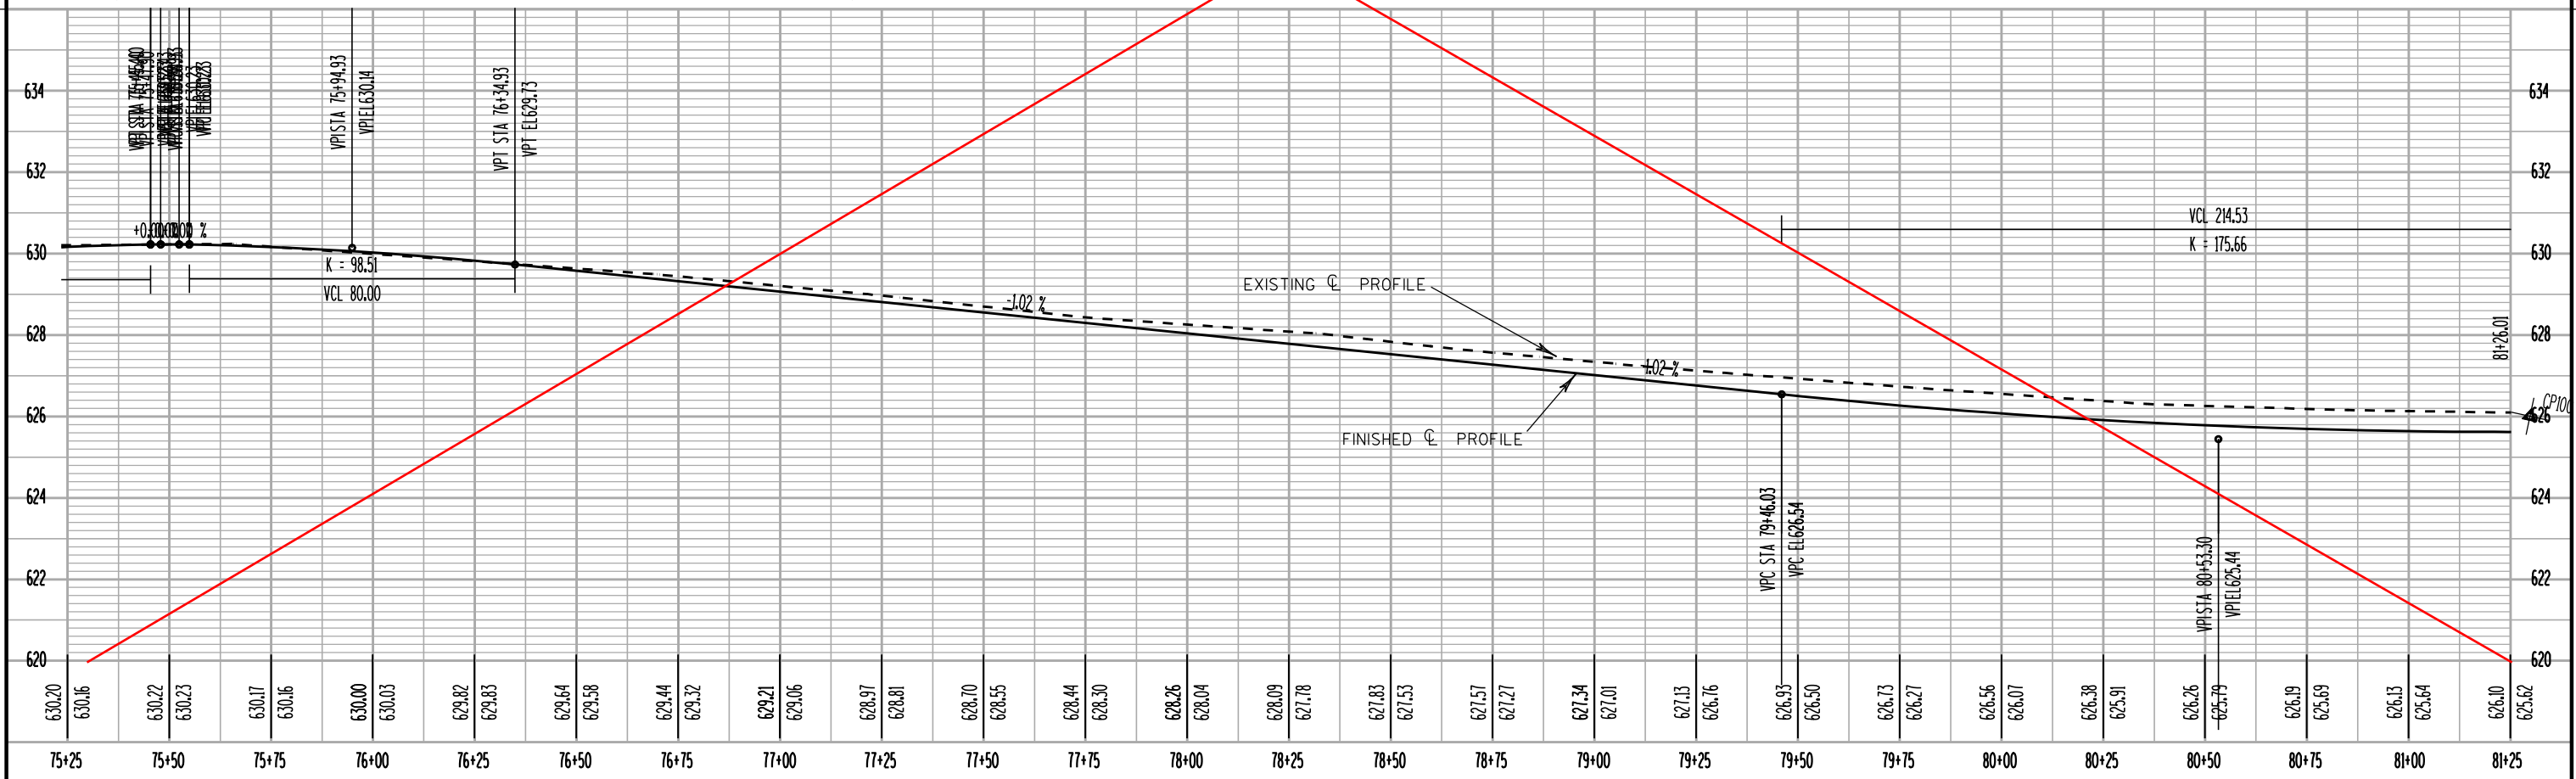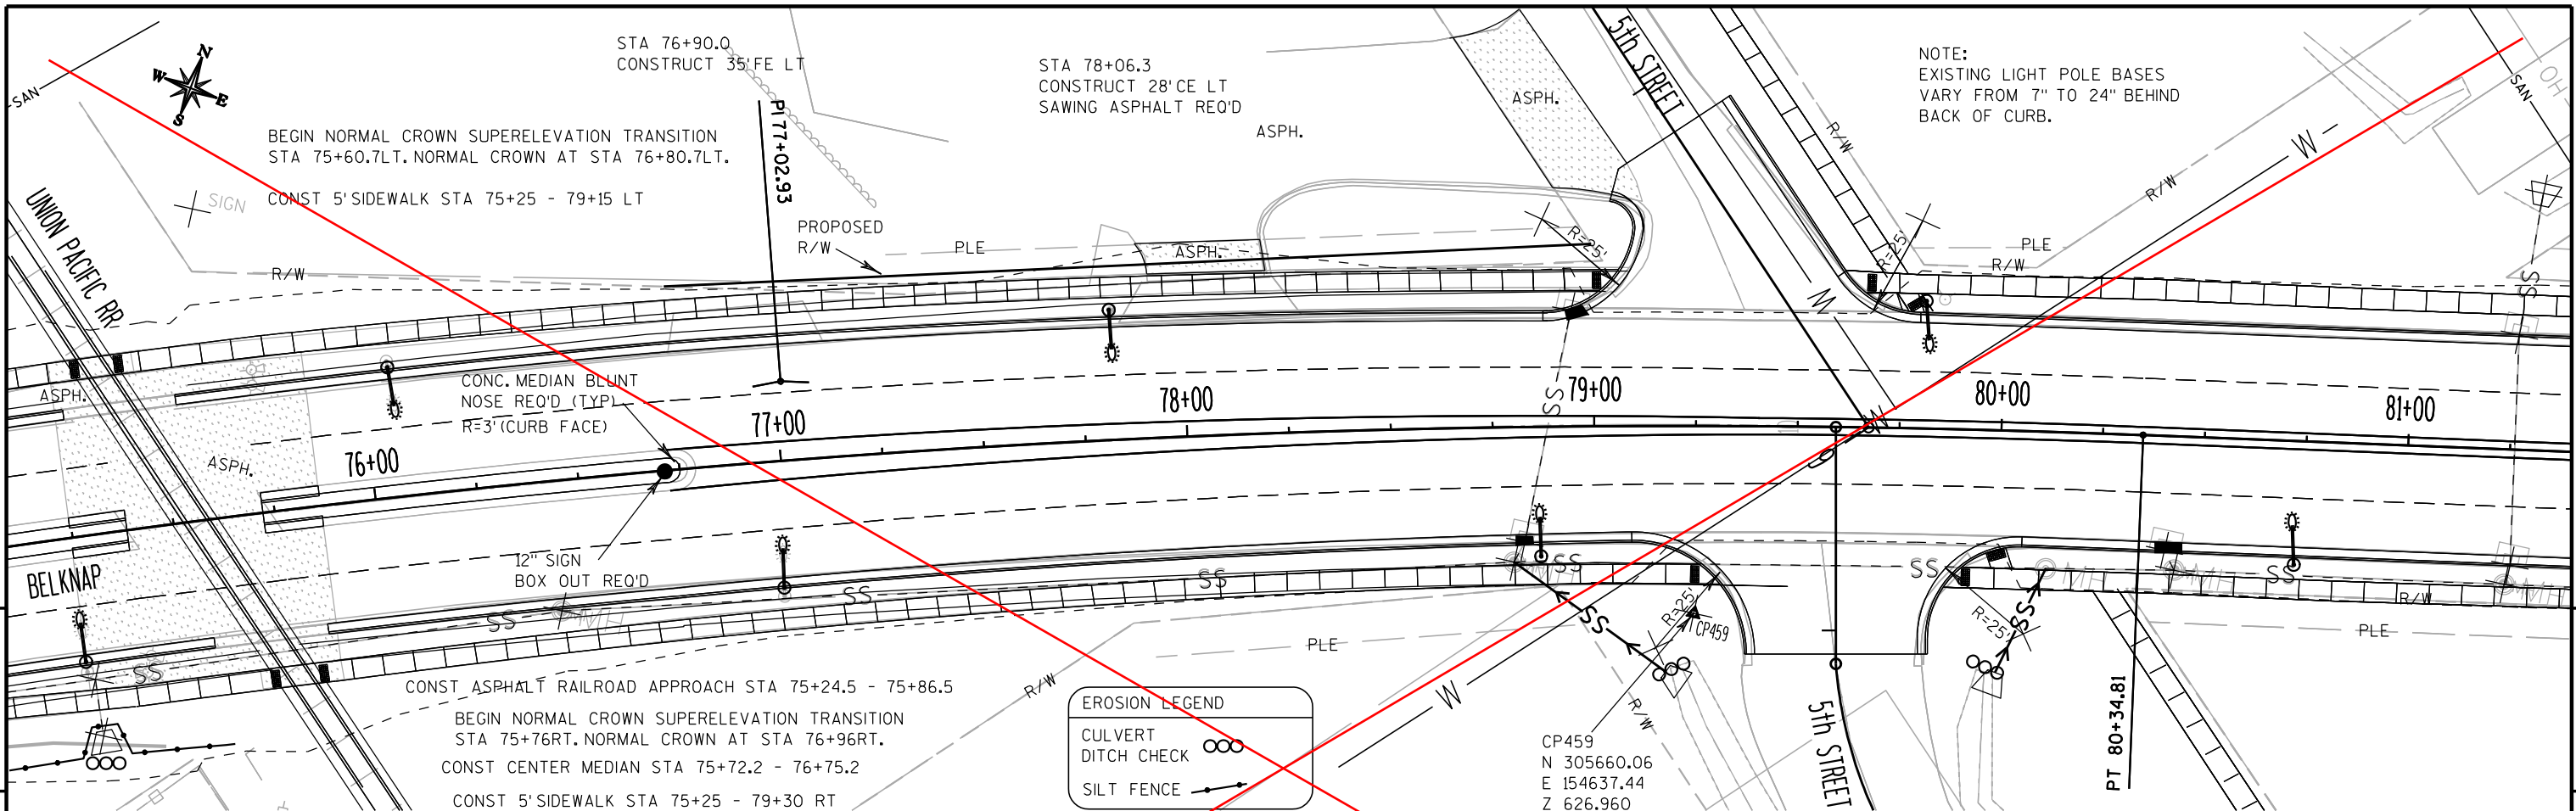


PROJECT NO: 1190-44-71      HWY: USH 2      COUNTY: DOUGLAS      PLAN & PROFILE      SHEET E




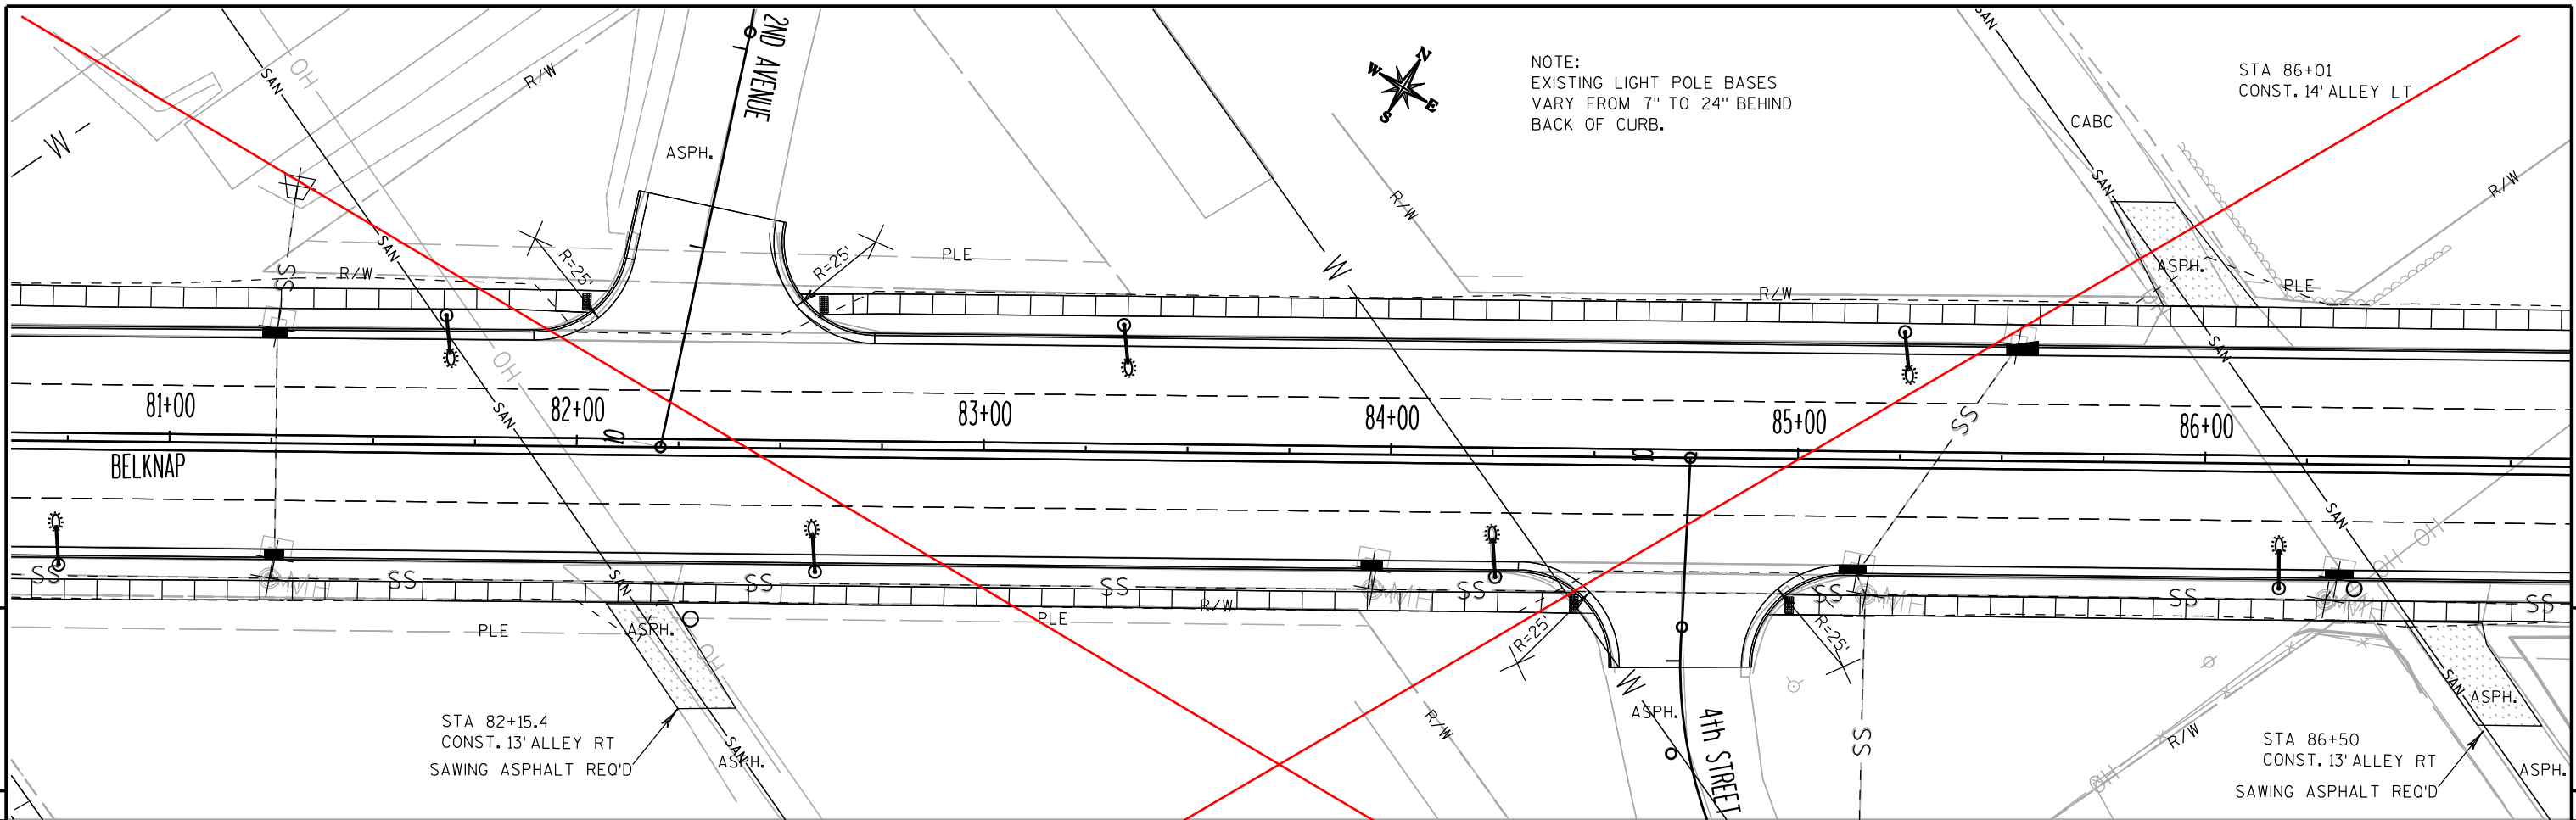


NOTE:  
EXISTING LIGHT POLE BASES  
VARY FROM 7" TO 24" BEHIND  
BACK OF CURB.

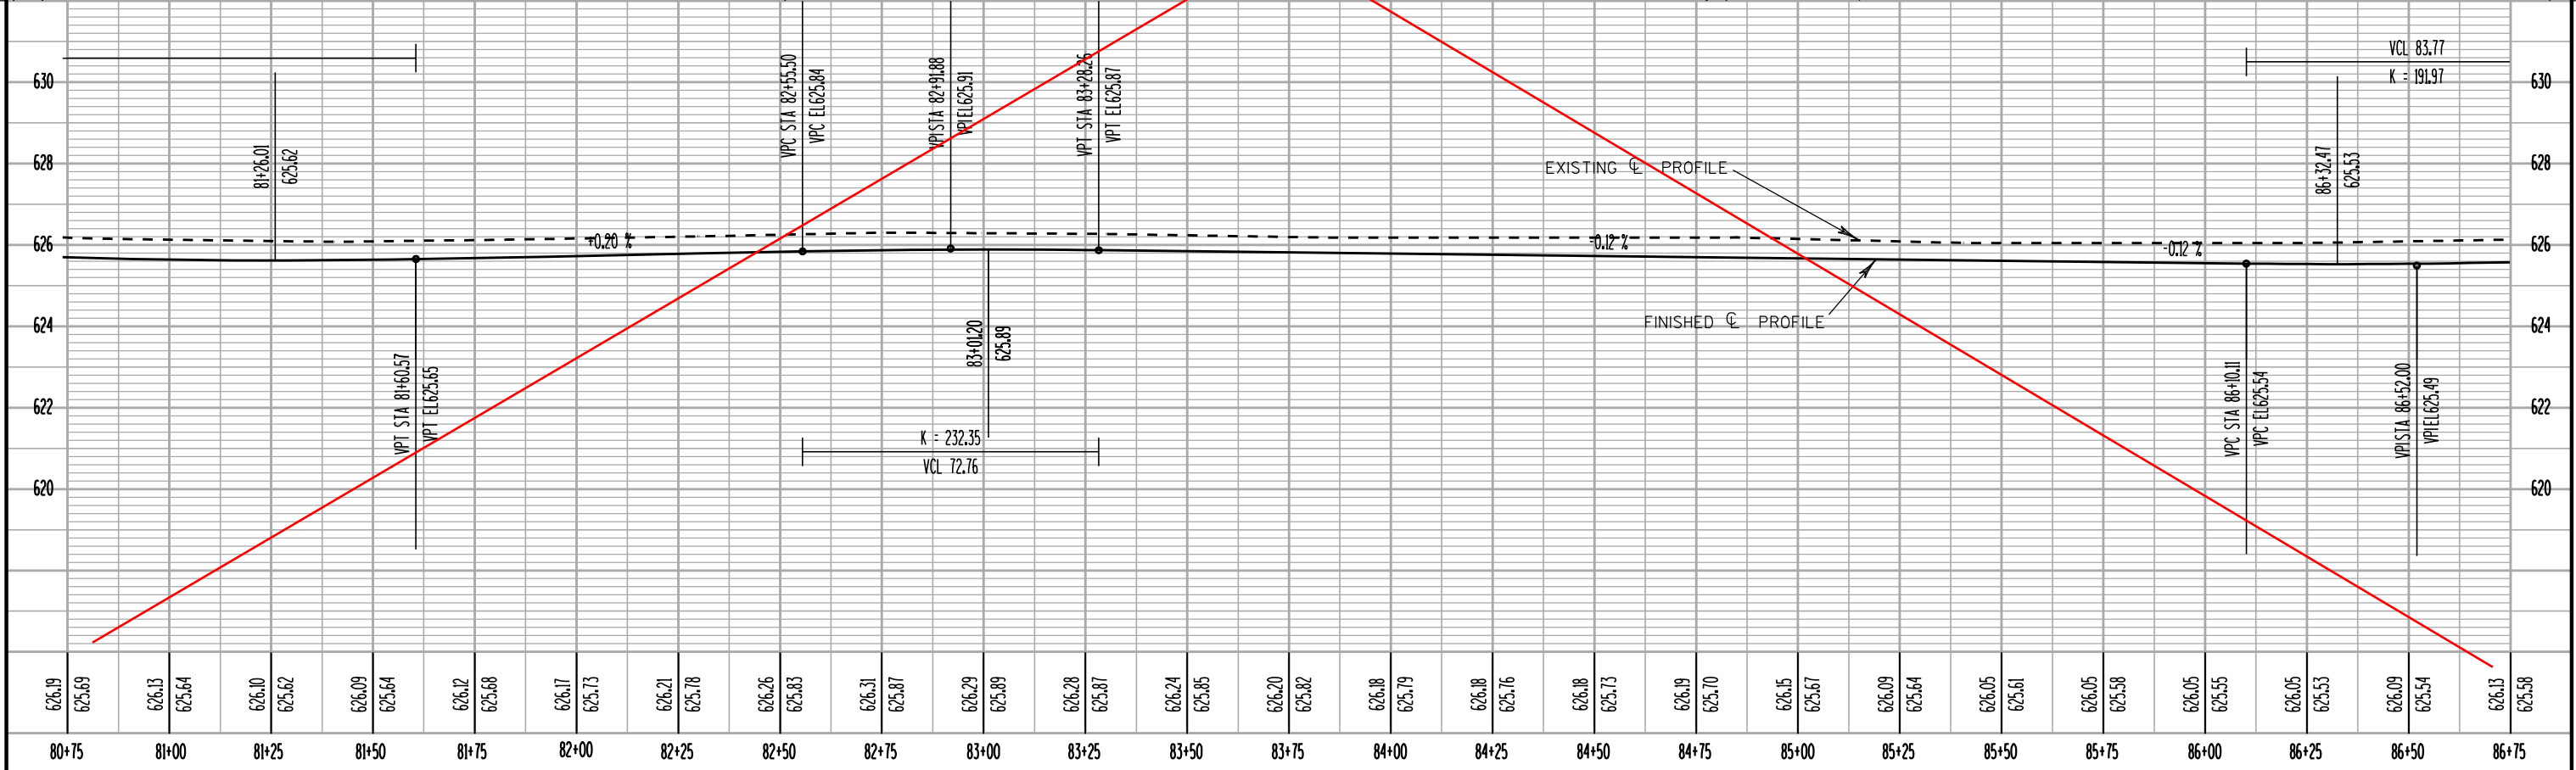

626.19	625.69	626.13	625.64	626.10	625.62	626.09	625.64	626.12	625.68	626.17	625.73	626.21	625.78	626.26	625.83	626.31	625.87	626.29	625.89	626.28	625.87	626.24	625.85	626.20	625.82	626.18	625.79	626.18	625.76	626.18	625.73	626.19	625.70	626.15	625.67	626.09	625.64	626.05	625.61	626.05	625.58	626.05	625.55	626.05	625.53	626.09	625.54	626.13	625.58
80+75	81+00	81+25	81+50	81+75	82+00	82+25	82+50	82+75	83+00	83+25	83+50	83+75	84+00	84+25	84+50	84+75	85+00	85+25	85+50	85+75	86+00	86+25	86+50	86+75																									

PROJECT NO: 1190-44-71      HWY: USH 2      COUNTY: DOUGLAS      PLAN & PROFILE      SHEET E

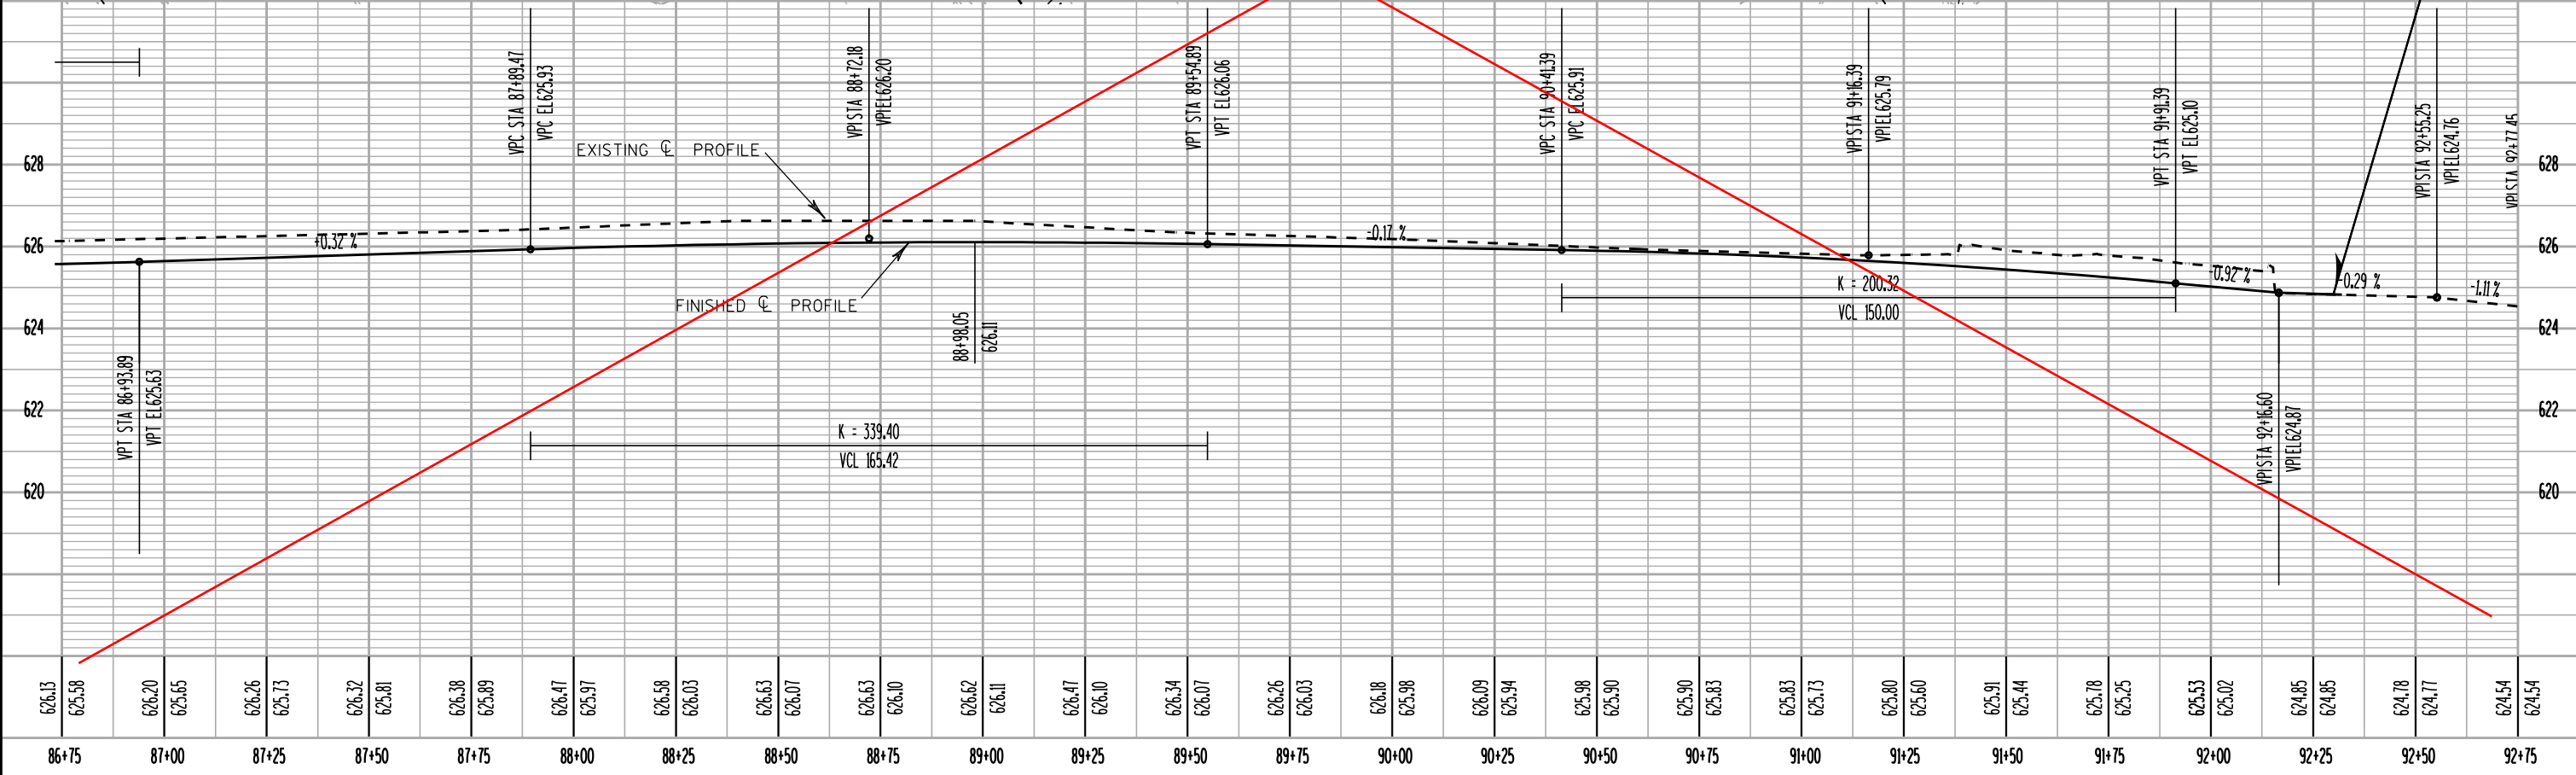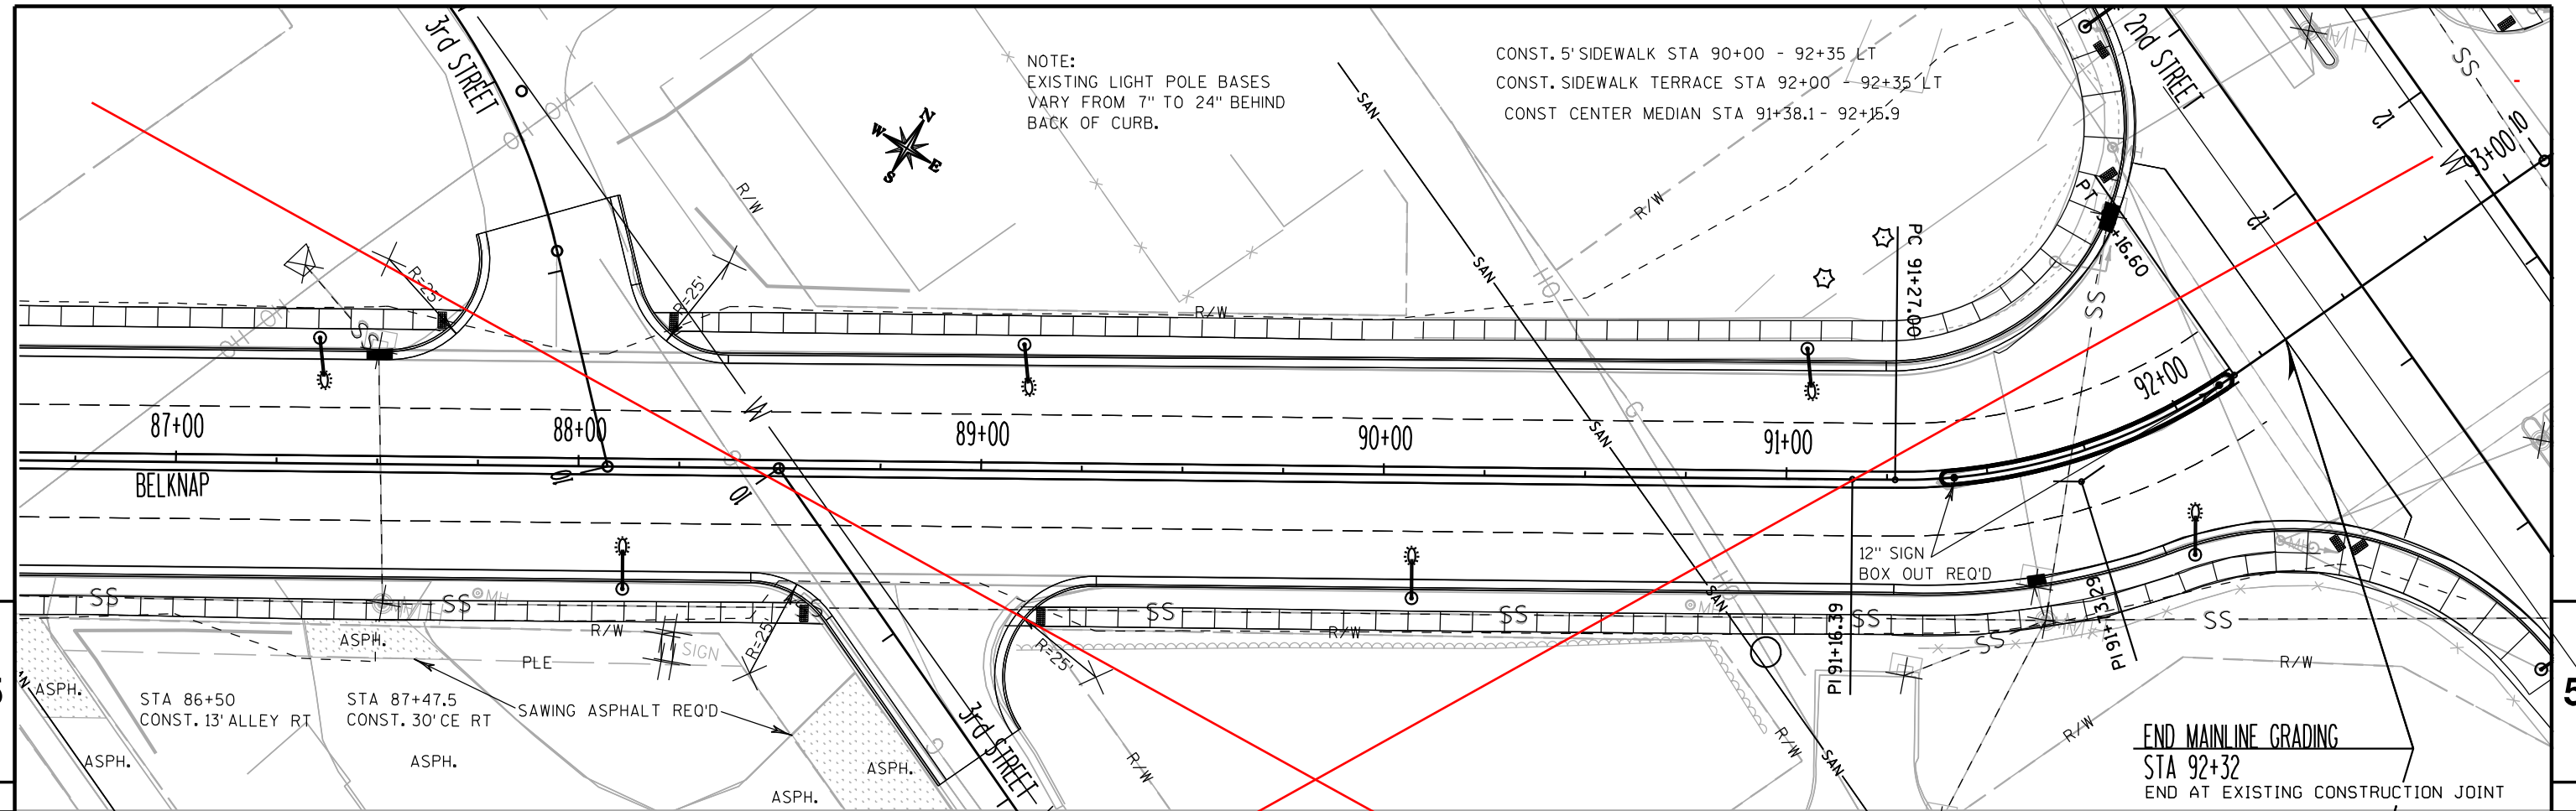

626.13	625.58	626.20	625.65	626.26	625.73	626.32	625.81	626.38	625.89	626.47	625.97	626.58	626.03	626.63	626.07	626.63	626.10	626.62	626.11	626.47	626.10	626.34	626.07	626.26	626.03	626.18	625.98	626.09	625.94	625.98	625.90	625.90	625.90	625.83	625.83	625.73	625.80	625.60	625.91	625.44	625.78	625.25	625.53	625.02	624.85	624.85	624.78	624.77	624.54	624.54
86+75	87+00	87+25	87+50	87+75	88+00	88+25	88+50	88+75	89+00	89+25	89+50	89+75	90+00	90+25	90+50	90+75	91+00	91+25	91+50	91+75	92+00	92+25	92+50	92+75																										

PROJECT NO: 1190-44-71

HWY: USH 2

COUNTY: DOUGLAS

PLAN & PROFILE

SHEET

E

NOTE:  
EXISTING LIGHT POLE BASES  
VARY FROM 7" TO 24" BEHIND  
BACK OF CURB.



CLEAR AND GRUB  
(APPROX 30" CIRCUMFERENCE TREE = 10.0 INCH OF DIAMETER)

CLEAR AND GRUB  
(APPROX 78" CIRCUMFERENCE TREE = 26.0 INCH OF DIAMETER)

REMOVING PAVEMENT  
SAWING CONCRETE REQ'D

CONSTRUCT 4" SIDEWALK  
CURB RAMP (TYP)

CLEAR AND GRUB  
(APPROX 23" CIRCUMFERENCE TREE = 7.7 INCH OF DIAMETER)

CONSTRUCT SIDEWALK  
W/CURB RAMP (TYP)

END PROJECT  
STA 93+30

CONC. MEDIAN BLUNT  
NOSE REQ'D  
R=2' (CURB FACE)

END MAINLINE GRADING  
STA 92+32  
END AT EXISTING CONSTRUCTION JOINT  
SAWING CONCRETE REQ'D

REMOVE ABANDONED BASE



5

5


## Standard Detail Drawing List

08A5-16A	INLET COVERS TYPE A, H, A-S, & H-S
08A5-17D	INLET COVER, TYPE Z MANHOLE COVERS, TYPE K, J, J-S, J-H, J-H-S, L & M
08A6-4	CATCH BASINS TYPE 1 & 2
08A7-3	CATCH BASINS TYPE 3 & 5
08B6-4	MANHOLES TYPE 1
08D1-17	CONCRETE CURB, CONCRETE CURB AND GUTTER AND TIES
08D5-14A	CURB RAMPS TYPES 1 AND 1-A
08D5-14B	CURB RAMPS TYPES 2 AND 3
08D5-14C	CURB RAMPS TYPE 4A
08D5-14D	CURB RAMPS TYPE 4B
08D5-14E	CURB RAMPS TYPES 5, 6, 7A, 7B & 8
08E9-6	SILT FENCE
08E10-2	INLET PROTECTION TYPE A, B, C AND D
08F1-11	APRON ENDWALLS FOR CULVERT PIPE
09B2-7	CONDUIT
09B4-9	PULL BOX
09C2-6	CONCRETE BASES, TYPES 1, 2 & 5
09F15-3A	LOOP DETECTOR INSTALLED IN BASE COURSE WITH PULL (SPLICE) BOX OFF ROADWAY (OPTION 1)
11B2-2	CONCRETE MEDIAN NOSE
13B1-10	PAVEMENT DETAILS FOR RAILROAD APPROACH
13C1-14	CONCRETE PAVEMENT LONGITUDINAL JOINTS AND TIES
13C13-7	URBAN DOWELED CONCRETE PAVEMENT
15C2-4A	BARRICADES AND SIGNS FOR MAINLINE CLOSURES
15C2-4B	BARRICADES AND SIGNS FOR MAINLINE CLOSURES
15C2-4C	DETOUR SIGNING FOR MAINLINE CLOSURES
15C3-1	BARRICADES AND SIGNS FOR SIDEROAD CLOSURES
15C5-1	TRAFFIC CONTROL, ADVANCE WARNING SIGNS 40 M. P. H. OR LESS
15C7-11B	PAVEMENT MARKING WORDS
15C7-11D	PAVEMENT MARKING ARROWS
15C8-13A	PAVEMENT MARKING (MAINLINE)
15C8-13B	PAVEMENT MARKING (INTERSECTIONS)
15C8-13E	PAVEMENT MARKING (LEFT TURN LANE)
15C8-13F	PAVEMENT MARKING (ISLANDS, STOP LINE & CROSS WALK)
15C9-8A	SIGNING AND PAVEMENT MARKING DETAILS FOR RAILROAD-HIGHWAY GRADE CROSSINGS
15C18-3	MEDIAN ISLAND MARKING
15C26-1	END-OF-ROADWAY SIGNING
15D20-1	TRAFFIC CONTROL, SINGLE LANE CLOSURE, NON-FREEWAY/EXPRESSWAY

NOTE:  
GRATE IS REVERSIBLE.

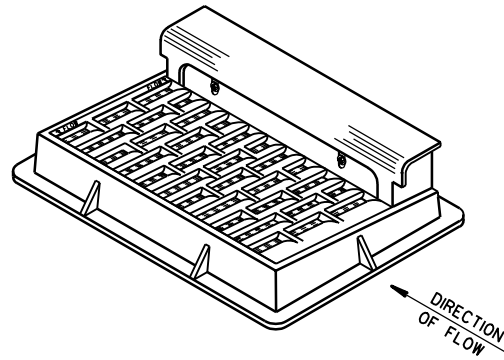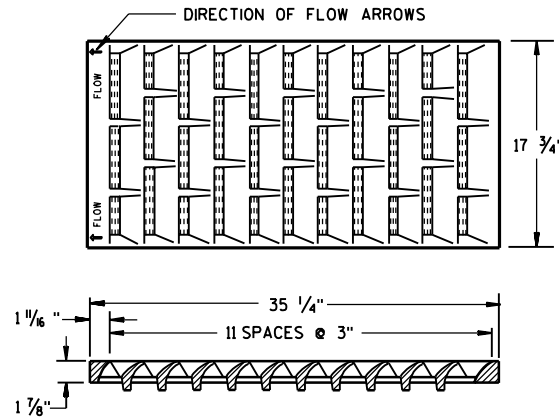


NOTE: CURB BOX HEIGHT ADJUSTABLE 6" TO 9"

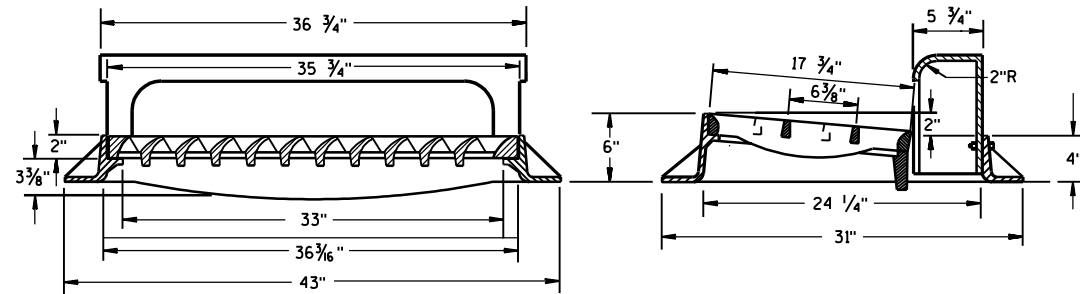

**TYPE "H"**

(APPROXIMATE WEIGHT 422 LBS.)  
 FRAME..... 175 LBS.  
 GRATE..... 138 LBS.  
 CURB BOX..... 109 LBS.

1 1/8" DIAGONAL BARS WITH 1 5/8" OPENINGS

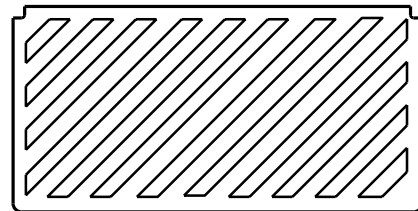

**SPECIAL GRATE FOR  
TYPE "H" COVER**

(MEASURES 35 1/4" X 17 3/4" X 2")  
 (APPROXIMATE WEIGHT 172 LBS.)  
 GRATE..... 172 LBS.

(NOTED AS TYPE H-S ON DRAINAGE TABLE)




**GENERAL NOTES**

DETAILS OF CONSTRUCTION, MATERIALS AND WORKMANSHIP NOT SHOWN ON THIS DRAWING SHALL CONFORM TO THE PERTINENT REQUIREMENTS OF THE STANDARD SPECIFICATIONS AND THE APPLICABLE SPECIAL PROVISIONS.


DETAIL DRAWINGS FOR PROPOSED ALTERNATE DESIGNS FOR CATCH BASIN, MANHOLE AND INLET COVERS SHALL BE SUBMITTED TO THE ENGINEER FOR APPROVAL PROVIDING THAT SUCH ALTERNATE DESIGNS MAKE PROVISION FOR EQUIVALENT CAPACITY AND STRENGTH.

ROUND FRAMES AND COVERS SHALL HAVE CONTINUOUSLY MACHINED BEARING SURFACES TO PREVENT ROCKING AND RATTLING.

THE ACTUAL WEIGHT OF COVERS MAY VARY WITHIN 5 PERCENT, PLUS OR MINUS, OF THE APPROXIMATE WEIGHT.

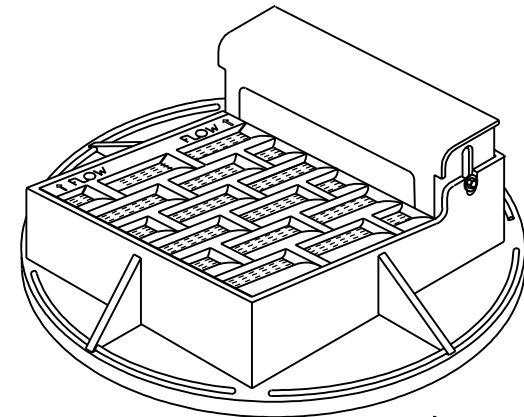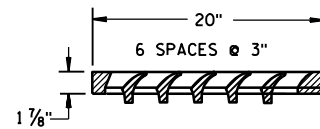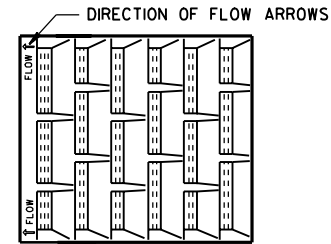

NOTE: CURB BOX ADJUSTABLE 4" TO 9"

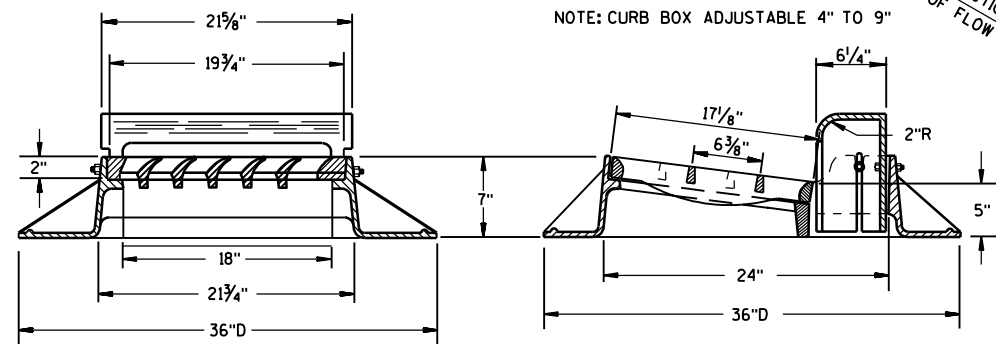


**TYPE "A"**

(APPROXIMATE WEIGHT 325 LBS.)  
 FRAME..... 157 LBS.  
 GRATE..... 84 LBS.  
 CURB BOX..... 84 LBS.

NOTE:  
GRATE IS REVERSIBLE.

1" DIAGONAL BARS  
WITH 1 1/2" OPENINGS

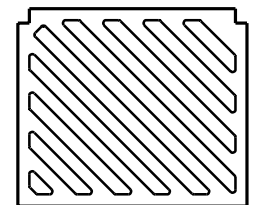

**SPECIAL GRATE FOR  
TYPE "A" COVER**

(MEASURES 19 3/4" X 17" X 1 7/8")

GRATE..... 84 LBS.

(NOTED AS TYPE A-S ON DRAINAGE TABLE)



6

6



**INLET COVERS  
TYPE A, H, A-S, & H-S**

STATE OF WISCONSIN  
DEPARTMENT OF TRANSPORTATION



APPROVED  
 10/4/99 DATE  
 [Signature] CHIEF ROADWAY DEVELOPMENT ENGINEER  
 FHWA

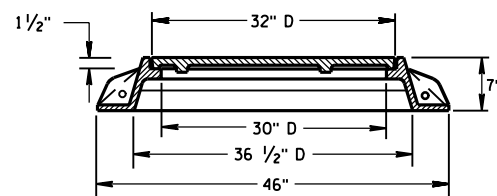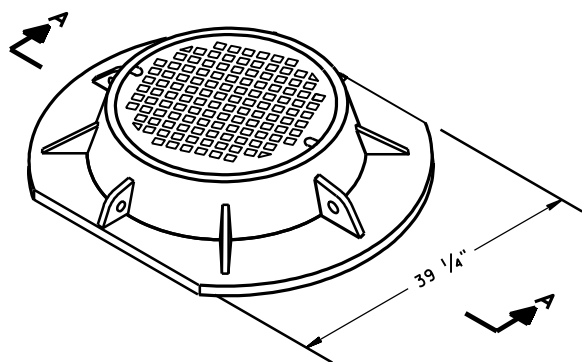

**SECTION A-A  
TYPE "K"**  
(APPROXIMATE WEIGHT 415 LBS.)  
FRAME..... 210 LBS.  
LID..... 205 LBS.

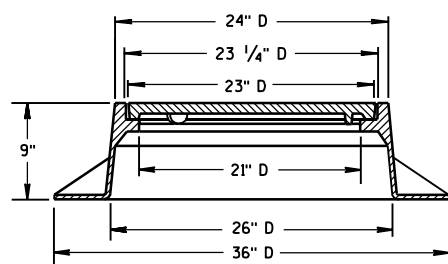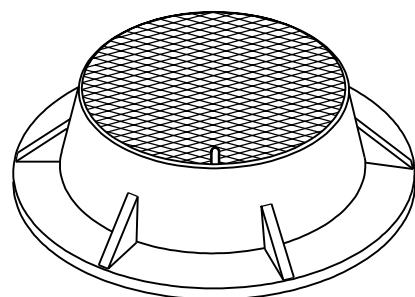

**TYPE "J"**  
(APPROXIMATE WEIGHT 250 LBS.)  
FRAME..... 135 LBS.  
LID..... 115 LBS.

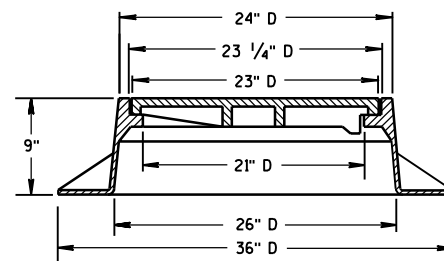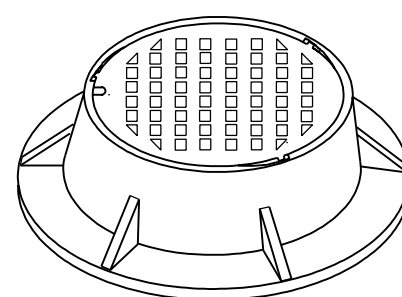

**TYPE "J" SPECIAL**  
TYPE "B" NON-ROCKING SELF-SEAL LID  
(APPROXIMATE WEIGHT 245 LBS.)  
FRAME..... 145 LBS.  
LID..... 100 LBS.  
(NOTED AS TYPE J-S ON THE DRAINAGE TABLE)

**GENERAL NOTES**


DETAILS OF CONSTRUCTION, MATERIALS AND WORKMANSHIP NOT SHOWN ON THIS DRAWING SHALL CONFORM TO THE PERTINENT REQUIREMENTS OF THE STANDARD SPECIFICATIONS AND THE APPLICABLE SPECIAL PROVISIONS.

DETAIL DRAWINGS FOR PROPOSED ALTERNATE DESIGNS FOR MANHOLE COVERS SHALL BE SUBMITTED TO THE ENGINEER FOR APPROVAL PROVIDING THAT SUCH ALTERNATE DESIGNS MAKE PROVISION FOR EQUIVALENT CAPACITY AND STRENGTH.



ROUND FRAMES AND COVERS SHALL HAVE CONTINUOUSLY MACHINED BEARING SURFACES TO PREVENT ROCKING AND RATTLING.

THE ACTUAL WEIGHT OF COVERS MAY VARY WITHIN 5 PERCENT, PLUS OR MINUS, OF THE APPROXIMATE WEIGHT.



① MANUFACTURER MAY PROVIDE ADDITIONAL SEALS OR GASKETS.

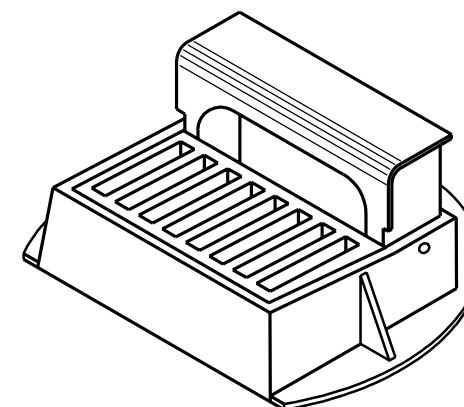



6

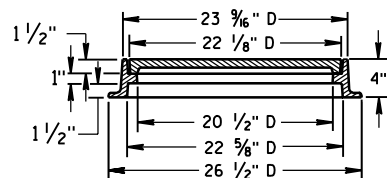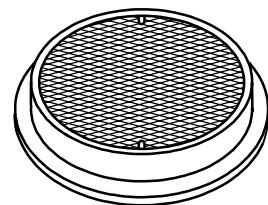


**TYPE "L"**  
(APPROXIMATE WEIGHT 145 LBS.)  
FRAME..... 75#  
LID..... 70#

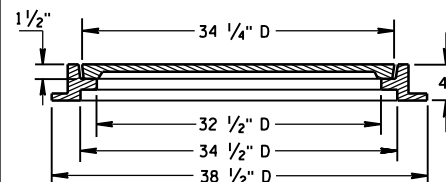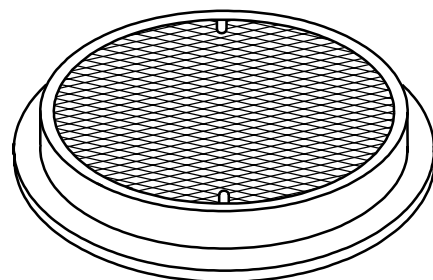


**TYPE "M"**  
(APPROXIMATE WEIGHT 385 LBS.)  
FRAME..... 125#  
LID..... 260#

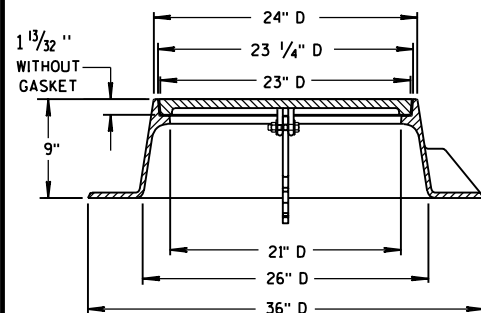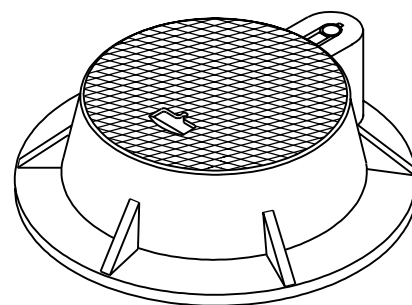

**TYPE "J" HINGED**  
LID WITHOUT "T SEAL" GASKET  
(APPROXIMATE WEIGHT 310 LBS.)  
FRAME..... 190 LBS.  
LID..... 120 LBS.  
(NOTED AS TYPE J-H ON THE DRAINAGE TABLE)


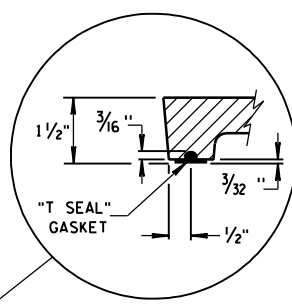


"T SEAL" GASKET DETAIL

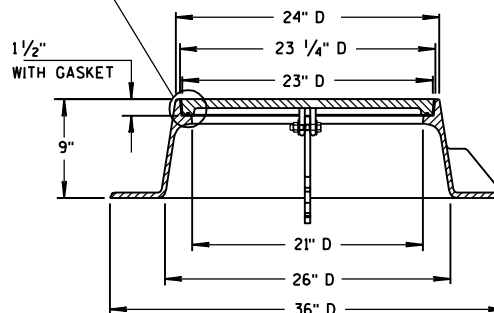

**TYPE "J" HINGED-SPECIAL** ①  
LID WITH "T SEAL" GASKET  
(APPROXIMATE WEIGHT 310 LBS.)  
FRAME..... 190 LBS.  
LID..... 120 LBS.  
(NOTED AS TYPE J-S-H ON THE DRAINAGE TABLE)

6

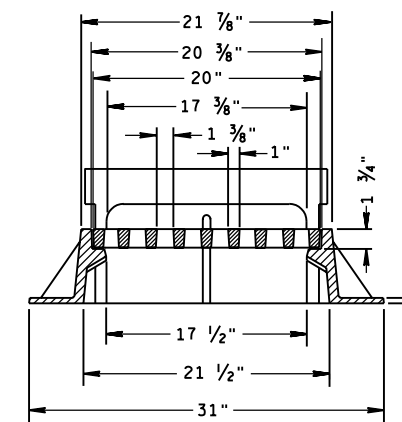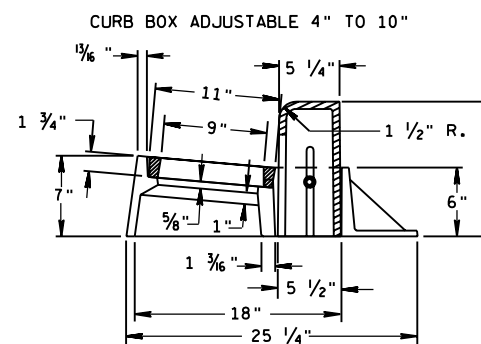

**INLET COVER TYPE "Z"**  
(APPROXIMATE WEIGHT 340 LBS.)  
FRAME..... 198 LBS.  
GRATE..... 50 LBS.  
CURB BOX..... 92 LBS.

**INLET COVER, TYPE Z  
MANHOLE COVERS, TYPE  
K, J, J-S, J-H, J-H-S, L & M**



STATE OF WISCONSIN  
DEPARTMENT OF TRANSPORTATION

APPROVED  
4-29-05  
DATE  
FHWA

*[Signature]*  
CHIEF ROADWAY DEVELOPMENT ENGINEER

S.D.D. 8 A 5-17d

S.D.D. 8 A 5-17d

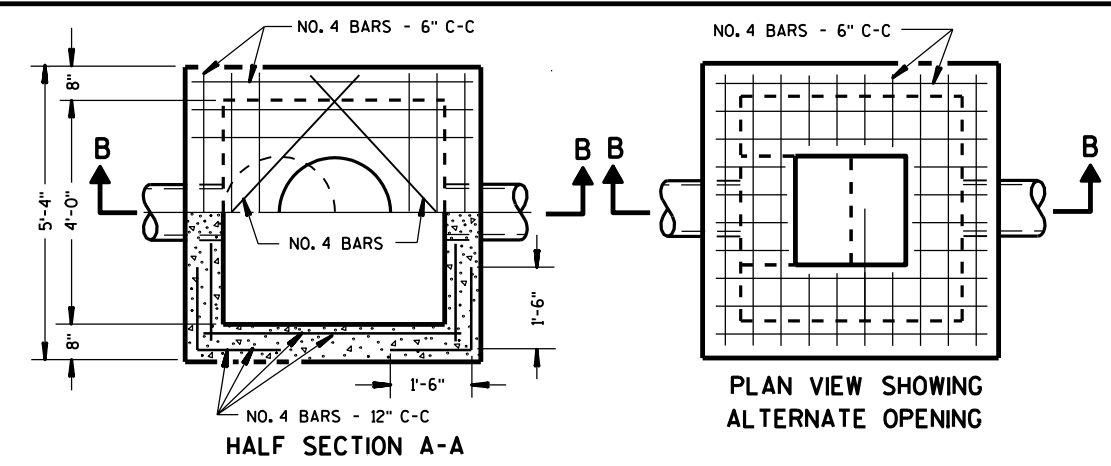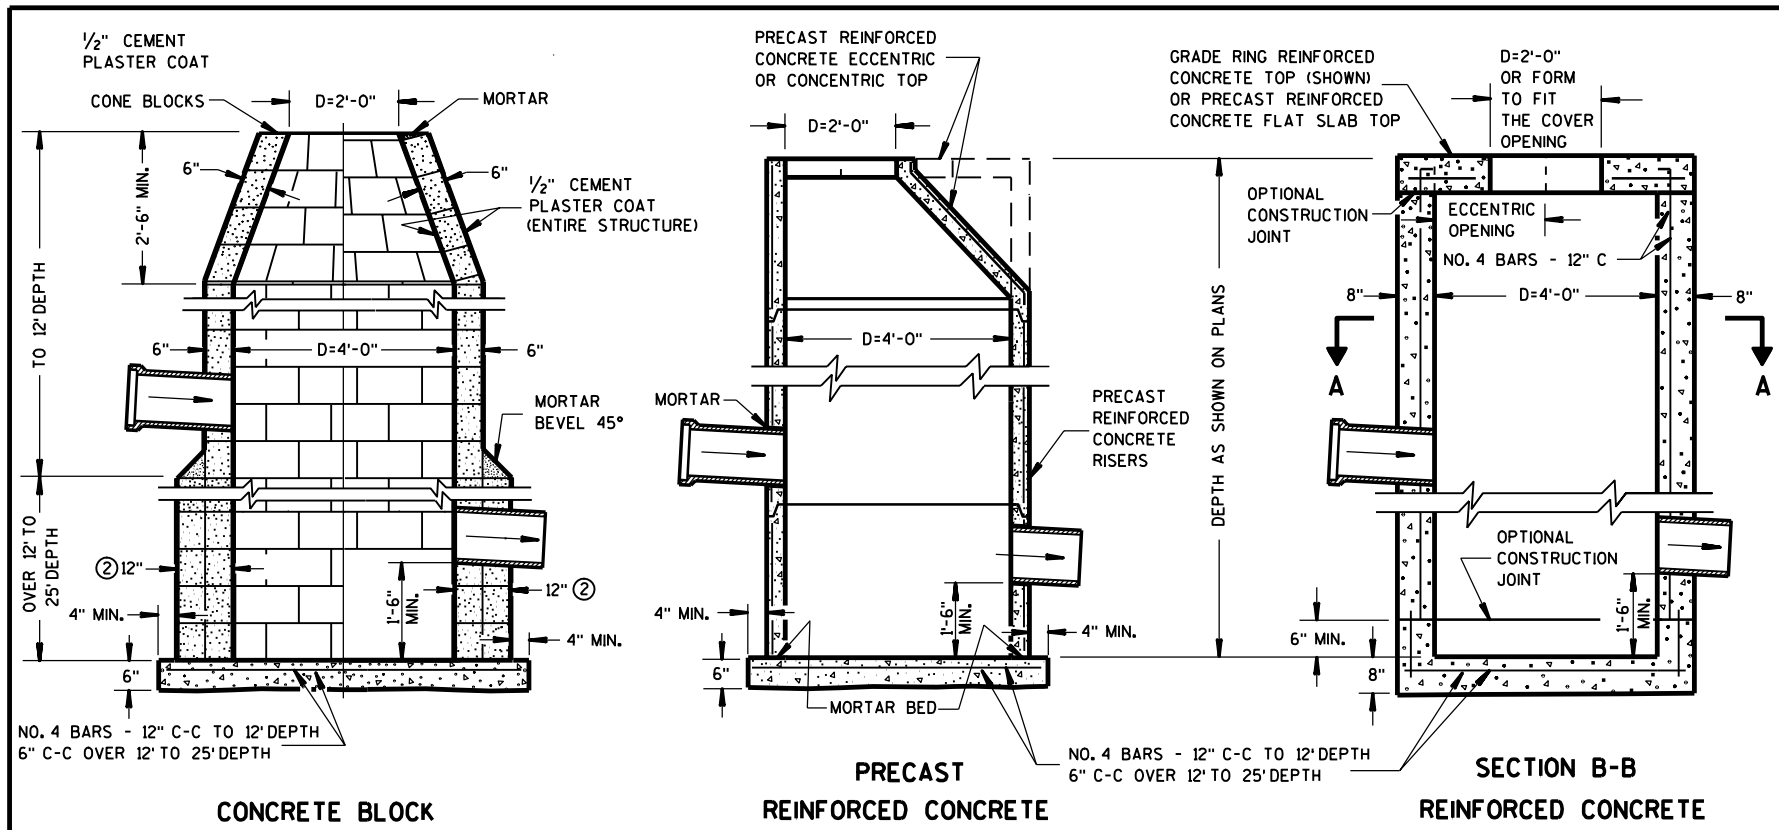

**GENERAL NOTES**

DETAILS OF CONSTRUCTION, MATERIALS AND WORKMANSHIP NOT SHOWN ON THIS DRAWING SHALL CONFORM TO THE PERTINENT REQUIREMENTS OF THE STANDARD SPECIFICATIONS AND THE APPLICABLE SPECIAL PROVISIONS.

DETAILED DRAWINGS FOR PROPOSED ALTERNATE DESIGNS FOR UNDERGROUND DRAINAGE STRUCTURES SHALL BE SUBMITTED TO THE ENGINEER FOR APPROVAL PROVIDING THAT SUCH ALTERNATE DESIGNS MAKE PROVISION FOR EQUIVALENT CAPACITY AND STRENGTH.

ALL DRAINAGE STRUCTURES ARE DESIGNATED ON THE PLANS AS "MANHOLES 1-C", "CATCH BASINS 1-B", "INLETS 3-H", ETC. THE FIRST DIGIT DESIGNATES THE MASONRY PORTION OF THE STRUCTURE, AND THE FOLLOWING LETTER DESIGNATES THE TYPE OF COVER TO BE USED TO COMPRISE THE COMPLETE UNIT.

PRECAST REINFORCED BASES SHALL BE PLACED ON A BED OF MATERIAL AT LEAST 6 INCHES IN DEPTH, WHICH MEETS THE REQUIREMENTS OF GRANULAR BACKFILL. THIS BEDDING SHALL BE COMPACTED AND PROVIDE UNIFORM SUPPORT FOR THE ENTIRE AREA OF THE BASE.

PRECAST REINFORCED CONCRETE CONE TOPS (ECCENTRIC OR CONCENTRIC) OR PRECAST REINFORCED CONCRETE FLAT SLAB TOPS MAY BE USED ON CONCRETE BLOCK STRUCTURES. THE CONE TOPS SHALL BE INSTALLED ON A BED OF MORTAR.

ECCENTRIC CONE TOPS MAY BE USED ON ALL STRUCTURES, AND CONCENTRIC CONE TOPS SHALL BE USED ONLY ON STRUCTURES 5 FEET OR LESS IN DEPTH, UNLESS OTHERWISE DIRECTED BY THE ENGINEER.

STEPS MEETING THE FOLLOWING REQUIREMENTS SHALL BE INSTALLED IN ALL STRUCTURES OVER 5 FEET IN DEPTH: 16 INCH C-C MAXIMUM SPACING; PROJECT A MINIMUM CLEAR DISTANCE OF 4 INCHES FROM THE WALL AT THE POINT OF EMBEDMENT; MINIMUM LENGTH OF 10 INCHES; MINIMUM WALL EMBEDMENT OF 3 INCHES. FERROUS METAL STEPS NOT PAINTED OR TREATED TO RESIST CORROSION SHALL HAVE A MINIMUM CROSS SECTIONAL DIMENSION OF 1 INCH.

STEPS OF APPROVED POLYPROPYLENE PLASTIC COATED REINFORCEMENT BAR ARE ACCEPTABLE.




CERTIFICATION SHALL BE PROVIDED THAT INSTALLED STEPS WHEN TESTED IN ACCORDANCE WITH SECTION 10 OF AASHTO T280 CAN WITHSTAND A VERTICAL LOAD OF 800 LBS. AND A HORIZONTAL LOAD OF 400 LBS.

ALL BAR STEEL REINFORCEMENT SHALL BE EMBEDDED 2 INCHES CLEAR UNLESS OTHERWISE SHOWN OR NOTED.

ALL PRECAST INLET UNITS SHALL CONFORM TO THE PERTINENT REQUIREMENTS OF AASHTO DESIGNATION M199.

THE "PRECAST REINFORCED CONCRETE FLAT SLAB TOP" OPTION IS REQUIRED ON CATCH BASINS, TYPE 1 WHEN 2' X 3' OPENING INLET COVERS ARE REQUIRED.

- ① PRECAST REINFORCED CONCRETE RISERS SHALL BE PLACED WITH THE TONGUE DOWN WHEN GRADE RINGS ARE USED FOR THE SLAB TOP.
- ② 2 COURSES 6" BLOCK.
- ③ WHEN THE CONNECTING PIPES ARE 24" OR LARGER THE PRECAST CATCH BASIN MAY BE INCREASED TO 42" DIA.

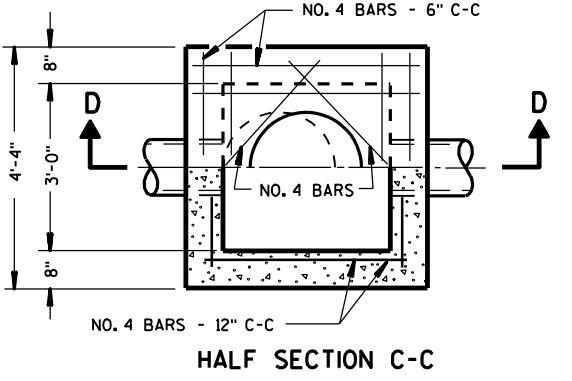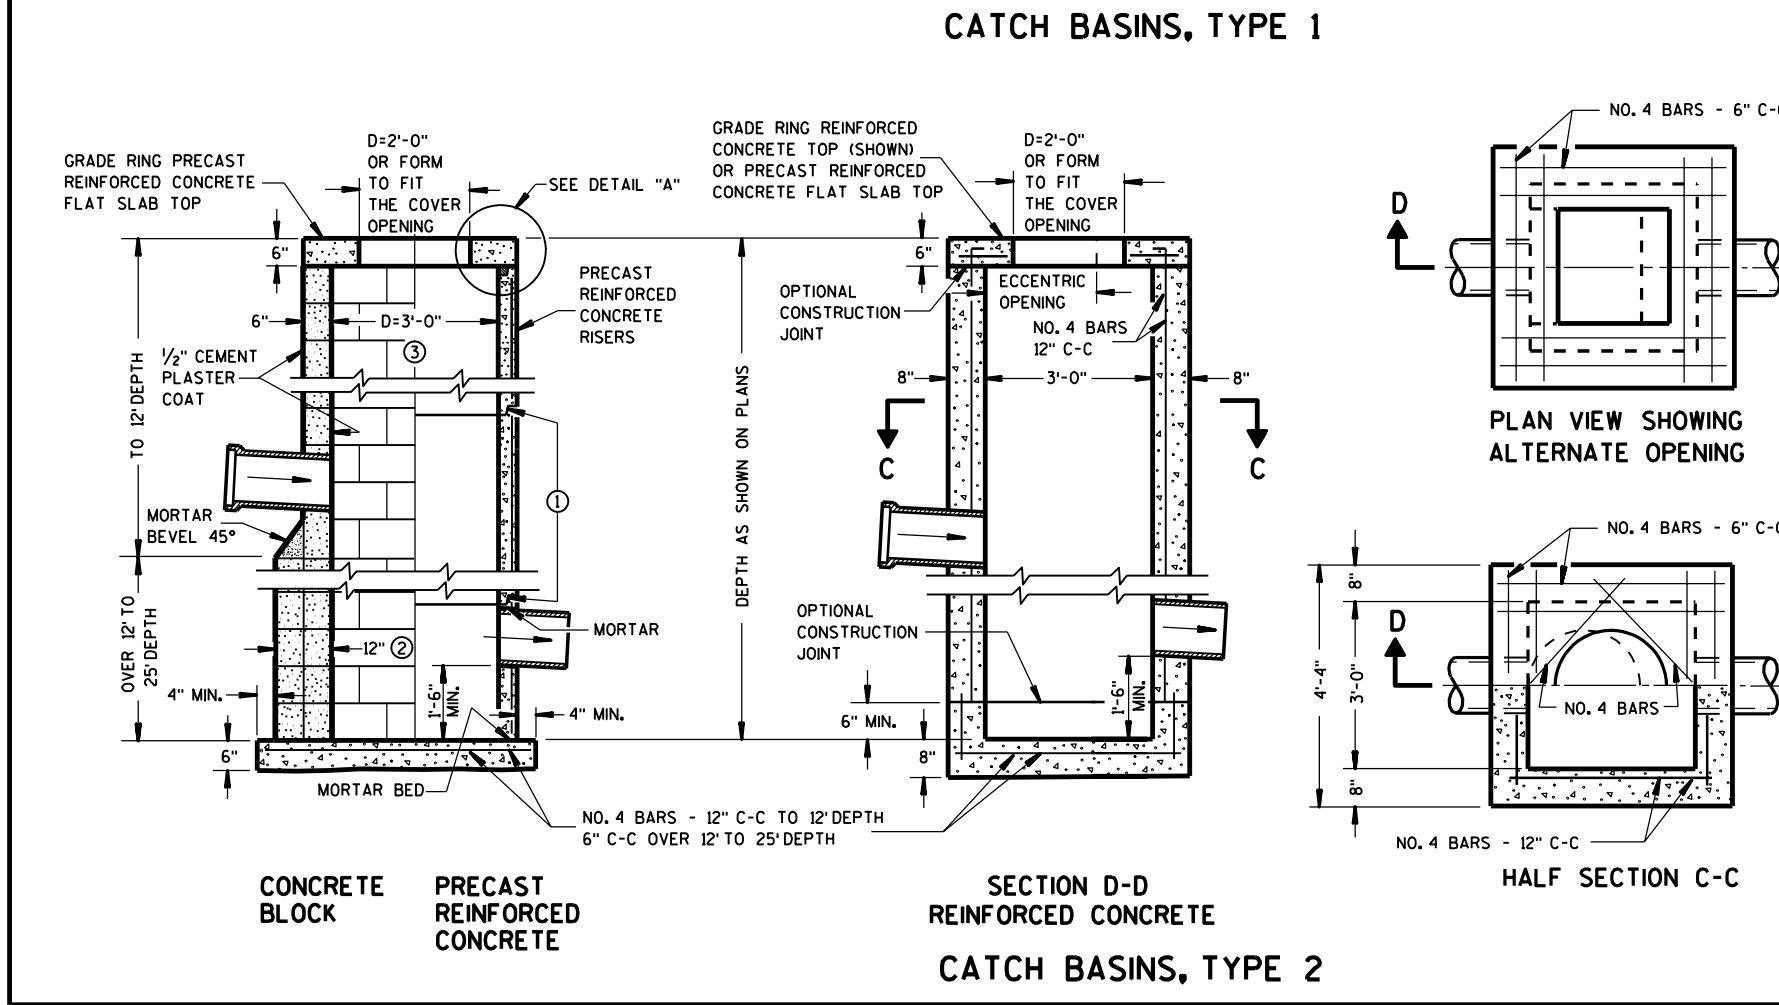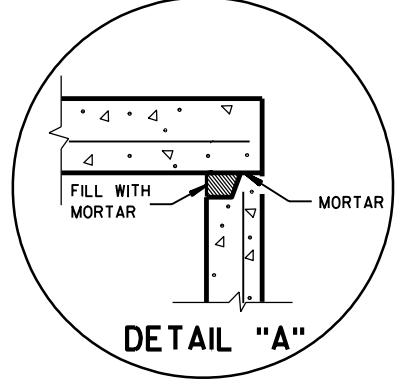





<b>CATCH BASINS TYPE 1 &amp; 2</b>	
STATE OF WISCONSIN DEPARTMENT OF TRANSPORTATION	
APPROVED 6/9/99 DATE	 CHIEF ROADWAY DEVELOPMENT ENGINEER
FHWA	

6

6

S.D.D. 8 A 6-4

S.D.D. 8 A 6-4

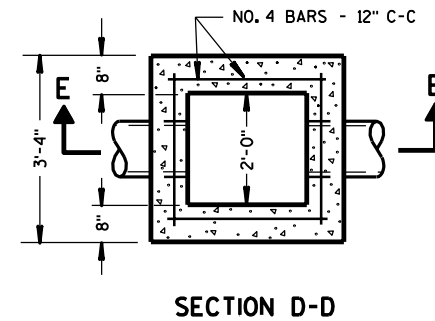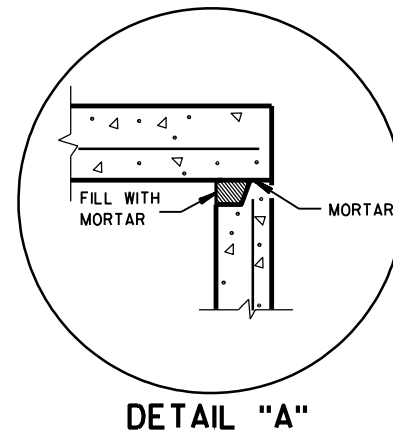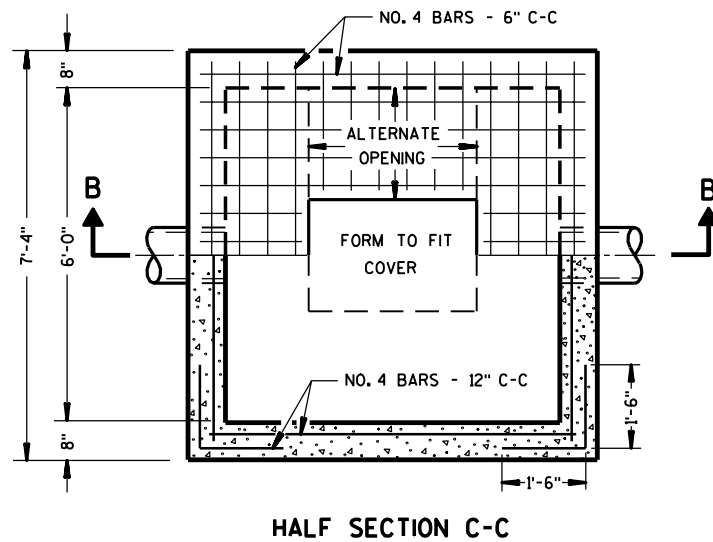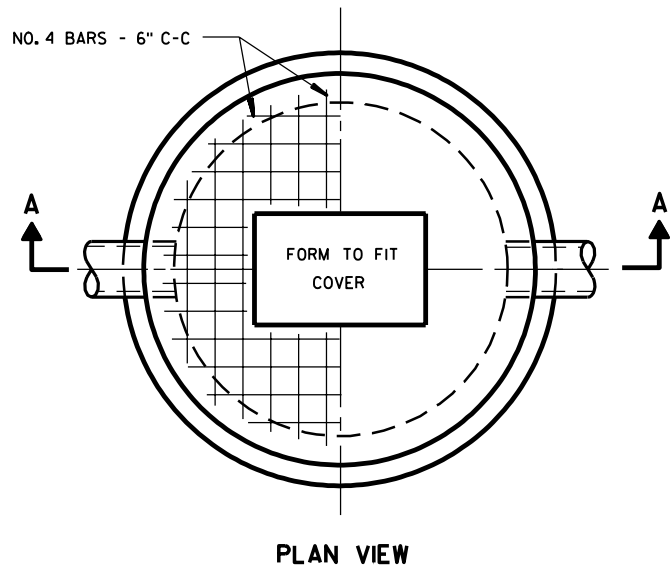

**GENERAL NOTES**

DETAILS OF CONSTRUCTION, MATERIALS AND WORKMANSHIP NOT SHOWN ON THIS DRAWING SHALL CONFORM TO THE PERTINENT REQUIREMENTS OF THE STANDARD SPECIFICATIONS AND THE APPLICABLE SPECIAL PROVISIONS.

DETAILED DRAWINGS FOR PROPOSED ALTERNATE DESIGNS FOR UNDERGROUND DRAINAGE STRUCTURES SHALL BE SUBMITTED TO THE ENGINEER FOR APPROVAL PROVIDING THAT SUCH ALTERNATE DESIGNS MAKE A PROVISION FOR EQUIVALENT CAPACITY AND STRENGTH.

ALL DRAINAGE STRUCTURES ARE DESIGNATED ON THE PLANS AS "MANHOLE 1-C", "CATCH BASINS 1-B", "INLETS 3-H", ETC. THE FIRST DIGIT DESIGNATES THE MASONRY PORTION OF THE STRUCTURE, AND THE FOLLOWING LETTER DESIGNATES THE TYPE OF COVER TO BE USED TO COMPRISE THE COMPLETE UNIT.

PRECAST REINFORCED BASES SHALL BE PLACED ON A BED OF MATERIAL AT LEAST 6 INCHES IN DEPTH, WHICH MEETS THE REQUIREMENTS FOR GRANULAR BACKFILL. THIS BEDDING SHALL BE COMPACTED AND PROVIDE UNIFORM SUPPORT FOR THE ENTIRE AREA OF THE BASE.

STEPS MEETING THE FOLLOWING REQUIREMENTS SHALL BE INSTALLED IN ALL STRUCTURES OVER 5 FEET IN DEPTH: 16 INCH C-C MAXIMUM SPACING; PROJECT A MINIMUM CLEAR DISTANCE OF 4 INCHES FROM THE WALL AT THE POINT OF EMBEDMENT; MINIMUM LENGTH OF 10 INCHES; MINIMUM WALL EMBEDMENT OF 3 INCHES; AND BE CAPABLE OF SUPPORTING A CONCENTRATED LOAD OF 300 LBS. FERROUS METAL STEPS NOT PAINTED OR TREATED TO RESIST CORROSION SHALL HAVE A CROSS SECTIONAL DIMENSION OF 1 INCH.


SOLID ALUMINUM STEPS SHALL HAVE A MINIMUM CROSS SECTIONAL DIMENSION OF 0.75 INCH. ALUMINUM SURFACES TO BE EMBEDDED IN CONCRETE SHALL BE GIVEN ONE COAT OF SUITABLE QUALITY PAINT, SUCH AS ZINC CHROMATE PRIMER CONFORMING TO FEDERAL SPECIFICATION TT-P-645 OR EQUIVALENT. STEPS OF APPROVED POLYPROPYLENE PLASTIC COATED REINFORCEMENT BAR WILL BE ACCEPTABLE.

ALL BAR STEEL REINFORCEMENT SHALL BE EMBEDDED 2 INCHES CLEAR UNLESS OTHERWISE SHOWN OR NOTED.


PRECAST REINFORCED CONCRETE RISERS SHALL BE PLACED WITH TONGUE DOWN.

ALL PRECAST INLET UNITS SHALL CONFORM TO THE PERTINENT REQUIREMENTS OF AASHTO DESIGNATION M 199.

6

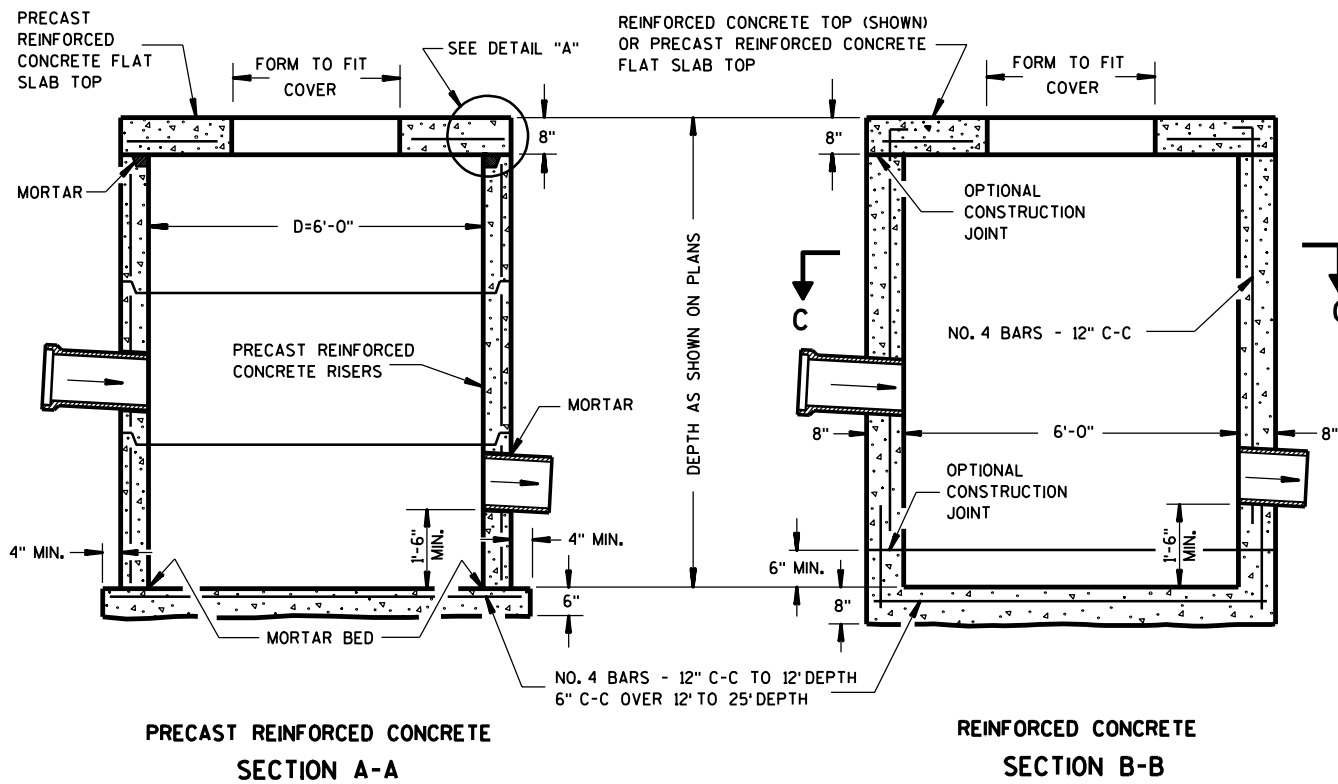

**CATCH BASINS TYPE 5**

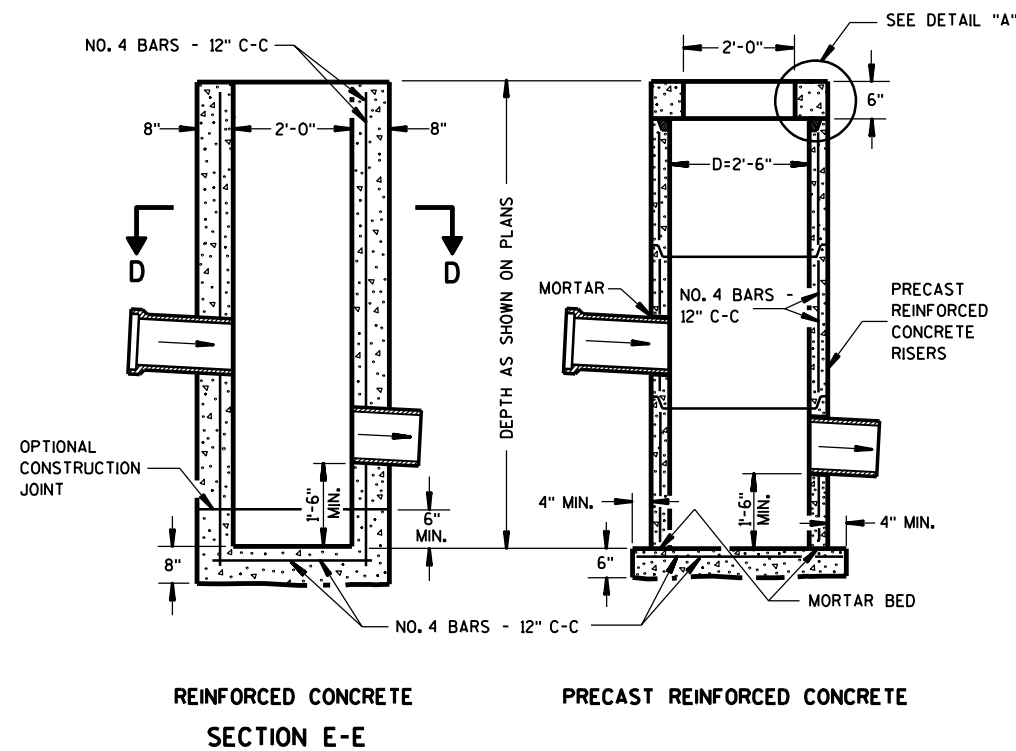

**CATCH BASINS TYPE 3**

6

**CATCH BASINS TYPE 3 & 5**


STATE OF WISCONSIN  
DEPARTMENT OF TRANSPORTATION

APPROVED  
4/13/82  
DATE


*D. J. Strand*  
CHIEF DESIGN ENGINEER

FHWA




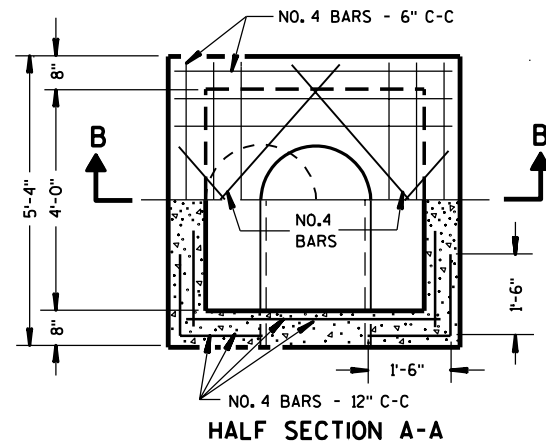


HALF SECTION A-A

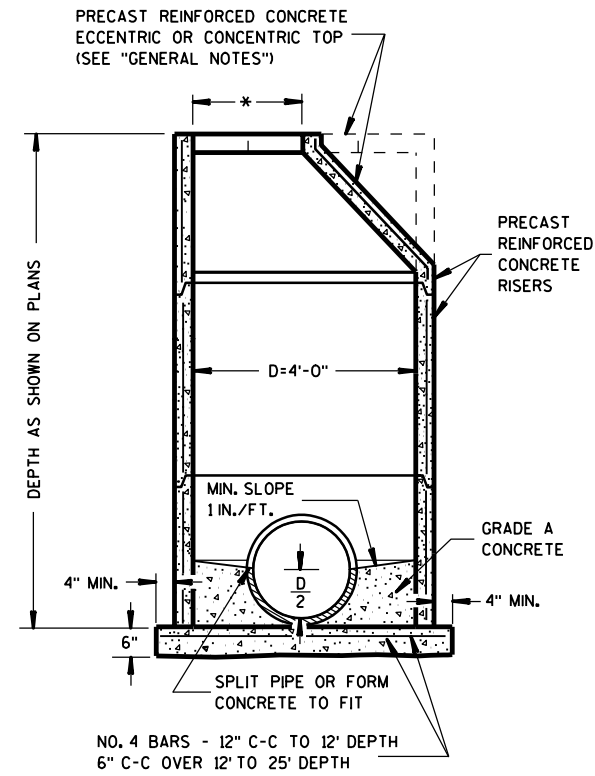

PRECAST REINFORCED CONCRETE

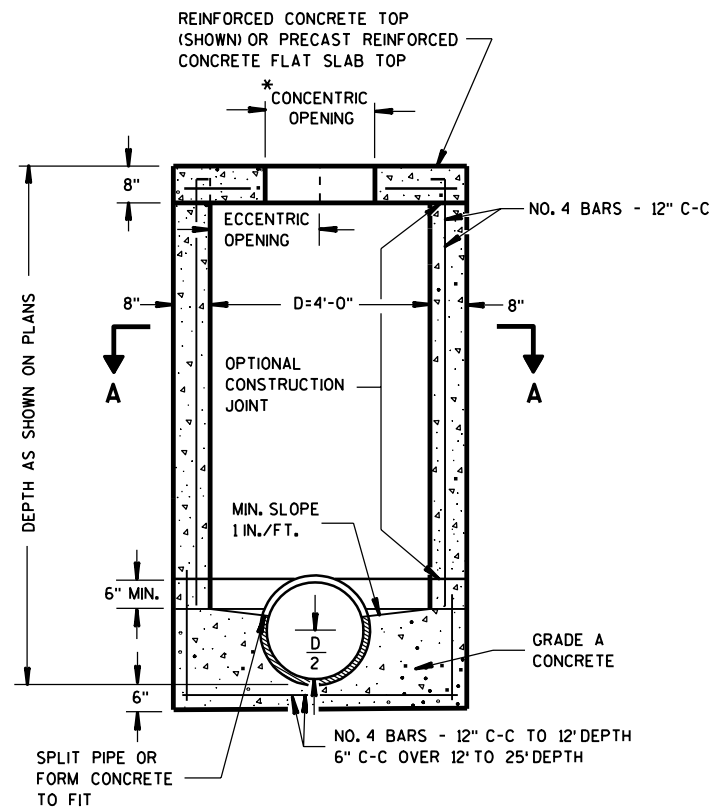

SECTION B-B  
REINFORCED CONCRETE

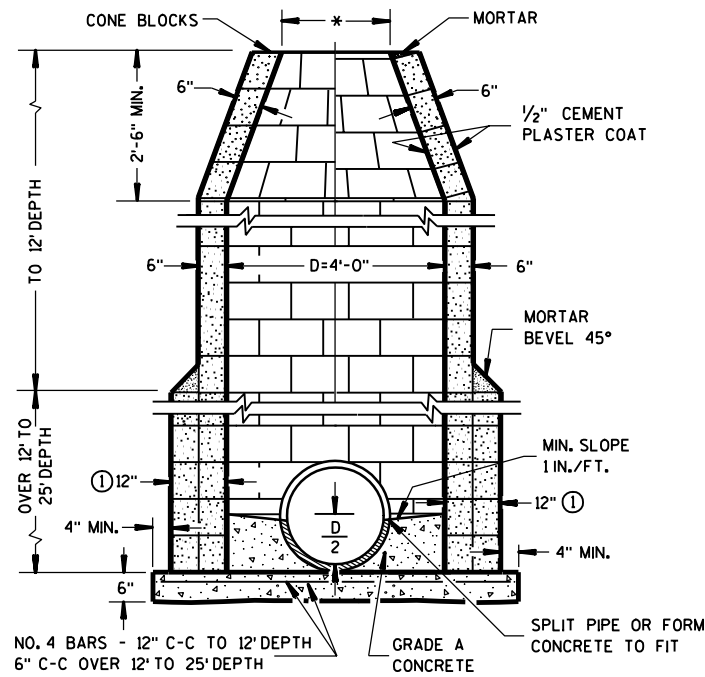

CONCRETE BLOCK

**GENERAL NOTES**

DETAILS OF CONSTRUCTION, MATERIALS AND WORKMANSHIP NOT SHOWN ON THIS DRAWING SHALL CONFORM TO THE PERTINENT REQUIREMENTS OF THE STANDARD SPECIFICATIONS AND THE APPLICABLE SPECIAL PROVISIONS.

DETAILED DRAWINGS FOR PROPOSED ALTERNATE DESIGNS FOR UNDERGROUND DRAINAGE STRUCTURES SHALL BE SUBMITTED TO THE ENGINEER FOR APPROVAL PROVIDING THAT SUCH ALTERNATE DESIGNS MAKE PROVISION FOR EQUIVALENT CAPACITY AND STRENGTH.

ALL DRAINAGE STRUCTURES ARE DESIGNATED ON THE PLANS AS "MANHOLES 1-C", "CATCH BASINS 1-B", "INLETS 3-H", ETC. THE FIRST DIGIT DESIGNATES THE MASONRY PORTION OF THE STRUCTURE, AND THE FOLLOWING LETTER DESIGNATES THE TYPE OF COVER TO BE USED TO COMPRISE THE COMPLETE UNIT.

PRECAST REINFORCED BASES SHALL BE PLACED ON A BED OF MATERIAL AT LEAST 6 INCHES IN DEPTH, WHICH MEETS THE REQUIREMENTS OF GRANULAR BACKFILL. THIS BEDDING SHALL BE COMPACTED AND PROVIDE UNIFORM SUPPORT FOR THE ENTIRE AREA OF THE BASE.

PRECAST REINFORCED CONE TOPS (ECCENTRIC OR CONCENTRIC) MAY BE USED ON CONCRETE BLOCK STRUCTURES. THE CONE TOPS SHALL BE INSTALLED ON A BED OF MORTAR.

ECCENTRIC CONE TOPS MAY BE USED ON ALL STRUCTURES, AND CONCENTRIC CONE TOPS SHALL BE USED ONLY ON STRUCTURES 5 FEET OR LESS IN DEPTH, UNLESS OTHERWISE DIRECTED BY THE ENGINEER.

STEPS CONFORMING TO AASHTO M 199 SHALL BE INSTALLED IN ALL STRUCTURES OVER 5 FEET IN DEPTH.

SOLID ALUMINUM STEPS SHALL HAVE A MINIMUM CROSS SECTIONAL DIMENSION OF 0.75 INCH. ALUMINUM SURFACES TO BE EMBEDDED IN CONCRETE SHALL BE GIVEN ONE COAT OF SUITABLE QUALITY PAINT, SUCH AS ZINC CHROMATE PRIMER CONFORMING TO FEDERAL SPECIFICATION TT-P-645 OR EQUIVALENT.

ALL BAR STEEL REINFORCEMENT SHALL BE EMBEDDED 2 INCHES CLEAR UNLESS OTHERWISE SHOWN OR NOTED.

PRECAST REINFORCED CONCRETE RISERS MAY BE PLACED WITH TONGUE UP OR DOWN.


ALL PRECAST INLET UNITS AND MANHOLES SHALL CONFORM TO THE PERTINENT REQUIREMENTS OF AASHTO DESIGNATION M 199.

\* USE 2'-0" DIAMETER OPENING WITH TYPE "C", "L" AND "J" COVERS, OR 3'-0" DIAMETER WITH TYPE "K" AND "M" COVERS.


① 2 COURSES 6" BLOCK.

**MANHOLES TYPE 1**


<b>MANHOLES TYPE 1</b>	
STATE OF WISCONSIN DEPARTMENT OF TRANSPORTATION	
APPROVED 9/9/05 DATE	/S/ Jerry H. Zogg ROADWAY STANDARDS DEVELOPMENT ENGINEER
FHWA	

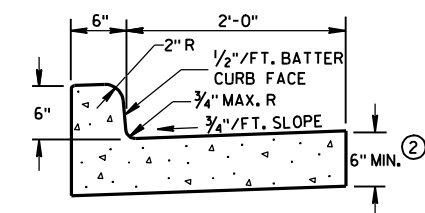


TYPES A & D ①

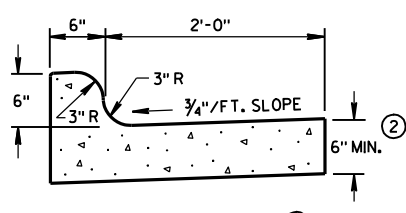


TYPES K & L ①

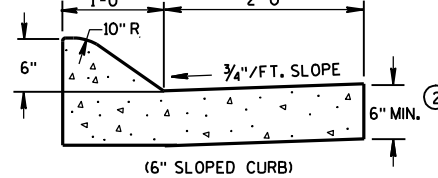


(6" SLOPED CURB)

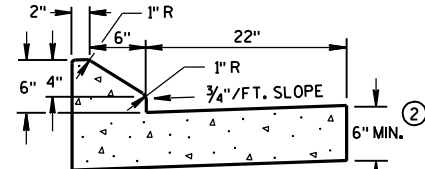


6" SLOPED CURB TYPES G & J ①

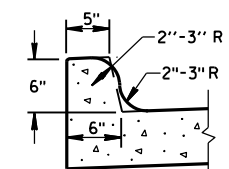


OPTIONAL CURB SHAPE FOR TYPES K & L ①

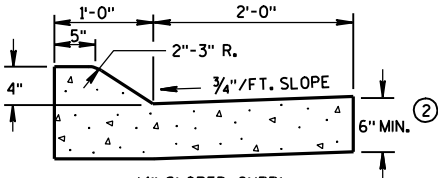

(4" SLOPED CURB)

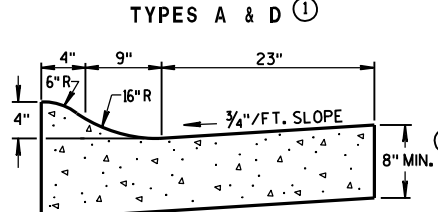


4" SLOPED CURB TYPES R & T ① ④

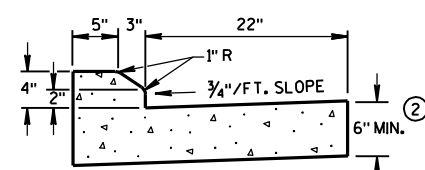


4" SLOPED CURB TYPES G & J ①


CONCRETE CURB & GUTTER 30"

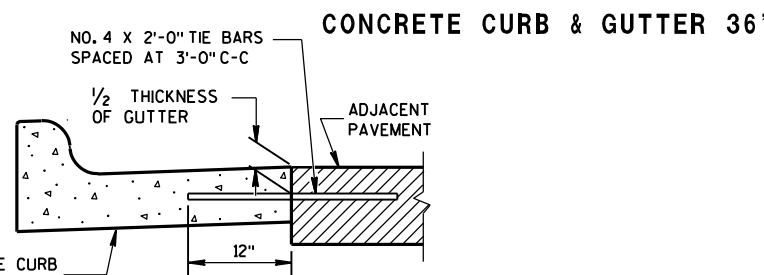


TYPICAL TIE BAR LOCATION ①

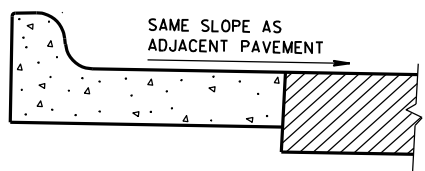

REVERSE SLOPE GUTTER (TYPICAL FOR ALL CURB & GUTTER TYPES) ⑤

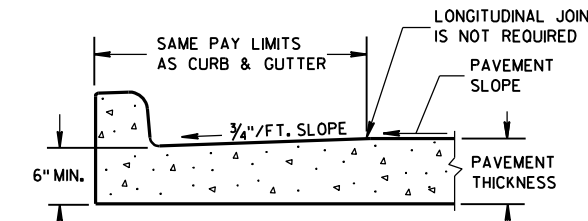


PARTIAL SECTION OF PAVEMENT WITH INTEGRAL CURB & GUTTER

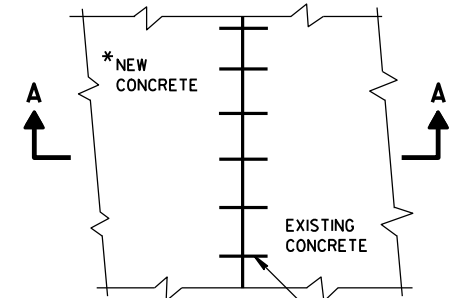


PLAN VIEW

\*NEW CURB & GUTTER, SURFACE DRAINS, CONCRETE PAVEMENT OR OTHER NEW CONCRETE.


NO. 6 TIE BARS SPACED 2'-6" C-C, INSTALLED PERPENDICULAR TO THE LONGITUDINAL JOINT.

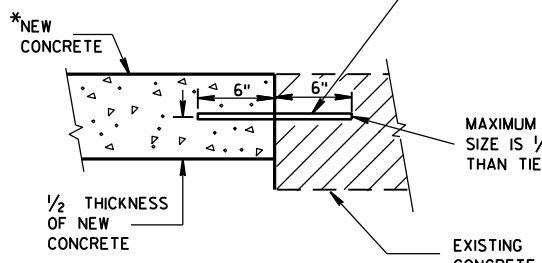

SECTION A-A TIE BARS DRILLED INTO EXISTING PAVEMENT

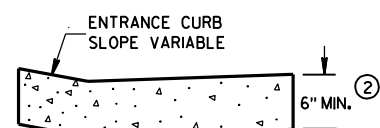


DRIVEWAY ENTRANCE CURB (WHEN DIRECTED BY THE ENGINEER)

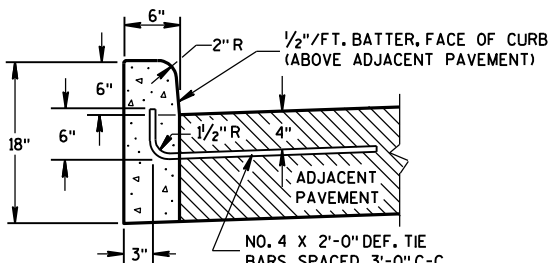


TYPES A & D ①

CONCRETE CURB

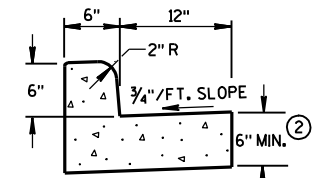

TYPES A & D CONCRETE CURB & GUTTER 18" ①

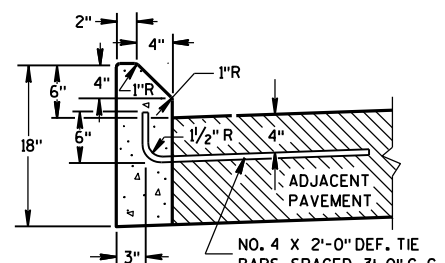

TYPES G & J ①

**GENERAL NOTES**


DETAILS OF CONSTRUCTION, MATERIALS AND WORKMANSHIP NOT SHOWN ON THIS DRAWING SHALL CONFORM TO THE PERTINENT REQUIREMENTS OF THE CONTRACT. PAVEMENT TIES AND TIE BARS SHALL BE EPOXY COATED IN CONFORMANCE WITH SUBSECTION 505.2.6.2 OF THE STANDARD SPECIFICATIONS.

INTEGRAL CURB & GUTTER SHALL CONFORM TO THE DETAILS SHOWN FOR CONCRETE CURB & GUTTER INCLUDING THE TRANSVERSE GUTTER SLOPE. A LONGITUDINAL CONSTRUCTION JOINT IS NOT REQUIRED WITH INTEGRAL CURB AND GUTTER.

WHERE THE TRANSVERSE JOINTS IN THE PAVEMENT ARE REQUIRED TO BE SEALED, THE JOINTS IN THE INTEGRAL CURB AND GUTTER SHALL BE SEALED TO THE FACE OF CURB WITH THE SAME TYPE OF SEALANT. THE COST OF FURNISHING AND INSTALLING THIS SEALANT SHALL BE INCIDENTAL TO THE ITEM CONCRETE CURB AND GUTTER.


UNLESS OTHERWISE SHOWN ON THE TYPICAL CROSS SECTIONS, THE BASE AGGREGATE AND COMMON EXCAVATION LIMITS ARE 2'-0" BEHIND THE BACK OF CURBS.

- ① TIE BARS ARE REQUIRED FOR CURB AND GUTTER TYPES A, G, K AND R.
- ② THE BOTTOM OF CURB AND GUTTER MAY BE CONSTRUCTED EITHER LEVEL OR PARALLEL TO THE SLOPE OF THE SUBGRADE OR BASE AGGREGATE PROVIDED A 6" MINIMUM GUTTER THICKNESS IS MAINTAINED.
- ③ THE BOTTOM OF CURB AND GUTTER MAY BE CONSTRUCTED EITHER LEVEL OR PARALLEL TO THE SLOPE OF THE SUBGRADE OR BASE AGGREGATE PROVIDED A 8" MINIMUM GUTTER THICKNESS IS MAINTAINED.
- ④ THE FACE OF CURB IS 6" FROM THE BACK OF CURB.
- ⑤ WHEN REVERSE SLOPE GUTTER IS REQUIRED, THE LOCATION(S) WILL BE SHOWN ELSEWHERE IN THE PLAN.

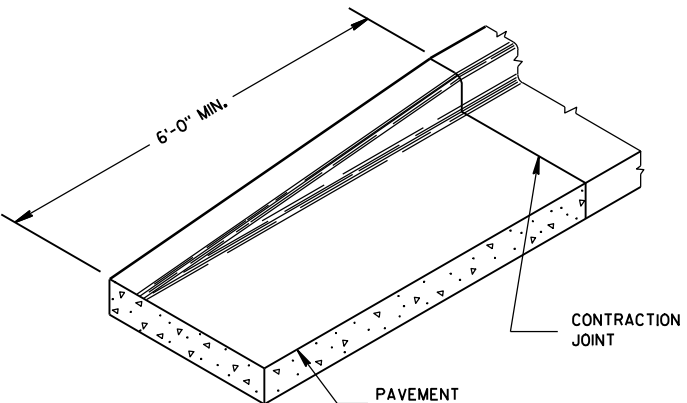


END SECTION CURB & GUTTER

<b>CONCRETE CURB, CONCRETE CURB &amp; GUTTER AND TIES</b>	
STATE OF WISCONSIN DEPARTMENT OF TRANSPORTATION	
APPROVED 9/4/08 DATE	/S/ Jerry H. Zogg ROADWAY STANDARDS DEVELOPMENT ENGINEER
FHWA	

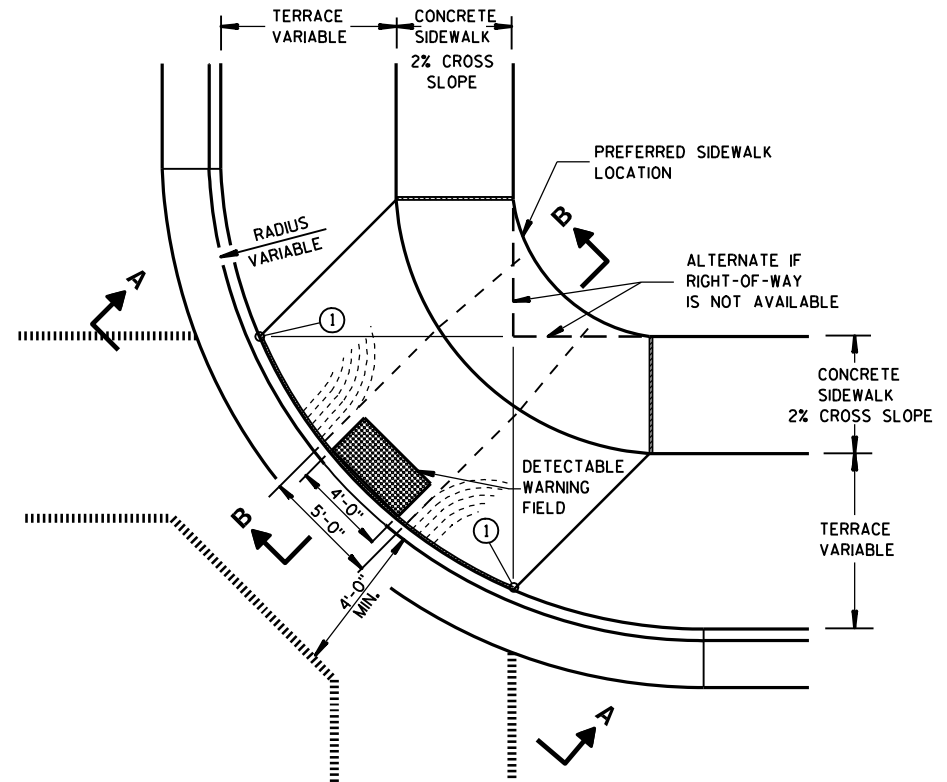

**PLAN VIEW  
TYPE 1 RAMP**  
(CENTER OF CORNER RADIUS)

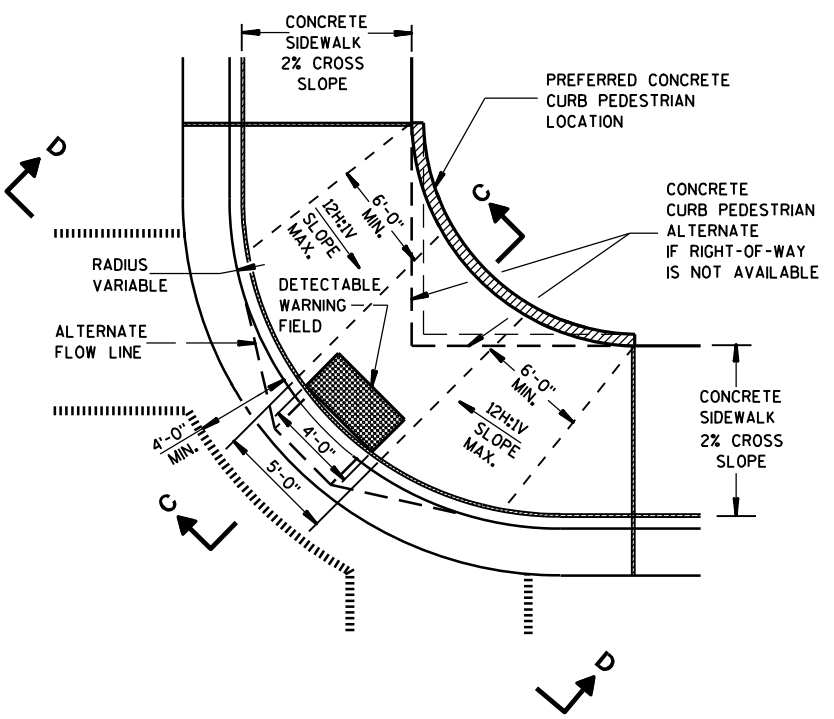


**PLAN VIEW  
TYPE 1-A RAMP**  
(NO TERRACE)

**GENERAL NOTES**


- DETAILS OF CONSTRUCTION, MATERIALS AND WORKMANSHIP NOT SHOWN ON THIS DRAWING SHALL CONFORM TO THE PERTINENT REQUIREMENTS OF THE STANDARD SPECIFICATIONS AND THE APPLICABLE SPECIAL PROVISIONS.
- RAMPS SHALL BE BUILT AT 12H:1V OR FLATTER. WHEN NECESSARY, THE SIDEWALK ELEVATION MAY BE LOWERED TO MEET THE HIGH POINT ON THE RAMP.
- TYPE 1 RAMPS SHALL HAVE A NORMAL SIDEWALK APRON AND CURB ON BOTH SIDES OF RAMP.
- DETECTABLE WARNING FIELD SHALL BE MEASURED AND PAID BY THE SQUARE FOOT AS "CURB RAMP DETECTABLE WARNING FIELD". THE CONCRETE PEDESTRIAN CURB, IF NEEDED, SHALL BE MEASURED AND PAID BY THE LINEAL FOOT AS "CONCRETE CURB PEDESTRIAN". CONCRETE SIDEWALK IN THE CURB RAMP AREA SHALL BE MEASURED AND PAID BY THE SQUARE FOOT AS CONCRETE SIDEWALK, INCLUDING THE AREA UNDER THE DETECTABLE WARNING FIELD.
- SELECT CURB RAMP DETECTABLE WARNING FIELD MATERIALS AND DEVICES FROM THE DEPARTMENT'S APPROVED MATERIALS LIST. THE COLOR OF THE DETECTABLE WARNING FIELD IS SPECIFIED ELSEWHERE AND IS INCIDENTAL TO THE BID ITEM OF "CURB RAMP DETECTABLE WARNING FIELD".
- SURFACE TEXTURE OF THE RAMP SHALL BE OBTAINED BY COARSE BROOMING TRANSVERSE TO THE SLOPE OF THE RAMP.
- THIS POINT IS AN EXTENSION OF OUTSIDE EDGE OF APPROACHING SIDEWALK WHERE IT MEETS THE BACK OF CONCRETE CURB.
  - GRADE CHANGE BETWEEN GUTTER FLAG SLOPE AND THE CURB RAMP SLOPE SHALL NOT EXCEED 11%. PROVIDE DRAINAGE AWAY FROM CURB RAMP AT GUTTER FLAG INTERFACE.

**LEGEND**


- 1/2" EXPANSION JOINT-SIDEWALK
- CONTRACTION JOINT FIELD LOCATED
- PAVEMENT MARKING CROSSWALK (WHITE)
- ALTERNATIVE LAYOUT

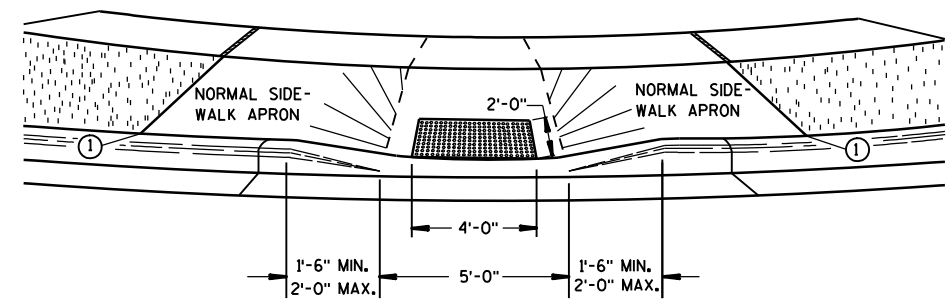


**VIEW A-A**

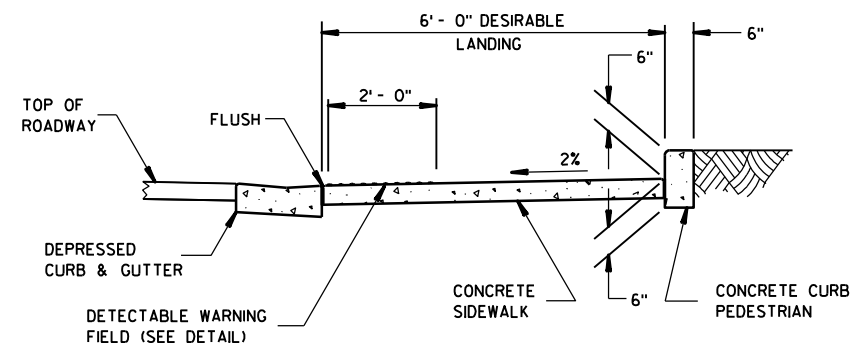

**SECTION C-C**

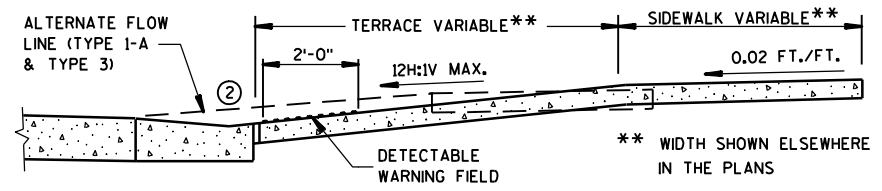


**SECTION B-B**

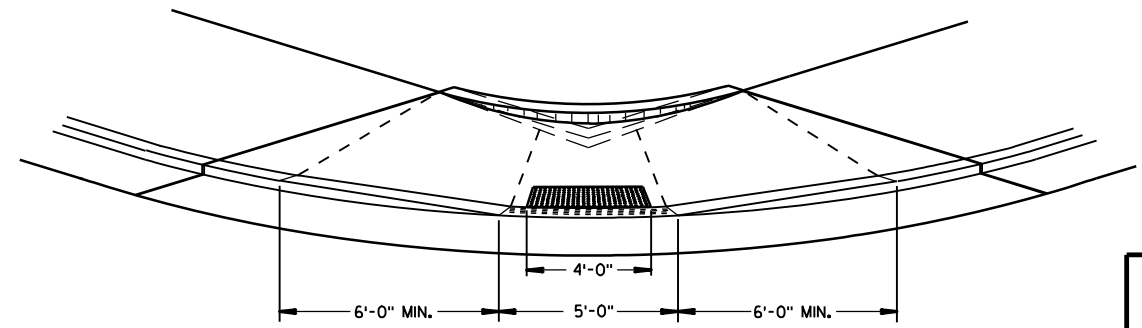


**VIEW D-D**

**CURB RAMPS  
TYPES 1 AND 1-A**


STATE OF WISCONSIN  
DEPARTMENT OF TRANSPORTATION

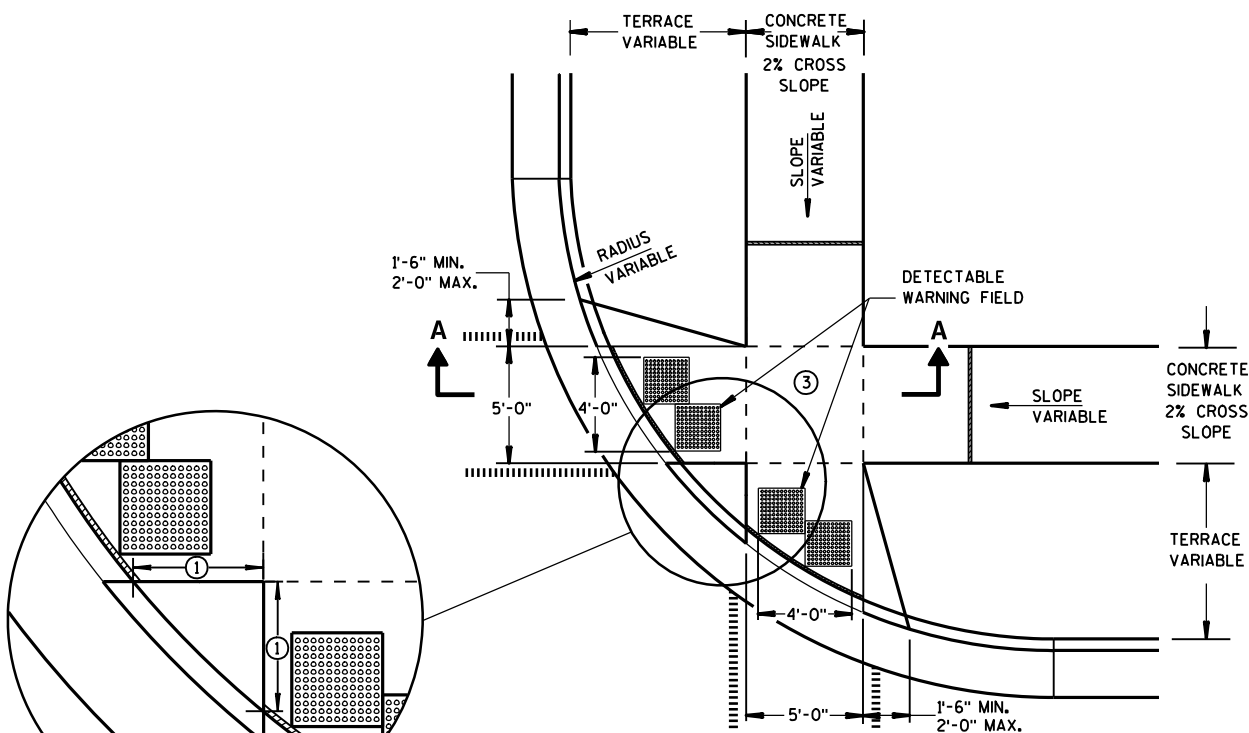

**PLAN VIEW  
TYPE 2 RAMP**  
(ON LINE WITH SIDEWALK)

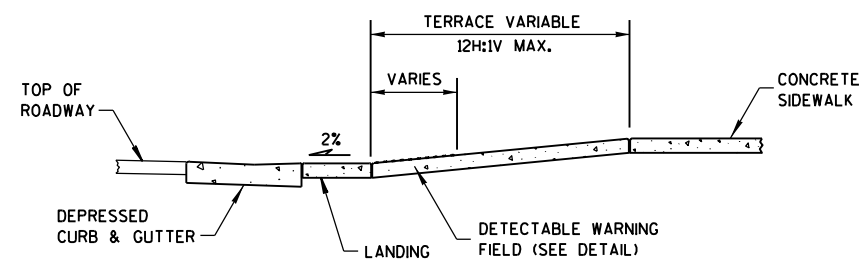

**SECTION A-A**

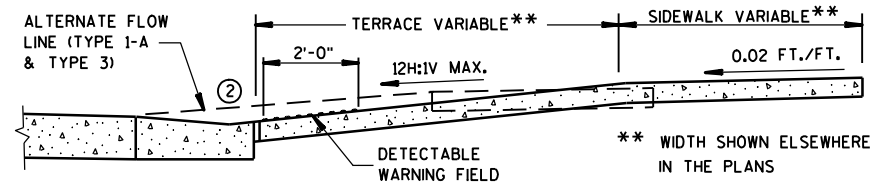

**SECTION B-B**


**GENERAL NOTES**

USE THE TYPE 3 RAMP ONLY WHEN A TYPE 1 OR TYPE 2 CANNOT BE ACHIEVED BECAUSE OF FIELD CONDITIONS.

- ① WHEN THIS DISTANCE IS LESS THAN 6'-0" IT MAY BE DIFFICULT TO ACHIEVE A 12H:1V SLOPE, OR FLATTER, ON THE RAMP, REDUCE CURB HEIGHT IN TRIANGLE AREA TO ACHIEVE 12H:1V SLOPE, OR FLATTER, ON RAMP. 2" MINIMUM CURB HEIGHT.
- ② GRADE CHANGE BETWEEN GUTTER FLAG SLOPE AND THE CURB RAMP SLOPE SHALL NOT EXCEED 1%. PROVIDE DRAINAGE AWAY FROM CURB RAMP AT GUTTER FLAG INTERFACE.
- ③ PROVIDE LANDING AT TOP OF RAMP WITH NO MORE THAN 2% SLOPE IN ANY DIRECTION.

**LEGEND**


- 1/2" EXPANSION JOINT-SIDEWALK
- CONTRACTION JOINT FIELD LOCATED
- PAVEMENT MARKING CROSSWALK (WHITE)
- ALTERNATIVE LAYOUT

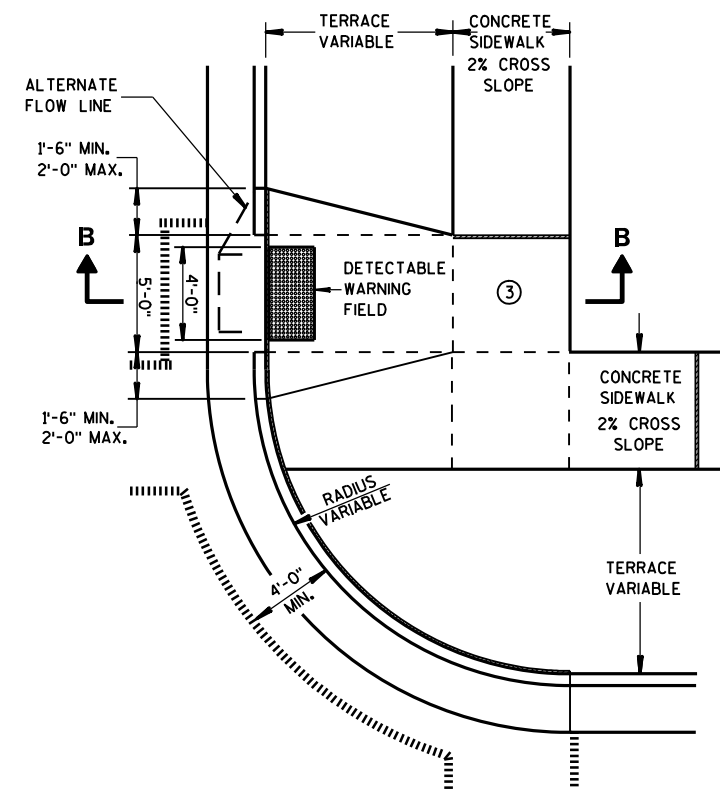

**PLAN VIEW  
TYPE 3 RAMP**  
(OUTSIDE OF CROSSWALK AREA)

**CURB RAMPS  
TYPES 2 AND 3**


STATE OF WISCONSIN  
DEPARTMENT OF TRANSPORTATION

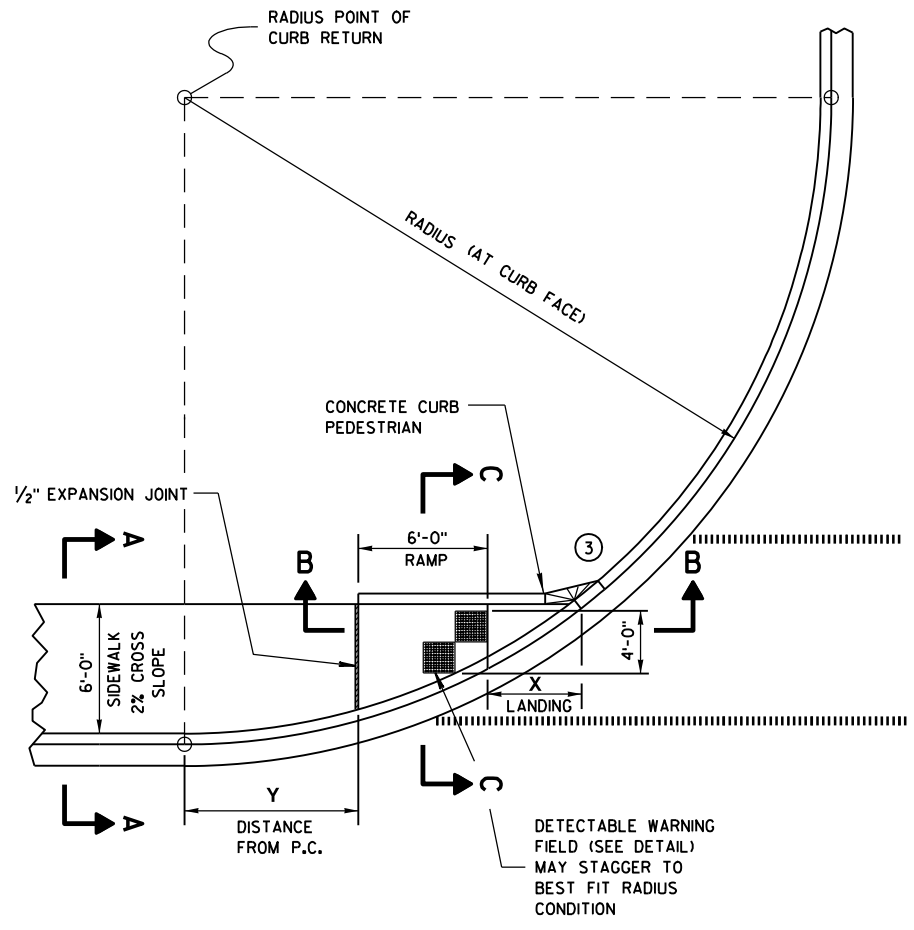


**CURB RAMP TYPE 4A  
PLAN VIEW**

RADIUS (AT CURB FACE)	X	Y
20 FEET	6'-1 <sup>3</sup> / <sub>4</sub> "	2'-7 <sup>1</sup> / <sub>4</sub> "
30 FEET	7'-11 <sup>3</sup> / <sub>4</sub> "	4'-8 <sup>1</sup> / <sub>4</sub> "
40 FEET	9'-5 <sup>1</sup> / <sub>4</sub> "	6'-5"
50 FEET	10'-8 <sup>3</sup> / <sub>4</sub> "	7'-11 <sup>1</sup> / <sub>4</sub> "
60 FEET	11'-10 <sup>1</sup> / <sub>4</sub> "	9'-3 <sup>1</sup> / <sub>2</sub> "


INTERMEDIATE RADII CAN BE INTERPOLATED

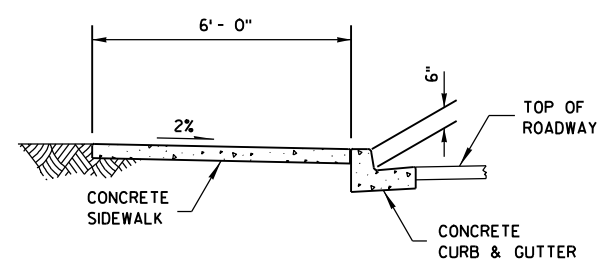


**SECTION A-A**

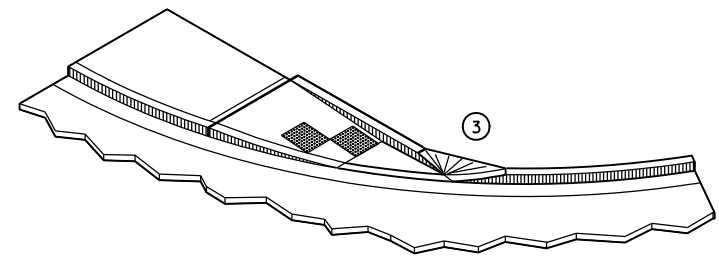

**ISOMETRIC VIEW**

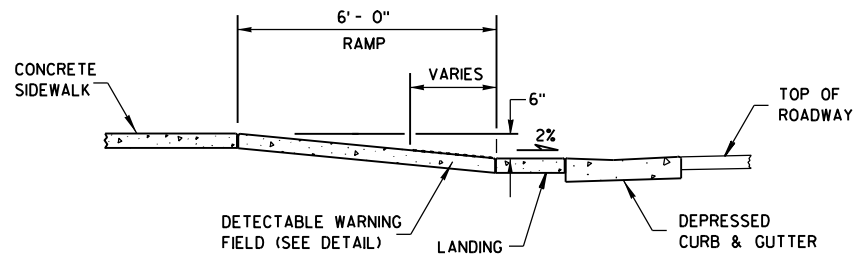

**SECTION B-B**

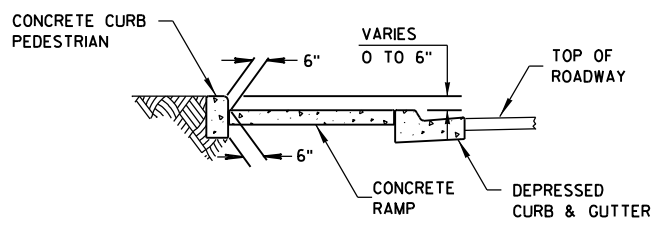

**SECTION C-C**

**GENERAL NOTES**

AVOID PLACING DRAINAGE STRUCTURES, JUNCTION BOXES OR OTHER OBSTRUCTIONS IN FRONT OF RAMP ACCESS AREAS.

RAMP SLOPES SHALL NOT BE STEEPER THAN 12:1.


SIDEWALK CROSS SLOPE SHALL NOT EXCEED 2%.

- ③ INSTALL TRANSITION NOSE. (INCIDENTAL TO OTHER PAY ITEMS.) DO NOT MARK TRANSITION NOSE.


**LEGEND**

- 1/2" EXPANSION JOINT-SIDEWALK
- - - CONTRACTION JOINT FIELD LOCATED
- ||||| PAVEMENT MARKING CROSSWALK (WHITE)


<p><b>CURB RAMPS TYPE 4A</b></p>
<p>STATE OF WISCONSIN DEPARTMENT OF TRANSPORTATION</p>

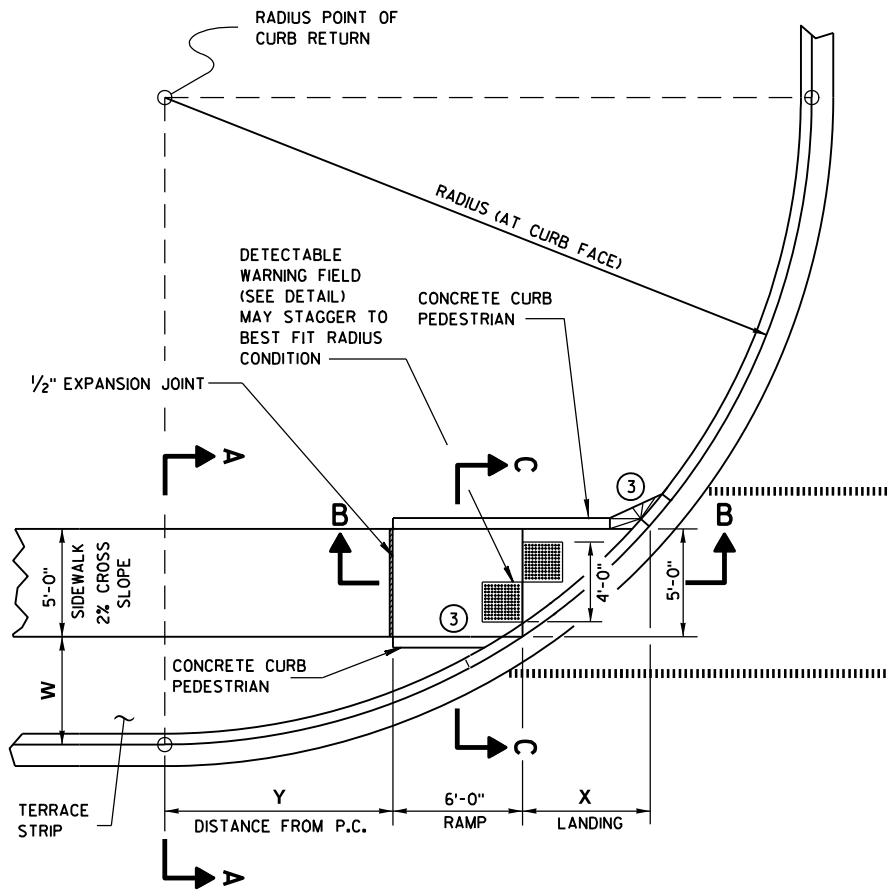


**CURB RAMP TYPE 4B  
PLAN VIEW**

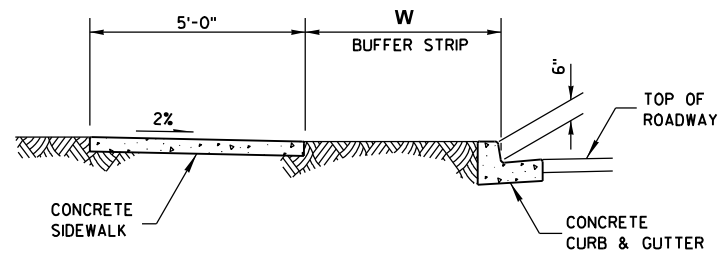

**SECTION A-A**

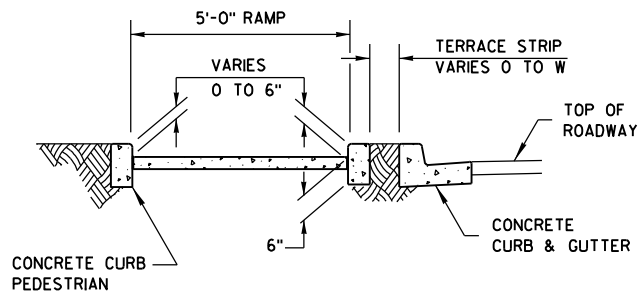

**SECTION C-C**

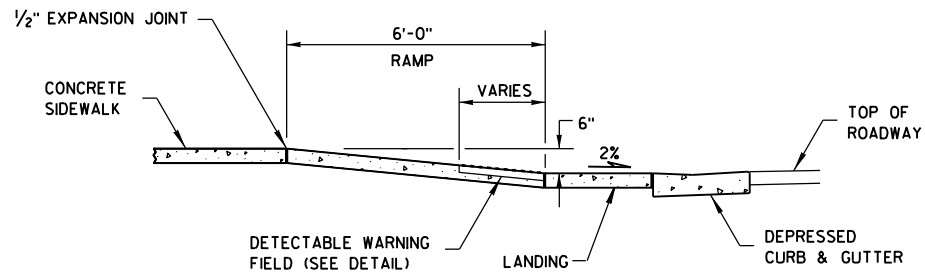

**SECTION B-B**

**GENERAL NOTES**

AVOID PLACING DRAINAGE STRUCTURES, JUNCTION BOXES OR OTHER OBSTRUCTIONS IN FRONT OF RAMP ACCESS AREAS.


RAMP SLOPES SHALL NOT BE STEEPER THAN 12:1.

SIDEWALK CROSS SLOPE SHALL NOT EXCEED 2%.

③ INSTALL TRANSITION NOSE. (INCIDENTAL TO OTHER PAY ITEMS.)  
DO NOT MARK TRANSITION NOSE.

RADIUS (AT CURB FACE)	W = 3' - 0"		W = 4' - 0"		W = 5' - 0"		W = 6' - 0"		W = 7' - 0"	
	X	Y	X	Y	X	Y	X	Y	X	Y
20 FEET	5'-5½"	4'-6½"	4'-8½"	6'-0"	4'-1"	7'-2¾"	3'-7"	8'-3½"	3'-1½"	9'-2½"
30 FEET	7'-3¾"	7'-1"	6'-5½"	8'-11½"	5'-9¼"	10'-7"	5'-2½"	12'-0"	4'-8¾"	13'-3¼"
40 FEET	8'-9½"	9'-2½"	7'-10"	11'-5¼"	7'-1"	13'-4½"	6'-5¾"	15'-¾"	5'-11½"	16'-7¼"
50 FEET	10'-¾"	11'-¾"	9'-¼"	13'-7¼"	8'-2½"	15'-9½"	7'-6½"	17'-9"	6'-11¾"	19'-6¼"
60 FEET	11'-2½"	12'-8¾"	10'-¾"	15'-6½"	9'-2¼"	17'-11¾"	8'-5¾"	20'-1¾"	7'-10½"	22'-1½"
70 FEET	12'-2¾"	14'-3¼"	11'-¼"	17'-4"	10'-1"	19'-11¾"	9'-3¾"	22'-4¼"	8'-8¼"	24'-6¼"
80 FEET	13'-2"	15'-8½"	11'-10½"	18'-11¾"	10'-10¾"	21'-10"	10'-1"	24'-4¾"	9'-5"	26'-8¾"
90 FEET	14'-½"	17'-½"	12'-8¼"	20'-6½"	11'-7¾"	23'-7"	10'-9¾"	26'-3¾"	10'-1¼"	28'-9½"
100 FEET	14'-10½"	18'-3¾"	13'-5½"	22'-0"	12'-4¼"	25'-2¾"	11'-5¾"	28'-1½"	10'-9"	30'-9"

INTERMEDIATE RADII CAN BE INTERPOLATED

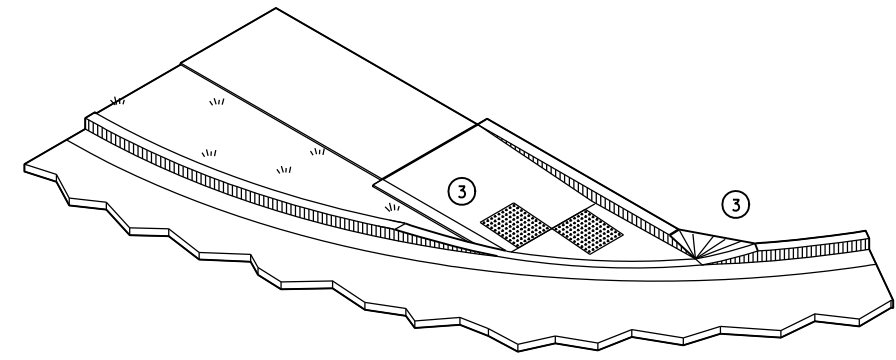


**ISOMETRIC VIEW**

**LEGEND**


- ½" EXPANSION JOINT-SIDEWALK
- - - CONTRACTION JOINT FIELD LOCATED
- ⋯ PAVEMENT MARKING CROSSWALK (WHITE)

**CURB RAMPS  
TYPE 4B**


STATE OF WISCONSIN  
DEPARTMENT OF TRANSPORTATION

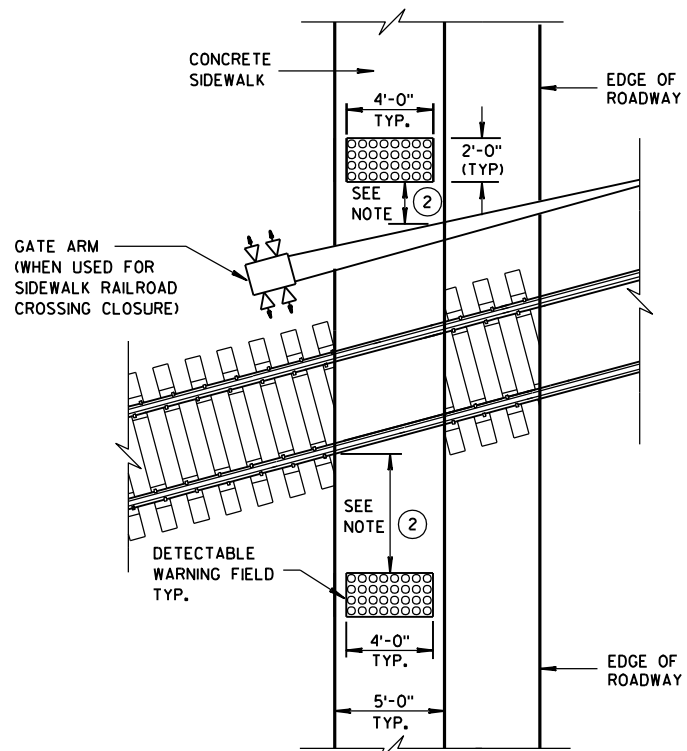


**TYPE 8**  
DETECTABLE WARNINGS  
AT RAILROAD CROSSING

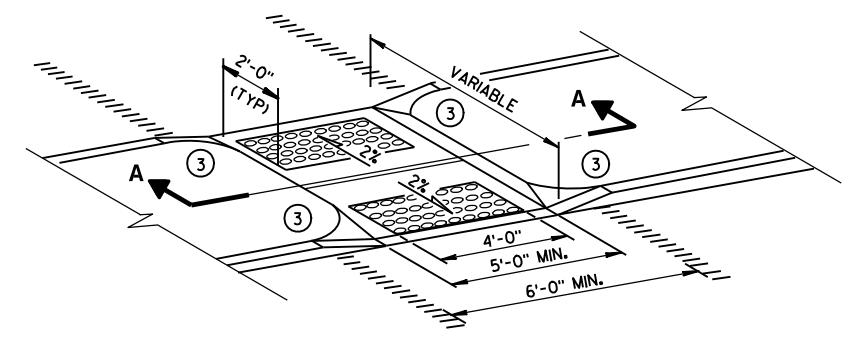


**MEDIAN ISLAND  
NON-ELEVATED CROSSING  
TYPE 5**

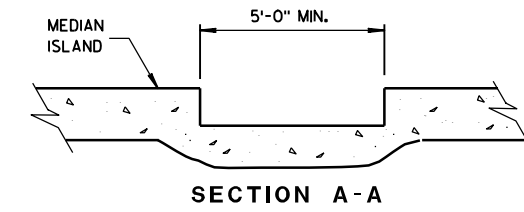


**SECTION A-A**

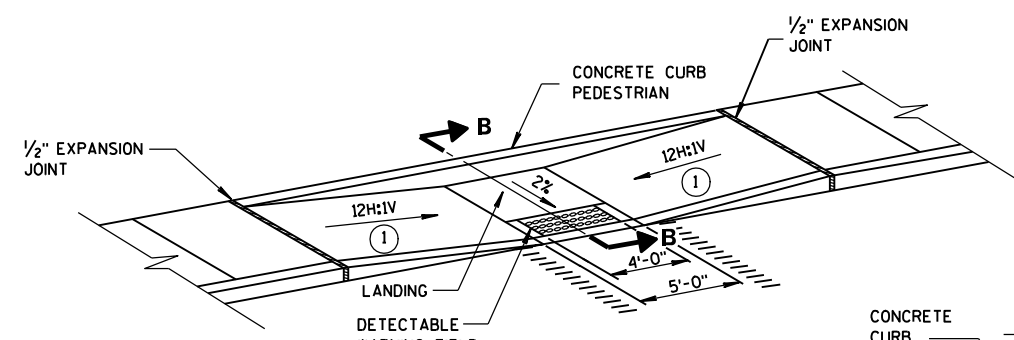

**MID-BLOCK CROSSING  
TYPE 7A**

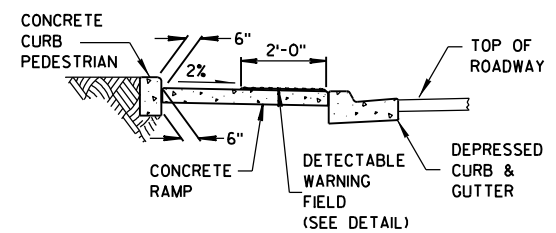

**SECTION B-B**

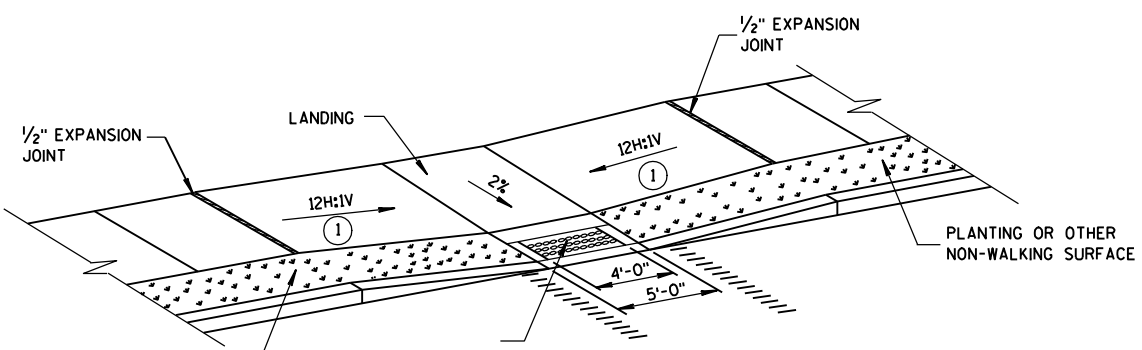

**MID-BLOCK CROSSING  
TYPE 7B**

NOTE: THESE PARALLEL AND PARALLEL/PERPENDICULAR CURB RAMPS  
MAY BE USED AT INTERSECTIONS AND MID BLOCK LOCATIONS.


**GENERAL NOTES**

SIDEWALK CROSS SLOPE SHALL NOT EXCEED 2%.

- ① SLOPE SIDEWALK TOWARD LANDING AS SHOWN WHERE THERE IS NO TERRACE OR WHERE THE TERRACE WIDTH IS LESS THAN 6 FEET WIDE.
- ② THE EDGE OF THE DETECTABLE WARNING FIELD NEAREST TO A RAILROAD CROSSING SHALL BE 1.5 FEET ± 0.1' FROM THE FACE OF THE GATE ARM IF THE GATE ARM EXTENDS ACROSS THE SIDEWALK. WHERE THERE IS NO PEDESTRIAN GATE, THE EDGE OF THE DETECTABLE WARNING FIELD NEAREST TO THE RAILROAD CROSSING SHALL BE 15 FEET FROM THE NEAREST RAIL.
- ③ INSTALL TRANSITION NOSE. (INCIDENTAL TO OTHER PAY ITEMS.) DO NOT MARK TRANSITION NOSE.

**LEGEND**


- 1/2" EXPANSION JOINT-SIDEWALK
- - - - - CONTRACTION JOINT FIELD LOCATED
- ||||| PAVEMENT MARKING CROSSWALK (WHITE)

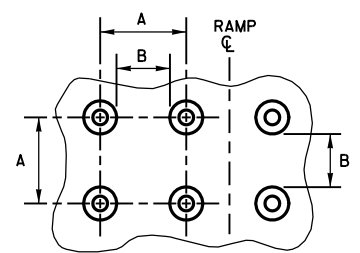

**PLAN VIEW**


	MIN.	MAX.
A	1.6"	2.4"
B	0.65"	1.5"
C	*	*
D	0.9"	1.4"

\* THE C DIMENSION IS 50% TO 65% OF THE D DIMENSION.

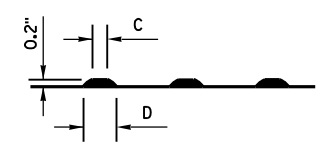


**ELEVATION VIEW**

**TRUNCATED DOMES  
DETECTABLE WARNING  
PATTERN DETAIL**

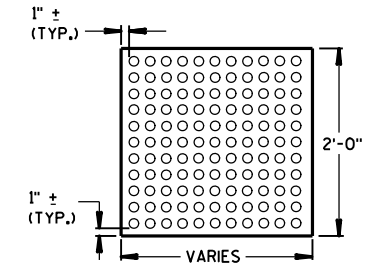


**PLAN VIEW  
DETECTABLE WARNING  
FIELD (TYPICAL)**

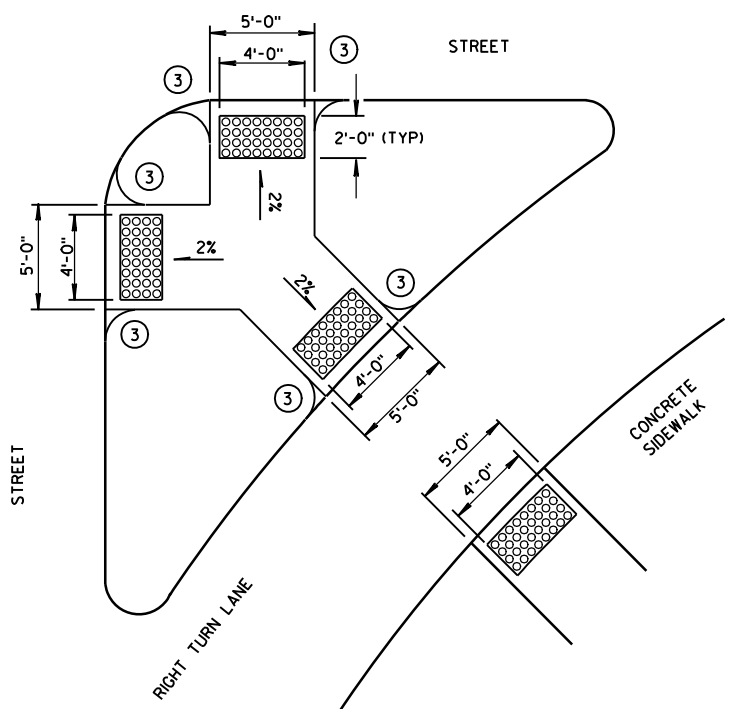


**TYPE 6**  
DETECTABLE WARNING AT ISLANDS

<b>CURB RAMPS TYPES 5, 6, 7A, 7B &amp; 8</b>	
STATE OF WISCONSIN DEPARTMENT OF TRANSPORTATION	
APPROVED	
2-9-10 DATE	/s/ Jerry H. Zogg ROADWAY STANDARDS DEVELOPMENT ENGINEER
FHWA	

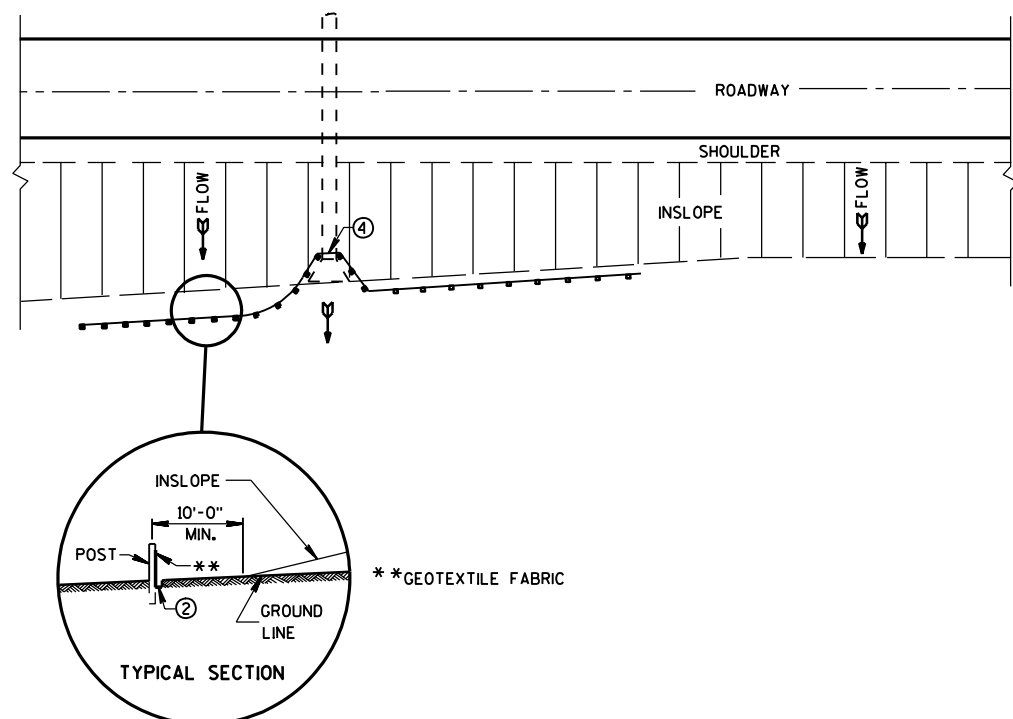


PLAN VIEW  
TYPICAL APPLICATION OF SILT FENCE

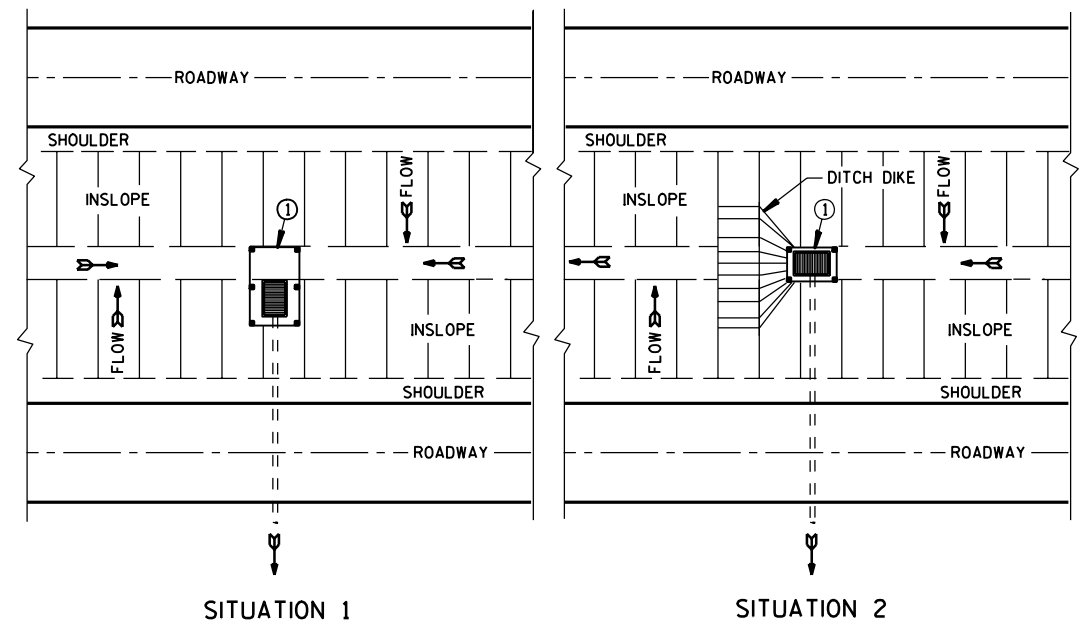


SITUATION 1                      SITUATION 2  
PLAN VIEW  
SILT FENCE AT MEDIAN SURFACE DRAINS

- GENERAL NOTES**
- DETAILS OF CONSTRUCTION NOT SHOWN ON THIS DRAWING SHALL CONFORM TO THE PERTINENT REQUIREMENTS OF THE STANDARD SPECIFICATIONS AND APPLICABLE SPECIAL PROVISIONS.
- ① HORIZONTAL BRACE REQUIRED WITH 2" X 4" WOODEN FRAME OR EQUIVALENT AT TOP OF POSTS.
  - ② FOR MANUAL INSTALLATIONS THE TRENCH SHALL BE A MINIMUM OF 4" WIDE & 6" DEEP TO BURY AND ANCHOR THE GEOTEXTILE FABRIC. FOLD MATERIAL TO FIT TRENCH AND BACKFILL & COMPACT TRENCH WITH EXCAVATED SOIL.
  - ③ WOOD POSTS SHALL BE A MINIMUM SIZE OF 1 1/8" X 1 1/8" OF OAK OR HICKORY.
  - ④ SILT FENCE TO EXTEND ACROSS THE TOP OF THE PIPE.
  - ⑤ CONSTRUCT SILT FENCE FROM A CONTINUOUS ROLL IF POSSIBLE BY CUTTING LENGTHS TO AVOID JOINTS. IF A JOINT IS NECESSARY USE ONE OF THE FOLLOWING TWO METHODS; A) OVERLAP THE END POSTS AND TWIST, OR ROTATE, AT LEAST 180 DEGREES, B) HOOK THE END OF EACH SILT FENCE LENGTH.

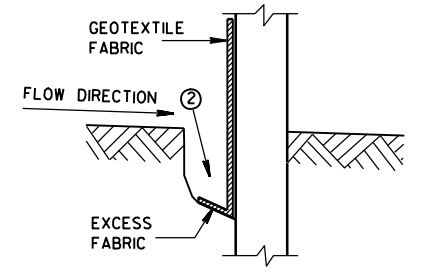


TRENCH DETAIL

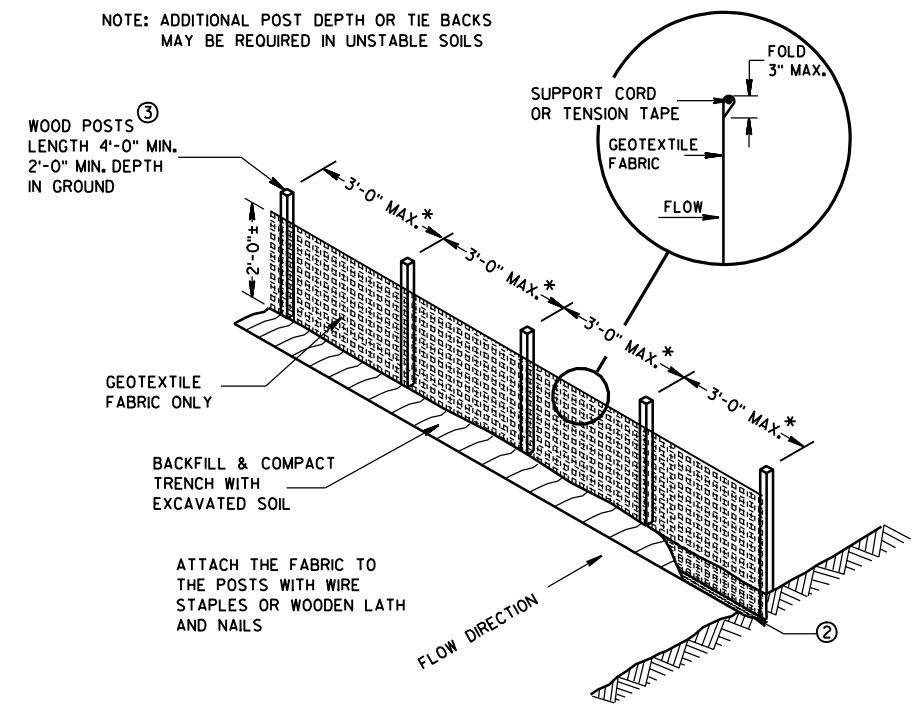


SILT FENCE

\* NOTE: 8'-0" POST SPACING ALLOWED IF A WOVEN GEOTEXTILE FABRIC IS USED.

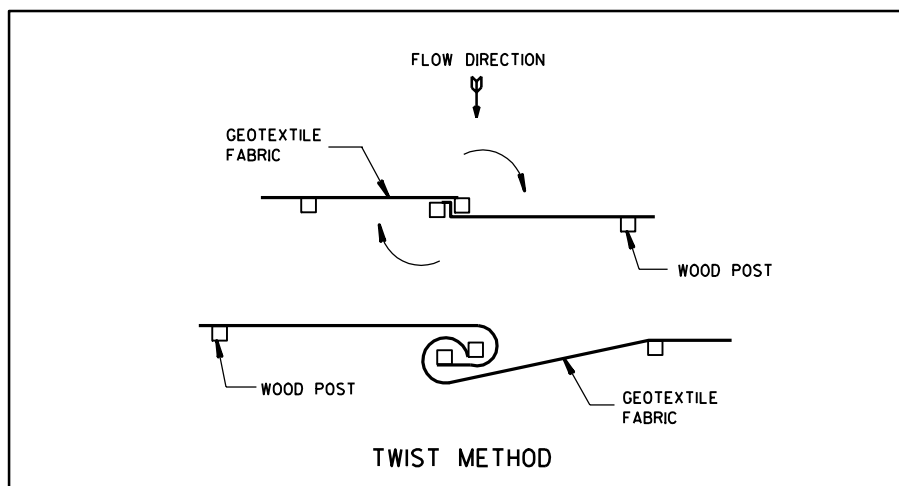


TWIST METHOD

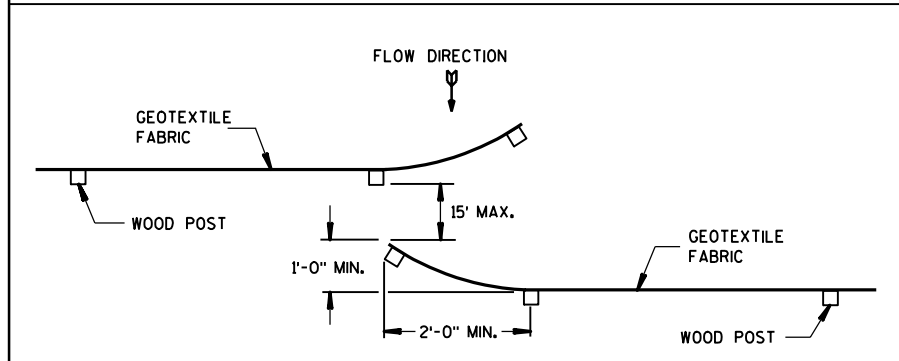

HOOK METHOD



JOINING TWO LENGTHS OF SILT FENCE ⑤

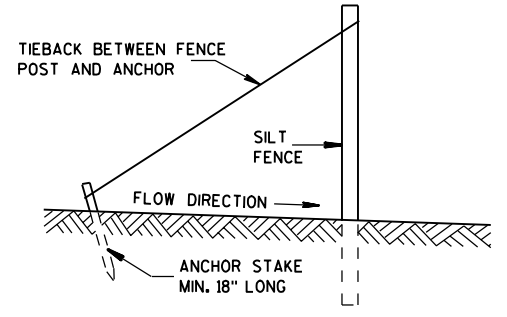

SILT FENCE TIE BACK  
(WHEN REQUIRED BY THE ENGINEER)

<b>SILT FENCE</b>	
STATE OF WISCONSIN DEPARTMENT OF TRANSPORTATION	
APPROVED 4-29-05 DATE FHWA	 CHIEF ROADWAY DEVELOPMENT ENGINEER



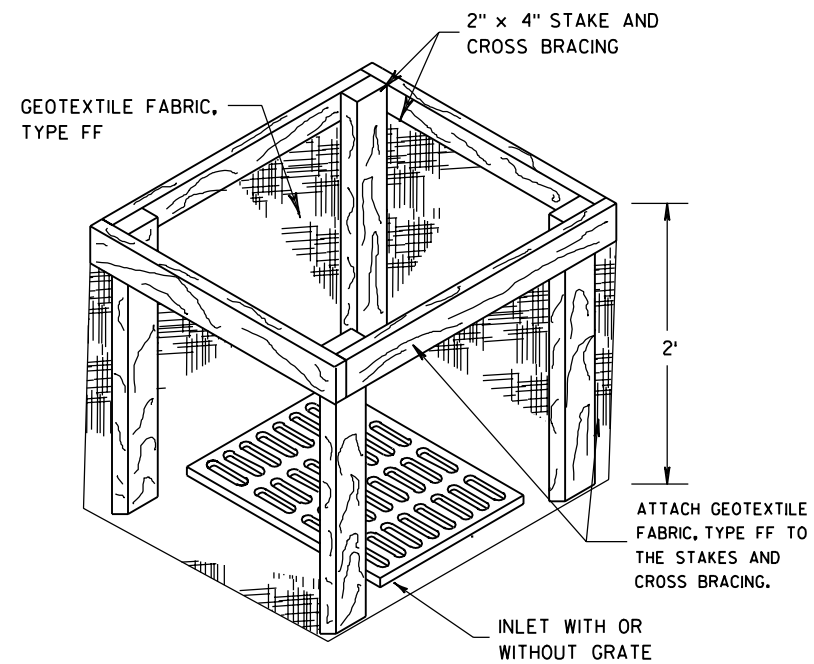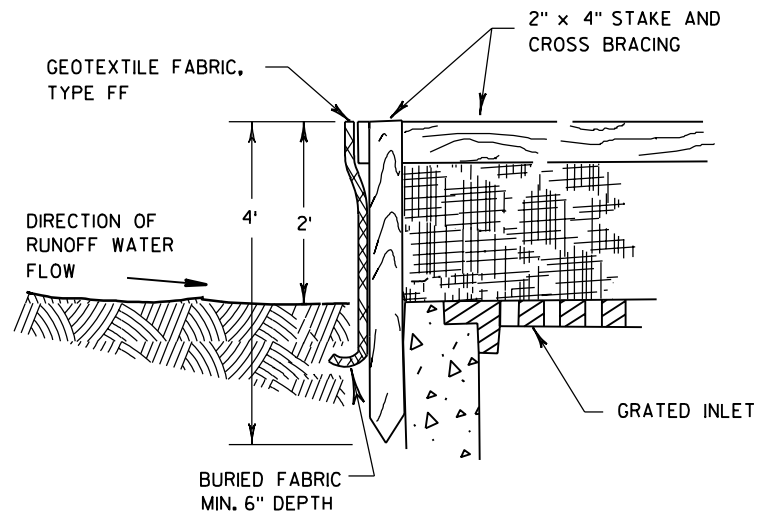

**INLET PROTECTION, TYPE A**


**GENERAL NOTES**

INLET PROTECTION DEVICES SHALL BE MAINTAINED OR REPLACED AT THE DIRECTION OF THE ENGINEER.

MANUFACTURED ALTERNATIVES APPROVED AND LISTED ON THE DEPARTMENT'S EROSION CONTROL PRODUCT ACCEPTABILITY LIST MAY BE SUBSTITUTED.


WHEN REMOVING OR MAINTAINING INLET PROTECTION, CARE SHALL BE TAKEN SO THAT THE SEDIMENT TRAPPED ON THE GEOTEXTILE FABRIC DOES NOT FALL INTO THE INLET. ANY MATERIAL FALLING INTO THE INLET SHALL BE REMOVED IMMEDIATELY.

- ① FINISHED SIZE, INCLUDING FLAP POCKETS WHERE REQUIRED, SHALL EXTEND A MINIMUM OF 10" AROUND THE PERIMETER TO FACILITATE MAINTENANCE OR REMOVAL.
- ② FOR INLET PROTECTION, TYPE C (WITH CURB BOX), AN ADDITIONAL 18" OF FABRIC IS WRAPPED AROUND THE WOOD AND SECURED WITH STAPLES. THE WOOD SHALL NOT BLOCK THE ENTIRE HEIGHT OF THE CURB BOX OPENING.
- ③ FLAP POCKETS SHALL BE LARGE ENOUGH TO ACCEPT WOOD 2X4.

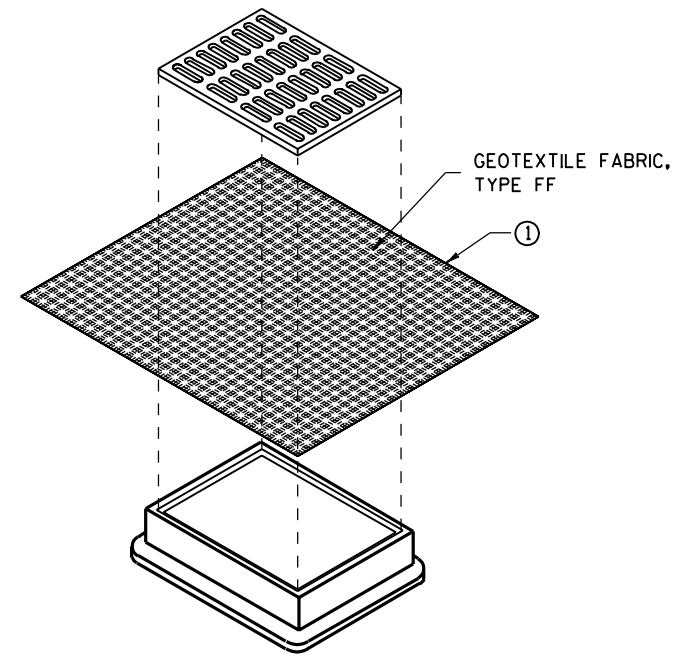

**INLET PROTECTION, TYPE B  
(WITHOUT CURB BOX)**

(CAN BE INSTALLED IN ANY INLET WITHOUT A CURB BOX)

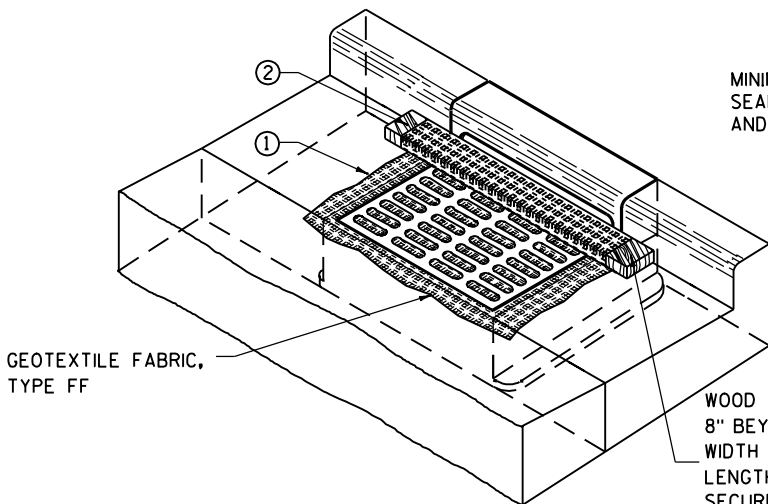

**INLET PROTECTION, TYPE C (WITH CURB BOX)**


**INSTALLATION NOTES**

**TYPE B & C**

TRIM EXCESS FABRIC IN THE FLOW LINE TO WITHIN 3" OF THE GRATE.  
THE CONTRACTOR SHALL DEMONSTRATE A METHOD OF MAINTENANCE, USING A SEWN FLAP, HAND HOLDS OR OTHER METHOD TO PREVENT ACCUMULATED SEDIMENT FROM ENTERING THE INLET.

**TYPE D**

DO NOT INSTALL INLET PROTECTION TYPE D IN INLETS SHALLOWER THAN 30", MEASURED FROM THE BOTTOM OF THE INLET TO THE TOP OF THE GRATE.  
TRIM EXCESS FABRIC IN THE FLOW LINE TO WITHIN 3" OF THE GRATE.  
THE INSTALLED BAG SHALL HAVE A MINIMUM SIDE CLEARANCE, BETWEEN THE INLET WALLS AND THE BAG, MEASURED AT THE BOTTOM OF THE OVERFLOW HOLES, OF 3". WHERE NECESSARY THE CONTRACTOR SHALL CINCH THE BAG, USING PLASTIC ZIP TIES, TO ACHIEVE THE 3" CLEARANCE. THE TIES SHALL BE PLACED AT A MAXIMUM OF 4" FROM THE BOTTOM OF THE BAG.

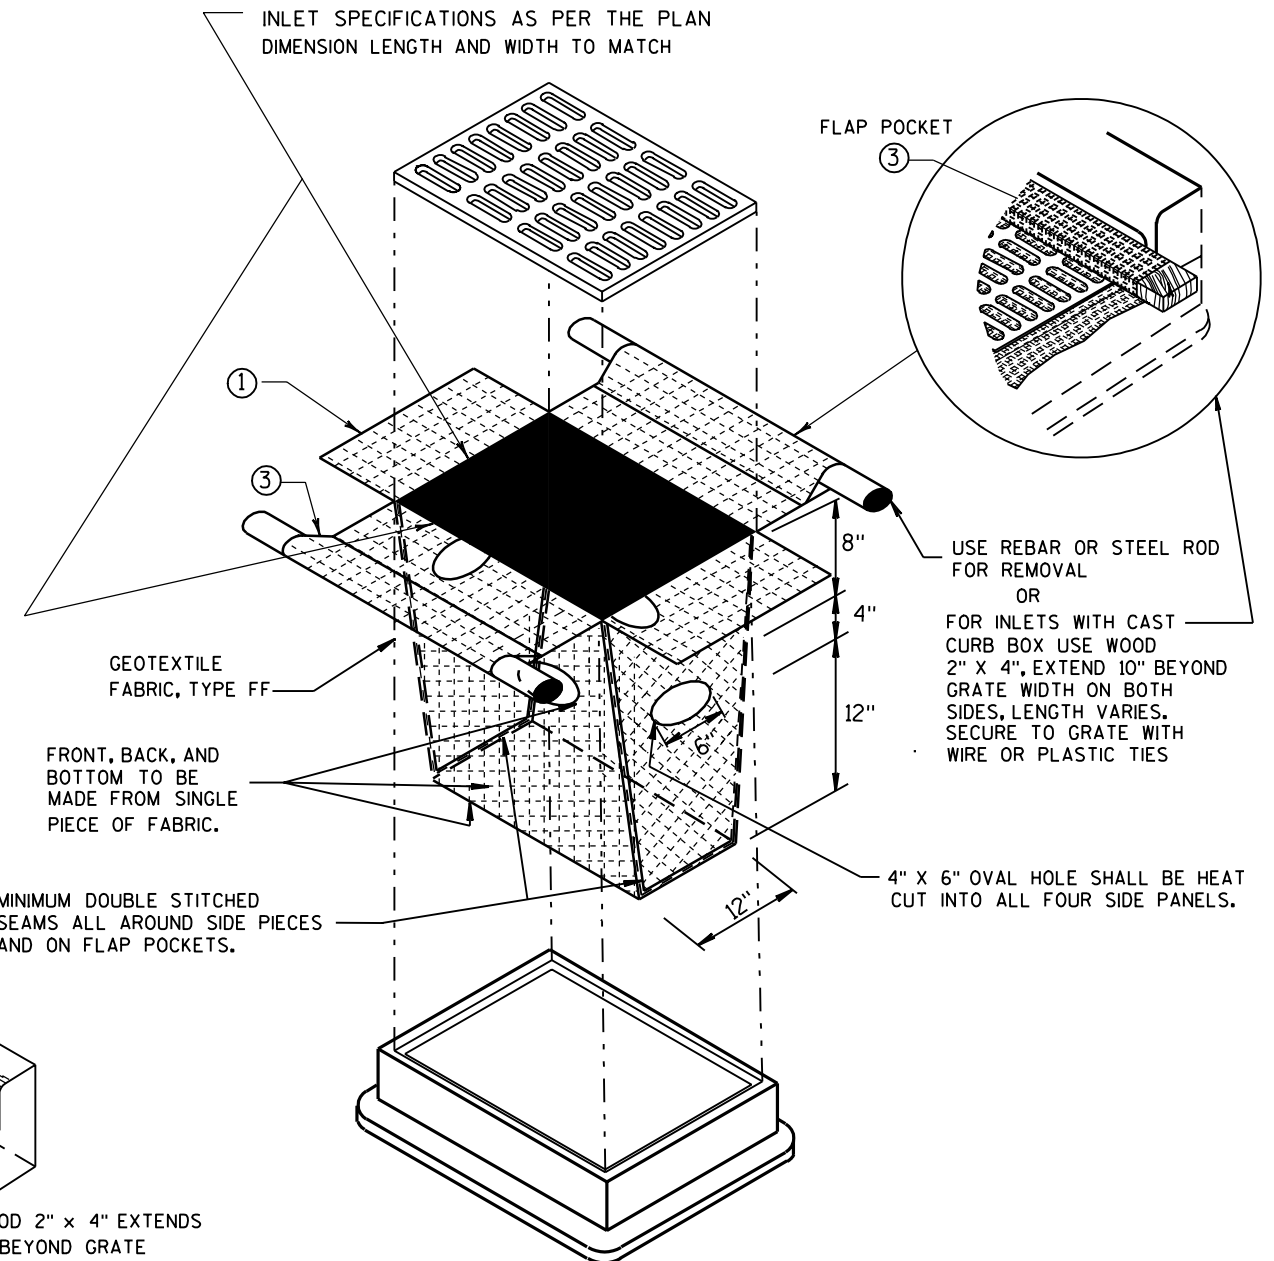

**INLET PROTECTION, TYPE D**

(CAN BE INSTALLED IN ANY INLET TYPE WITH OR WITHOUT A CURB BOX AS PER NOTE ②)

<b>INLET PROTECTION TYPE A, B, C, AND D</b>	
STATE OF WISCONSIN DEPARTMENT OF TRANSPORTATION	
APPROVED 10/16/02 DATE FHWA	 CHIEF ROADWAY DEVELOPMENT ENGINEER

6

6

S.D.D. 8 E 10-2


S.D.D. 8 E 10-2

METAL APRON ENDWALLS											
PIPE DIA. (IN.)	MIN. THICK. (Inches)		DIMENSIONS (Inches)							APPROX. SLOPE	BODY
	STEEL	ALUM.	A (±1")	B (MAX.)	H (±1")	L (±1 1/2")	L1 (⓪)	L2 (⓪)	W (±2")		
12	.064	.060	6	6	6	21	12	17 1/2	24	2 1/2 to 1	1 Pc.
15	.064	.060	7	8	6	26	14	21 3/4	30	2 1/2 to 1	1 Pc.
18	.064	.060	8	10	6	31	15	28 1/4	36	2 1/2 to 1	1 Pc.
21	.064	.060	9	12	6	36	18	29 3/8	42	2 1/2 to 1	1 Pc.
24	.064	.075	10	13	6	41	18	37 1/4	48	2 1/2 to 1	1 Pc.
30	.079	.075	12	16	8	51	18	52 1/4	60	2 1/2 to 1	1 Pc.
36	.079	.105	14	19	9	60	24	59 3/4	72	2 1/2 to 1	2 Pc.
42	.109	.105	16	22	11	69	24	75 5/8	84	2 1/2 to 1	2 Pc.
48	.109	.105	18	27	12	78	24	81	90	2 1/2 to 1	3 Pc.
54	.109	.105	18	30	12	84	30	85 1/2	102	2 1/2 to 1	3 Pc.
60	.109x	.105x	18	33	12	87	—	—	114	2 to 1	3 Pc.
66	.109x	.105x	18	36	12	87	—	—	120	2 to 1	3 Pc.
72	.109x	.105x	18	39	12	87	—	—	126	2 to 1	3 Pc.
78	.109x	.105x	18	42	12	87	—	—	132	1 1/2 to 1	3 Pc.
84	.109x	.105x	18	45	12	87	—	—	138	1 1/2 to 1	3 Pc.
90	.109x	.105x	18	37	12	87	—	—	144	1 1/2 to 1	3 Pc.
96	.109x	.105x	18	35	12	87	—	—	150	1 1/2 to 1	3 Pc.

x EXCEPT CENTER PANEL SEE GENERAL NOTES

REINFORCED CONCRETE APRON ENDWALLS									
PIPE DIA. (IN.)	DIMENSIONS (Inches)							APPROX. SLOPE	
	T	A	B	C	D	E	G		
12	2	4	24	48 3/8	72 3/8	24	2	3 to 1	
15	2 1/4	6	27	46	73	30	2 1/4	3 to 1	
18	2 1/2	9	27	46	73	36	2 1/2	3 to 1	
21	2 3/4	9	36	37 1/2	73 1/2	42	2 3/4	3 to 1	
24	3	9 1/2	43 1/2	30	73 1/2	48	3	3 to 1	
27	3 1/4	10 1/2	49 1/2	24	73 1/2	54	3 1/4	3 to 1	
30	3 1/2	12	54	19 3/4	73 1/2	60	3 1/2	3 to 1	
36	4	15	63	34 3/4	97 3/4	72	4	3 to 1	
42	4 1/2	21	63	35	98	78	4 1/2	3 to 1	
48	5	24	72	26	98	84	5	3 to 1	
54	5 1/2	27	65	33 1/4	98 3/4	90	5 1/2	2 3/5 to 1	
60	6	30-35	60	39	99	96	5	2 to 1	
66	6 1/2	24-30	72-78	21-27	99	102	5 1/2	2 to 1	
72	7	24-36	78	21	99	108	6	2 to 1	
78	7 1/2	24-36	78	21	99	114	6 1/2	2 to 1	
84	8	36	90 1/2	21	111 1/2	120	6 1/2	1 1/2 to 1	
90	8 1/2	41	87 1/2	24	111 1/2	132	6 1/2	1 1/2 to 1	






\*MINIMUM  
\*\*MAXIMUM

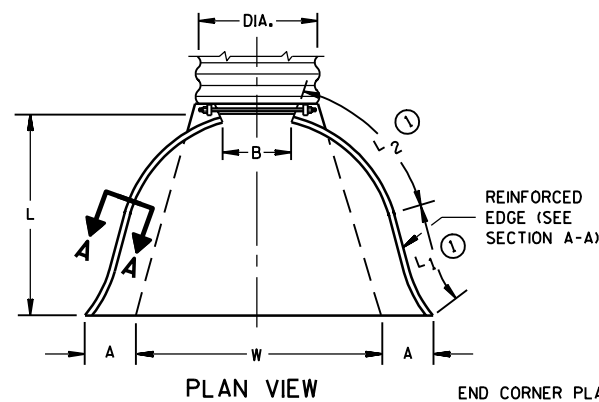


REINFORCED EDGE (SEE SECTION A-A)

END CORNER PLATES MAY BE FASTENED TO APRON PROPER BY BOLTS, RIVETS, OR RESISTANCE SPOT WELDS WHICH WILL HOLD THE SURFACES TIGHTLY TOGETHER





TOE PLATE (SAME THICKNESS AND METAL AS APRON) SHALL BE FURNISHED WHEN CALLED FOR ON THE PLANS

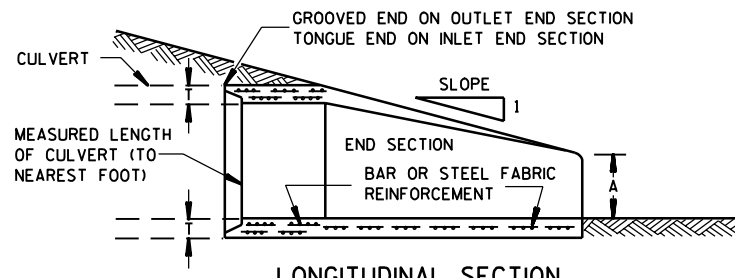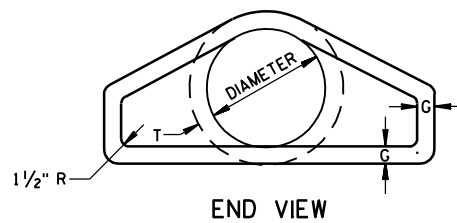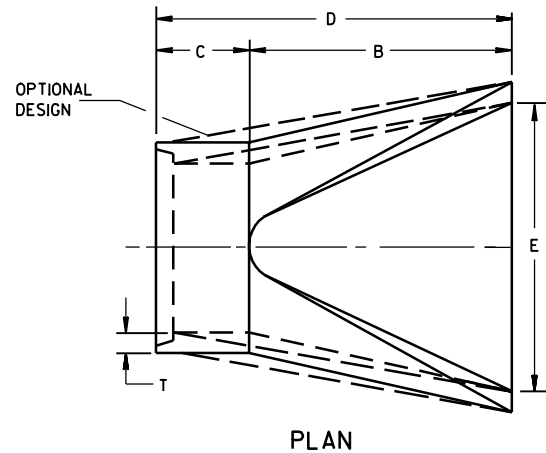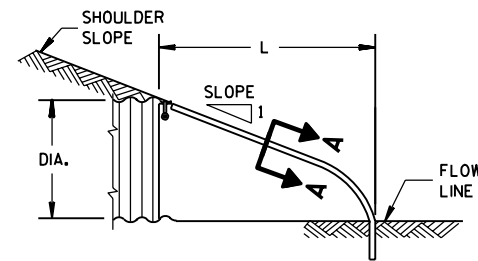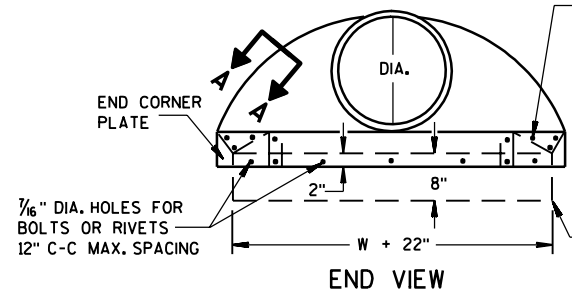

1" WIDE, 12 GA. (0.109" THICK) GALVANIZED STRAP WITH STANDARD 6" X 1/2" BAND BOLT AND NUT

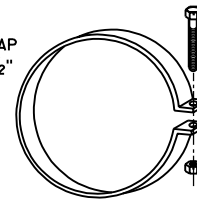

ALTERNATE FOR TYPE 1 CONNECTION END SECTION CONNECTOR STRAP

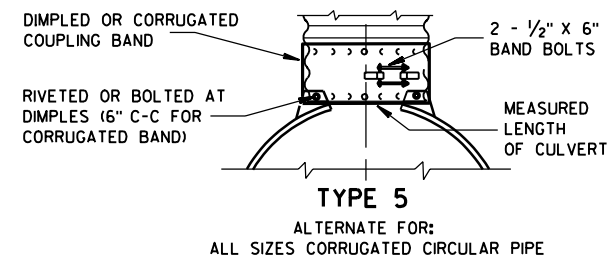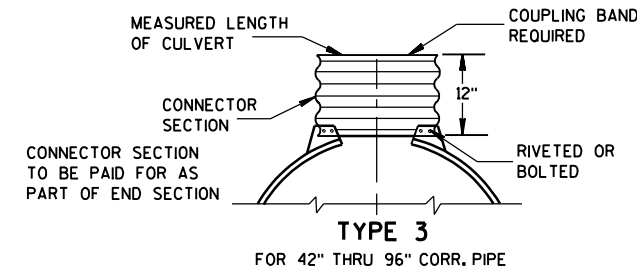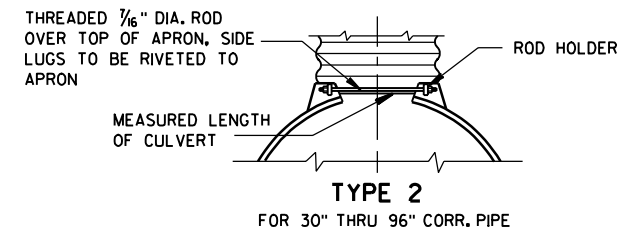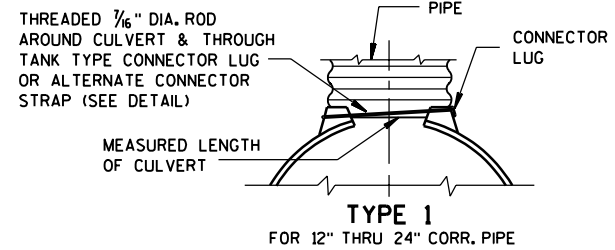


NOTE: DIMPLED BAND FITS OVER OUTSIDE OF ENDWALL, AND CORRUGATED BAND FITS INSIDE ENDWALL. DIMPLED BAND MAY BE USED WITH HELICALLY CORRUGATED PIPE.

FOR CIRCUMFERENTIALLY CORRUGATED PIPE USE ENDWALL CONNECTION DETAILS 1, 2, 3 OR 5 AS APPLICABLE.

FOR HELICALLY CORRUGATED PIPE USE ENDWALL CONNECTION DETAILS 1, 2 OR 5.

FOR HELICALLY CORRUGATED PIPES WITH TWO CIRCUMFERENTIAL CORRUGATIONS AT EACH END USE ENDWALL CONNECTION DETAILS 1, 2 OR 3.

CONNECTION DETAILS

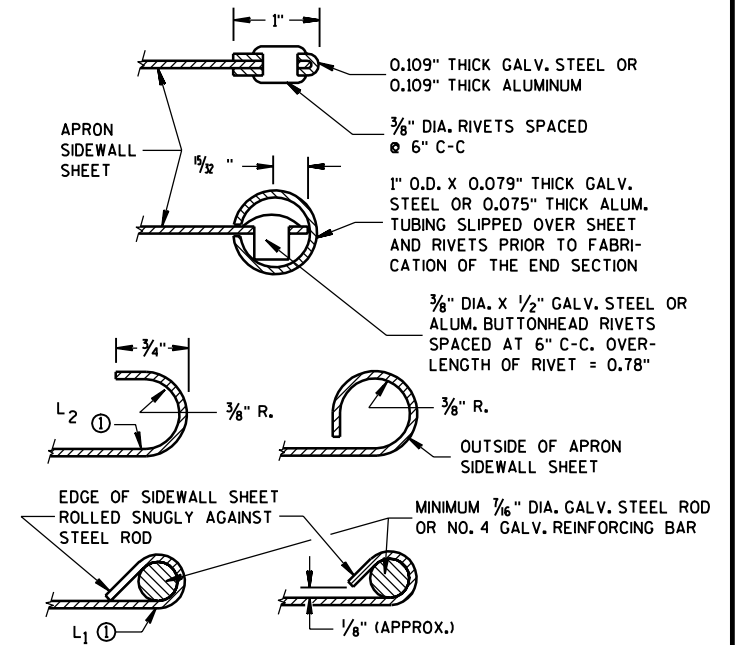

GENERAL NOTES

DETAILS OF CONSTRUCTION, MATERIALS AND WORKMANSHIP NOT SHOWN ON THIS DRAWING SHALL CONFORM TO THE PERTINENT REQUIREMENTS OF THE STANDARD SPECIFICATIONS AND THE APPLICABLE SPECIAL PROVISIONS.

CONCRETE CULVERT ENDWALLS MAY NOT BE USED WITH GALVANIZED STEEL OR ALUMINUM CULVERT PIPE OR VICE VERSA. GALVANIZED STEEL OR ALUMINUM ENDWALLS SHALL NORMALLY BE INSTALLED ON CULVERT PIPE OF THE SAME METAL.

ALL THREE PIECE STEEL APRON ENDWALLS FOR 60" DIAMETER PIPE AND LARGER SHALL HAVE 0.109" SIDES AND 0.138" CENTER PANELS. ALL THREE PIECE ALUMINUM APRON ENDWALLS FOR 60" DIAMETER PIPE AND LARGER SHALL HAVE 0.105" SIDES AND 0.134" CENTER PANELS. THE WIDTH OF CENTER PANELS SHALL BE GREATER THAN 20 PERCENT OF THE PIPE PERIMETER.

LAP SEAMS SHALL BE TIGHTLY JOINED BY GALVANIZED RIVETS OR BOLTS FOR STEEL UNITS AND ALUMINUM RIVETS AND BOLTS FOR ALUMINUM UNITS. FOR THE 60" THROUGH 96" DIAMETER APRON ENDWALL SIZES, THE REINFORCED EDGES AND CENTER PANEL SEAMS SHALL BE FURTHER REINFORCED WITH GALVANIZED STEEL OR ALUMINUM STIFFENER ANGLES. THE ANGLES SHALL BE ATTACHED BY GALVANIZED NUTS AND BOLTS FOR STEEL UNITS AND ALUMINUM NUTS AND BOLTS FOR ALUMINUM UNITS.


WHERE TWO OR MORE PIPES WITH APRON ENDWALLS ARE LAID ADJACENT TO EACH OTHER, THEY SHALL BE SEPARATED BY A DISTANCE SUFFICIENT TO PROVIDE A MINIMUM CLEARANCE OF 6 INCHES BETWEEN APRON ENDWALLS.

⓪ FOR PIPE SIZES UP TO 60" DIAMETER, A 180° ROLLED EDGE MAY BE USED INSTEAD OF STEEL ROD REINFORCEMENT. SEE SECTION A-A.


APRON ENDWALLS FOR CULVERT PIPE

STATE OF WISCONSIN DEPARTMENT OF TRANSPORTATION

APPROVED 11/30/94 DATE  
*Paul J. Harrison*  
 CHIEF ROADWAY DEVELOPMENT ENGINEER  
 FHWA

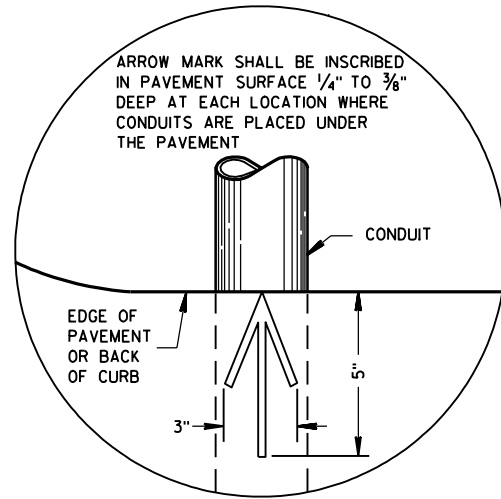


PLAN VIEW  
ARROW MARK

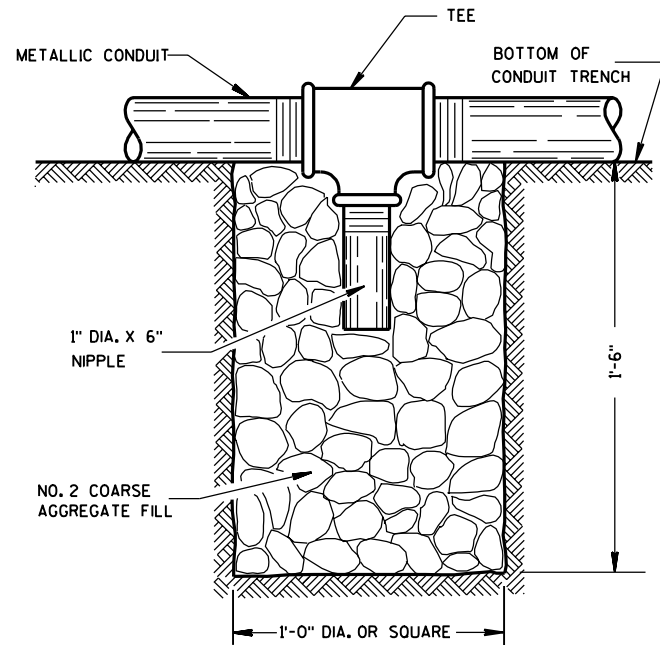

NOTE: INSTALL AT LOCATIONS WHERE METALLIC CONDUITS CANNOT BE PITCHED TO DRAIN INTO A PULL BOX.

DRAIN SUMP FOR METALLIC CONDUIT

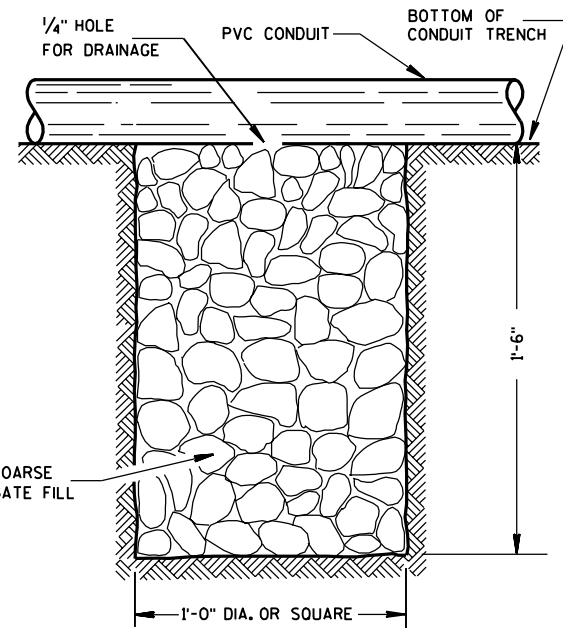

NOTE: INSTALL AT LOCATIONS WHERE PVC CONDUITS CANNOT BE PITCHED TO DRAIN INTO A PULL BOX.

DRAIN SUMP FOR PVC CONDUIT

**GENERAL NOTES**

DETAILS OF CONSTRUCTION, MATERIALS AND WORKMANSHIP NOT SHOWN ON THIS DRAWING SHALL CONFORM TO THE PERTINENT REQUIREMENTS OF THE CONTRACT.

METALLIC (STANDARD SPECIFICATION 652.2.2) OR NONMETALLIC (STANDARD SPECIFICATION 652.2.3) CONDUIT SHALL BE FURNISHED AND PLACED AS SHOWN.

DEPTH OF CONDUIT INSTALLED BELOW THE TRAVELED WAY SHALL BE 24 INCHES MINIMUM AND 36 INCHES MAXIMUM.

DEPTH OF CONDUIT INSTALLED THAT IS NOT BELOW THE TRAVELED WAY SHALL BE 18 INCHES MINIMUM AND 36 INCHES MAXIMUM.

ANY EXCEPTION TO THE MAXIMUM DEPTH SHALL BE ONLY WITH THE WRITTEN APPROVAL OF THE ENGINEER.

THE TRENCH SHALL NOT BE BACKFILLED PRIOR TO INSPECTION OF THE CONDUIT.

ALL METALLIC CONDUIT RACEWAY ENDS SHALL BE REAMED AND THREADED.

ALL METALLIC CONDUIT IN WHICH WIRE OR CABLE IS TO BE INSTALLED SHALL BE BUSHED WITH APPROVED THREADED BUSHINGS BEFORE INSTALLATION OF THE WIRE OR CABLE.

ALL METALLIC CONDUITS IN WHICH WIRE OR CABLE IS NOT TO BE INSTALLED SHALL BE CAPPED WITH THREADED PROTECTIVE CAPS, AS APPROVED BY THE ENGINEER.

ALL NONMETALLIC CONDUIT SHALL BE CAPPED OR PLUGGED IMMEDIATELY AFTER INSTALLATION AND SHALL REMAIN CAPPED OR PLUGGED UNTIL WIRE/CABLES ARE INSTALLED.

NONMETALLIC CONDUITS IN WHICH WIRE OR CABLE IS NOT BEING INSTALLED SHALL REMAIN CAPPED OR PLUGGED.

BENDING OF PVC ELECTRICAL CONDUIT SHALL BE ACCOMPLISHED BY USING A BLANKET OR EMERSION TYPE TANK DESIGNED FOR THE PURPOSE OF BENDING PVC ELECTRICAL CONDUIT.

ALL CUT ENDS SHALL BE TRIMMED INSIDE AND OUTSIDE TO REMOVE ALL ROUGH EDGES ON NONMETALLIC CONDUIT. (SEE NEC 347.5)

WHEN REQUIRED TO CONNECT NONMETALLIC CONDUIT TO METALLIC CONDUIT, ONLY U.L. LISTED ADAPTER FITTINGS SHALL BE USED.


PRIOR TO CONDUIT ACCEPTANCE, CONDUIT CAPS OR PLUGS SHALL BE REMOVED, AND THE CAPS, PLUGS AND CONDUIT ENDS SHALL BE THOROUGHLY CLEANED AND THEN THE CAPS OR PLUGS REINSTALLED TO ENSURE THAT THE CAPS OR PLUGS CAN BE EASILY REMOVED IN THE FUTURE.

ALL CONDUIT BEING FURNISHED AND INSTALLED SHALL HAVE THE U.L. LABEL FIRMLY ATTACHED.

CONDUIT RUNS SHALL BE THE SAME SIZE OF CONDUIT FROM ONE END TO THE OTHER (FROM PULL BOX TO PULL BOX-OR-JUNCTION BOX TO JUNCTION BOX-OR-BASE TO BASE, ETC.).

POLY ROPE OR A PULL WIRE SHALL BE INSTALLED AS STATED IN THE STANDARD SPECIFICATION, ITEM 652.3.1.1.

ALL CONDUIT RUNS SHALL BE STRAIGHT (WITHOUT BENDS) FROM PULL BOX TO PULL BOX, PULL BOX TO BASE AND BASE TO BASE AS SHOWN ON THE PLANS.

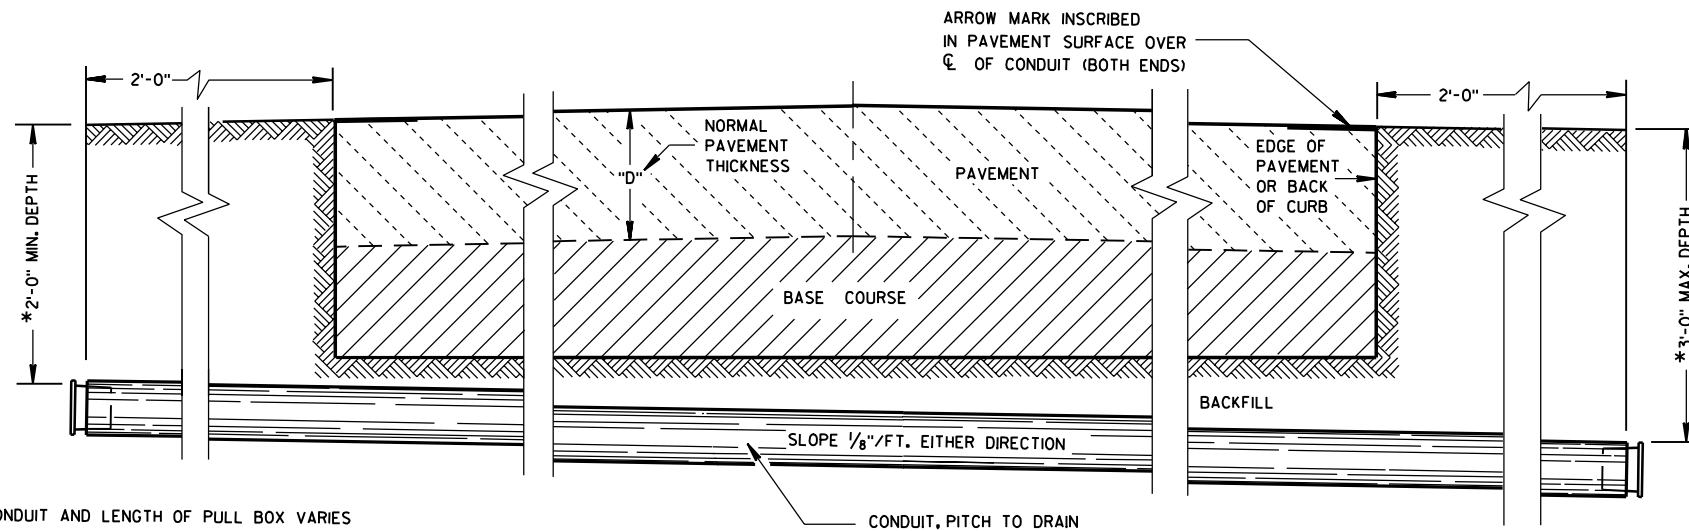

\*DEPTH OF CONDUIT AND LENGTH OF PULL BOX VARIES WITH HEIGHT OF CURB USED. ALSO SEE PULL BOX S.D.D. 9B4

SIDE ELEVATION  
DETAIL FOR CONDUIT UNDER PAVED HIGHWAYS

<b>CONDUIT</b>	
STATE OF WISCONSIN DEPARTMENT OF TRANSPORTATION	
APPROVED 10/23/03 DATE	 STATE ELECTRICAL ENGINEER FOR HIGHWAYS
FHWA	

**TABLE OF NOMINAL DIMENSIONS AND WEIGHTS**

DIMENSION IN INCHES	CORRUGATED STEEL PIPE										
	PIPE DIAMETER (INSIDE)	A	12	12	12	18	18	18	24	24	24
PIPE LENGTH **	B	24	30	36	24	30	36	36	42	48	
WALL THICKNESS	C	0.064	0.064	0.064	0.064	0.064	0.064	0.064	0.064	0.064	
COVER	D	10 1/4	10 1/4	10 1/4	16 1/4	16 1/4	16 1/4	22 1/4	22 1/4	22 1/4	
FRAME	E	14 1/2	14 1/2	14 1/2	20 1/2	20 1/2	20 1/2	26 1/2	26 1/2	26 1/2	
FRAME	F	8 1/2	8 1/2	8 1/2	14 1/2	14 1/2	14 1/2	20 1/2	20 1/2	20 1/2	
FRAME	G	11 1/2	11 1/2	11 1/2	17 1/2	17 1/2	17 1/2	23 1/2	23 1/2	23 1/2	
WEIGHT IN POUNDS *											
FRAME AND COVER		60	60	60	110	110	110	155	155	155	

\* THE ACTUAL WEIGHT OF THE MANHOLE FRAME AND COVER MAY VARY WITHIN 5 PERCENT PLUS OR MINUS OF THE WEIGHTS SHOWN.

\*\* NORMALLY USED LENGTHS. THE PROJECT ENGINEER SHALL DETERMINE IF PIPE LENGTHS, OTHER THAN THOSE SPECIFIED, SHALL BE USED, TO A MAXIMUM OF 48" (CONTINUOUS LENGTH, NON-SPLICED). THE ADDITIONAL LENGTH SHALL BE INCIDENTAL TO THE PULL BOX BID PRICE.

**GENERAL NOTES**

DETAILS OF CONSTRUCTION, MATERIALS AND WORKMANSHIP NOT SHOWN ON THIS DRAWING SHALL CONFORM TO THE PERTINENT REQUIREMENTS OF THE CONTRACT.

ALL FRAMES AND COVERS SHALL BE HEAVY DUTY TYPE, SUITABLE FOR VEHICULAR TRAFFIC LOADS.

PULL BOXES LOCATED IN THE ROADWAYS SHALL HAVE LOCKING COVERS.

ENTRANCE HOLES INTO PULL BOXES SHALL BE CUT WITH A CIRCULAR HOLE SAW OR HYDRAULIC CONDUIT PUNCH. HOLE SIZE SHALL BE THE OUTSIDE DIAMETER OF THE CONDUIT THAT IS TO FIT IN THE OPENING PLUS NO MORE THAN 1/4".

THE CONTRACTOR SHALL NOT INSTALL WIRE IN ANY PULL BOX UNTIL ITS INSTALLATION HAS BEEN INSPECTED AND ACCEPTED BY THE ENGINEER.

GROUNDING LUGS (MECHANICAL CONNECTORS) SHALL BE U.L. LISTED AND APPROVED FOR USE WITH COPPER WIRE. THE MECHANICAL CONNECTION (INSIDE AND OUTSIDE) TO THE PULL BOX, SHALL BE TOTALLY AND PERMANENTLY SEALED WITH A SILICONE OR RUBBERIZED CAULKING COMPOUND AS APPROVED BY THE ENGINEER.


GROUNDING LUGS ARE NOT REQUIRED IN PULL BOXES WHEN VOLTAGES OF LESS THAN 50 VOLTS AC ARE THE ONLY VOLTAGES ENCOUNTERED IN THE BOXES.

ALL METALLIC CONDUIT IN WHICH WIRE AND/OR CABLE IS TO BE INSTALLED, SHALL BE BUSHED BEFORE INSTALLATION OF THE WIRE AND/OR CABLE.



S.D.D. 9B2, "CONDUIT", APPLIES TO THIS DRAWING.

WHEN PULL BOXES ARE INSTALLED FOR FUTURE USE, DO NOT INSTALL THE EQUIPMENT GROUNDING LUG. THE EQUIPMENT GROUNDING LUG, THE EQUIPMENT GROUNDING ELECTRODE AND THE EQUIPMENT GROUNDING CONDUCTOR SHALL BE REQUIRED AND INSTALLED UNDER A FUTURE WIRING CONTRACT.

IF PULL BOX EQUIPMENT GROUNDING IS REQUIRED USING AN EQUIPMENT GROUNDING ELECTRODE IN EACH PULL BOX, THE EQUIPMENT GROUNDING ELECTRODE SHALL BE 5/8" X 8'-0", COPPERCLAD AND BE EXOTHERMICALLY WELDED TO A #4 AWG, COPPER, STRANDED WIRE (BARE OR GREEN INSULATED). THE #4 AWG WIRE SHALL BE 4 FEET IN LENGTH, NEATLY COILED, TAPED AND AVAILABLE FOR USE WHEN REQUIRED.

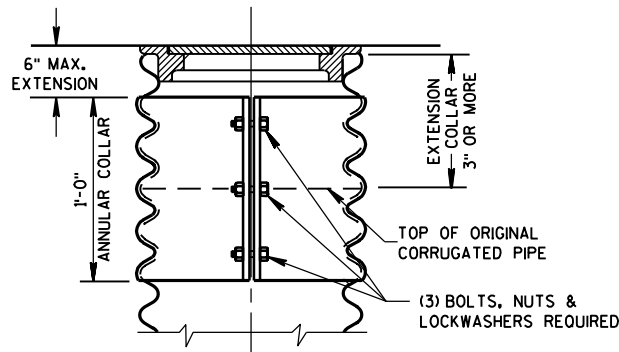


**CORRUGATED PIPE EXTENDER**

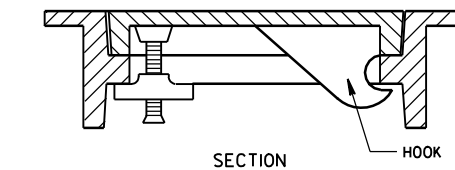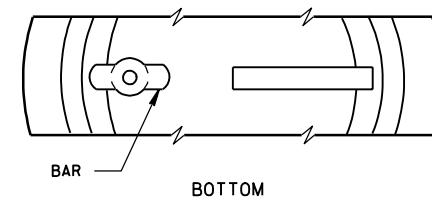


**ALTERNATE COVER (LOCKING)**


TIGHTENING BAR TYPE

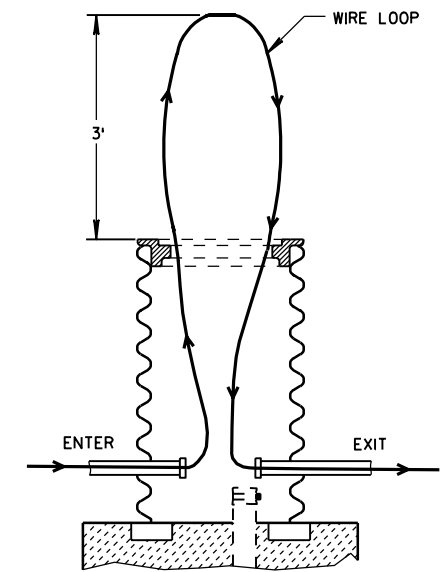

**MEASUREMENT DETAIL FOR WIRE/CABLE IN THE PULL BOX**

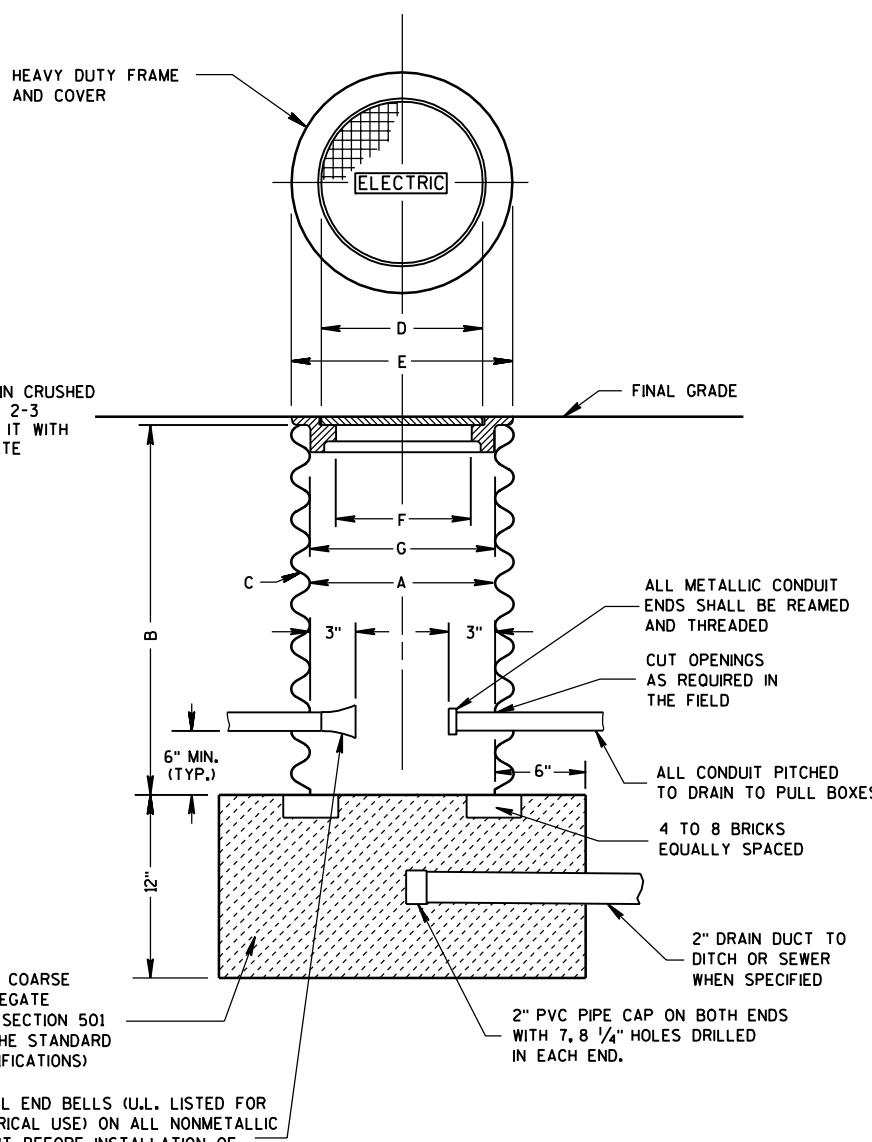


**PULL BOX**

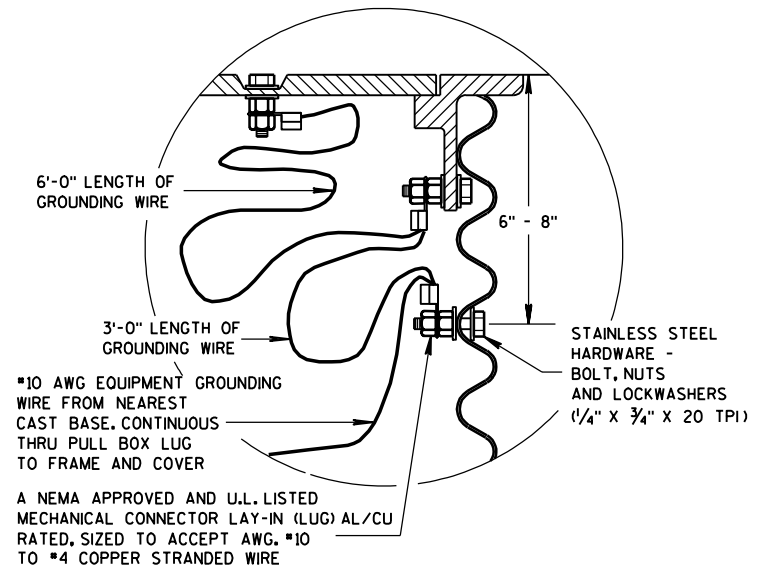

**EQUIPMENT GROUNDING LUG AND LOCATION IN STEEL PULL BOXES**

<b>PULL BOX</b>	
STATE OF WISCONSIN DEPARTMENT OF TRANSPORTATION	
APPROVED 9/27/06 DATE	/S/ Balu Ananthanarayanan STATE ELECTRICAL ENGINEER FOR HIGHWAYS
FHWA	

FORM DEPTH SHALL BE NO MORE THAN 6" BELOW GRADE ON THE LOWER SIDE OF BASE

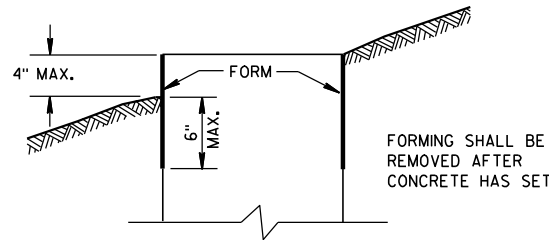

**FORMING DETAIL**

QUANTITY REQUIREMENTS	CONCRETE BASE TYPE		
	1	2	5
APPROX. CUBIC YARDS OF CONCRETE	0.40	0.57	0.40
LBS. OF HOOP BAR STEEL	NONE	23	16
LBS. OF VERTICAL BAR STEEL	NONE	60	18

**GENERAL NOTES**

DETAILS OF CONSTRUCTION, MATERIALS AND WORKMANSHIP NOT SHOWN ON THIS DRAWING SHALL CONFORM TO THE PERTINENT REQUIREMENTS OF THE CONTRACT.

BASES SHALL BE EXCAVATED BY USE OF A CIRCULAR AUGER.

TOP SURFACES OF CONCRETE BASES SHALL BE TROWEL FINISHED SMOOTH AND LEVEL.

CONDUIT SIZES AND LOCATIONS SHALL BE AS SHOWN ON THE PLANS.

THE FINAL OR TERMINATING CONCRETE BASE IN A CONDUIT RUN SHALL HAVE A 6" EXIT STUB INSTALLED FOR FUTURE CABLING USE. THE EXIT STUB SHALL BE SIZED AS USED THROUGHOUT THE CONDUIT RUN AS SHOWN AT THE ENTRANCE OF THE BASE.

MINIMUM BENDING RADIUS OF CONDUIT IS EQUAL TO 6 X THE DIAMETER.

CONDUIT HEIGHT ABOVE CONCRETE BASES SHALL BE 1 INCH. ALL METALLIC CONDUIT ENDS SHALL BE REAMED AND THREADED.

ALL CONDUIT ENDS AT THE TOP OF CONCRETE BASES SHALL BE CAPPED IF METALLIC OR PLUGGED IF NONMETALLIC IMMEDIATELY AFTER PLACEMENT AND BEFORE CONCRETE IS POURED. CONDUITS IN WHICH WIRE OR CABLE IS NOT INSTALLED SHALL REMAIN CAPPED OR PLUGGED.

**GENERAL NOTES (CONTINUED)**

BELL ENDS SHALL BE INSTALLED ON ALL PVC CONDUIT EXPOSED AT THE TOP OF CONCRETE BASES BEFORE INSTALLATION OF CABLE OR WIRE.

ENDS OF CONDUIT INSTALLED BELOW GRADE FOR FUTURE USE SHALL BE CAPPED IF METALLIC OR PLUGGED IF NONMETALLIC.

WHEN REQUIRED TO CONNECT NONMETALLIC CONDUIT TO METALLIC CONDUIT, ONLY ADAPTER FITTINGS, U.L. LISTED FOR ELECTRICAL USE, SHALL BE USED.

IF A BASE REQUIRES A DEEP FORM BECAUSE OF LOOSE DIRT OR FILL, THE FORM SHALL BE REMOVED BEFORE BACKFILLING AROUND THE BASE. BACKFILL SHALL BE TAMPED TIGHT AGAINST THE BARE CONCRETE BASE IN LAYERS OF 1 FOOT OR LESS.

A NO. 4 AWG, STRANDED COPPER EQUIPMENT GROUNDING CONDUCTOR SHALL BE EXOTHERMICALLY WELDED TO THE EQUIPMENT GROUNDING ELECTRODE (GROUND ROD) FOR TYPE 2 AND TYPE 5 BASES.

THE EQUIPMENT GROUNDING CONDUCTOR SHALL BE FURNISHED AND INSTALLED TO ENTER THE BASE OF THE TYPE 2 AND TYPE 5 BASES THROUGH A 1 INCH CONDUIT INSTALLED FOR GROUNDING PURPOSES, LEAVING A 4 FOOT COIL OF WIRE ABOVE THE CONCRETE BASE. THE EQUIPMENT GROUNDING CONDUCTOR SHALL BE NEATLY COILED AND THE COILS TIED TOGETHER.

ANCHOR RODS SHALL BE THREADED 12" IN LENGTH ON EACH END OF THE ROD. ANCHOR RODS SHALL BE MANUFACTURED IN ACCORDANCE WITH SECTION 654.2.1 AND 641.2.2 OF THE STANDARD SPECIFICATIONS, ASTM A-449, OR ASTM A-687 (GRADE 105).




WASHERS AND LOCK WASHERS ARE REQUIRED ON ALL ANCHOR RODS.

WHEN ANCHOR RODS USING THE ALTERNATE "L" BEND ARE FURNISHED, THE 4" "L" BEND SHALL BE IN ADDITION TO THE SPECIFIED ANCHOR ROD BAR LENGTH. THE "L" BEND END SHALL NOT BE THREADED.

ANCHOR RODS SHALL BE INSTALLED WITH MISALIGNMENTS OF LESS THAN 1:40 FROM VERTICAL.

WELDING OF THE ANCHOR RODS TO THE CAGE IS UNACCEPTABLE. TIE WIRES SHALL BE USED.


BAR STEEL REINFORCEMENT SHALL BE COATED WITH POWDERED EPOXY RESIN IN ACCORDANCE WITH SECTION 505 OF THE STANDARD SPECIFICATIONS (LATEST EDITION).

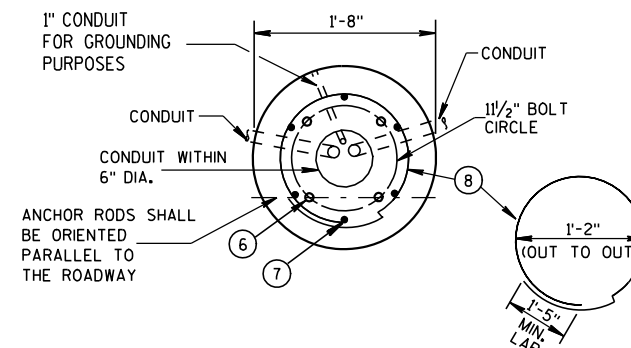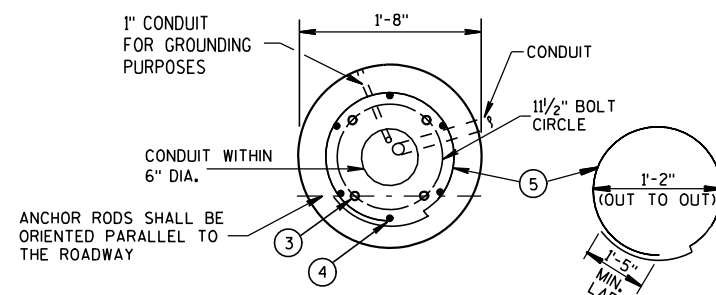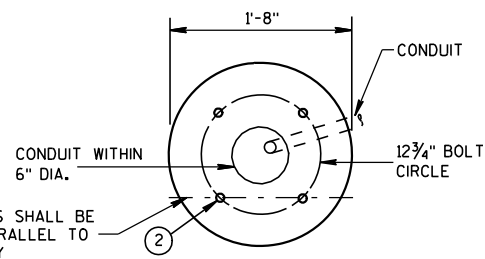

FORM ALL EXPOSED CONCRETE. PROVIDE 1" CHAMFER ALL AROUND

**HALF SECTION IN UNPAVED AREA**  
(TYPICAL FOR TYPES 1, 2 & 5)

**HALF SECTION IN PAVEMENT**  
(TYPICAL FOR TYPES 1, 2 & 5)

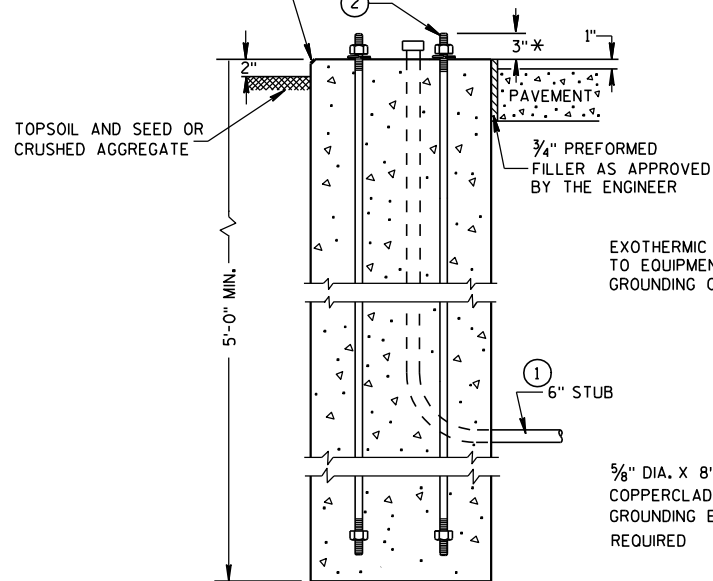


FORM ALL EXPOSED CONCRETE. PROVIDE 1" CHAMFER ALL AROUND

EXOTHERMIC CONNECTION TO EQUIPMENT GROUNDING CONDUCTOR

5/8" DIA. X 8'-0" COPPERCLAD EQUIPMENT GROUNDING ELECTRODE REQUIRED

**TYPE 1**

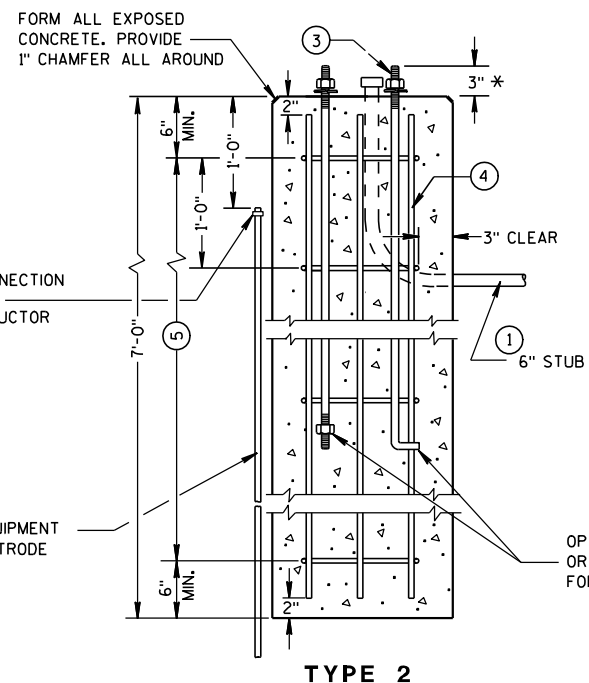

**TYPE 2**


**CONCRETE BASES**

FORM ALL EXPOSED CONCRETE. PROVIDE 1" CHAMFER ALL AROUND

EXOTHERMIC CONNECTION TO EQUIPMENT GROUNDING CONDUCTOR

5/8" DIA. X 8'-0" COPPERCLAD EQUIPMENT GROUNDING ELECTRODE REQUIRED

OPTIONAL 4" L BEND OR HEX NUT (TYPICAL FOR TYPES 1, 2 & 5)

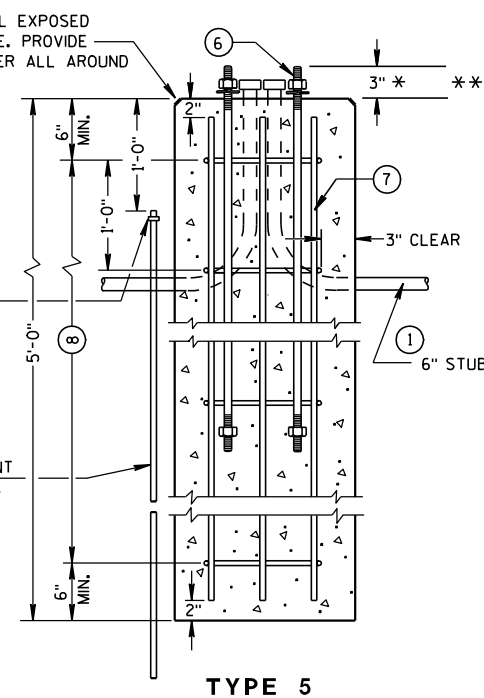

**TYPE 5**


① THE MINIMUM DEPTH OF CONDUIT EXITING THE CONCRETE BASE AND INSTALLED BELOW THE TRAVELED WAY SHALL BE 24 INCHES. THE MINIMUM DEPTH OF CONDUIT EXITING THE CONCRETE BASE THAT IS NOT INSTALLED BELOW THE TRAVELED WAY SHALL BE 18 INCHES. THE MAXIMUM DEPTH OF ALL CONDUIT SHALL BE 36 INCHES EXCEPT WITH WRITTEN APPROVAL BY THE ENGINEER.

- ② (4) 1" DIA. X 3'-6" ANCHOR RODS.
- ③ (4) 1" DIA. X 5'-0" ANCHOR RODS.
- ④ (6) NO. 6 X 6'-8" BAR STEEL REINFORCEMENT.
- ⑤ (7) NO. 4 X 5'-1" BAR STEEL REINFORCEMENT @ 1'-0" C-C.
- ⑥ (4) 1" DIA. X 3'-6" ANCHOR RODS.
- ⑦ (6) NO. 4 X 4'-8" BAR STEEL REINFORCEMENT.
- ⑧ (5) NO. 4 X 5'-1" BAR STEEL REINFORCEMENT @ 1'-0" C-C.

\* ANY ANCHOR ROD PROJECTION SHORTER THAN 2 3/4" OR LONGER THAN 3/4" SHALL REQUIRE THE BASE TO BE REMOVED AND REPLACED AT THE CONTRACTORS EXPENSE.

\*\* FOR NONBREAKAWAY INSTALLATIONS, 4 1/2" ± ANCHOR ROD PROJECTION WITH THE USE OF LEVELING NUTS. RODENT SCREEN REQUIRED.

<b>CONCRETE BASES, TYPES 1, 2 &amp; 5</b>	
STATE OF WISCONSIN DEPARTMENT OF TRANSPORTATION	
APPROVED 3/3/10 DATE	/s/ Joanna L. Bush STATE ELECTRICAL ENGINEER FOR HIGHWAYS
FHWA	

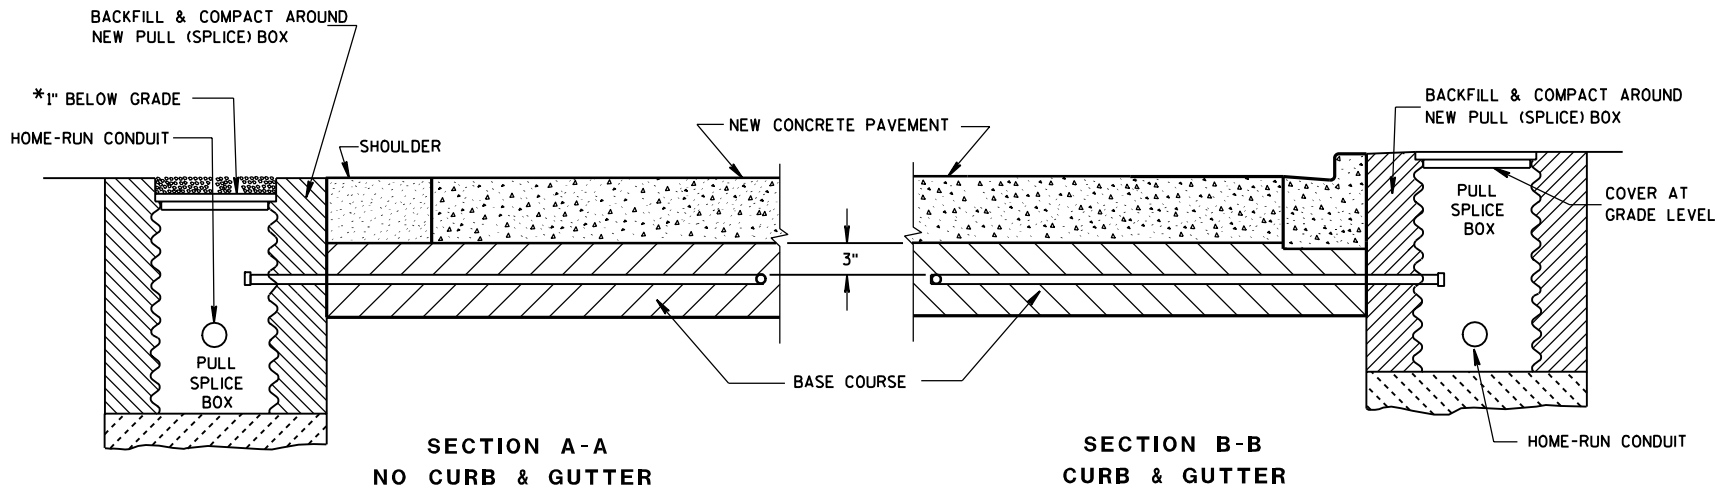

\*RECESS PULL (SPlice) BOX SO THAT THE COVER IS 3" BELOW GRADE IN SHOULDER AREAS OF CRUSHED AGGREGATE. BACKFILL OVER COVER WITH THE CRUSHED AGGREGATE TO BRING THE AREA TO GRADE LEVEL.

**LOOP DETECTOR INSTALLATION DETAIL**

**GENERAL NOTES**

DETAILS OF CONSTRUCTION, MATERIALS AND WORKMANSHIP NOT SHOWN ON THIS DRAWING SHALL CONFORM TO THE PERTINENT REQUIREMENTS OF THE CONTRACT.

LOOP SIZE, CONFIGURATION LOCATION, NUMBER OF TURNS OF WIRE AND ASSOCIATED SIGNAL PHASE SHALL BE AS SHOWN ON THE PLANS.

PITCH LEAD OUT CONDUIT TO DRAIN TO ROADSIDE PULL (SPlice) BOX.

SPLICES SHALL BE INSTALLED BY USING CAST IN PLACE SPLICE KITS SUCH AS 3M TYPE B2A1 OR APPROVED EQUAL. NON-INSULATED BUTT SPLICES TO FIT #12 AWG STRANDED WIRE SHALL BE USED. SPLICES SHALL BE SOLDERED AND INSULATED FROM EACH OTHER AS PER INSTRUCTIONS INCLUDED IN THE SPLICE KIT.

MEASURE GROUND RESISTANCE USING A MEGGER. REPLACE LOOP WIRE NOT ATTAINING A READING OF INFINITY TO GROUND.

AFTER SPLICING THE LOOP WIRE TO THE LOOP LEAD-IN CABLE, THE CONTRACTOR SHALL MEASURE INDUCTANCE, GROUND RESISTANCE AND WIRE RESISTANCE AT THE CABINET END OF THE LEAD-IN CABLE AND FURNISH A COPY OF THE READINGS TO THE PROJECT ENGINEER FOR EVALUATION.

LOOP DETECTOR LEADS SHALL BE IDENTIFIED WITH THEIR ASSOCIATED LOOP BY USE OF WATERPROOF TAGS AT BOTH ENDS OF THE CABLE. A LISTING OF THE CABLE IDENTIFICATION PER INDIVIDUAL LOOP LEAD-IN SHALL BE PLACED IN THE CABINET.


THE #12 AWG LOOP WIRE IN THE PULL (SPlice) BOX SHALL BE HAND TWISTED AT LEAST 3 TWISTS PER FOOT BEFORE BEING SPLICED TO THE LOOP LEAD-IN CABLE.

SPLICES OF LOOP WIRE TO LEAD-IN CABLE SHALL BE MADE ONLY IN PULL (SPlice) BOXES AT THE SIDE OF THE ROAD.

THE #12 AWG LOOP WIRE SHALL BE INSTALLED FROM THE ROADSIDE PULL (SPlice) BOX THROUGH THE LOOP CONDUIT, BACK TO THE ROADSIDE PULL (SPlice) BOX, AND BE INSTALLED IN ONE, NON-SPLICE CONTINUOUS LENGTH.





PROTECTION OF THE CONDUIT IN THE BASE COURSE, SHALL BE REQUIRED AFTER INSTALLATION AND BEFORE NEW PAVEMENT IS INSTALLED.

SHOULD INSTALLATION REPAIR BE REQUIRED, IT SHALL BE DONE UNDER THE DIRECTION OF THE PROJECT ENGINEER.



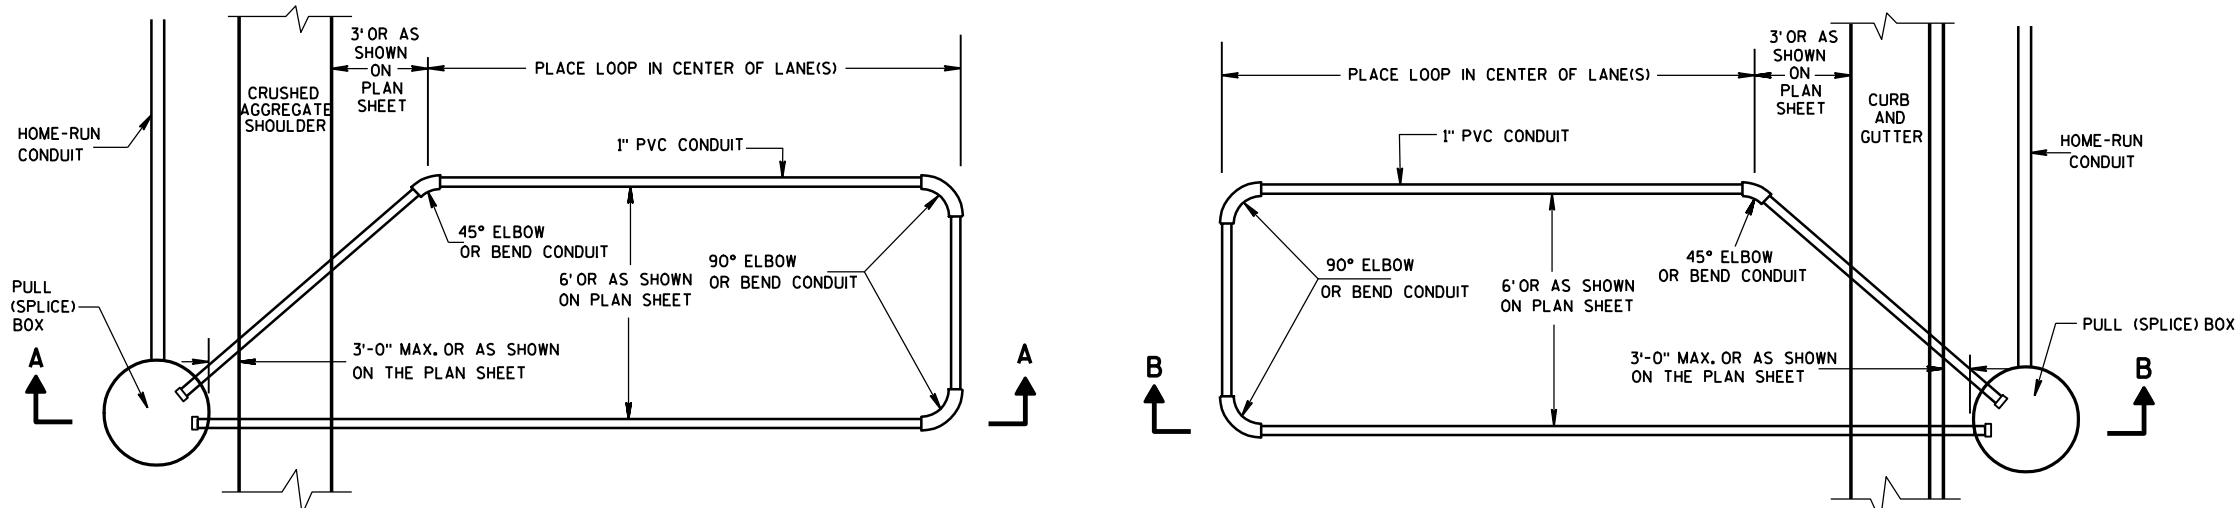


**TYPICAL PLAN OF LOOP DETECTOR WITH 18" OR 24" PULL (SPlice) BOX**



<b>LOOP DETECTOR INSTALLED IN BASE COURSE WITH PULL (SPlice) BOX OFF ROADWAY (OPTION I)</b>	
STATE OF WISCONSIN DEPARTMENT OF TRANSPORTATION	
APPROVED 6/7/06 DATE	/S/ Balu Ananthanarayanan STATE ELECTRICAL ENGINEER FOR HIGHWAYS

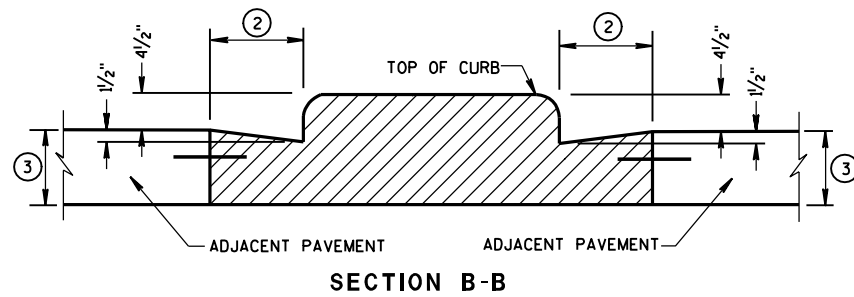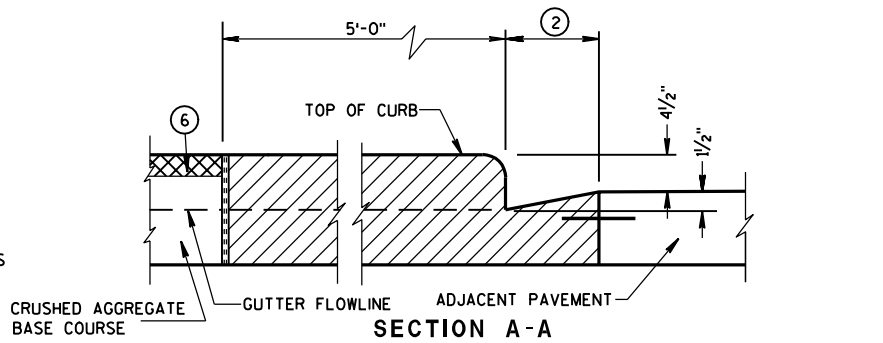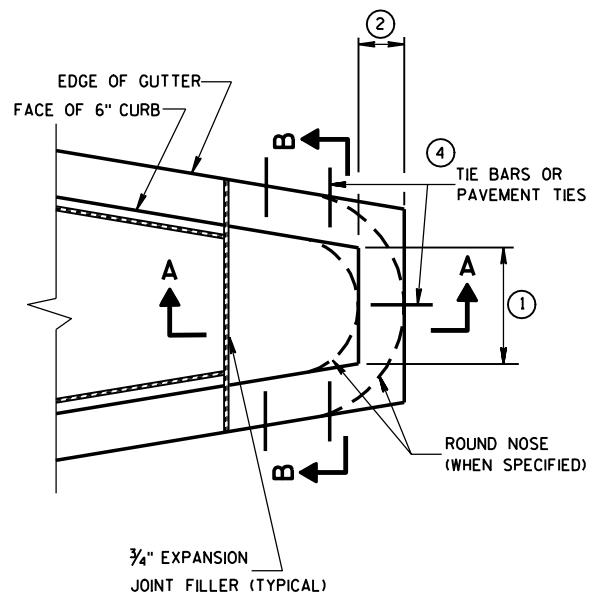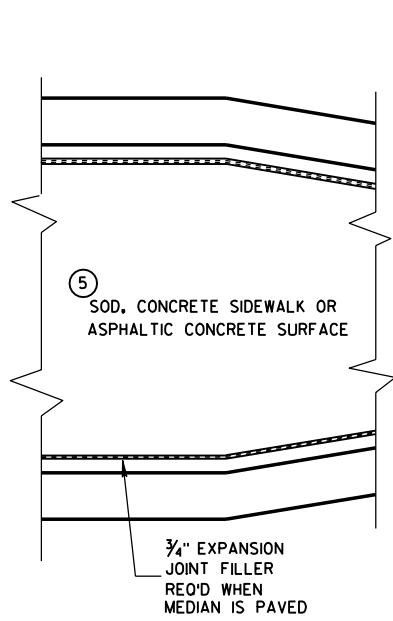


CONCRETE MEDIAN BLUNT NOSE DETAIL

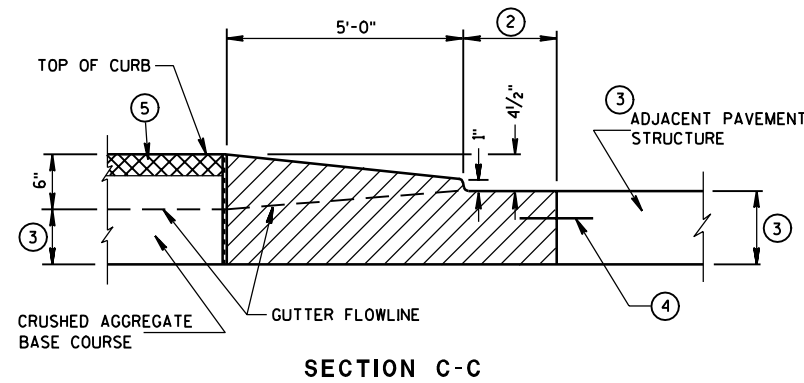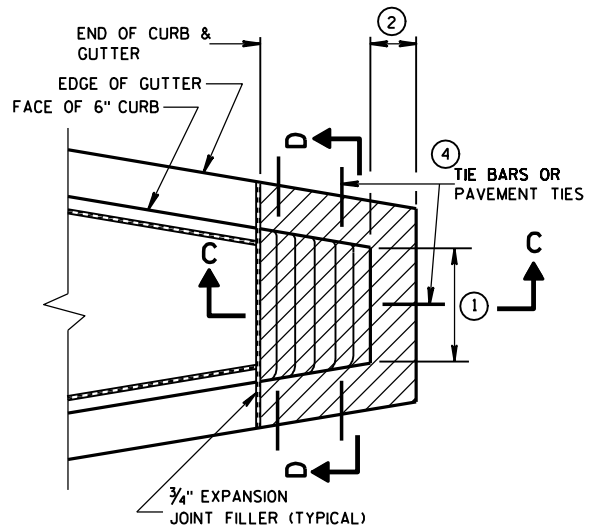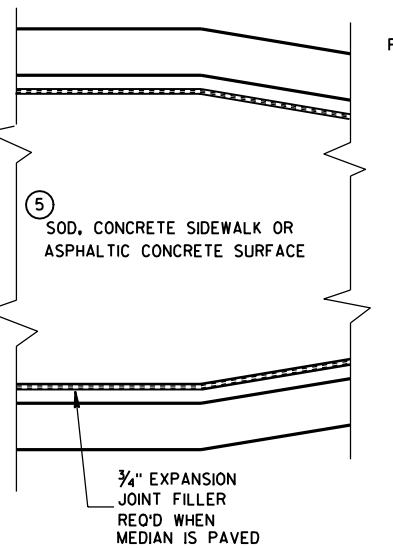

CONCRETE MEDIAN SLOPED NOSE TYPE 1

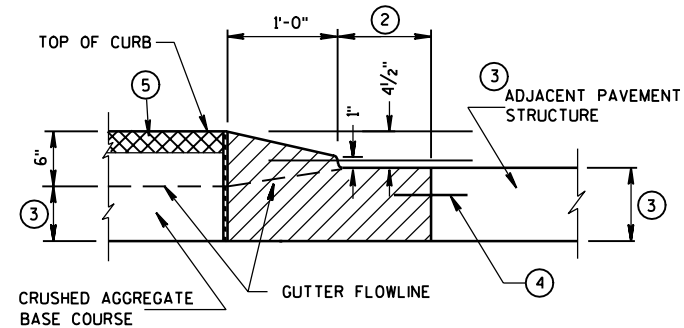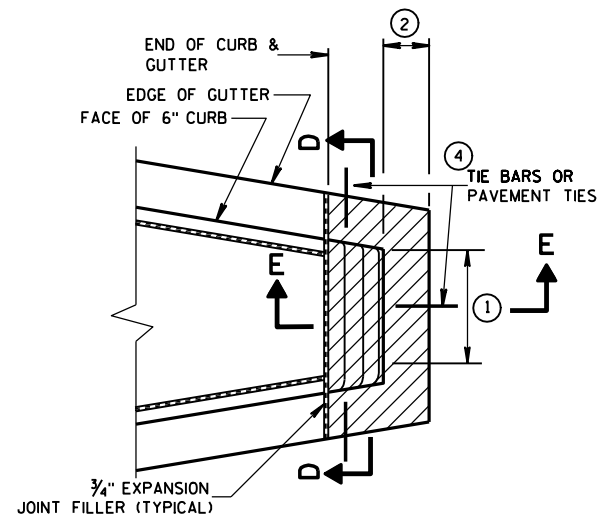

CONCRETE MEDIAN SLOPED NOSE TYPE 2

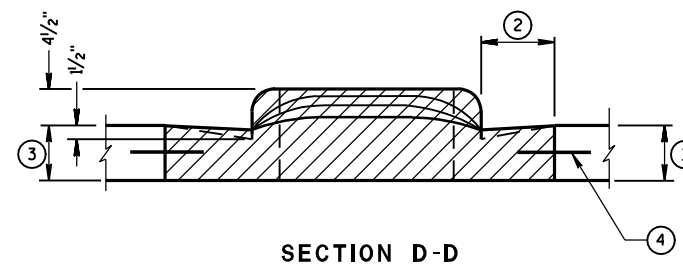

SECTION D-D

**GENERAL NOTES**

DETAILS OF CONSTRUCTION, MATERIALS AND WORKMANSHIP NOT SHOWN ON THIS DRAWING SHALL CONFORM TO THE PERTINENT REQUIREMENTS OF THE STANDARD SPECIFICATIONS AND THE APPLICABLE SPECIAL PROVISIONS.


- ① SEE PLAN FOR MEDIAN NOSE WIDTH AND RADIUS (FOR ROUND NOSE ALTERNATE).
- ② WIDTH OF GUTTER TO MATCH EXISTING ADJACENT GUTTER OR AS SPECIFIED ELSEWHERE IN THE PLAN.
- ③ DEPTH EQUAL TO ADJACENT PAVEMENT. ADJACENT PAVEMENT STRUCTURE DETAILS ARE SHOWN ON THE PLAN. TYPICAL OPTIONS ARE:

- (1) NEW OR EXISTING CONCRETE PAVEMENT.
- (2) ASPHALTIC CONCRETE PAVEMENT OVER NEW OR EXISTING CONCRETE BASE COURSE.
- (3) ASPHALTIC CONCRETE PAVEMENT OVER CRUSHED AGGREGATE BASE COURSE.

- ④ TIE BARS OR PAVEMENT TIES REQUIRED IN NEW CONCRETE PAVEMENT OR CONCRETE BASE COURSE. TIE BARS SHALL BE NO. 4 X 2'-0" SPACED AT 2'-0" C-C.
- PAVEMENT TIES REQUIRED IN EXISTING CONCRETE BASE COURSE. PAVEMENT TIES SHALL BE NO. 6 X 1'-0" SPACED AT 3'-0" C-C INSTALLED ON A HORIZONTAL SKEW OF 6:1. THE DIRECTION OF SKEW SHALL ALTERNATE AFTER EVERY ONE OR TWO BARS.

- ⑤ SURFACE TYPE AND DETAILS ARE SHOWN ELSEWHERE IN THE PLAN.

<b>CONCRETE MEDIAN NOSE</b>	
STATE OF WISCONSIN DEPARTMENT OF TRANSPORTATION	
APPROVED 6/8/06 DATE	/S/ Jerry H. Zogg ROADWAY STANDARDS DEVELOPMENT ENGINEER
FHWA	

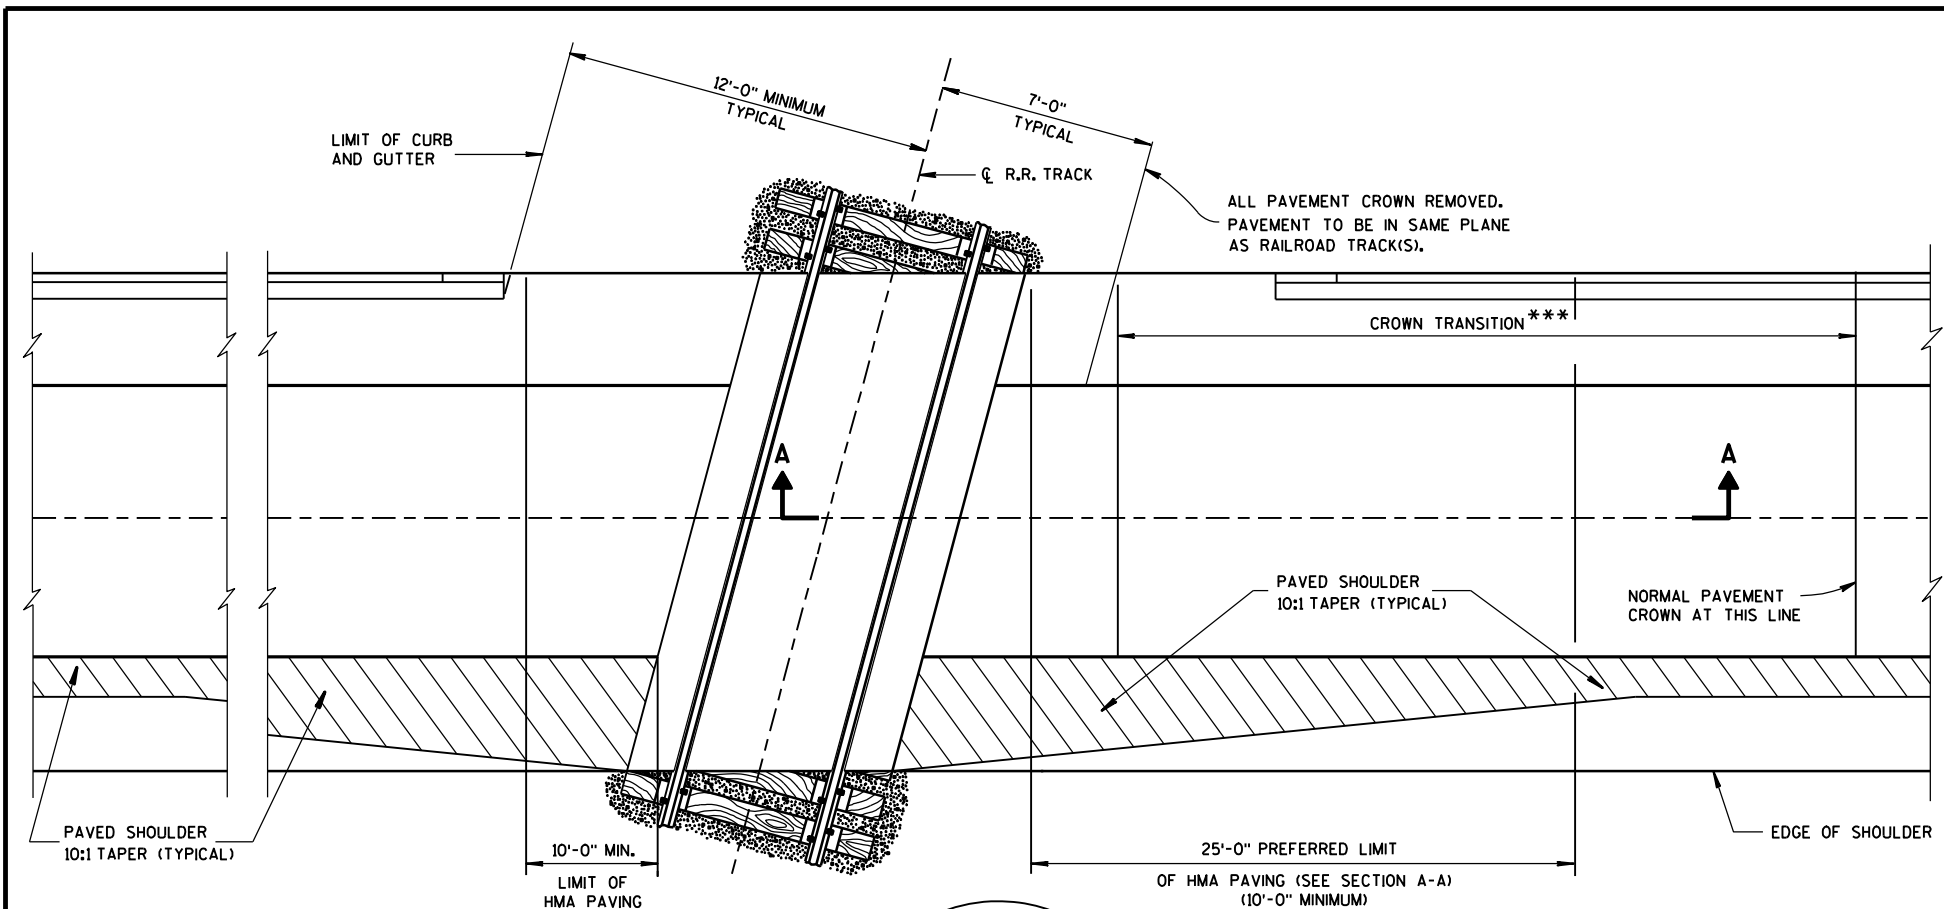

**URBAN**

**RURAL**

**GENERAL NOTES**

DETAILS OF CONSTRUCTION, MATERIALS AND WORKMANSHIP NOT SHOWN ON THIS DRAWING SHALL CONFORM TO THE PERTINENT REQUIREMENTS OF THE STANDARD SPECIFICATIONS AND THE APPLICABLE SPECIAL PROVISIONS.

TIMBER, CONCRETE OR RUBBER CROSSING SURFACE MATERIAL, RAILS, TIES, BALLAST, GEOTEXTILE FABRIC AND CROSSING DRAINAGE SYSTEM BY OTHERS UNLESS OTHERWISE PROVIDED.


HMA PAVEMENT APPROACHES AND HMA PAVEMENT CROSSING SURFACES TO BE PLACED BY CONTRACTOR UNLESS OTHERWISE PROVIDED.

HMA FLANGEWAY AND FIELD FILLERS TO BE PLACED AND THOROUGHLY HAND COMPACTED BY THE CONTRACTOR WHEN NOT PROVIDED BY OTHERS. SEE DETAIL B. HMA FILLERS NOT REQUIRED WHEN RUBBER FILLERS ARE PROVIDED.


HMA PAVEMENT SHALL BE ROLLED PARALLEL TO THE TRACK.

\*\* CROSSING SURFACE MAY BE TIMBER, RUBBER, CONCRETE, HMA PAVEMENT OR A COMBINATION OF SUCH MATERIALS.


\*\*\* CROWN TRANSITION LENGTH SHOWN ELSEWHERE IN THE PLAN.

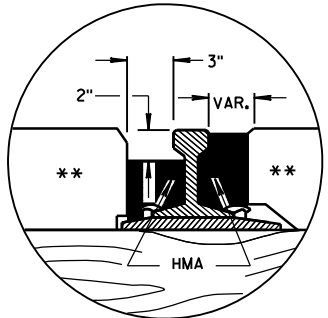


**DETAIL B**  
**HMA FLANGEWAY AND FIELD FILLERS**

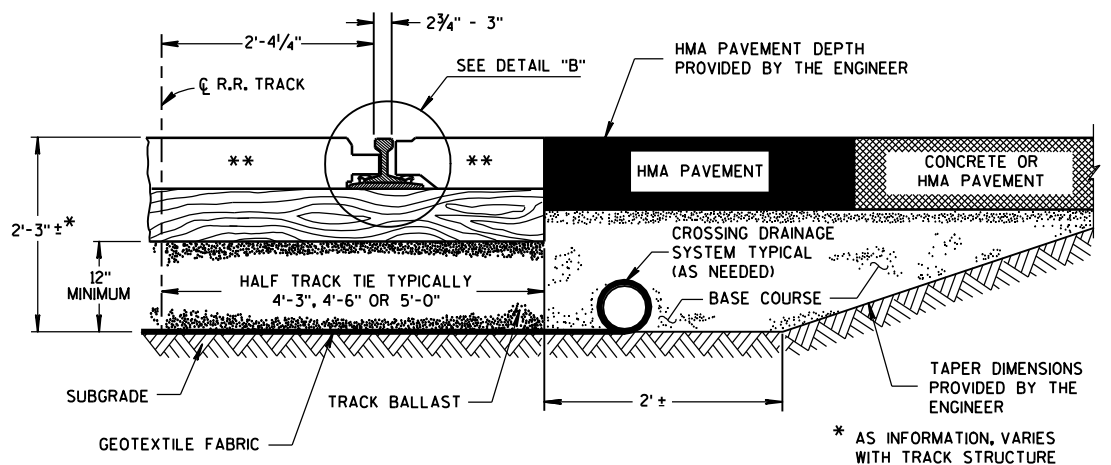

**TYPICAL HALF SECTION**

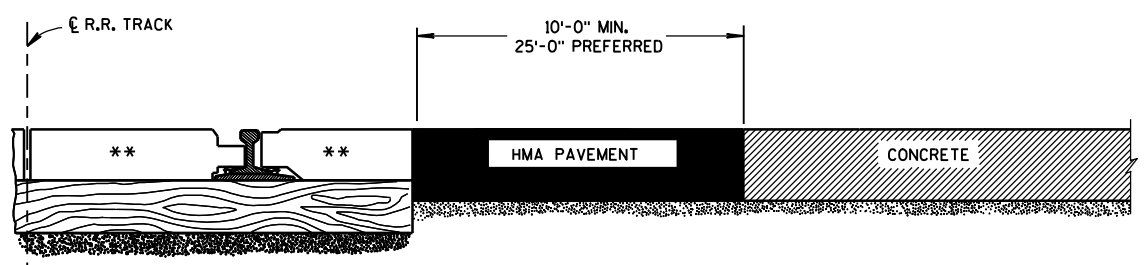

**SECTION A-A**  
**CONCRETE PAVEMENT APPROACH**

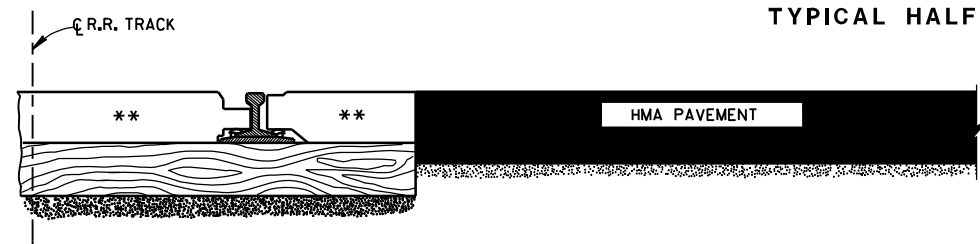

**SECTION A-A**  
**HMA PAVEMENT APPROACH**

**EXAMPLES OF PAVEMENT APPROACHES**

<b>PAVEMENT DETAILS FOR RAILROAD APPROACH</b>	
STATE OF WISCONSIN DEPARTMENT OF TRANSPORTATION	
APPROVED 8-28-09 DATE	/S/ Ronald E. Adams CHIEF, RAILROADS & HARBORS SECTION
FHWA	


6

6


S.D.D. 13 B 1-10

S.D.D. 13 B 1-10



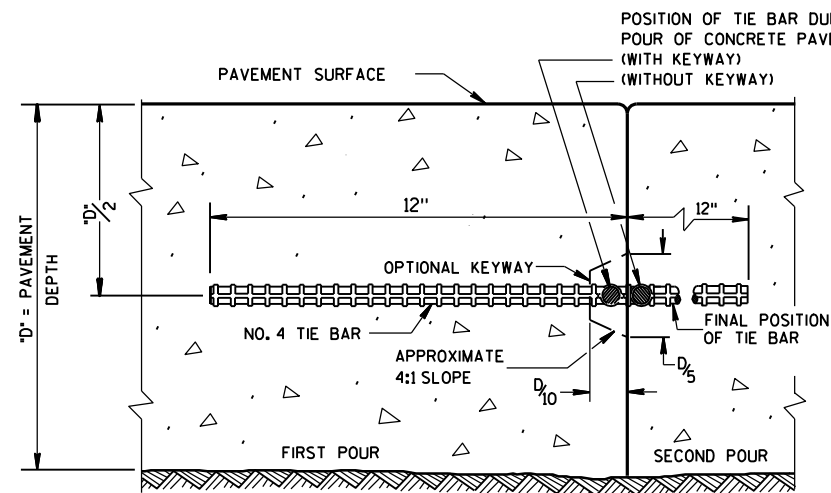


**CONSTRUCTION JOINT**

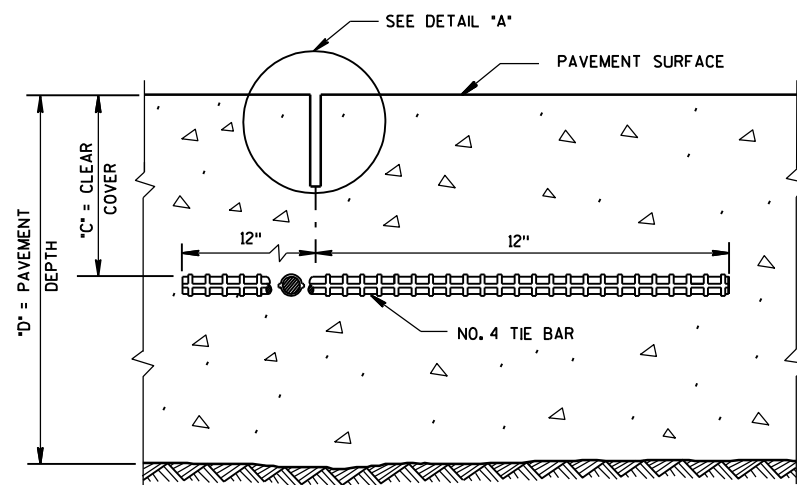

**SAWED JOINT**


**GENERAL NOTES**

- DO NOT SEAL OR FILL LONGITUDINAL JOINTS.
- ① ANCHOR TIE BARS INTO DRILLED HOLES WITH AN EPOXY.

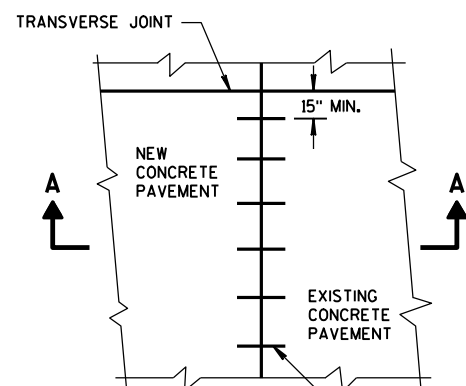


**PLAN VIEW**

NO. 6 TIE BARS SPACED 2'-6" C-C, INSTALLED PERPENDICULAR TO THE LONGITUDINAL JOINT. ①

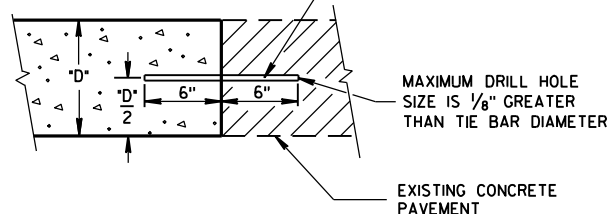


**SECTION A-A  
LONGITUDINAL CONSTRUCTION JOINT  
TIE BARS ANCHORED  
INTO EXISTING PAVEMENT**

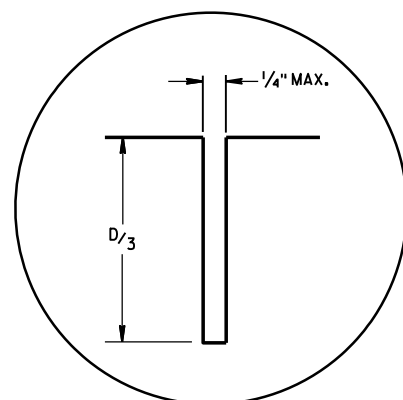


**DETAIL "A"**

PAVEMENT DEPTH "D"	CLEAR COVER "C"	MAXIMUM TIE BAR SPACING "S"	
		PAVEMENT WIDTH 24' OR 26'	≥ 30'
6, 6 1/2"	3" ± 1/2"	48"	42"
7, 7 1/2"	3 1/4" ± 1"	45"	36"
8, 8 1/2"	3 3/4" ± 1"	39"	30"
9, 9 1/2"	4 1/4" ± 1"	33"	27"
10, 10 1/2"	4 3/4" ± 1"	30"	24"
11, 11 1/2"	5 1/4" ± 1"	27"	21"
12"	5 3/4" ± 1"	24"	21"

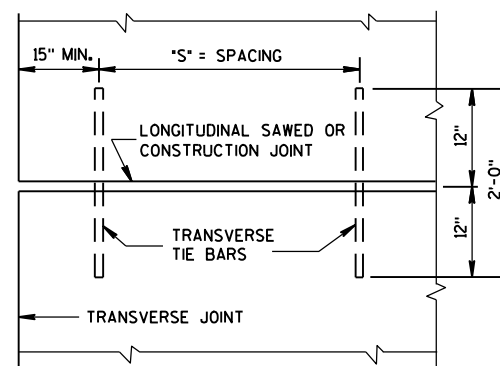

**PLAN VIEW  
SHOWING LOCATION OF TIE BARS**

<b>CONCRETE PAVEMENT LONGITUDINAL JOINTS AND TIES</b>	
STATE OF WISCONSIN DEPARTMENT OF TRANSPORTATION	
APPROVED 12/11/2009 DATE	/s/ Deb Bischoff PAVEMENT POLICY & DESIGN ENGINEER
FHWA	

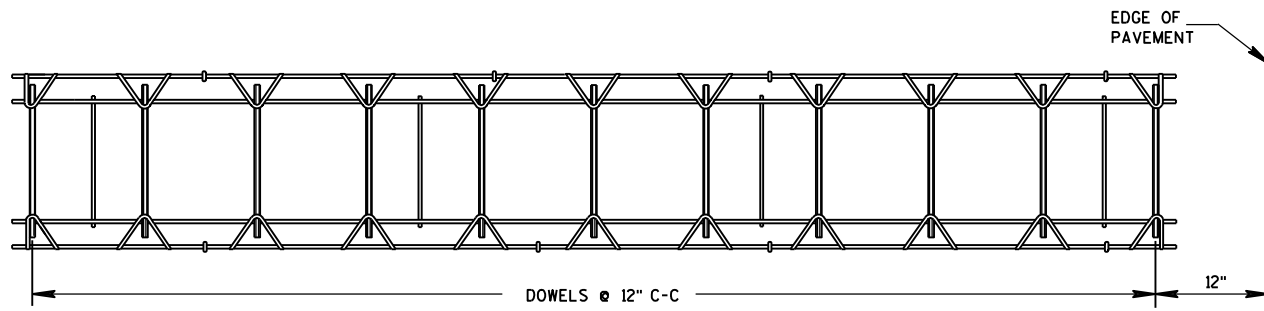

PLAN VIEW




SIDE VIEW


CONTRACTION JOINT DOWEL ASSEMBLY

PAVEMENT DEPTH, DOWEL BAR SIZE AND JOINT SPACING TABLE


PAVEMENT DEPTH (D)	DOWEL BAR DIAMETER	CONTRACTION JOINT SPACING
5 1/2", 6", 6 1/2"	NONE	12'
7", 7 1/2"	1"	14'
8", 8 1/2"	1 1/4"	15'
9", 9 1/2"	1 1/4"	15'
10" & ABOVE	1 1/2"	15'

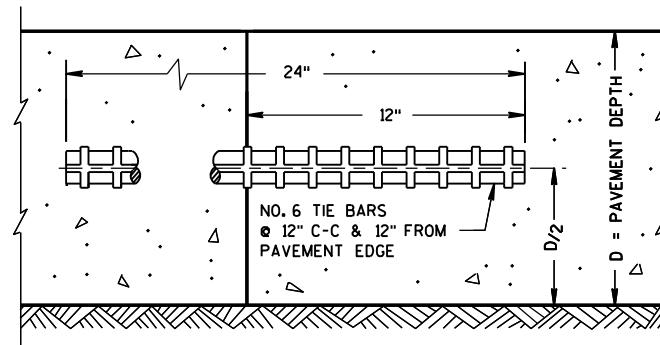


TRANSVERSE CONSTRUCTION JOINT

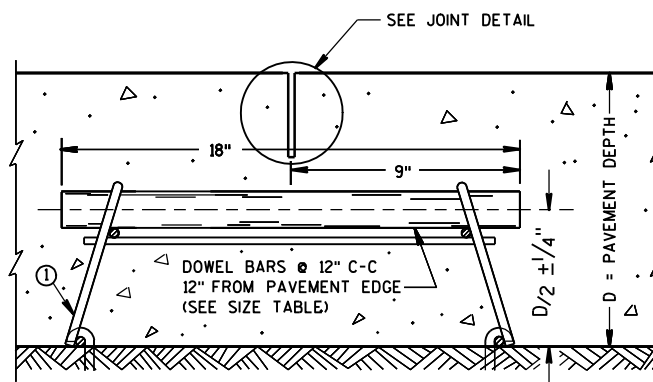


DOWELED CONTRACTION JOINT

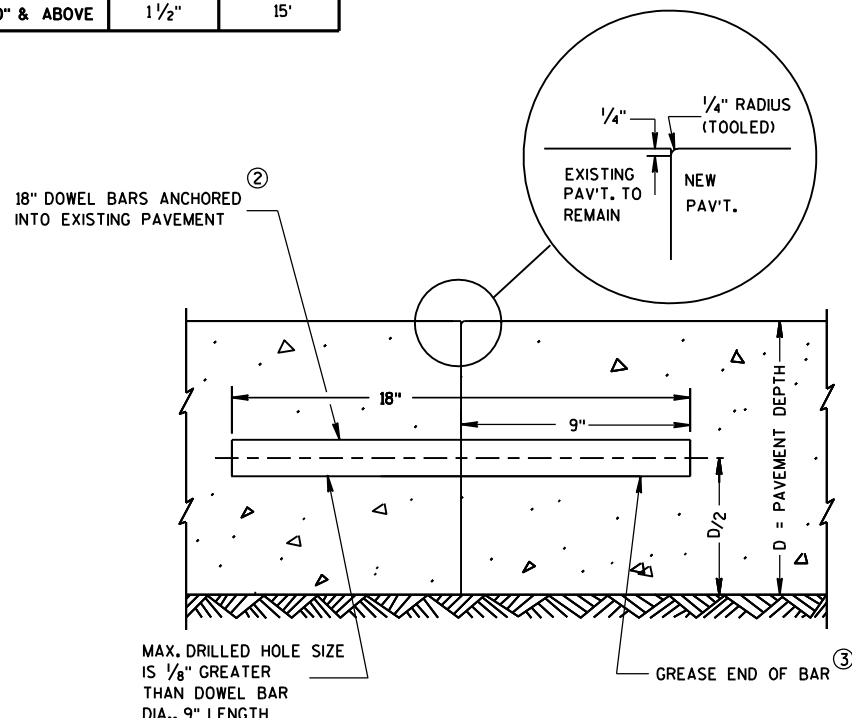

TRANSVERSE CONTRACTION JOINTS ABUTTING EXISTING PAVEMENT  
DOWEL BAR DETAIL

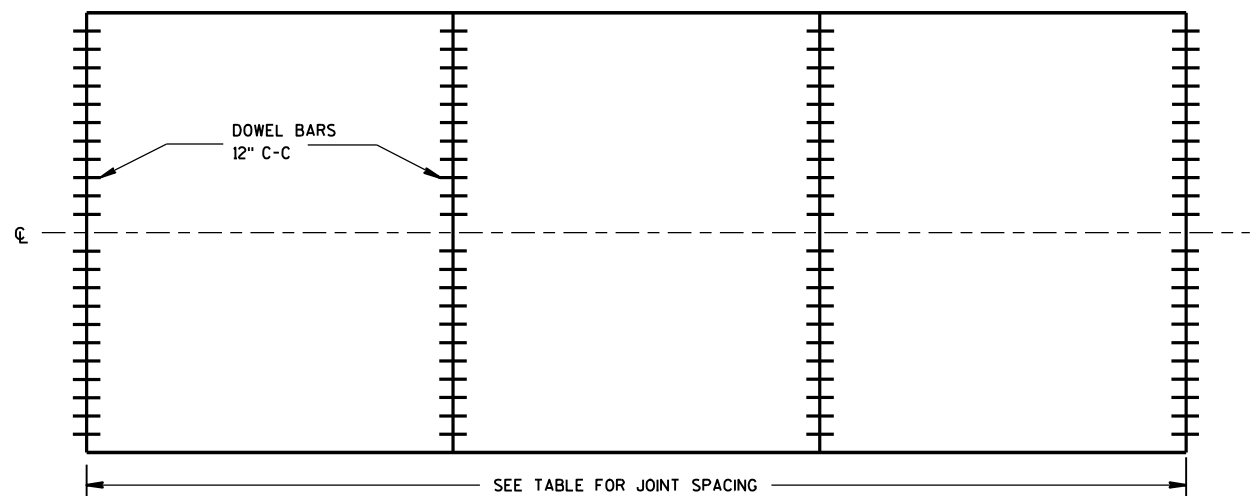

CONTRACTION JOINT LOCATIONS

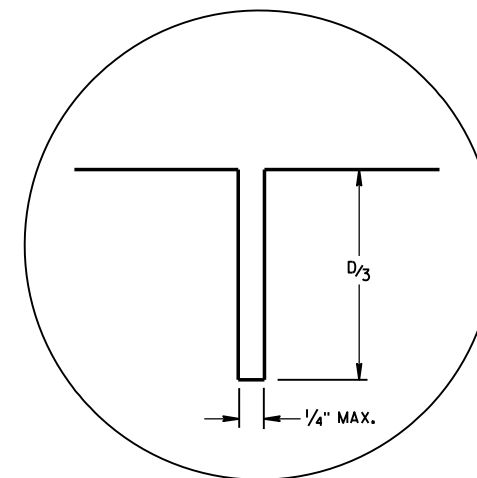

JOINT DETAIL

GENERAL NOTES

CONTRACTION JOINTS

CONSTRUCT CONTRACTION JOINTS NORMAL TO THE CENTERLINE. SHOW THE LOCATION OF CONTRACTION JOINTS THROUGH INTERSECTIONS ON THE PLANS OR AS DIRECTED BY THE ENGINEER.

DO NOT SEAL OR FILL CONTRACTION JOINTS.

INSTALL DOWEL BARS PARALLEL TO THE PAVEMENT CENTERLINE AND PAVEMENT SURFACE.

FOR PAVEMENT SLABS OF VARYING WIDTHS, CENTER THE DOWEL ASSEMBLY ACROSS THE LANES. LOCATE THE INNER AND OUTER MOST DOWEL BARS SO THAT THE CENTER OF THE BARS ARE A MINIMUM OF 6 INCHES AND A MAXIMUM OF 12 INCHES FROM THE LONGITUDINAL JOINT AND THE EDGE OF PAVEMENT.

CONSTRUCTION JOINTS

LOCATE CONSTRUCTION JOINTS A MINIMUM OF 4 FEET FROM THE NEAREST CONTRACTION JOINT AND ALIGN PARALLEL TO CONTRACTION JOINTS.


THE CONTRACTOR MAY INSERT TIE BARS THROUGH THE HEADER BOARD AFTER THE CONCRETE HAS BEEN PLACED.

- ① THE ENGINEER MAY APPROVE THE USE OF ALTERNATIVE DESIGNS OF THE DOWEL ASSEMBLY. THE CONTRACTOR MAY USE MECHANICAL DOWEL BAR INSERTERS INSTEAD OF DOWEL ASSEMBLIES.
- ② ANCHOR DOWEL BARS INTO DRILLED HOLES WITH AN EPOXY.
- ③ APPLY A THIN UNIFORM COATING OF SURFACE TREATMENT TO THE FREE END OF DOWEL BARS TO PREVENT BONDING.
- ④ SPACE DOWEL BARS INSTALLED BY DRILLING 1'-3" ON CENTER. CENTER THE GROUPING OF DOWEL BARS INSIDE THE SLAB BASED ON ALL THE FOLLOWING SITUATIONS:  
  
BETWEEN THE EDGES OF PAVEMENTS WITHOUT LONGITUDINAL JOINTS OR BETWEEN THE EDGE OF PAVEMENT AND NEAREST LONGITUDINAL JOINT OR BETWEEN TWO ADJACENT LONGITUDINAL JOINTS.
- ⑤ SECURE BASKETS WITH ANCHORS TO HOLD DOWEL BARS IN THE CORRECT POSITION AND ALIGNMENT. TYPE, LOCATION, NUMBER AND LENGTH OF ANCHORS ARE DEPENDENT UPON FIELD CONDITIONS.

**URBAN DOWELED  
CONCRETE PAVEMENT**


STATE OF WISCONSIN  
DEPARTMENT OF TRANSPORTATION

APPROVED  
12/11/2009 /S/ Deb Bischoff  
DATE PAVEMENT POLICY & DESIGN ENGINEER  
FHWA

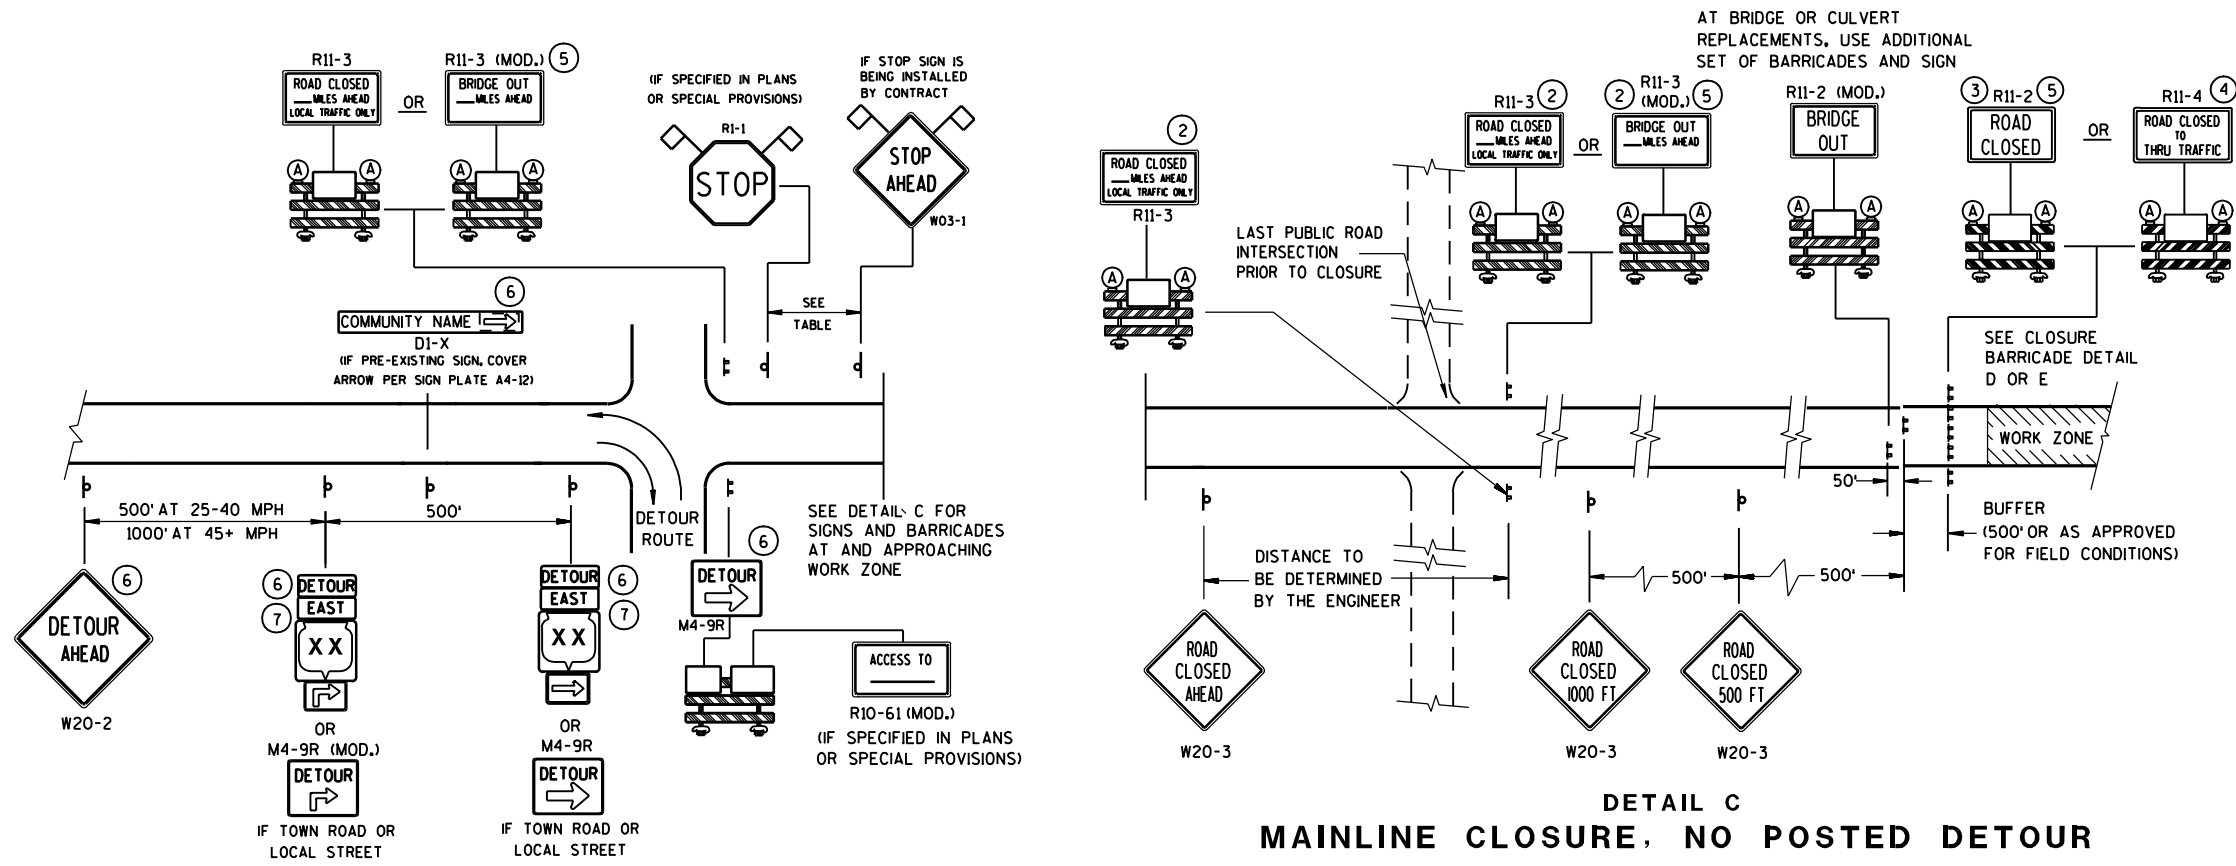

**DETAIL A**  
**MAINLINE CLOSURE WITH POSTED DETOUR**  
 WORK ZONE GREATER THAN 1/2 MILE FROM DETOUR ROUTE (1000 FEET IF URBAN)

**DETAIL C**  
**MAINLINE CLOSURE, NO POSTED DETOUR**

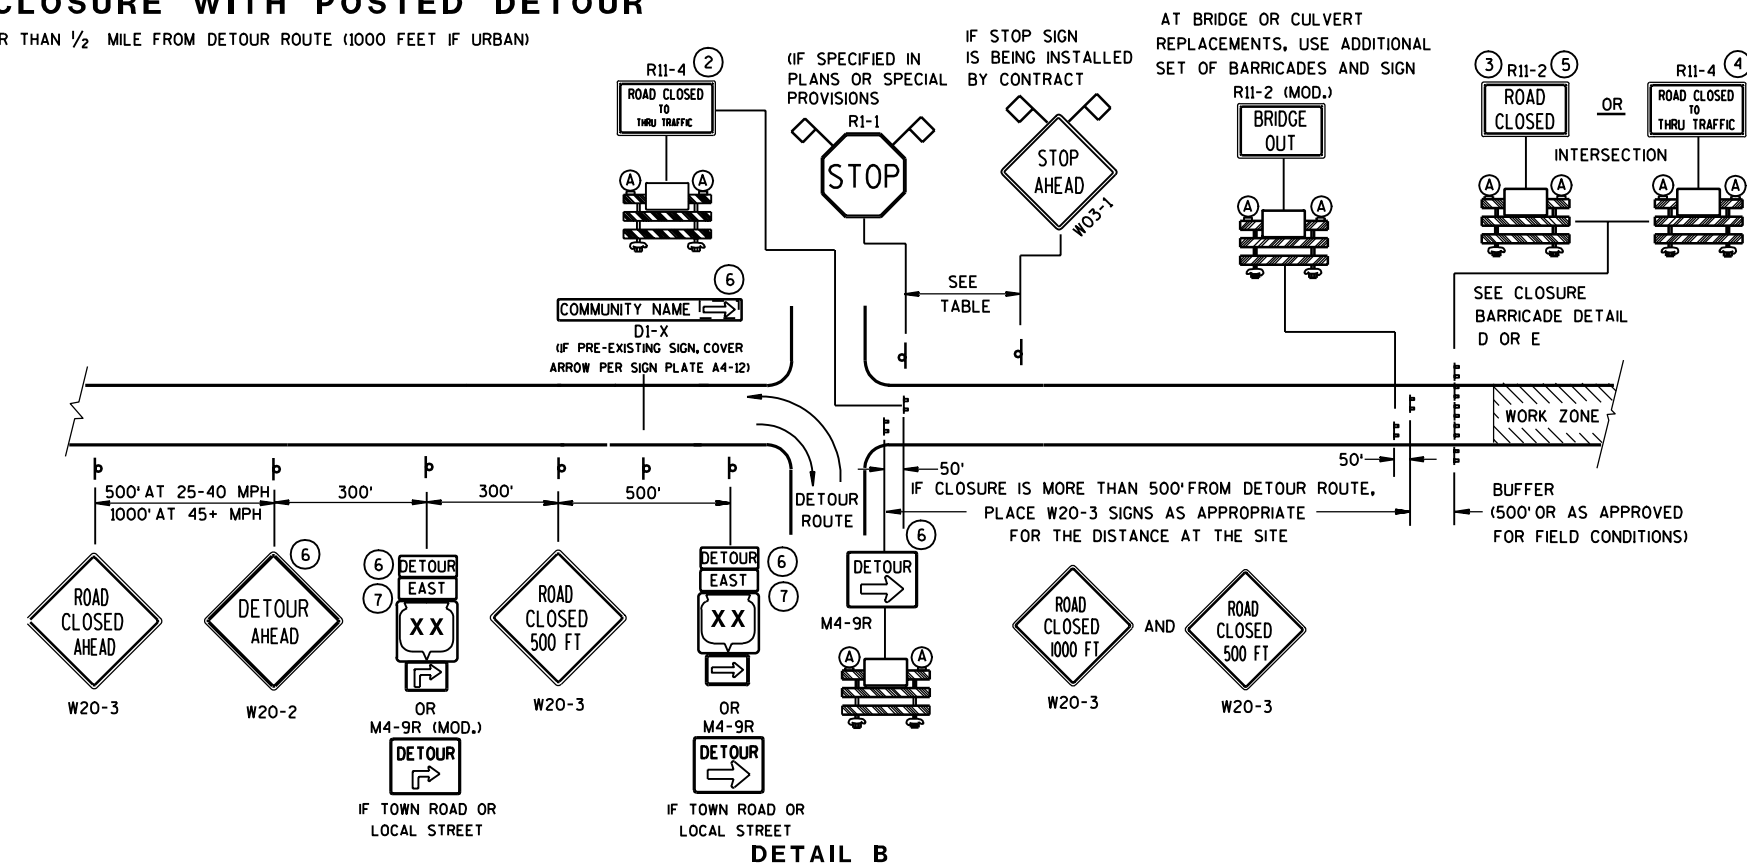

**DETAIL B**  
**MAINLINE CLOSURE WITH POSTED DETOUR**  
 WORK ZONE LESS THAN 1/2 MILE FROM DETOUR ROUTE (1000 FEET IF URBAN)

- LEGEND**
- ⌋ POST MOUNTED SIGN
  - ⌋ TYPE III BARRICADES
  - Ⓐ TYPE "A" LOW INTENSITY FLASHING WARNING LIGHT (FOR NIGHT USE)
  - ▨ WORK ZONE
  - DETOUR EAST M4-8 M3-X
  - XX OR COUNTY XX OR XX M1-4 M1-5A M1-6
  - OR M05-1 M06-1
  - ◇ FLAGS, 16" X 16" MIN., (ORANGE)


**BARRICADES AND SIGNS FOR MAINLINE CLOSURES**  
 STATE OF WISCONSIN  
 DEPARTMENT OF TRANSPORTATION

6


6

S.D.D. 15 C 2-40

S.D.D. 15 C 2-40

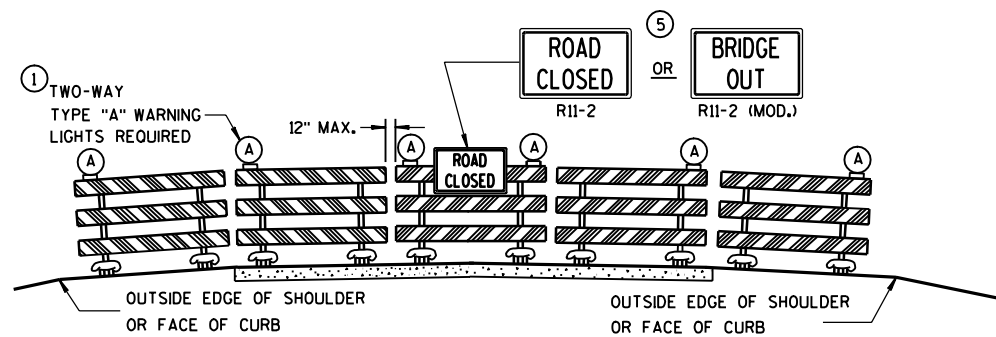

**DETAIL D**  
**ROAD CLOSURE BARRICADE DETAIL**  
 APPROACH VIEW

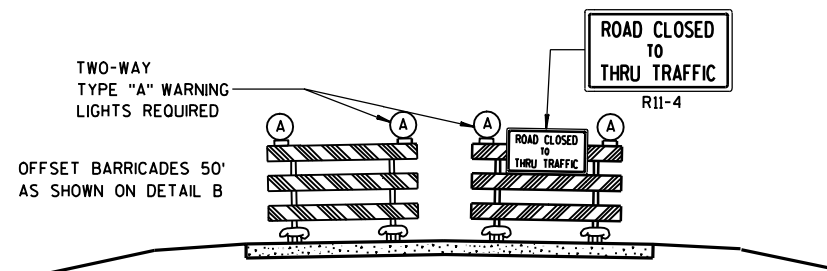

**DETAIL E**  
**LANE CLOSURE BARRICADE DETAIL**  
 APPROACH VIEW

SEE SDD 15C2-4a FOR LEGEND

**GENERAL NOTES**

THE EXACT NUMBER, LOCATION, AND SPACING OF ALL SIGNS AND BARRICADES SHALL BE ADJUSTED TO FIT FIELD CONDITIONS AS APPROVED BY THE ENGINEER.

ANY SIGNS TEMPORARY OR EXISTING, WHICH CONFLICT WITH TRAFFIC CONTROL "IN USE" SHALL BE REMOVED OR COVERED AS NEEDED AND AS APPROVED BY THE ENGINEER.

THE SPACING BETWEEN TRAFFIC CONTROL SIGNS SHOULD BE ADJUSTED TO NOT CONFLICT WITH AND SHOULD PROVIDE A DESIRABLE MINIMUM OF 200 FEET CLEARANCE TO EXISTING SIGNS THAT WILL REMAIN IN PLACE.

BARRICADES THAT MUST BE MOVED FOR A WORK OPERATION SHALL BE IMMEDIATELY RE-ESTABLISHED UPON COMPLETION OF THE OPERATION OR, FOR CONTINUING OPERATIONS, AT THE END OF EACH WORKING DAY.

SIGNS THAT WILL BE IN PLACE LESS THAN 7 CONTINUOUS DAYS AND NIGHTS MAY BE MOUNTED ON PORTABLE SUPPORTS.

ALL TYPE III BARRICADES SHALL HAVE RAILS REFLECTORIZED ON BOTH FACES. STRIPES SHALL BE PROPERLY SLOPED DOWN TOWARD THE TRAFFIC SIDE OR AS SHOWN IN THE ROAD CLOSURE BARRICADE DETAIL D FOR FULL ROAD CLOSURES.

TYPE "A" LOW-INTENSITY FLASHING WARNING LIGHTS SHALL BE VISIBLE ON BOTH SIDES OF THE BARRICADE.

THE R11-2, R11-3, M4-9, R11-4 AND R10-61 SIGNS PLACED ON BARRICADES SHALL COVER NO MORE THAN THE TOP RAIL. THE SIGNS SHALL NOT COVER ANY PORTION OF THE MIDDLE OR BOTTOM RAILS.

THE REFLECTIVE SHEETING USED ON R11-2, R11-3, R11-4, R10-61 AND R1-1 SIGNS SHALL COMPLY WITH SUBSECTION 637.2.2.2 OF THE STANDARD SPECIFICATIONS.

"WO AND "MO" SIGNS ARE THE SAME AS "W" AND "M" SIGNS EXCEPT THE BACKGROUND IS ORANGE.

ALL SIGNS SHALL BE 48" X 48" UNLESS OTHERWISE NOTED BELOW:

- R11-2 SHALL BE 48" X 30".
- R11-3, R11-4 AND R10-61 SHALL BE 60" X 30".
- M4-9 SHALL BE 30" X 24".
- M3-X AND M4-8 SHALL BE 24" X 12". (30" X 15" IF NEEDED TO MATCH EXISTING SIGNS.)
- M1-4, M1-5A, AND M1-6 SHALL BE 24" X 24". (36" X 36" IF NEEDED TO MATCH EXISTING SIGNS.)
- M05-1 AND M06-1 SHALL BE 21" X 21". (30" X 30" IF NEEDED TO MATCH EXISTING SIGNS.)
- D1-X SHALL BE AS SHOWN ON SPECIFIC PROJECT SIGNING DETAIL SHEETS.
- R1-1 SHALL BE 36" X 36".

- 1 TWO WARNING LIGHTS SHALL BE PROVIDED ON THE CENTER BARRICADE AND A MINIMUM OF ONE WARNING LIGHT SHALL BE PROVIDED ON EACH OF THE OTHER BARRICADES WITHIN THE ROADWAY LIMITS. SPACING OF THE WARNING LIGHTS SHALL BE UNIFORM TO THE EDGE OF ROADWAY AS SHOWN (APPROX. 8-FOOT LIGHT SPACING).
- 2 THESE SIGNS AND BARRICADES ARE NOT REQUIRED IF ROAD CLOSURE BEGINS AT INTERSECTION.
- 3 FOR ROAD CLOSURE WITHOUT LOCAL ACCESS TO PROJECT, SEE ROAD CLOSURE BARRICADE DETAIL D.
- 4 FOR ROAD CLOSURE WITH LOCAL ACCESS TO PROJECT, SEE LANE CLOSURE BARRICADE DETAIL E.
- 5 FOR BRIDGE OR CULVERT REPLACEMENTS, SUBSTITUTE "BRIDGE OUT" INSTEAD OF "ROAD CLOSED" ON R11-2 AND R11-3 SIGNS.
- 6 INSTALL DETOUR AND COMMUNITY GUIDE SIGNS AND ARROWS ONLY IF SPECIFIED IN THE CONTRACT. IF THERE ARE EXISTING ROUTE MARKER ASSEMBLIES THAT WILL REMAIN IN PLACE, ADJUST THE LOCATION OF THE DETOUR ROUTE SIGNS TO CORRESPOND WITH THE EXISTING ASSEMBLIES. MODIFY EXISTING SIGNS WHERE POSSIBLE. SEE SPECIFIC PROJECT DETOUR SIGNING DETAIL SHEETS. IF DETOUR SIGNS ARE BEING INSTALLED BY OTHERS, PLACE THE CONTRACTED TRAFFIC CONTROL SIGNS TO ALLOW FOR PLACEMENT OF ALL WARNING, DETOUR AND GUIDE SIGNS AS SHOWN.
- 7 "EAST" CARDINAL DIRECTION MARKERS AND RIGHT TURN ARROWS ARE SHOWN. USE OTHER CARDINAL DIRECTIONS AND ARROWS AS APPROPRIATE.

6

6

S.D.D. 15 C 2-4b

S.D.D. 15 C 2-4b

<b>BARRICADES AND SIGNS FOR MAINLINE CLOSURES</b>	
STATE OF WISCONSIN DEPARTMENT OF TRANSPORTATION	
APPROVED 9/16/03 DATE	<i>Thomas N. Nottm for</i> CHIEF SIGNS AND MARKING ENGINEER
FHWA	

**THIS DRAWING PROVIDES GENERAL GUIDANCE ON TYPICAL DETOUR SIGN LAYOUT AND SPACING. SEE PROJECT DETOUR SIGNING SHEETS FOR SPECIFIC DETAILS FOR EACH PROJECT.**

**GENERAL NOTES**

THE EXACT NUMBER, LOCATION AND SPACING OF ALL SIGNS SHALL BE ADJUSTED TO FIT FIELD CONDITIONS AS APPROVED BY THE ENGINEER.

IF THERE ARE EXISTING ROUTE MARKER ASSEMBLIES THAT WILL REMAIN IN PLACE, ADJUST THE LOCATION OF THE DETOUR ROUTE SIGNS TO CORRESPOND WITH THE EXISTING ASSEMBLIES. SEE SPECIFIC PROJECT DETOUR SIGNING DETAIL SHEETS. MODIFY EXISTING SIGNS WHERE POSSIBLE.

THE SPACING BETWEEN TRAFFIC CONTROL AND DETOUR SIGNS SHOULD BE ADJUSTED TO NOT CONFLICT WITH AND TO PROVIDE A DESIRABLE MINIMUM OF 200 FEET CLEARANCE TO EXISTING SIGNS THAT WILL REMAIN IN PLACE.

ANY SIGNS TEMPORARY OR EXISTING, WHICH CONFLICT WITH TRAFFIC CONTROL "IN USE", SHALL BE REMOVED OR COVERED AS NEEDED AND AS APPROVED BY THE ENGINEER.

SIGNS THAT WILL BE IN PLACE LESS THAN 7 CONTINUOUS DAYS AND NIGHTS MAY BE MOUNTED ON PORTABLE SUPPORTS.


"M0" SIGNS ARE THE SAME AS "M" SIGNS EXCEPT THE BACKGROUND IS ORANGE.

SIGN SIZES SHALL BE AS FOLLOWS:


- M3-X AND M4-8 SHALL BE 24" X 12", (30" X 15" IF NEEDED TO MATCH EXISTING SIGNS.)
- M1-4, M1-5A, AND M1-6 SHALL BE 24" X 24", (36" X 36" IF NEEDED TO MATCH EXISTING SIGNS.)
- M05-1 AND M06-1 SHALL BE 21" X 21", (30" X 30" IF NEEDED TO MATCH EXISTING SIGNS.)
- M4-9 SHALL BE 30" X 24".
- M4-8a SHALL BE 24" X 18".
- G20-51 SHALL BE 60" X 24".
- W20-2 SHALL BE 48" X 48".
- D1-X SHALL BE AS SHOWN ON SPECIFIC PROJECT SIGNING DETAIL SHEETS.

\* OPTIONAL SIGNS. SEE SPECIFIC PROJECT DETOUR SIGNING DETAIL SHEETS.


\*\* FOR A TOWN ROAD OR LOCAL STREET DETOURED ONTO A STATE TRUNK HIGHWAY, PLACE A ROAD NAME PLAQUE ABOVE THE M4-9 SIGN AS SPECIFIED IN THE CONTRACT.

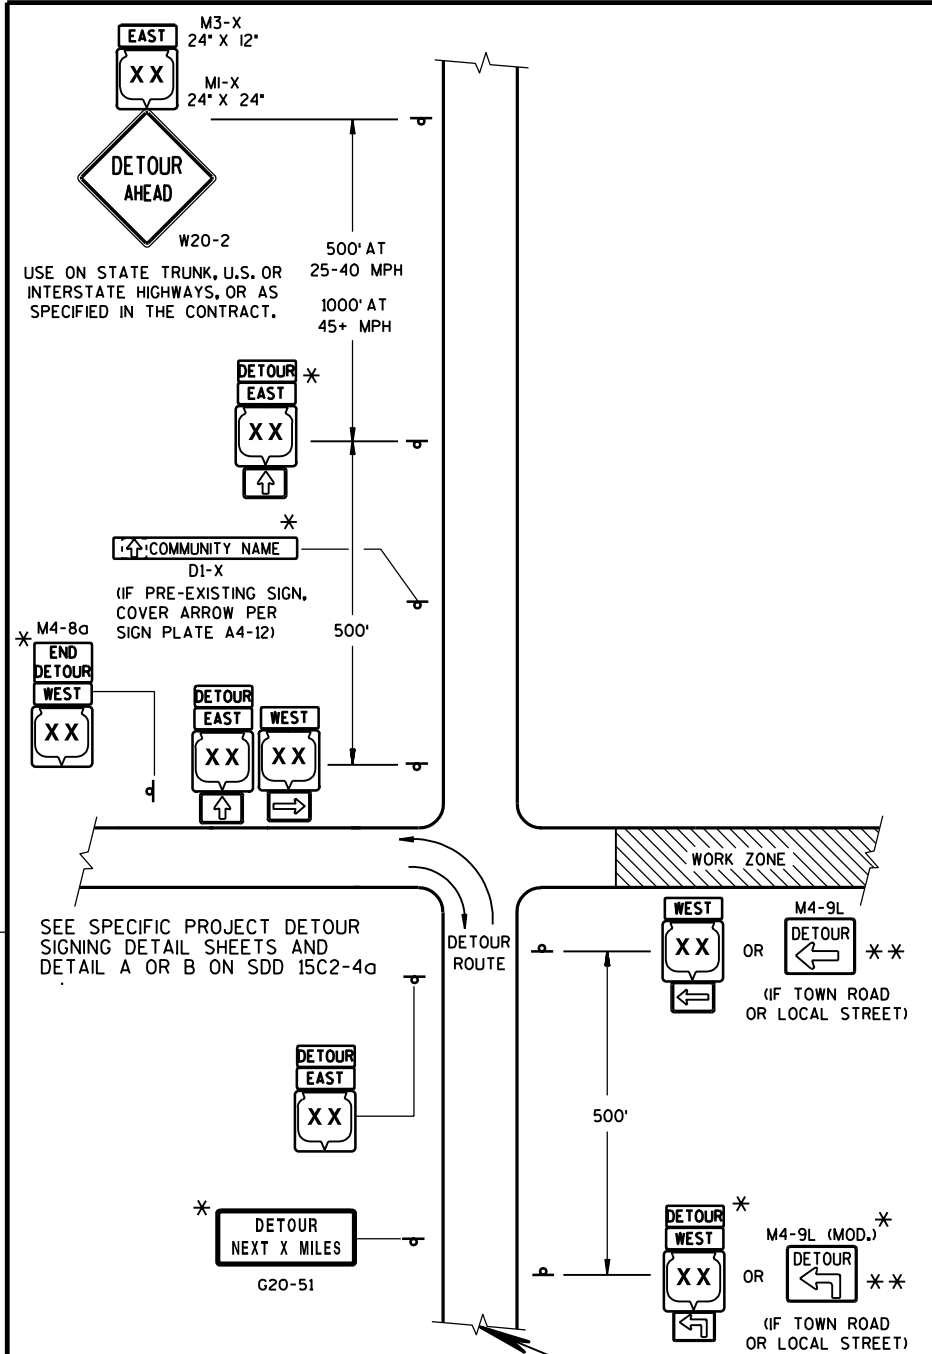

**MATCH POINT**

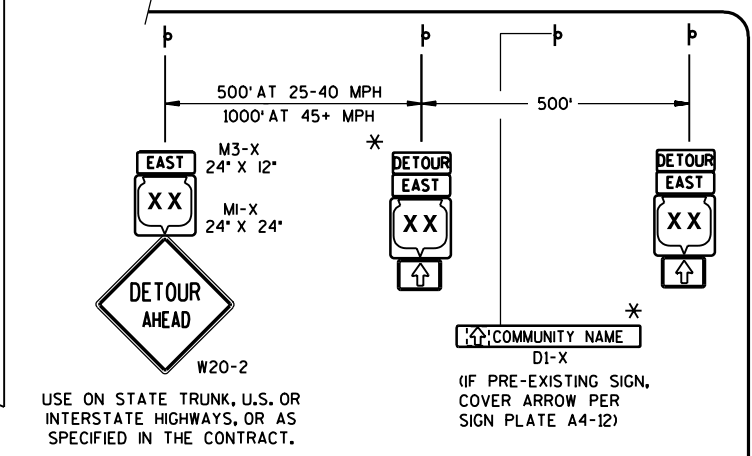

**DETAIL F  
DETOUR SIGNING**

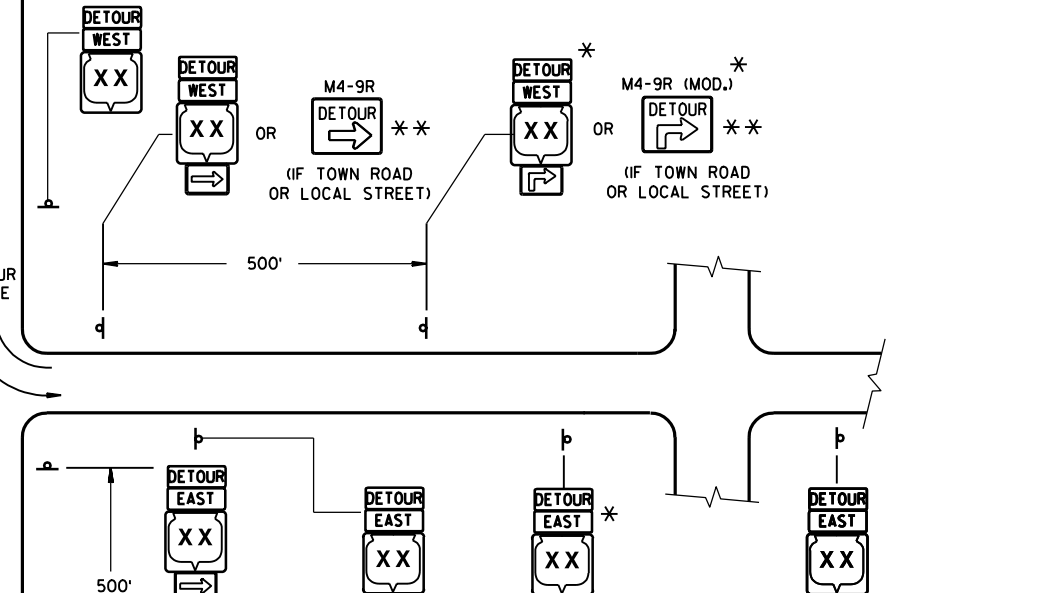

PLACE SIGNS BEYOND INTERSECTIONS WITH STATE OR COUNTY TRUNK HIGHWAYS OR AT 4 MILE MAXIMUM SPACING (4 BLOCKS IF URBAN AREA.)

**LEGEND**

- POST MOUNTED SIGN
- WORK ZONE
- DETOUR EAST M4-8 M3-X
- MI-4 MI-5A MI-6
- M05-1 M06-1 M06-1


<b>DETOUR SIGNING FOR MAINLINE CLOSURES</b>	
STATE OF WISCONSIN DEPARTMENT OF TRANSPORTATION	
APPROVED 9-16-03 DATE	<i>Thomas N. Nottm for</i> CHIEF SIGNS AND MARKING ENGINEER
FHWA	

6


6

S.D.D. 15 C 2-4C


S.D.D. 15 C 2-4C

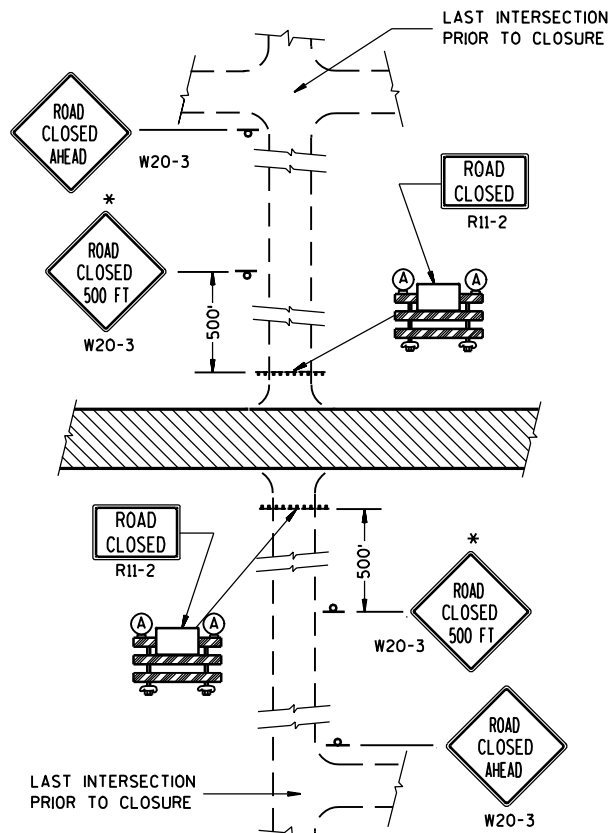


**DETAIL 1**  
(NO ACCESS TO PROJECT)

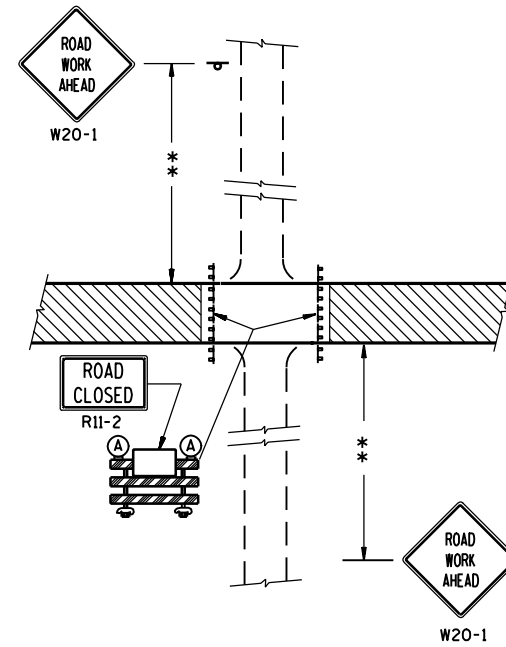

**DETAIL 2**  
(PUBLIC CROSS-TRAFFIC MAINTAINED.  
NO ACCESS TO PROJECT).

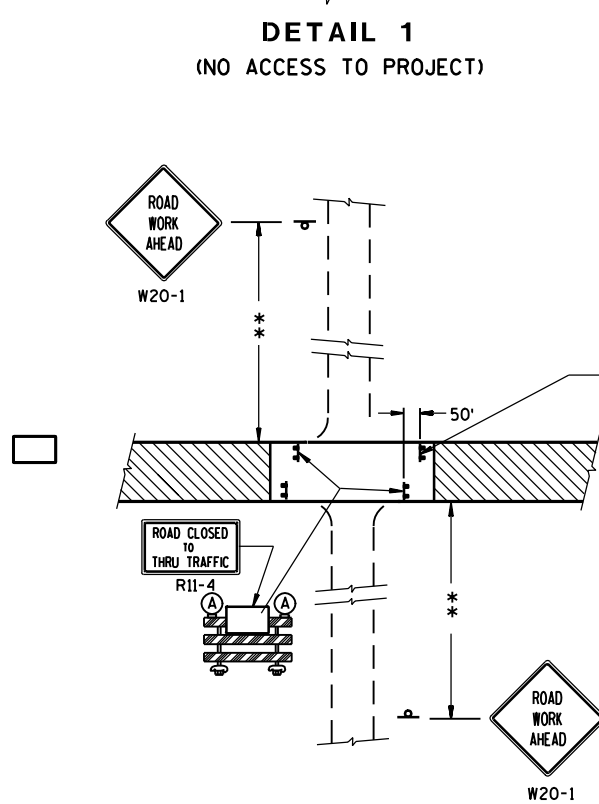

**DETAIL 3**  
(PUBLIC CROSS-TRAFFIC MAINTAINED. CONTRACTOR,  
LOCAL BUSINESS AND RESIDENT ACCESS).

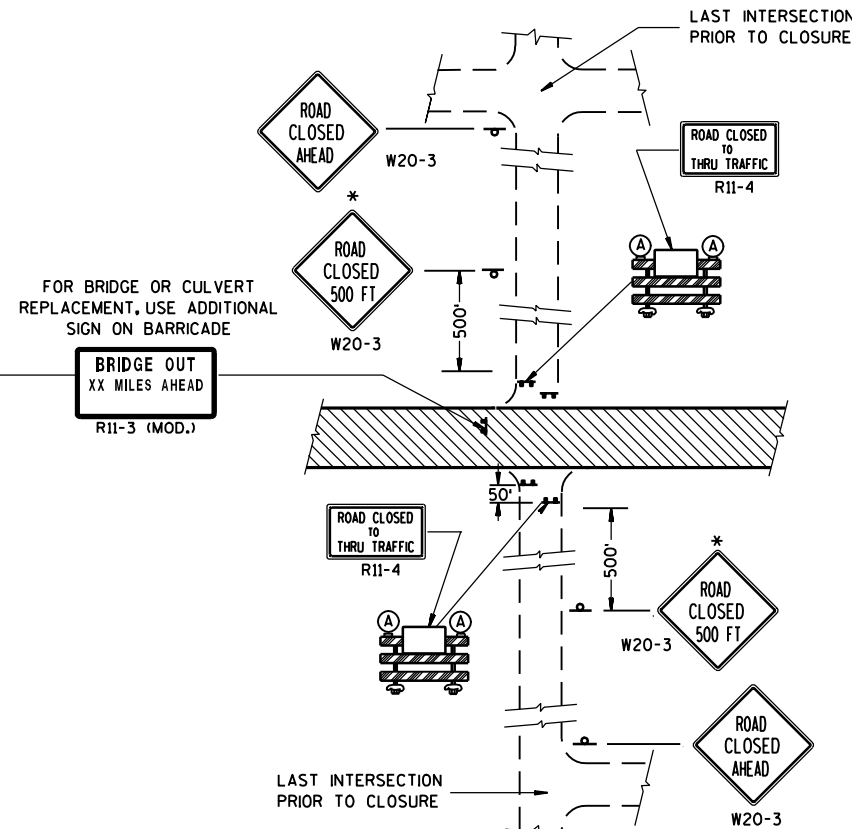

**DETAIL 4**  
(CONTRACTOR, LOCAL BUSINESS AND  
RESIDENT ACCESS TO PROJECT)

**GENERAL NOTES**

THE EXACT NUMBER, LOCATION, AND SPACING OF ALL SIGNS AND BARRICADES SHALL BE ADJUSTED TO FIT FIELD CONDITIONS AS APPROVED BY THE ENGINEER.

ANY SIGNS TEMPORARY OR EXISTING, WHICH CONFLICT WITH TRAFFIC CONTROL "IN USE" SHALL BE REMOVED OR COVERED AS NEEDED AND AS APPROVED BY THE ENGINEER.

THE SPACING BETWEEN TRAFFIC CONTROL SIGNS SHOULD BE ADJUSTED TO NOT CONFLICT WITH AND SHOULD PROVIDE A DESIRABLE MINIMUM OF 200 FEET CLEARANCE TO EXISTING SIGNS THAT WILL REMAIN IN PLACE.

IF A "STOP" SIGN MUST BE REMOVED FOR A WORK OPERATION, A TEMPORARY "STOP" SIGN SHALL BE PLACED PRIOR TO THE SIGN REMOVAL, OR A FLAGGER SHALL BE PROVIDED UNTIL THE SIGN IS RE-ESTABLISHED.

BARRICADES THAT MUST BE MOVED FOR A WORK OPERATION SHALL BE IMMEDIATELY RE-ESTABLISHED UPON COMPLETION OF THE OPERATION OR, FOR CONTINUING OPERATIONS, AT THE END OF EACH WORKING DAY.

SIGNS THAT WILL BE IN PLACE LESS THAN 7 CONTINUOUS DAYS AND NIGHTS MAY BE MOUNTED ON PORTABLE SUPPORTS.

ALL TYPE III BARRICADES SHALL HAVE RAILS REFLECTORIZED ON BOTH FACES. STRIPES SHALL BE PROPERLY SLOPED DOWN TOWARD THE TRAFFIC SIDE OR AS SHOWN IN THE ROAD CLOSURE BARRICADE DETAIL D FOR FULL ROAD CLOSURES.

TYPE "A" LOW-INTENSITY FLASHING WARNING LIGHTS SHALL BE VISIBLE ON BOTH SIDES OF THE BARRICADE.

THE R11-2, R11-3 AND R11-4 SIGNS PLACED ON BARRICADES SHALL COVER NO MORE THAN THE TOP RAIL. THE SIGNS SHALL NOT COVER ANY PORTION OF THE MIDDLE OR BOTTOM RAILS.

THE REFLECTIVE SHEETING USED ON R11-2, R11-3 AND R11-4 SIGNS SHALL COMPLY WITH SUBSECTION 637.2.2.2 OF THE STANDARD SPECIFICATIONS.

ALL SIGNS SHALL BE 48" X 48" UNLESS OTHERWISE NOTED BELOW:

R11-2 SHALL BE 48" X 30".

R11-4 AND R11-3 SHALL BE 60" X 30".

\*OMIT THE "ROAD CLOSED 500 FT." SIGN IF THE LAST INTERSECTION IS 500 FT. OR LESS FROM THE WORK ZONE.

\*\*500' MAX. OR AT LAST INTERSECTION WHICHEVER IS CLOSER.

**LEGEND**

▬ POST MOUNTED WARNING SIGN

▬ TYPE III BARRICADES

Ⓐ TYPE "A" LOW INTENSITY FLASHING WARNING LIGHT (FOR NIGHT USE)

▨ WORK AREA

**BARRICADES AND SIGNS  
FOR  
SIDEROAD CLOSURES**

STATE OF WISCONSIN  
DEPARTMENT OF TRANSPORTATION


APPROVED

9-16-03


DATE

*Thomas N. Nottm for*  
CHIEF SIGNS AND MARKING ENGINEER

FHWA

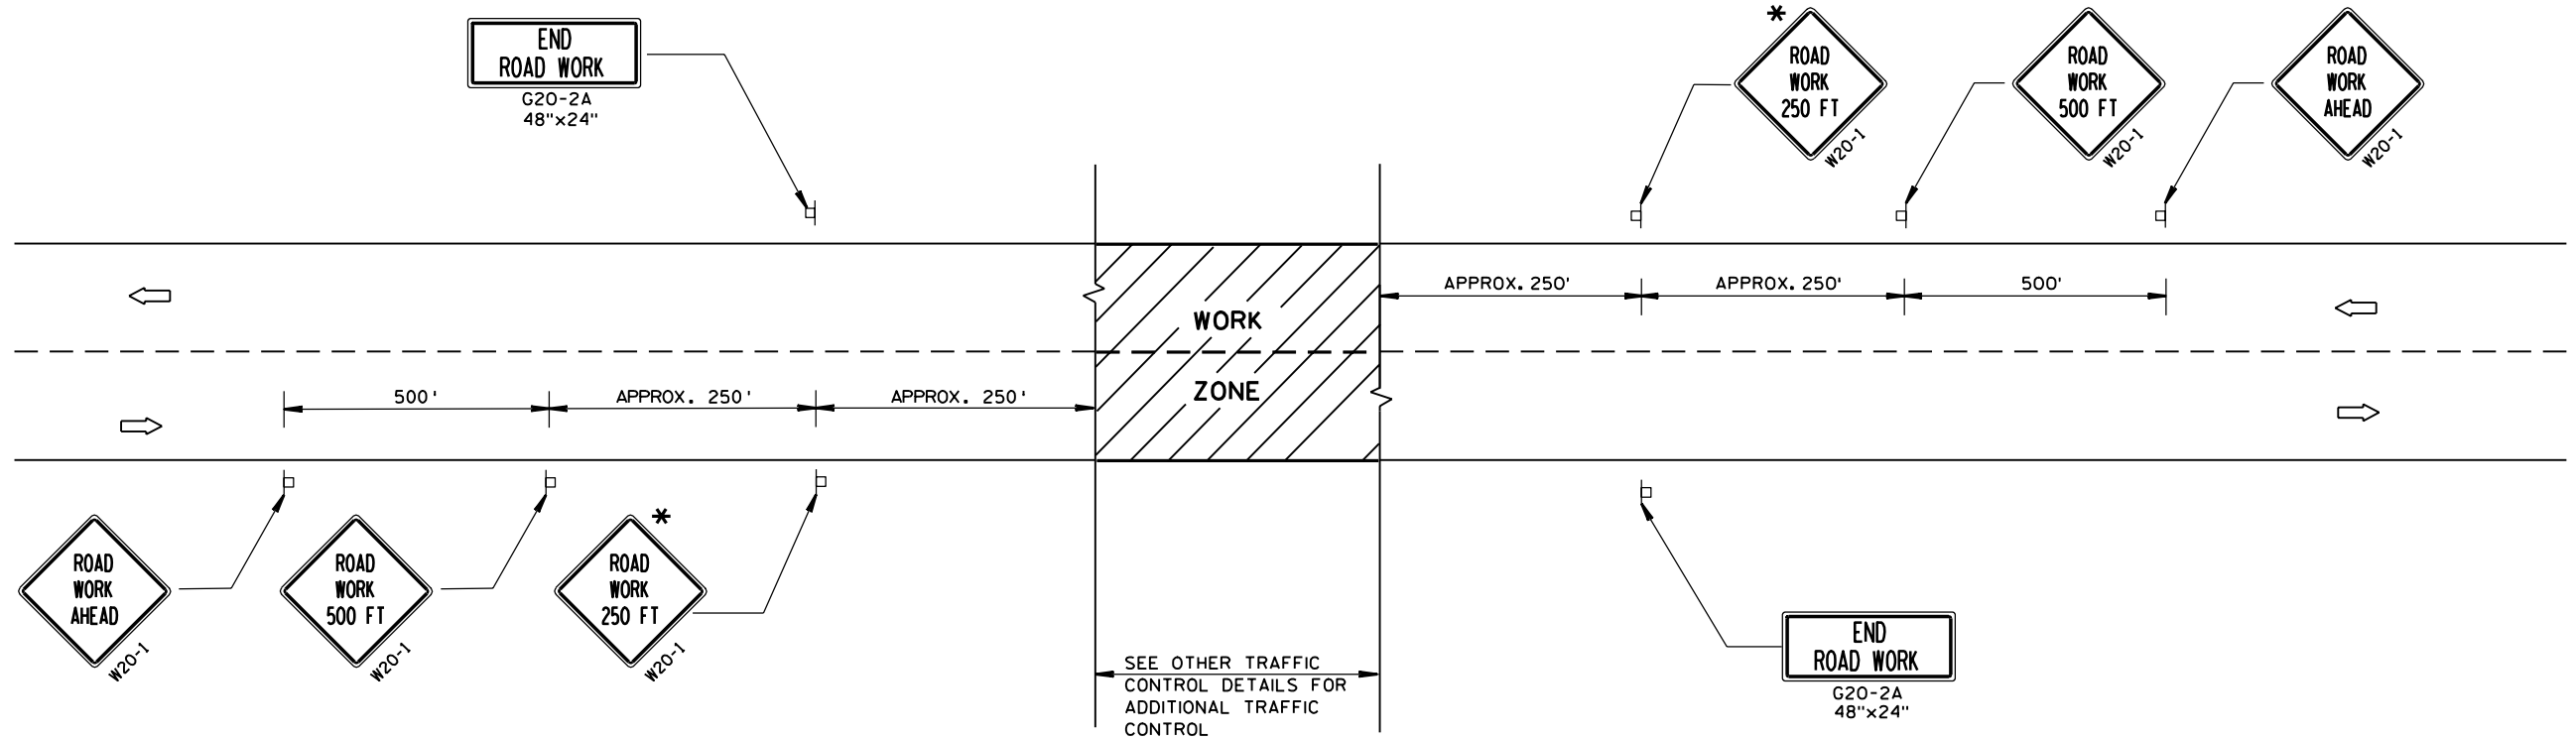

**TYPICAL SIDEROAD APPROACH WARNING SIGN DETAIL**

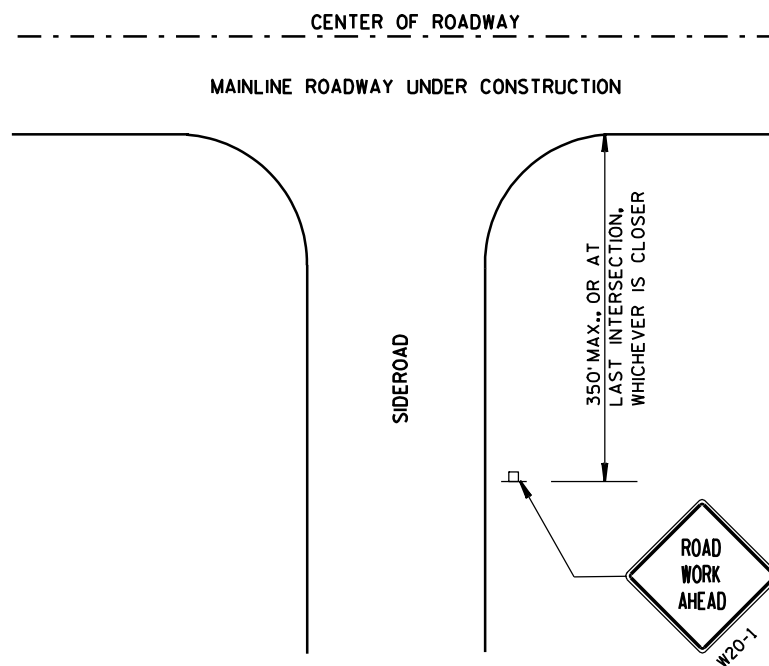

**GENERAL NOTES**

THE EXACT NUMBER, LOCATION, AND SPACING OF ALL SIGNS AND DEVICES SHALL BE ADJUSTED TO FIT FIELD CONDITIONS.

THE SPACING BETWEEN TRAFFIC CONTROL SIGNS SHOULD BE ADJUSTED TO NOT CONFLICT WITH AND SHOULD PROVIDE A DESIRABLE MINIMUM OF 200 FEET CLEARANCE TO EXISTING SIGNS THAT WILL REMAIN IN PLACE.

ALL SIGNS ARE 48"x48" UNLESS OTHERWISE NOTED. IF NECESSARY DUE TO SPACE CONSTRAINTS, 36"x36" SIGNS MAY BE USED INSTEAD OF 48"x48" SIGNS, IF APPROVED BY DISTRICT TRAFFIC UNIT.

SIGNS THAT WILL BE IN PLACE LESS THAN 7 CONTINUOUS DAYS AND NIGHTS MAY BE MOUNTED ON PORTABLE SUPPORTS.

IF A "STOP" SIGN MUST BE REMOVED FOR A WORK OPERATION, A TEMPORARY "STOP" SIGN SHALL BE PLACED PRIOR TO THE SIGN REMOVAL, OR A FLAGGER SHALL BE PROVIDED UNTIL THE SIGN IS RE-ESTABLISHED.

\* THE THIRD W20-1 SIGN IS REQUIRED ONLY IF THERE IS AN INTERSECTION BETWEEN THE "ROAD WORK 500 FT" SIGN AND THE WORK ZONE. ADJUST THE PLACEMENT OF THIS SIGN BASED ON INTERSECTION LOCATION AND OTHER FIELD CONDITIONS.

**LEGEND**








- ▣ POST MOUNTED SIGN
- ➡ DIRECTION OF TRAFFIC FLOW

<b>TRAFFIC CONTROL, ADVANCE WARNING SIGNS 40 M.P.H. OR LESS TWO-WAY UNDIVIDED ROAD OPEN TO TRAFFIC</b>	
STATE OF WISCONSIN DEPARTMENT OF TRANSPORTATION	
APPROVED 5/23/00 DATE	<i>Christa J. Spang</i> CHIEF SIGNS AND MARKING ENGINEER
FHWA	

**GENERAL NOTES**

DETAILS OF INSTALLATION, MATERIALS AND WORKMANSHIP NOT SHOWN ON THIS DRAWING SHALL CONFORM TO THE PERTINENT REQUIREMENTS OF THE STANDARD SPECIFICATIONS AND APPLICABLE SPECIAL PROVISIONS.

ALL LETTERS, ARROWS AND SYMBOLS SHALL BE IN CONFORMANCE WITH REQUIREMENTS INCLUDED IN "STANDARD ALPHABETS FOR HIGHWAY SIGNS AND PAVEMENT MARKING" BOOK BY THE FEDERAL HIGHWAY ADMINISTRATION. ALL LETTERS, ARROWS AND SYMBOLS SHALL BE WHITE AND REFLECTORIZED. SMALL DIFFERENCES IN DIMENSIONS WITHIN THE TOLERANCES OF THAT BOOK ARE ACCEPTABLE.

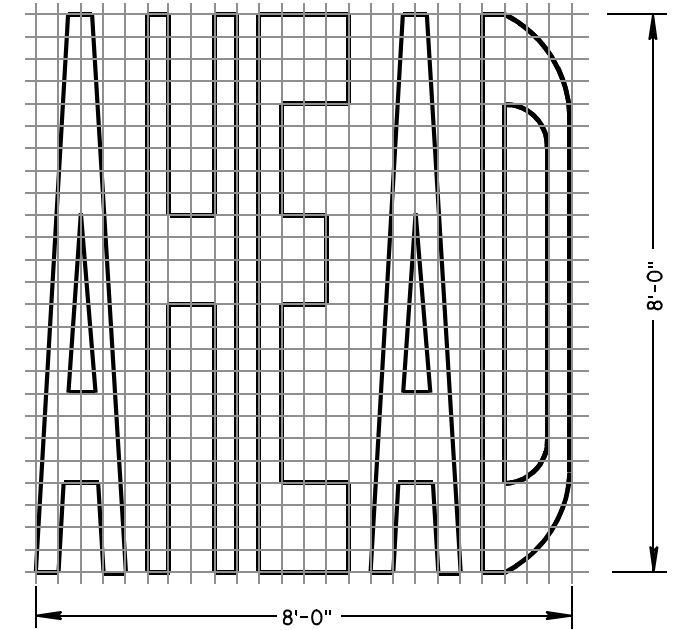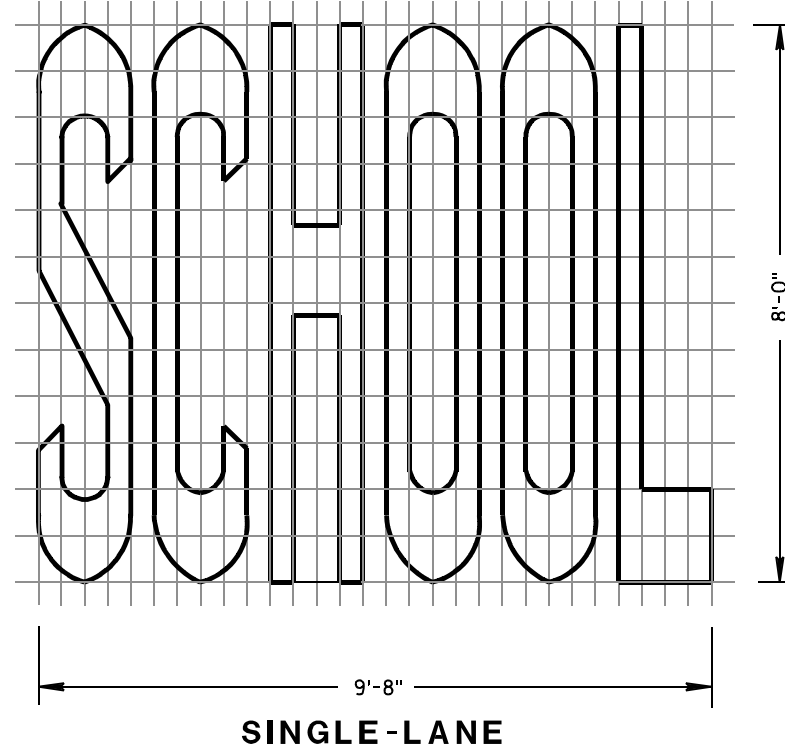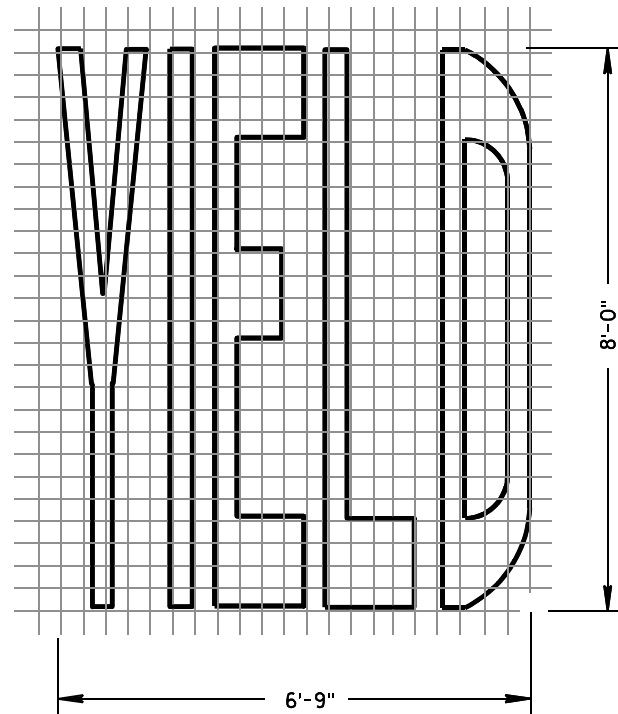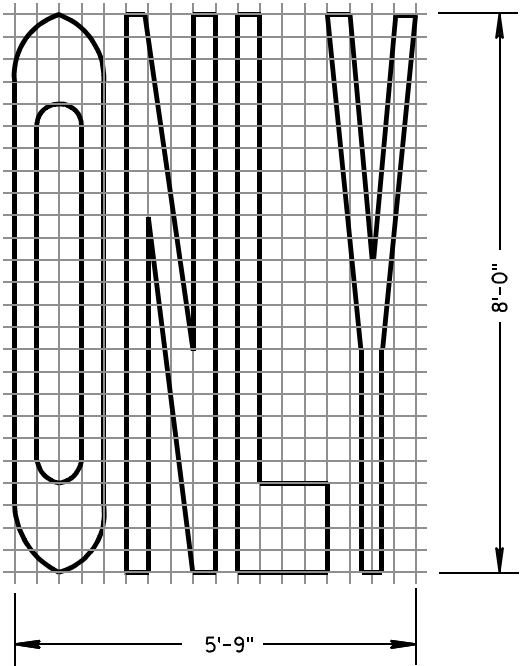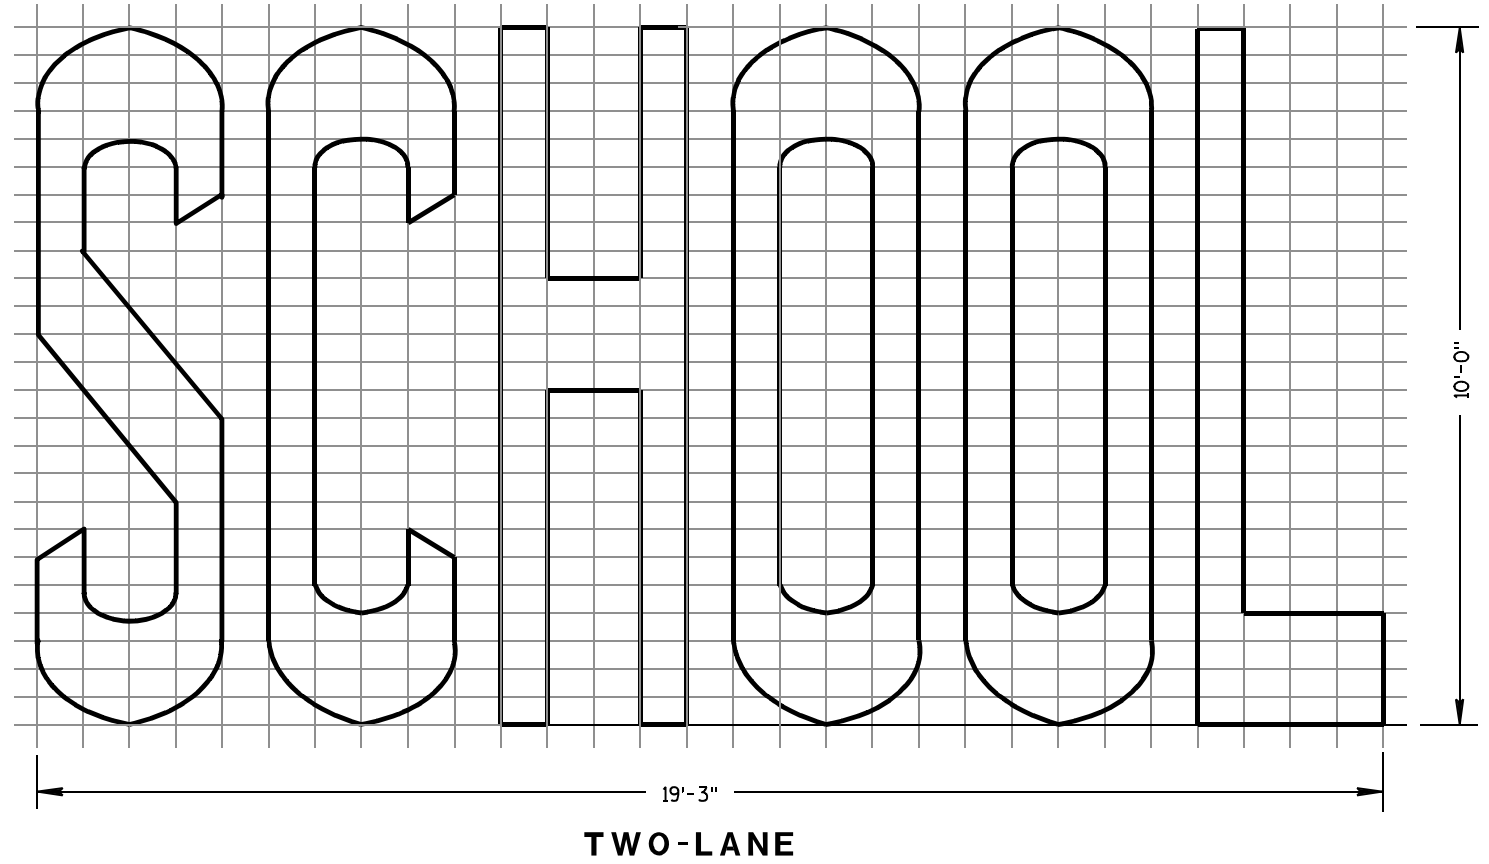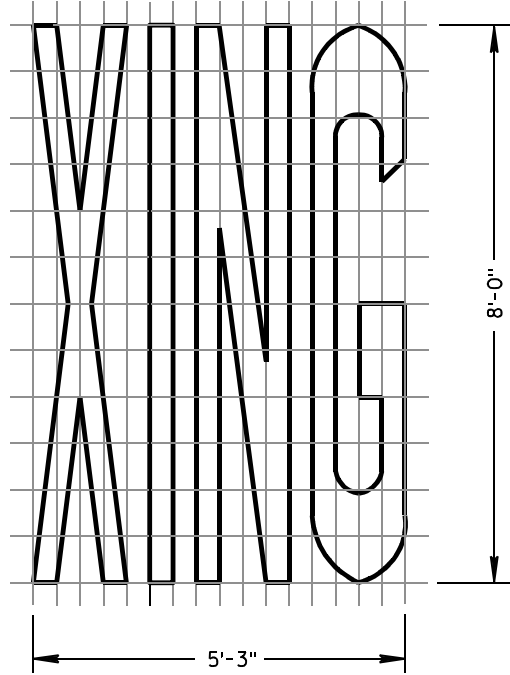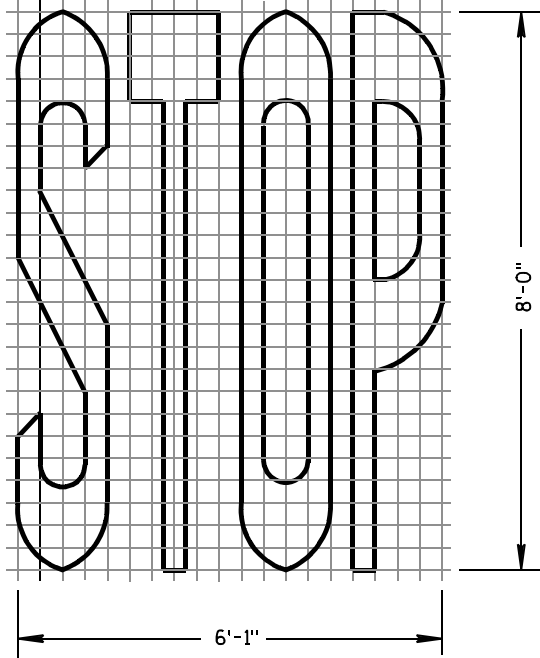

6


6

**PAVEMENT MARKING WORDS**


STATE OF WISCONSIN  
DEPARTMENT OF TRANSPORTATION

APPROVED  
5-13-10 /S/ Thomas N. Notbohm  
DATE STATE TRAFFIC ENGINEER OF DESIGN  
FHWA




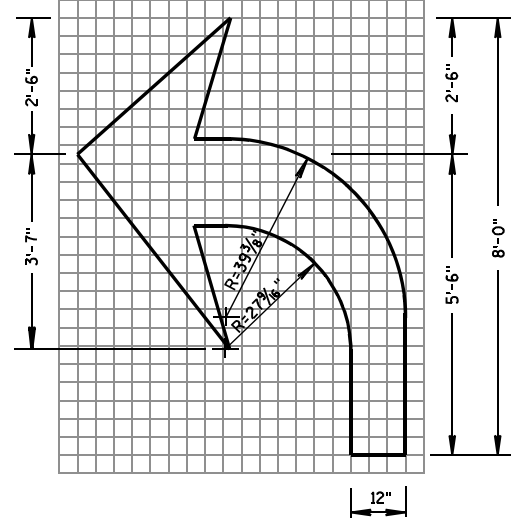


TYPE 2

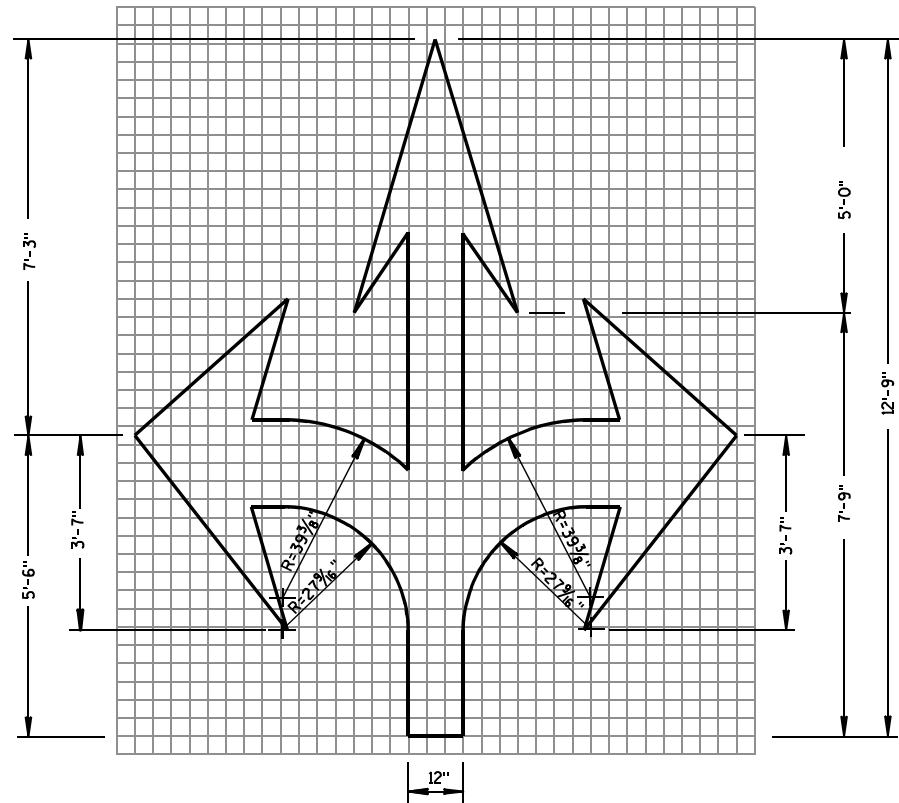


TYPE 6

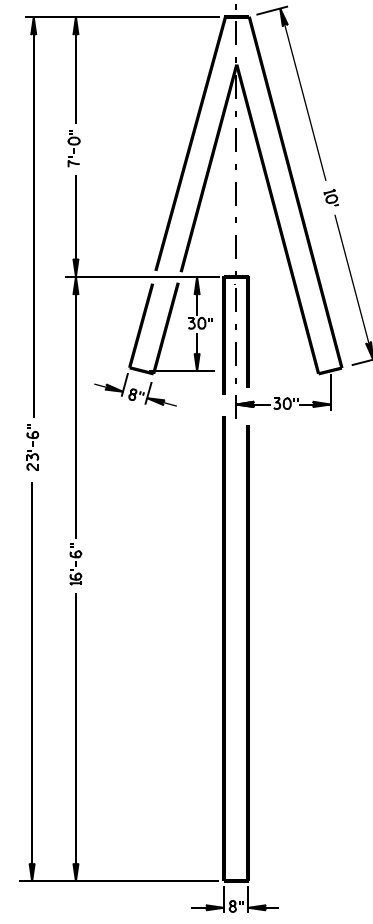


TYPE 4

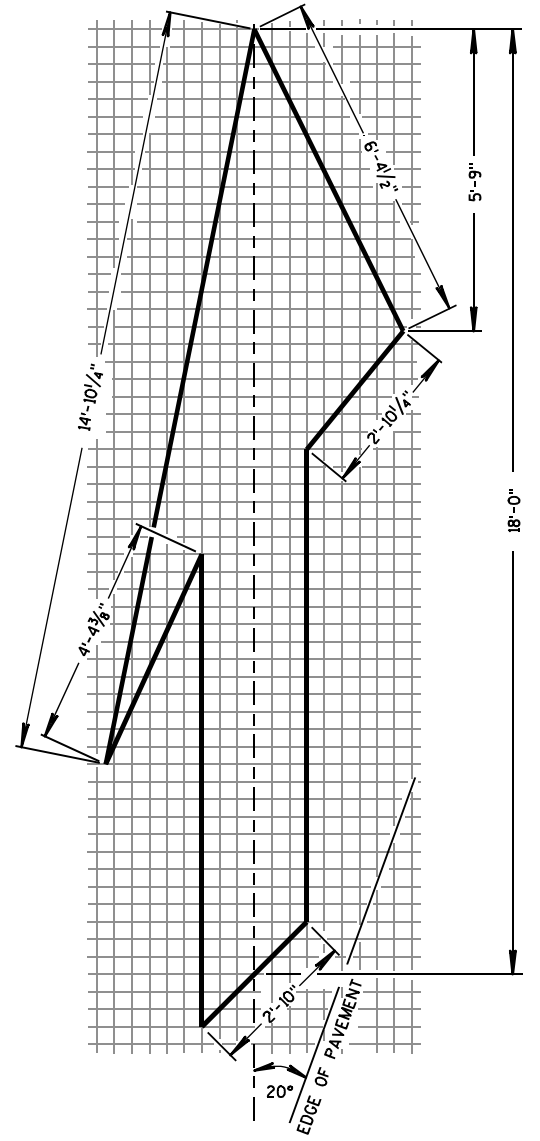


TYPE 5 LANE DROP ARROW

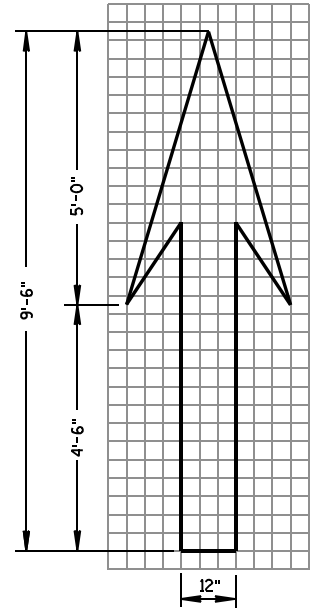

TYPE 1

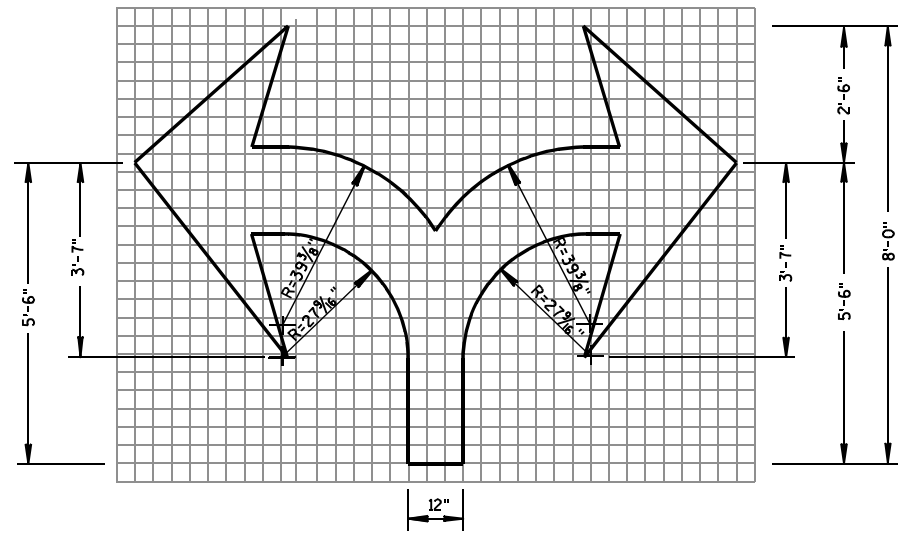

TYPE 7

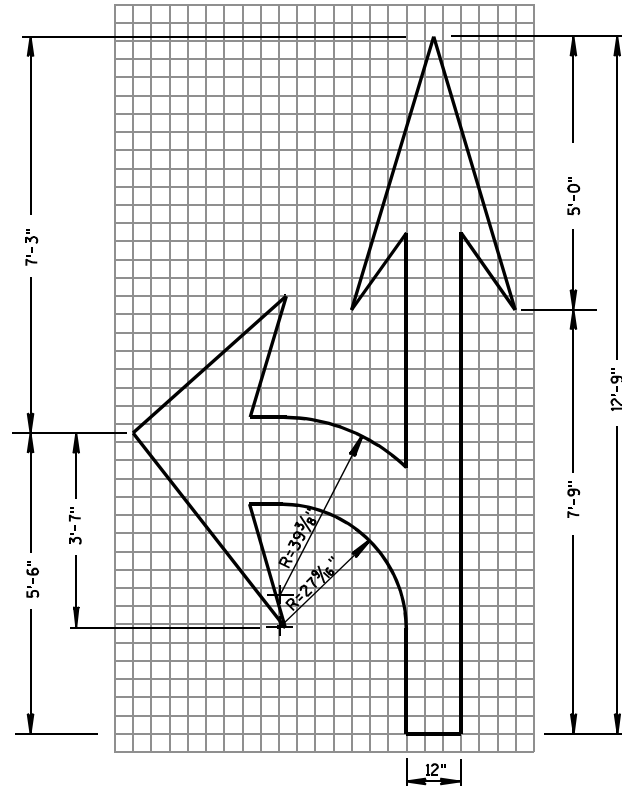

TYPE 3

GENERAL NOTES


DETAILS OF INSTALLATION, MATERIALS AND WORKMANSHIP NOT SHOWN ON THIS DRAWING SHALL CONFORM TO THE PERTINENT REQUIREMENTS OF THE STANDARD SPECIFICATIONS AND APPLICABLE SPECIAL PROVISIONS.

ALL LETTERS, ARROWS AND SYMBOLS SHALL BE IN CONFORMANCE WITH REQUIREMENTS INCLUDED IN "STANDARD ALPHABETS FOR HIGHWAY SIGNS AND PAVEMENT MARKING" BOOK BY THE FEDERAL HIGHWAY ADMINISTRATION. ALL LETTERS, ARROWS AND SYMBOLS SHALL BE WHITE AND REFLECTORIZED. SMALL DIFFERENCES IN DIMENSIONS WITHIN THE TOLERANCES OF THAT BOOK ARE ACCEPTABLE.


PAVEMENT MARKING ARROWS

STATE OF WISCONSIN  
DEPARTMENT OF TRANSPORTATION

APPROVED	/S/ Thomas N. Notbohm
5/13/10	STATE TRAFFIC ENGINEER OF DESIGN
DATE	
FHWA	

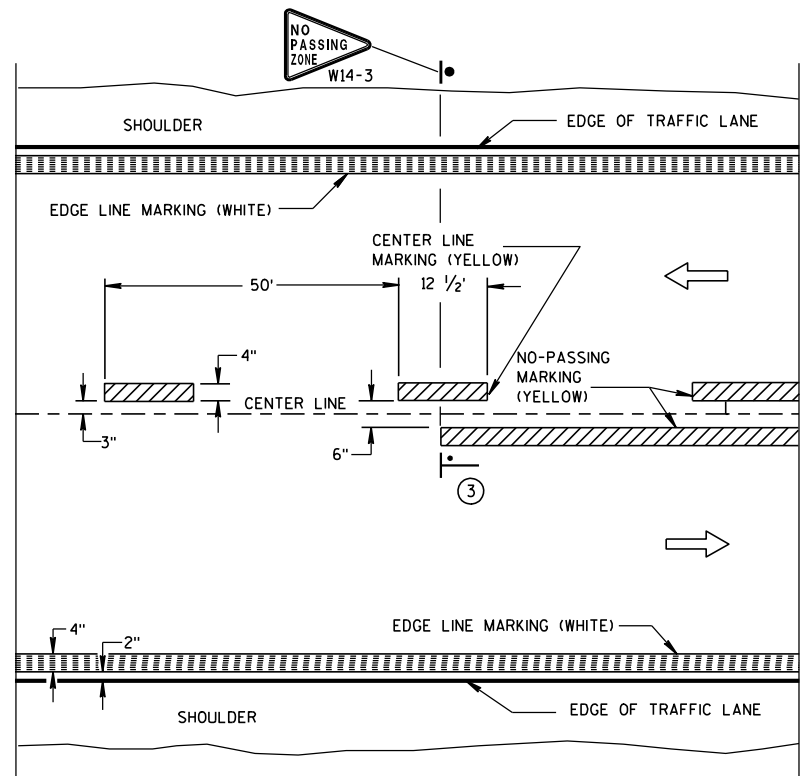


TWO WAY TRAFFIC

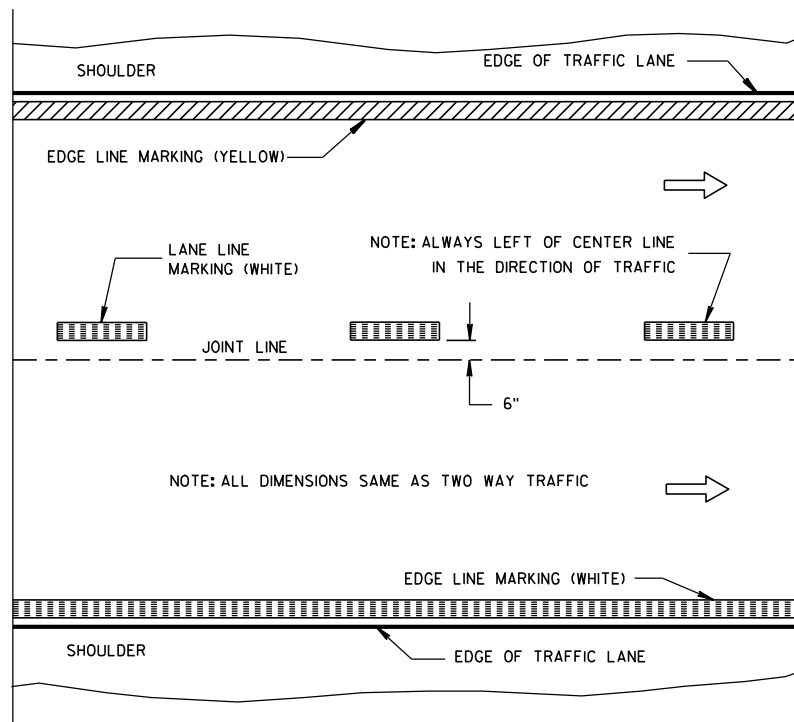


ONE WAY TRAFFIC

**PERMANENT PAVEMENT MARKING**

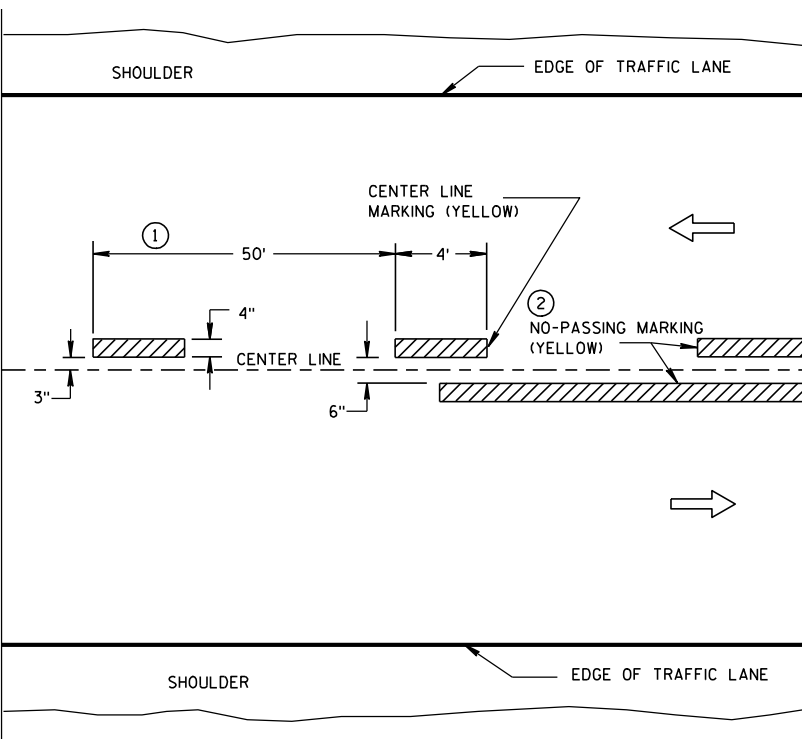

TWO WAY TRAFFIC

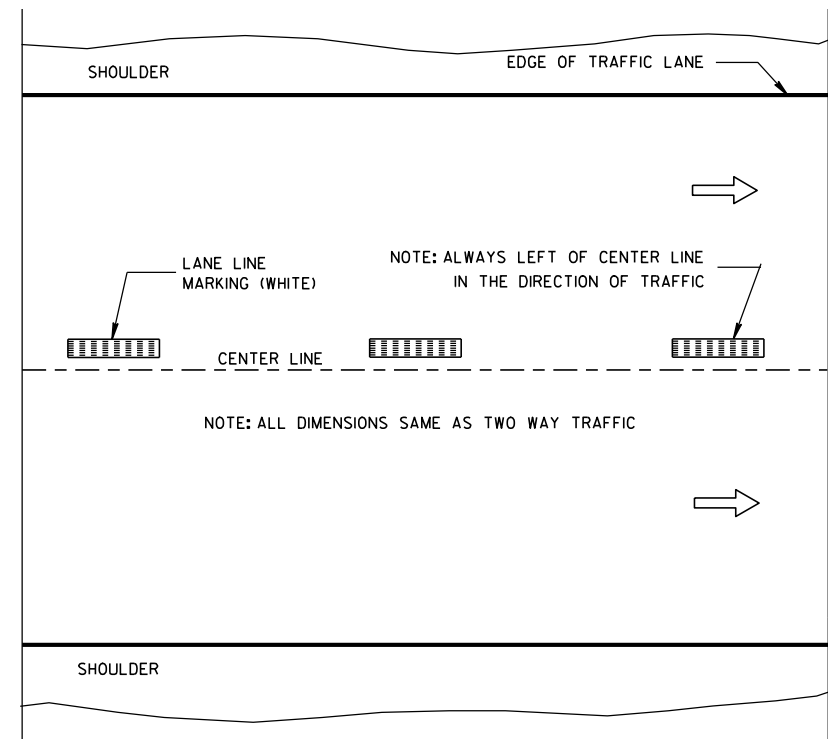

ONE WAY TRAFFIC

**TEMPORARY (INTERMEDIATE) PAVEMENT MARKING**  
(SHOWS CYCLE FOR TEMPORARY CENTER LINE OR TEMPORARY LANE LINE MARKING)


**GENERAL NOTES**

DETAILS OF CONSTRUCTION NOT SHOWN ON THIS DRAWING SHALL CONFORM TO STANDARD SPECIFICATIONS AND SPECIAL PROVISIONS.

- ① HALF CYCLE LENGTHS (25'±) WITH 2' MINIMUM STRIPE LENGTHS SHALL BE PROVIDED ON ROADWAYS (INCLUDING TEMPORARY TRAVELED WAYS) WITH REVERSE CURVATURE, CURVATURE OF OVER 5 DEGREES OR WHEN DIRECTED BY THE ENGINEER TO MARK UNUSUAL ALIGNMENT OF THE TRAVELED WAY.
- ② NO PASSING ZONE TEMPORARY PAVEMENT MARKING IS REQUIRED TO BE PLACED, WHERE APPROPRIATE, ALONG WITH CENTERLINE TEMPORARY PAVEMENT MARKING WHEN A SAME DAY PERMANENT PAVEMENT MARKING ITEM IS INCLUDED IN THE CONTRACT.
- ③ NO PASSING ZONE MARKINGS ARE PLACED ACCORDING TO "T" MARKINGS. IF EXISTING NO PASSING ZONE W14-3 SIGNS ARE BEYOND 50 FEET IN EITHER DIRECTION, THE SIGNS SHALL BE MOVED TO THE "T" MARKINGS.

**NOTE**

ARROW SYMBOL ( → ) SHOWS DIRECTION OF TRAVEL

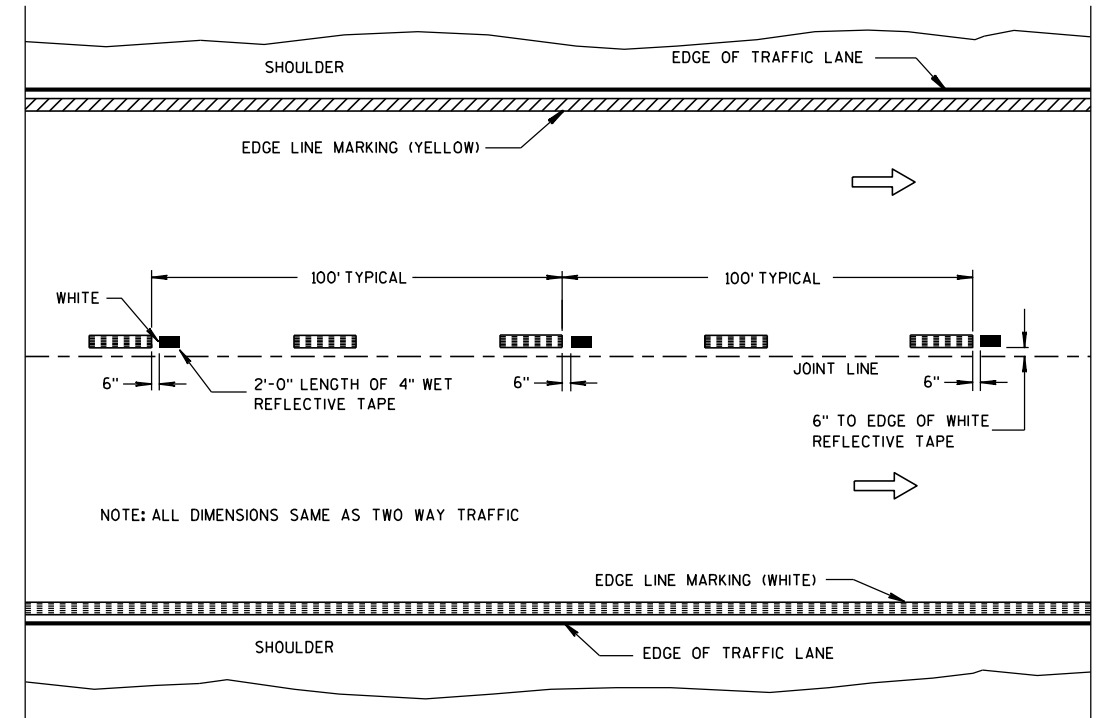


**WET REFLECTIVE TAPE SUPPLEMENT TO  
SPRAYED OR NON WET REFLECTIVE TAPE LANE LINE**

**LEGEND**

- "T" MARKING
- POST MOUNTED SIGN


PAVEMENT MARKING (MAINLINE)	
STATE OF WISCONSIN DEPARTMENT OF TRANSPORTATION	
APPROVED 5-13-10 DATE	/S/ Thomas N. Notbohm STATE TRAFFIC ENGINEER OF DESIGN
FHWA	

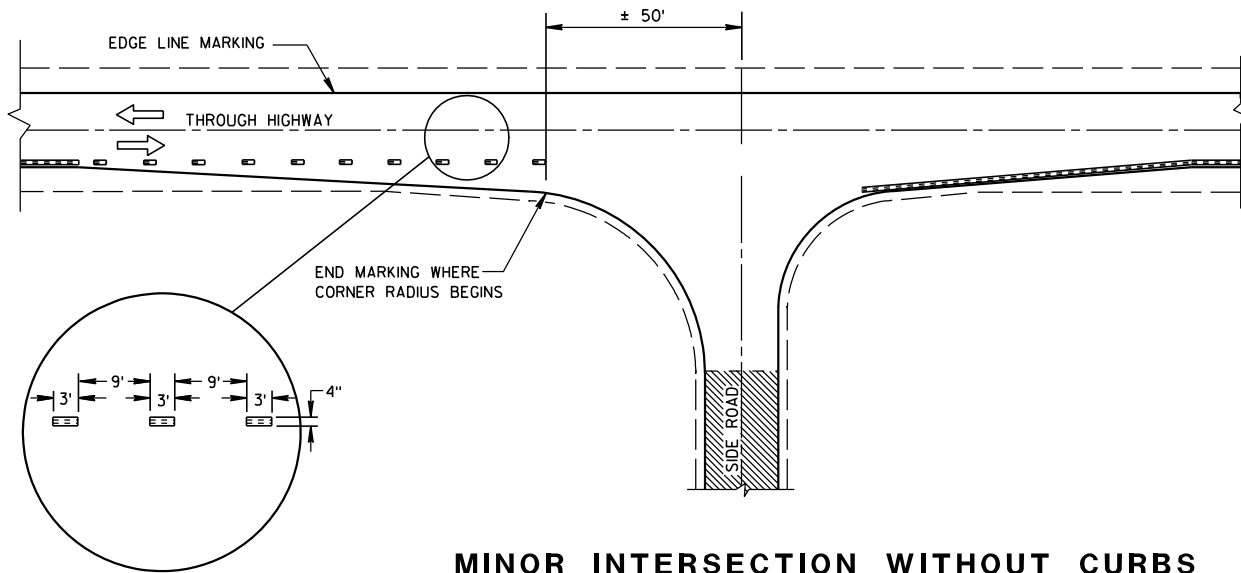


**MINOR INTERSECTION WITHOUT CURBS**

⑦



POSTED SPEED (MPH)	MINIMUM DISTANCE BETWEEN ZONES (FEET)
25 - 30	528
35 - 40	528
45 - 50	686
55	792

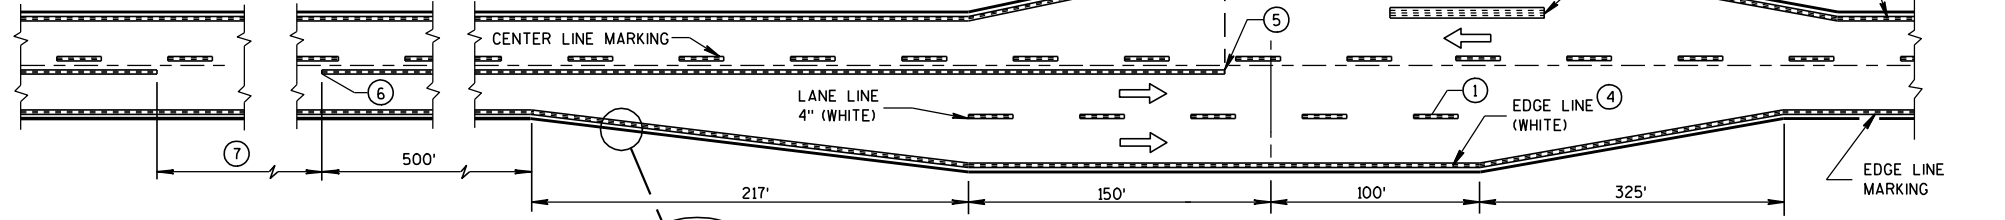

**MAJOR INTERSECTIONS  
(INTERSECTION WITH FULL RIGHT TURN LANE OR BYPASS LANES)**

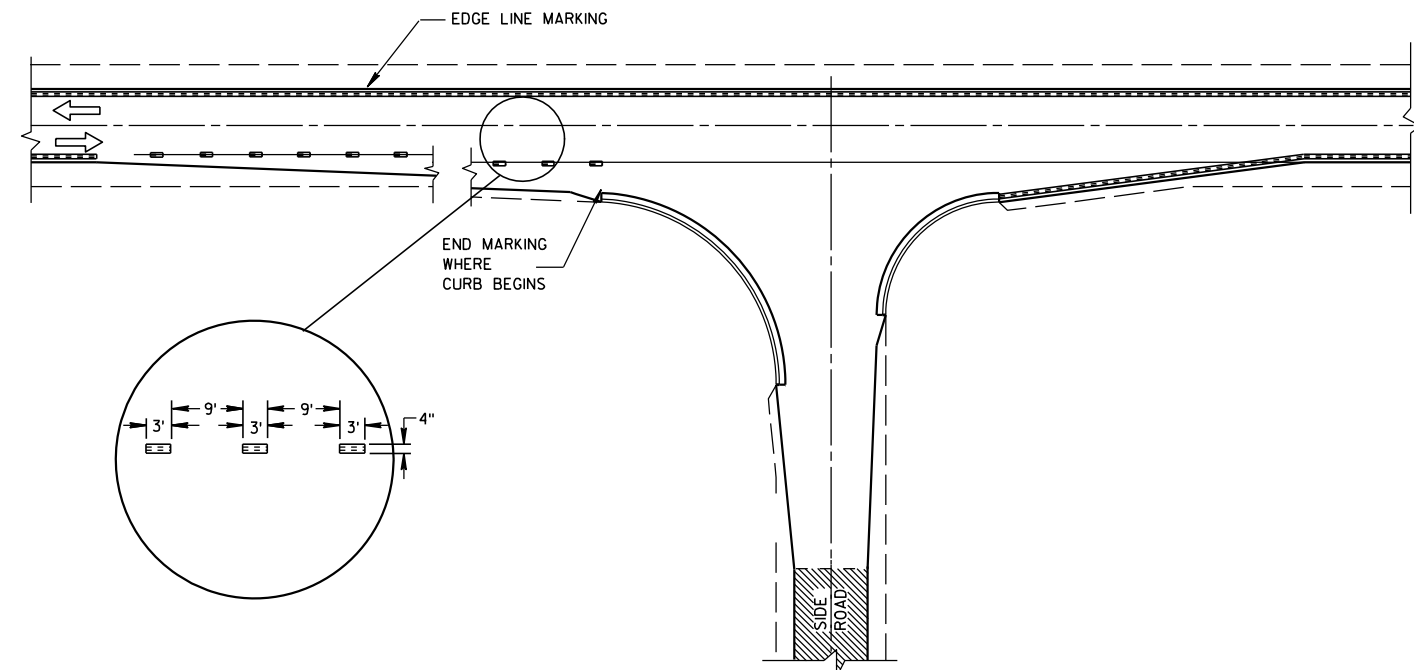

**MINOR INTERSECTION WITH CURBS  
(TYPICAL MARKING)**

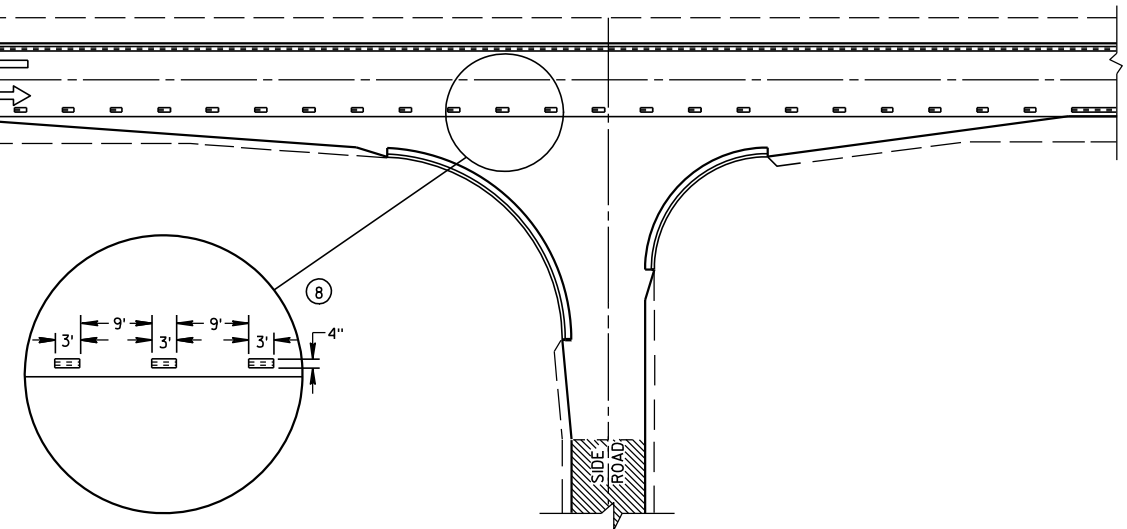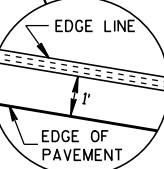


**MINOR INTERSECTION WITH CURBS  
③ (FOR SPECIAL CONDITIONS AS SPECIFIED)**

**GENERAL NOTES**

- EDGE LINES SHALL BE OMITTED THROUGH INTERSECTIONS. EDGE LINES SHALL BE CONTINUED THROUGH DRIVEWAYS.
- ① WHEN DISTANCE "A" IS LESS THAN 250 FEET, OMIT LANE LINE.
  - ② WHEN DISTANCE "B" IS LESS THAN 100 FEET, OMIT CHANNELIZING LANE LINE.
  - ③ ALTERNATIVE MARKING SHALL BE PROVIDED WHEN SPECIFIED IN THE CONTRACT. TYPICAL SITUATIONS WHERE THIS MARKING MAY BE REQUIRED ARE WHERE THE INTERSECTION IS ON A SHARP HORIZONTAL CURVE OR CREST VERTICAL CURVE IN AN UNLIGHTED AREA SUCH THAT THE EDGE LINE MAY BE MISLEADING TO THE MOTORIST OR DISAPPEAR FROM SIGHT.
  - ④ THE EDGE LINE IN THE TAPER AREAS OF THE BYPASS LANE AND THE BYPASS LANE SHALL BE LOCATED 1-FOOT FROM EDGE OF PAVEMENT TO THE OUTSIDE EDGE OF EDGE LINE.
  - ⑤ BARRIER LINE ENDS AT SIDE ROAD PAVEMENT/SURFACE EDGE EXTENSION.
  - ⑥ BARRIER LINE STARTS 500 FEET PRIOR TO THE BYPASS TAPER.
  - ⑦ IF THE DISTANCE BETWEEN 2 SUCCESSIVE NO-PASSING ZONES IS LESS THAN THE MINIMUM DISTANCE BETWEEN ZONES, CONNECT THE 2 ZONES.
  - ⑧ 3' LINE 9' GAP, EXCEPT RETRACE THE EXISTING LINE - GAP PATTERN WHERE EXISTING MARKINGS ARE IN PLACE.
- ARROW SYMBOL ( → ) SHOWS DIRECTION OF TRAVEL

**PAVEMENT MARKING  
(INTERSECTIONS)**

STATE OF WISCONSIN  
DEPARTMENT OF TRANSPORTATION

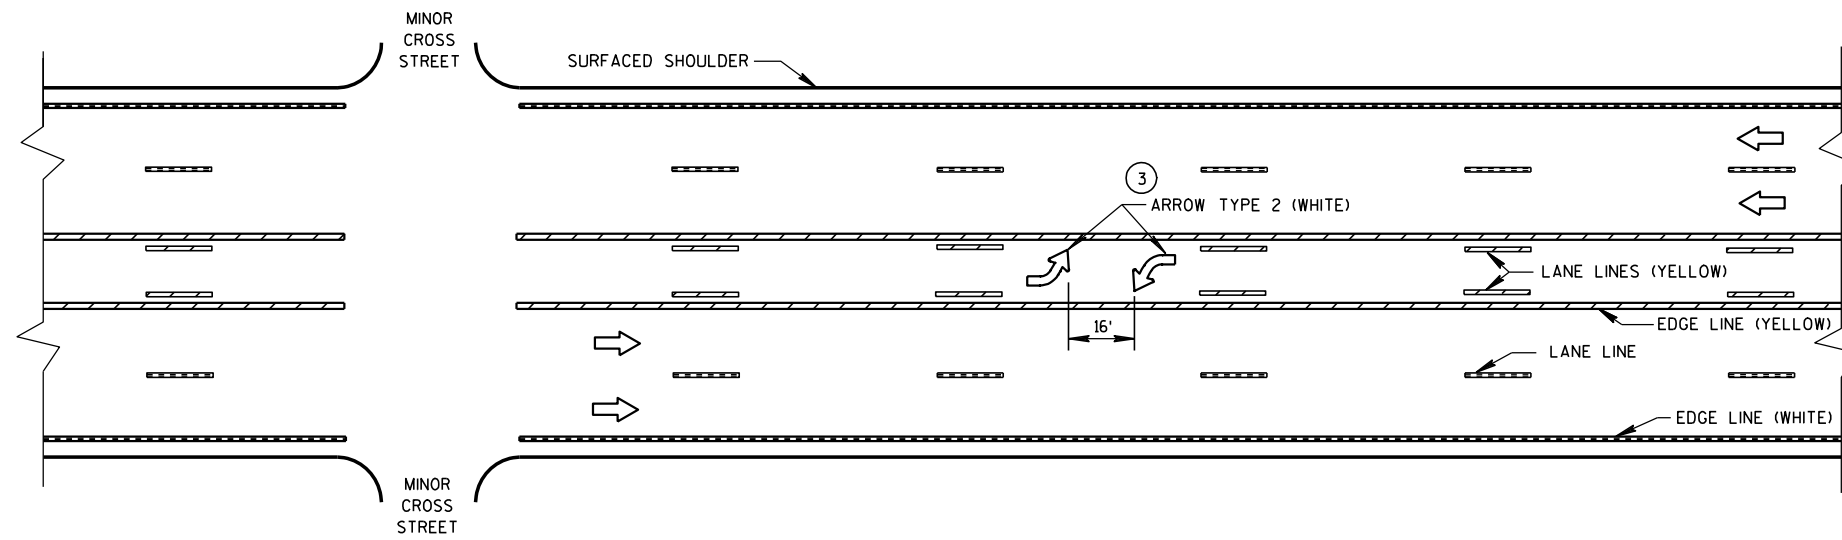


**TWO WAY LEFT TURN LANE**

**GENERAL NOTES**


- ① STOP BAR IS REQUIRED ONLY WHEN SPECIFIED IN THE CONTRACT.
- ② DISTANCE MAY BE ADJUSTED TO ACCOMODATE SHORT LEFT TURN LANES. AS APPROVED BY THE ENGINEER.
- ③ A SET OF ARROWS IS REQUIRED EVERY 400' OR NEAR INTERSECTIONS OR DRIVEWAYS WITH TURNING TRAFFIC.
- ④ ADD EXTRA ARROW AND ONLY PER 160' OR WHEN ON A CURVE.
- ⑤ 8" WHITE WITH 2' LINE 6' GAPS FOR DUAL TURN LANE.
- ⑥ 8" WHITE
- ⑦ ADD SECOND ARROW WHEN TURN BAY IS GREATER THAN OR EQUAL TO 108'.
- ⑧ REQUIRED ONLY WHEN SPECIFIED IN THE CONTRACT.

NOTE:  
ARROW SYMBOL ( → )  
SHOWS DIRECTION OF TRAVEL

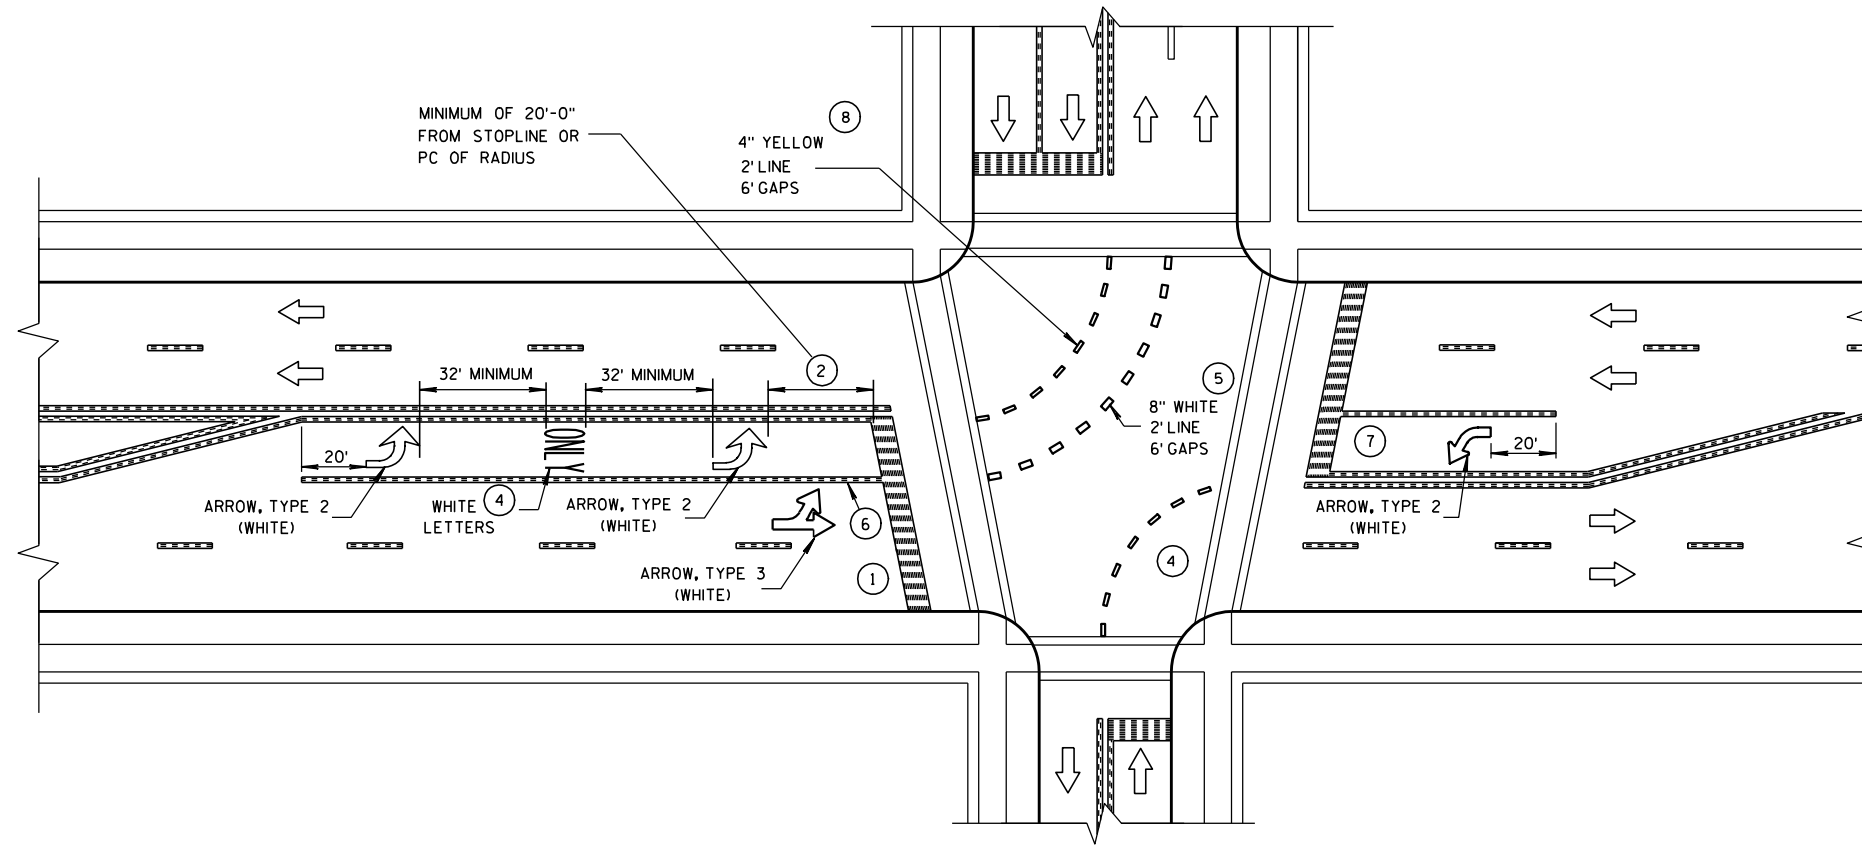


**PAVEMENT MARKING  
(LEFT TURN LANE)**


STATE OF WISCONSIN  
DEPARTMENT OF TRANSPORTATION

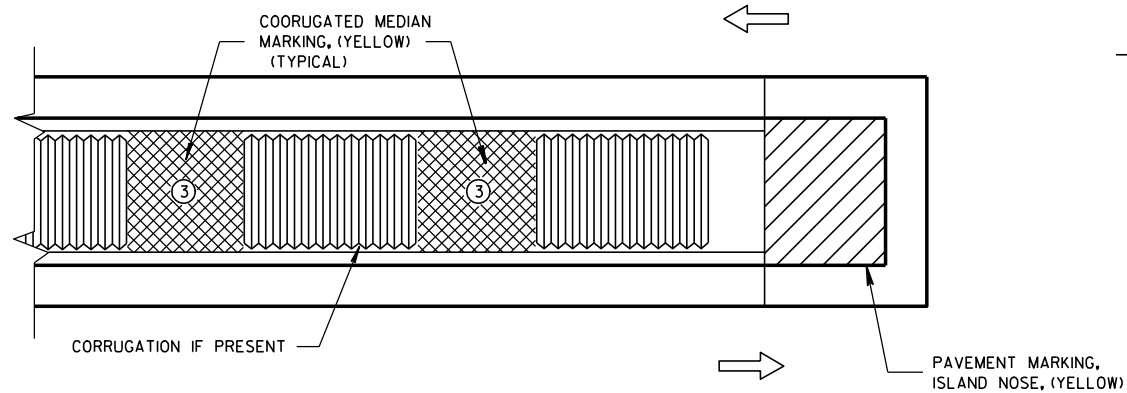

**MEDIAN ISLAND WITH SQUARE BLUNT NOSE**

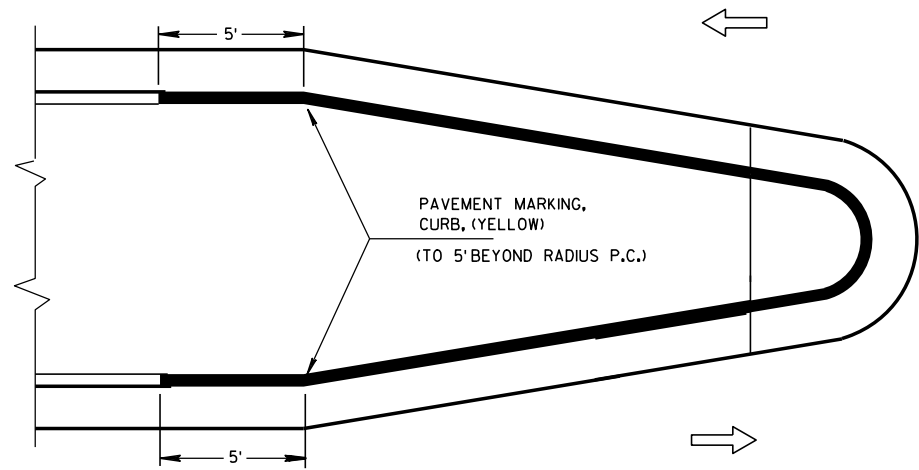


**MEDIAN ISLAND WITH ROUND BLUNT NOSE**

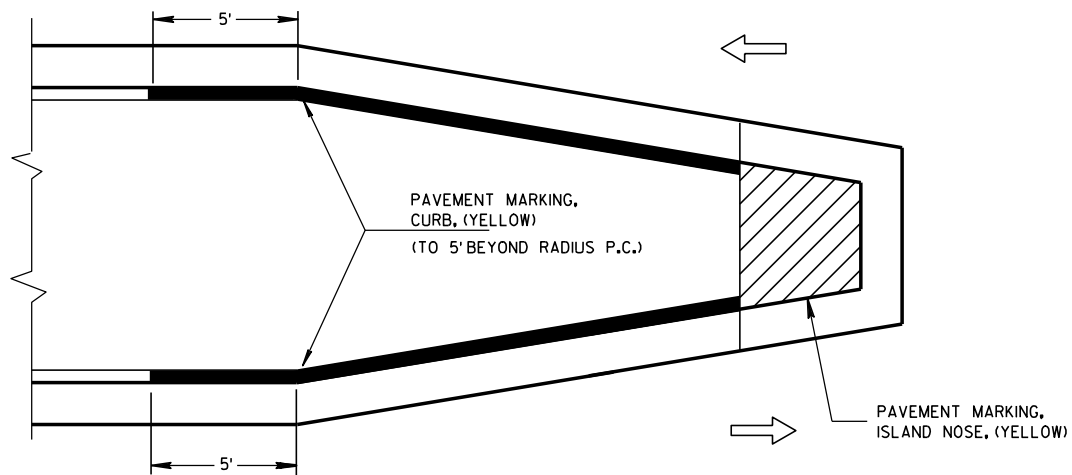


**MEDIAN ISLAND WITH SLOPED NOSE**

**TYPICAL PLACEMENT OF PAVEMENT MARKING ON MEDIAN ISLANDS**

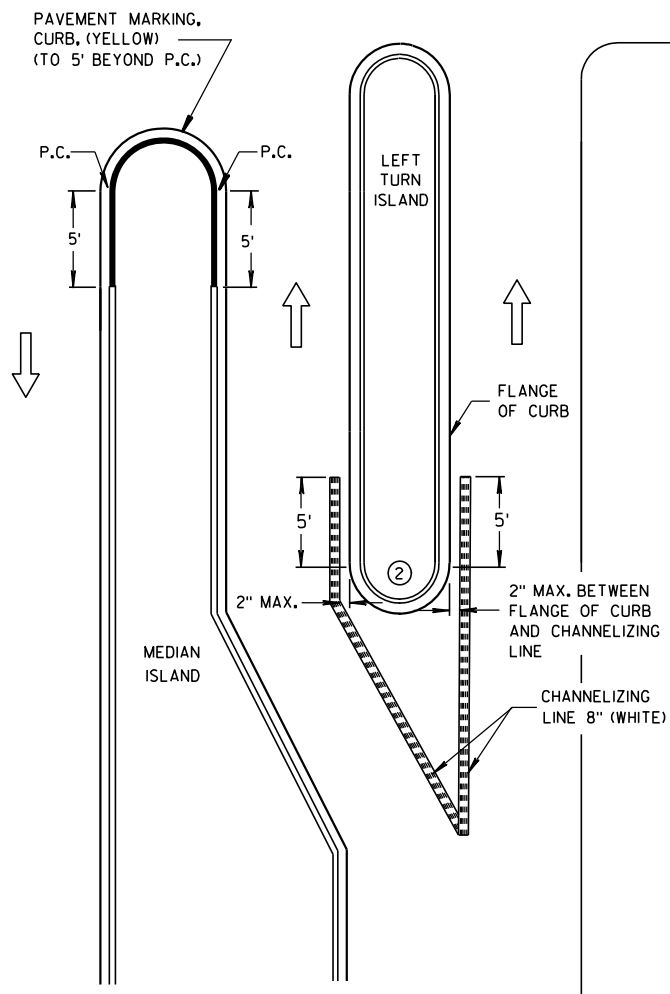

**LEFT TURN & MEDIAN ISLAND**

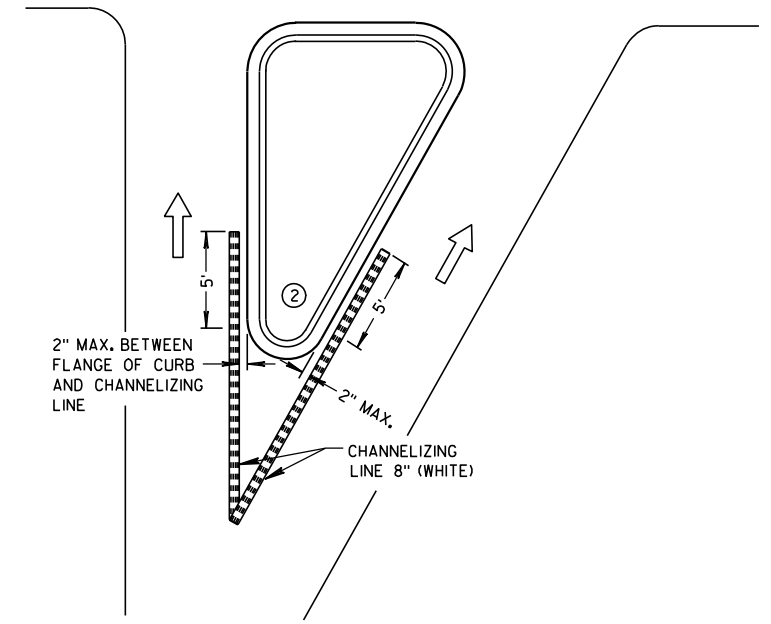


**RIGHT TURN ISLAND**

**GENERAL NOTES**

- ① STOP LINE IS REQUIRED ONLY WHEN SPECIFIED IN THE CONTRACT.
- ② DO NOT MARK CURB NOSES THAT SEPARATE LANES OF TRAFFIC TRAVELING IN THE SAME DIRECTION.
- ③ WHEN CONCRETE CORRUGATED MEDIAN IS CONSTRUCTED TO SEPARATE TRAFFIC OPERATING IN THE OPPOSING DIRECTION YELLOW PAVEMENT MARKING SHALL BE APPLIED TO THE FLAT PORTION OF THE CONCRETE CORRUGATED MEDIAN. THE ITEM OF PAVEMENT MARKING, CONCRETE CORRUGATED MEDIAN, WILL BE MEASURED IN PLACE AND ACCEPTED IN ACCORDANCE WITH THE CONTRACT AND PAID FOR AT THE CONTRACT UNIT PRICE PER SQUARE FOOT.

**LEGEND**

- ISLAND NOSE MARKING
- CURB MAKING
- CORRUGATED MEDIAN MARKING
- DIRECTION OF TRAVEL

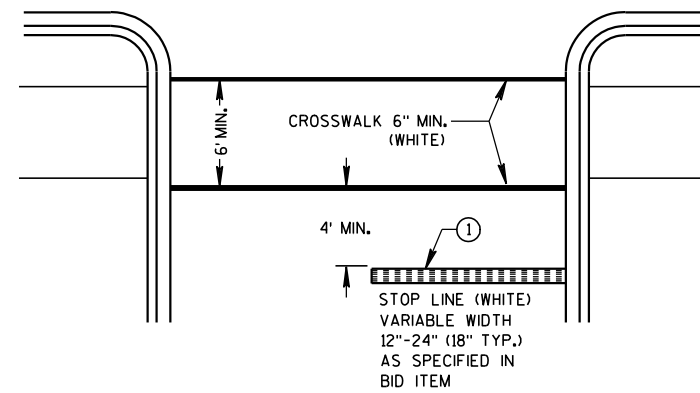


**STOP LINE AND CROSSWALK**

**PAVEMENT MARKING (ISLANDS, STOP LINE & CROSS WALK)**  
STATE OF WISCONSIN DEPARTMENT OF TRANSPORTATION



W14-3

500'

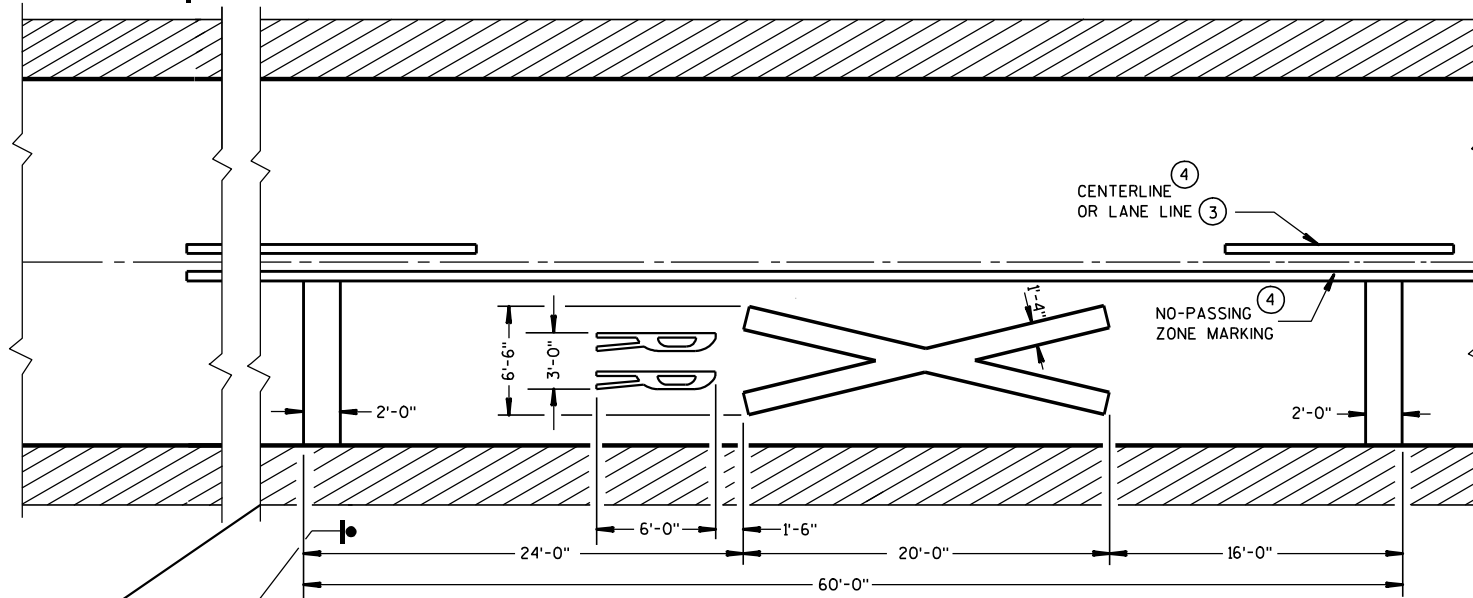

CENTERLINE OR LANE LINE (3)

NO-PASSING ZONE MARKING (4)

(5) (SEE TABLE)


**PREFERRED PAVEMENT MARKING**



W10-1

MATCH LINE

6

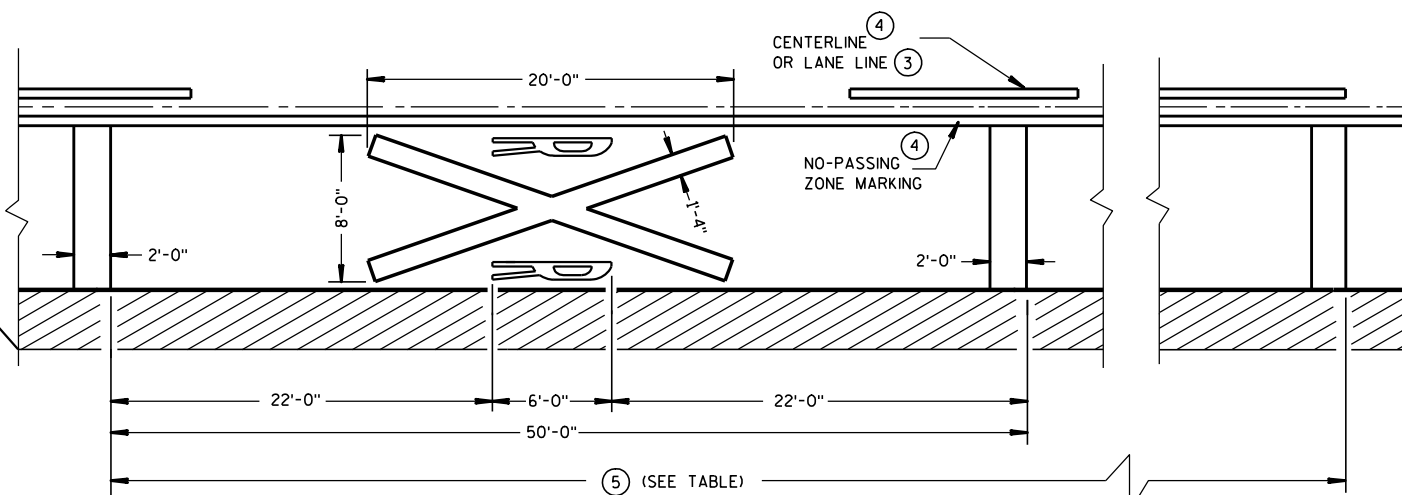


CENTERLINE OR LANE LINE (3)

NO-PASSING ZONE MARKING (4)

(5) (SEE TABLE)

**ALTERNATE PAVEMENT MARKING**

Posted Speed (M.P.H.)	Minimum Dimension (Feet)
25	150
30	200
35	250
40	300
45	400
50	550
55	750
60	1000
65	1000

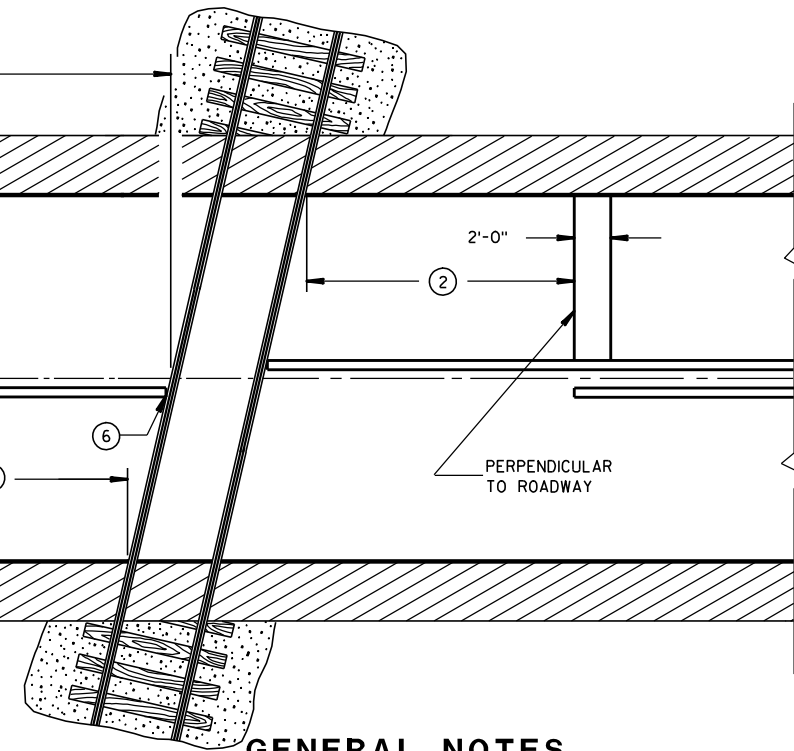

PERPENDICULAR TO ROADWAY

**GENERAL NOTES**


DETAILS OF CONSTRUCTION, MATERIALS, AND WORKMANSHIP NOT SHOWN ON THIS DRAWING SHALL CONFORM TO THE PERTINENT REQUIREMENTS OF THE STANDARD SPECIFICATIONS AND THE APPLICABLE SPECIAL PROVISIONS.

A THREE-LANE ROADWAY SHOULD BE MARKED WITH A CENTERLINE FOR TWO-LANE APPROACH OPERATION ON THE APPROACH TO A CROSSING.

ON MULTI-LANE ROADS THE TRANSVERSE BANDS SHOULD EXTEND ACROSS ALL APPROACH LANES, AND INDIVIDUAL R X R SYMBOLS SHOULD BE USED IN EACH APPROACH LANE. ALL LETTERS AND SYMBOLS SHALL BE IN CONFORMANCE WITH THE "STANDARD ALPHABETS FOR HIGHWAY SIGNS AND PAVEMENT MARKINGS" (ADOPTED BY THE FEDERAL HIGHWAY ADMINISTRATION).

CENTER OR LANE LINES AND NO-PASSING ZONE MARKINGS SHOWN ON THIS DRAWING ARE REQUIRED AND PAID FOR UNDER OTHER ITEMS IN THE CONTRACT.


- ① A PORTION OF THE PAVEMENT MARKING SYMBOL SHOULD BE DIRECTLY OPPOSITE THE ADVANCE WARNING SIGN (W10-1).
- ② MINIMUM 8' FROM ANY RAILROAD WARNING DEVICES (SIGNALS, GATES, ETC.) OR 25' FROM THE NEAREST RAIL, WHICHEVER DISTANCE IS GREATER.
- ③ REFLECTIVE WHITE.
- ④ REFLECTIVE YELLOW 500' MINIMUM. MARKING LIMITS MAY BE EXTENDED AS DIRECTED BY THE ENGINEER TO MEET ADJACENT NO-PASSING ZONE MARKINGS.
- ⑤ TABLE BASED UPON 2C-4 WISCONSIN SUPPLEMENT OF MANUAL ON UNIFORM TRAFFIC CONTROL DEVICES.
- ⑥ FOR MULTIPLE TRACK CROSSINGS, THE BARRIER LINE SHALL EXTEND TO THE NEAR RAIL OF THE FURTHEST TRACK IN THE DIRECTION OF HIGHWAY TRAVEL.

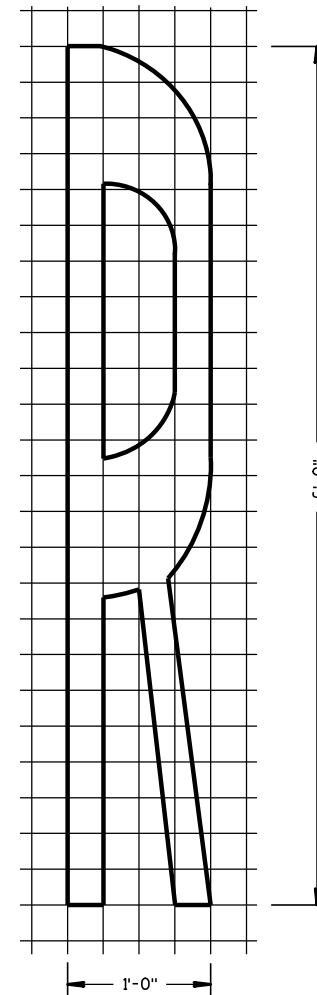

**SIGNING AND PAVEMENT MARKING  
DETAILS FOR RAILROAD-HIGHWAY  
GRADE CROSSINGS**

STATE OF WISCONSIN  
DEPARTMENT OF TRANSPORTATION


APPROVED  
5-13-10 /S/ Thomas N. Notbohm  
DATE STATE TRAFFIC ENGINEER OF DESIGN  
FHWA

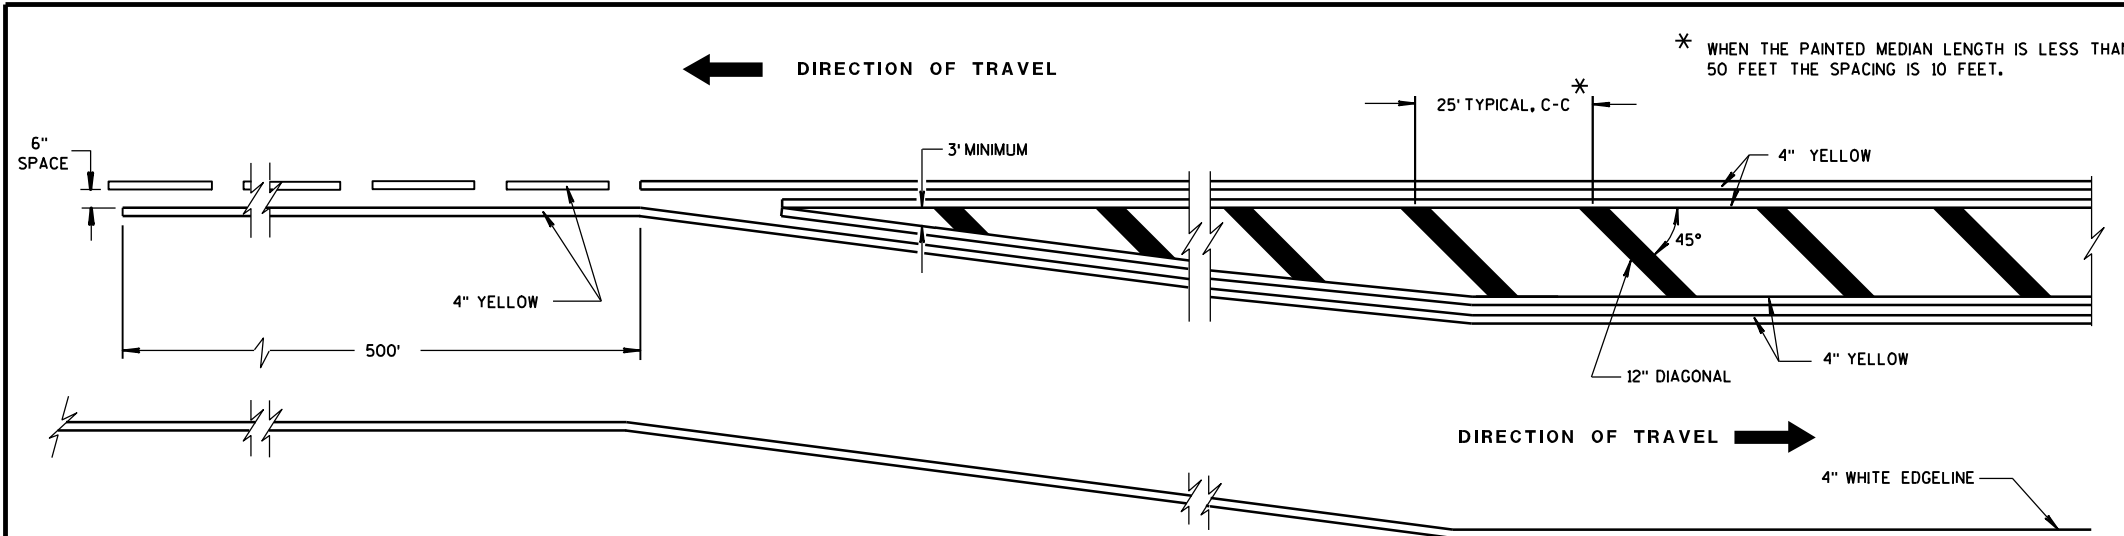


**GENERAL NOTE**

DIAGONALS ARE OPTIONAL WHEN PAINTED ISLAND IS LESS THAN 6 FEET AT WIDEST POINT.

**MEDIAN ISLAND DETAIL**

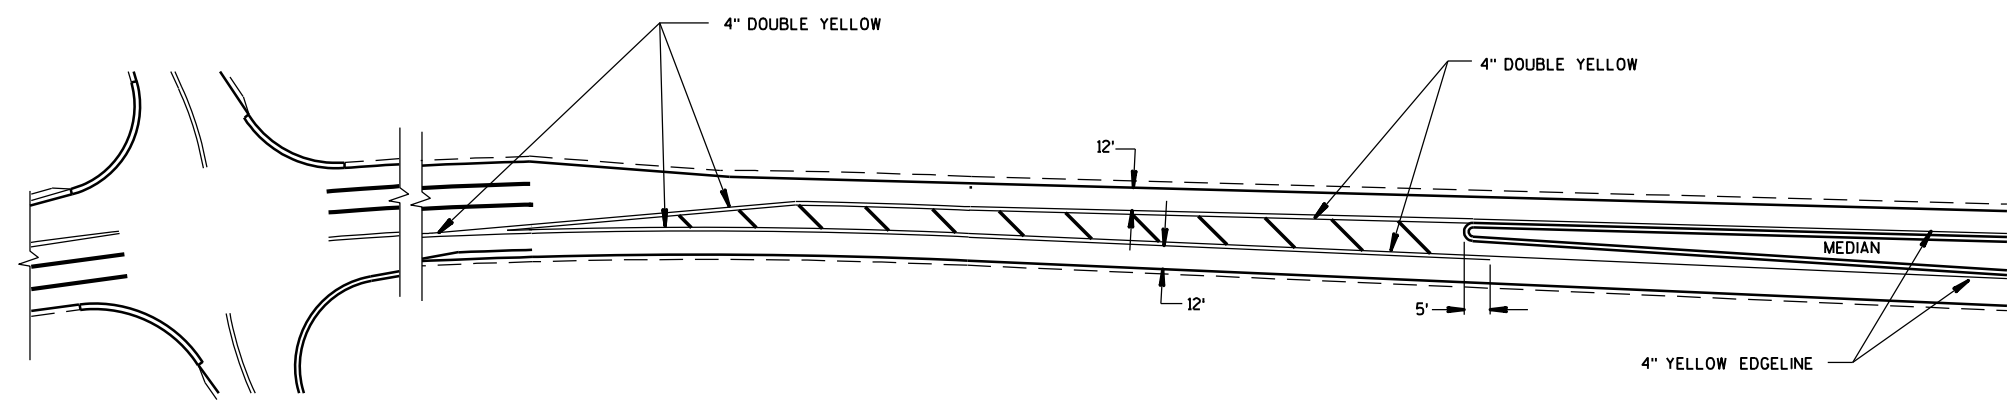

**APPROACH MARKINGS FOR OTHER MEDIAN TYPES**

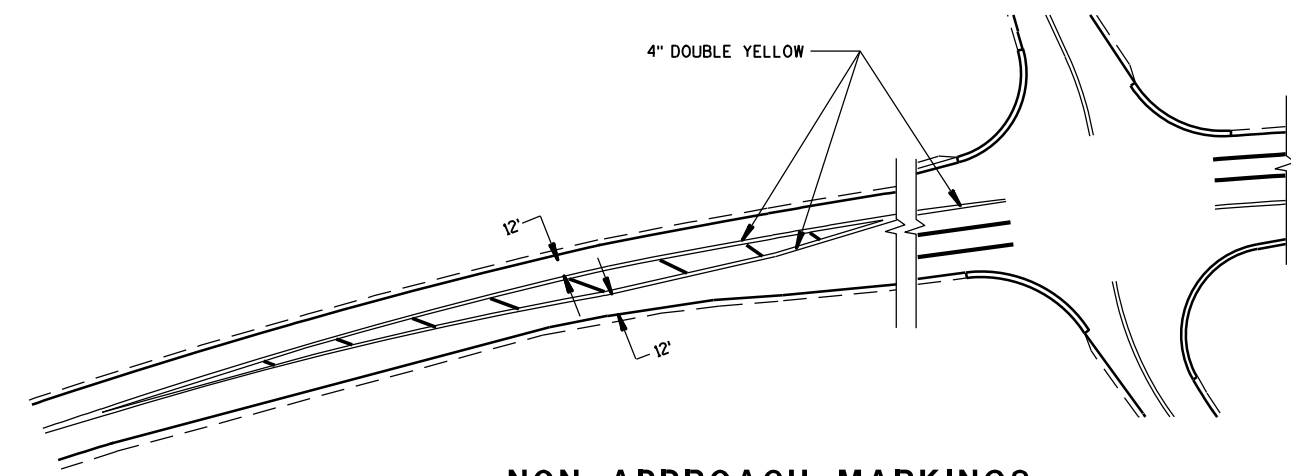

**NON APPROACH MARKINGS**

<b>MEDIAN ISLAND MARKING</b>	
STATE OF WISCONSIN DEPARTMENT OF TRANSPORTATION	
APPROVED 2-5-09 DATE	/S/ Thomas N. Notbohm STATE TRAFFIC ENGINEER OF DESIGN
FHWA	

6

6

S.D.D. 15 C 18-3


S.D.D. 15 C 18-3

**GENERAL NOTES**


SIGN LOCATIONS SHOWN ARE TYPICAL PLACEMENT AND MAY BE ADJUSTED BY THE ENGINEER AS FIELD CONDITIONS DICTATE.

THE MINIMUM NUMBER OF END-OF-ROADWAY SIGNS ARE THREE (AS SHOWN). ADDITIONAL END-OF-ROADWAY SIGNS MAY BE INSTALLED AS FIELD CONDITIONS DICTATE. (SEE SIGNING PLAN).

WHEN BEAMGUARD IS REQUIRED, PLACE END-OF-ROADWAY SIGNING BEHIND BEAMGUARD.

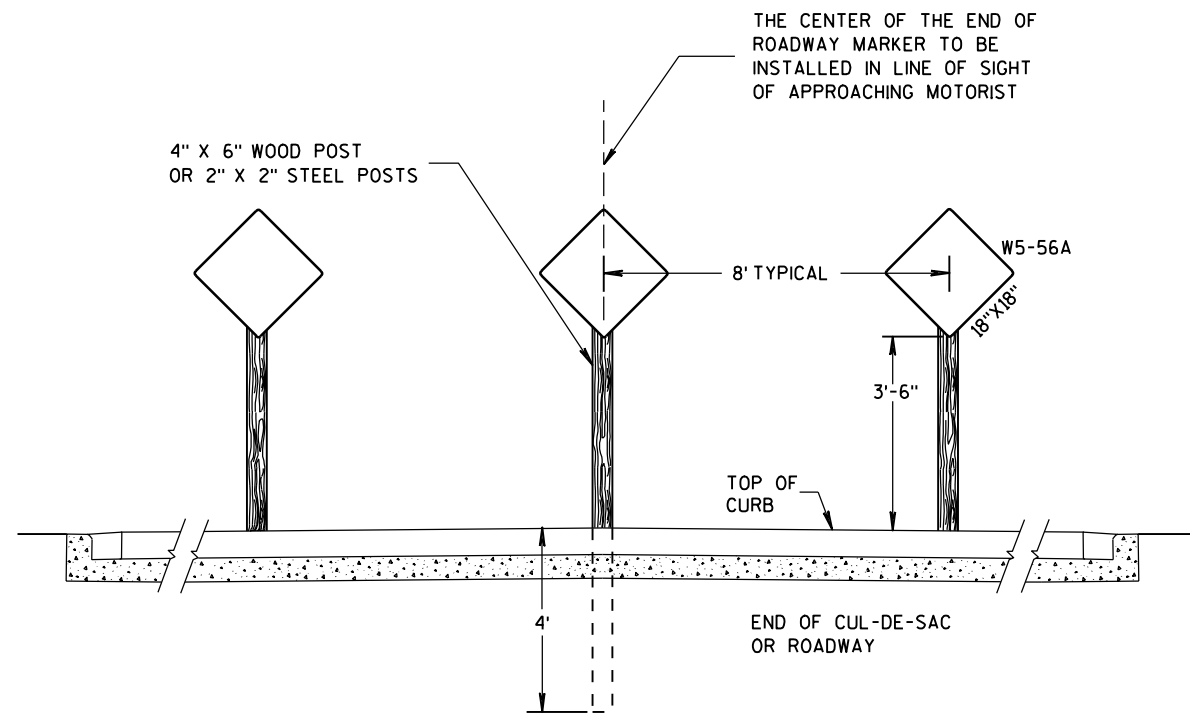

**TYPICAL URBAN SIGN INSTALLATION  
(WITH CURB & GUTTER)**

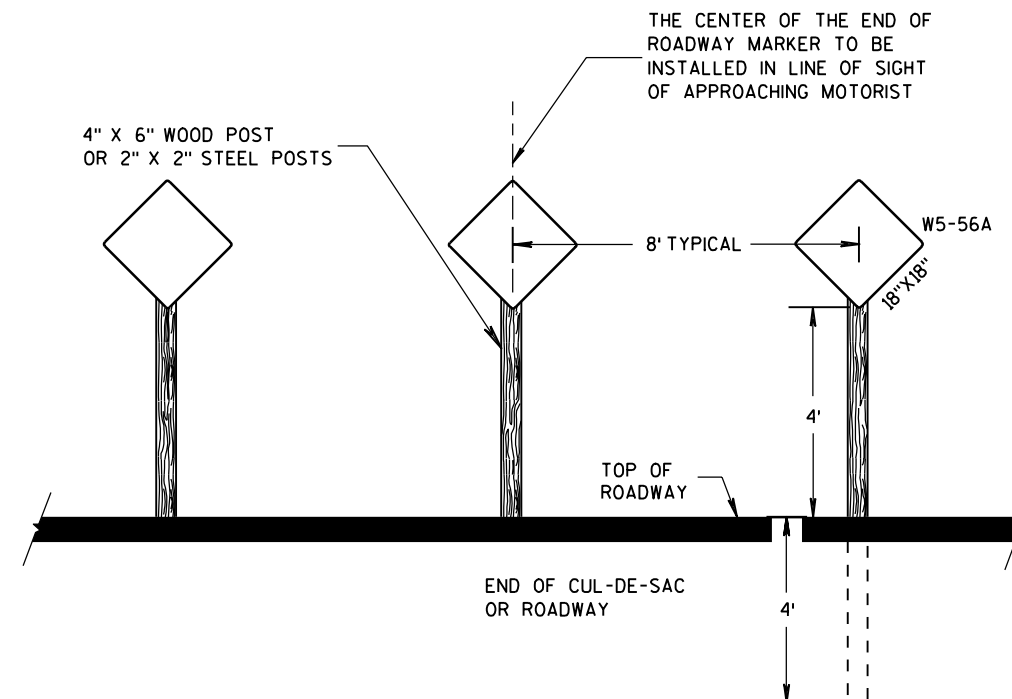

**TYPICAL RURAL SIGN INSTALLATION  
(WITHOUT CURB & GUTTER)**

6


6

S.D.D. 15 C 26-1

S.D.D. 15 C 26-1

<b>END-OF-ROADWAY SIGNING</b>	
STATE OF WISCONSIN DEPARTMENT OF TRANSPORTATION	
APPROVED 12-5-07 DATE	/S/ Thomas N. Notbohm STATE TRAFFIC ENGINEER OF DESIGN
FHWA	



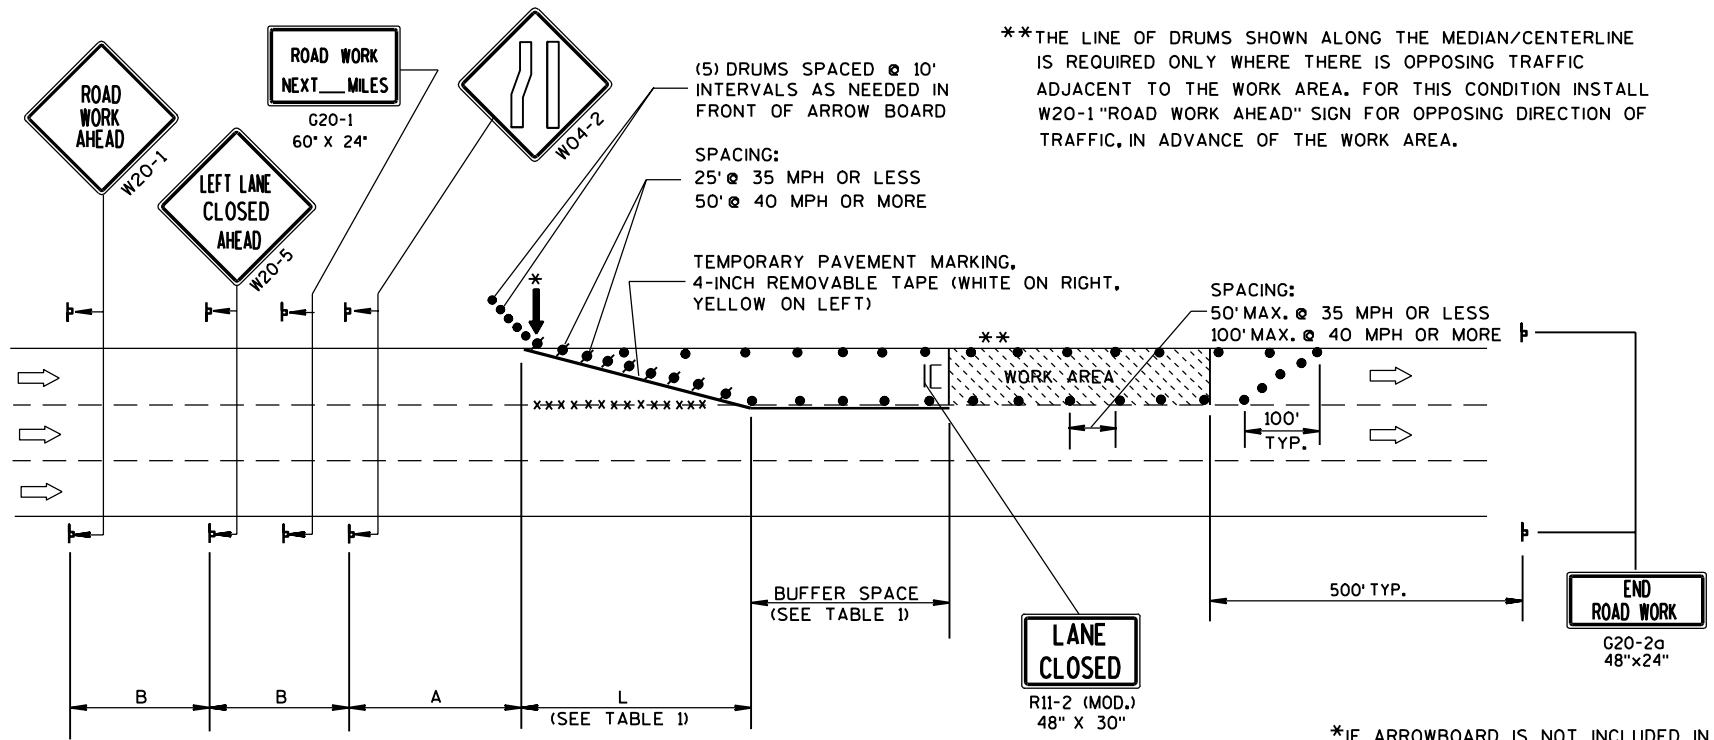

B=400' AT 25-30 MPH  
700' AT 35-40 MPH  
1000' AT 45-55 MPH

A=200' AT 25-30 MPH  
350' AT 35-40 MPH  
500' AT 45-55 MPH

TABLE 1  
TAPER AND BUFFER SPACE  
FOR 12' LANE WIDTH


S	L	BUFFER SPACE
25	125'	55'
30	180'	85'
35	245'	120'
40	320'	170'
45	540'	220'
50	600'	280'
55	660'	335'

FOR LANE WIDTH OTHER THAN 12':  
 L = WS AT 45 MPH OR GREATER  
 $L = \frac{WS^2}{60}$  AT 40 MPH OR LESS  
 L = TAPER LENGTH IN FEET  
 S = NON-CONSTRUCTION SPEED LIMIT (MPH)  
 W = WIDTH OF LANE CLOSURE

\*\*THE LINE OF DRUMS SHOWN ALONG THE MEDIAN/CENTERLINE IS REQUIRED ONLY WHERE THERE IS OPPOSING TRAFFIC ADJACENT TO THE WORK AREA. FOR THIS CONDITION INSTALL W20-1 "ROAD WORK AHEAD" SIGN FOR OPPOSING DIRECTION OF TRAFFIC, IN ADVANCE OF THE WORK AREA.

(PLACE BARRICADE AND SIGN APPROX. EVERY 1000' ACROSS THE CLOSED LANE)

\*IF ARROWBOARD IS NOT INCLUDED IN MISCELLANEOUS QUANTITIES, SUBSTITUTE A TYPE III BARRICADE WITH W01-6 SIGN IN THE LANE CLOSURE TAPER.

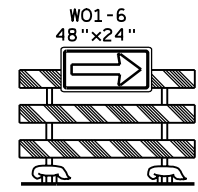

LEGEND

- /● DRUM WITH/WITHOUT WARNING LIGHT, TYPE C (STEADY-BURN)
- ⊥ POST MOUNTED SIGN
- ↑ ARROW BOARD
- IC/C TYPE III BARRICADE (8' EQUIVALENT) AND WARNING LIGHTS, TYPE A (FLASHING) WITH/WITHOUT SIGN
- DIRECTION OF TRAFFIC FLOW
- xxxx REMOVING PAVEMENT MARKING (SEE GENERAL NOTES)

GENERAL NOTES

THIS LANE CLOSURE DETAIL IS TYPICAL FOR CLOSING THE LEFT LANE. FOR A RIGHT LANE CLOSURE, REVERSE THE TRAFFIC CONTROL.

THIS DETAIL MAY BE USED FOR ROADWAYS WITH EITHER TWO OR THREE LANES IN EACH DIRECTION.

THE EXACT NUMBER, LOCATION, AND SPACING OF ALL SIGNS AND DEVICES SHALL BE ADJUSTED TO FIT FIELD CONDITIONS AS APPROVED BY THE ENGINEER.

THE SPACING BETWEEN TRAFFIC CONTROL SIGNS SHOULD BE ADJUSTED TO NOT CONFLICT WITH AND SHOULD PROVIDE A DESIRABLE MINIMUM OF 200 FEET CLEARANCE TO EXISTING SIGNS THAT WILL REMAIN IN PLACE.

ALL SIGNS ARE 48"x48" UNLESS OTHERWISE NOTED. IF NECESSARY DUE TO SPACE CONSTRAINTS IN URBAN AREAS, 36" X 36" SIGNS MAY BE USED IF APPROVED BY DISTRICT TRAFFIC UNIT.

"W0" SIGNS ARE THE SAME AS "W" SIGNS EXCEPT THE BACKGROUND IS ORANGE.

SIGNS THAT WILL BE IN PLACE LESS THAN 7 CONTINUOUS DAYS AND NIGHTS, OR THAT WILL BE PLACED IN A CLOSED LANE, MAY BE MOUNTED ON PORTABLE SUPPORTS.

ANY SIGNS TEMPORARY OR EXISTING, WHICH CONFLICT WITH TRAFFIC CONTROL "IN USE" SHALL BE REMOVED OR COVERED AS NEEDED AND AS APPROVED BY THE ENGINEER.

REMOVE PAVEMENT MARKINGS AND PLACE TEMPORARY PAVEMENT MARKING, REMOVABLE TAPE IF LANE CLOSURE IS TO BE IN PLACE FOR 7 OR MORE CONTINUOUS DAYS AND NIGHTS. ON UNDIVIDED ROADWAYS, OMIT THE SIGNS SHOWN ON LEFT SIDE OF ROAD.

W20-1, G20-1 AND G20-2A SIGNS ARE NOT REQUIRED IF THE LANE CLOSURE IS WITHIN A LARGER WORK ZONE WHERE THESE SIGNS ARE ALREADY PRESENT.

OMIT G20-1 SIGNS IF LENGTH OF WORK AREA IS 2 MILES OR LESS.

CONSIDER GEOMETRICS WHEN LOCATING SIGNS AND ARROWBOARDS SO THE APPROACHING DRIVER HAS A CLEAR VIEW OF THE ARROWBOARDS AND LANE CLOSURE DRUMS.

PLACE THE ARROWBOARD AS CLOSE AS POSSIBLE TO THE BEGINNING OF THE LANE CLOSURE TAPER, PREFERABLY ON THE SHOULDER OR TERRACE.

CHANNELIZING DEVICES PLACED ADJACENT TO WORK AREA SHALL BE PULLED BACK FROM THE TRAVEL LANE WHEN WORK IS NOT IN PROGRESS.

BARRICADES IN A CLOSED LANE THAT MUST BE MOVED FOR A WORK OPERATION SHALL BE IMMEDIATELY RE-ESTABLISHED UPON COMPLETION OF THE OPERATION OR, FOR CONTINUING OPERATIONS, AT THE END OF EACH WORKING DAY.

WARNING LIGHTS ARE NOT REQUIRED IF THE LANE CLOSURE IS A DAYTIME ONLY OPERATION.

**TRAFFIC CONTROL,  
SINGLE LANE CLOSURE,  
NON-FREEWAY/EXPRESSWAY**

STATE OF WISCONSIN  
DEPARTMENT OF TRANSPORTATION



APPROVED  
5/23/00  
DATE

*Christa J. Spang*  
CHIEF SIGNS AND MARKING ENGINEER

FHWA

NOTES

1. All Signs Type II - Type F Reflective - reference WIS DOT Standard Specification for HIGHWAY and STRUCTURE CONSTRUCTION latest edition.
2. Color:  
Background - ORANGE except as NOTED  
Message - BLACK
3. Message Series - D

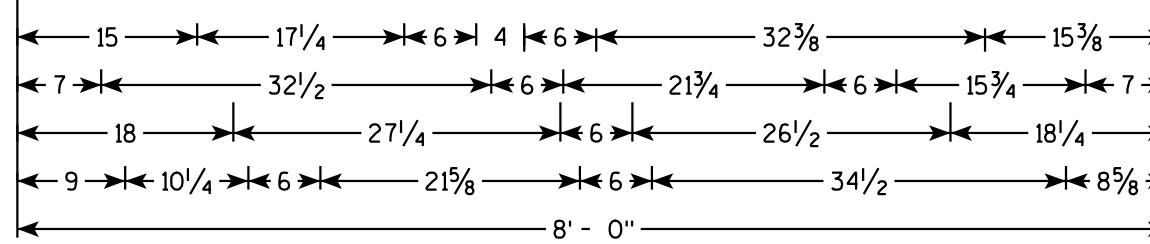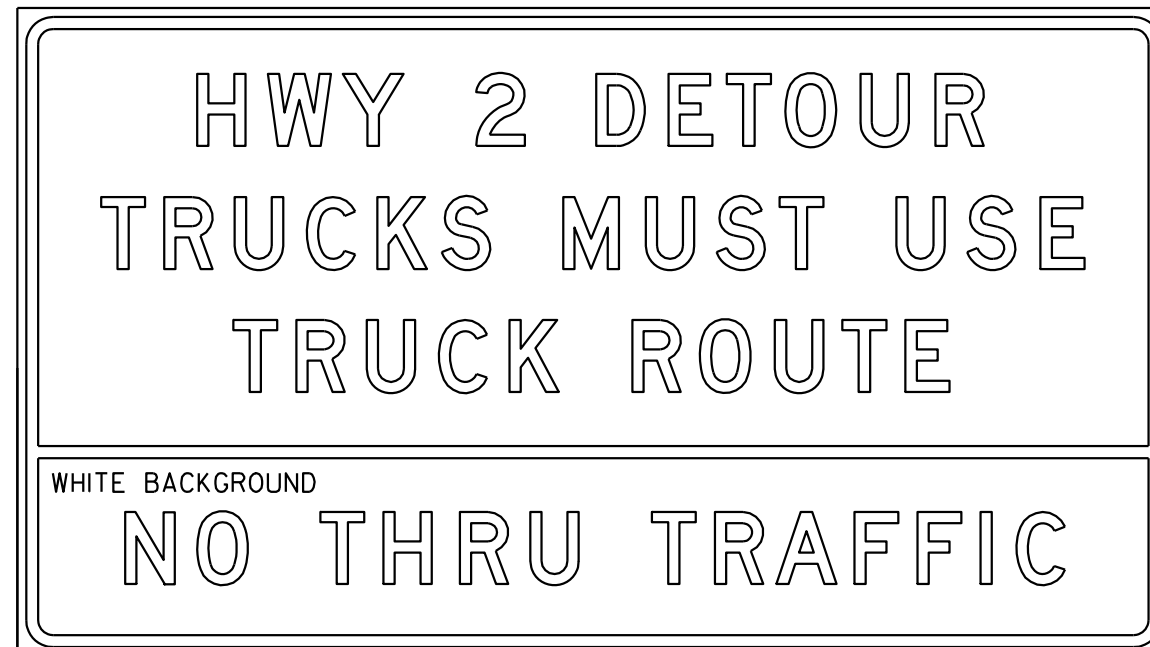


1" Border  
3/4" Margin  
2 1/4" Radius

7

7

NOTES

- 1. Sign is Type II - Type H Reflective - reference WIS DOT Standard Specification for HIGHWAY and STRUCTURE CONSTRUCTION latest edition.
- 2. Color:  
 Background - GREEN  
 Message - WHITE
- 3. Message Series - E

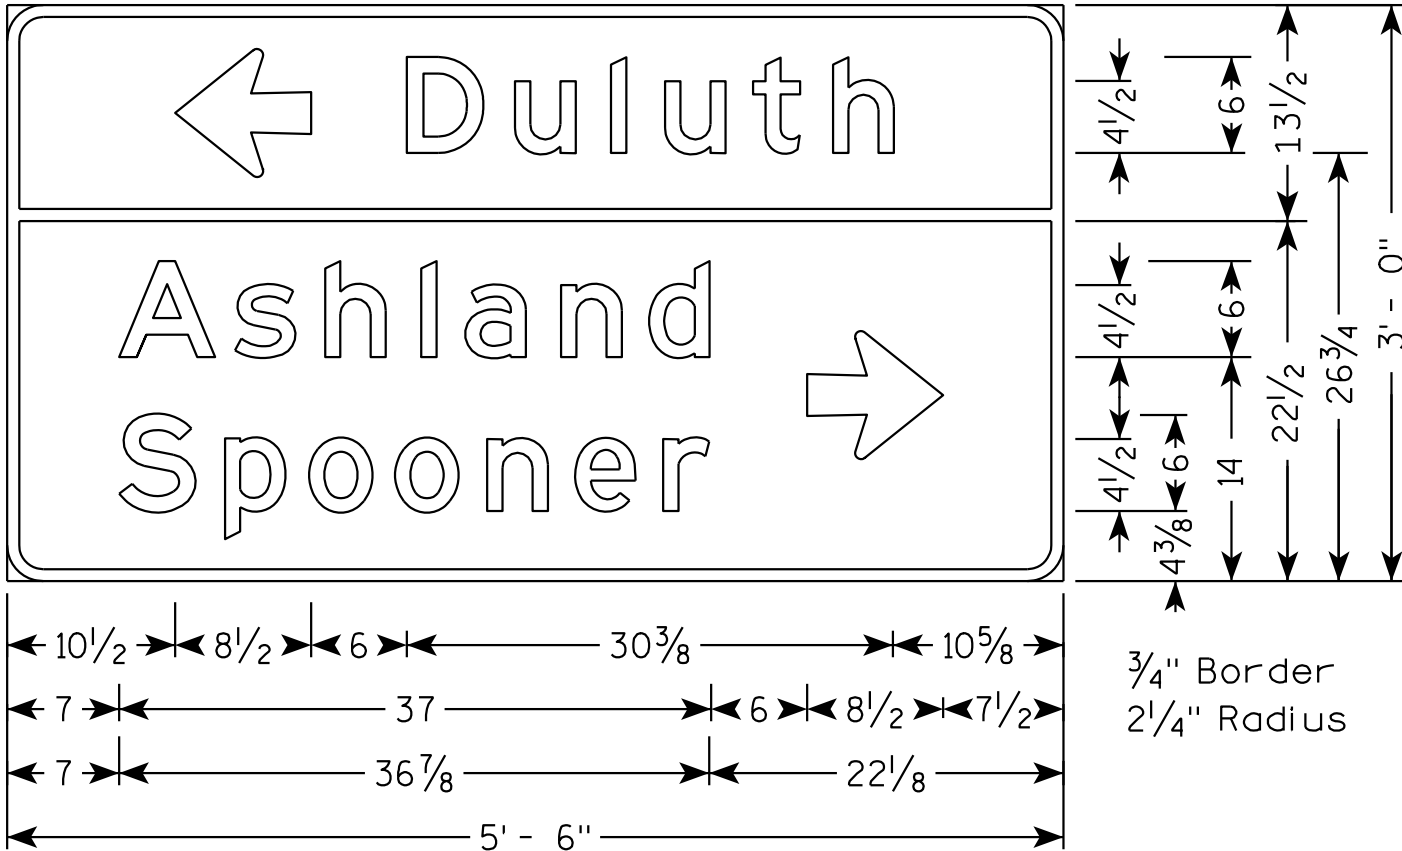


D1-3


7

7


# TYPICAL ASSEMBLIES

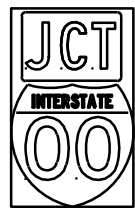

J1-1

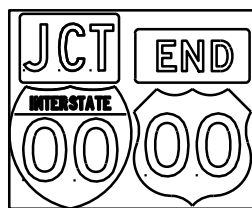

J1-2

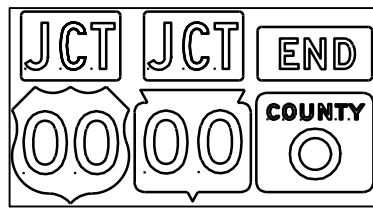


J1-3




JV




J2-1

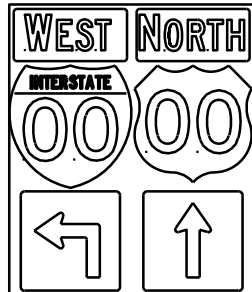


J2-2

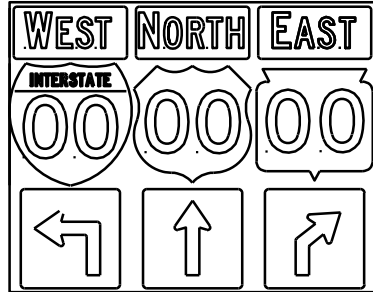


J2-3

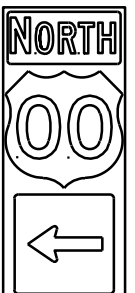

J3-1

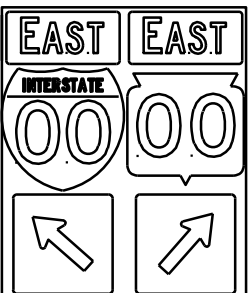


J3-2

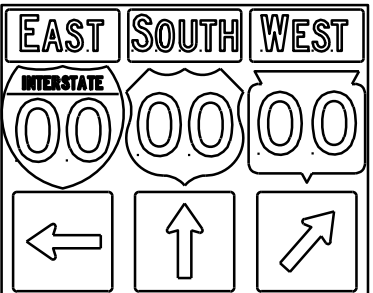


J3-3




J4-1

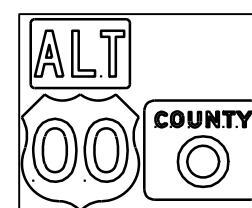

J4-2

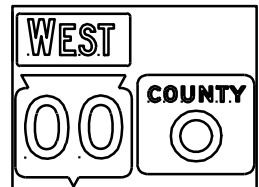

J4-2

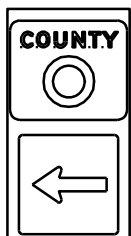

J13-1



J12-1



J32-1



J33-1






J23-1



J22-1

[blue background with interstate]

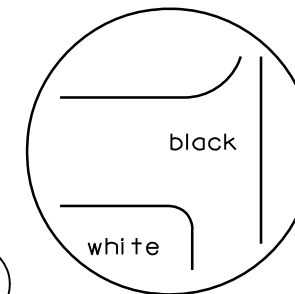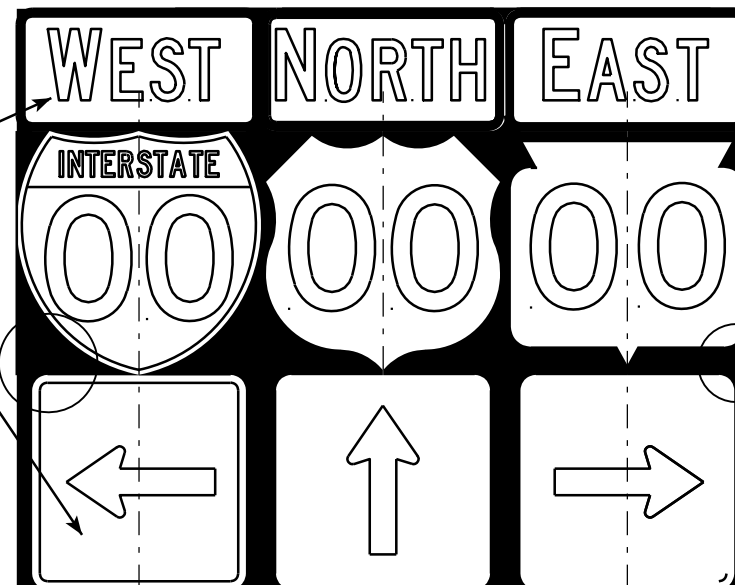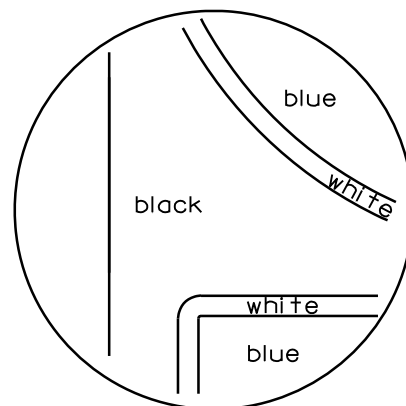


[black background]

## NOTES


- Signs are Type II - Type H Reflective - reference WIS DOT Standard Specification for HIGHWAY and STRUCTURE CONSTRUCTION latest edition.
- Color:  
Background - Black Non-reflective  
Message - see Note 5
- Message Series - See Note 5
- Corners shall be square since base material is plywood.
- The colors and message spacing on each marker shall be according to the applicable route marker panel specifications.
- Certain marker heads require the component pieces to be the same color. As an example, all the components used with an M1-1 Interstate marker shall be blue.
- Single panel j-assemblies shall only be used with route marker shields that are same size. If the route marker shields are different size use multiple piece component.
- Route assemblies that have 24 inch route shields and have dimensions greater than 48 inches (both vertical and horizontal) shall have one horizontal splice between the arrows and route shields. Vertical splices shall not be used on route assemblies with a horizontal dimension of 144 inches or less. The contractor shall not use more than one vertical joint per sign and the joint shall be between route shields.
- Route assemblies that have 36 inch shields and have dimensions greater than 48 inches (both vertical and horizontal) shall have two horizontal splices. One horizontal splice shall be between the cardinal direction and route shields and the other horizontal splice shall be between the arrows and route shields. Vertical splices shall not be used on route assemblies with a horizontal dimension of 144 or less. The contractor shall not use more than one vertical joint per sign and the joint shall be between route shields.

ROUTE MARKERS & COMPONENTS IN TYPICAL ASSEMBLIES	
WISCONSIN DEPT OF TRANSPORTATION	
APPROVED	<i>Matthew R. Rauch</i> For State Traffic Engineer
DATE 10/21/09	PLATE NO. A2-15.6

URBAN AREA

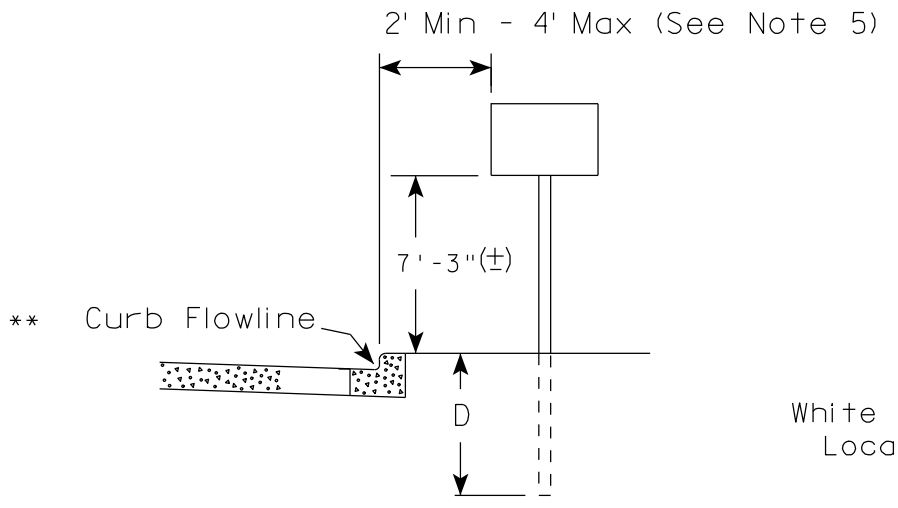



RURAL AREA (See Note 2)

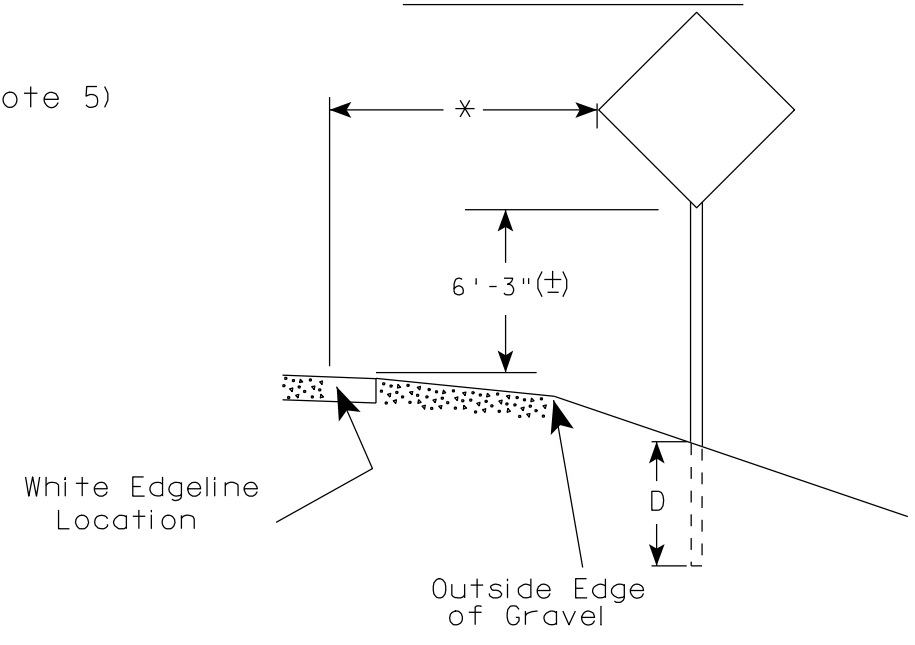

GENERAL NOTES

1. Signs wider than 4 feet or larger than 20 sq. ft. shall be mounted on multiple posts. Refer to plate A4-4.
2. If signs are mounted on barrier wall, see A4-10 sign plate.
3. For expressways and freeways, mounting height is 7'- 3" (±) or 6'-3" (±) depending upon existence of a sub-sign.
4. Minimum mounting height for J assemblies (A4-5) is 7'-3" (±) or 6'-3" (±) per urban or rural detail respectively.
5. Minimum mounting height for signs mounted on traffic signal poles is 5'- 3" (±).
6. Offset distance shall be consistent with existing signs or consistent throughout length of project.
7. The (±) tolerance for mounting height is 3 inches.
8. Folding stop signs (R1-1F) shall be mounted at a height of 5'-3" (±) or as directed by the Engineer.
9. The Double Arrow sign (W12-1) shall be mounted at a height of 2'-3" (±). The Chevron sign (W1-8), Roundabout Chevron panel (W1-8A), Clearance Markers (W5-52), Mile Markers (D10 series) & End of Road Markers (W5-56 & W5-56A) shall be mounted at a height of 4'-3" (±).

2' Min - 4' Max (See Note 5)

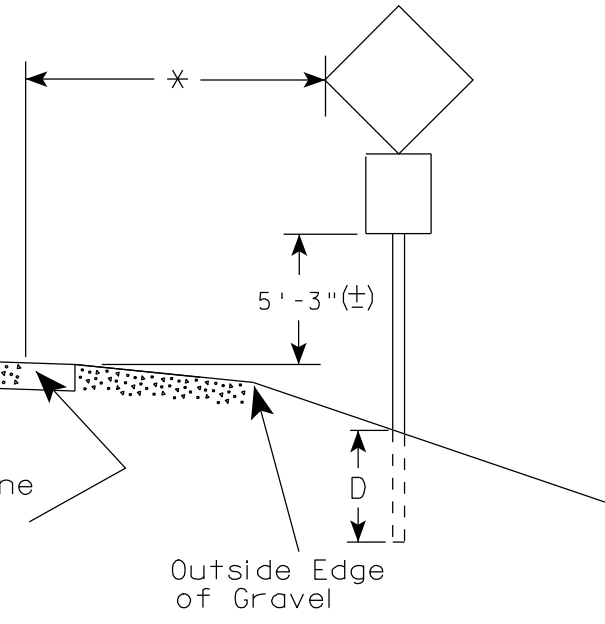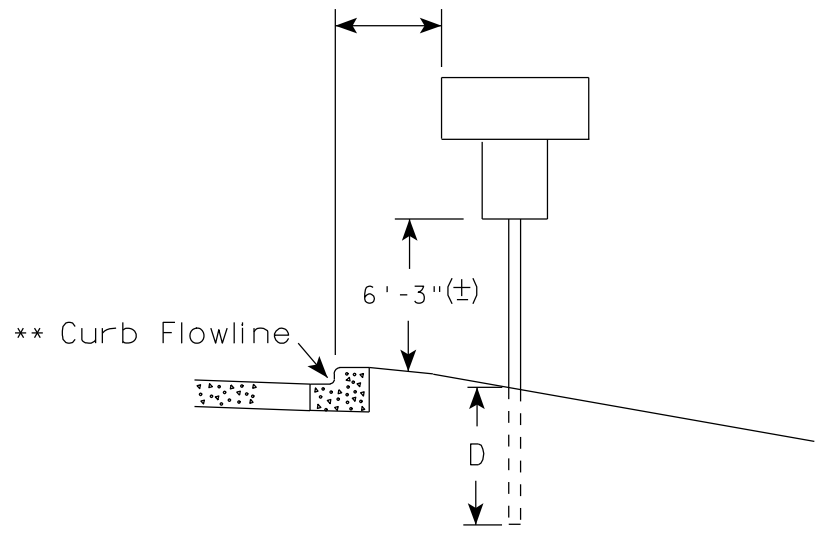

POST EMBEDMENT DEPTH

Area of Sign Installation ( Sq. Ft. )	D ( Min )
20 or Less	4'
Greater than 20	5'

\* \* The existence of curb and gutter does not in itself mandate the vertical clearance illustrated. That height is typically measured where there is sidewalk adjacent to the roadway or parking is permitted. In the absence of sidewalk vertical clearance is measured from the top of the curb. Offset of signs is measured from the flow line.

\* 6 feet from edge of a paved shoulder or 12 feet from the edge of pavement (edge line location) or 2 feet from outside edge of gravel, whichever is greater unless directed by project engineer.

TYPICAL INSTALLATION OF PERMANENT TYPE II SIGNS ON SINGLE POSTS

WISCONSIN DEPT OF TRANSPORTATION

APPROVED *Matthew R. Rauch*  
for State Traffic Engineer

DATE 9/30/09 PLATE NO. A4-3.15

**GENERAL NOTES**



1. For multiple post installations, individual post spacing shall be greater than 3'-6".
2. See tables below for required number of posts.
3. For expressways and freeways, mounting height is 7'-3" (±) or 6'-3" (±) depending upon existence of sub-sign.
4. The (±) tolerance for mounting height is 3 inches.
5. Minimum mounting height for J assemblies (A4-5) is 7'-3" (±) or 6'-3" (±) per urban or rural detail respectively.
6. Offset distance shall be consistent with existing signs or consistent throughout length of project.
7. Folding stop signs (R1-1F) shall be mounted at a height of 5'-3" (±) or as directed by the engineer.
8. The Double Arrow sign (W12-1) shall be mounted at a height of 2'-3" (±). The Chevron sign (W1-8), Roundabout Chevron panel (W1-8A), Clearance Markers (W5-52), Mile Markers (D10 series) & End of Road Markers (W5-56 & W5-56A) shall be mounted at a height of 4'-3" (±).

\* 6 feet from edge of a paved shoulder or 12 feet from the edge of pavement (edge line location) or 2 feet from outside edge of gravel, whichever is greater unless directed by project engineer.

\*\* The existence of curb and gutter does not in itself mandate the vertical clearance illustrated. That height is typically measured where there is sidewalk adjacent to the roadway or parking is permitted. In the absence of sidewalk vertical clearance is measured from the top of the curb. Offset of signs is measured from the flow line.



\*\*\* See A4-3 sign plate for signs 4' or less in width or 20 S.F. or less in area.

**URBAN AREA**

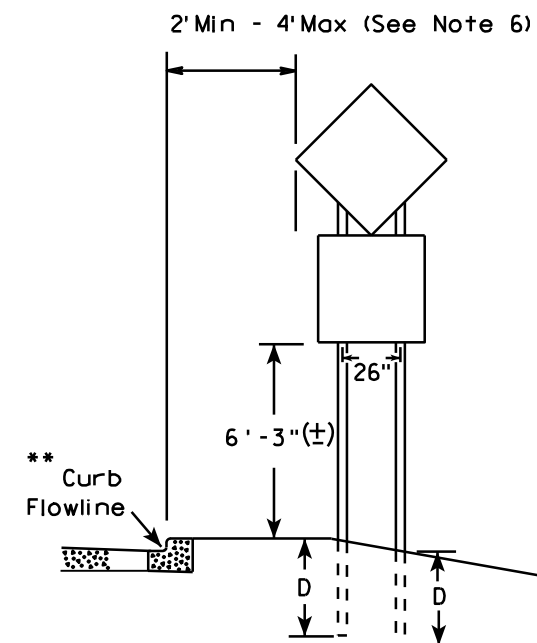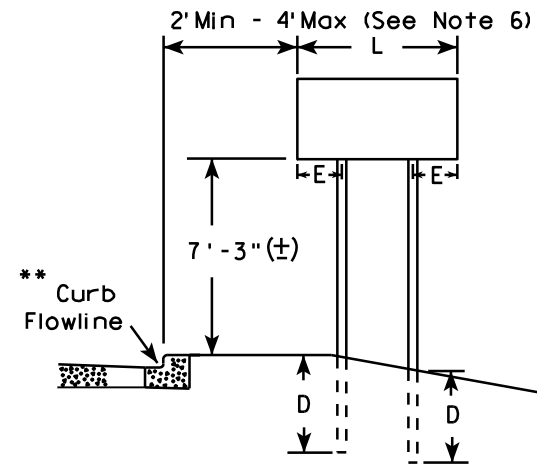


**48" DIAMOND WARNING SIGN**

**RURAL AREA (See Note 3)**

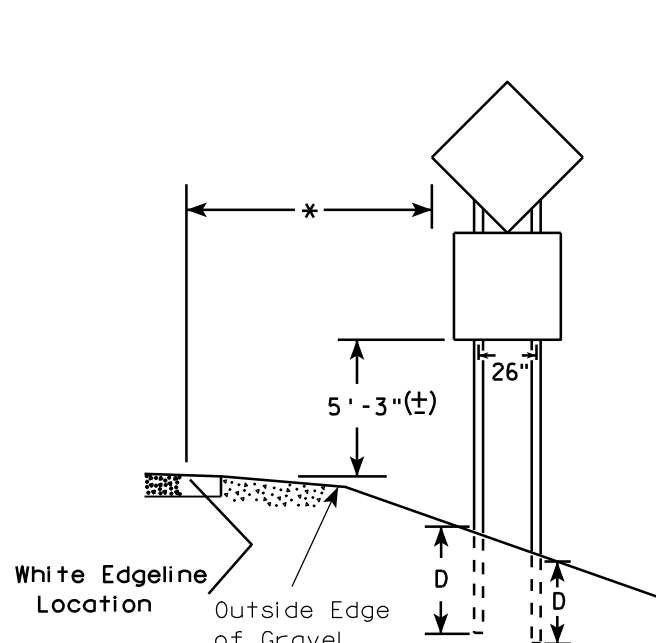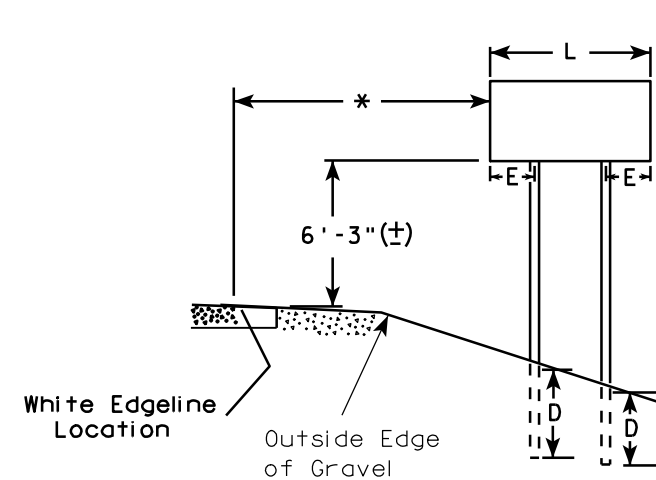

**48" DIAMOND WARNING SIGN**

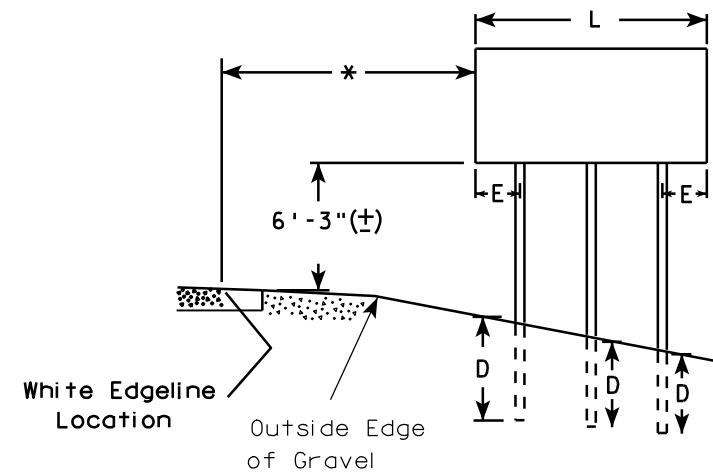

SIGN SHAPE OTHER THAN DIAMOND (TWO POSTS REQUIRED)	
L	E
Greater than 48" Less than 60"	12"
60" to 120"	L/5


SIGN SHAPE OTHER THAN DIAMOND (THREE POSTS REQUIRED)	
L	E
Greater than 120" less than 168"	12"

SIGN SHAPE OTHER THAN DIAMOND (FOUR POSTS REQUIRED)	
L	E
168" and greater	12"

**POST EMBEDMENT DEPTH**


Area of Sign Installation ( Sq. Ft. )	D ( Min )
20 or Less	4'
Greater than 20	5'

TYPICAL INSTALLATION OF TYPE II SIGNS ON MULTIPLE POSTS	
WISCONSIN DEPT OF TRANSPORTATION	
APPROVED	<i>Matthew R. Rauch</i> for State Traffic Engineer
DATE 9/30/09	PLATE NO. A4-4.10

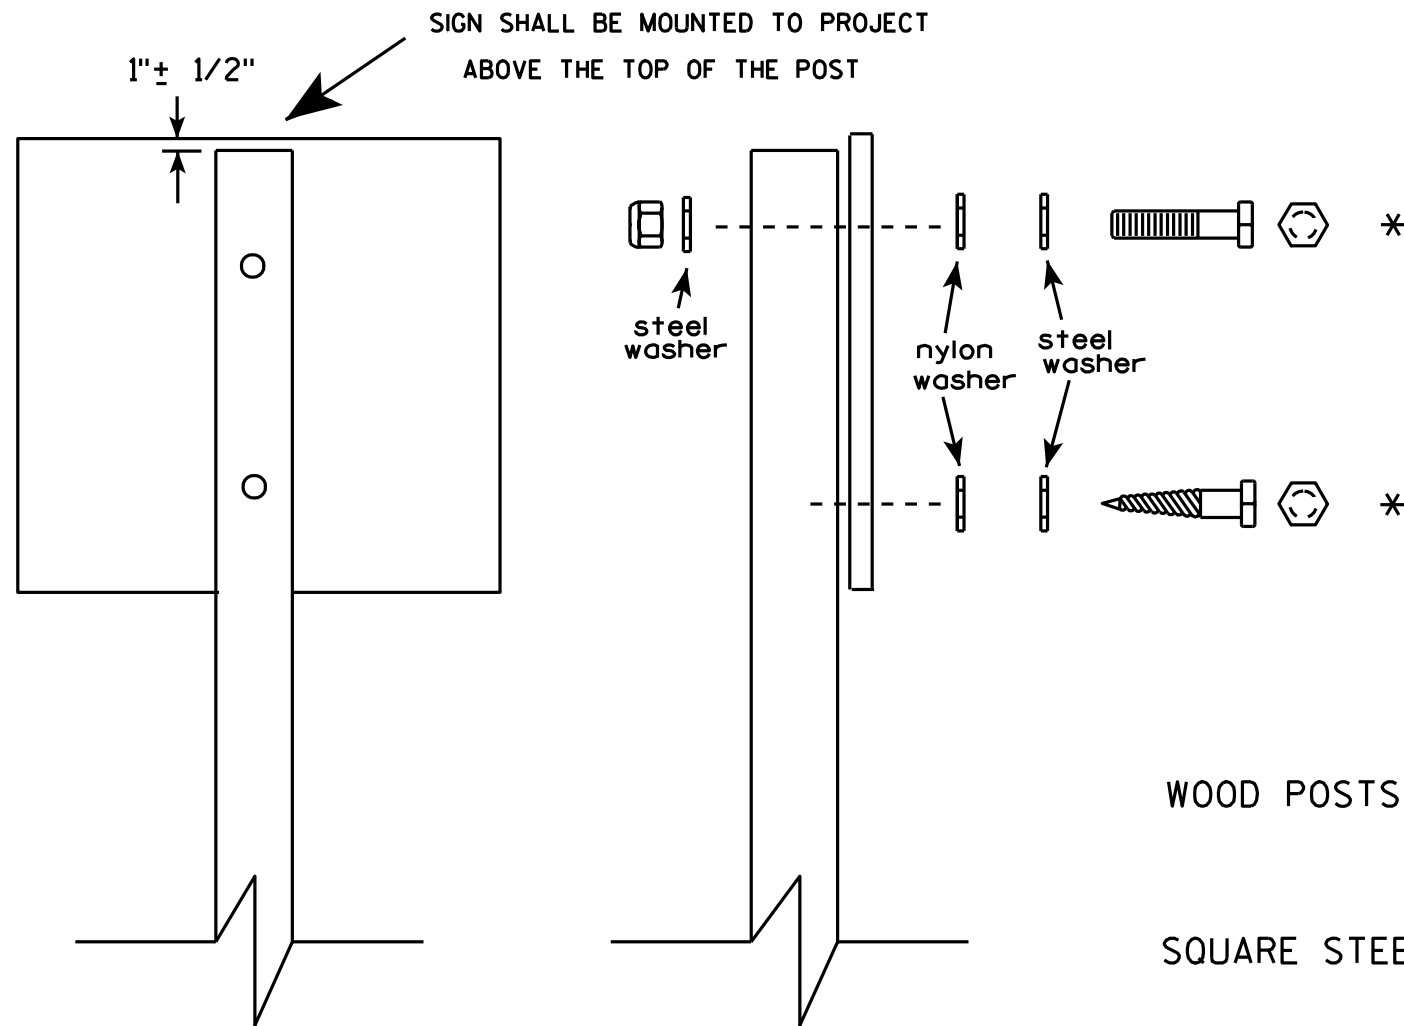

SIGN SHALL BE MOUNTED TO PROJECT ABOVE THE TOP OF THE POST

1" ± 1/2"

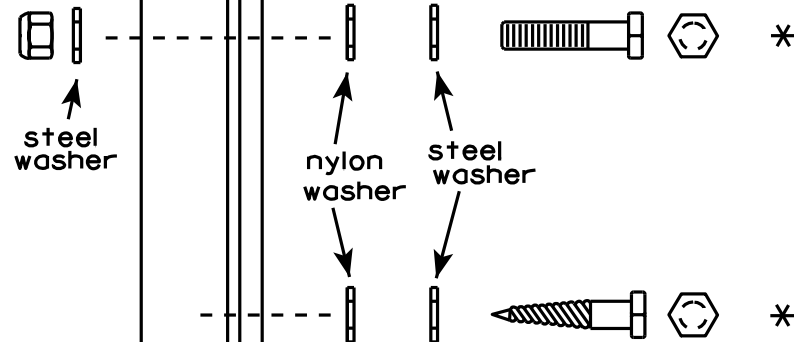

Nuts, bolts and lags used for mounting signs shall have hexagonal heads and shall be either :

- a. Hot dip galvanized in accordance with ASTM Designation: A 153, Class D, or SC 3
- b. Electro-galvanized in accordance with ASTM Designation : B 633, TYPE III, SC 3.

Threads on bolts and nuts shall be manufactured with sufficient allowance for the cadmium plate or galvanized coating to permit the nuts to run freely on the bolts.

WOOD POSTS (4" x 4" or 4" x 6")

LAG SCREWS - 3/8" X 3"

MACHINE BOLTS - 5/16" X 6-1/2" or 7" Length w/ nuts

SQUARE STEEL POSTS (2" x 2")

MACHINE BOLTS - 3/8" X 3-1/4" Length w/ nuts


RIVETS - 9/32" (6605-9-6) BULB-TITE, TRI-FOLD, ALUMINUM BODY/MANDREL

O.D. FLANGE .720-.765 INCH, GRIP RANGE .042-.375 INCH

WASHERS (ALL POSTS) -

1-1/4" O.D. X 3/8" I.D. X 1/16" STEEL

1-1/4" O.D. X 3/8" I.D. X .080 NYLON for all Type H signs.

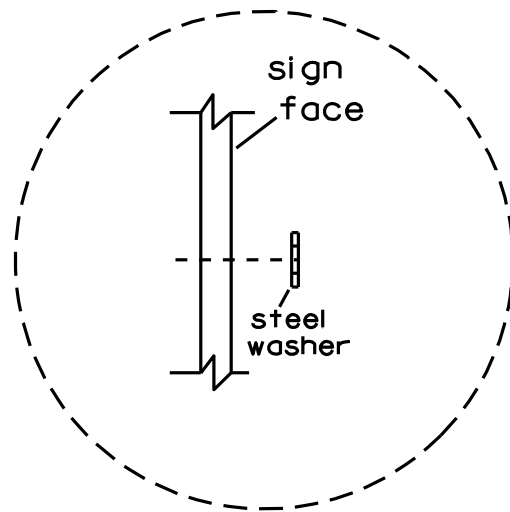

Washer Placement when Sign Has Other Than Type H or Type F Face

\* Two different fastening systems are shown for illustration purposes. On any individual sign, either one or the other system shall be used. Actual number of fasteners per sign varies with the sign area, but normally there are two. For a single post installation, all signs greater than 9 sq. ft. require the use of 3 fasteners.

ATTACHMENT OF SIGNS TO POSTS


WISCONSIN DEPT OF TRANSPORTATION

APPROVED *Matthew R Rauch*  
For State Traffic Engineer

DATE 3/23/10 PLATE NO. A4-8.7


**TELESCOPIC TUBING ANCHORS  
TWO PIECE SYSTEM**

2 1/4" SQUARE  
12 GAUGE  
PERFORATED  
GALVANIZED FINISH

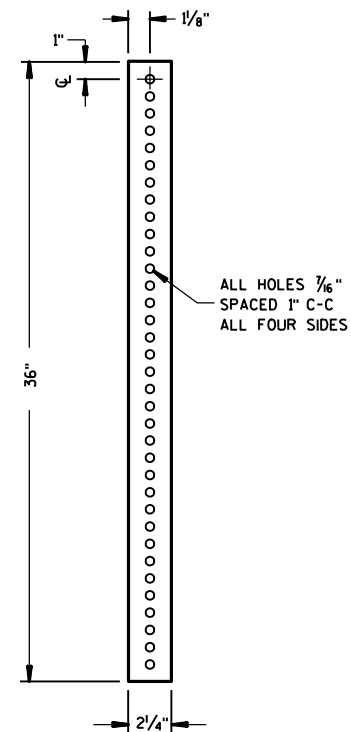


ALL HOLES 7/16" SPACED 1" C-C ALL FOUR SIDES

2 1/2" SQUARE  
12 GAUGE  
OMNI-DIRECTIONAL  
PERFORATED  
SOIL STABILIZING SLEEVE  
GALVANIZED FINISH


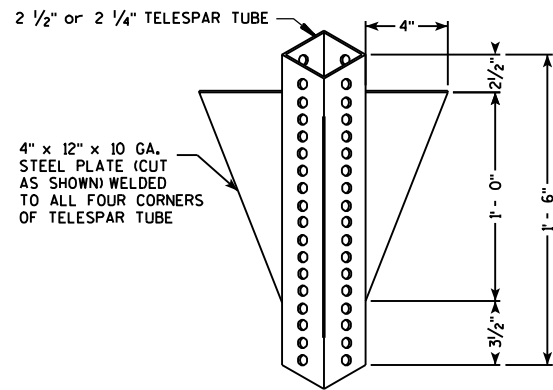


4" x 12" x 10 GA. STEEL PLATE (CUT AS SHOWN) WELDED TO ALL FOUR CORNERS OF TELESPAR TUBE

**DETAIL OF TUBULAR STEEL SIGN POST  
(IN POURED CONCRETE OR ASPHALT)**

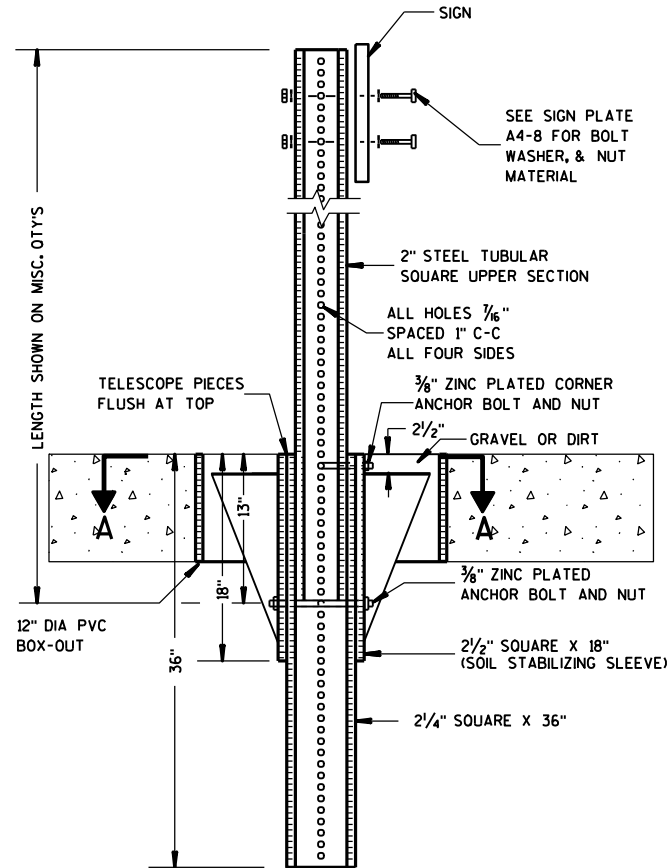

**DETAIL OF TUBULAR STEEL SIGN POST  
(IN LOCATIONS OTHER THAN POURED CONCRETE OR ASPHALT)**

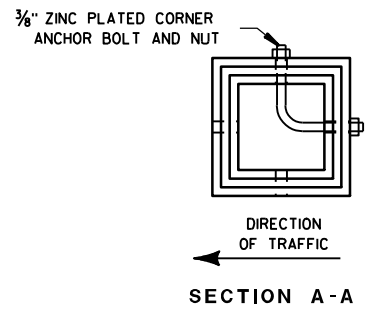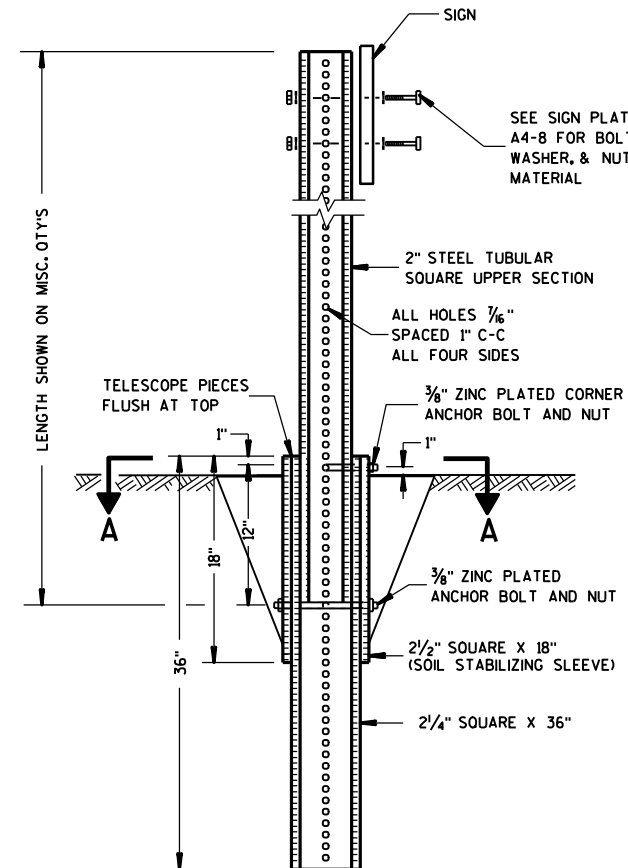

Area of Sign Installation (Sq. Ft.)	Number of Required Posts
9 or less	1
Greater than 9 less than or equal to 18	2
Greater than 18 less than or equal to 27	3

Signs wider than 3 feet or larger than 9 sq. ft shall be mounted on multiple posts (see above table).

**TUBULAR STEEL  
SIGN POST  
A4-9**

WISCONSIN DEPT OF TRANSPORTATION

APPROVED *Matthew R. Rauch*  
For State Traffic Engineer

DATE 3/9/11 PLATE NO. A4-9.6






BRACE BANDING

BRACKET BANDING


"J" ASSEMBLY

SINGLE SIGN



DETAIL C  
CADMIUM PLATED STEEL BOLT  
THROUGH BLACK BORDER

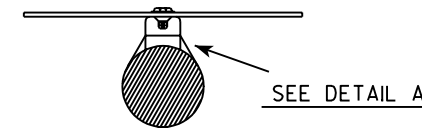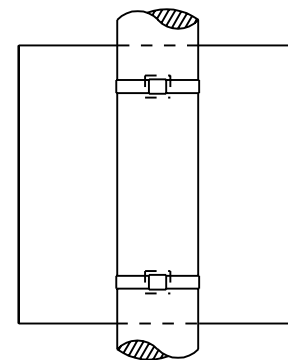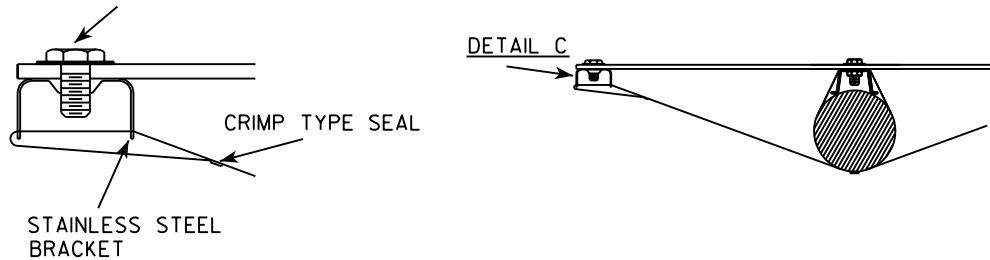

CHANNEL  
SEE TYPICAL PANEL  
INSTALLATION SHEET

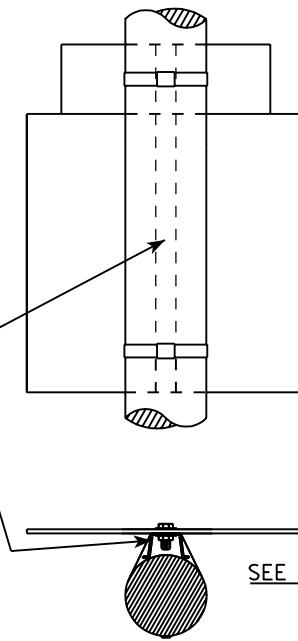


SEE DETAIL B

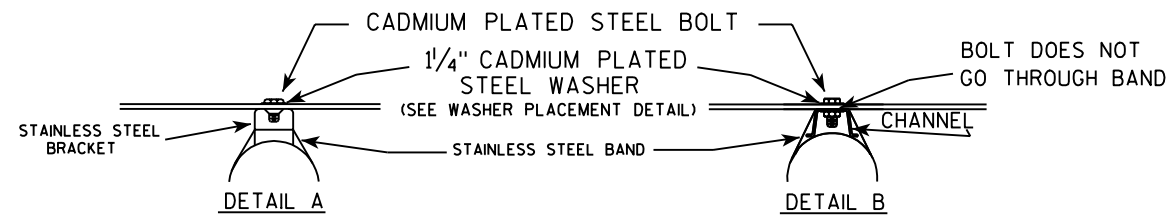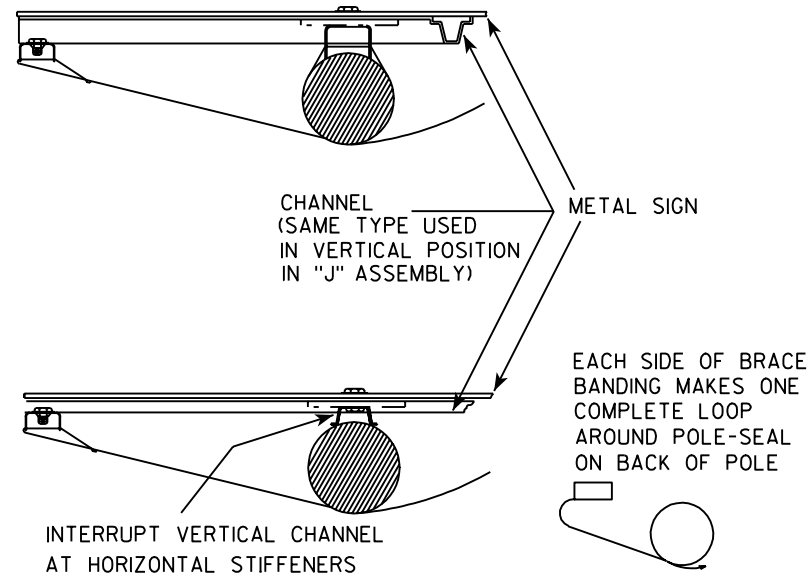

GENERAL NOTES

1. Signs 4' or greater in width shall have one brace band installed at the center of the sign.
2. Signs 3' or greater in height shall have three bracket bands installed. Signs less than 3' in height shall have two bracket bands installed.
3. Banding and assembly bracket shall be stainless steel. All bands shall be 3/4" in width and 0.025" thickness.

WASHER PLACEMENT


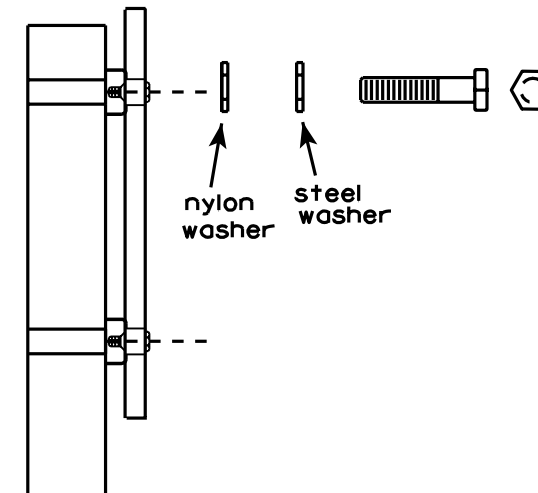


WASHERS (ALL POSTS) -

1-1/4" O.D. X 3/8" I.D. X 1/16" STEEL  
1-1/4" O.D. X 3/8" I.D. X .080 NYLON  
FOR ALL TYPE H SIGNS

BRACE BANDING

BRACE BANDING SHALL BE TIGHTENED FIRMLY  
BUT NOT SO TIGHT AS TO APPRECIABLY  
CURVE FACE OF SIGN.

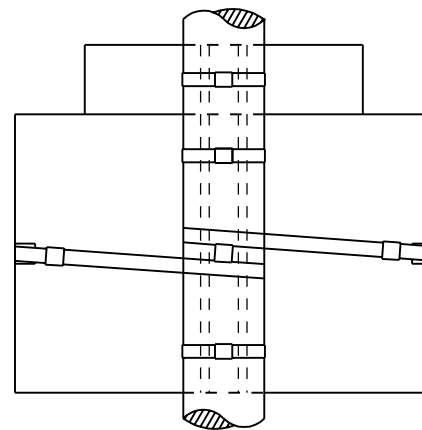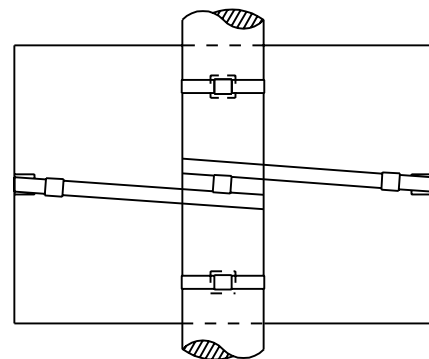

7

7

STANDARD SIGN  
SIGN BANDING DETAILS



WISCONSIN DEPT OF TRANSPORTATION

APPROVED *Matthew R. Rauch*  
For State Traffic Engineer

DATE 11/08/05 PLATE NO. A5-9.2

NOTES

1. Sign is Type II - See Note 6 - reference WIS DOT Standard Specification for HIGHWAY and STRUCTURE CONSTRUCTION latest edition.
2. Color:  
Background - White & Black - See Note 6  
Message - Black
3. Message Series - See note 5
4. Corners may be square or rounded when base material is plywood but borders shall be rounded as shown. When base material is metal, the corners and borders shall be rounded.
5. Substitute appropriate numerals and adjust spacing as per Plate A10-1.
6. Permanent Signs  
Background - Type H Reflective  
Detour or other temporary signs  
Background - Reflective

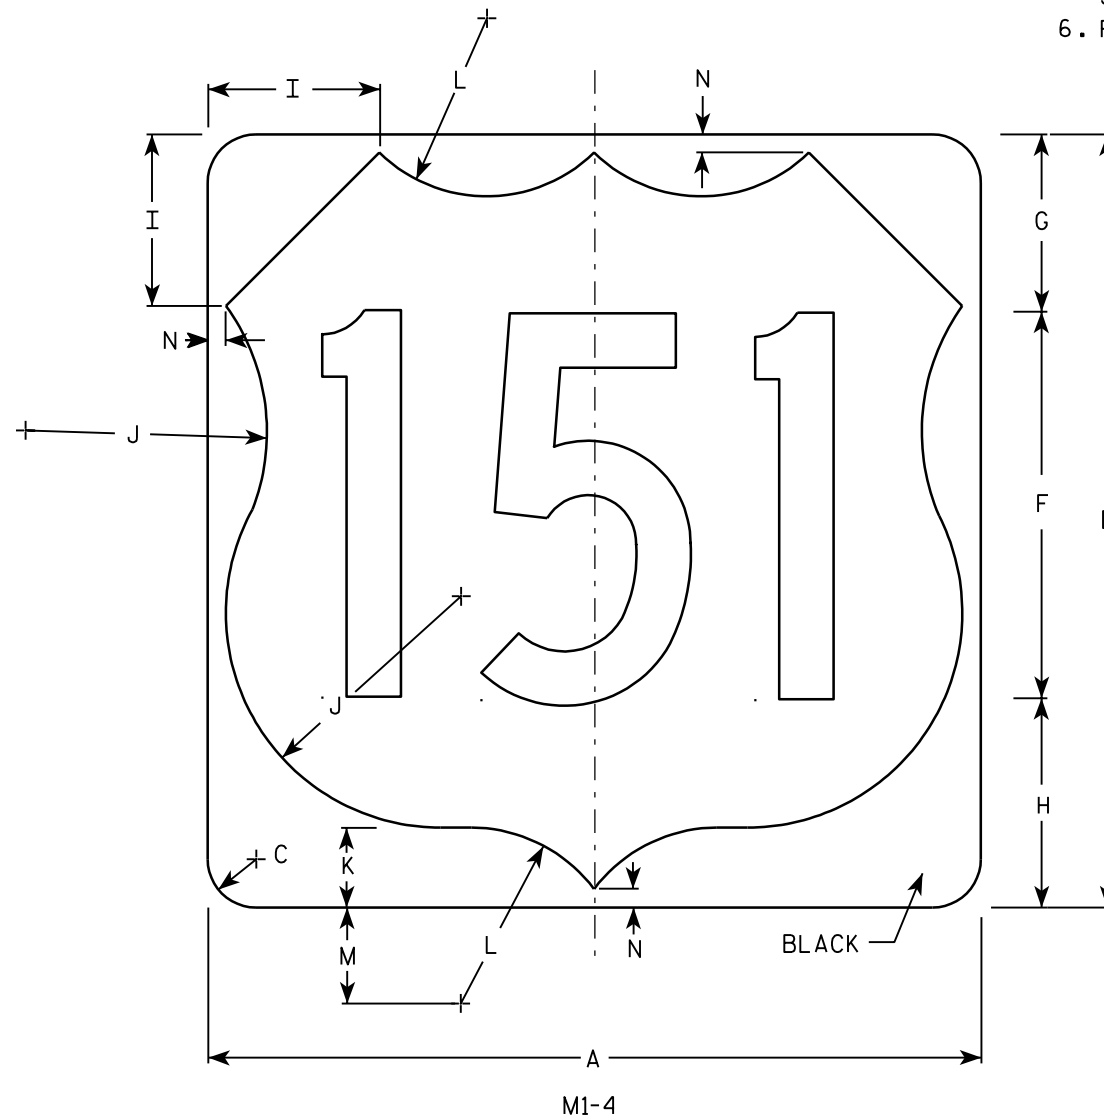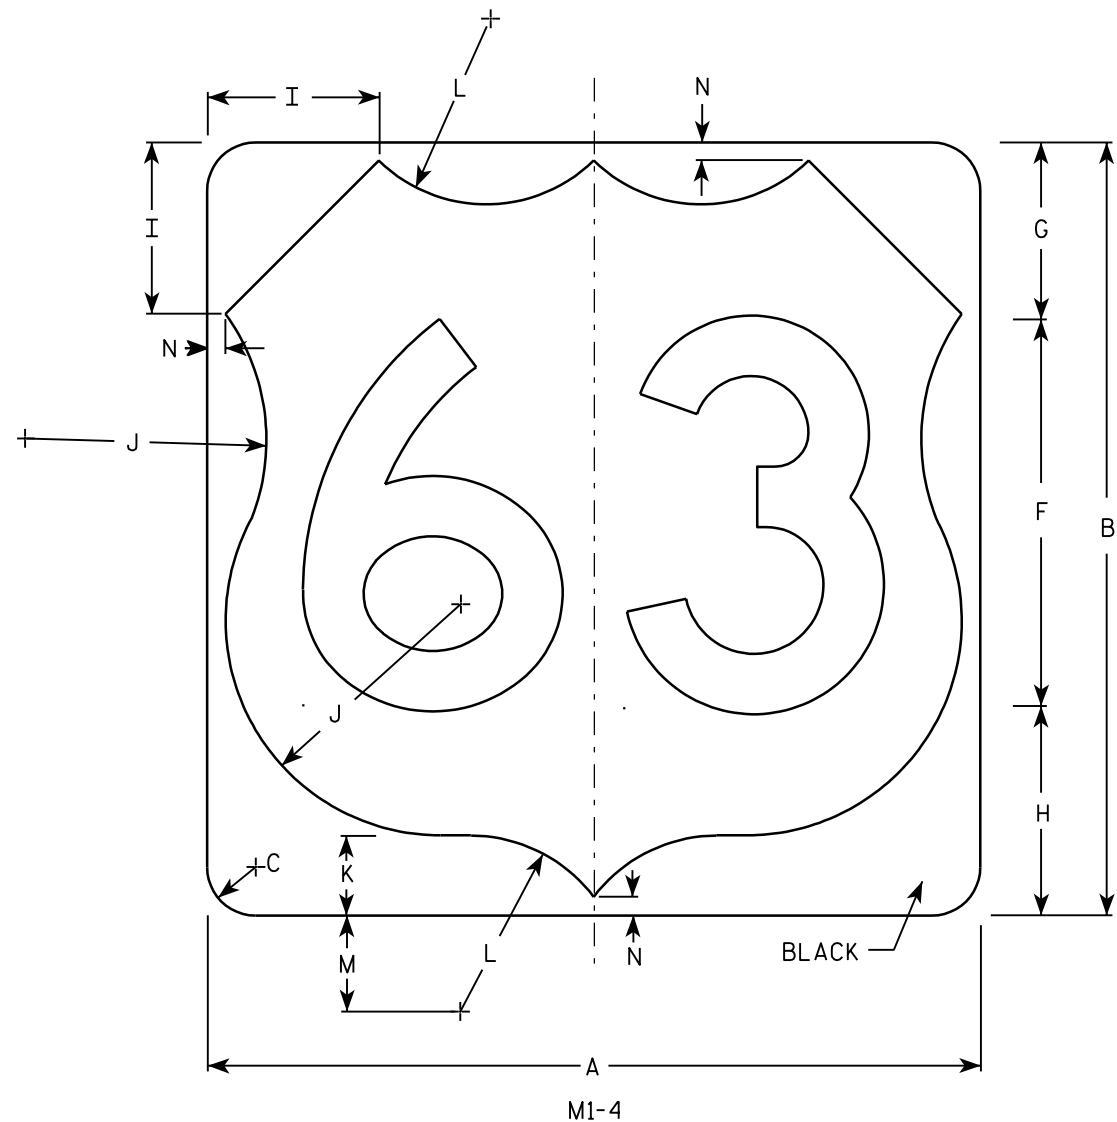

Metric equivalent for this sign is:

SIZE	
1	
2	600 mm X 600 mm
3	900 mm X 900 mm
4	900 mm X 900 mm
5	900 mm X 900 mm

SIZE	A	B	C	D	E	F	G	H	I	J	K	L	M	N	O	P	Q	R	S	T	U	V	W	X	Y	Z	Area sq. ft.	Area m <sup>2</sup>
1																												
2	24	24	1 1/2			12	5 1/2	6 1/2	5	7 1/2	2 1/2	5 1/2	3	1/2													4.0	.36
3	36	36	2 1/4			18	8 1/4	9 1/4	7 1/4	11 1/4	3 3/4	8 1/4	4 1/2	3/4													9.0	.81
4	36	36	2 1/4			18	8 1/4	9 1/4	7 1/4	11 1/4	3 3/4	8 1/4	4 1/2	3/4													9.0	.81
5	36	36	2 1/4			18	8 1/4	9 1/4	7 1/4	11 1/4	3 3/4	8 1/4	4 1/2	3/4													9.0	.81


USH MARKER  
M1-4 FOR ASSEMBLIES

WISCONSIN DEPT OF TRANSPORTATION

APPROVED *Matthew R. Rauch*  
For State Traffic Engineer

DATE 08/25/05 PLATE NO. M1-4.9

C

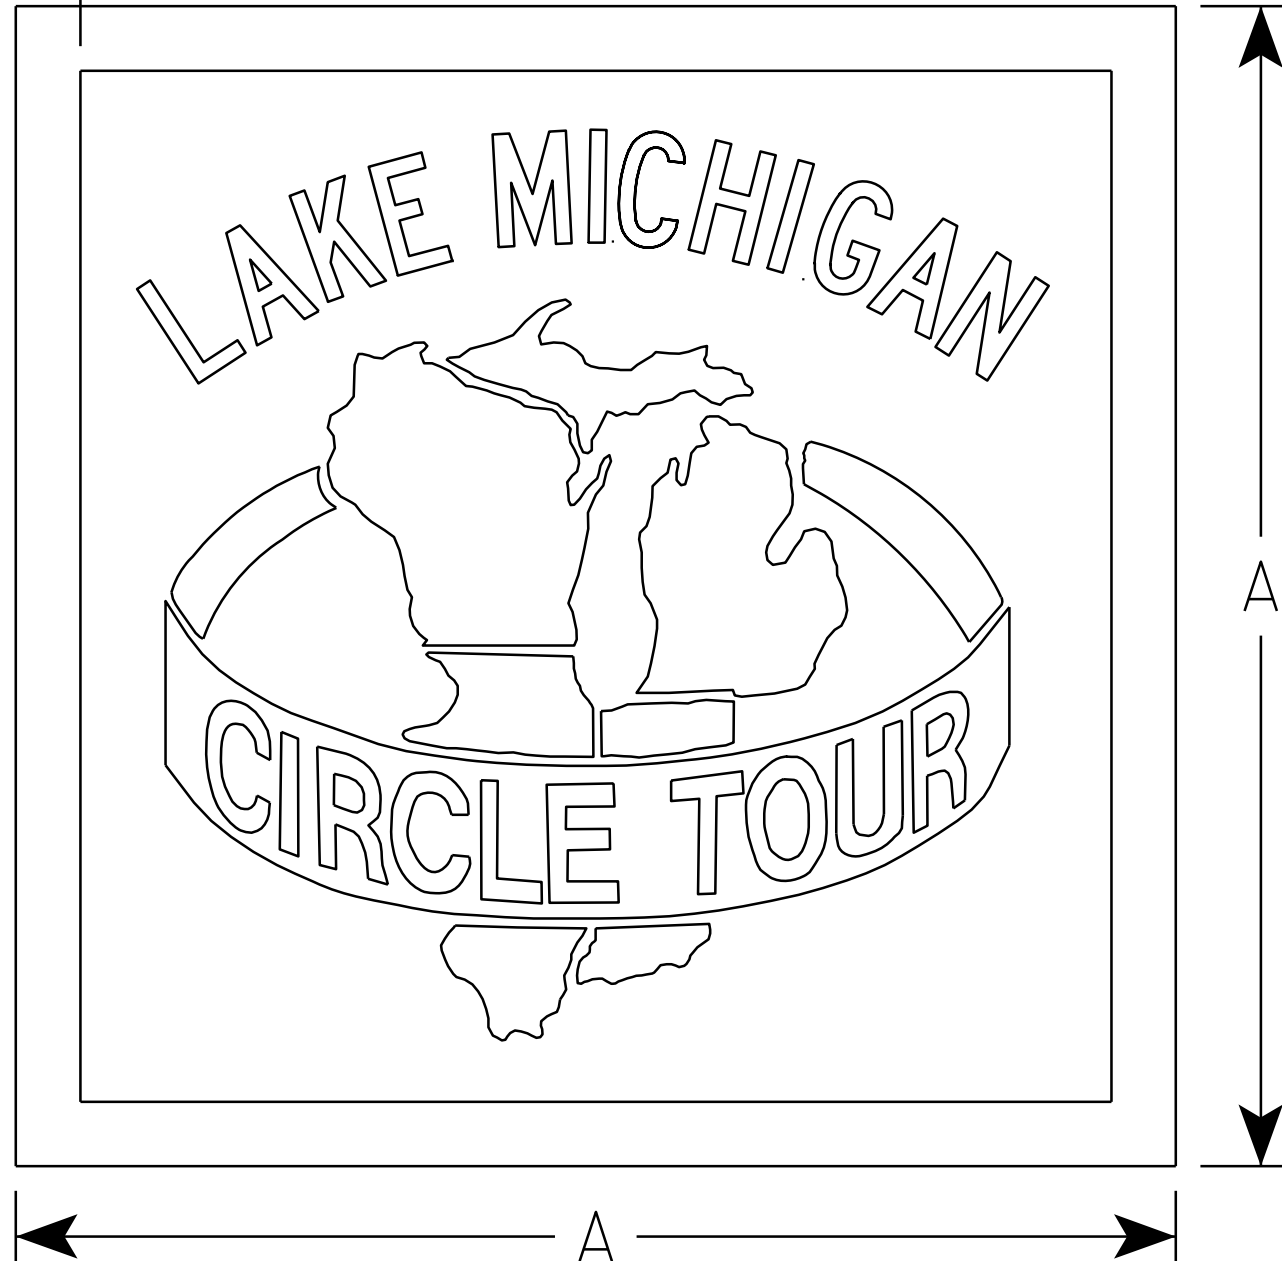

**NOTES**

1. Sign is Type II - Type H Reflective - reference WIS DOT Standard Specification for HIGHWAY and STRUCTURE CONSTRUCTION latest edition.
2. Color:  
 Background - Green  
 Message - White - Graphics - White  
 Circle Tour Message is Green
3. Message Series - Special
4. Corners may be square or rounded when base material is plywood but borders shall be rounded as shown. When base material is metal, the corners and borders shall be rounded.

7

7

SIZE	A	B	C	D	E	F	G	H	I	J	K	L	M	N	O	P	Q	R	S	T	U	V	W	X	Y	Z	Area sq. ft.	Area m <sup>2</sup>
1																												
2	24		1 1/2																							4.0	.36	
3																												
4	36		2																							9.0	.81	
5																												

**STANDARD SIGN**  
M1-93

WISCONSIN DEPT OF TRANSPORTATION


APPROVED *Matthew R. Rauch*  
State Traffic Engineer

DATE 10/05/09 For PLATE NO. M1-93.1


PROJECT NO: \_\_\_\_\_ HWY: \_\_\_\_\_ COUNTY: \_\_\_\_\_ SHEET NO: \_\_\_\_\_ E

NOTES

1. Sign is Type II - See Note 5 - reference WIS DOT Standard Specification for HIGHWAY and STRUCTURE CONSTRUCTION latest edition.
2. Color:  
Background - See note 5  
Message - See note 5
3. Message Series - C
4. Corners may be square or rounded when base material is plywood but borders shall be rounded as shown. When base material is metal, the corners and borders shall be rounded.
5. M2-1 Background - White - Type H Reflective  
(Detour or temporary Signs - Reflective)  
Message - Black  
MB2-1 Background - Blue  
Message - White - Type H Reflective  
(Detour or temporary Signs - Reflective)  
MG2-1 Background - Green  
Message - White - Type H Reflective  
MK2-1 Background - Green  
Message - White - Type H Reflective  
MM2-1 Background - White - Type H Reflective  
Message - Green  
MN2-1 Background - Brown  
Message - White - Type H Reflective  
MR2-1 Background - Brown  
Message - Yellow - Type H Reflective

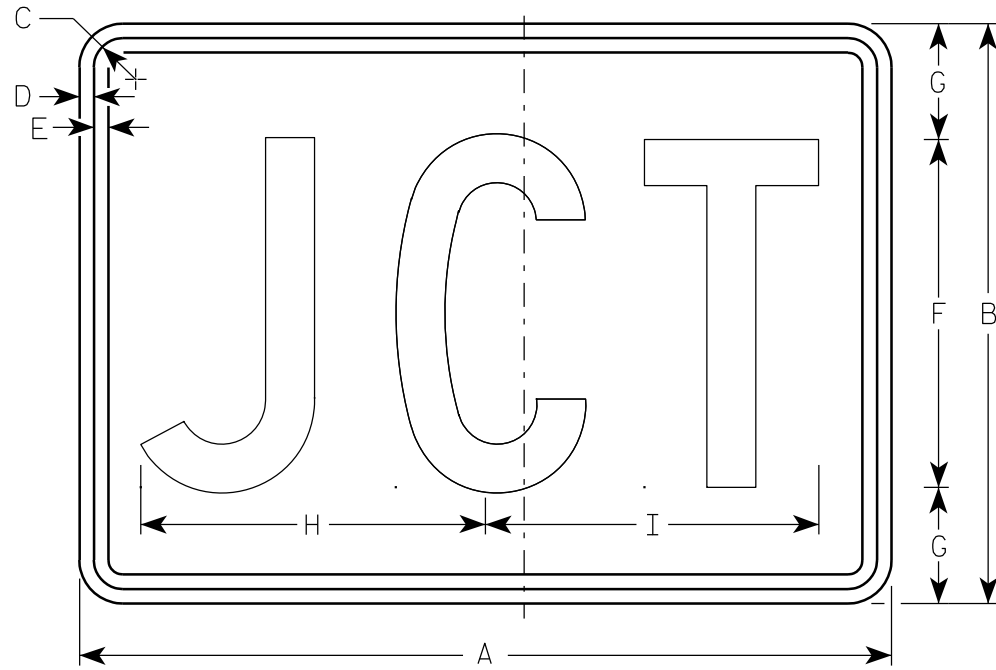

M2-1  
MK2-1  
MM2-1  
MR2-1

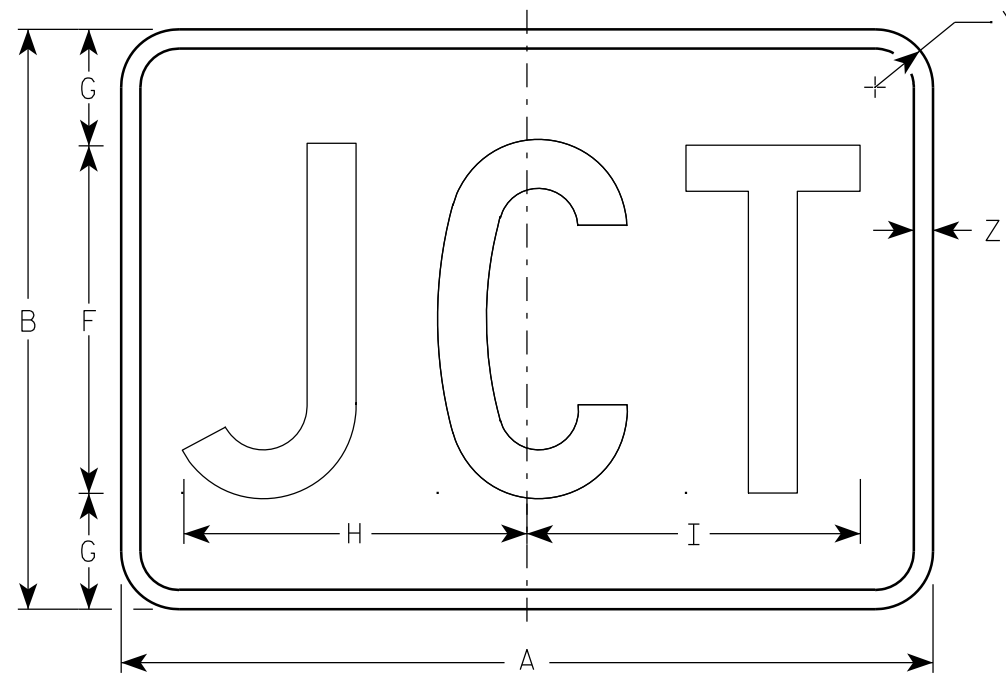

MB2-1  
MG2-1  
MN2-1

7

Metric equivalent for this sign is:

SIZE	
1	
2	525 mm X 375 mm
3	750 mm X 525 mm
4	750 mm X 525 mm
5	750 mm X 525 mm


SIZE	A	B	C	D	E	F	G	H	I	J	K	L	M	N	O	P	Q	R	S	T	U	V	W	X	Y	Z	Area sq. ft.	Area m <sup>2</sup>
1																												
2	21	15	1 1/8	3/8	3/8	9	3	8 7/8	8 5/8															1 1/2	1/2	2.20	0.20	
3	30	21	1 1/8	3/8	3/8	13	4	12 7/8	12 3/8															1 1/2	1/2	4.40	0.20	
4	30	21	1 1/8	3/8	3/8	13	4	12 7/8	12 3/8															1 1/2	1/2	4.40	0.20	
5	30	21	1 1/8	3/8	3/8	13	4	12 7/8	12 3/8															1 1/2	1/2	4.40	0.20	

STANDARD SIGN  
M2-1


WISCONSIN DEPT OF TRANSPORTATION  
APPROVED *Matthew R. Rauch*  
for State Traffic Engineer

DATE 3/16/10 PLATE NO. M2-1.10

PROJECT NO: \_\_\_\_\_ HWY: \_\_\_\_\_ COUNTY: \_\_\_\_\_ SHEET NO: \_\_\_\_\_ E

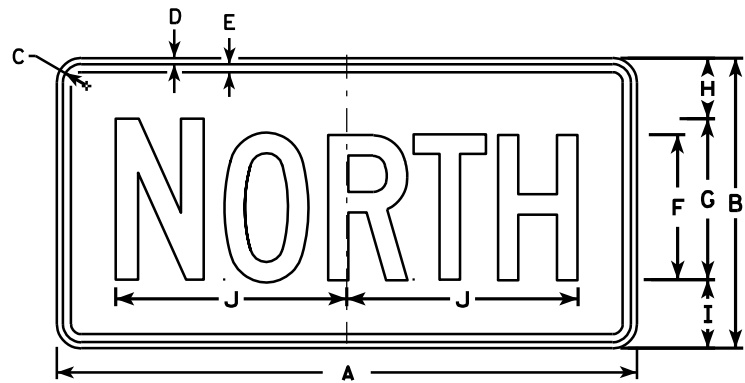


M3-1  
MK3-1  
M03-1

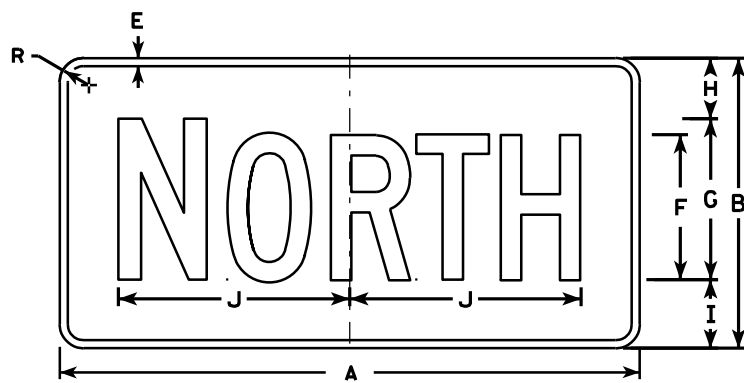


MB3-1  
MG3-1  
MM3-1  
MN3-1




M3-2  
MK3-2  
M03-2

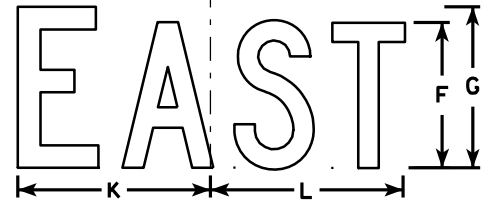


MB3-2  
MG3-2  
MM3-2  
MN3-2

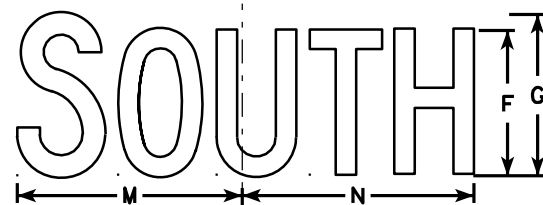


M3-3  
MK3-3  
M03-3

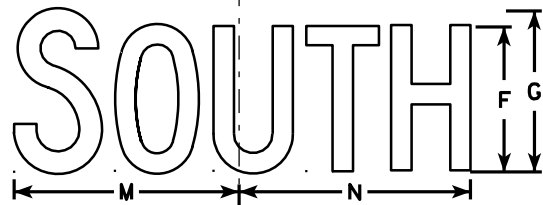

MB3-3  
MG3-3  
MM3-3  
MN3-3

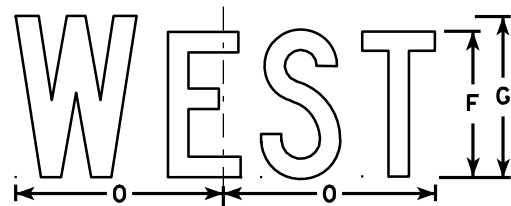

M3-4  
MK3-4  
M03-4

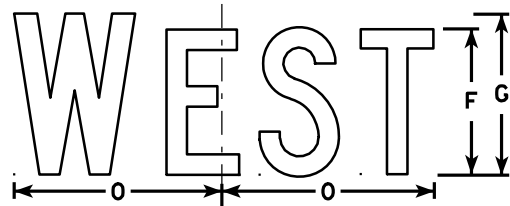

MB3-4  
MG3-4  
MM3-4  
MN3-4

NOTES

- All Signs Type II - See Note 5 - reference WIS DOT Standard Specification for HIGHWAY and STRUCTURE CONSTRUCTION latest edition.
- Color:  
Background - See note 5  
Message - See note 5
- Message Series - C
- Corners may be square or rounded when base material is plywood but borders shall be rounded as shown. When base material is metal, the corners and borders shall be rounded.
- M3-1 thru M3-4 Background - White - Type H Reflective (Detour or temporary signs - Reflective)  
Message - Black  
MB3-1 thru MB3-4 Background - Blue  
Message - White - Type H Reflective (Detour or temporary signs - Reflective)  
MG3-1 thru MG3-4 Background - Green  
Message - White - Type H Reflective  
MK3-1 thru MK3-4 Background - Green  
Message - White - Type H Reflective  
MM3-1 thru MM3-4 Background - White - Type H Reflective  
Message - Green  
MN3-1 thru MN3-4 Background - Brown  
Message - White - Type H Reflective  
M03-1 thru M03-4 Background - Orange - Reflective  
Message - Black
- Note the first letter of each direction is larger than the remainder of the message.

7

7

SIZE	A	B	C	D	E	F	G	H	I	J	K	L	M	N	O	P	Q	R	S	T	U	V	W	X	Y	Z	Area sq. ft.
1																											
2	24	12	1 1/8	3/8	3/8	6	7	2 1/4	2 3/4	10 1/4	7 7/8	8 3/8	10 1/4	9 3/4	8 3/4			1 1/2									2.00
3	36	18	1 1/8	3/8	1/2	9	10	3 3/4	4 1/4	14 3/8	12	12 1/8	14	14 1/8	13			1 1/2									4.5
4	36	18	1 1/8	3/8	1/2	9	10	3 3/4	4 1/4	14 3/8	12	12 1/8	14	14 1/8	13			1 1/2									4.5
5	36	18	1 1/8	3/8	1/2	9	10	3 3/4	4 1/4	14 3/8	12	12 1/8	14	14 1/8	13			1 1/2									4.5


STANDARD SIGNS  
M3-1 thru M3-4  
SERIES

WISCONSIN DEPT OF TRANSPORTATION


APPROVED *Matthew R. Rauch*  
For State Traffic Engineer

DATE 11/10/10 PLATE NO. M3-1.12


PROJECT NO: \_\_\_\_\_ HWY: \_\_\_\_\_ COUNTY: \_\_\_\_\_ SHEET NO: \_\_\_\_\_ E

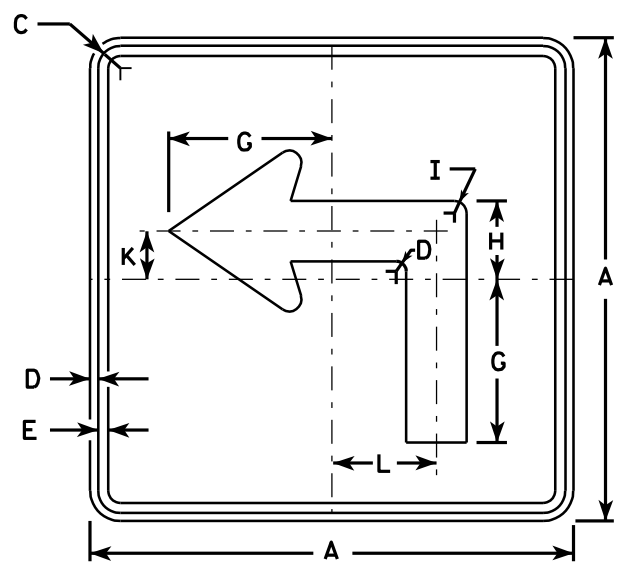


M5-1L  
MK5-1L  
MM5-1L  
MO5-1L  
MR5-1L

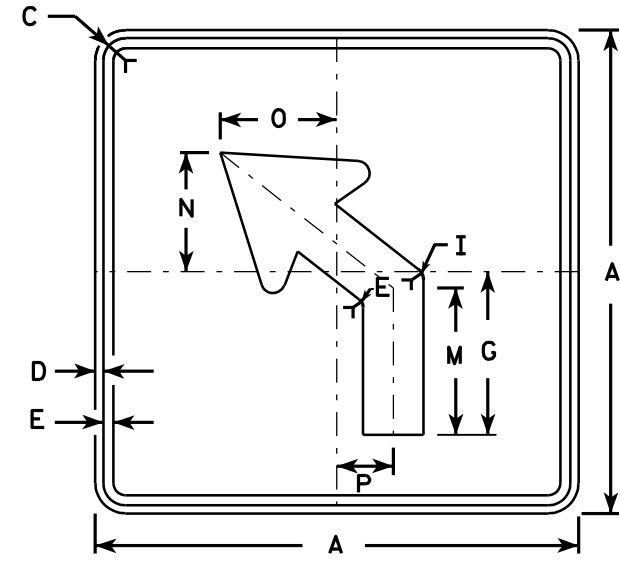


M5-2L  
MK5-2L  
MM5-2L  
MO5-2L  
MR5-2L

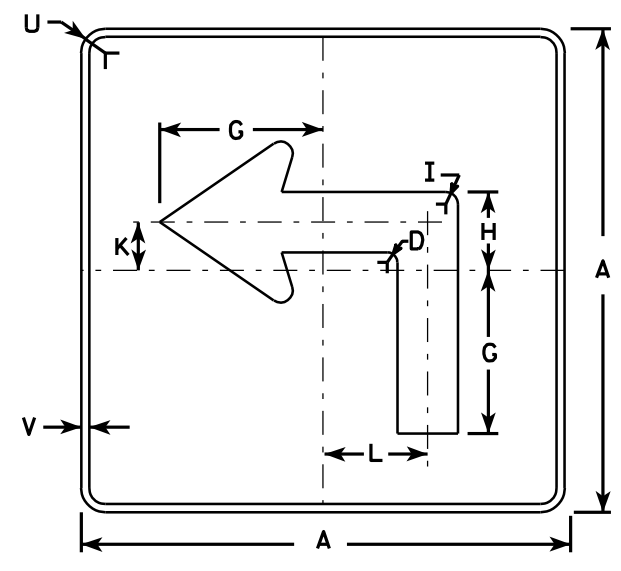

MB5-1L  
MG5-1L  
MN5-1L

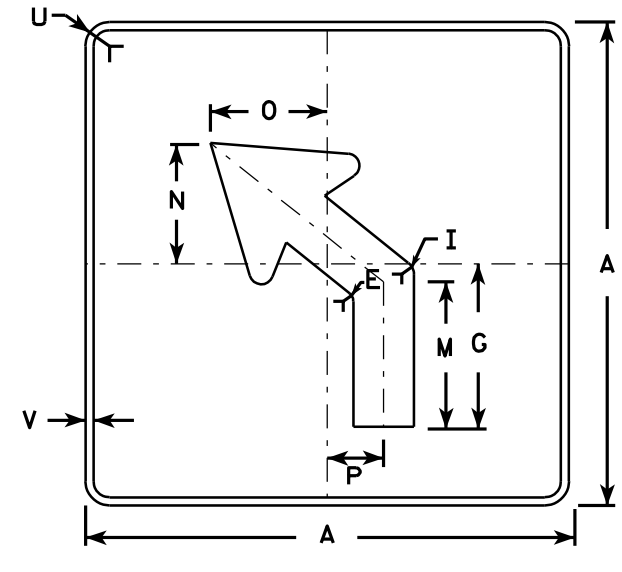

MB5-2L  
MG5-2L  
MN5-2L

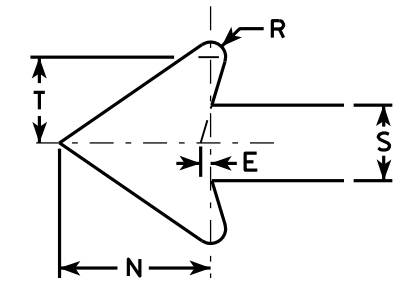

**NOTES**

- Signs are Type II - See Note 4 - reference WIS DOT Standard Specification for HIGHWAY and STRUCTURE CONSTRUCTION latest edition.
- Color:  
Background - See note 4  
Message - See note 4
- Corners may be square or rounded when base material is plywood but borders shall be rounded as shown. When base material is metal, the corners and borders shall be rounded.
- M5-1 and M5-2 Background - White - Type H Reflective (Detour or temporary Signs - Reflective)  
Message - Black  
MB5-1 and MB5-2 Background - Blue  
Message - White - Type H Reflective (Detour or temporary Signs - Reflective)  
MG5-1 and MG5-2 Background - Green  
Message - White - Type H Reflective  
MK5-1 and MK5-2 Background - Green  
Message - White Type H Reflective  
MM5-1 and MM5-2 Background - White - Type H Reflective  
Message - Green  
MN5-1 and MN5-2 Background - Brown  
Message - White - Type H Reflective  
MO5-1 and MO5-2 Background - Orange - Reflective  
Message - Black  
MR5-1 and MR5-2 Background - Brown  
Message - Yellow - Type H Reflective
- M5-1R same as M5-1L except arrow points right.
- M5-2R same as M5-2L except arrow tilts right.

7

Metric equivalent for this sign is:

SIZE	
1	
2	525 mm X 525 mm
3	750 mm X 750 mm
4	750 mm X 750 mm
5	750 mm X 750 mm

SIZE	A	B	C	D	E	F	G	H	I	J	K	L	M	N	O	P	Q	R	S	T	U	V	W	X	Y	Z	Area sq. ft.	Area sq. m.
1																												
2	21		1 1/8	3/8	3/8		7	3 3/8	5/8		2 1/8	4 1/2	6 3/8	5 1/4	5	2 1/2		1/2	2 5/8	3	1 1/2	1/2					3.06	0.28
3	30		1 3/8	1/2	5/8		10 1/8	4 7/8	7/8		3	6 1/2	9 1/8	7 1/2	7 1/4	3 1/2		3/4	3 3/4	4 1/4	1 7/8	1/2					6.25	0.56
4	30		1 3/8	1/2	5/8		10 1/8	4 7/8	7/8		3	6 1/2	9 1/8	7 1/2	7 1/4	3 1/2		3/4	3 3/4	4 1/4	1 7/8	1/2					6.25	0.56
5	30		1 3/8	1/2	5/8		10 1/8	4 7/8	7/8		3	6 1/2	9 1/8	7 1/2	7 1/4	3 1/2		3/4	3 3/4	4 1/4	1 7/8	1/2					6.25	0.56


**STANDARD SIGN**  
**M5-1 & M5-2**

WISCONSIN DEPT OF TRANSPORTATION


APPROVED *Matthew R. Rauch*  
For State Traffic Engineer

DATE 3/16/10 PLATE NO. M5-1.11


PROJECT NO: \_\_\_\_\_ HWY: \_\_\_\_\_ COUNTY: \_\_\_\_\_ SHEET NO: \_\_\_\_\_ E

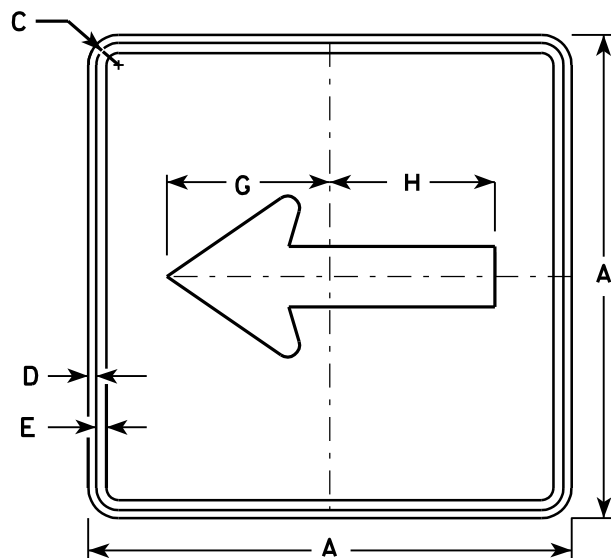


M6-1  
MK6-1  
MM6-1  
MO6-1  
MR6-1

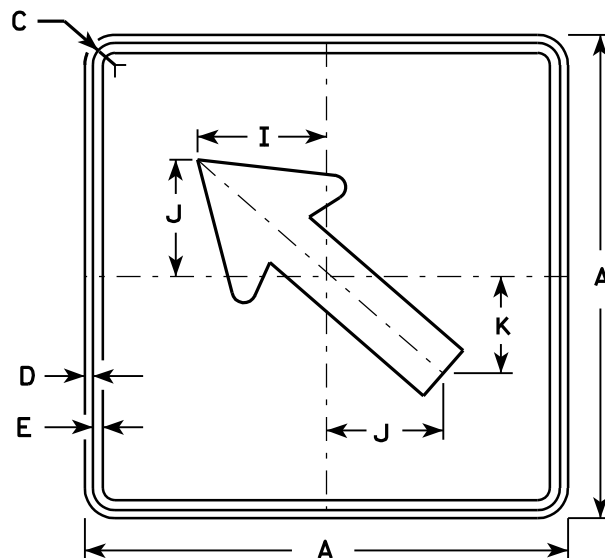


M6-2  
MK6-2  
MM6-2  
MO6-2  
MR6-2

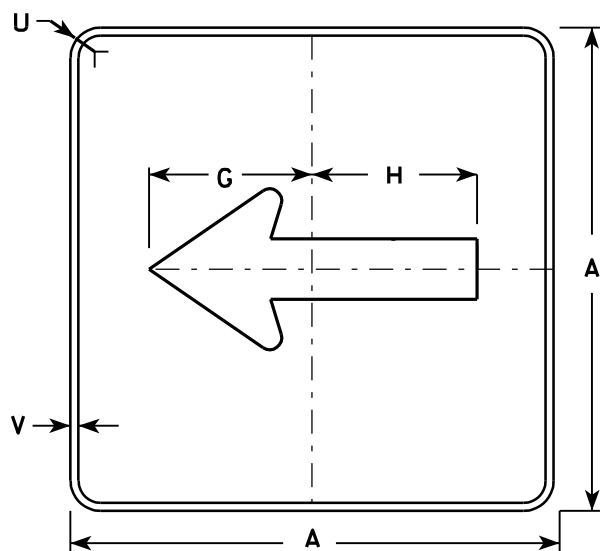

MB6-1  
MG6-1  
MN6-1

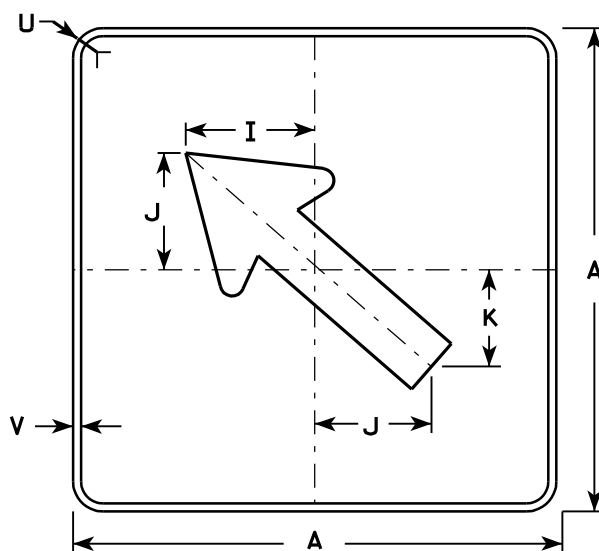

MB6-2  
MG6-2  
MN6-2

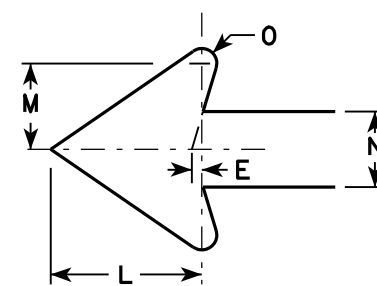

**NOTES**

- Signs are Type II - See Note 4 - reference WIS DOT Standard Specification for HIGHWAY and STRUCTURE CONSTRUCTION latest edition.
- Color:  
Background - See note 4  
Message - See note 4
- Corners may be square or rounded when base material is plywood but borders shall be rounded as shown. When base material is metal, the corners and borders shall be rounded.
- M6-1 and M6-2 Background - White - Type H Reflective (Detour or temporary Signs - Reflective)  
Message - Black  
MB6-1 and MB6-2 Background - Blue  
Message - White - Type H Reflective (Detour or temporary Signs - Reflective)  
MG6-1 and MG6-2 Background - Green  
Message - White - Type H Reflective  
MK6-1 and MK6-2 Background - Green  
Message - White - Type H Reflective  
MM6-1 and MM6-2 Background - White - Type H Reflective  
Message - Green  
MN6-1 and MN6-2 Background - Brown  
Message - White - Type H Reflective  
MO6-1 and MO6-2 Background - Orange - Reflective  
Message - Black  
MR6-1 and MR6-2 Background - Brown  
Message - Yellow - Type H Reflective

7 Metric equivalent for this sign is:

SIZE	
1	
2	525 mm X 525 mm
3	750 mm X 750 mm
4	750 mm X 750 mm
5	750 mm X 750 mm

SIZE	A	B	C	D	E	F	G	H	I	J	K	L	M	N	O	P	Q	R	S	T	U	V	W	X	Y	Z	Area sq. ft.	Area m <sup>2</sup>
1																												
2	21		1 1/8	3/8	3/8		7 1/2	7 1/8	5 5/8	5	4 1/4	5 1/4	3	2 5/8	1/2						1 1/2	1/2					3.06	0.28
3	30		1 3/8	1/2	5/8		10 3/4	10 1/4	8	7 1/4	6	7 1/2	4 1/4	3 3/4	3/4						1 7/8	1/2					6.25	0.56
4	30		1 3/8	1/2	5/8		10 3/4	10 1/4	8	7 1/4	6	7 1/2	4 1/4	3 3/4	3/4						1 7/8	1/2					6.25	0.56
5	30		1 3/8	1/2	5/8		10 3/4	10 1/4	8	7 1/4	6	7 1/2	4 1/4	3 3/4	3/4						1 7/8	1/2					6.25	0.56


PROJECT NO: \_\_\_\_\_ HWY: \_\_\_\_\_ COUNTY: \_\_\_\_\_ SHEET NO: \_\_\_\_\_ E

**STANDARD SIGN**  
M6-1 & M6-2  
SERIES


WISCONSIN DEPT OF TRANSPORTATION

APPROVED *Matthew R. Rauch*  
for State Traffic Engineer


DATE 3/16/10 PLATE NO. M6-1.12

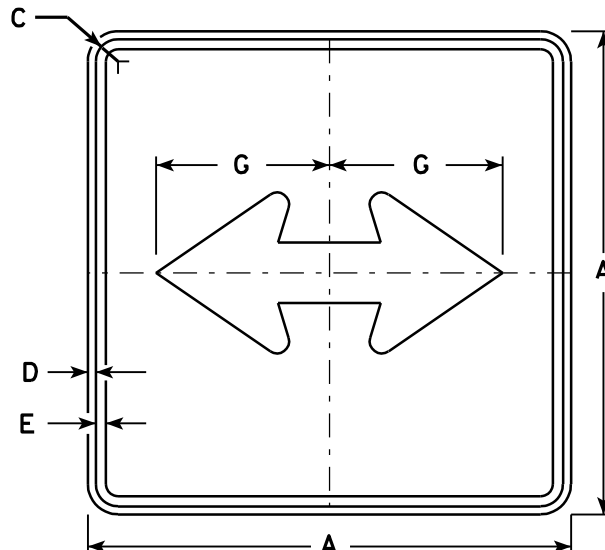


M6-4  
MK6-4  
MM6-4  
MO6-4  
MR6-4

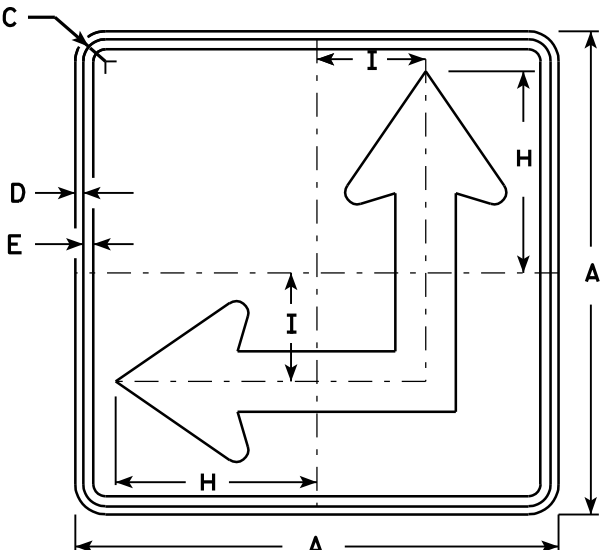

M6-6  
MK6-6  
MM6-6  
MO6-6  
MR6-6

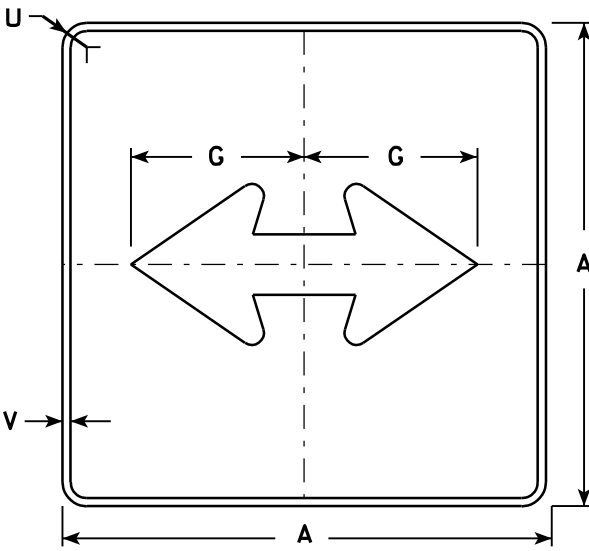


MB6-4  
MG6-4  
MN6-4

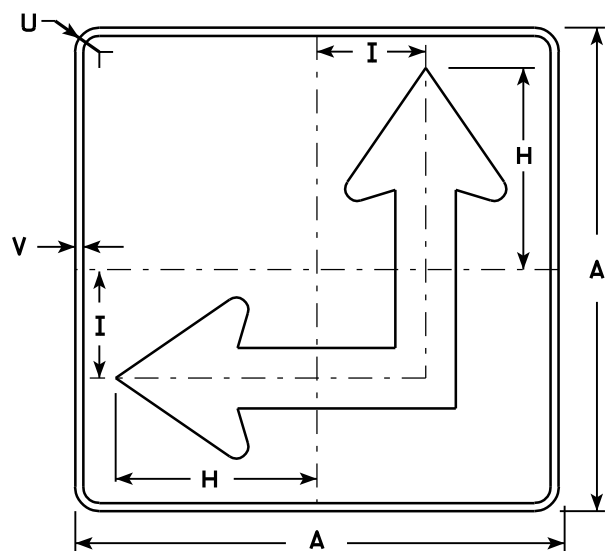

MB6-6  
MG6-6  
MN6-6

**NOTES**

- Signs are Type II - See Note 4 - reference WIS DOT Standard Specification for HIGHWAY and STRUCTURE CONSTRUCTION latest edition.
- Color:  
Background - See Note 4  
Message - See Note 4
- Corners may be square or rounded when base material is plywood but borders shall be rounded as shown. When base material is metal, the corners and borders shall be rounded.
- M6-4 and M6-6 Background - White - Type H Reflective (Detour or temporary Signs - Reflective)  
Message - Black  
MB6-4 and MB6-6 Background - Blue  
Message - White - Type H Reflective (Detour or temporary Signs - Reflective)  
MG6-4 and MG6-6 Background - Green  
Message - White - Type H Reflective  
MK6-4 and MK6-6 Background - Green  
Message - White - Type H Reflective  
MM6-4 and MM6-6 Background - White - Type H Reflective  
Message - Green  
MN6-4 and MN6-6 Background - Brown  
Message - White - Type H Reflective  
MO6-4 and MO6-6 Background - Orange - Reflective  
Message - Black  
MR6-4 and MR6-6 Background - Brown  
Message - Yellow - Type H Reflective
- M6-6R same as M6-6L except arrow points ahead and right.

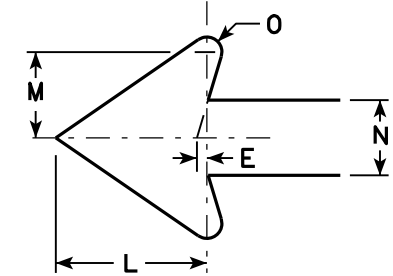

7

7

Metric equivalent for this sign is:

SIZE	
1	
2	525 mm X 525 mm
3	750 mm X 750 mm
4	750 mm X 750 mm
5	750 mm X 750 mm

SIZE	A	B	C	D	E	F	G	H	I	J	K	L	M	N	O	P	Q	R	S	T	U	V	W	X	Y	Z	Area sq. ft.	Area m <sup>2</sup>
1																												
2	21		1 1/8	3/8	3/8		7 1/2	8 3/4	4 1/4			5 1/4	3	2 5/8	1/2						1 1/2	1/2					3.06	0.28
3	30		1 3/8	1/2	5/8		10 3/4	12 1/2	6 3/4			7 1/2	4 1/4	3 3/4	3/4						1 7/8	1/2					6.25	0.56
4	30		1 3/8	1/2	5/8		10 3/4	12 1/2	6 3/4			7 1/2	4 1/4	3 3/4	3/4						1 7/8	1/2					6.25	0.56
5	30		1 3/8	1/2	5/8		10 3/4	12 1/2	6 3/4			7 1/2	4 1/4	3 3/4	3/4						1 7/8	1/2					6.25	0.56

**STANDARD SIGN**  
**M6-4 & M6-6**  
**SERIES**


WISCONSIN DEPT OF TRANSPORTATION

APPROVED *Matthew R. Rauch*  
for State Traffic Engineer

DATE 3/16/10 PLATE NO. M6-4.7

PROJECT NO: \_\_\_\_\_ HWY: \_\_\_\_\_ COUNTY: \_\_\_\_\_ SHEET NO: \_\_\_\_\_ E



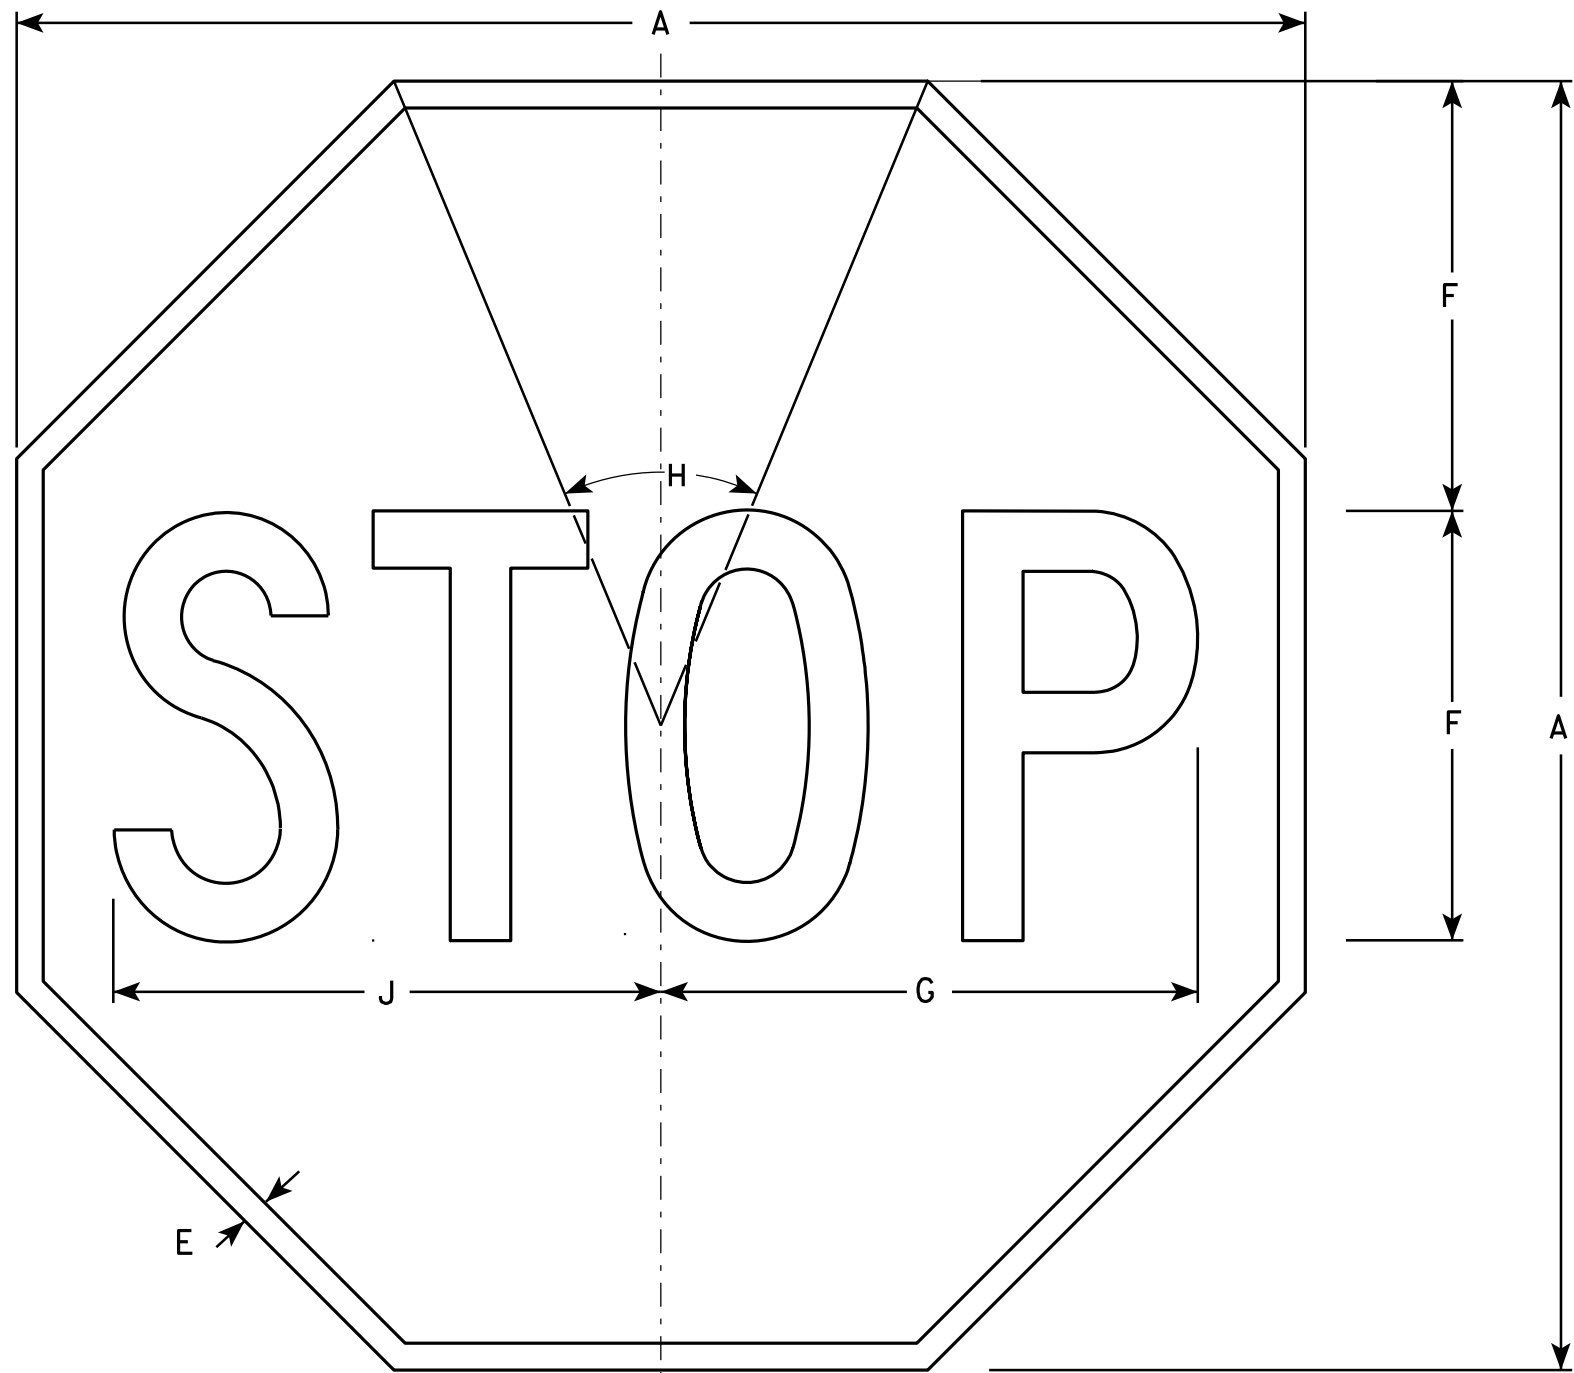

**NOTES**

1. Sign is Type II - Type H Reflective - reference WIS DOT Standard Specification for HIGHWAY and STRUCTURE CONSTRUCTION latest edition.
2. Color:  
Background - Red  
Message - White
3. Message Series - C

7

7

R1-1

SIZE	A	B	C	D	E	F	G	H	I	J	K	L	M	N	O	P	Q	R	S	T	U	V	W	X	Y	Z	Area sq. Ft.
1	24				3/8	8	10	45°		10 1/4																	3.31
2S	30				5/8	10	12 1/2	45°		12 3/4																	5.18
2M	36				3/4	12	15	45°		15 3/8																	7.46
3	36				3/4	12	15	45°		15 3/8																	7.46
4	48				1	16	20	45°		20 1/2																	13.25
5	48				1	16	20	45°		20 1/2																	13.25
6	18				3/8	6	7 3/4	45°		7 3/4																	1.86
7	12				1/4	4	5	45°		5 1/8																	0.78


**STANDARD SIGN**  
R1-1

WISCONSIN DEPT OF TRANSPORTATION

APPROVED *Matthew R. Rauch*  
for State Traffic Engineer

DATE 12/03/10 PLATE NO. R1-1.12

PROJECT NO: \_\_\_\_\_ HWY: \_\_\_\_\_ COUNTY: \_\_\_\_\_ SHEET NO: \_\_\_\_\_ E

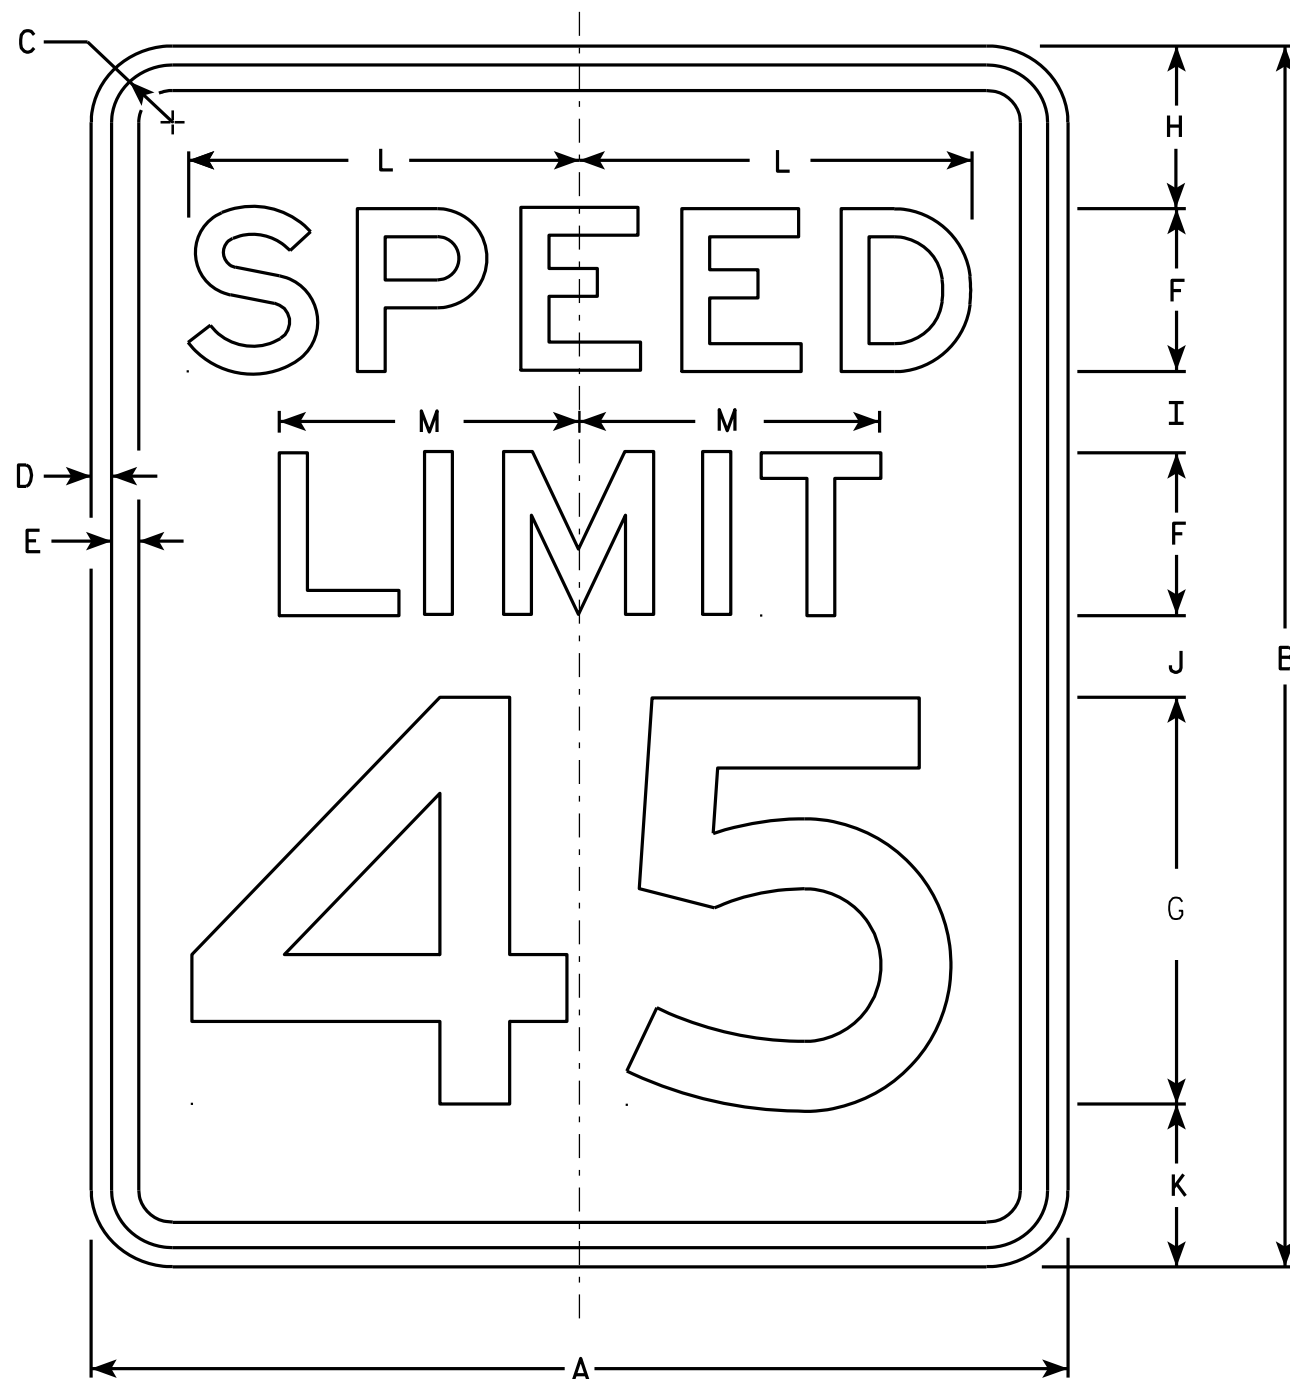

R2-1

NOTES

1. Sign is Type II - Type H Reflective - reference WIS DOT Standard Specification for HIGHWAY and STRUCTURE CONSTRUCTION latest edition.
2. Color:  
Background - White  
Message - Black
3. Message Series - E
4. Corners may be square or rounded when base material is plywood but borders shall be rounded as shown. When base material is metal, the corners and borders shall be rounded.
5. Substitute appropriate numerals and optically adjust spacing to achieve proper balance.

7

7

SIZE	A	B	C	D	E	F	G	H	I	J	K	L	M	N	O	P	Q	R	S	T	U	V	W	X	Y	Z	Area sq. ft.
1	18	24	1 1/8	3/8	1/2	3	8	3	2	2	3	7 1/4	5 1/2														3.0
2S	24	30	1 1/8	3/8	1/2	4	10	3	2 1/4	3 3/8	3 3/8	9 5/8	7 3/8														5.0
2M	30	36	1 3/8	1/2	5/8	5	12	5	2 1/2	2 1/2	4	12	9 1/4														7.5
3	36	48	1 3/8	1/2	5/8	6	14	6	5	5	6	14 3/8	11														12.0
4	36	48	1 3/8	1/2	5/8	6	14	6	5	5	6	14 3/8	11														12.0
5	48	60	2 1/4	3/4	1	8	20	6	4 1/2	6 3/4	6 3/4	19 1/4	14 5/8														20.0


STANDARD SIGN  
R2-1

WISCONSIN DEPT OF TRANSPORTATION

APPROVED *Matthew R. Rauch*  
For State Traffic Engineer

DATE 5/26/10 PLATE NO. R2-1.13


PROJECT NO: \_\_\_\_\_ HWY: \_\_\_\_\_ COUNTY: \_\_\_\_\_ SHEET NO: \_\_\_\_\_ E

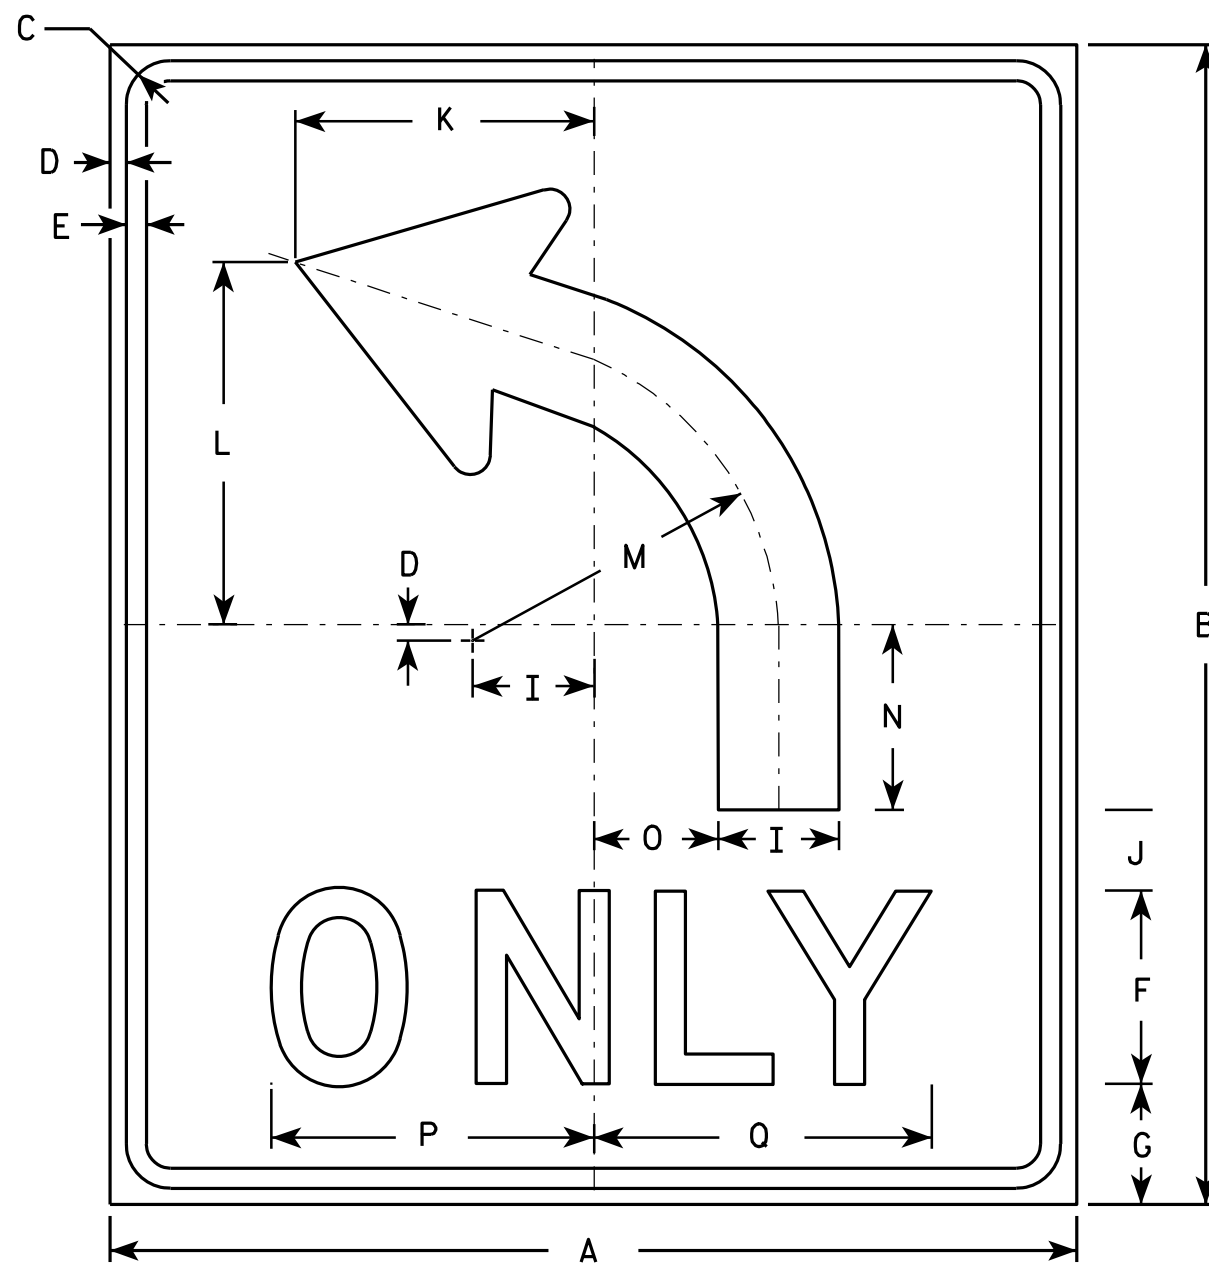

R3-50L

**NOTES**

1. Sign is Type II - Type H Reflective - reference WIS DOT Standard Specification for HIGHWAY and STRUCTURE CONSTRUCTION latest edition.
2. Color:  
Background - White  
Message - Black
3. Message Series - D
4. Corners may be square or rounded when base material is plywood but borders shall be rounded as shown. When base material is metal, the corners and borders shall be rounded.
5. R3-50R is the same as R3-50L except curved portion of arrow points right.

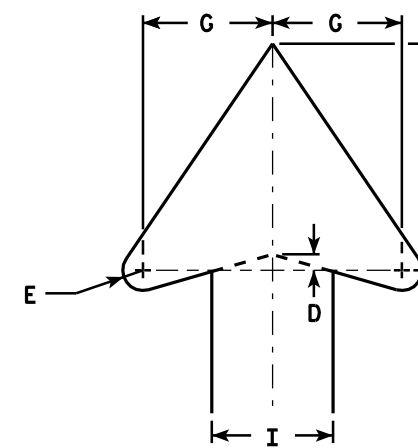

ARROW DETAIL

7

7

SIZE	A	B	C	D	E	F	G	H	I	J	K	L	M	N	O	P	Q	R	S	T	U	V	W	X	Y	Z	Area sq. ft.
1																											
2S	30	36	1 3/8	1/2	5/8	6	4	7	3 3/4	2 1/2	9 1/4	11 1/4	9 1/2	5 3/4	3 7/8	10	10 1/2										7.5
2M	30	36	1 3/8	1/2	5/8	6	4	7	3 3/4	2 1/2	9 1/4	11 1/4	9 1/2	5 3/4	3 7/8	10	10 1/2										7.5
3																											
4																											
5																											

**STANDARD SIGN**  
**R3-50**

*WISCONSIN DEPT OF TRANSPORTATION*



APPROVED *Matthew R. Raush*  
for State Traffic Engineer

DATE 3/24/2011 PLATE NO. R3-50.2


PROJECT NO: \_\_\_\_\_ HWY: \_\_\_\_\_ COUNTY: \_\_\_\_\_ SHEET NO: \_\_\_\_\_ E

**NOTES**

1. Sign is Type II - Type H Reflective - reference WIS DOT Standard Specification for HIGHWAY and STRUCTURE CONSTRUCTION latest edition. material is plywood but borders shall be rounded
2. Color:  
Background - White  
Message - Black
3. Corners may be square or rounded when base as shown. When base material is metal, the corners and borders shall be rounded.
4. R4-8 is the same as R4-7 except Legend is reversed.

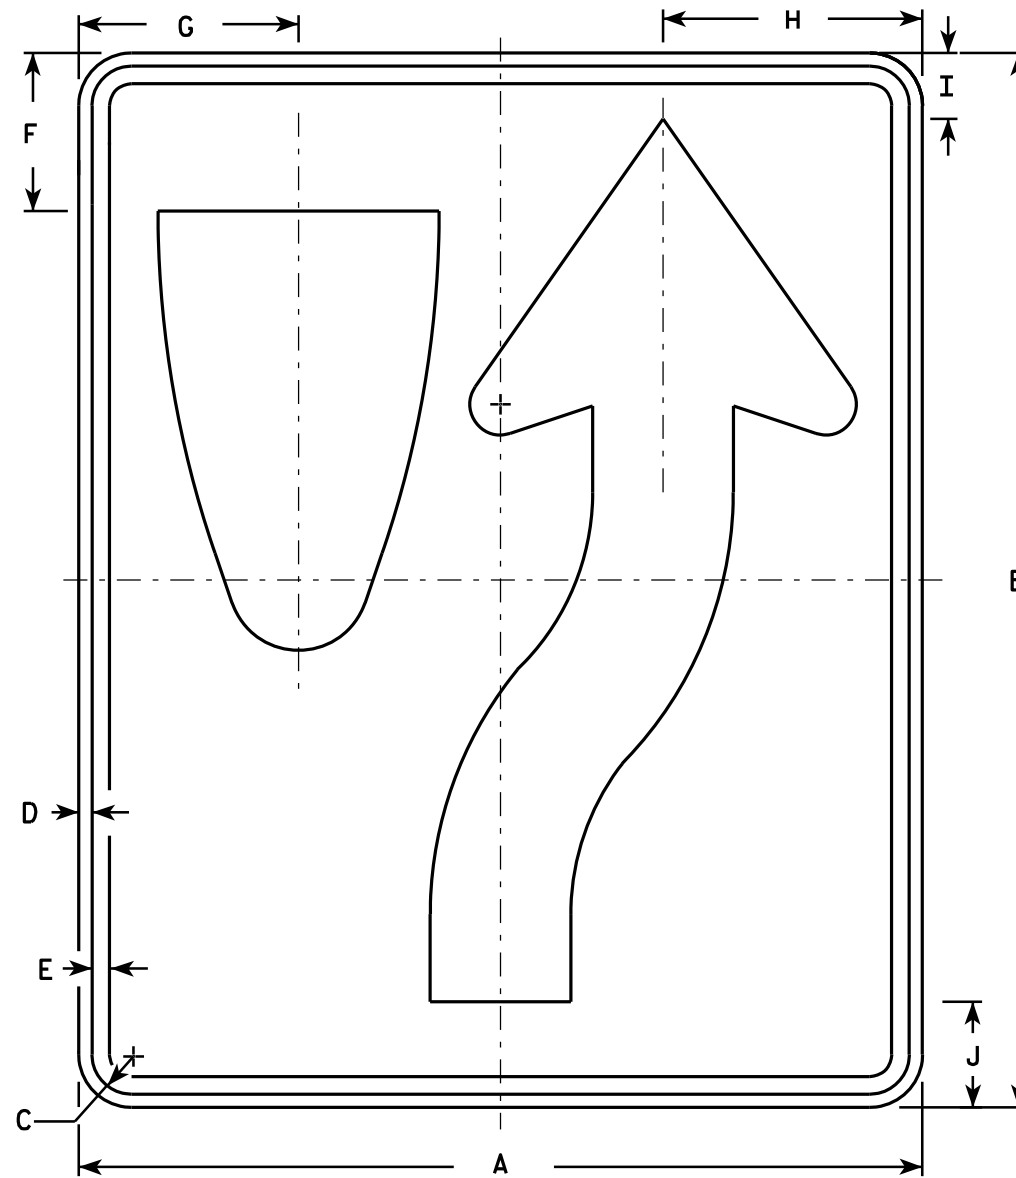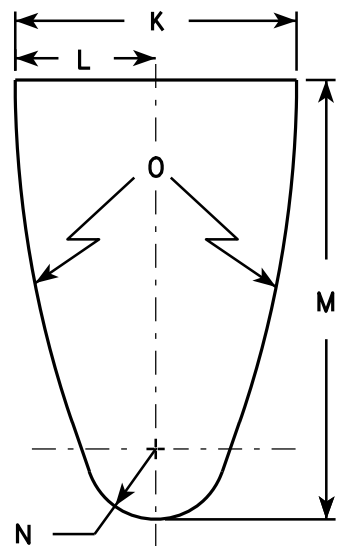

R4-7

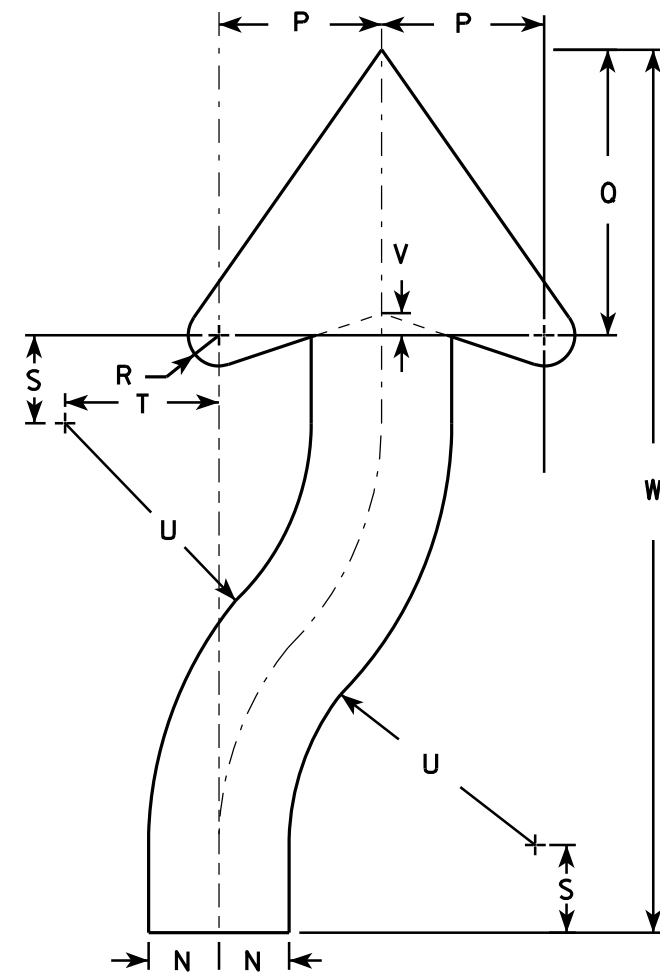

ARROW DETAIL

SIZE	A	B	C	D	E	F	G	H	I	J	K	L	M	N	O	P	Q	R	S	T	U	V	W	X	Y	Z	Area sq. ft.
1	18	24	1 1/8	3/8	1/2	3 3/8	4 3/4	5 1/2	1 3/8	2 1/4	6	3	9 3/8	1 1/2	22 1/2	3 1/2	6 1/8	5/8	1 7/8	3 1/4	6 3/4	1/2	20 3/8				3.0
2S	24	30	1 1/8	3/8	1/2	4 1/2	6 1/4	7 3/8	1 7/8	3	8	4	12 1/2	2	30	4 5/8	8 1/8	7/8	2 1/2	4 3/8	9	5/8	25 1/8				5.0
2M	24	30	1 1/8	3/8	1/2	4 1/2	6 1/4	7 3/8	1 7/8	3	8	4	12 1/2	2	30	4 5/8	8 1/8	7/8	2 1/2	4 3/8	9	5/8	25 1/8				5.0
3	36	48	1 3/4	1/2	5/8	6 3/4	9 3/8	11 1/8	2 7/8	4 1/2	12	6	18 3/4	3	45	6 7/8	12 1/4	1 1/4	3 3/4	6 5/8	13 1/2	1	40 3/4				12.0
4	36	48	1 3/4	1/2	5/8	6 3/4	9 3/8	11 1/8	2 7/8	4 1/2	12	6	18 3/4	3	45	6 7/8	12 1/4	1 1/4	3 3/4	6 5/8	13 1/2	1	40 3/4				12.0
5	48	60	2 1/4	3/4	1	9	12 1/2	14 3/4	3 3/4	6	16	8	25	4	60	9 1/4	16 1/4	1 5/8	5	8 3/4	18	1 1/4	50 1/4				20.0


**STANDARD SIGN**  
R4-7 & R4-8

WISCONSIN DEPT OF TRANSPORTATION

APPROVED *Matthew R. Rauch*  
for State Traffic Engineer

DATE 3/25/2011 PLATE NO. R4-7.8


PROJECT NO: \_\_\_\_\_ HWY: \_\_\_\_\_ COUNTY: \_\_\_\_\_ SHEET NO: \_\_\_\_\_ E

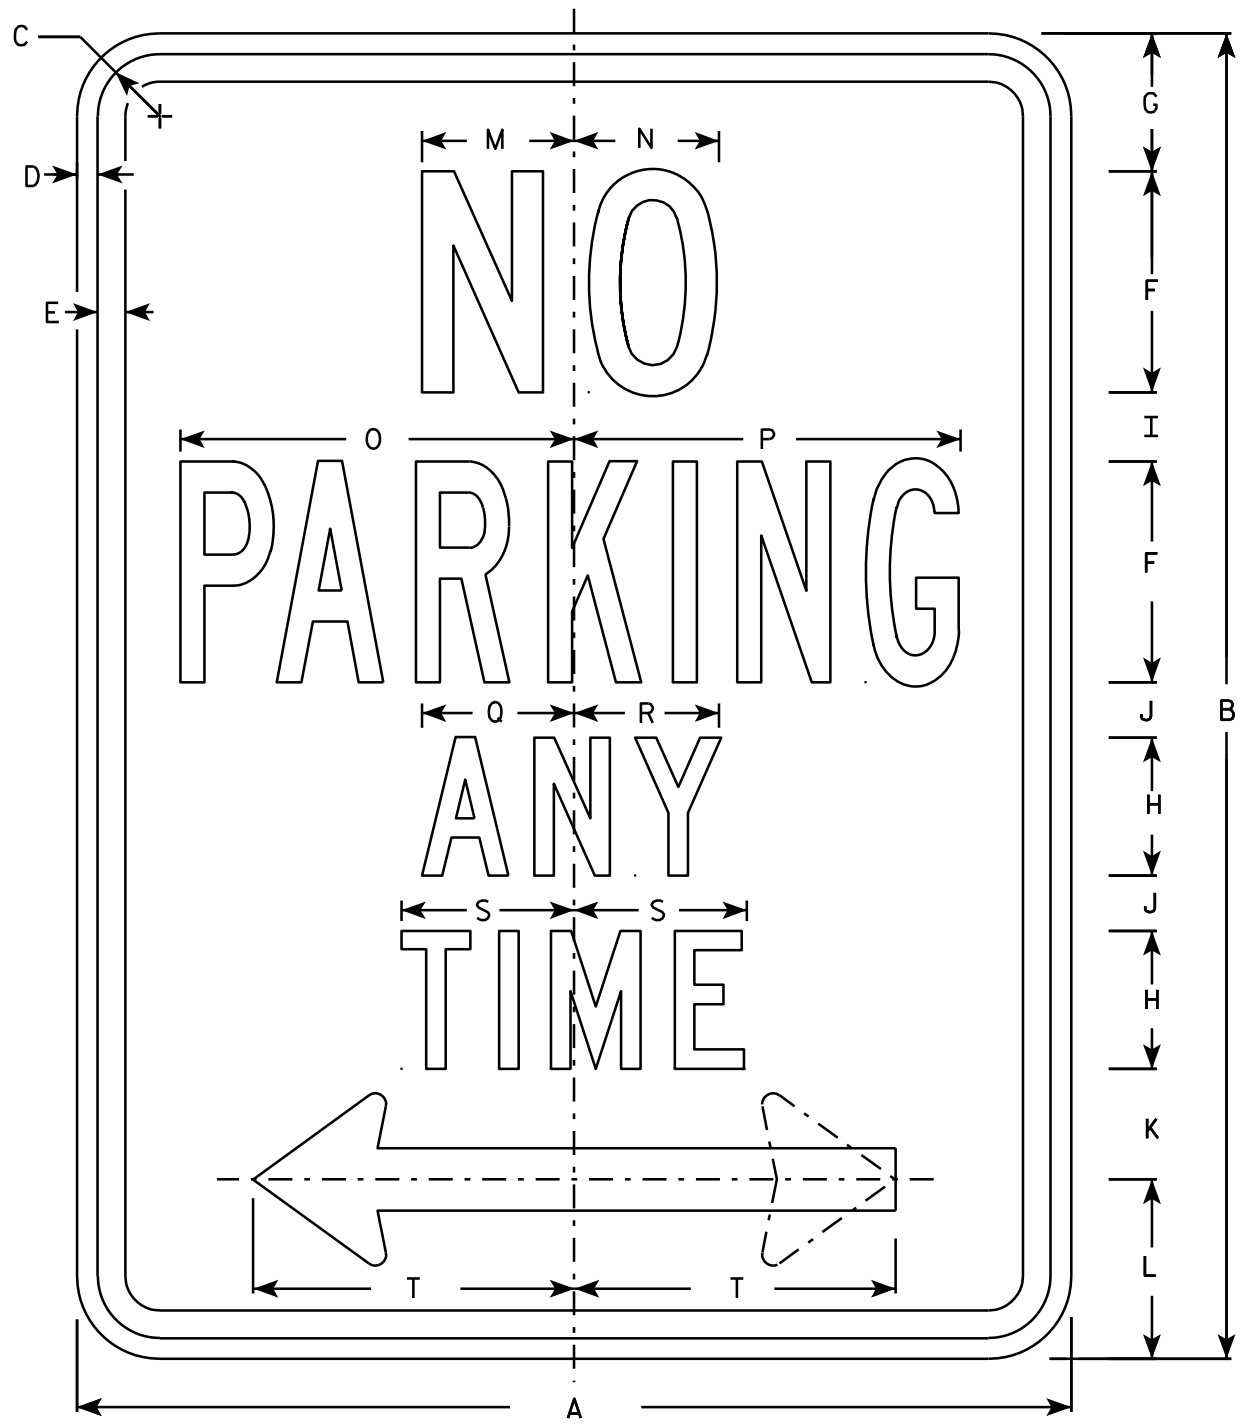

R7-1

**NOTES**

1. Sign is Type II - Type H Reflective - reference WIS DOT Standard Specification for HIGHWAY and STRUCTURE CONSTRUCTION latest edition.
2. Color:  
Background - White  
Message - Red
3. Message Series - See Note 5
4. Corners may be square or rounded when base material is plywood but borders shall be rounded as shown. When base material is metal, the corners and borders shall be rounded.
5. Lines 1, 3 and 4 are series C, line 2 is series B.
6. R7-1D (double arrow)  
R7-1L (left arrow)  
R7-1R (right arrow)

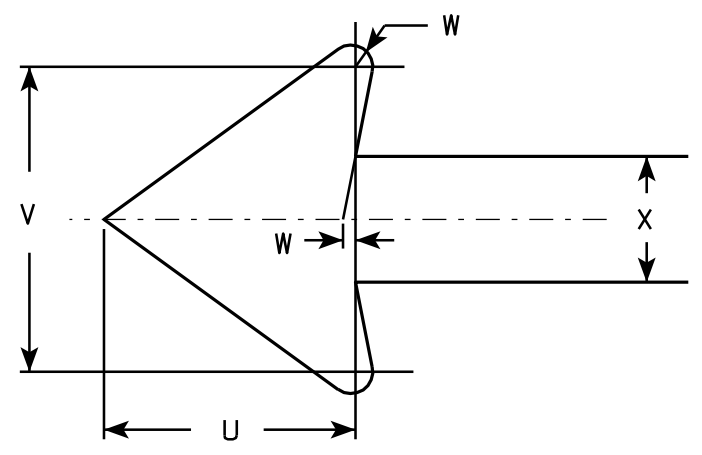

7

7

SIZE	A	B	C	D	E	F	G	H	I	J	K	L	M	N	O	P	Q	R	S	T	U	V	W	X	Y	Z	Area sq. ft.
1	12	18	1 1/8	3/8	3/8	3	1 7/8	2	7/8	5/8	1 1/2	2 1/2	2	2	4 7/8	4 7/8	2 1/4	2 1/8	2 1/2	3 7/8	1 1/2	1 3/4	1/8	3/4			1.5
2S	18	24	1 1/8	3/8	1/2	4	2 1/2	2 1/2	1 1/4	1	2	3 1/4	2 3/4	2 5/8	7 1/8	7	2 3/4	2 5/8	3 1/8	5 7/8	2 1/4	2 5/8	1/4	1 1/8			3.0
2M	24	30	1 1/8	3/8	1/2	5	3	3	2	1 1/4	2 1/2	4	3 1/4	3 3/8	9 1/4	9 1/4	3 1/4	3 1/4	3 3/4	7 3/4	3	3 1/2	1/4	1 1/2			5.0
3	24	30	1 1/8	3/8	1/2	5	3	3	2	1 1/4	2 1/2	4	3 1/4	3 3/8	9 1/4	9 1/4	3 1/4	3 1/4	3 3/4	7 3/4	3	3 1/2	1/4	1 1/2			5.0
4																											
5																											


**STANDARD SIGN**  
R7-1

WISCONSIN DEPT OF TRANSPORTATION

APPROVED *Matthew R. Rauch*  
for State Traffic Engineer

DATE 3/31/2011 PLATE NO. R7-1.9

PROJECT NO: \_\_\_\_\_ HWY: \_\_\_\_\_ COUNTY: \_\_\_\_\_ SHEET NO: \_\_\_\_\_ E

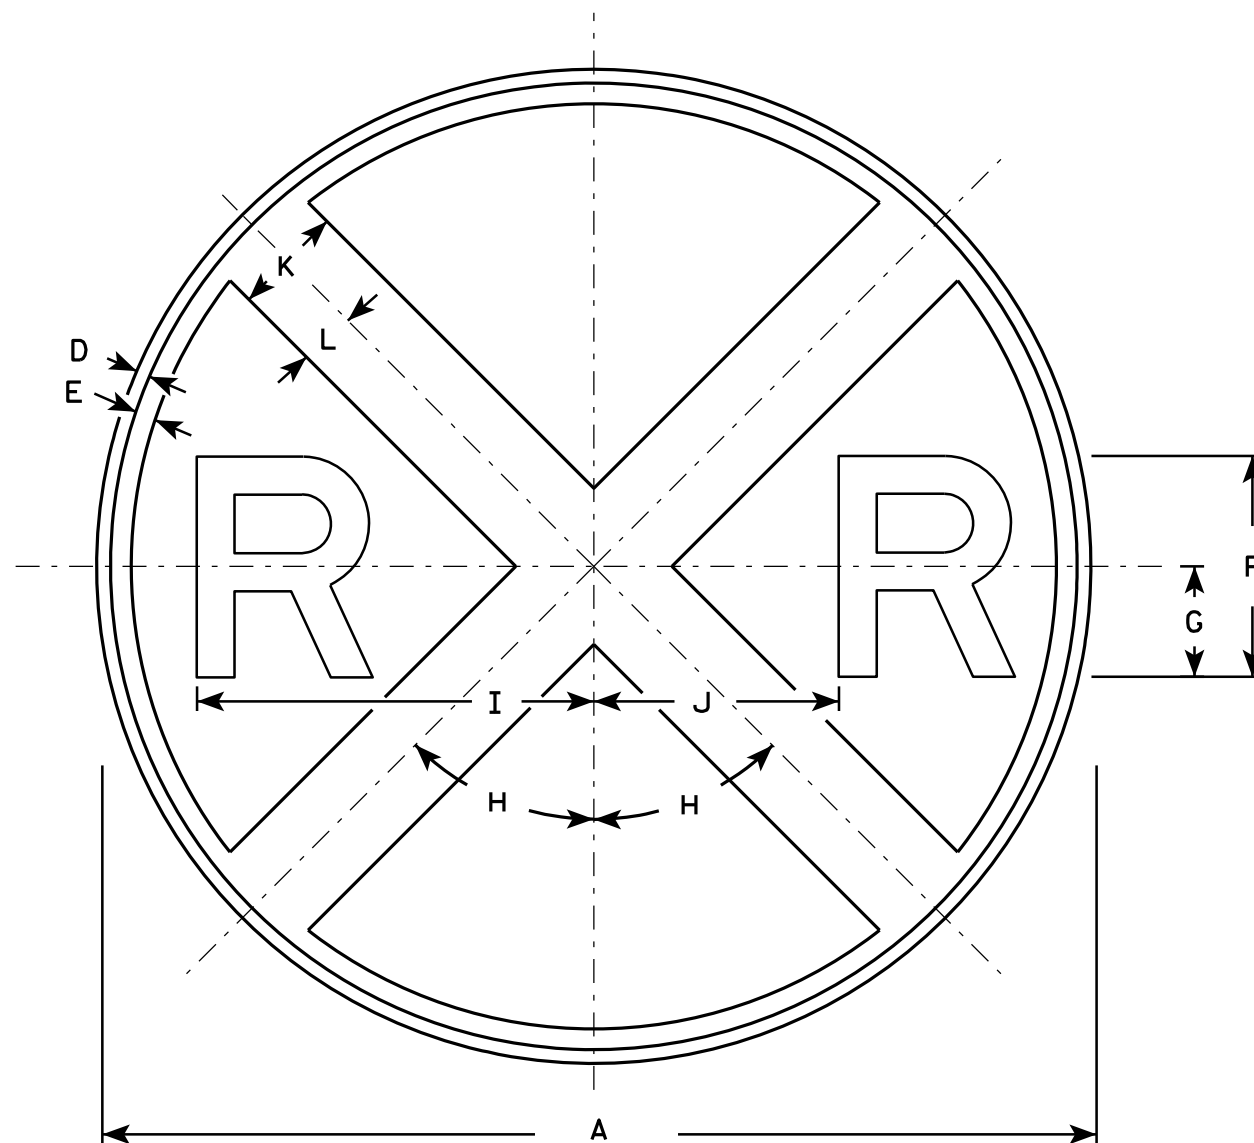

W10-1

NOTES

1. Sign is Type II - Type H Reflective - reference WIS DOT Standard Specification for HIGHWAY and STRUCTURE CONSTRUCTION latest edition.
2. Color:  
Background - Yellow  
Message - Black
3. Message Series - E

7

7


SIZE	A	B	C	D	E	F	G	H	I	J	K	L	M	N	O	P	Q	R	S	T	U	V	W	X	Y	Z	Area sq. ft.
1	30			$\frac{3}{8}$	$\frac{5}{8}$	7	3 1/2	45°	12 3/8	7 1/8	3	1 1/2															4.91
2S	36			$\frac{5}{8}$	$\frac{3}{4}$	8	4	45°	14 3/8	8 5/8	4	2															7.07
2M	36			$\frac{5}{8}$	$\frac{3}{4}$	8	4	45°	14 3/8	8 5/8	4	2															7.07
3																											
4	48			$\frac{3}{4}$	1 1/4	10	5	45°	18 3/8	11 5/8	5	2 1/2															12.57
5																											

STANDARD SIGN  
W10-1

WISCONSIN DEPT OF TRANSPORTATION

APPROVED *Matthew R. Rauch*  
for State Traffic Engineer  
DATE 3/15/11 PLATE NO. W10-1.7

PROJECT NO: \_\_\_\_\_ HWY: \_\_\_\_\_ COUNTY: \_\_\_\_\_ SHEET NO: \_\_\_\_\_ E

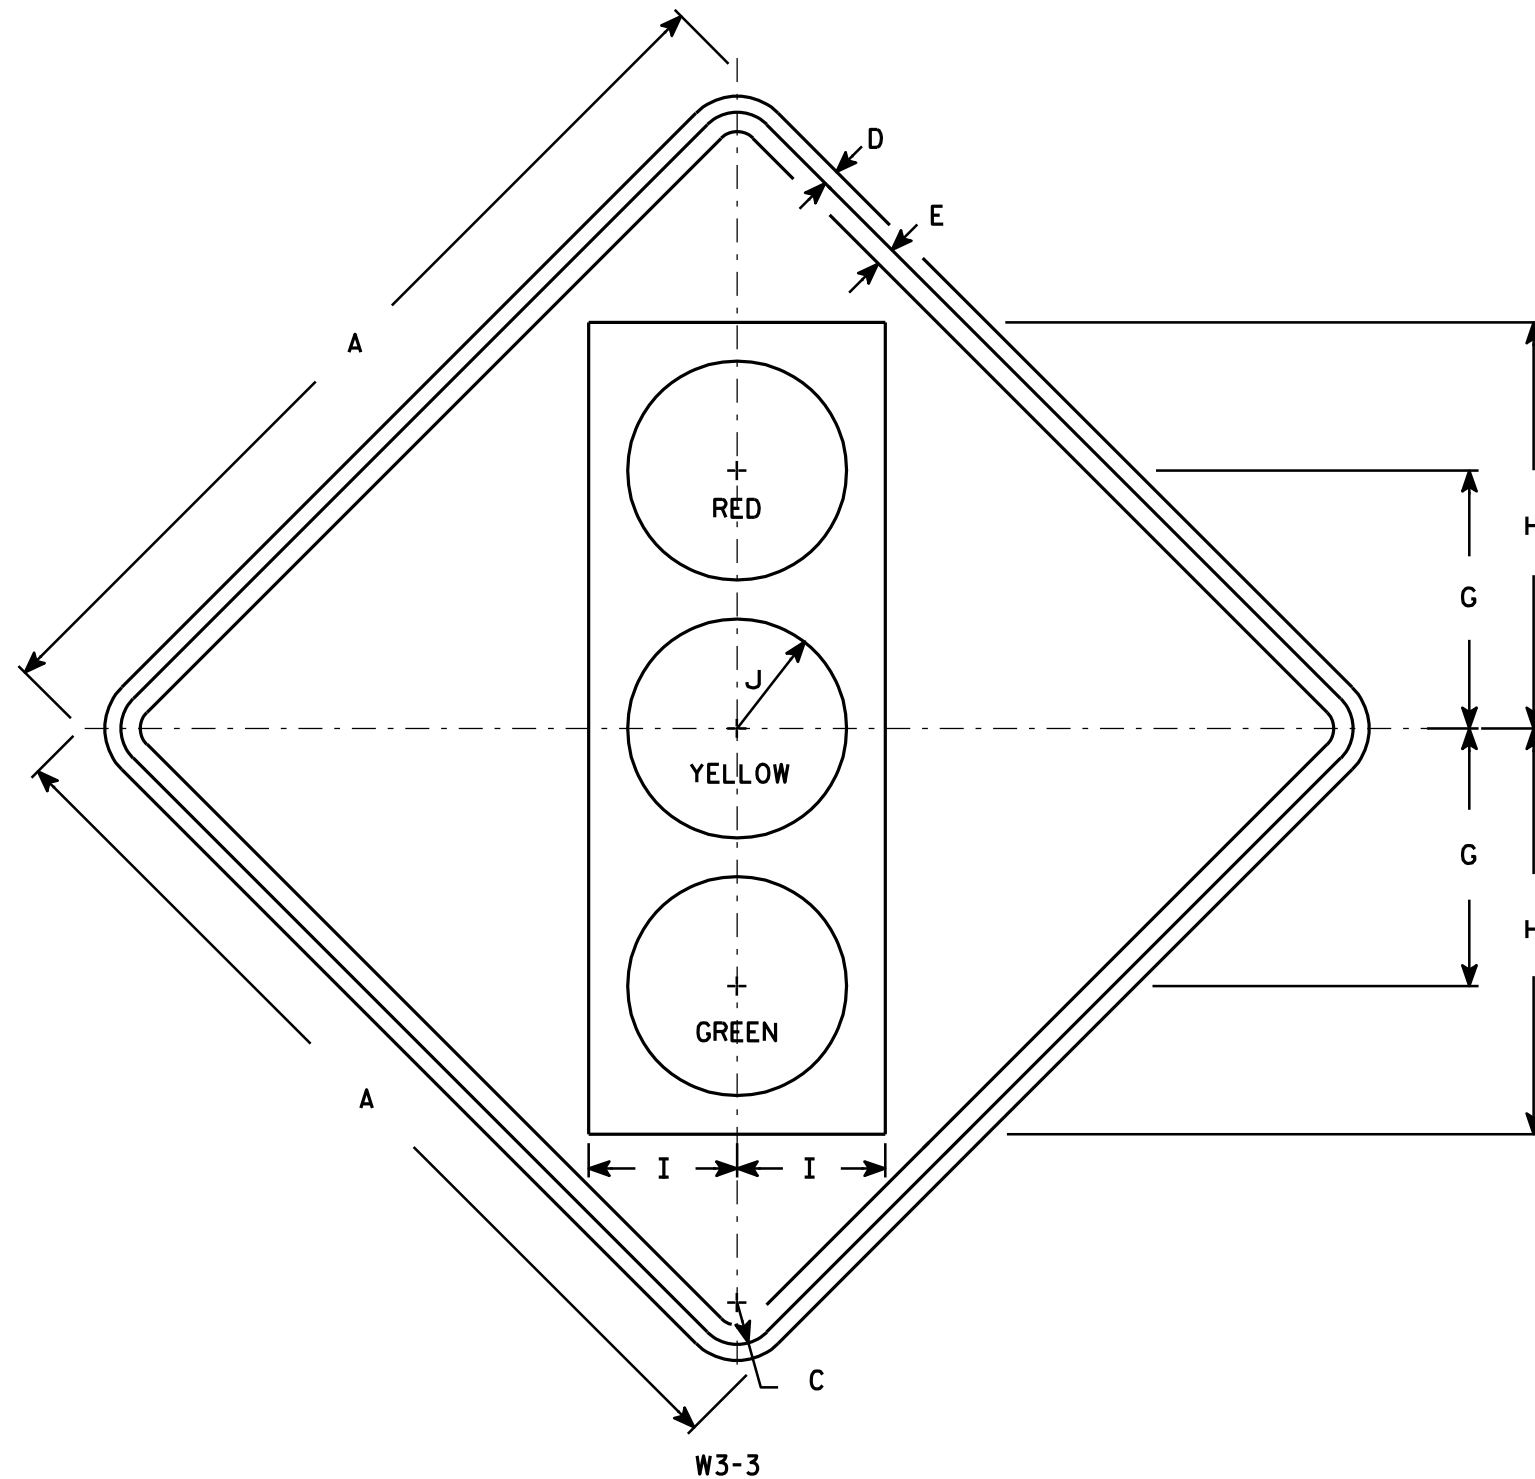

**NOTES**

1. Sign is Type II - Type F Reflective - reference WIS DOT Standard Specification for HIGHWAY and STRUCTURE CONSTRUCTION latest edition.
2. Color:  
Background - Yellow  
Message - See Note 4
3. Corners may be square or rounded when base material is plywood but borders shall be rounded as shown. When base material is metal, the corners and borders shall be rounded.
4. Symbol and border are non-reflective black.  
Top circle - Type H ReflectORIZED Red  
Center circle - Same as background  
Bottom circle - Type H ReflectORIZED Green

7

7

SIZE	A	B	C	D	E	F	G	H	I	J	K	L	M	N	O	P	Q	R	S	T	U	V	W	X	Y	Z	Area sq. ft.
1	30		1 3/8	1/2	5/8		8 3/4	13 3/4	5	3 3/4																	6.25
2S	36		1 5/8	5/8	3/4		10	15 3/4	5 3/4	4 1/4																	9.0
2M	36		1 5/8	5/8	3/4		10	15 3/4	5 3/4	4 1/4																	9.0
3	36		1 5/8	5/8	3/4		10	15 3/4	5 3/4	4 1/4																	9.0
4	48		2 1/4	3/4	1		12 1/2	20	7 1/2	5																	16.0
5	48		2 1/4	3/4	1		12 1/2	20	7 1/2	5																	16.0

**STANDARD SIGN**  
**W3-3**

WISCONSIN DEPT OF TRANSPORTATION


APPROVED *Matthew R. Rauch*  
for State Traffic Engineer

DATE 6/7/10 PLATE NO. W3-3.11

PROJECT NO: \_\_\_\_\_ HWY: \_\_\_\_\_ COUNTY: \_\_\_\_\_ SHEET NO: \_\_\_\_\_ **E**

NOTES

1. Sign is Type II - Type SH Reflective - reference WIS DOT Standard Specification for HIGHWAY and STRUCTURE CONSTRUCTION latest edition.
2. Color:  
Background - Red
3. Corners may be square or rounded when base material is plywood. When base material is metal the corners shall be rounded.

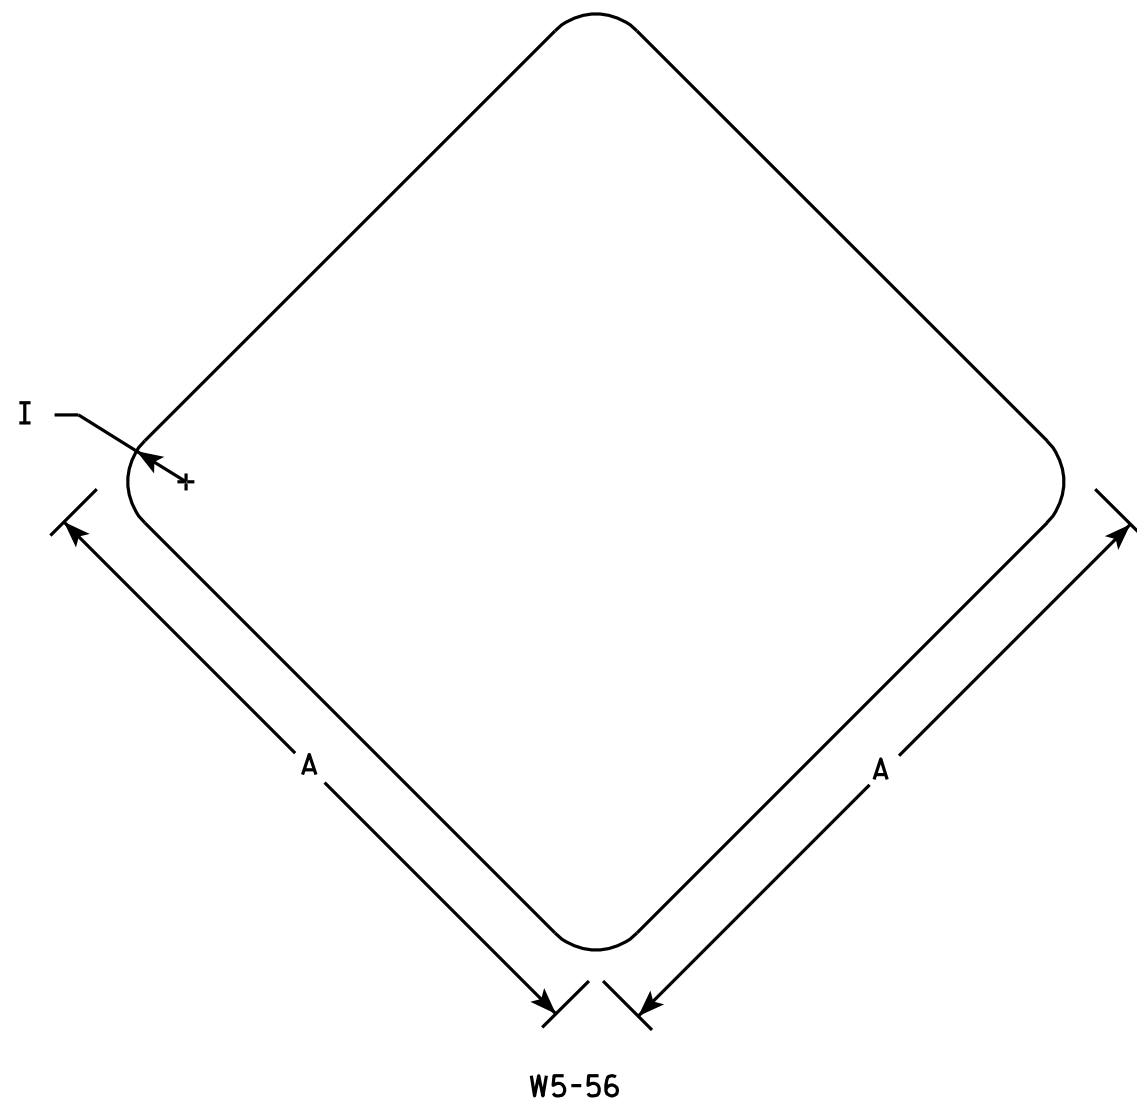

7

7

SIZE	A	B	C	D	E	F	G	H	I	J	K	L	M	N	O	P	Q	R	S	T	U	V	W	X	Y	Z	Area sq. ft.
1	12								1																		1.0
2S	18								1 1/2																		2.25
2M	18								1 1/2																		2.25
3																											
4																											
5																											

**STANDARD SIGN**  
**W5-56**

WISCONSIN DEPT OF TRANSPORTATION

APPROVED *Matthew R Rauch*  
for State Traffic Engineer

DATE 11/2/10 PLATE NO. W5-56.6

PROJECT NO: \_\_\_\_\_ HWY: \_\_\_\_\_ COUNTY: \_\_\_\_\_ SHEET NO: **E**



STATION	Distance	AREA (SF)			Inc. Vol (CY) (Unadjusted)			Cumulative Vol (CY)				Mass Ordinate
		Cut	Fill	EBS	Cut	Fill	EBS	Cut 1.00	Expanded Fill 1.25	Expanded EBS Backfill 1.30	Reduced EBS In Fill 1.00	
71+00.00		88	0	92								
71+17.91	18	94	0	92	60	0	61	60	0	79	60.70	60.25
71+50.00	32	103	0	92	117	0	109	177	0	220	169.45	177.14
71+58.49	8	103	0	92	32	0	29	210	0	258	198.23	209.52
71+64.51	6	104	0	93	23	0	21	233	0	284	218.76	232.56
72+00.00	35	102	0	89	135	0	119	368	0	439	337.94	367.62
72+20.78	21	95	0	89	76	0	68	444	0	528	406.36	443.58
72+33.91	13	94	0	89	46	0	43	490	0	585	449.78	489.68
72+48.61	15	89	0	94	50	0	50	540	0	649	499.58	539.61
72+50.00	1	89	0	94	5	0	5	544	0	656	504.40	544.20
73+00.00	50	110	0	97	185	0	177	729	1	886	681.21	728.37
73+28.30	28	108	0	99	114	0	103	843	1	1,019	784.11	842.42
73+45.79	17	104	0	100	69	0	64	912	1	1,103	848.44	911.10
73+50.00	4	105	0	100	16	0	16	928	1	1,123	863.99	927.37
73+57.88	8	98	0	100	30	0	29	958	1	1,161	893.15	956.90
73+66.18	8	101	0	100	31	0	31	989	1	1,201	923.94	987.33
74+00.00	34	108	0	101	131	0	126	1,119	2	1,365	1,049.84	1,117.56
74+16.00	16	112	0	101	65	0	60	1,184	2	1,442	1,109.55	1,182.74
74+29.90	14	109	0	101	57	0	52	1,241	2	1,510	1,161.39	1,239.52
74+35.40	6	109	0	101	22	0	20	1,264	2	1,536	1,181.88	1,261.68
74+50.00	15	106	2	101	58	1	54	1,322	3	1,607	1,236.24	1,319.27
75+00.00	50	86	22	101	178	22	186	1,500	30	1,849	1,422.36	1,469.12
75+25.84	26	78	32	101	78	26	96	1,578	63	1,974	1,518.55	1,515.14
75+36.00	10	75	27	101	29	11	38	1,607	76	2,023	1,556.37	1,530.22
75+47.90	12	74	26	101	33	12	44	1,639	91	2,081	1,600.66	1,548.59
75+49.90	2	75	17	101	5	2	7	1,645	93	2,091	1,608.11	1,552.10
75+50.00	0	75	17	101	0	0	0	1,645	93	2,091	1,608.48	1,552.30
75+55.30	5	76	15	101	15	3	20	1,660	97	2,117	1,628.21	1,563.16
75+60.70	5	75	18	101	15	3	20	1,675	101	2,143	1,648.31	1,574.12
75+76.00	15	75	21	101	43	11	57	1,718	115	2,217	1,705.26	1,602.88
76+00.00	24	77	16	101	67	17	89	1,785	135	2,333	1,794.60	1,649.62
76+42.91	43	89	7	101	131	18	160	1,917	158	2,541	1,954.33	1,758.20
76+50.00	7	91	7	101	24	2	26	1,940	161	2,575	1,980.72	1,779.60
76+75.20	25	100	3	100	89	5	94	2,029	166	2,697	2,074.49	1,862.75
76+80.70	6	101	2	100	20	1	20	2,050	167	2,723	2,094.92	1,882.47
76+96.00	15	103	2	100	58	1	57	2,107	169	2,797	2,151.59	1,938.78
77+00.00	4	103	2	100	15	0	15	2,123	169	2,816	2,166.36	1,953.69
77+50.00	50	101	1	98	188	2	183	2,311	172	3,054	2,349.26	2,139.03
78+00.00	50	108	1	96	193	1	179	2,504	174	3,287	2,528.75	2,330.27
78+50.00	50	101	1	94	193	1	176	2,697	175	3,516	2,704.43	2,521.83
78+79.82	30	97	1	92	109	1	103	2,806	176	3,649	2,807.23	2,629.78
78+82.54	3	98	1	92	10	0	9	2,816	176	3,661	2,816.53	2,639.47
78+87.70	5	101	1	92	19	0	18	2,835	176	3,684	2,834.14	2,658.19
78+94.50	7	100	1	93	25	0	23	2,860	177	3,715	2,857.47	2,683.11
79+00.00	6	89	1	88	19	0	18	2,879	177	3,739	2,875.92	2,702.18
79+09.08	9	89	1	88	30	0	30	2,909	177	3,777	2,905.47	2,731.95
79+19.50	10	84	0	84	33	0	33	2,943	177	3,820	2,938.61	2,765.18
79+50.00	31	94	0	84	101	0	95	3,043	177	3,944	3,033.50	2,865.75
79+59.33	9	92	0	84	32	0	29	3,075	177	3,981	3,062.53	2,897.99
79+67.38	8	94	0	84	28	0	25	3,103	177	4,014	3,087.58	2,925.79
79+79.66	12	104	0	88	45	0	39	3,148	178	4,065	3,126.63	2,970.82
80+00.00	20	108	0	88	80	0	66	3,228	178	4,151	3,192.74	3,050.37
80+05.84	6	116	0	92	24	0	19	3,252	178	4,176	3,212.13	3,074.51
80+11.60	6	116	0	92	25	0	20	3,277	178	4,201	3,231.65	3,099.18
80+41.16	30	115	0	92	126	0	100	3,403	178	4,331	3,331.83	3,225.17
80+43.66	3	116	0	92	11	0	8	3,414	178	4,342	3,340.30	3,235.85
80+50.00	6	114	0	92	27	0	21	3,441	178	4,370	3,361.78	3,262.85
81+00.00	50	109	1	92	206	1	169	3,647	179	4,591	3,531.23	3,468.05
81+24.84	25	106	2	92	99	1	84	3,746	181	4,700	3,615.41	3,565.48
81+26.15	1	105	2	92	5	0	4	3,751	181	4,706	3,619.85	3,570.48
81+29.13	3	104	2	92	12	0	10	3,763	181	4,719	3,629.95	3,581.73
81+30.75	2	105	2	92	6	0	5	3,769	181	4,726	3,635.44	3,587.85
81+50.00	19	104	2	92	75	1	65	3,844	183	4,811	3,700.68	3,660.57
81+89.21	39	108	1	92	154	2	133	3,997	186	4,984	3,833.57	3,811.52


9

9

STATION	Distance	AREA (SF)			Inc. Vol (CY) (Unadjusted)			Cumulative Vol (CY)				Mass Ordinate
		Cut	Fill	EBS	Cut	Fill	EBS	Cut 1.00	Expanded Fill 1.25	Expanded EBS Backfill 1.30	Reduced EBS In Fill 1.00	
82+00.00	11	100	0	88	41	0	36	4,039	186	5,030	3,869.38	3,852.76
82+15.40	15	105	0	88	59	0	50	4,097	186	5,095	3,919.43	3,911.33
82+20.58	5	101	0	88	20	0	17	4,117	186	5,117	3,936.27	3,931.10
82+50.00	29	102	0	88	111	0	96	4,228	186	5,241	4,031.89	4,041.80
82+72.92	23	112	0	92	91	0	76	4,319	186	5,340	4,107.98	4,132.81
82+98.87	26	112	0	92	108	0	88	4,427	186	5,455	4,195.93	4,240.25
83+00.00	1	112	0	92	5	0	4	4,431	186	5,460	4,199.76	4,244.92
83+50.00	50	112	0	92	207	0	169	4,639	187	5,680	4,369.21	4,451.50
83+95.54	46	109	0	92	186	0	154	4,825	188	5,881	4,523.54	4,637.19
84+00.00	4	109	0	92	18	0	15	4,843	188	5,900	4,538.65	4,655.12
84+31.57	32	109	0	92	127	0	107	4,970	188	6,039	4,645.64	4,782.21
84+50.00	18	102	0	88	72	0	61	5,042	188	6,119	4,706.82	4,854.33
84+73.54	24	104	0	88	90	0	77	5,132	188	6,218	4,783.33	4,944.19
85+00.00	26	98	0	88	99	0	86	5,231	188	6,330	4,869.34	5,042.97
85+11.57	12	102	1	92	43	0	38	5,274	189	6,380	4,907.74	5,085.44
85+14.65	3	102	1	92	12	0	10	5,286	189	6,394	4,918.18	5,096.89
85+16.80	2	101	1	92	8	0	7	5,294	189	6,403	4,925.47	5,104.82
85+50.00	33	109	1	92	129	1	113	5,423	191	6,549	5,037.99	5,232.02
85+53.74	4	109	1	92	15	0	13	5,438	191	6,566	5,050.66	5,246.99
85+82.57	29	111	1	92	117	1	98	5,555	192	6,693	5,148.37	5,363.38
86+00.00	17	117	0	92	73	0	59	5,629	192	6,770	5,207.44	5,436.43
86+29.91	30	116	0	92	129	0	101	5,757	192	6,901	5,308.81	5,564.82
86+32.65	3	116	0	92	12	0	9	5,769	192	6,914	5,318.10	5,576.54
86+50.00	17	121	0	92	76	0	59	5,845	193	6,990	5,376.90	5,652.42
87+00.00	50	121	0	92	224	0	169	6,069	193	7,210	5,546.35	5,875.83
87+31.62	32	120	0	92	141	0	107	6,209	193	7,350	5,653.51	6,016.64
87+50.00	18	117	0	92	81	0	62	6,290	193	7,431	5,715.80	6,097.21
87+50.10	0	114	1	92	0	0	0	6,291	193	7,431	5,716.14	6,097.64
87+51.65	2	112	1	92	6	0	5	6,297	193	7,438	5,721.39	6,104.08
87+52.40	1	113	1	92	3	0	3	6,300	193	7,441	5,723.93	6,107.19
88+00.00	48	104	0	88	192	1	158	6,492	194	7,647	5,881.94	6,298.10
88+07.21	7	105	0	88	28	0	23	6,520	194	7,677	5,905.37	6,326.00
88+36.93	30	120	0	92	124	0	99	6,644	194	7,805	6,004.03	6,449.80
88+43.04	6	120	0	92	27	0	21	6,671	194	7,832	6,024.74	6,476.94
88+50.00	7	110	0	88	30	0	23	6,701	194	7,862	6,047.86	6,506.58
88+55.49	5	109	0	88	22	0	18	6,723	194	7,885	6,065.72	6,528.86
89+00.00	45	108	0	88	179	0	145	6,902	194	8,074	6,210.73	6,707.89
89+28.88	29	109	1	92	116	1	96	7,018	195	8,199	6,307.03	6,823.00
89+50.00	21	110	1	92	86	1	72	7,104	196	8,293	6,379.03	6,907.45
90+00.00	50	112	1	92	206	2	171	7,309	199	8,515	6,549.82	7,110.84
90+50.00	50	117	1	93	212	2	171	7,522	201	8,737	6,721.08	7,320.85
91+00.00	50	139	0	93	237	1	172	7,758	202	8,961	6,892.82	7,555.94
91+38.10	38	131	0	95	190	0	132	7,948	203	9,133	7,025.26	7,745.48
91+50.00	12	129	0	98	57	0	42	8,005	203	9,188	7,067.73	7,802.58
91+56.11	6	124	0	100	29	0	22	8,034	203	9,217	7,090.11	7,831.17
91+57.06	1	123	0	100	4	0	4	8,038	203	9,222	7,093.63	7,835.51
92+00.00	43	148	0	126	215	0	180	8,254	203	9,456	7,273.85	8,050.69
92+12.20	12	161	0	146	70	0	62	8,324	203	9,536	7,335.42	8,120.61
92+15.90	4	169	0	154	23	0	21	8,346	203	9,563	7,356.01	8,143.24
92+32.00	16	190	0	208	107	0	108	8,453	203	9,703	7,464.03	8,250.17
					250			8,703				
					261			8,964				
					334			9,298				
82+15					72			9,370				
					241			9,611				
					188			9,799				
86+01					72			9,871				
86+50					72			9,943				
					270			10,213				
					260			10,473				
					234			10,707				
					10,707	162	7,464					

9

9

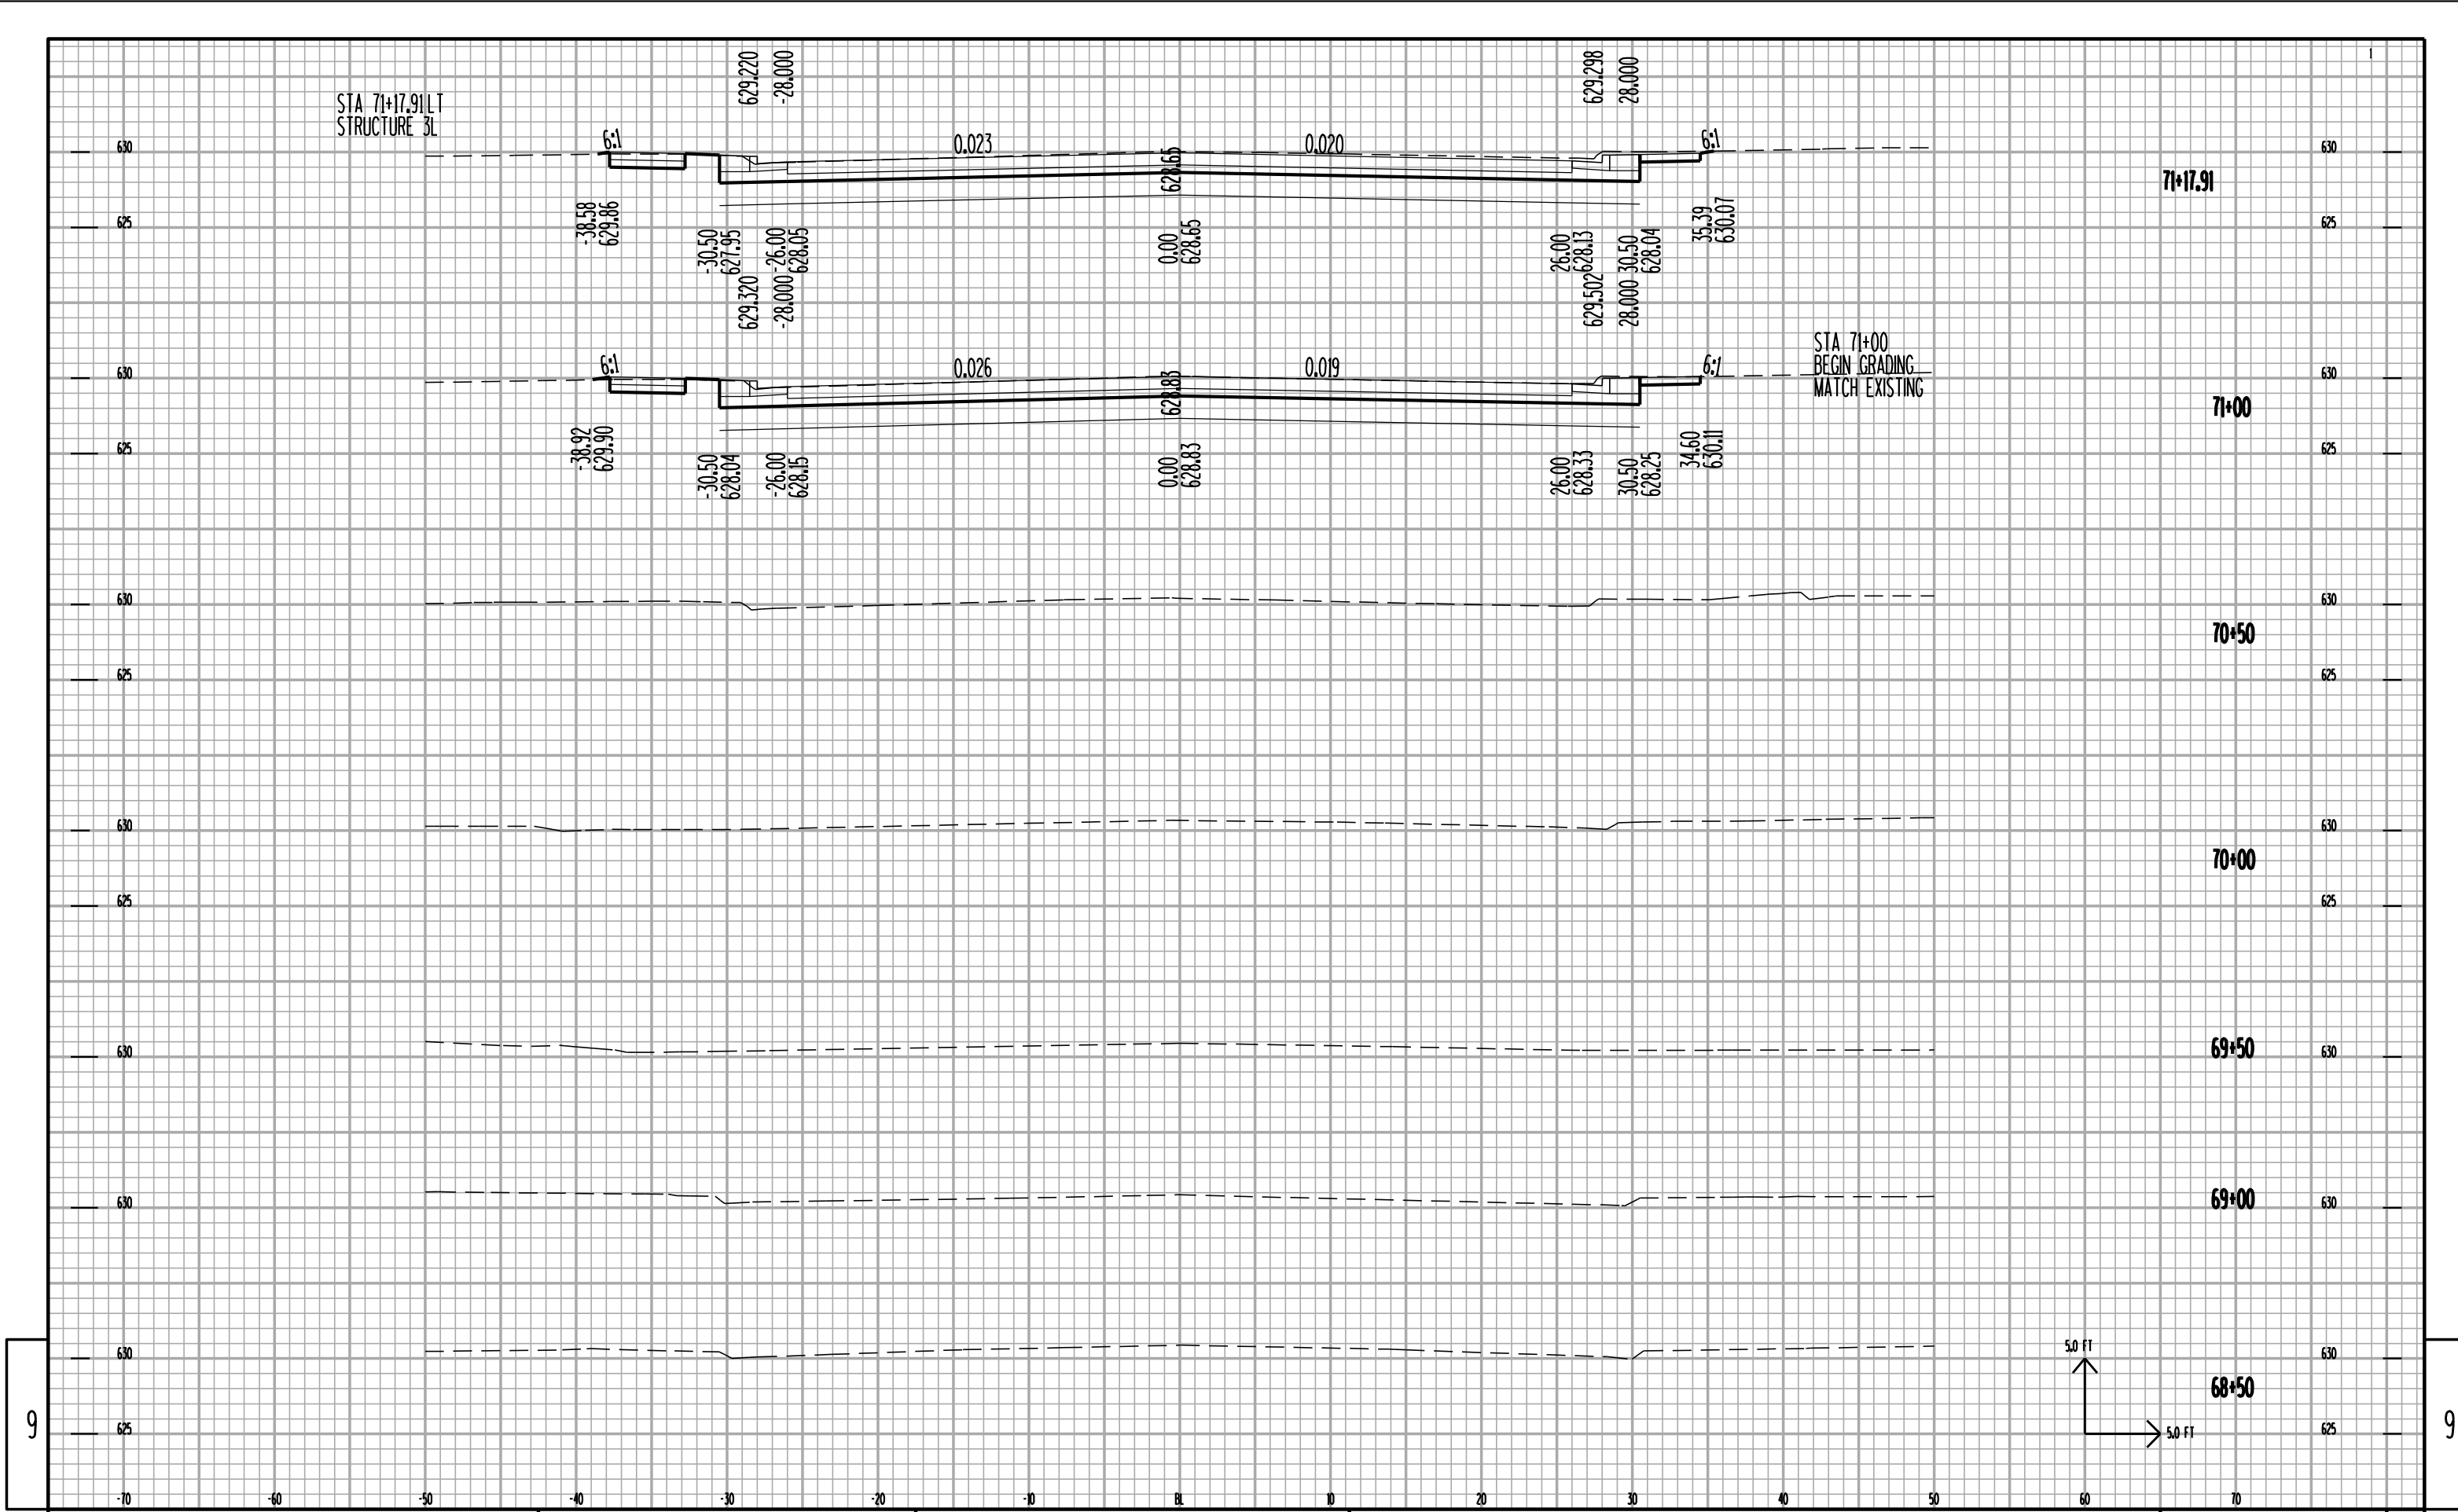

PROJECT NO:1190-44-71

HWY:JSH 2

COUNTY:DOUGLAS

CROSS SECTIONS

SHEET NO:

E

FILE NAME : rca\p05\Design\Project\11904401\dgn\XSHGF\NAL 2.DGN

PLOT DATE : 24-OCT-2000 16:35


PLOT BY : dotbam


PLOT NAME :


PLOT SCALE : 2:1


9


9

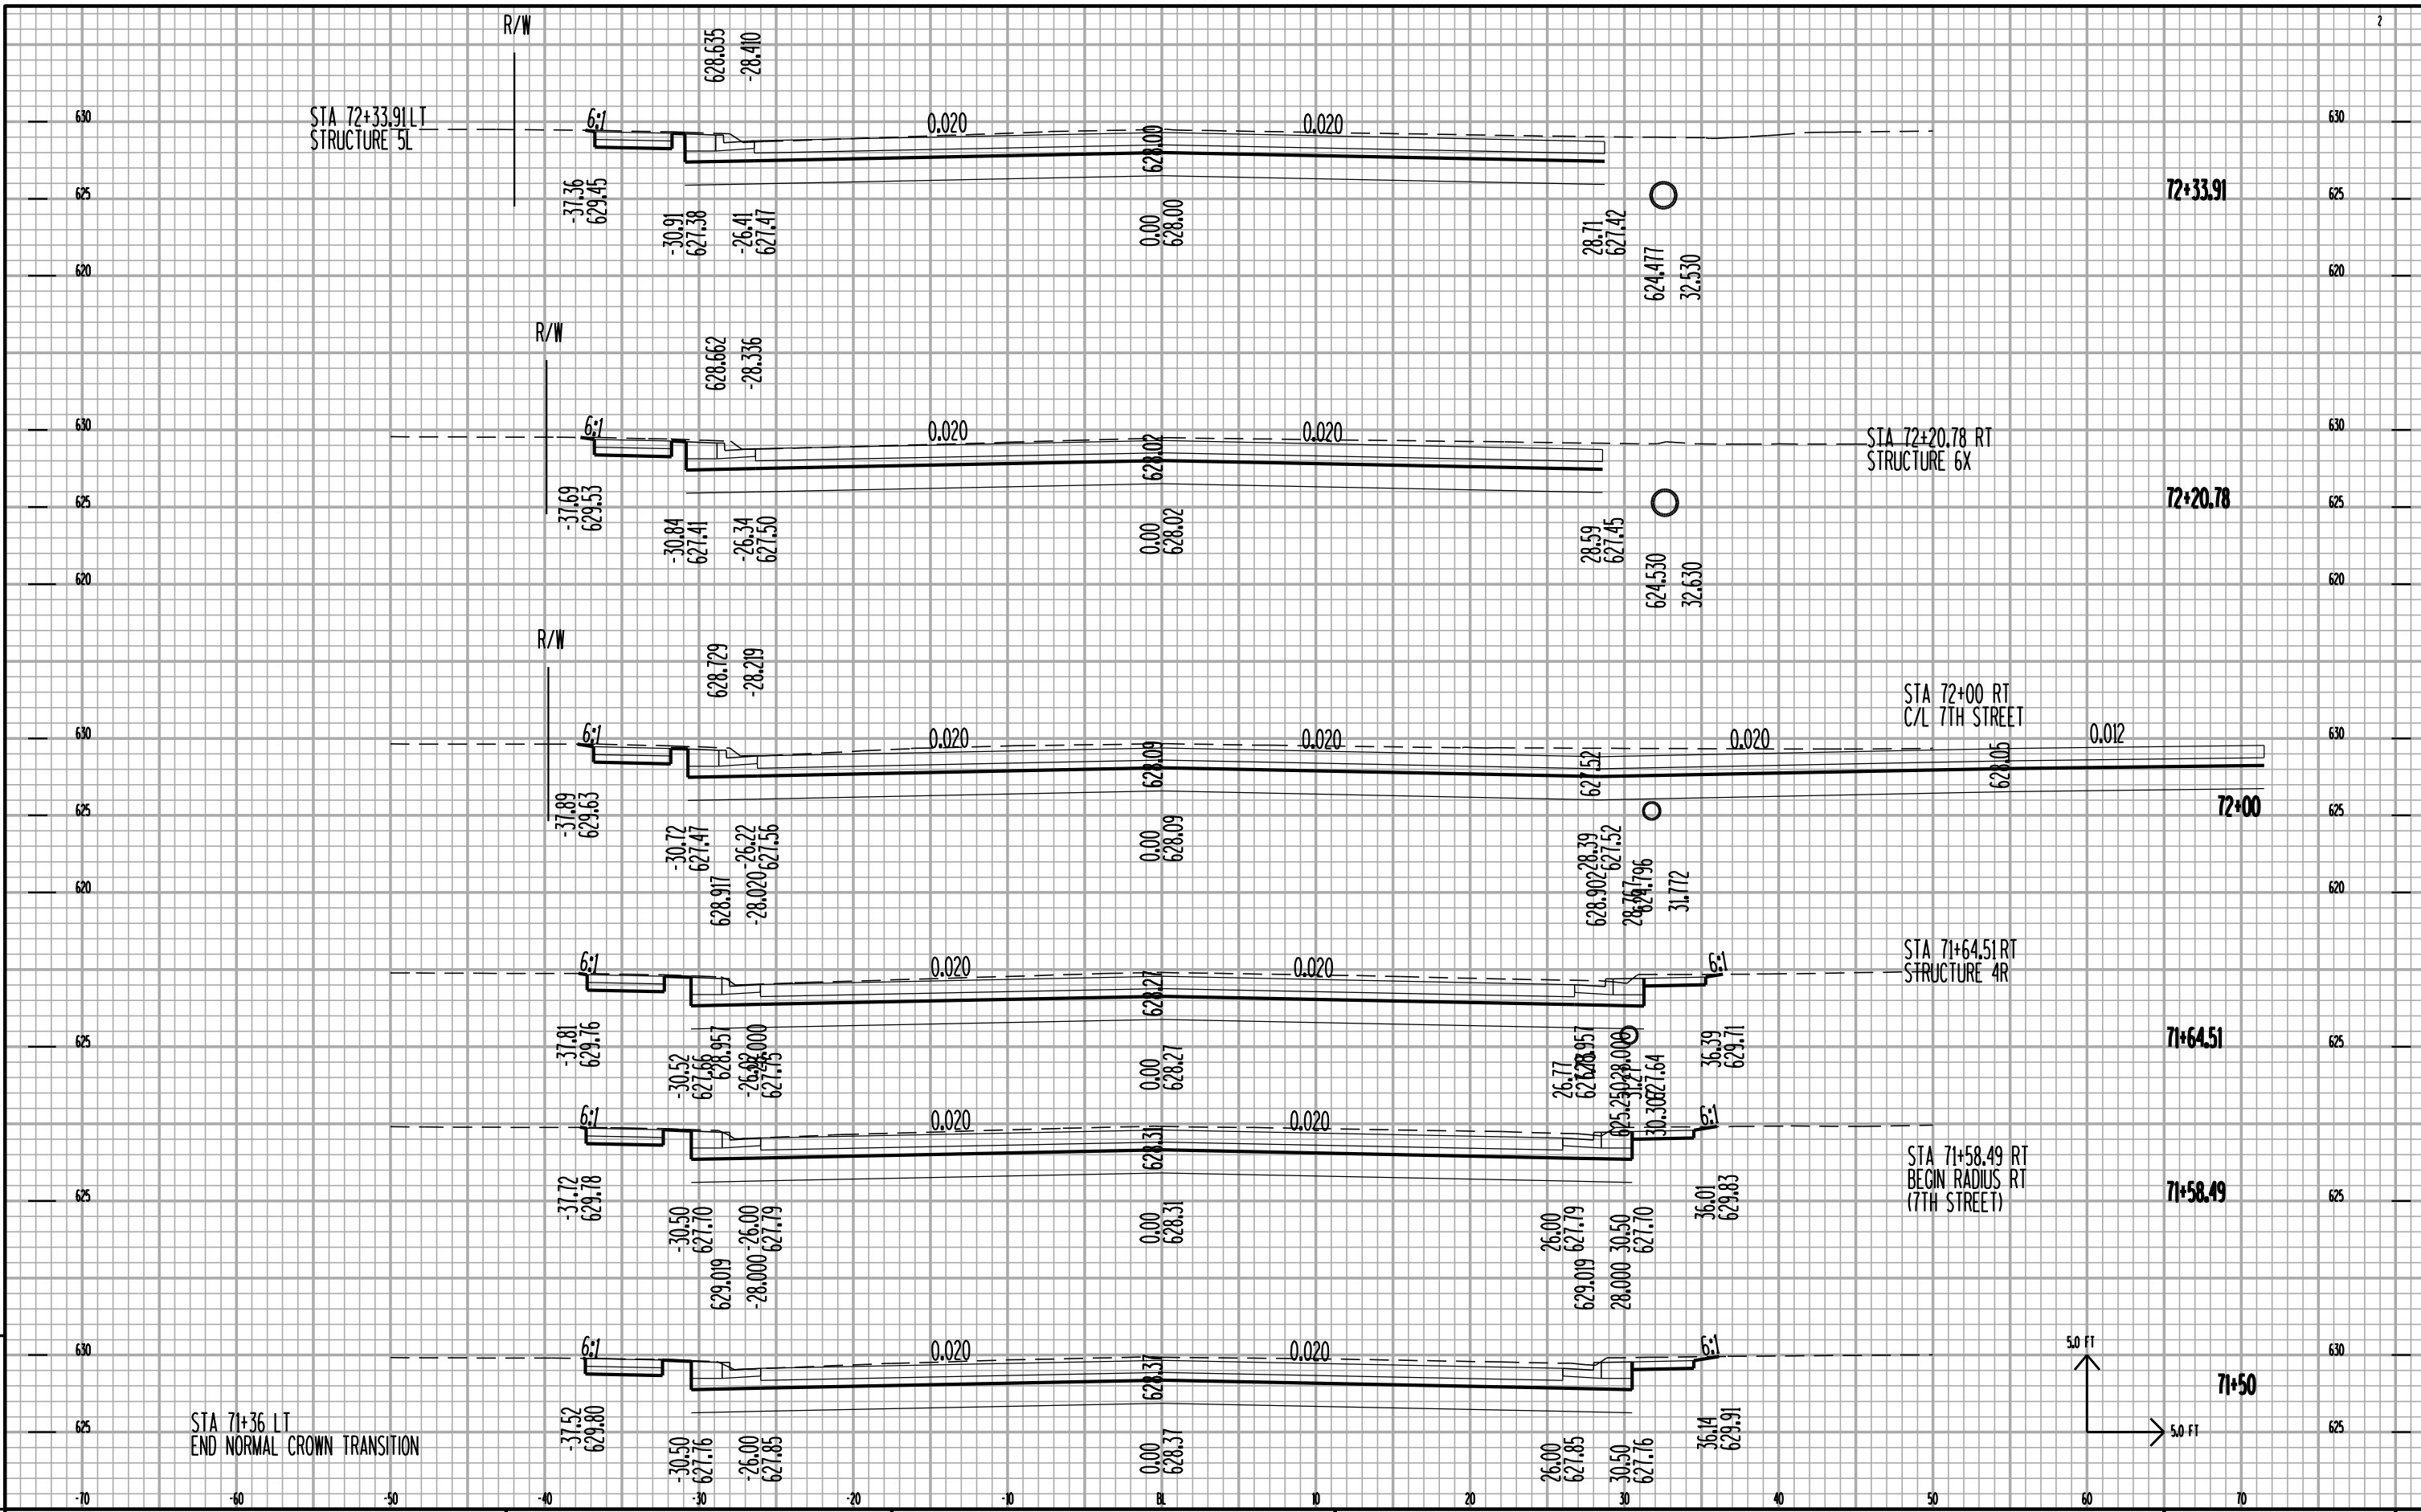

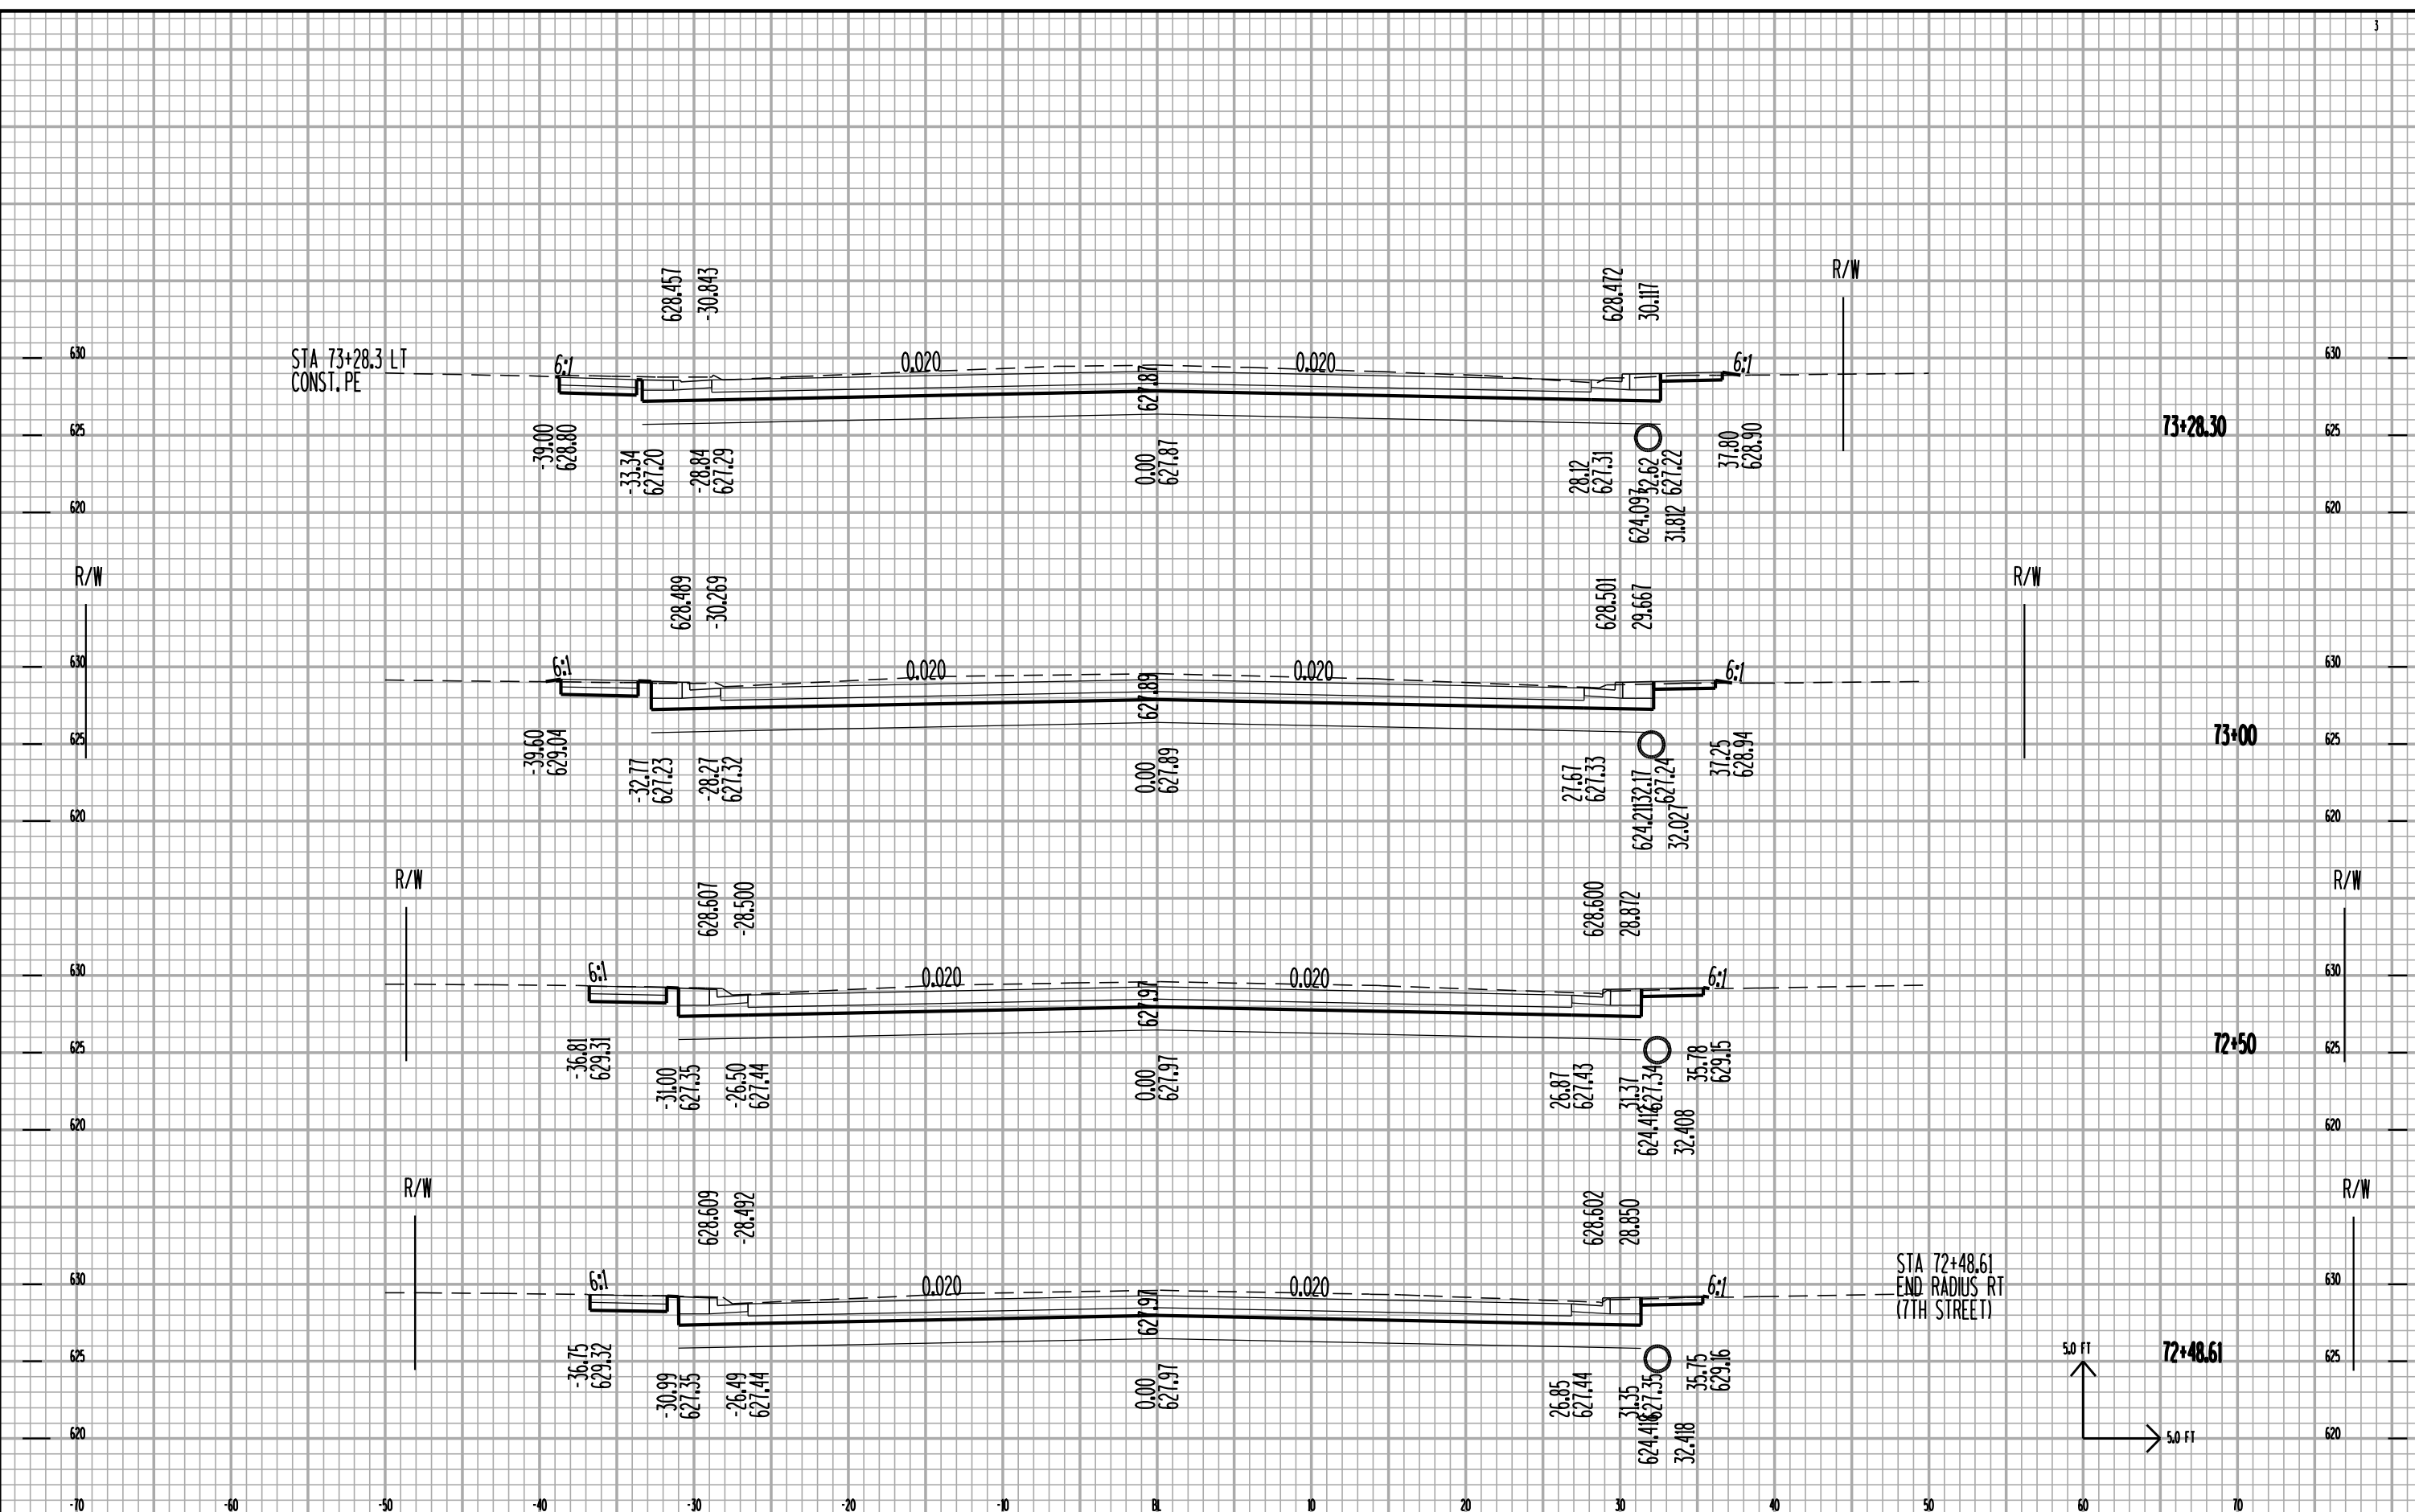

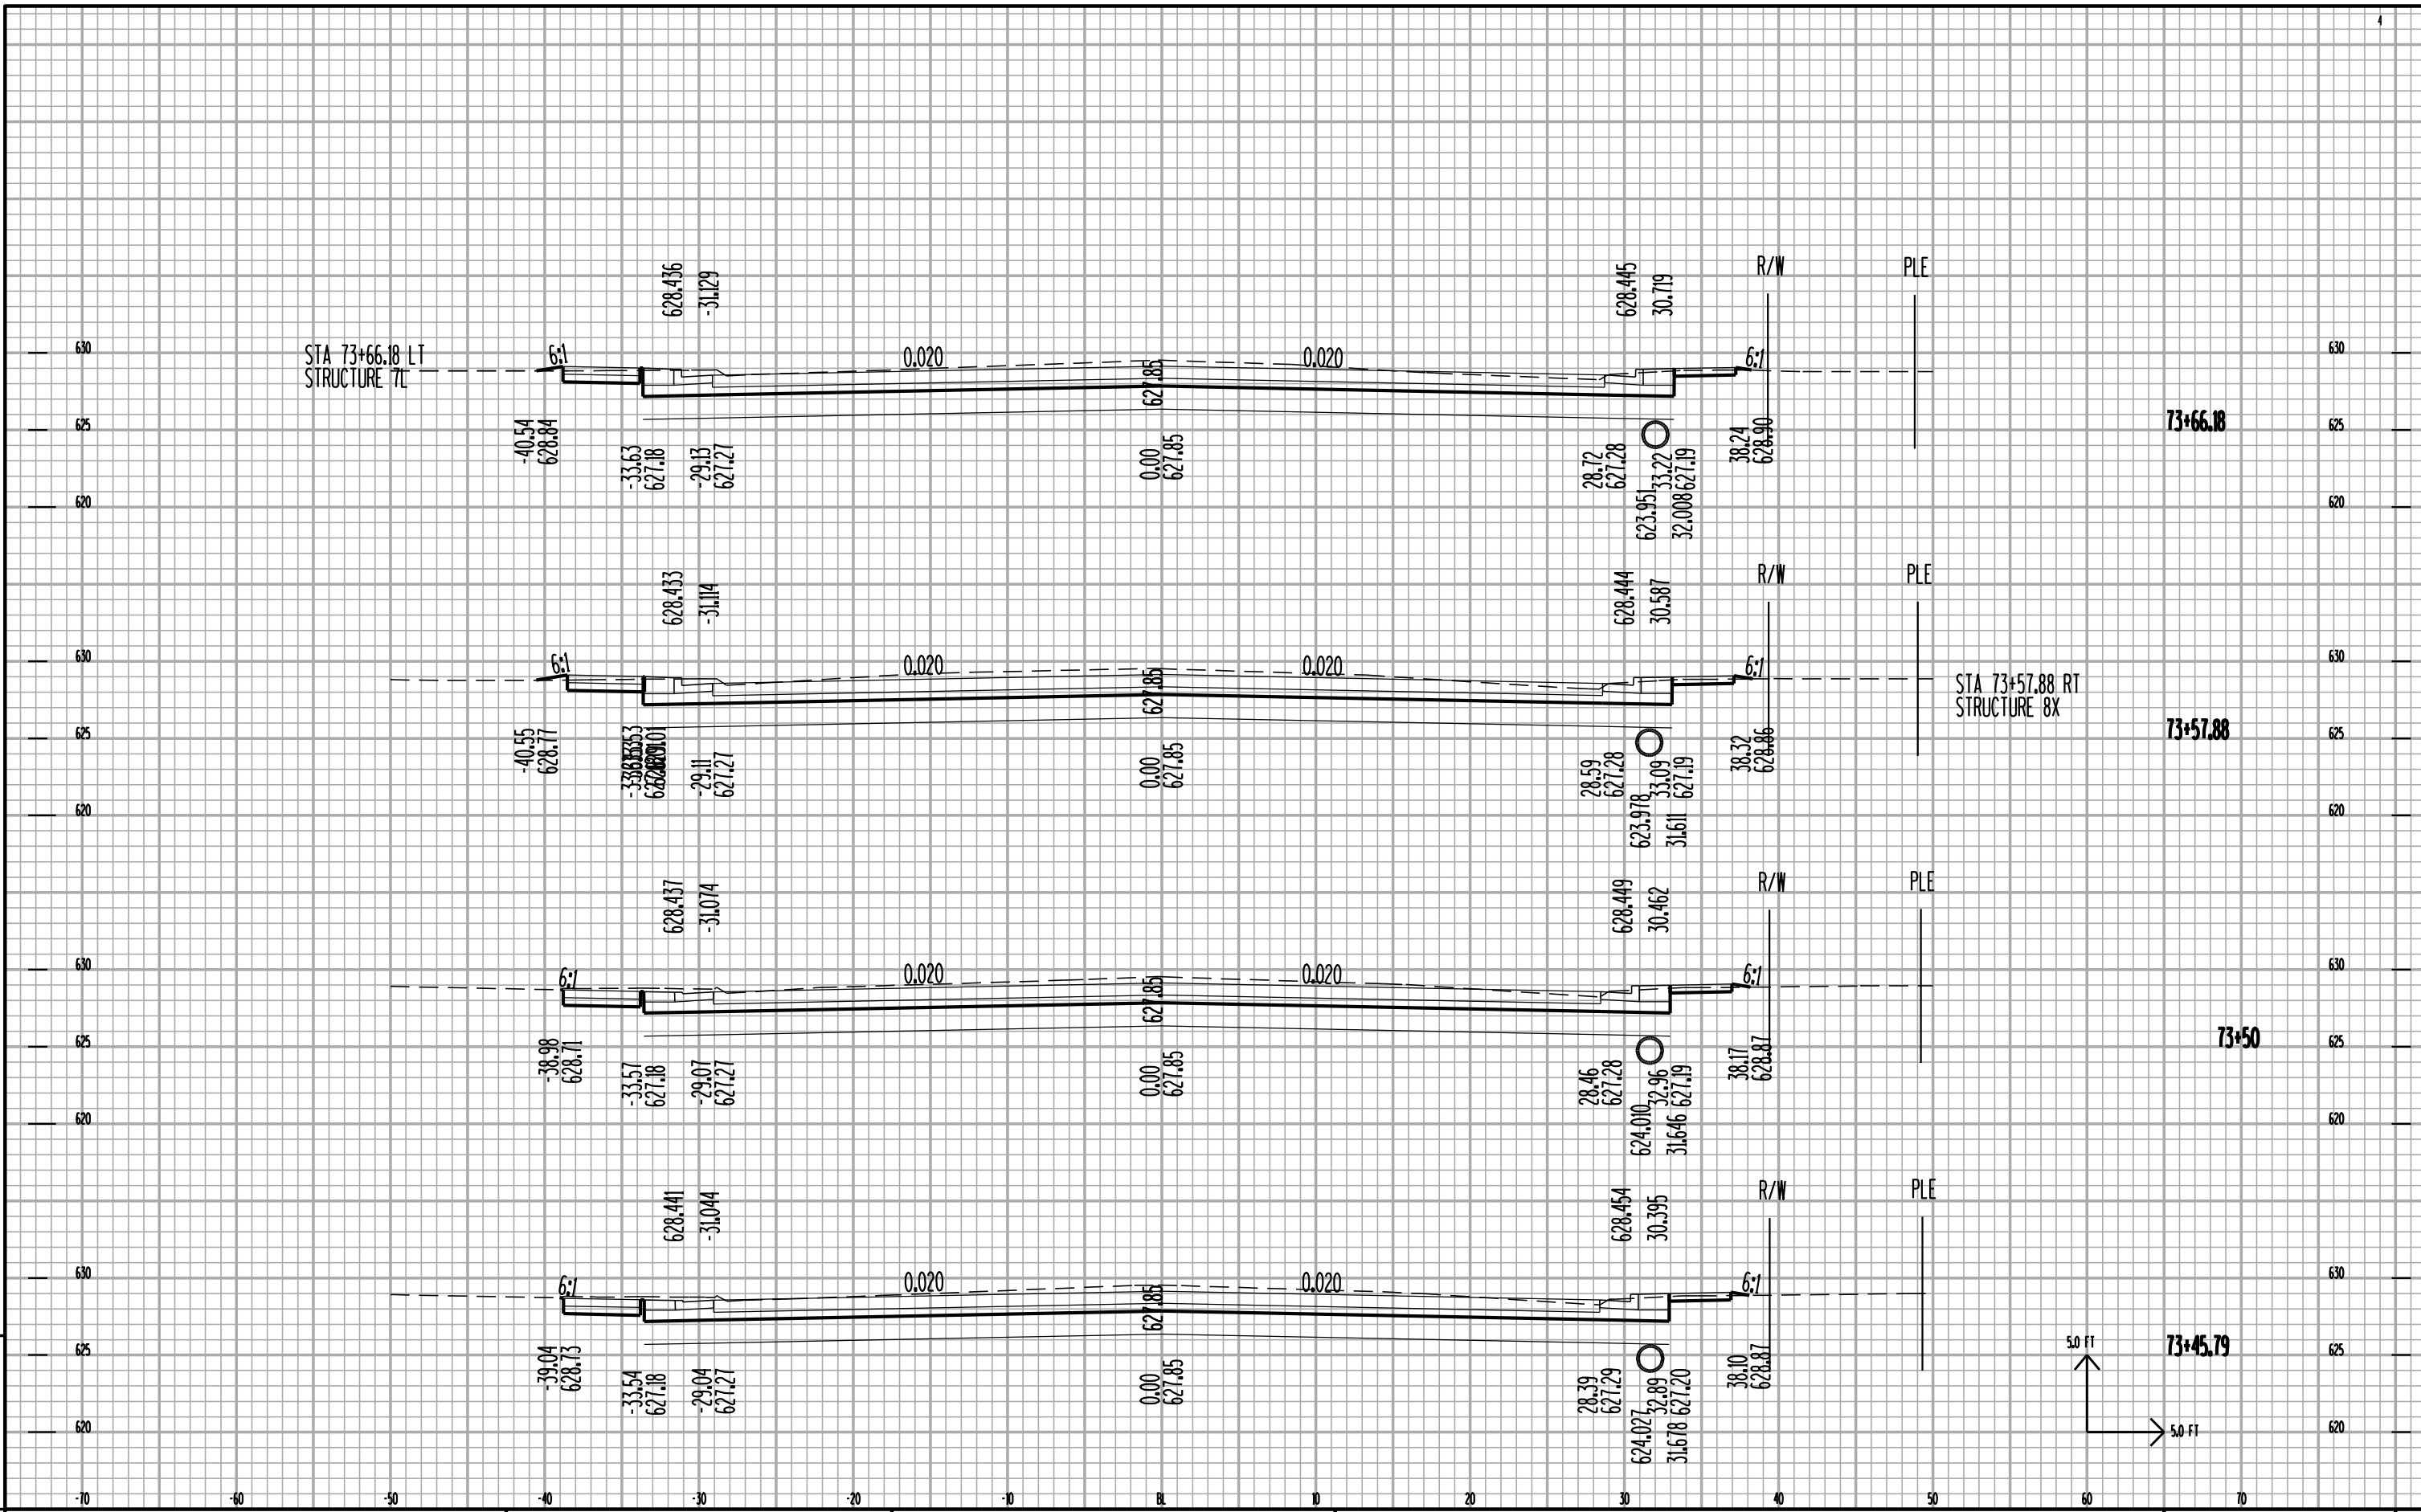

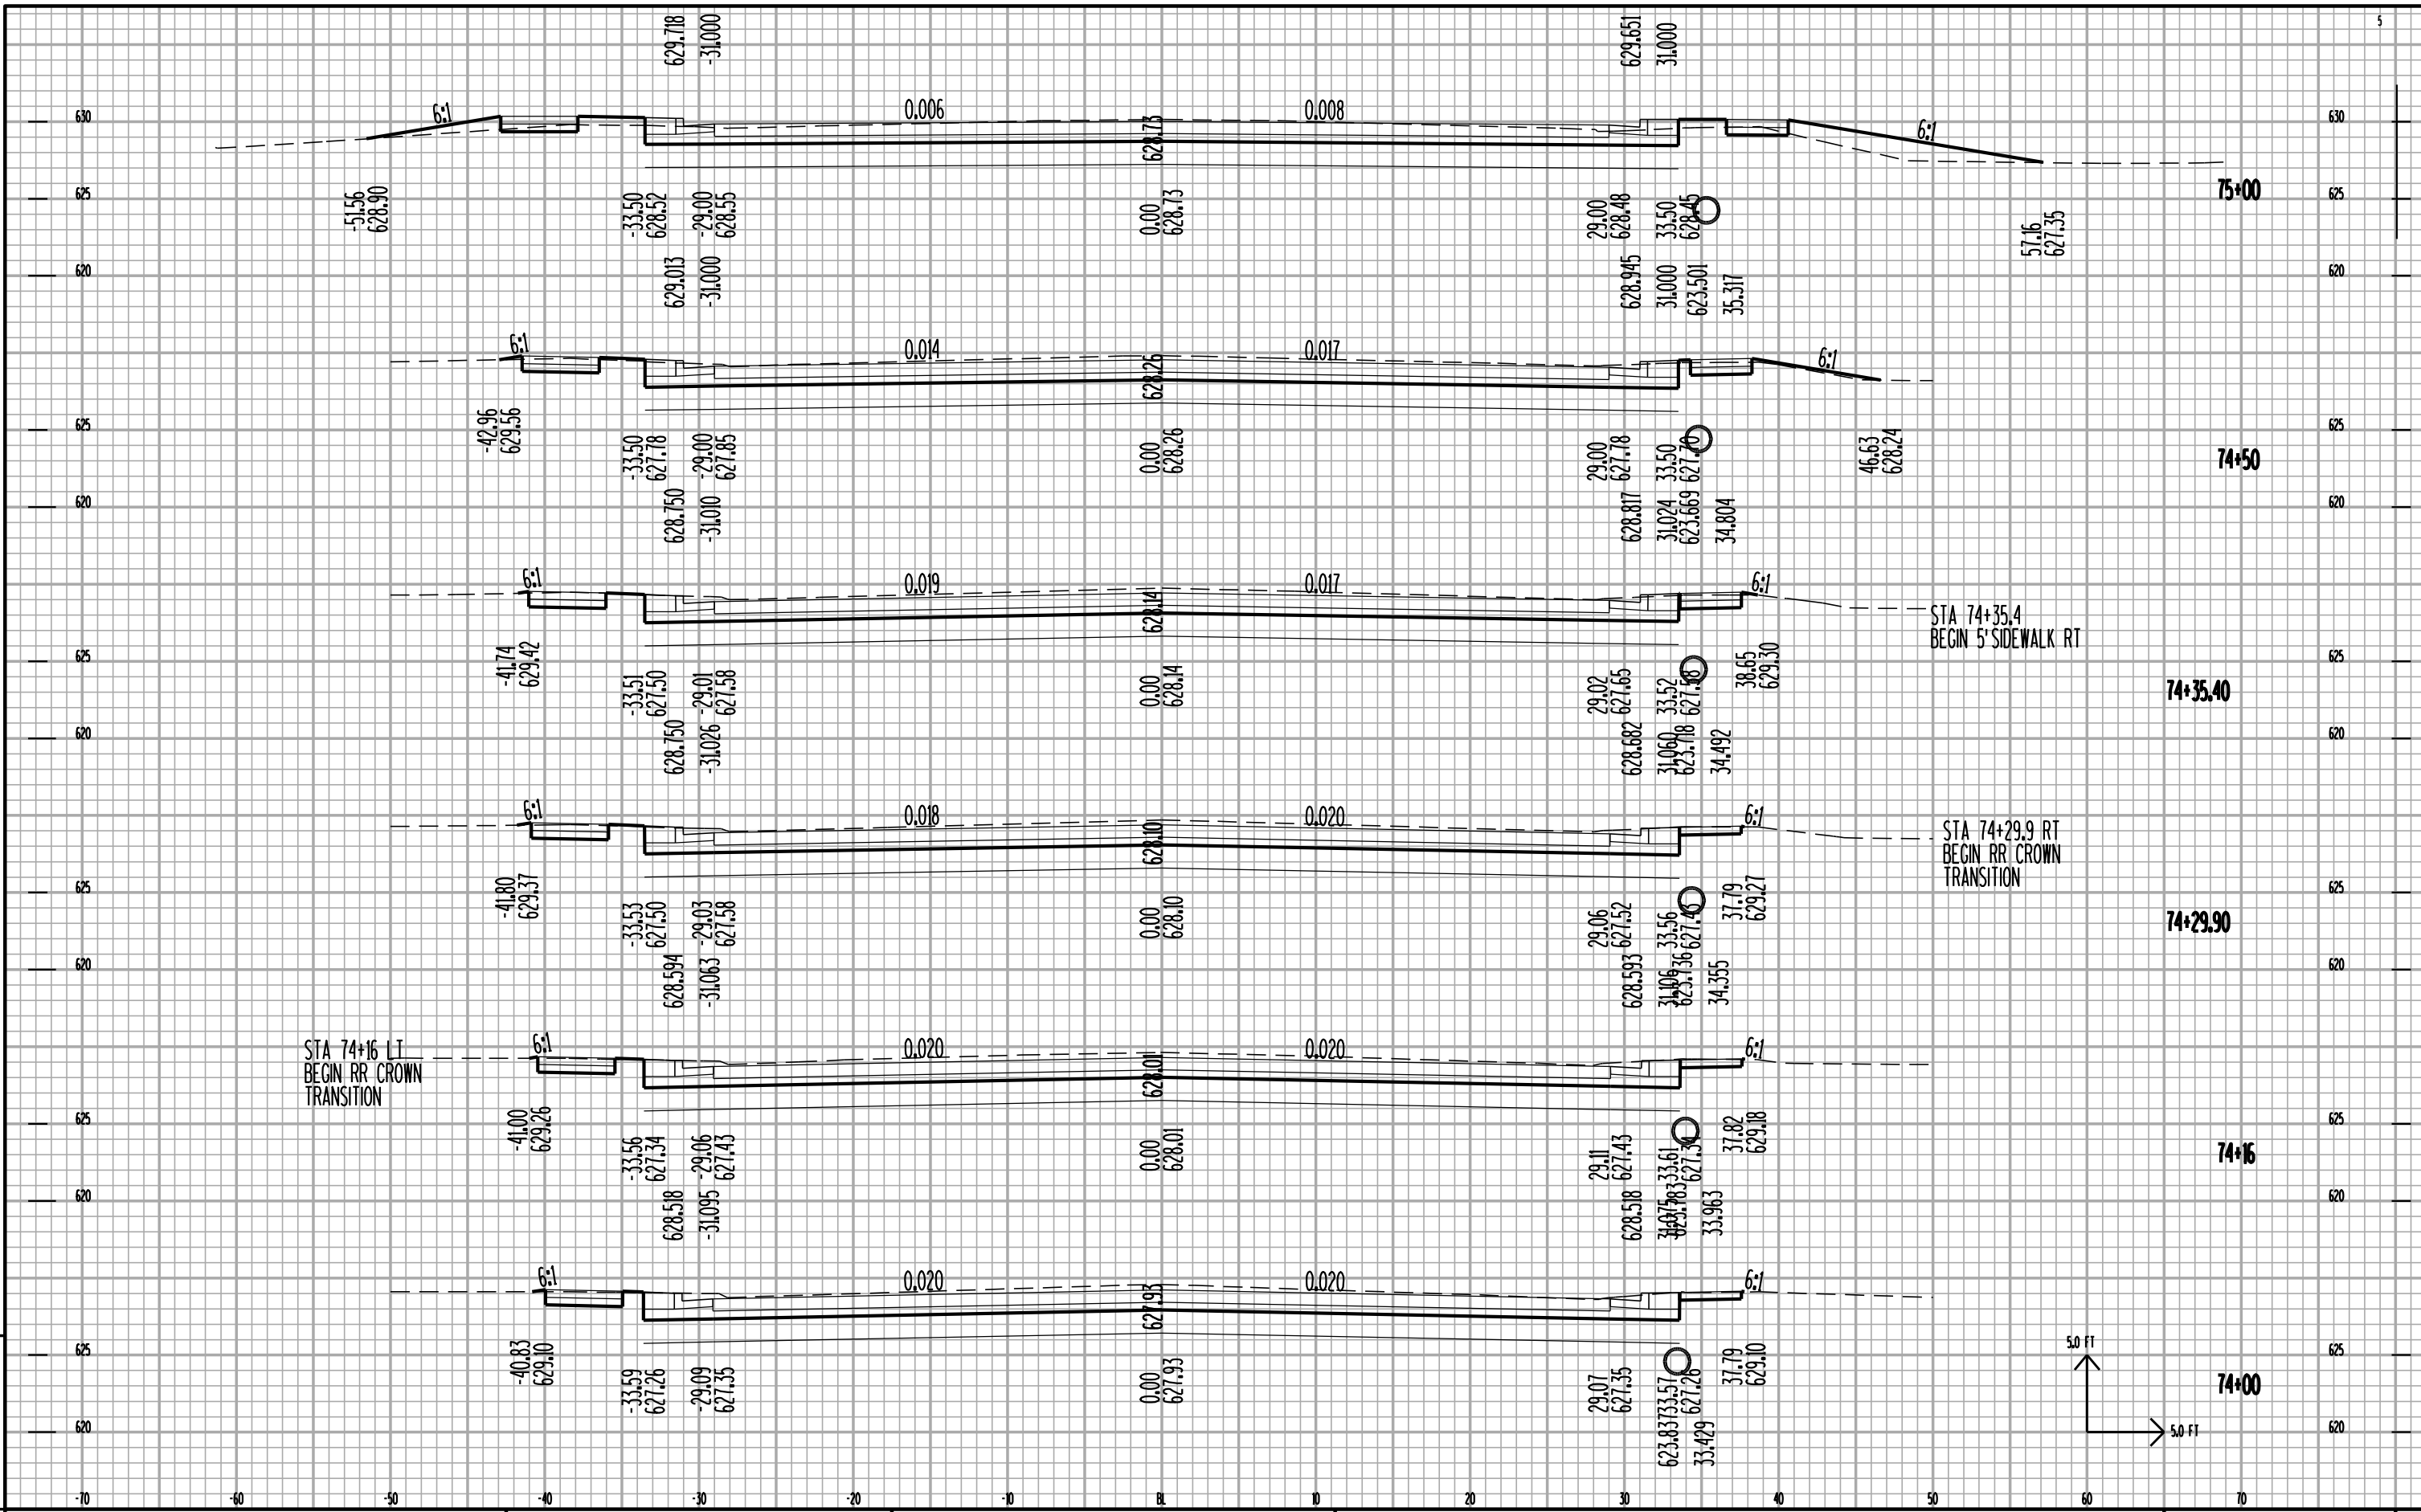


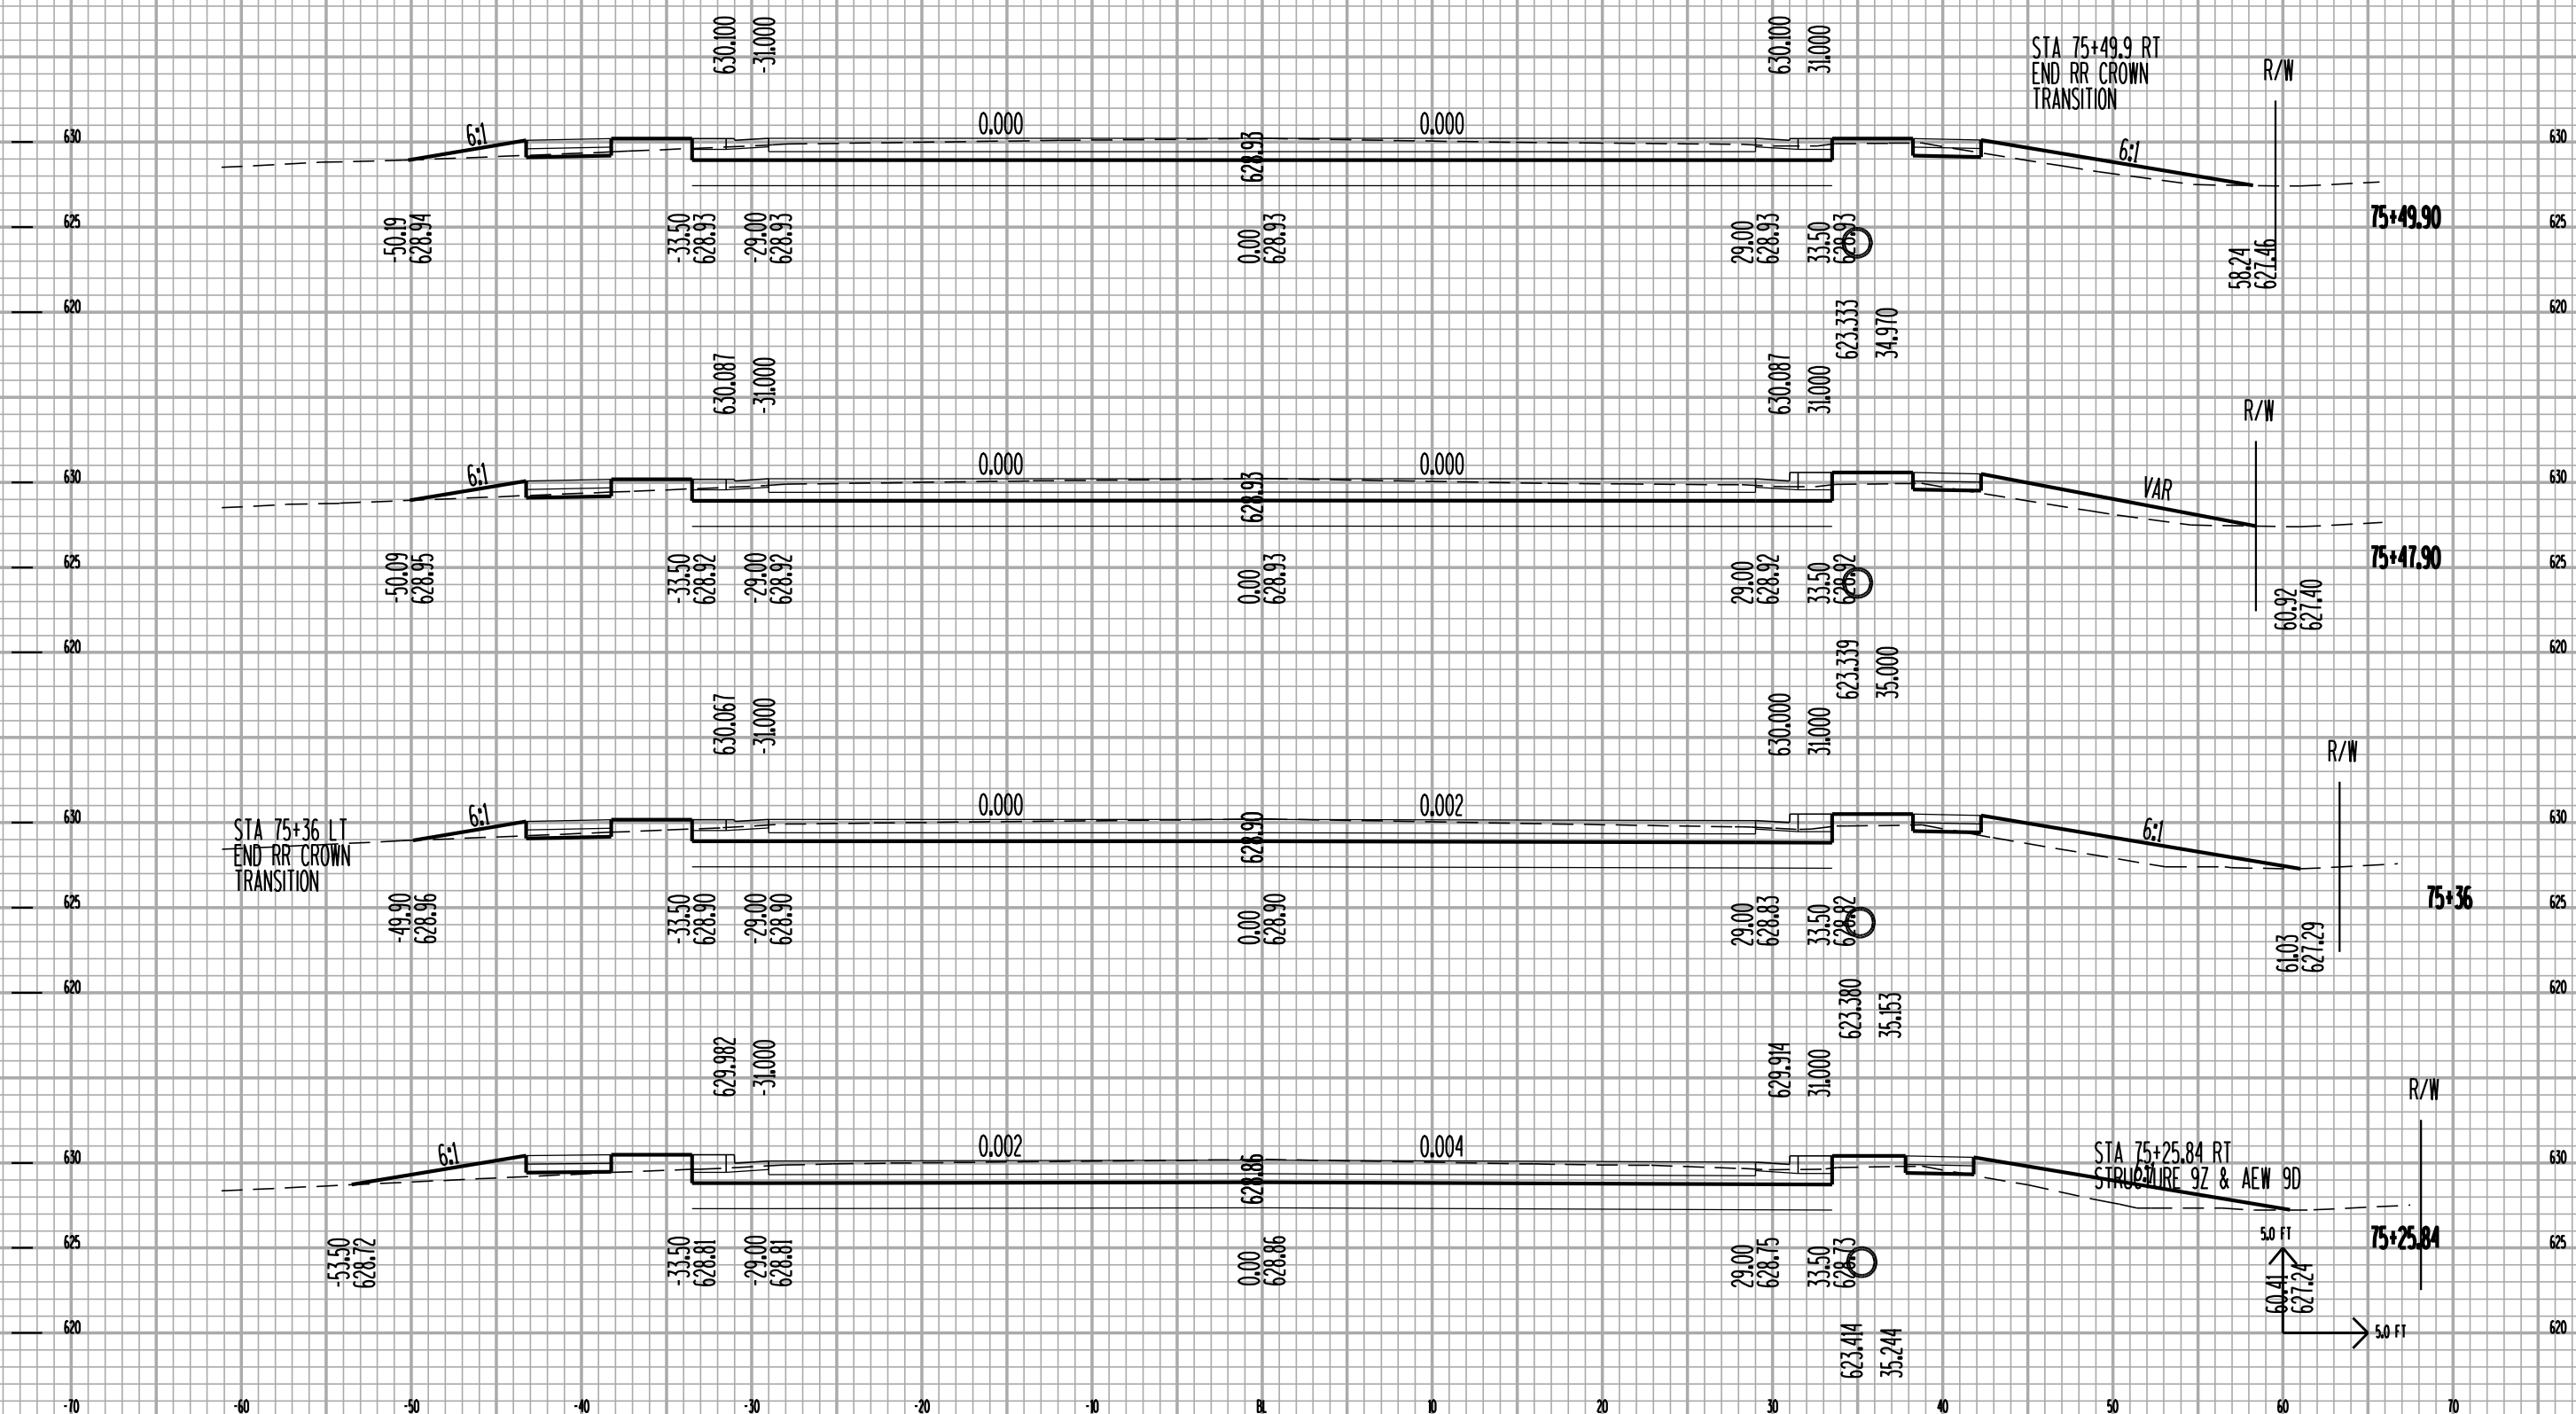


9

9





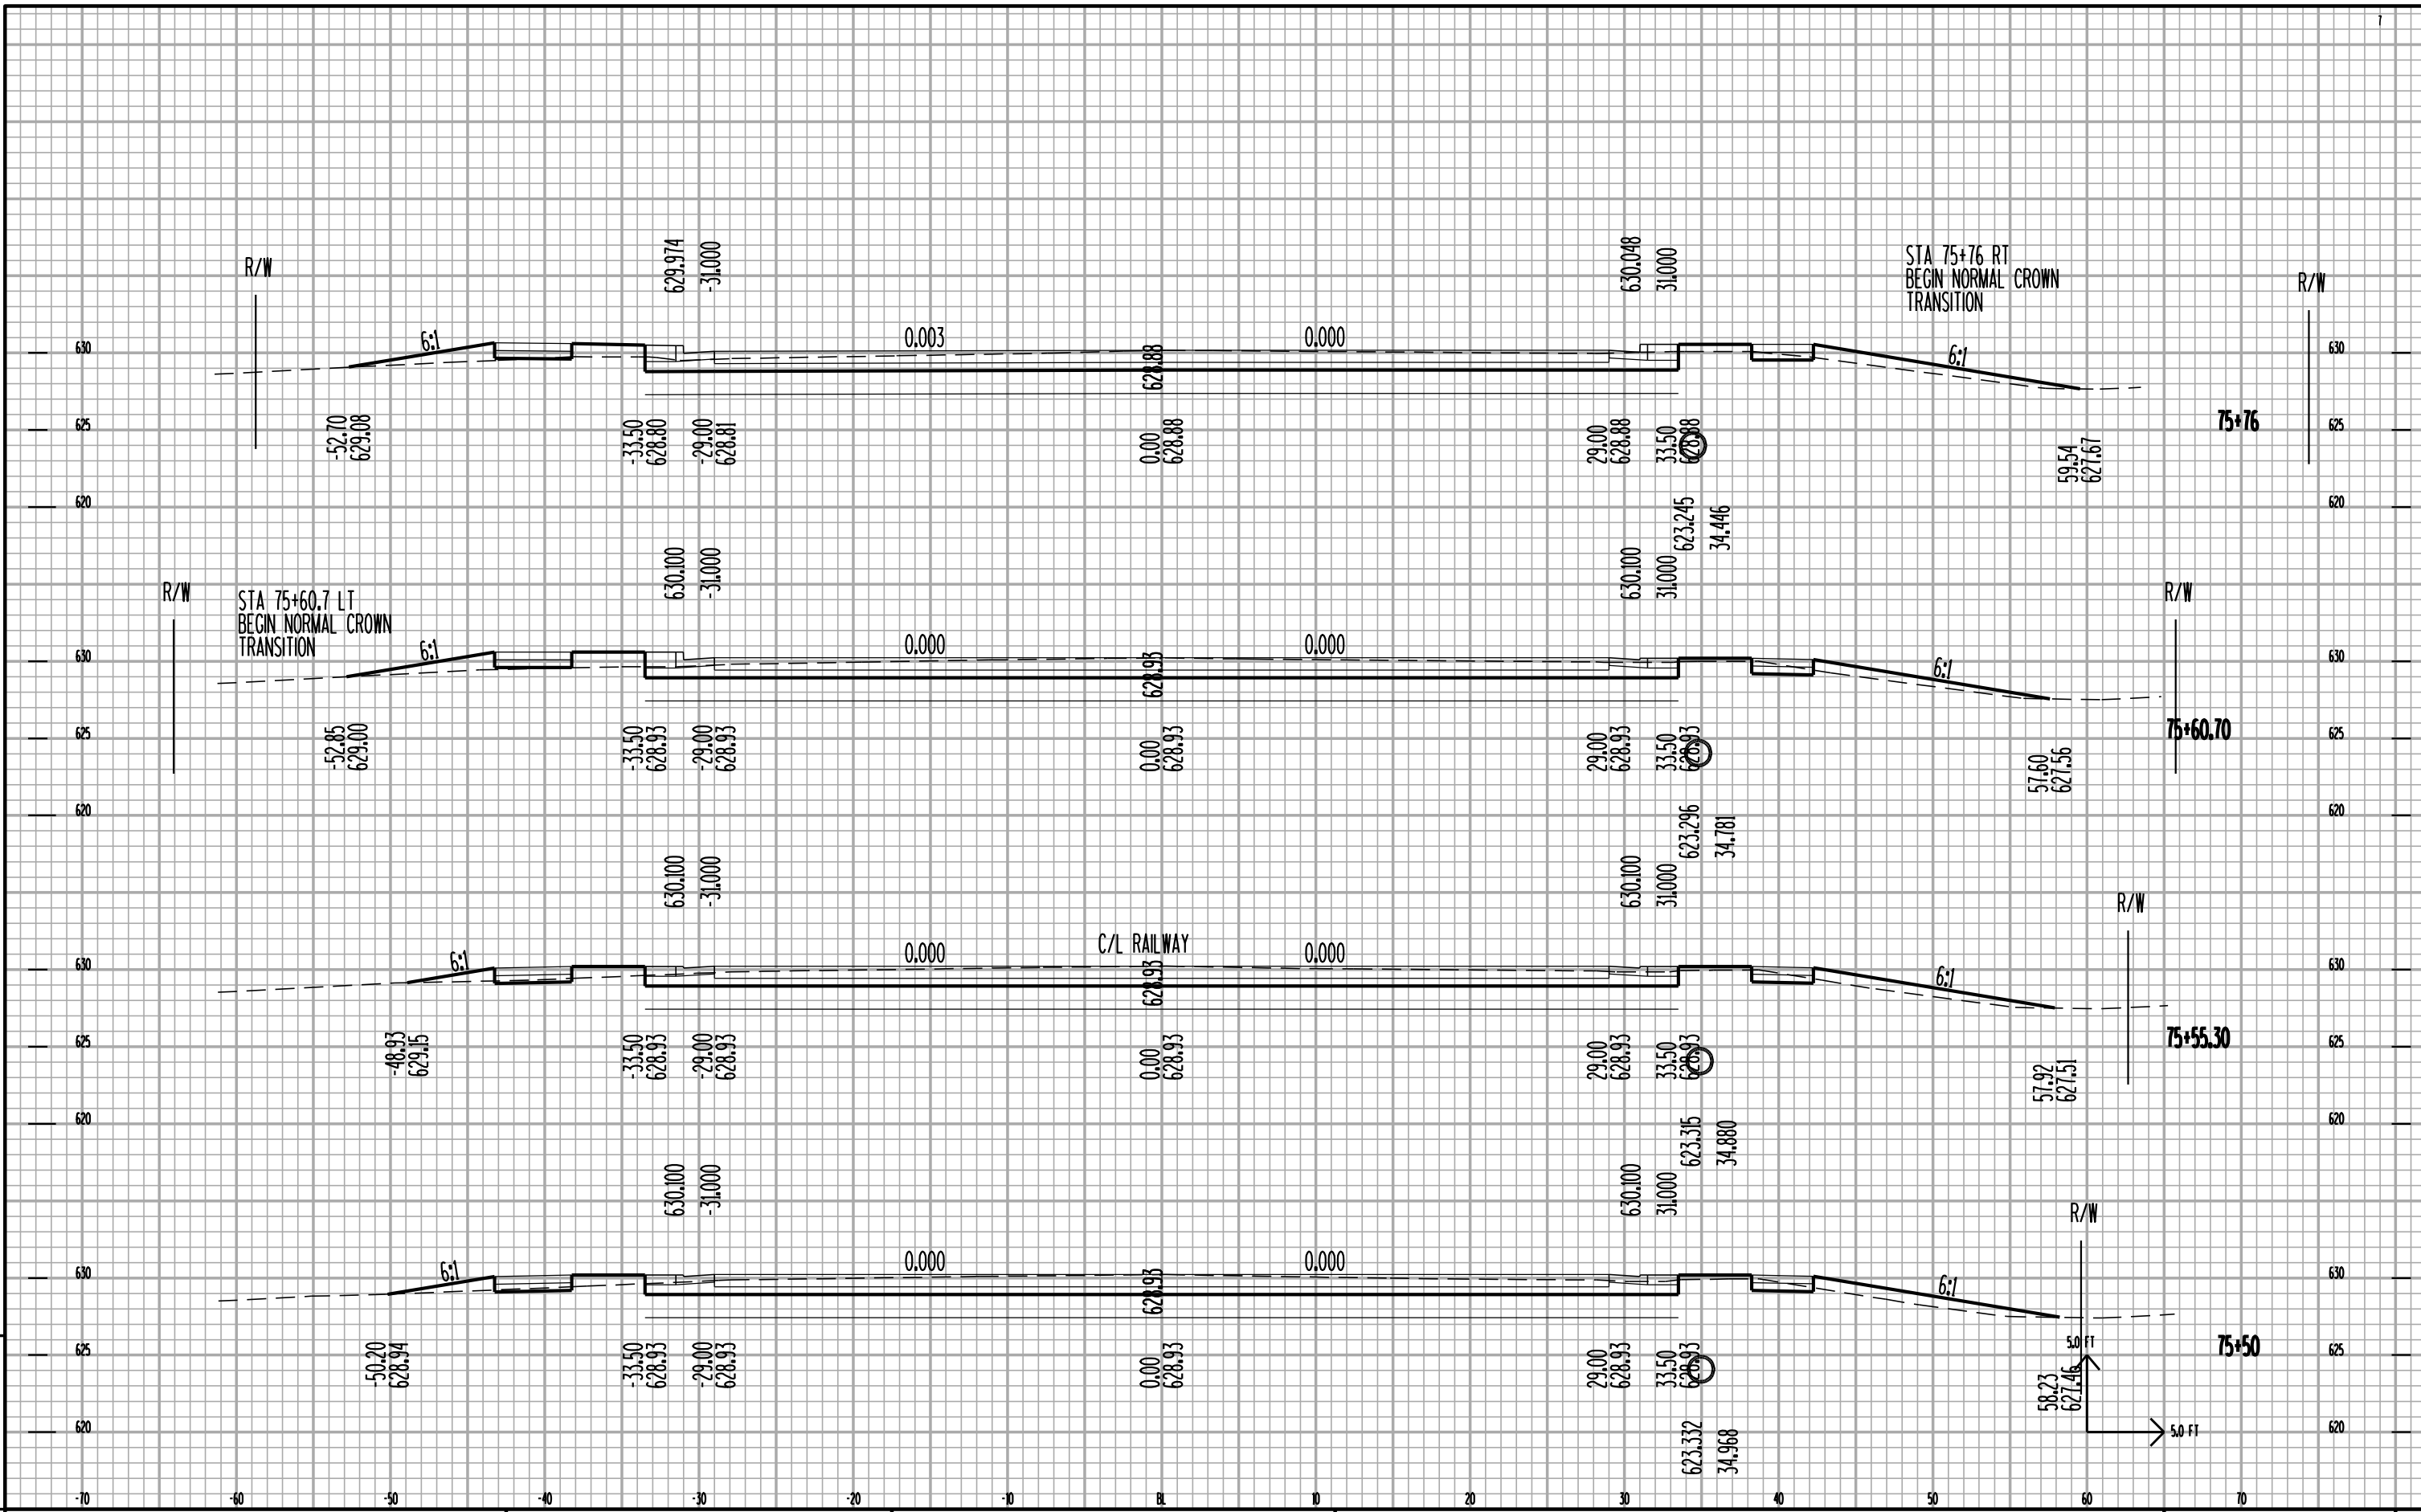


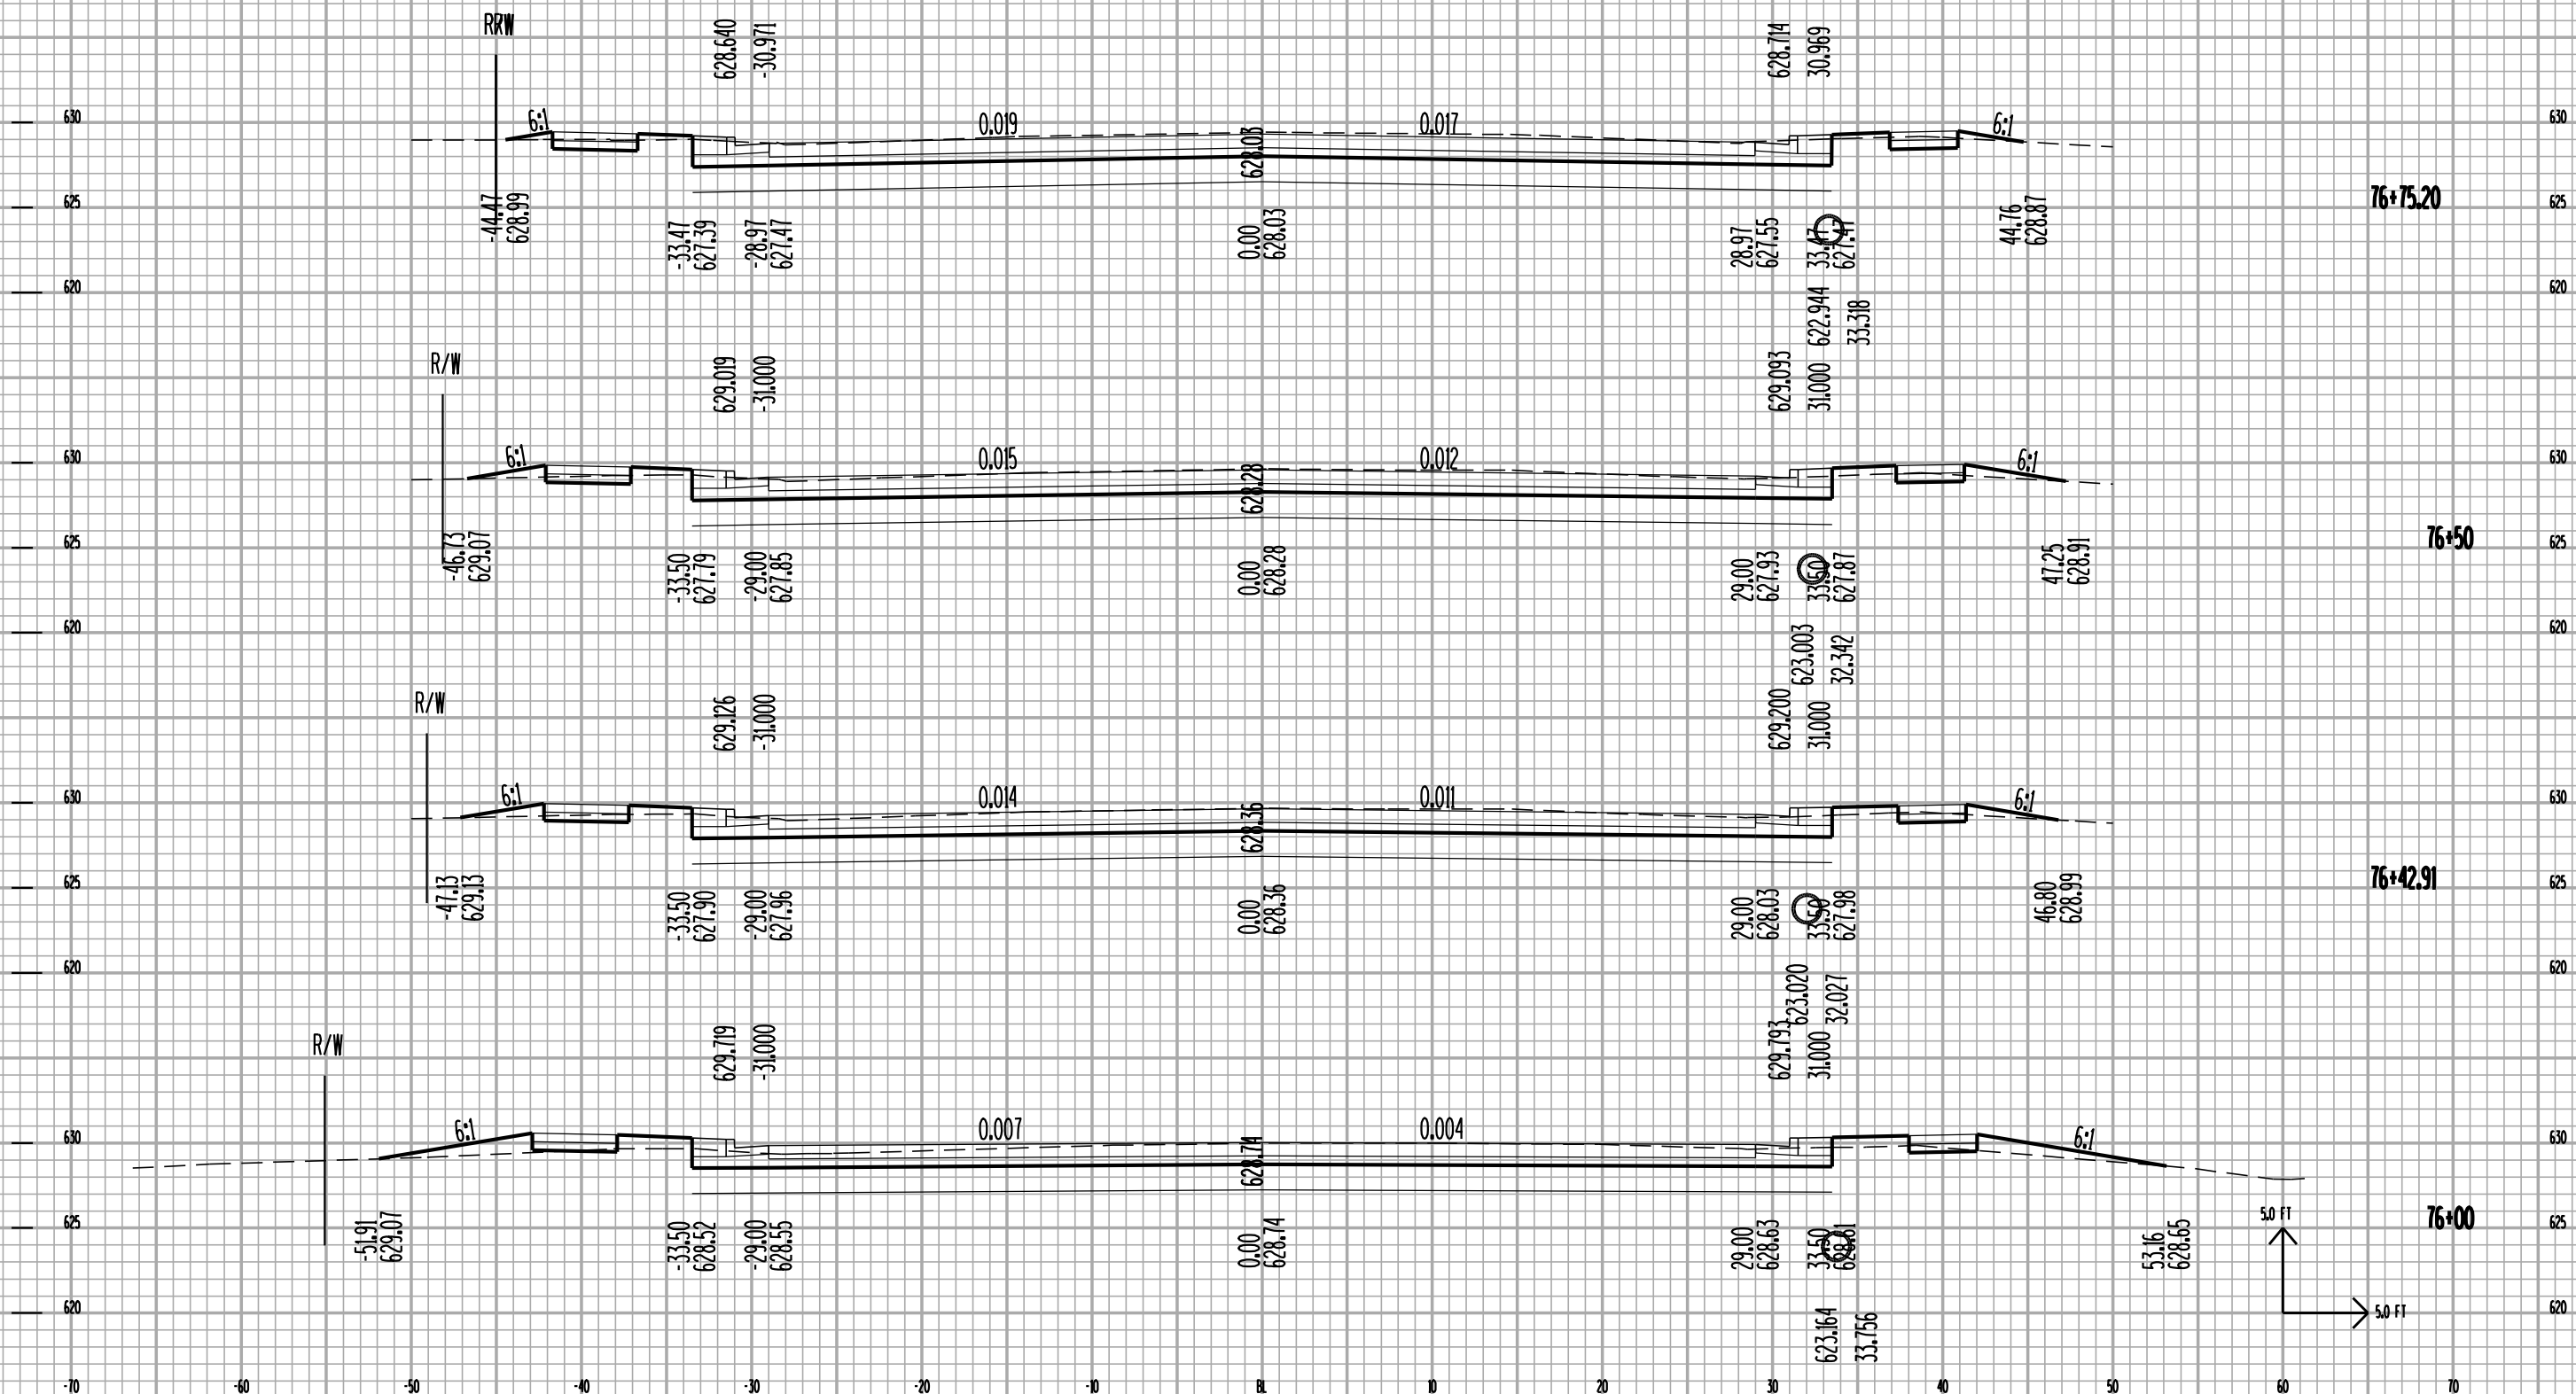



9


9

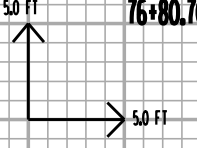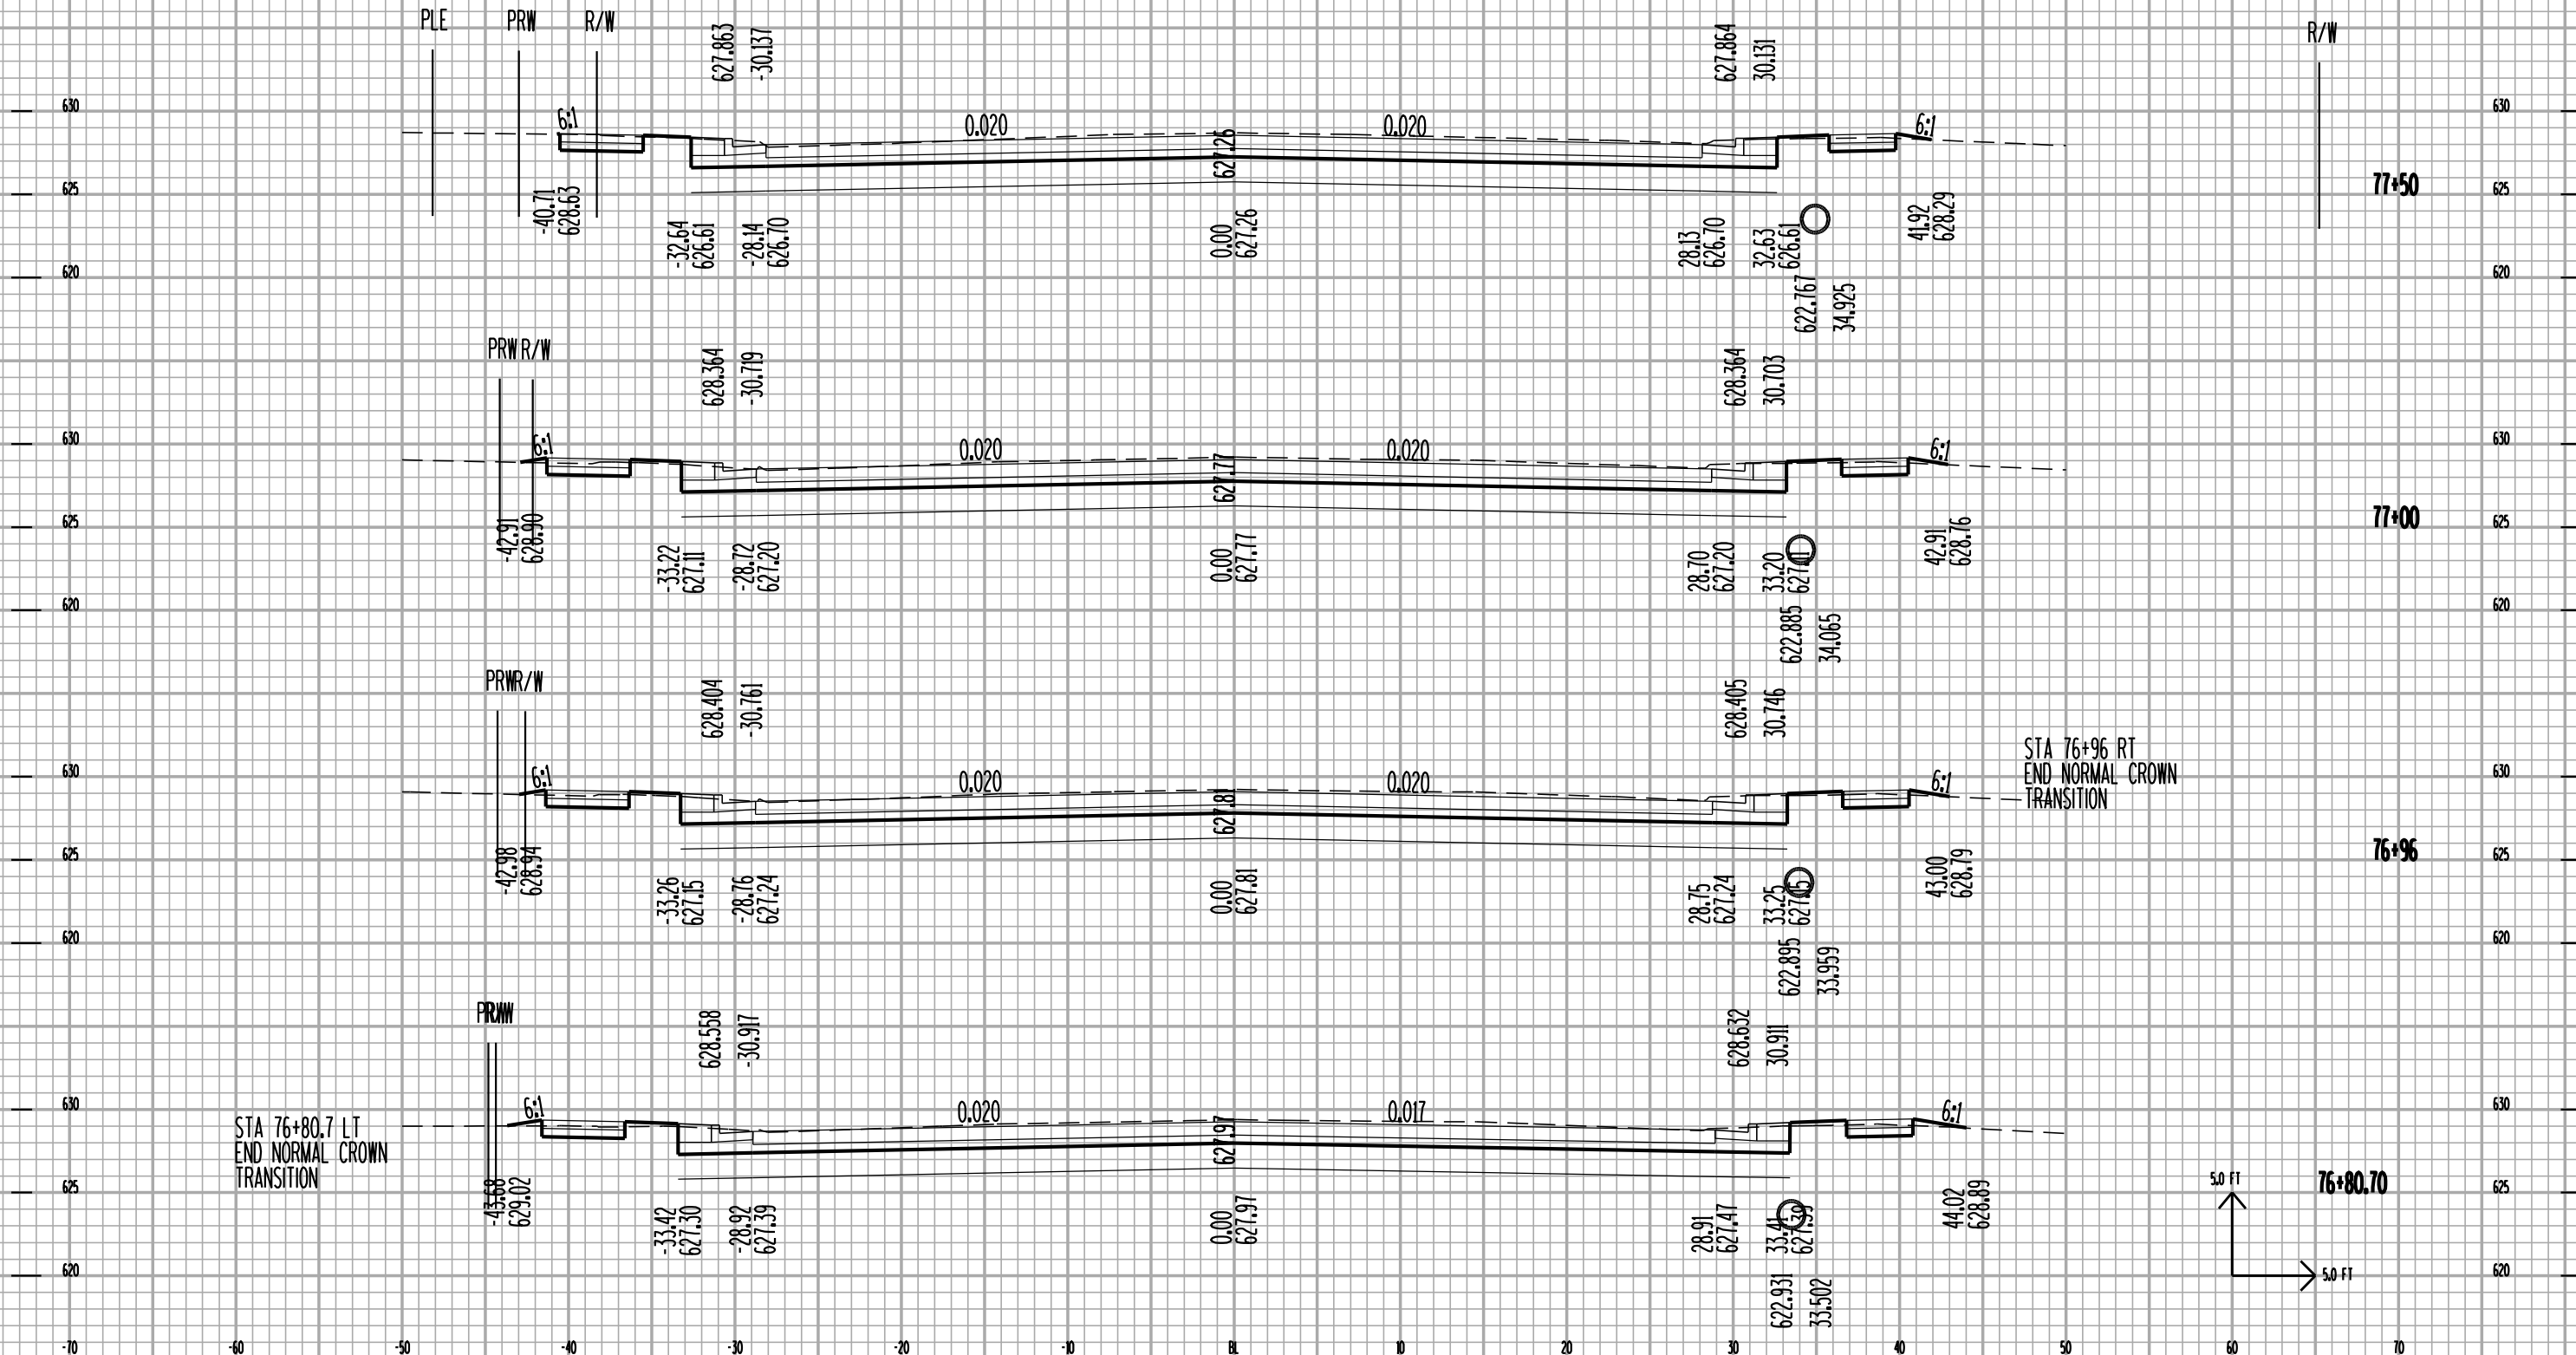


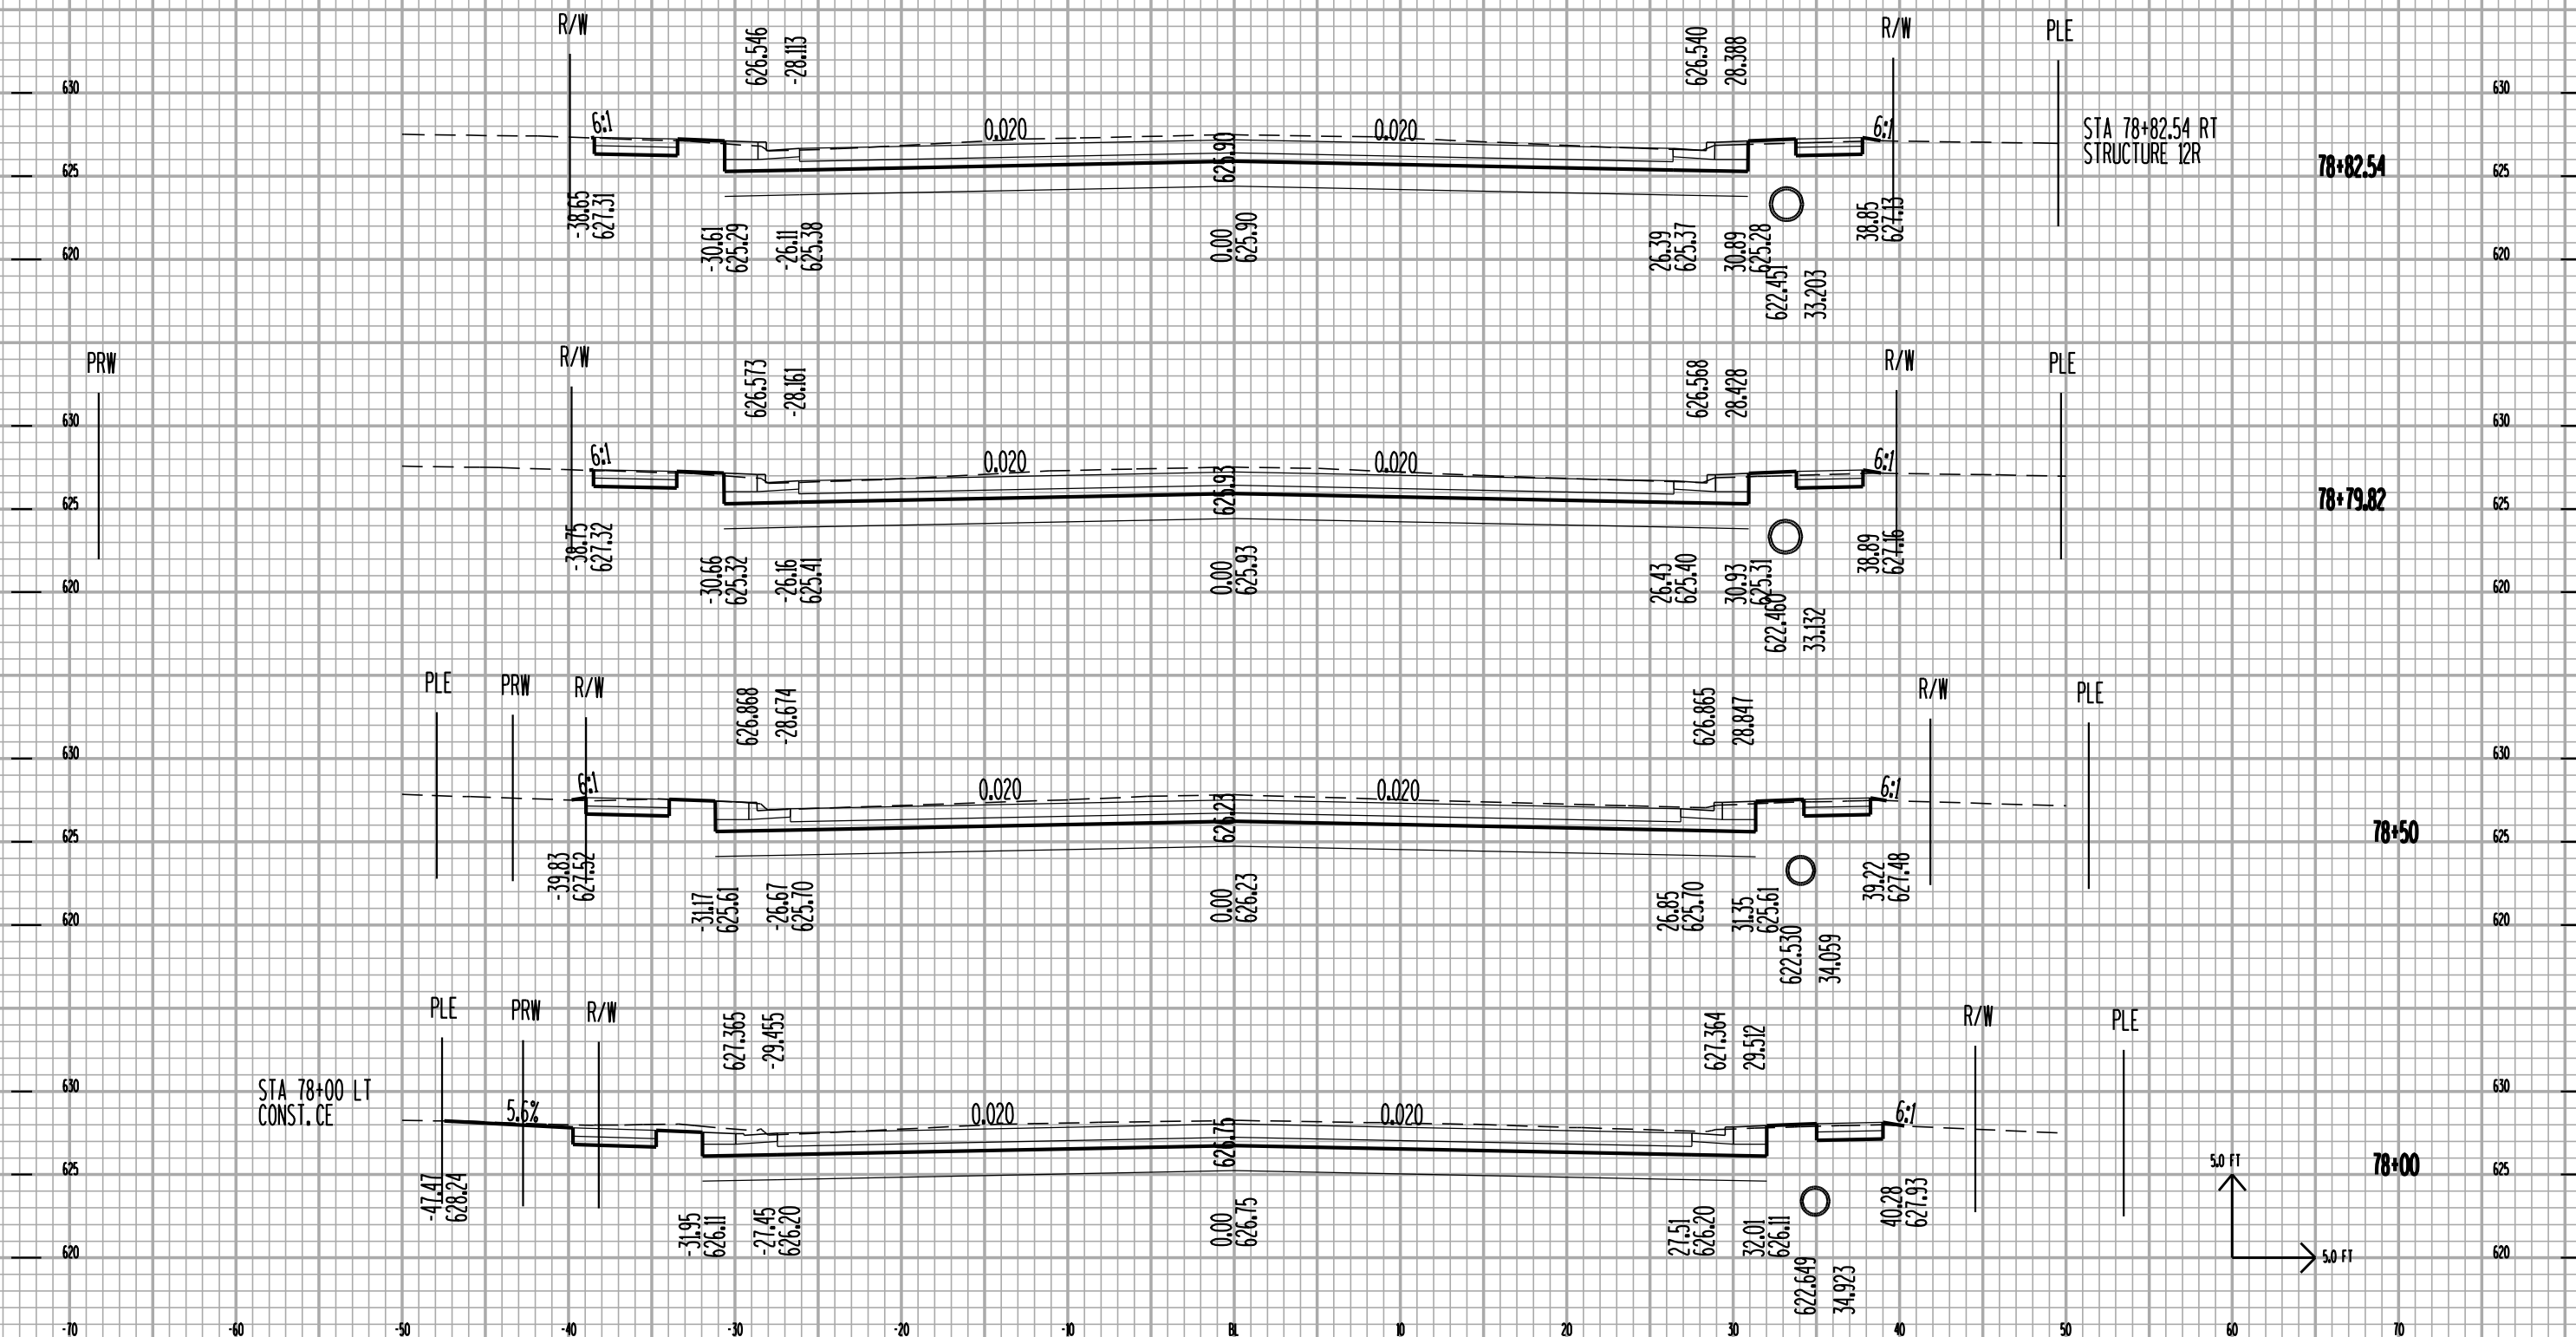

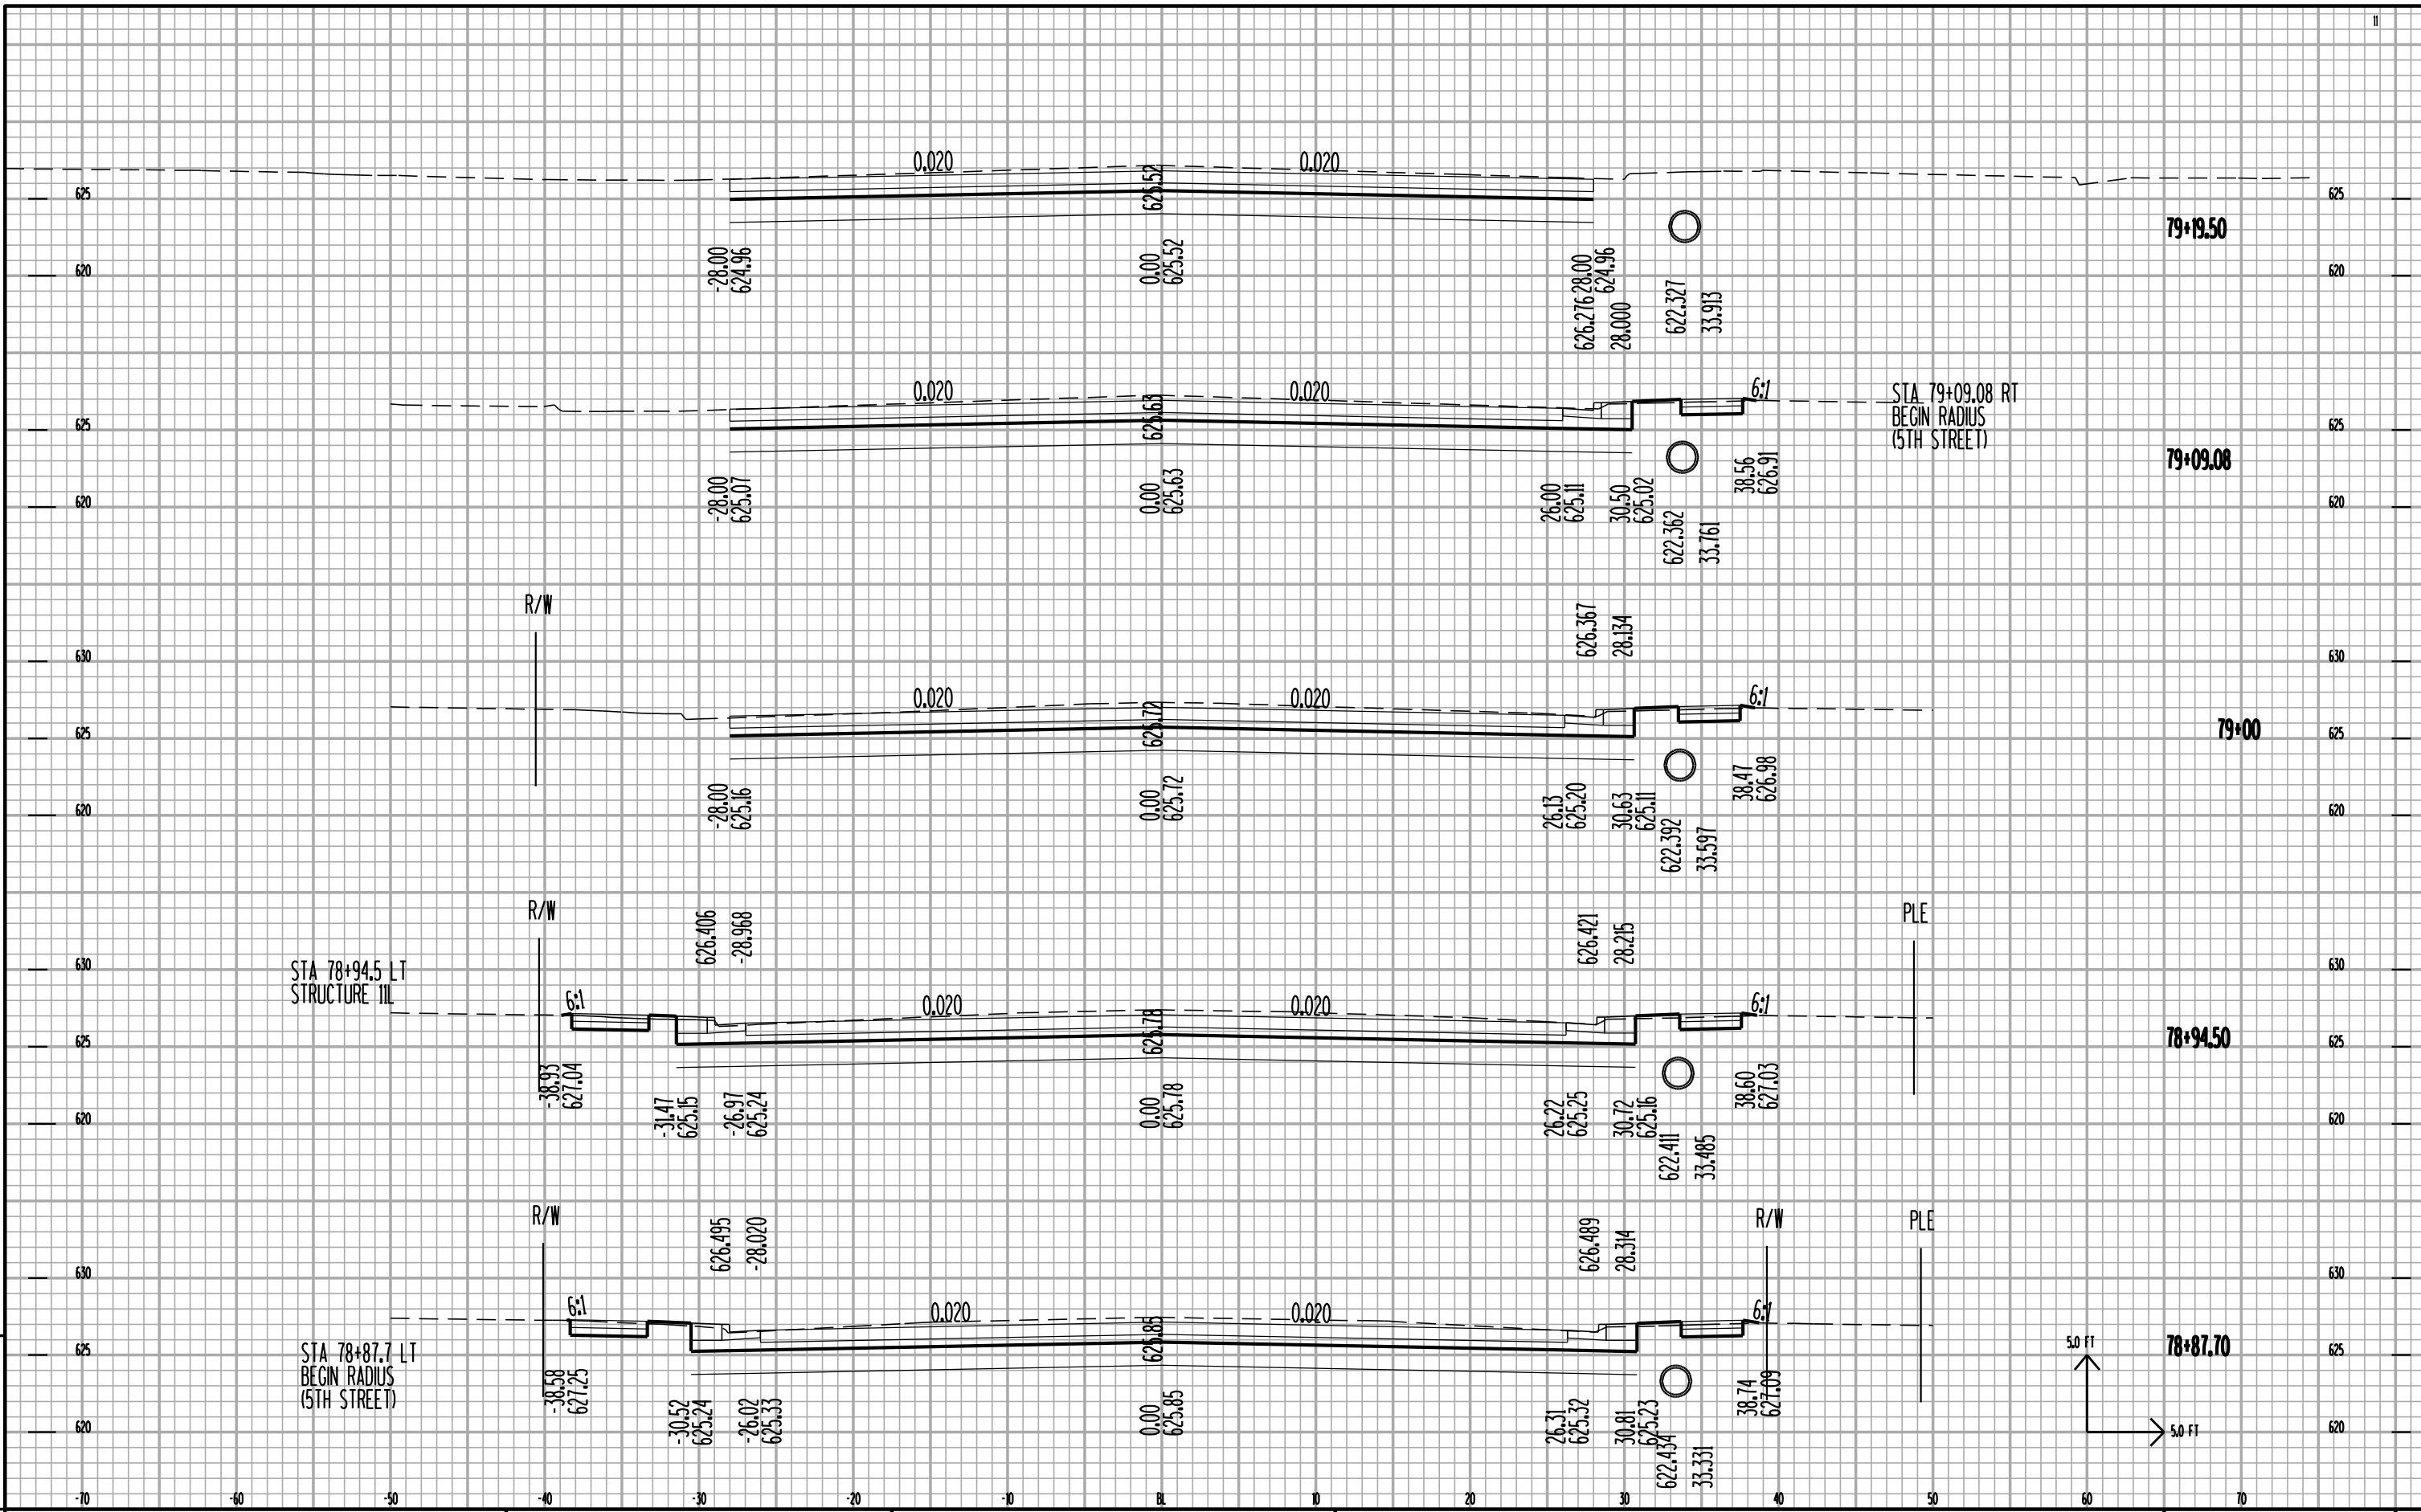


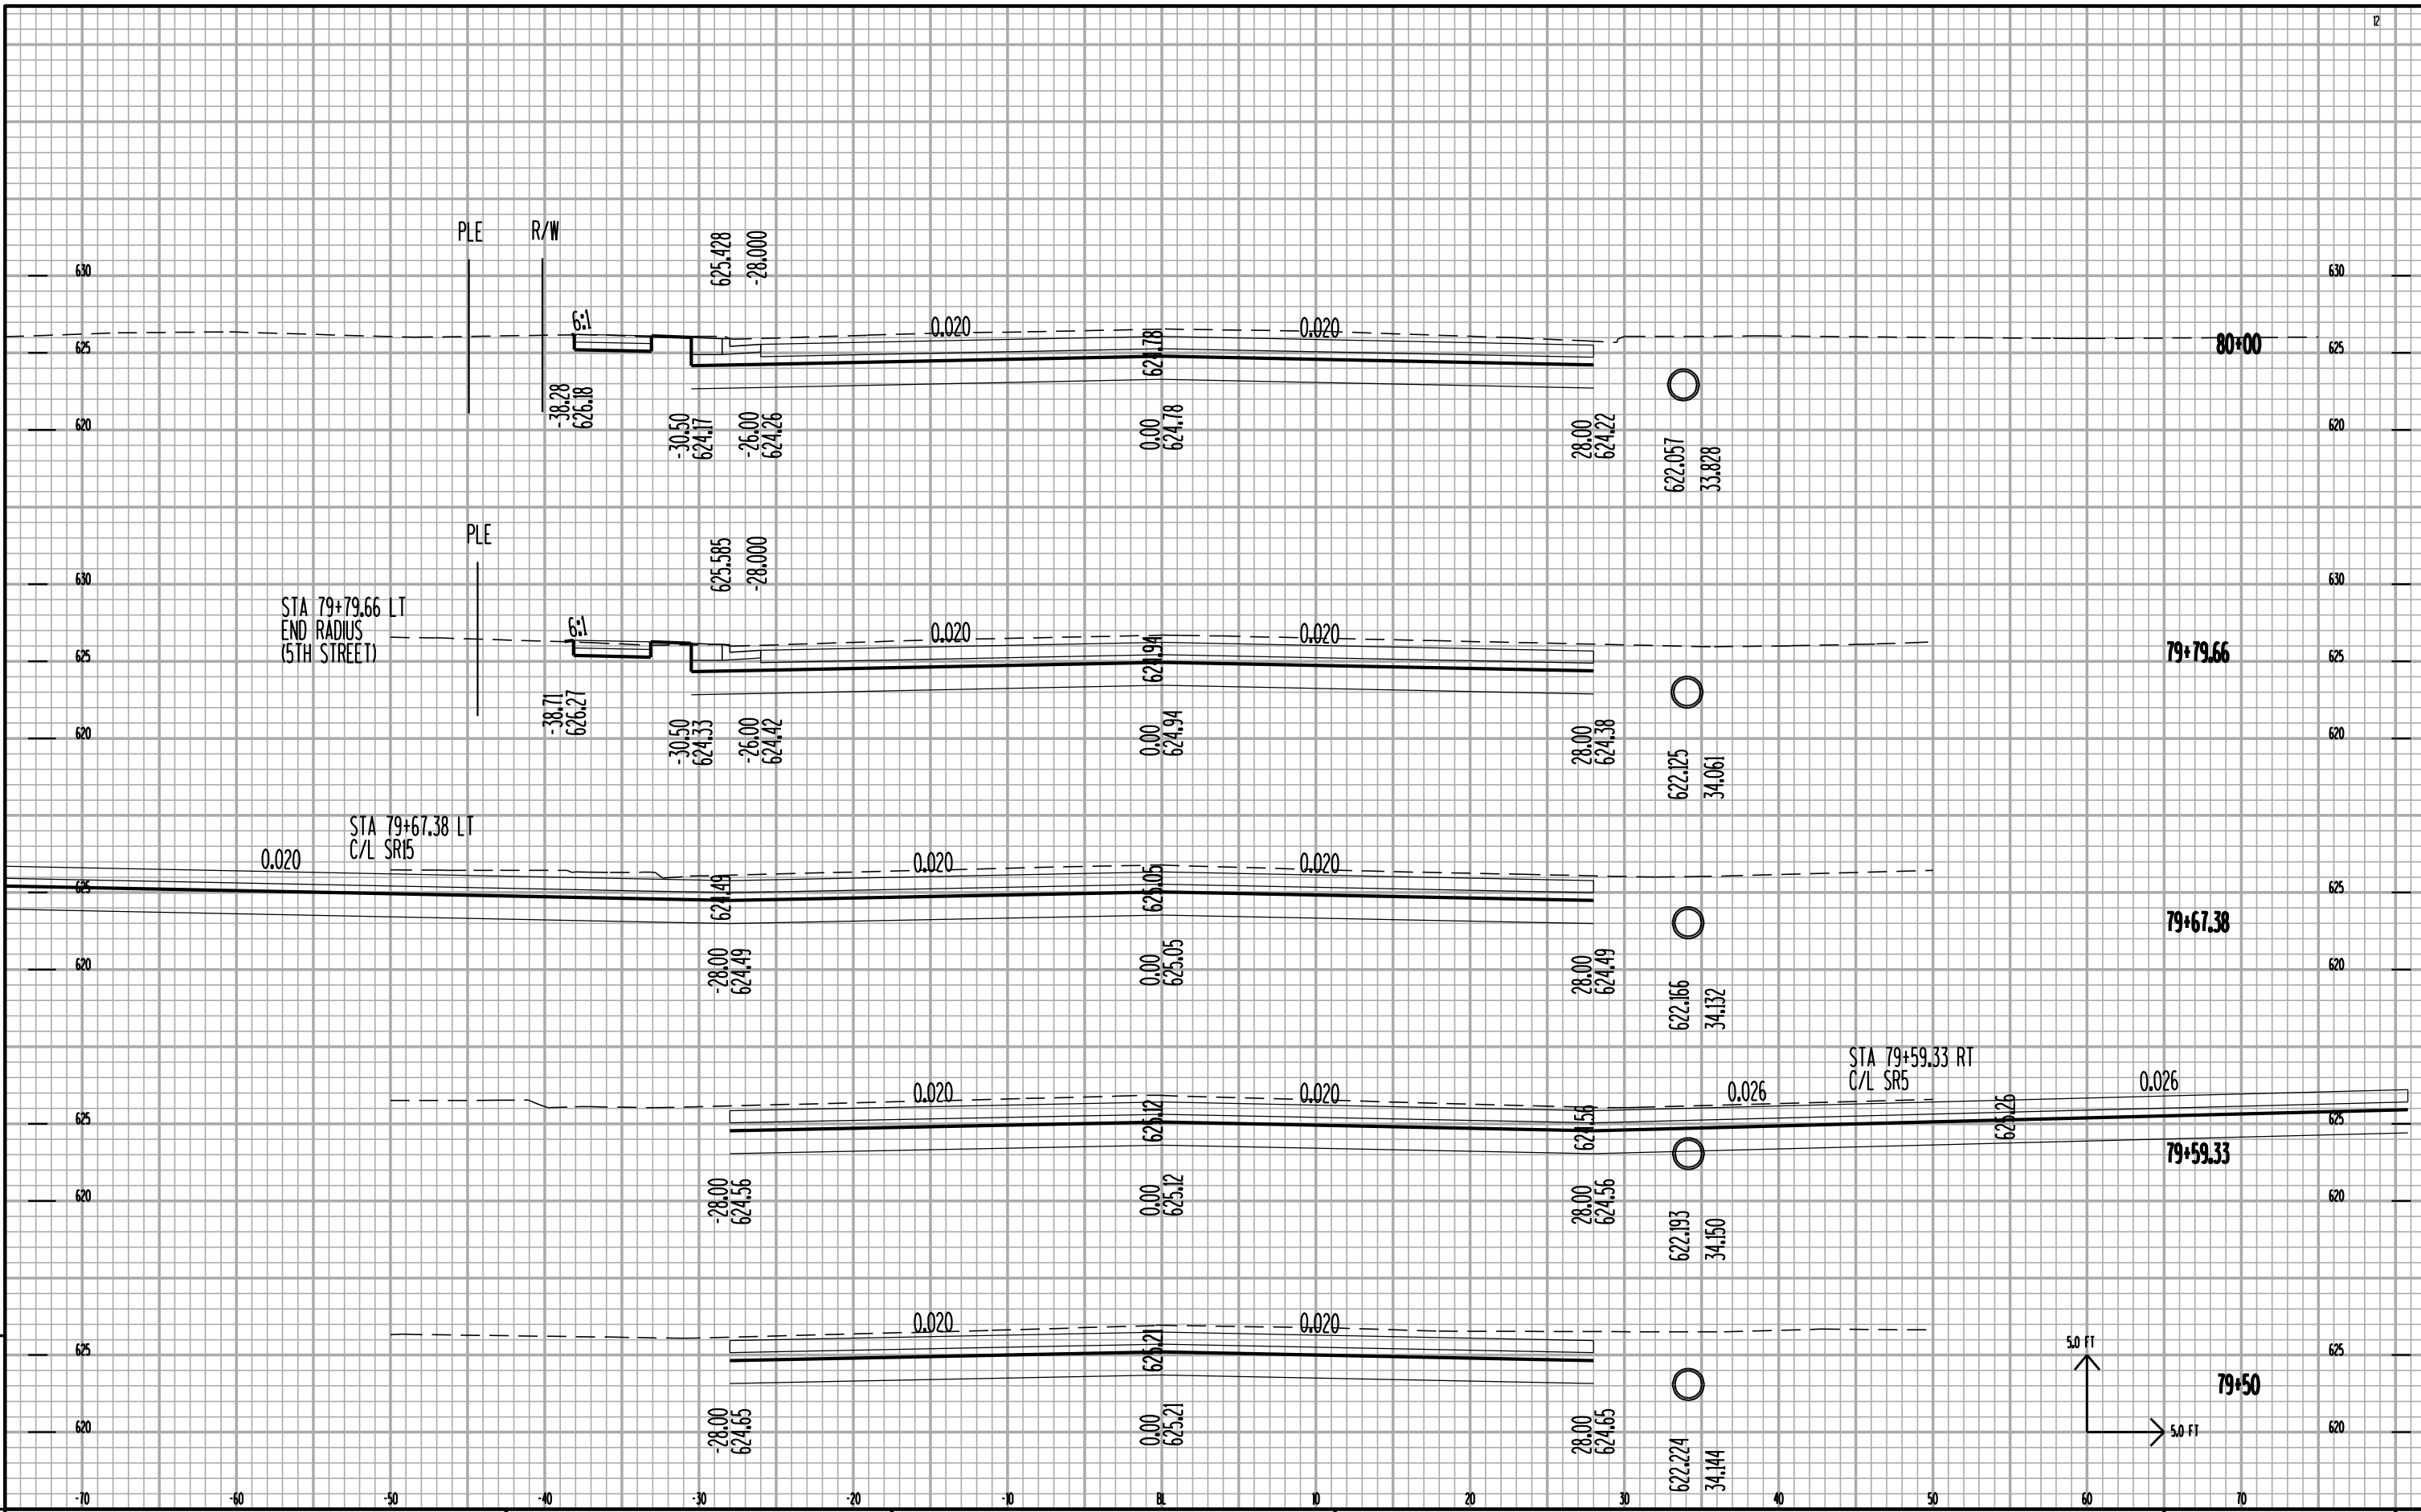

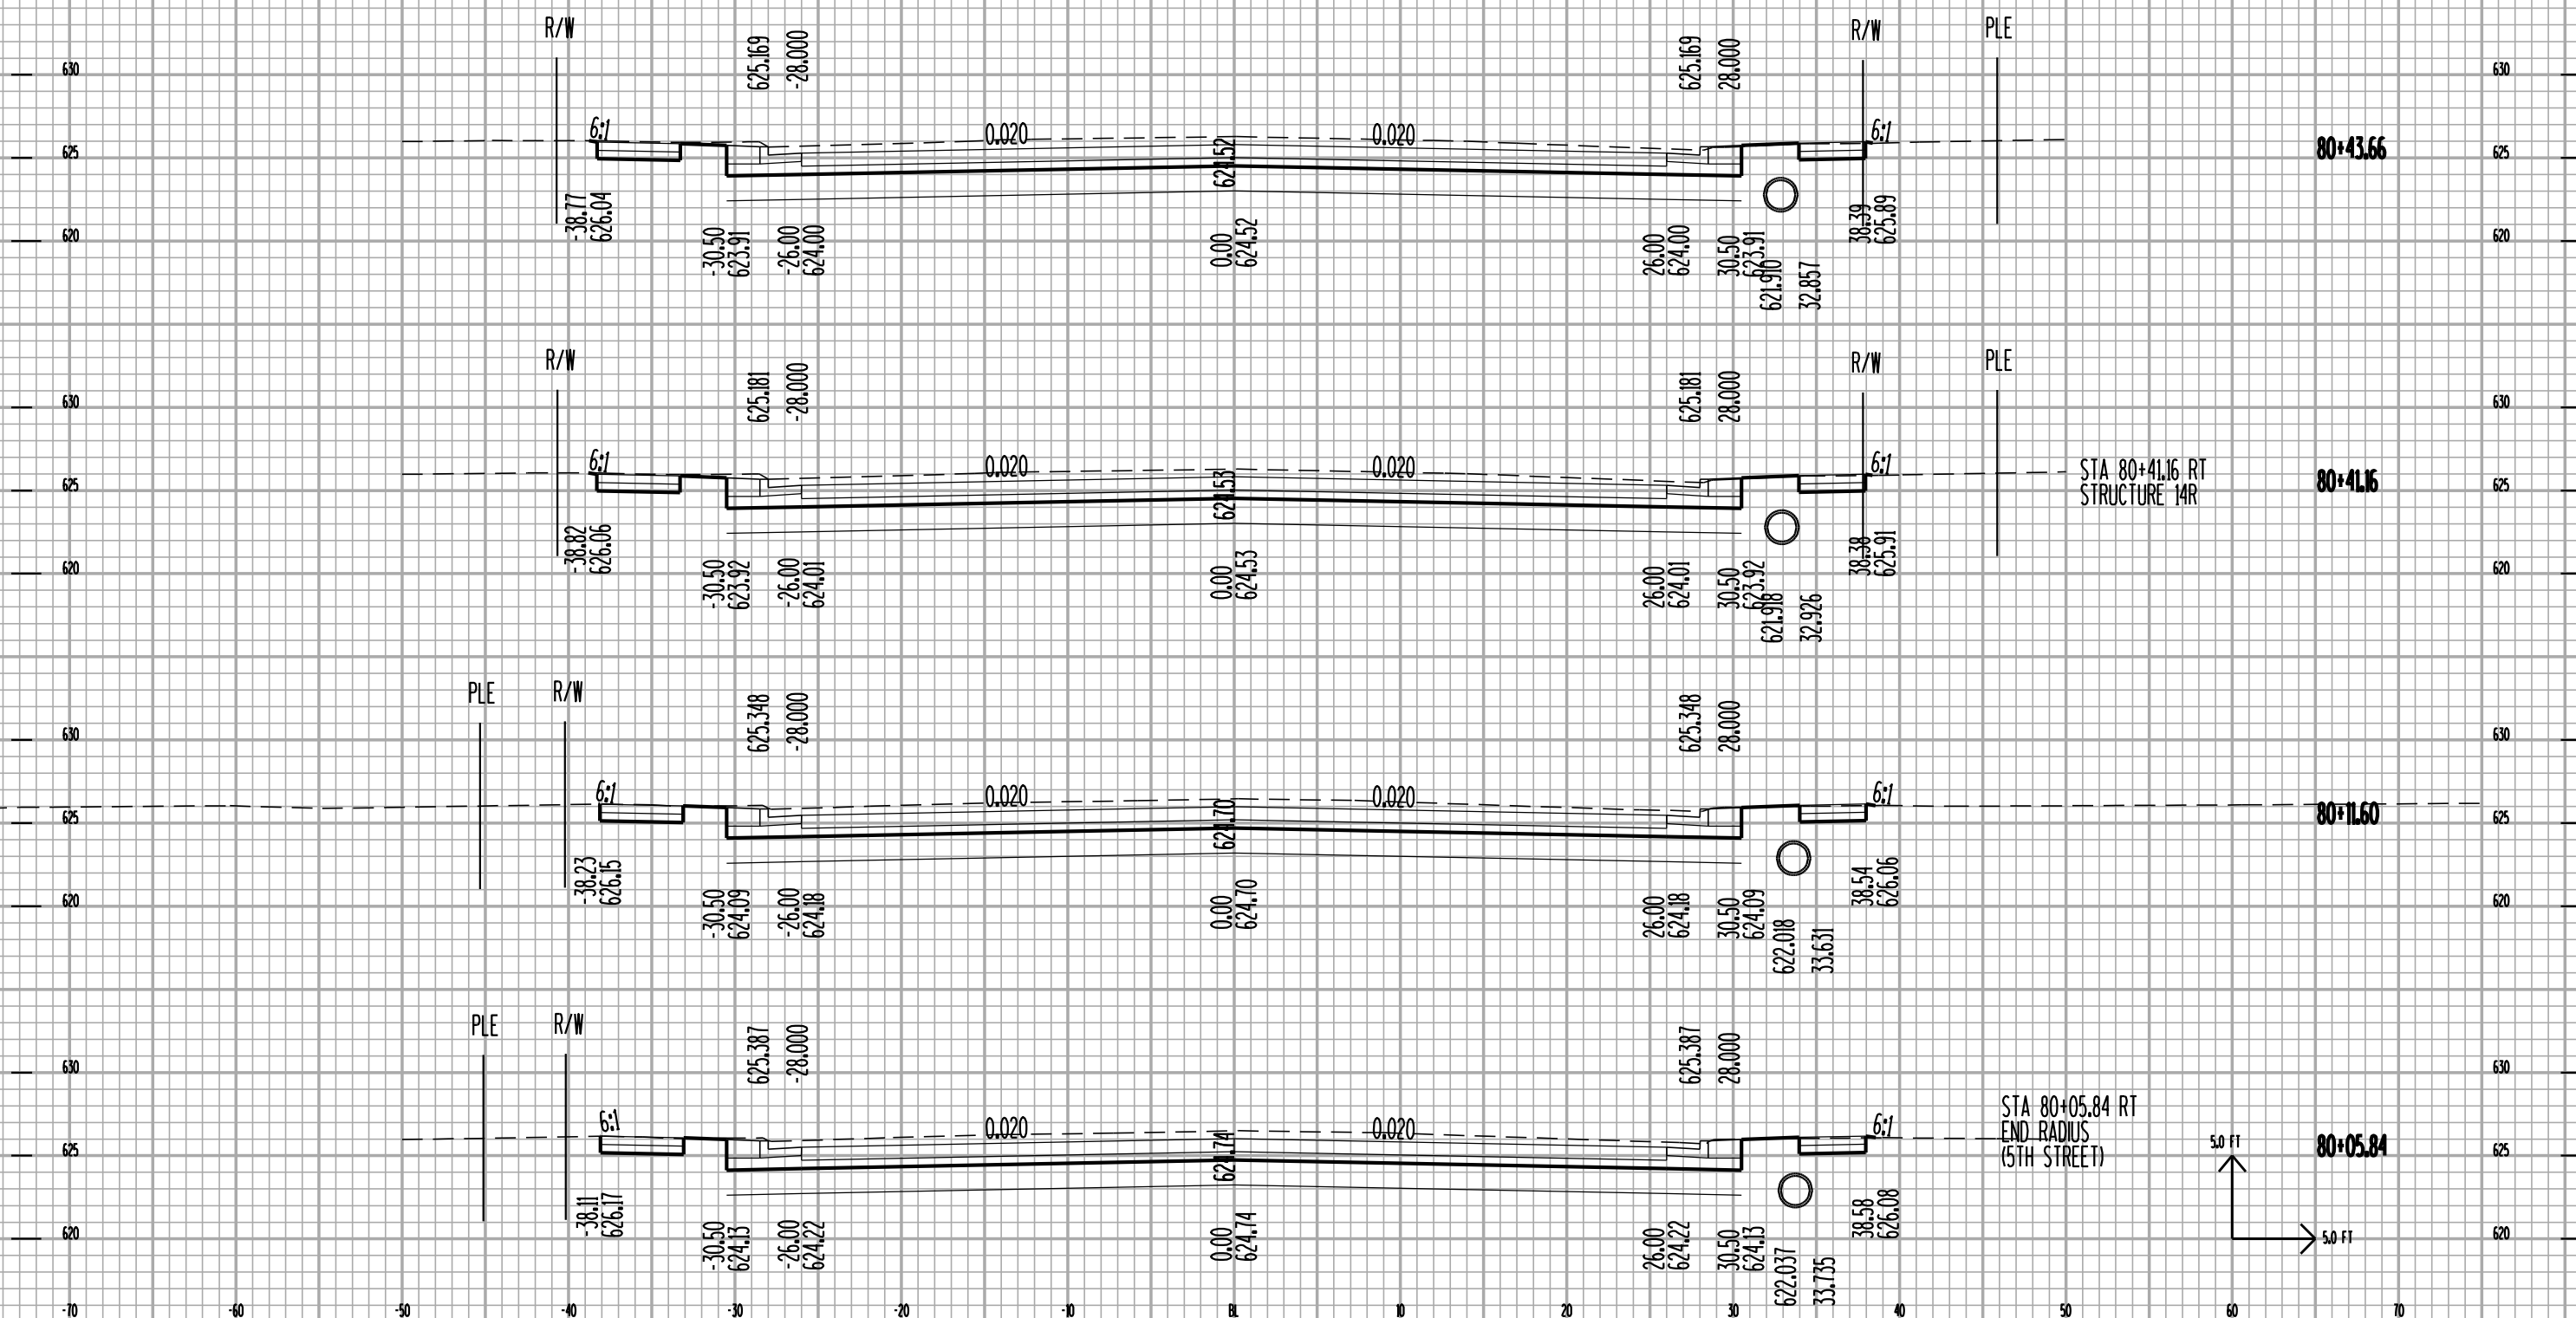

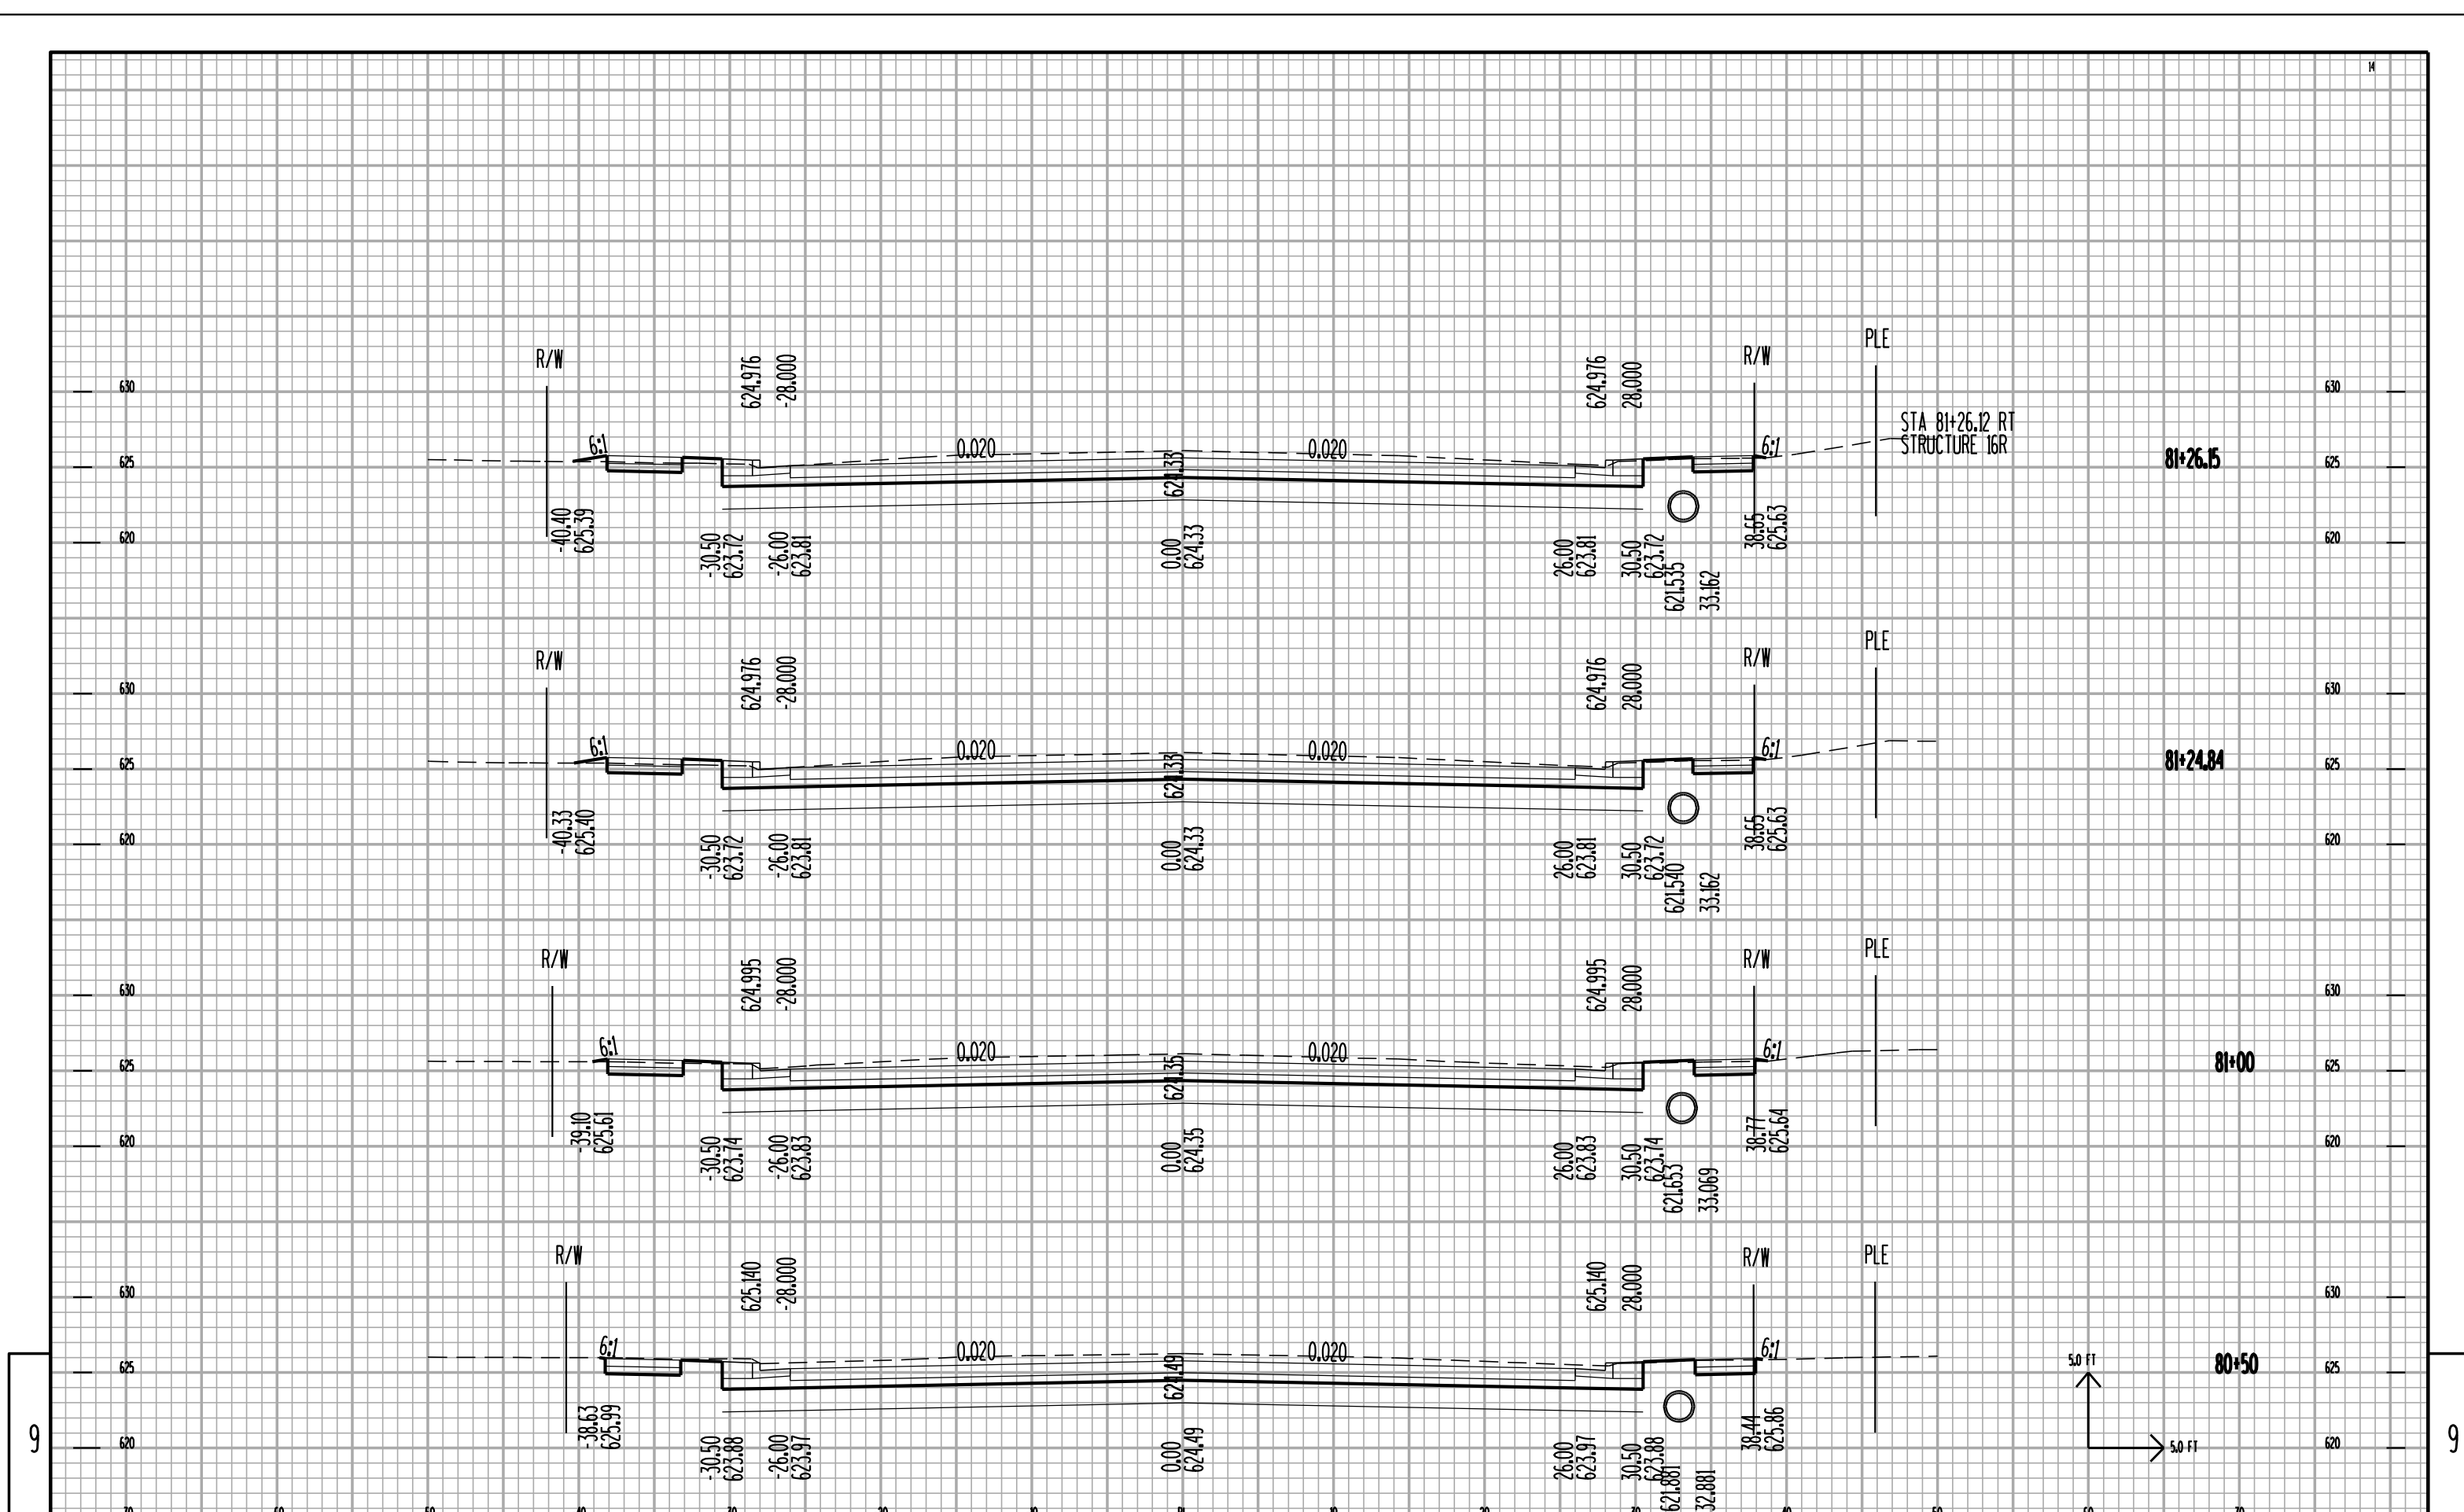



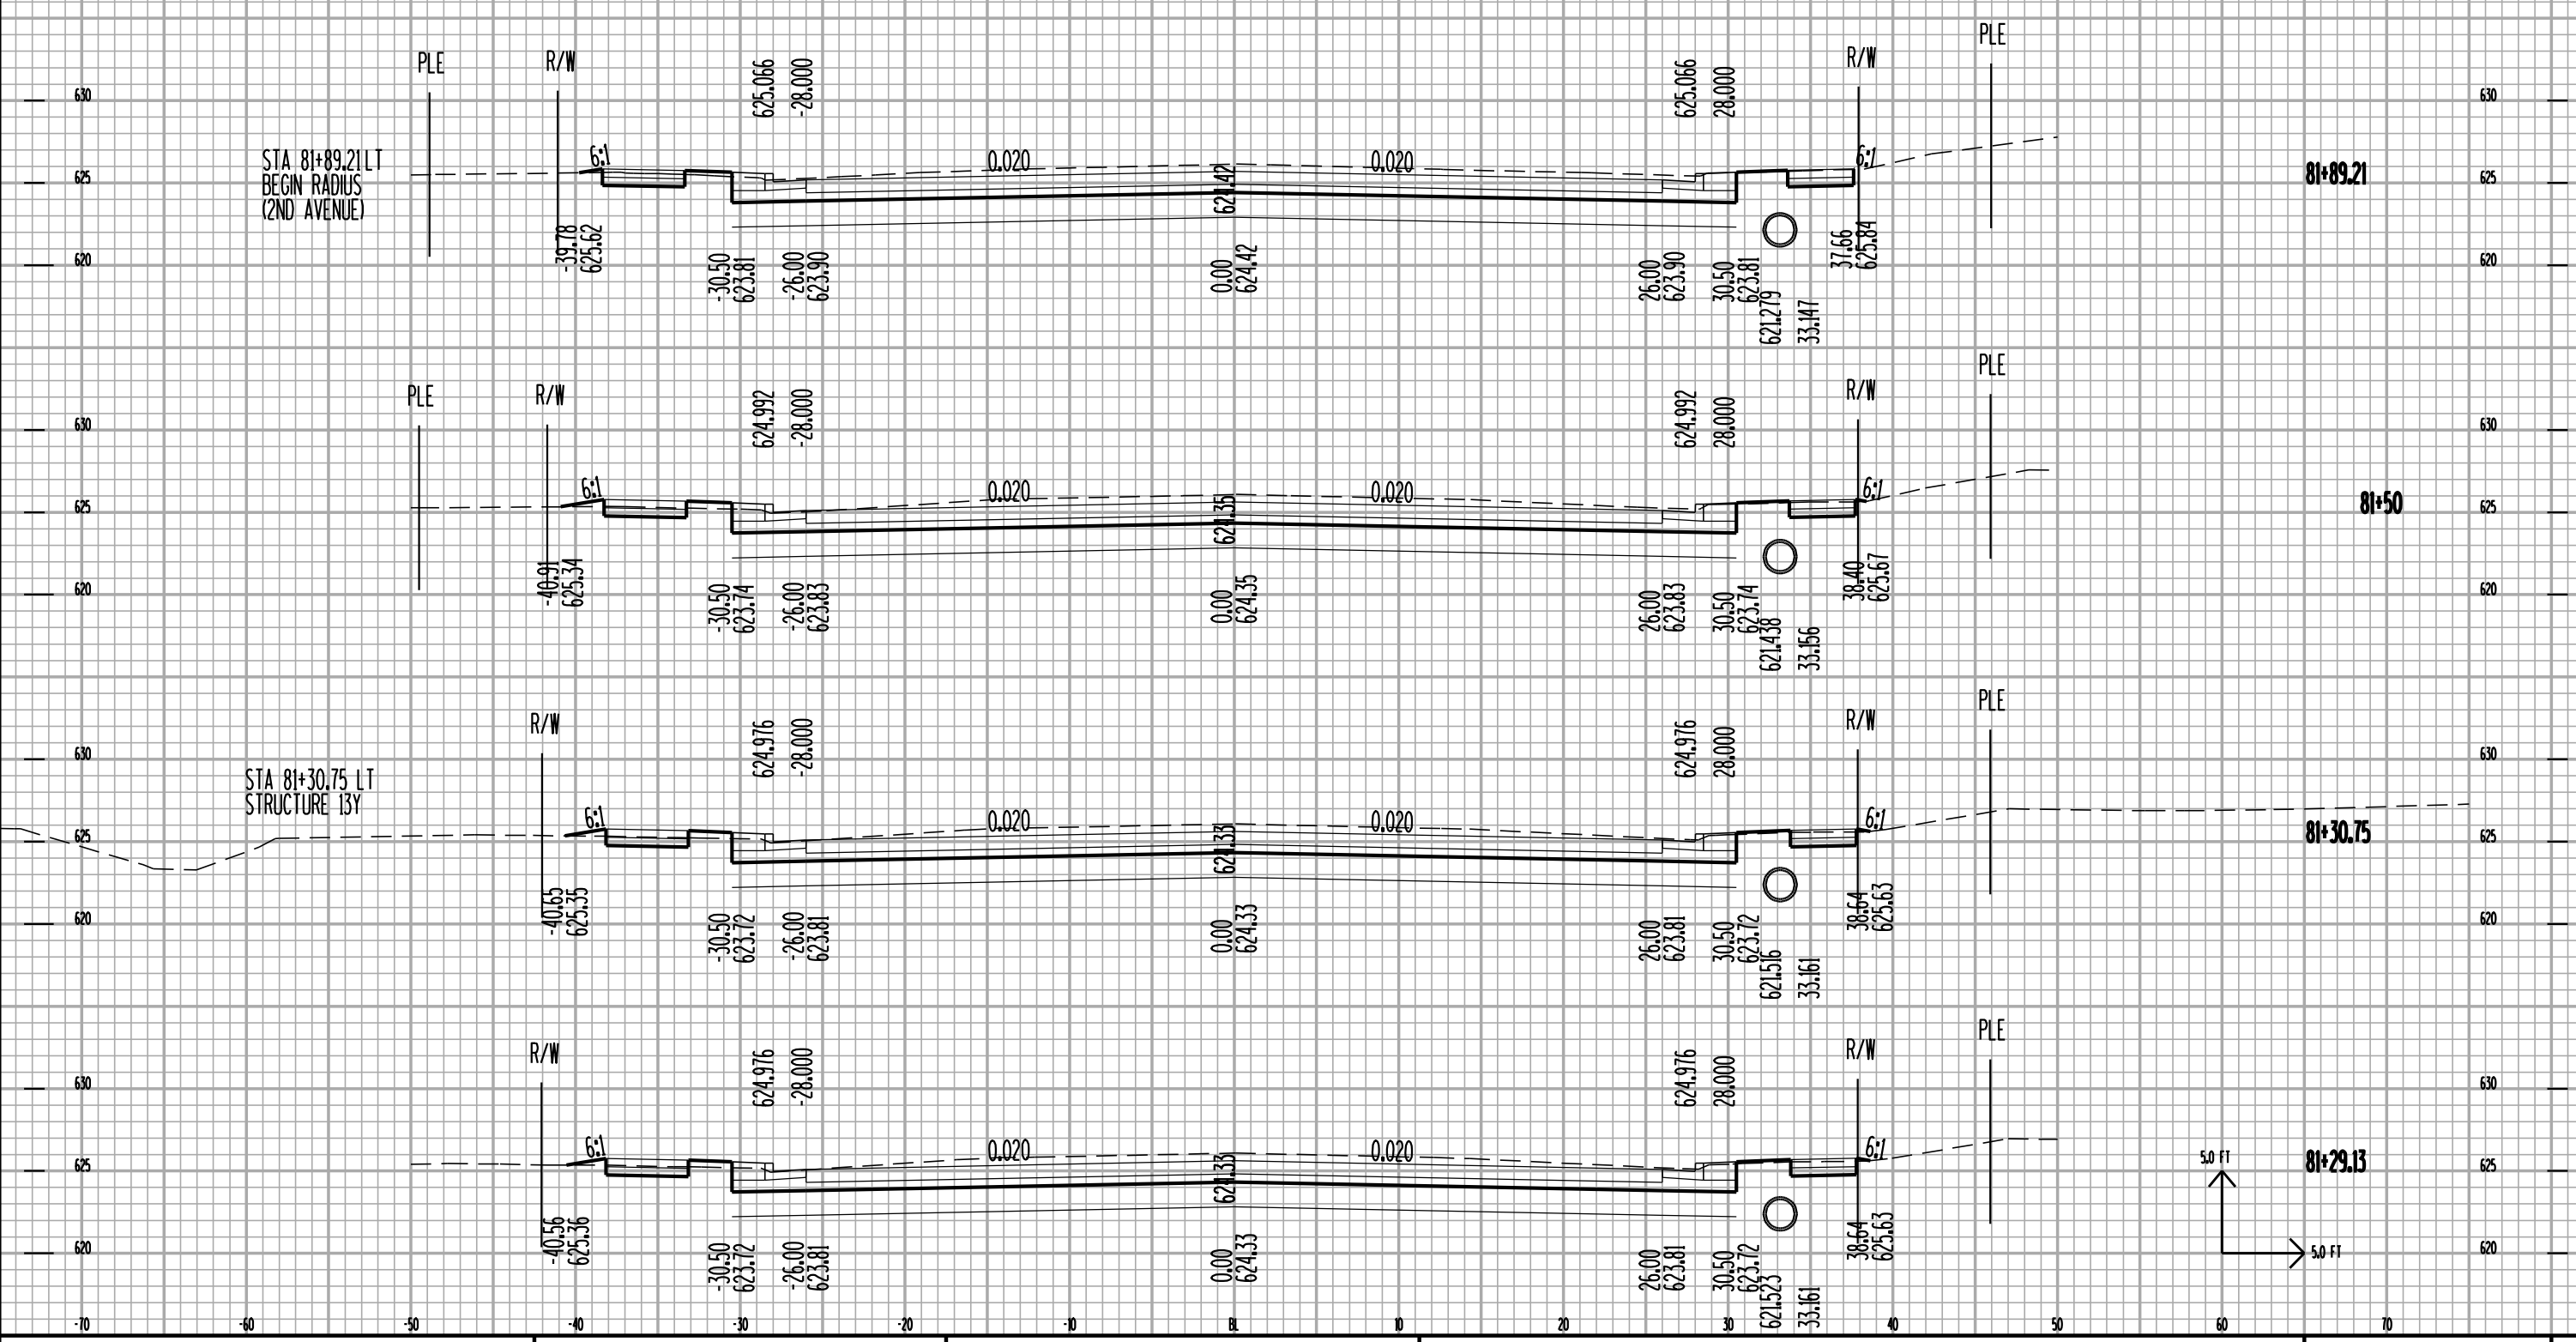


STA 81+89.21 LT  
BEGIN RADIUS  
(2ND AVENUE)


81+89.21


STA 81+30.75 LT  
STRUCTURE 13Y


81+30.75

81+29.13

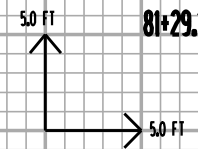

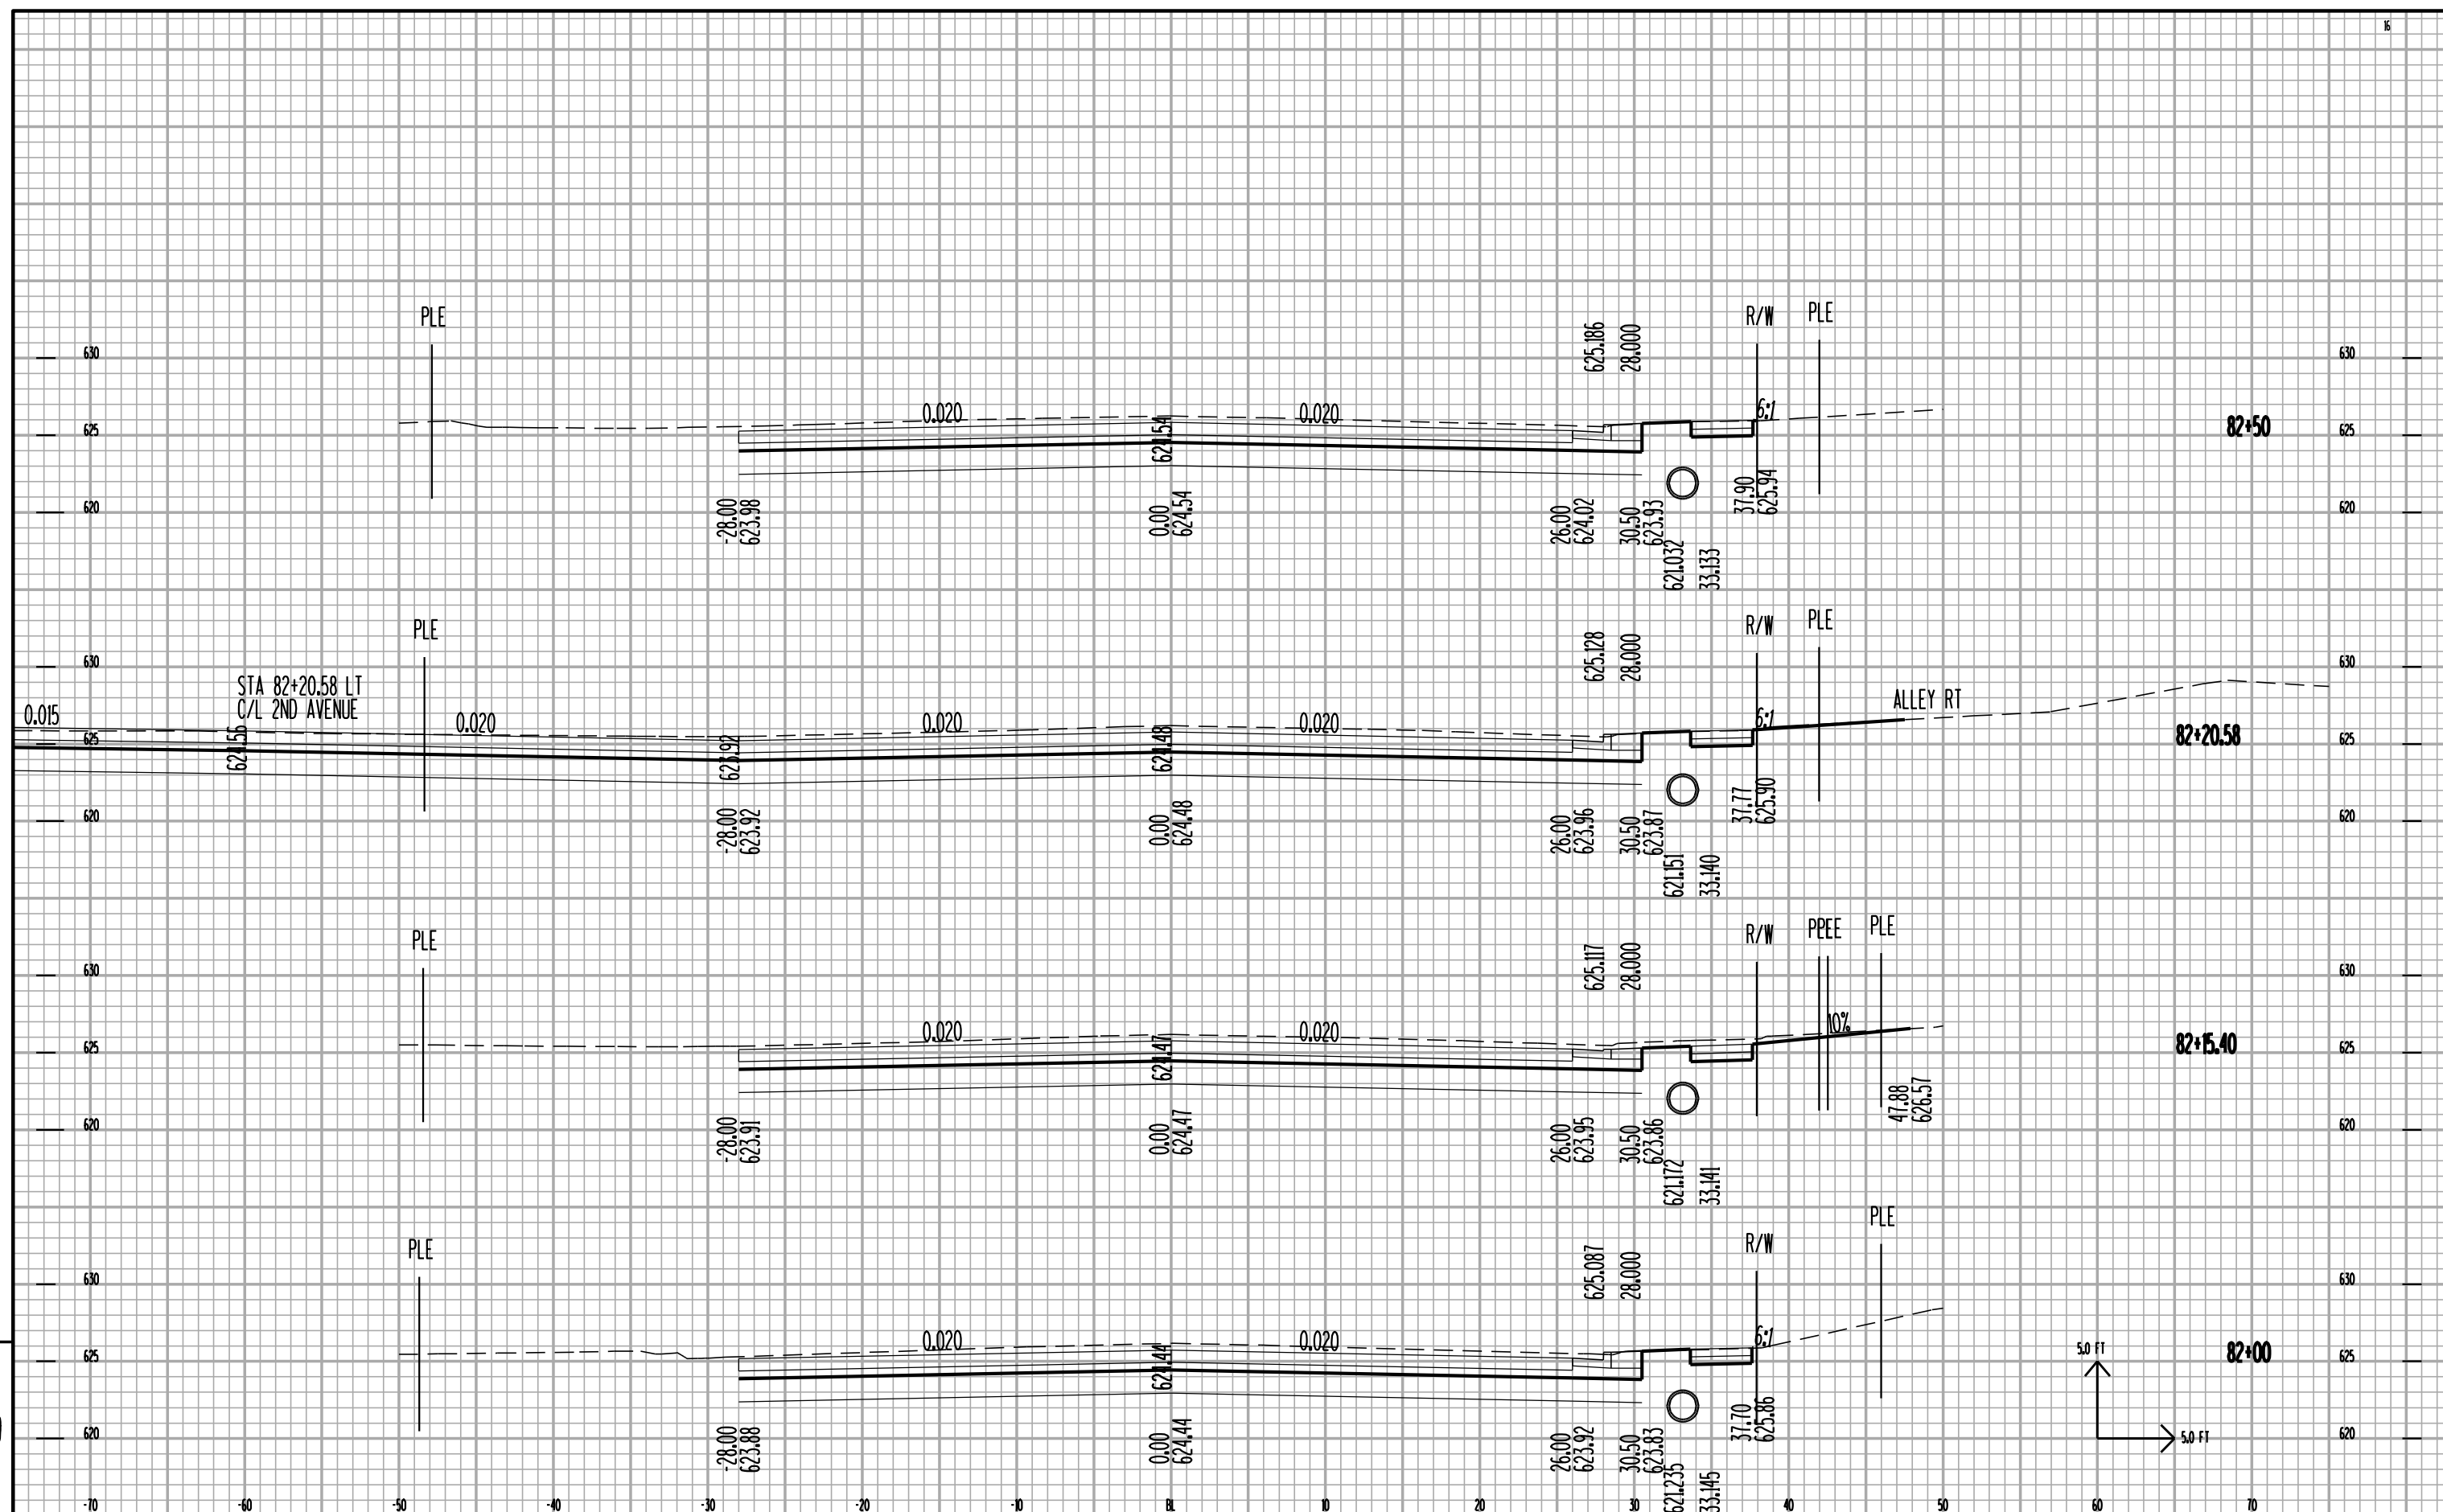


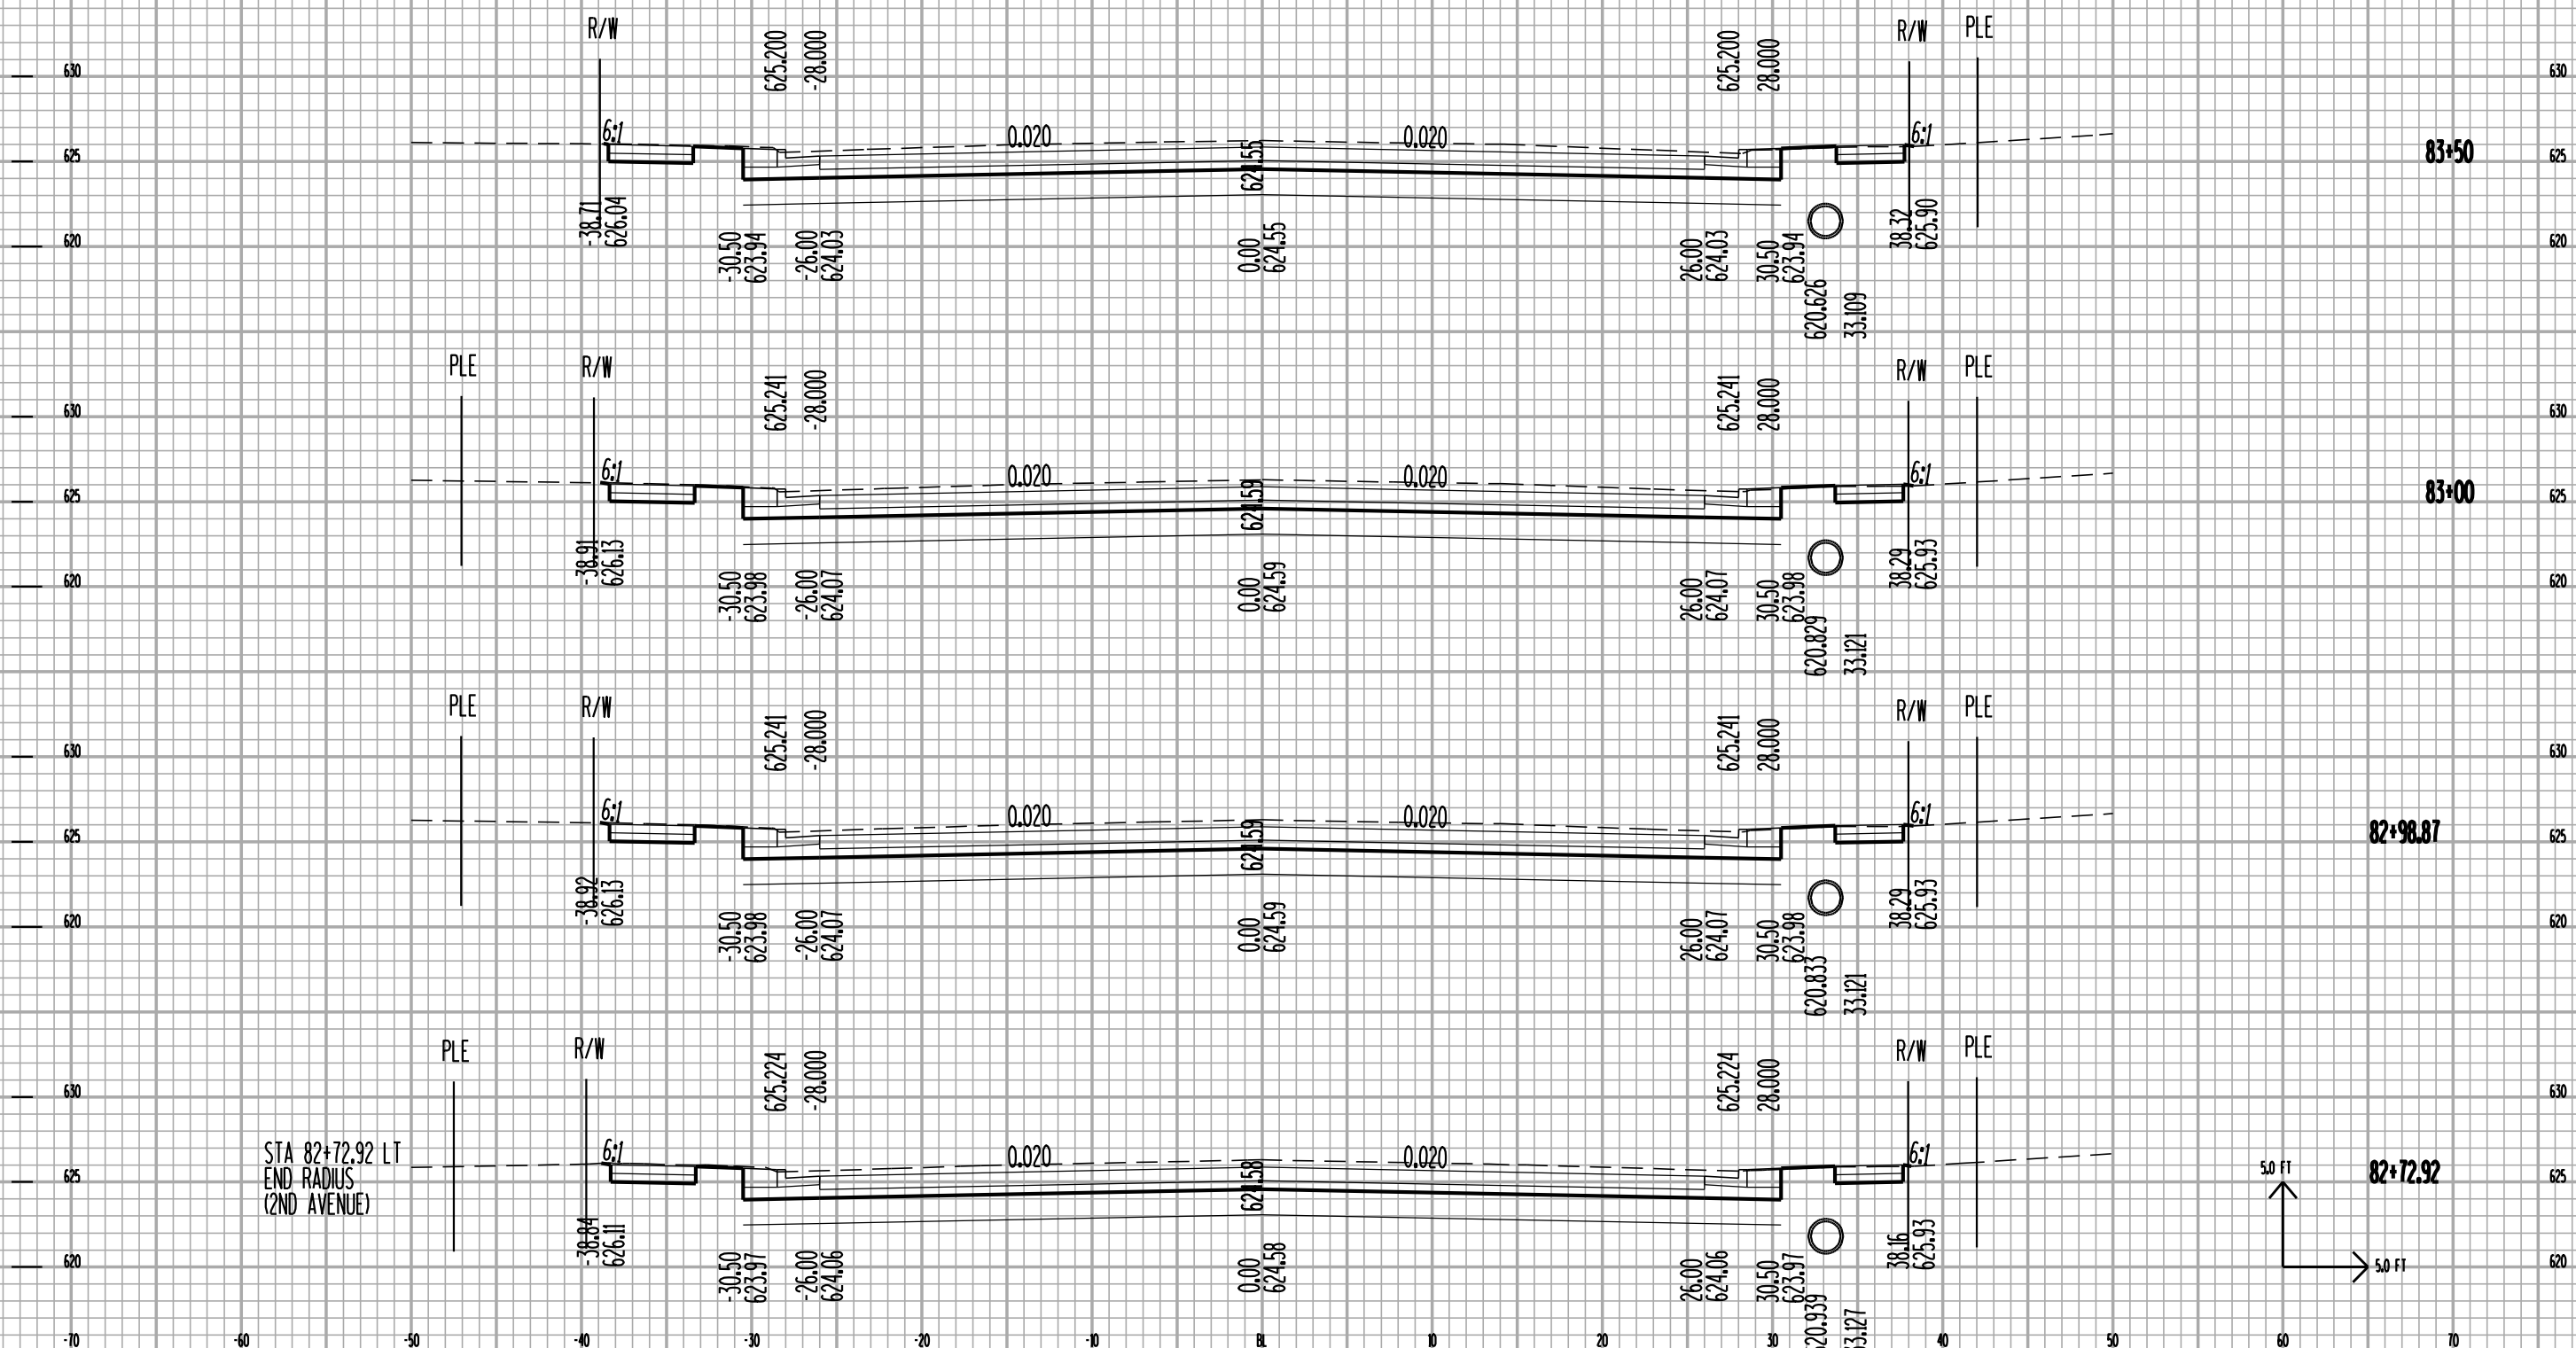


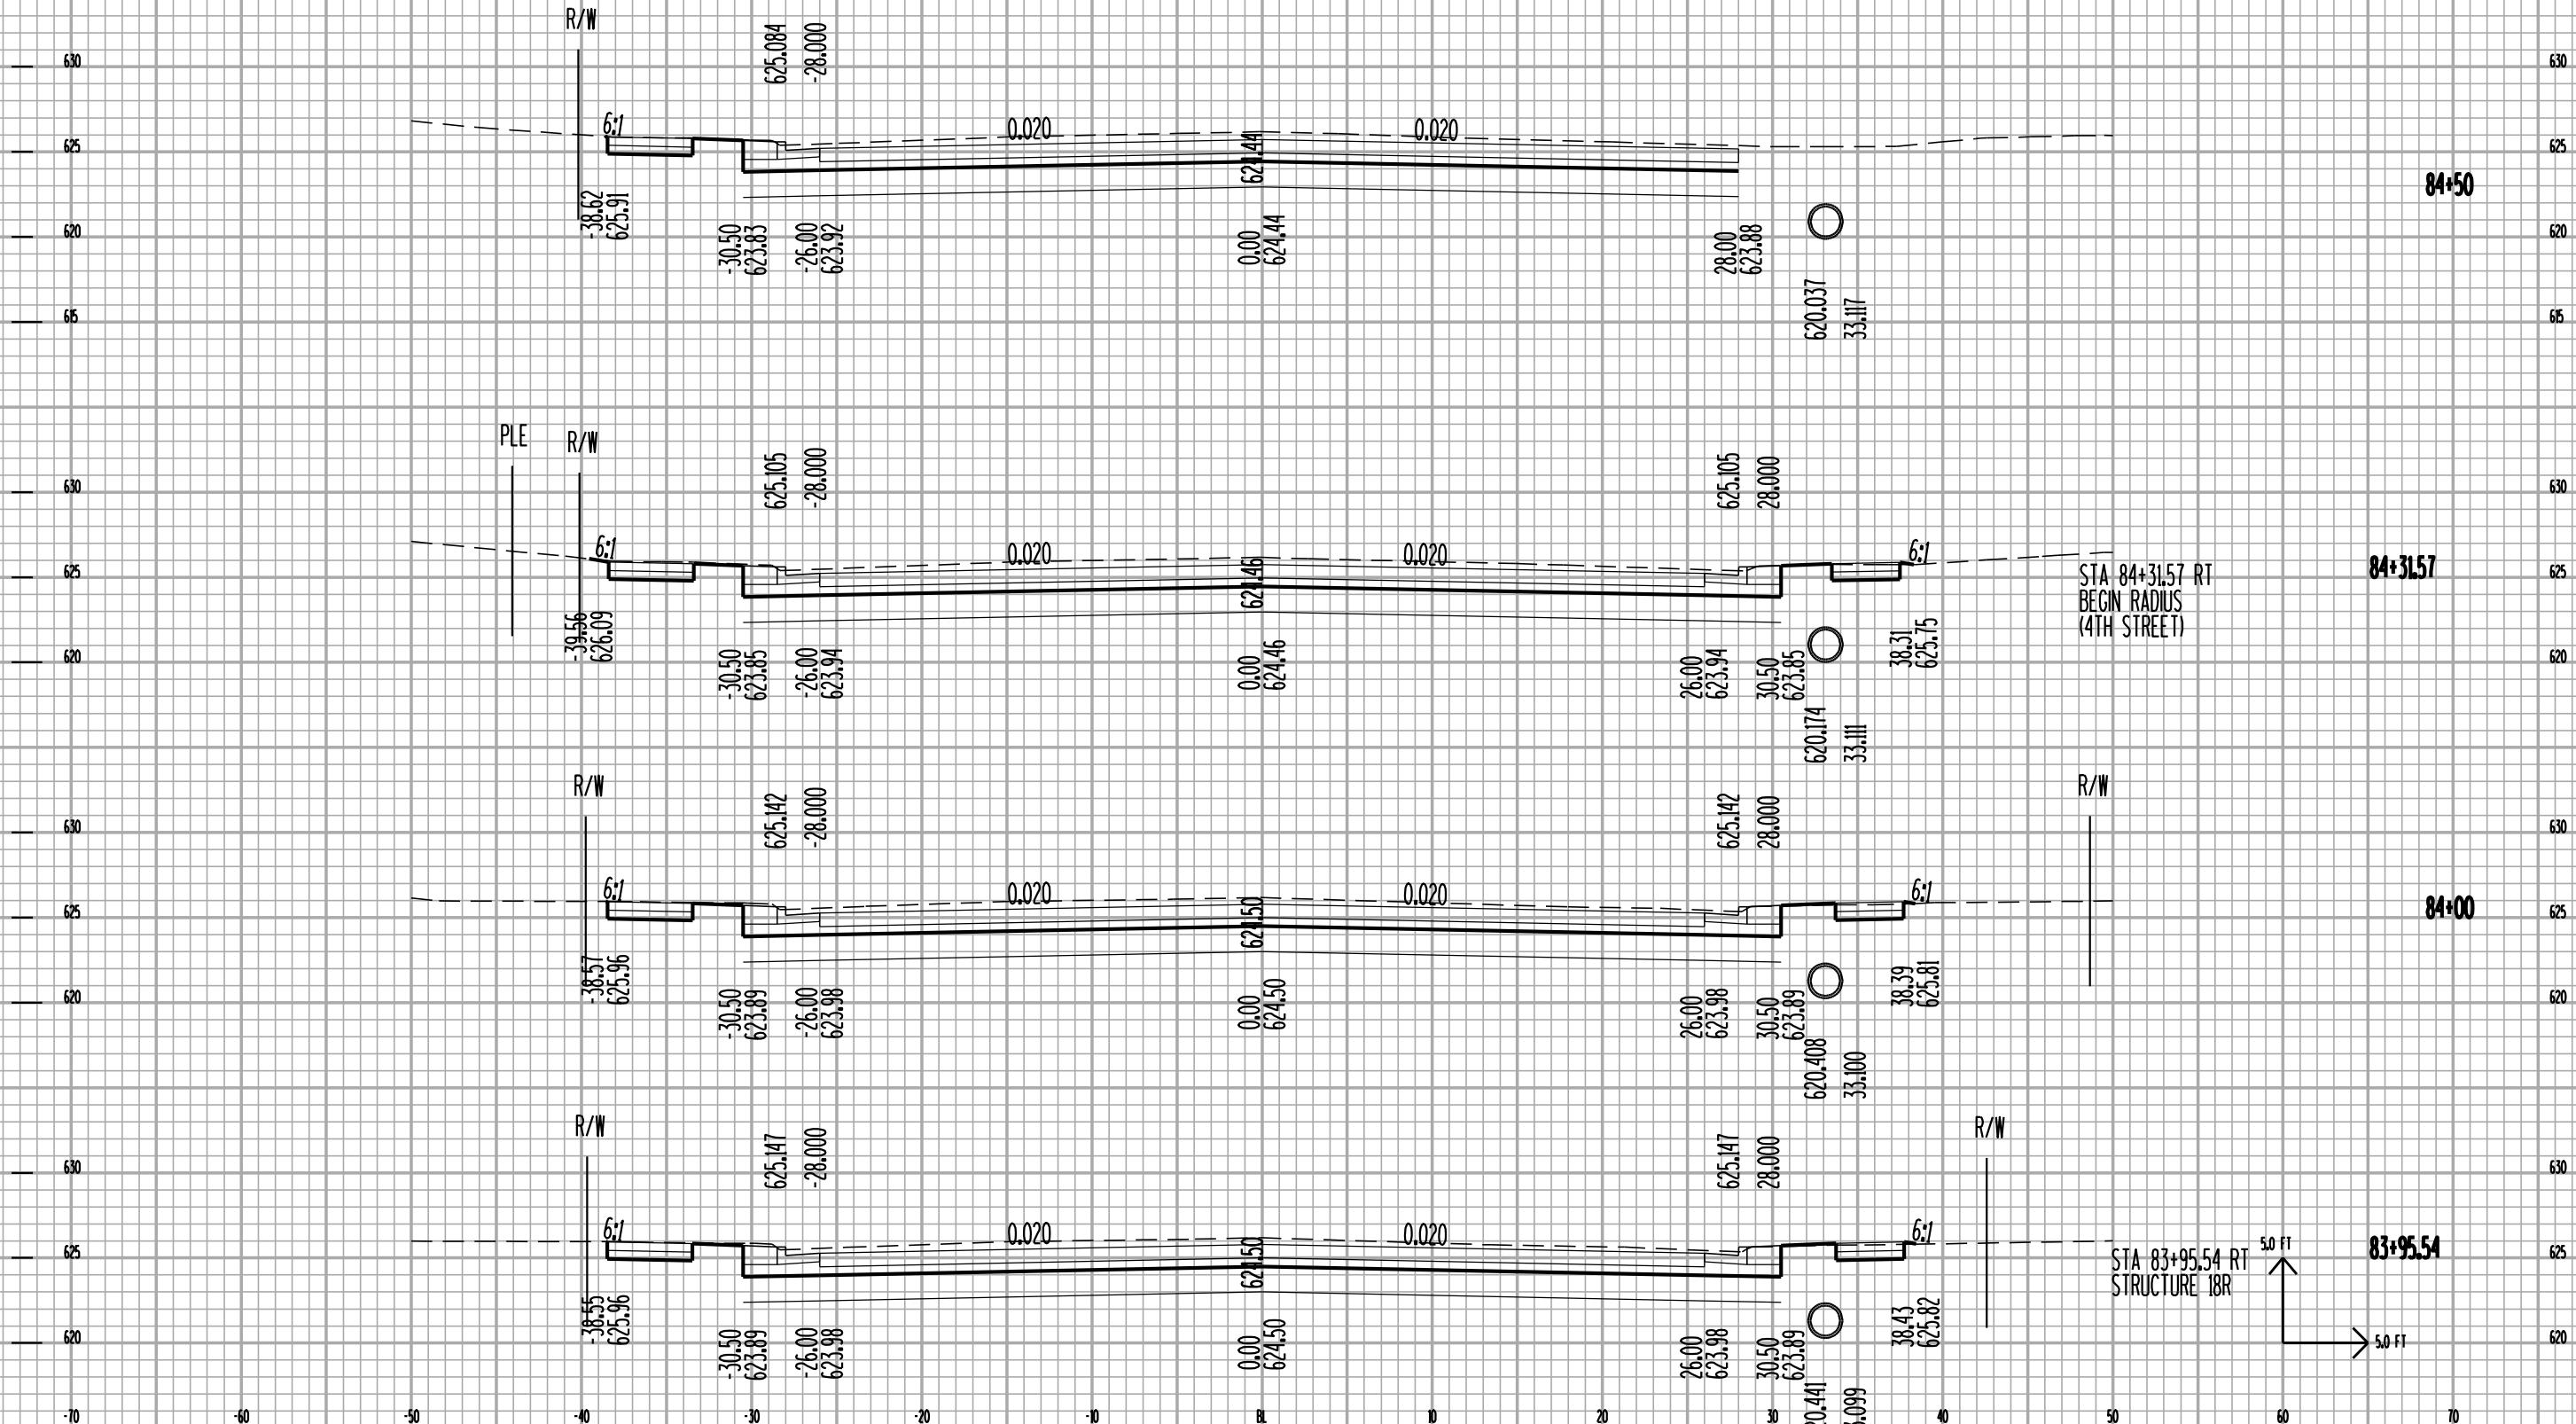



9

9

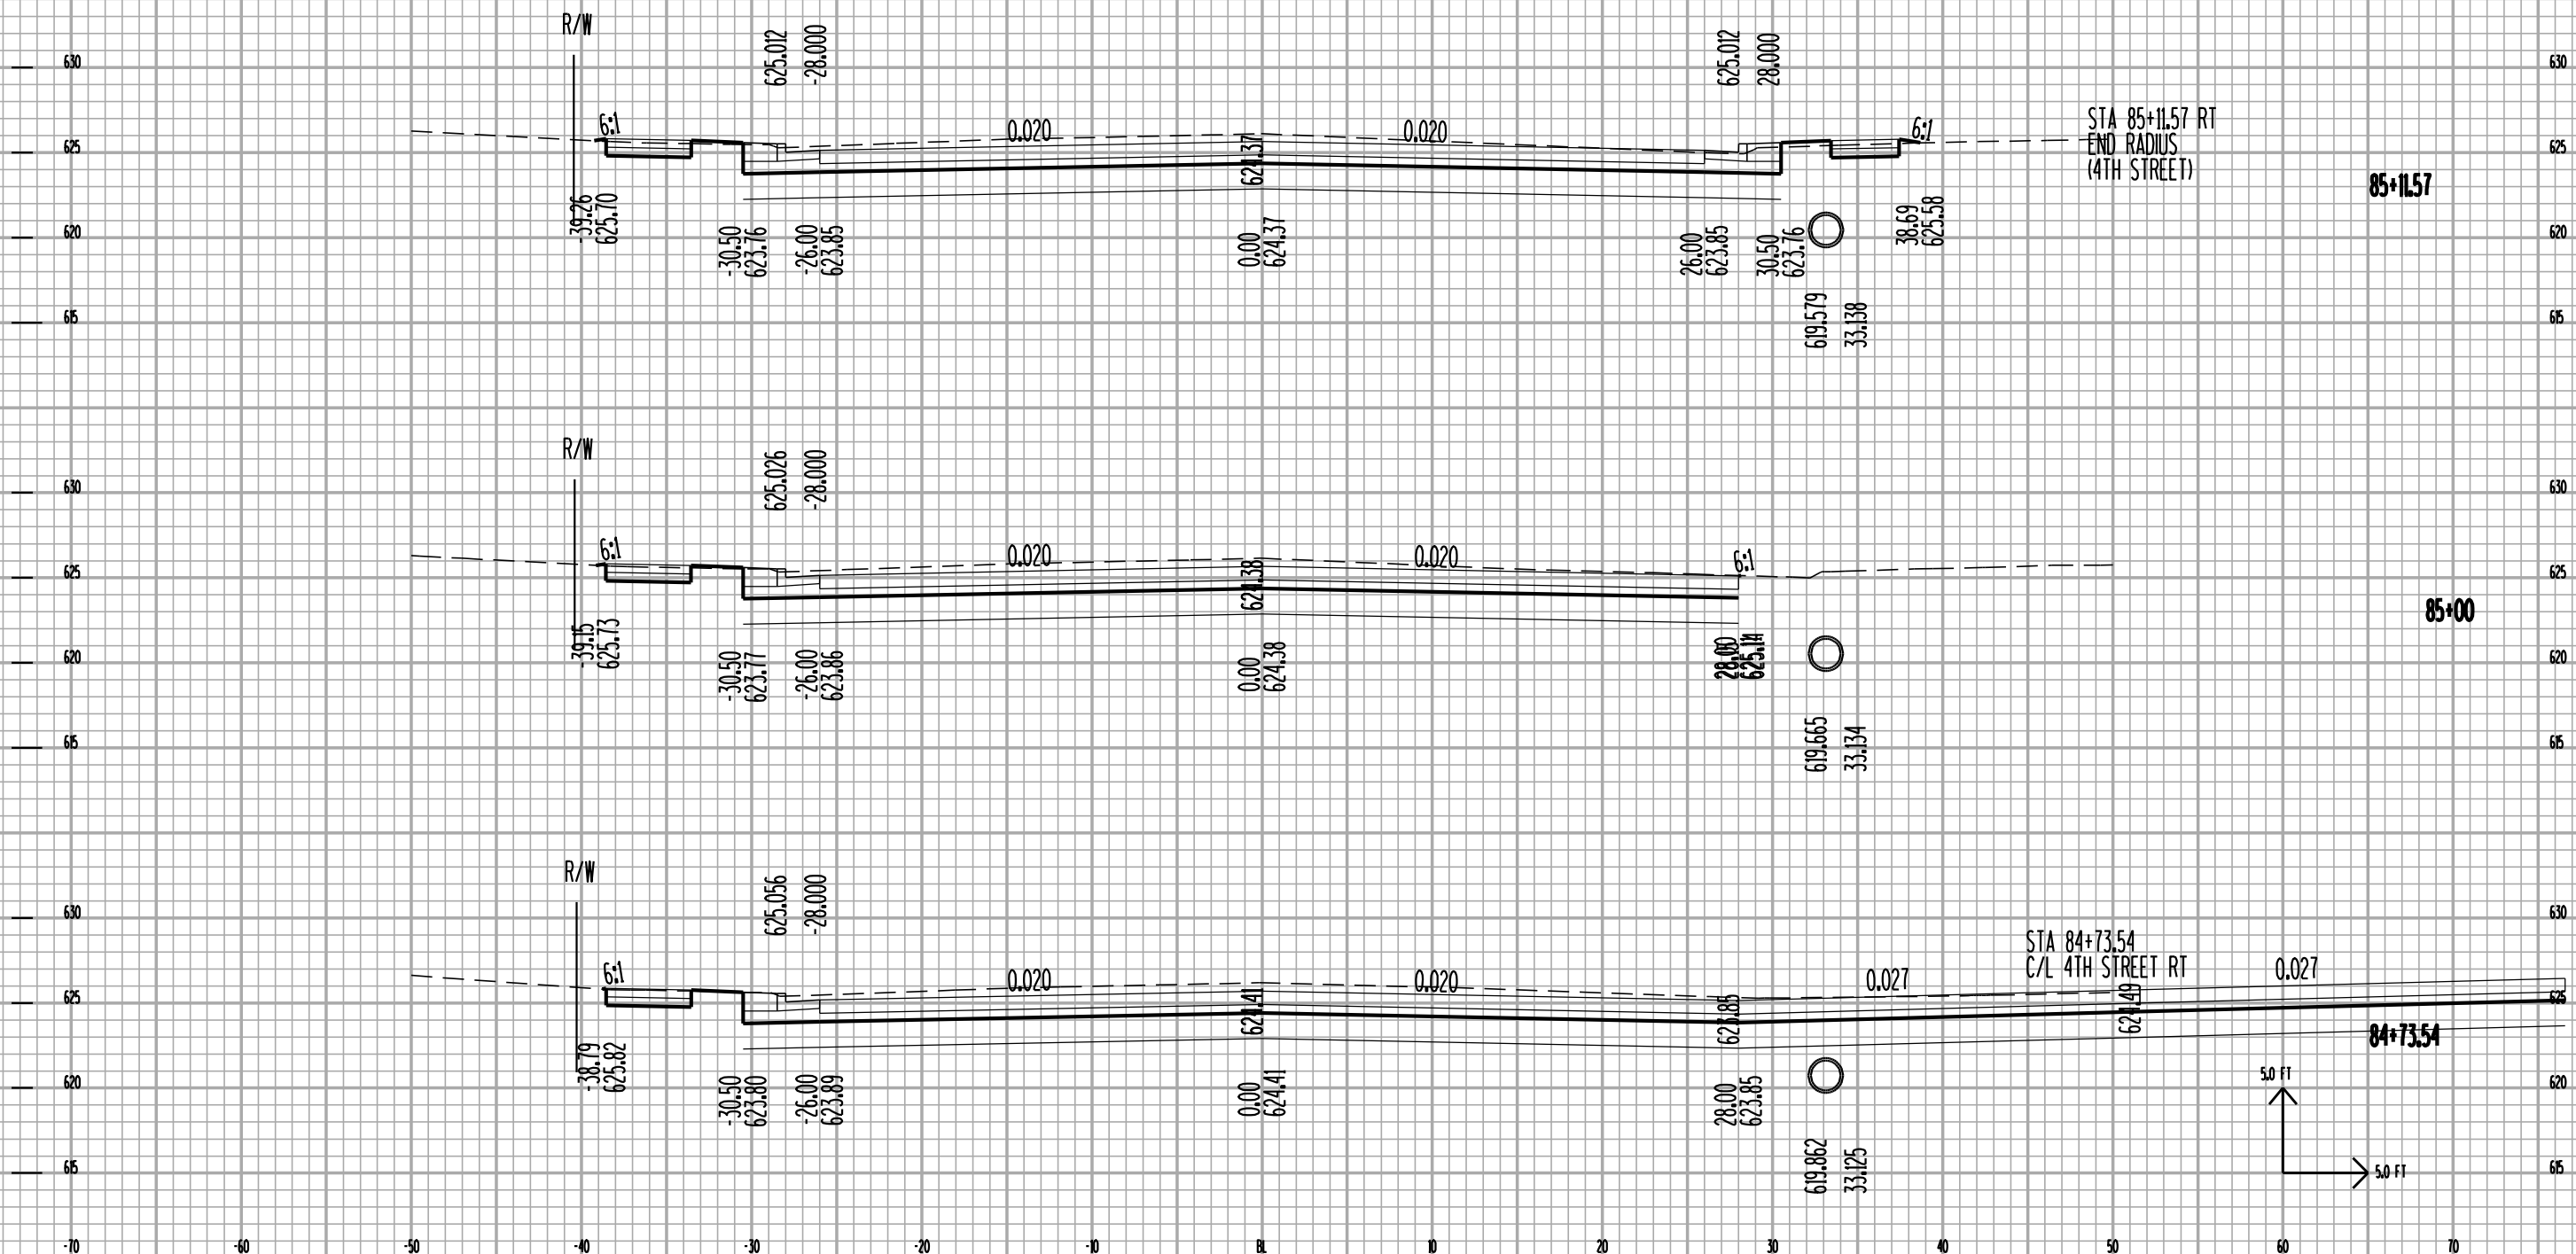


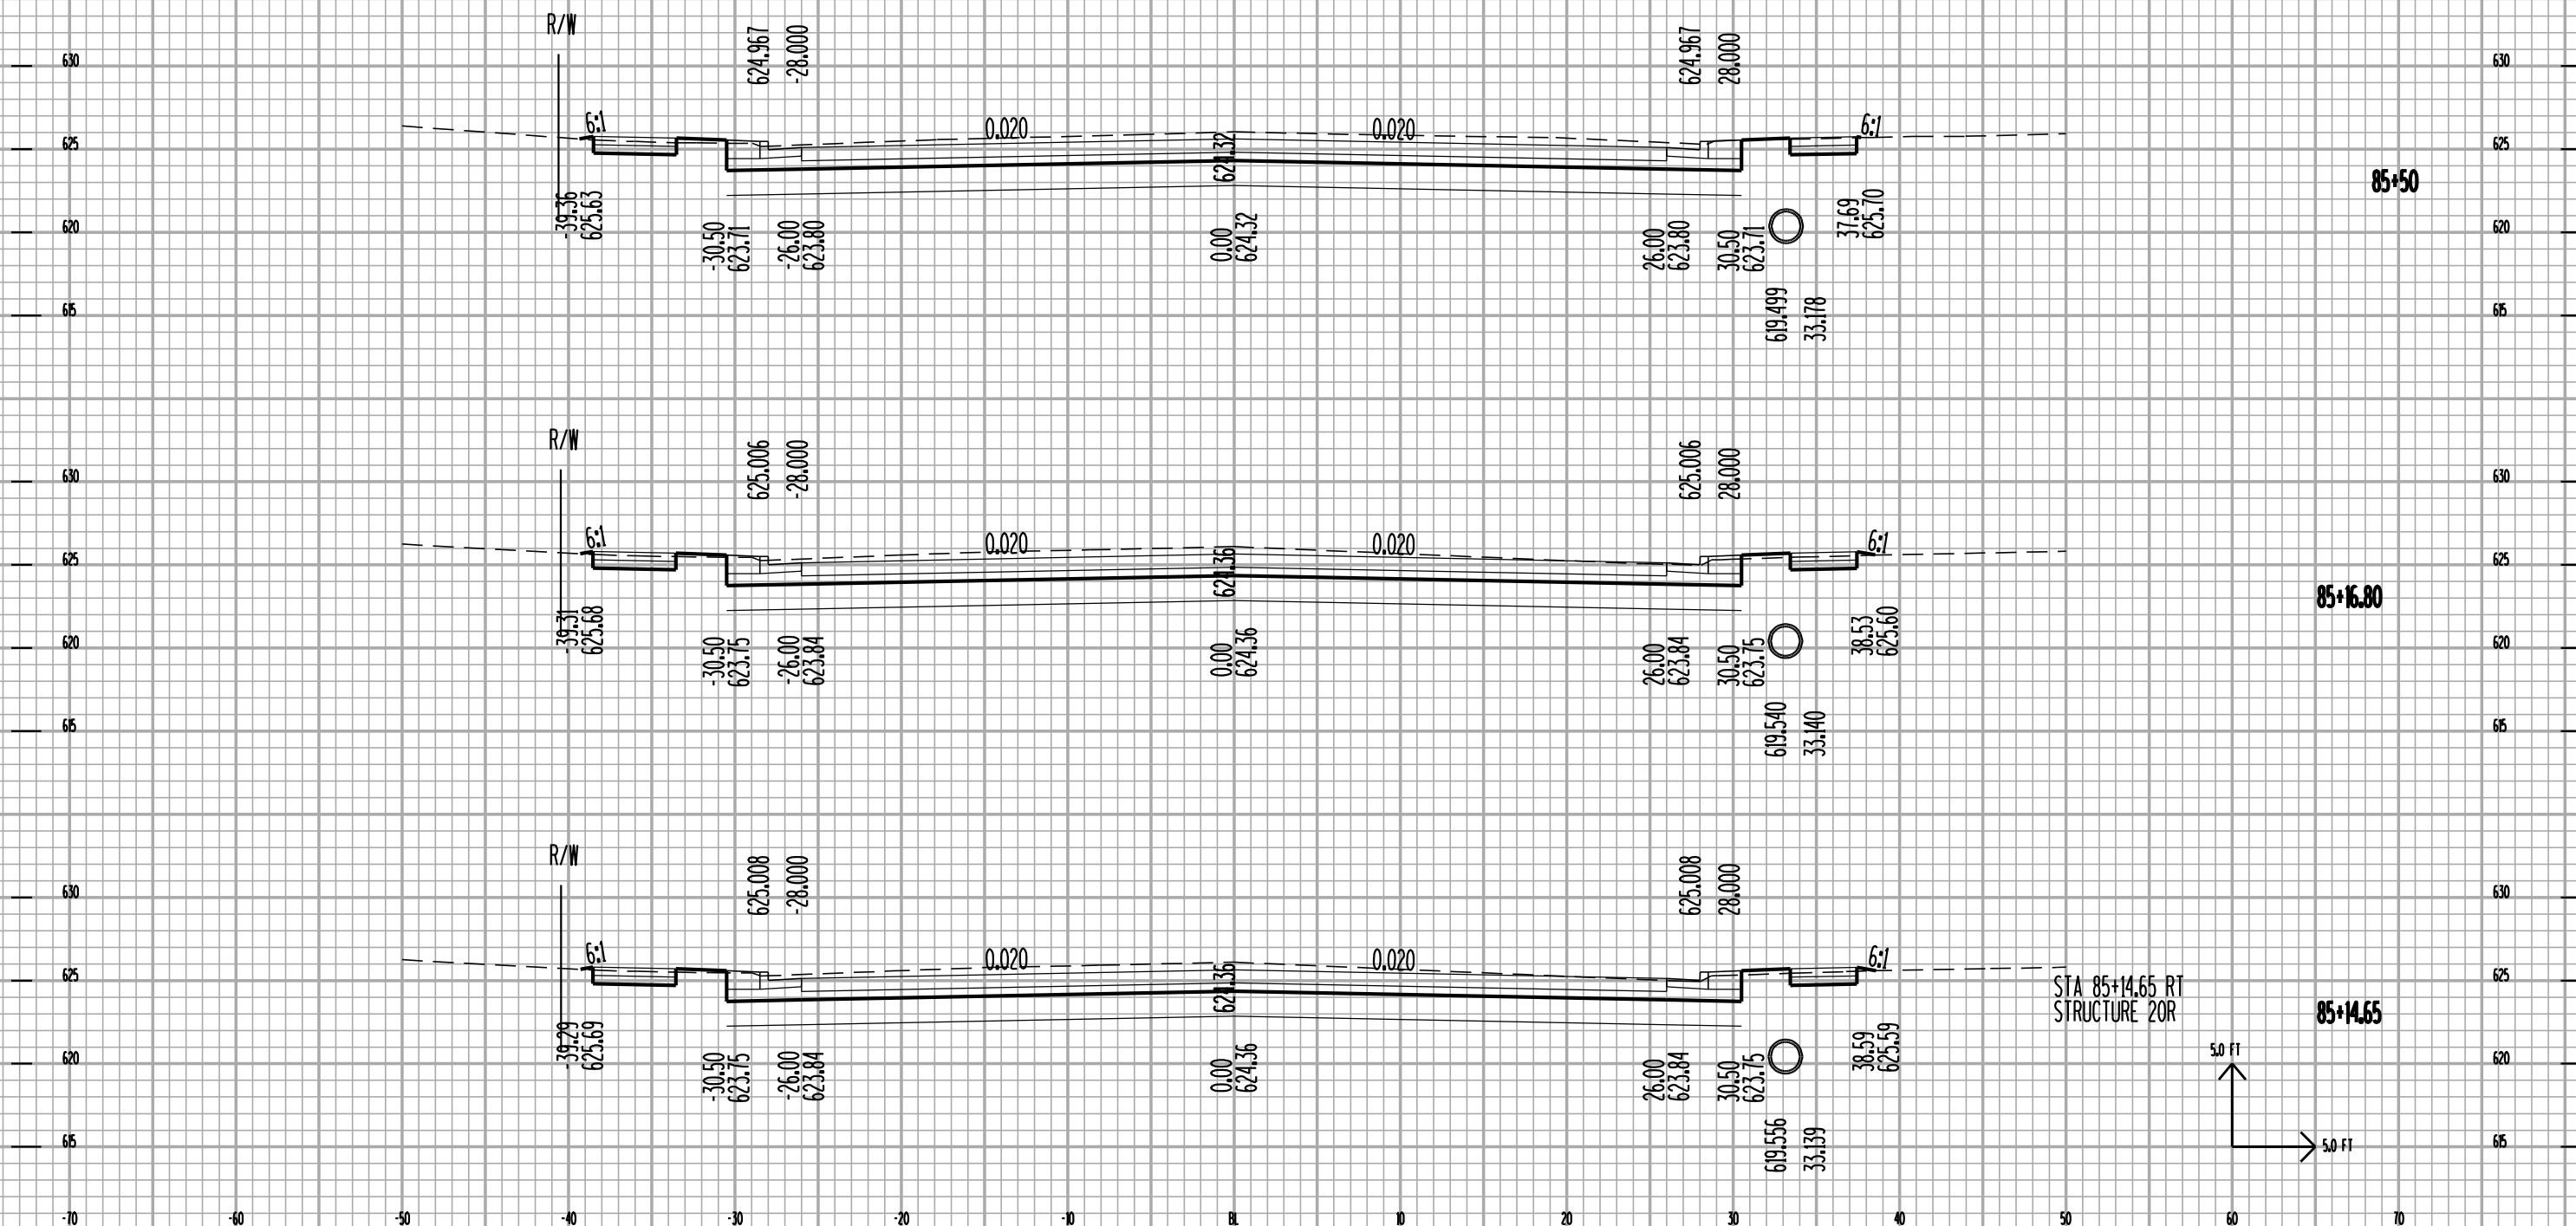

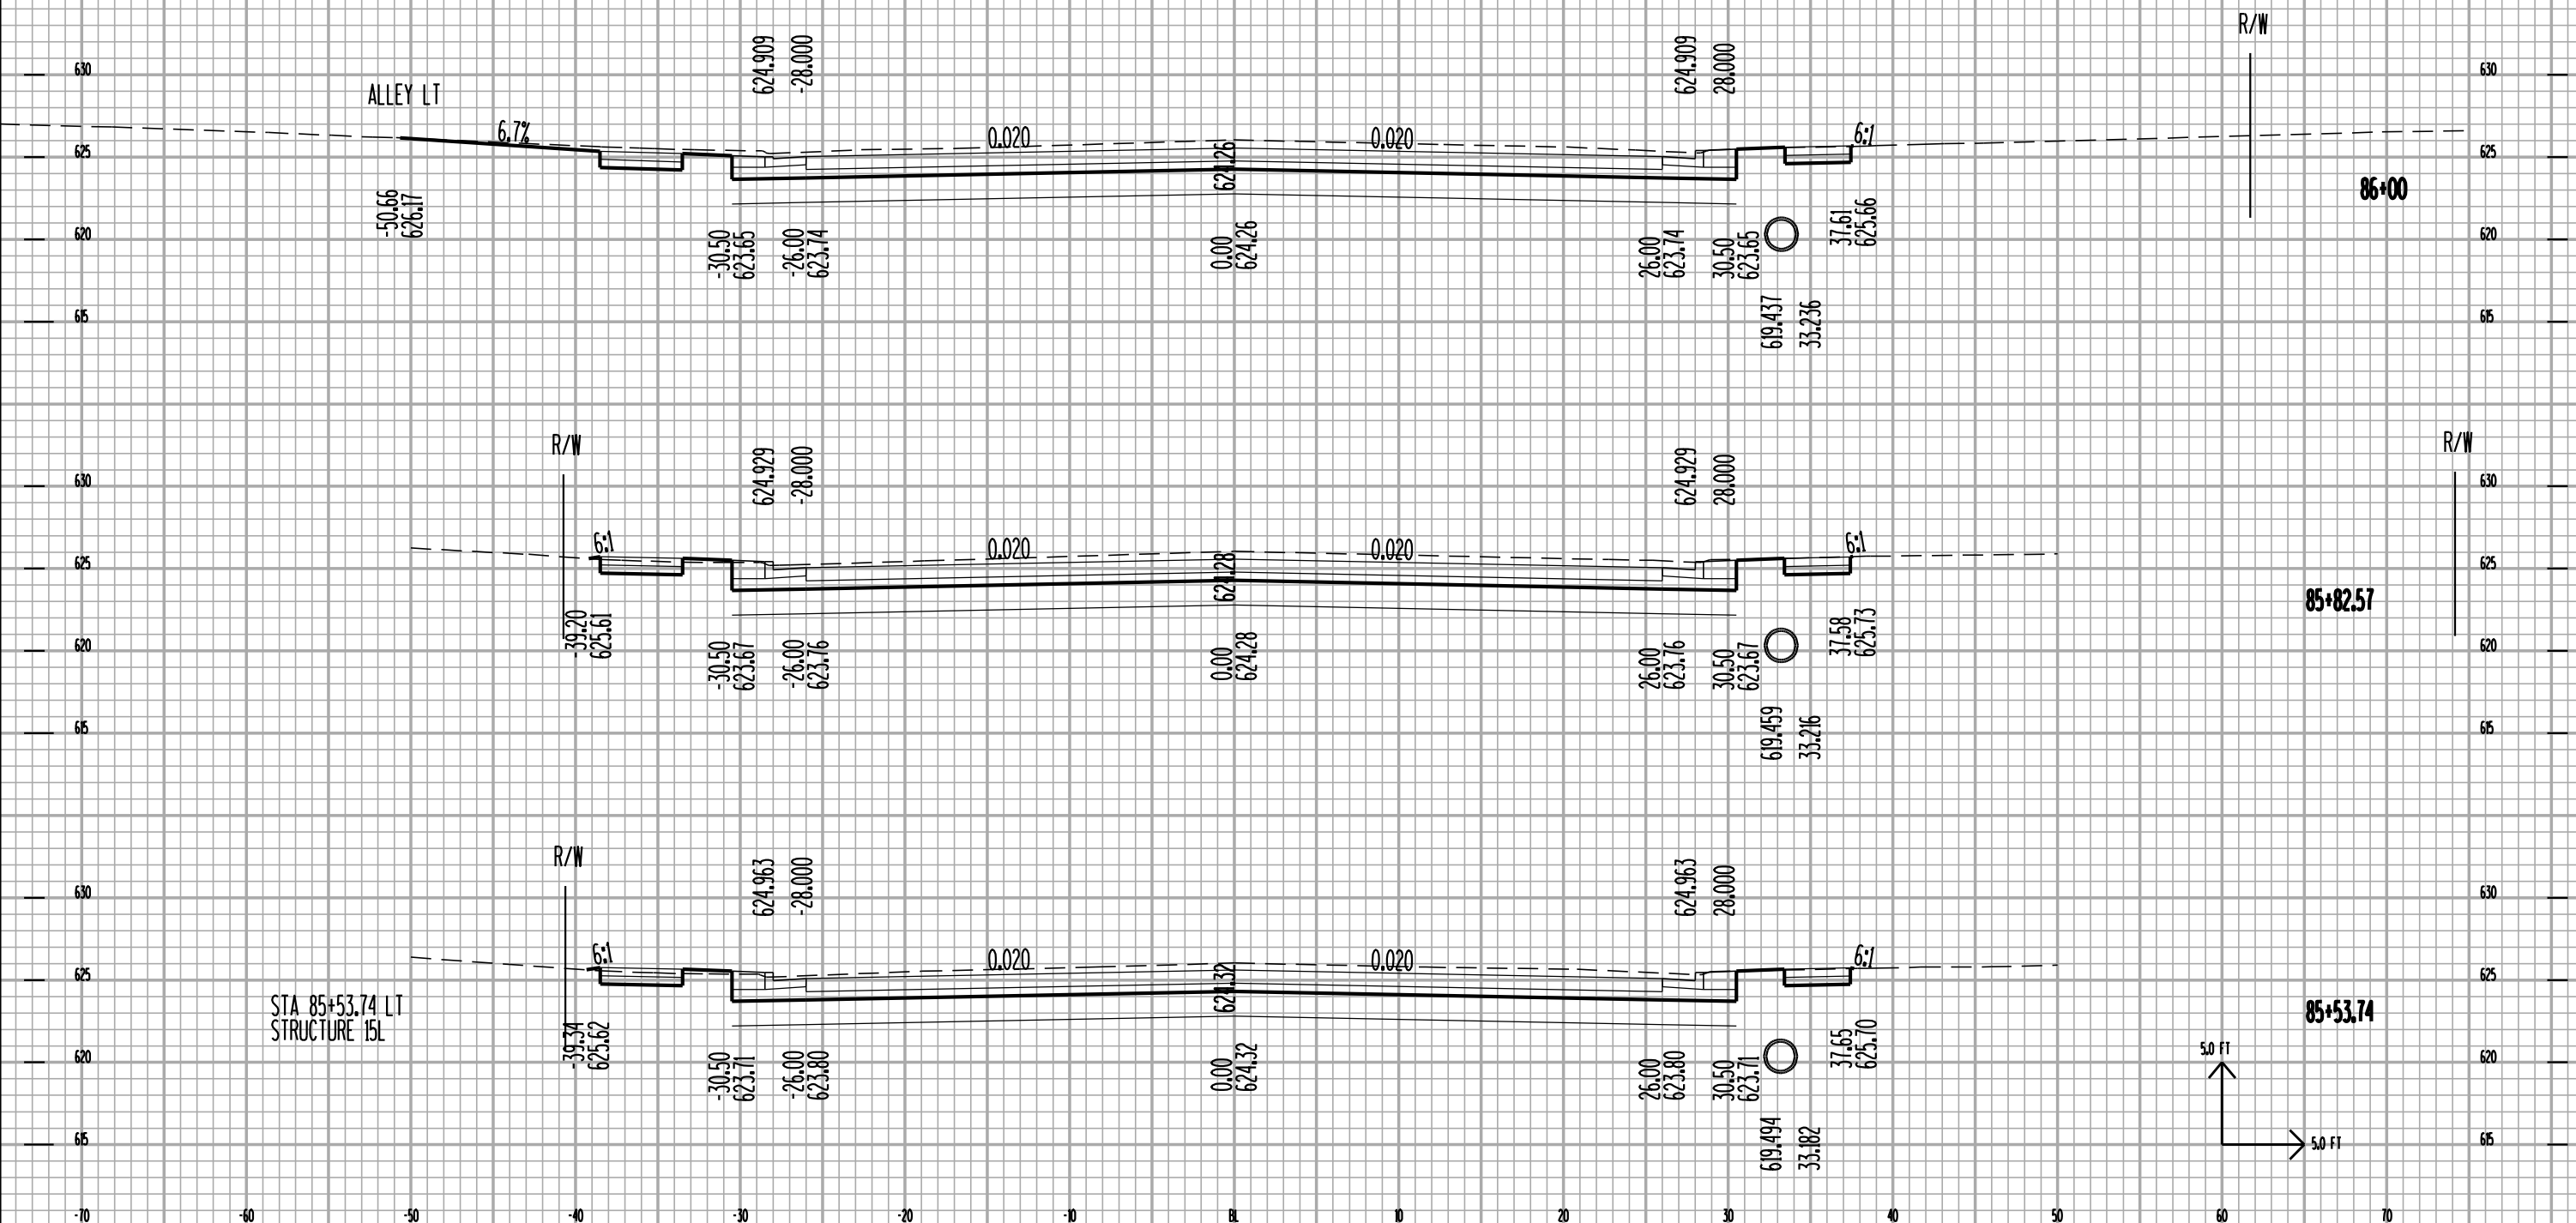

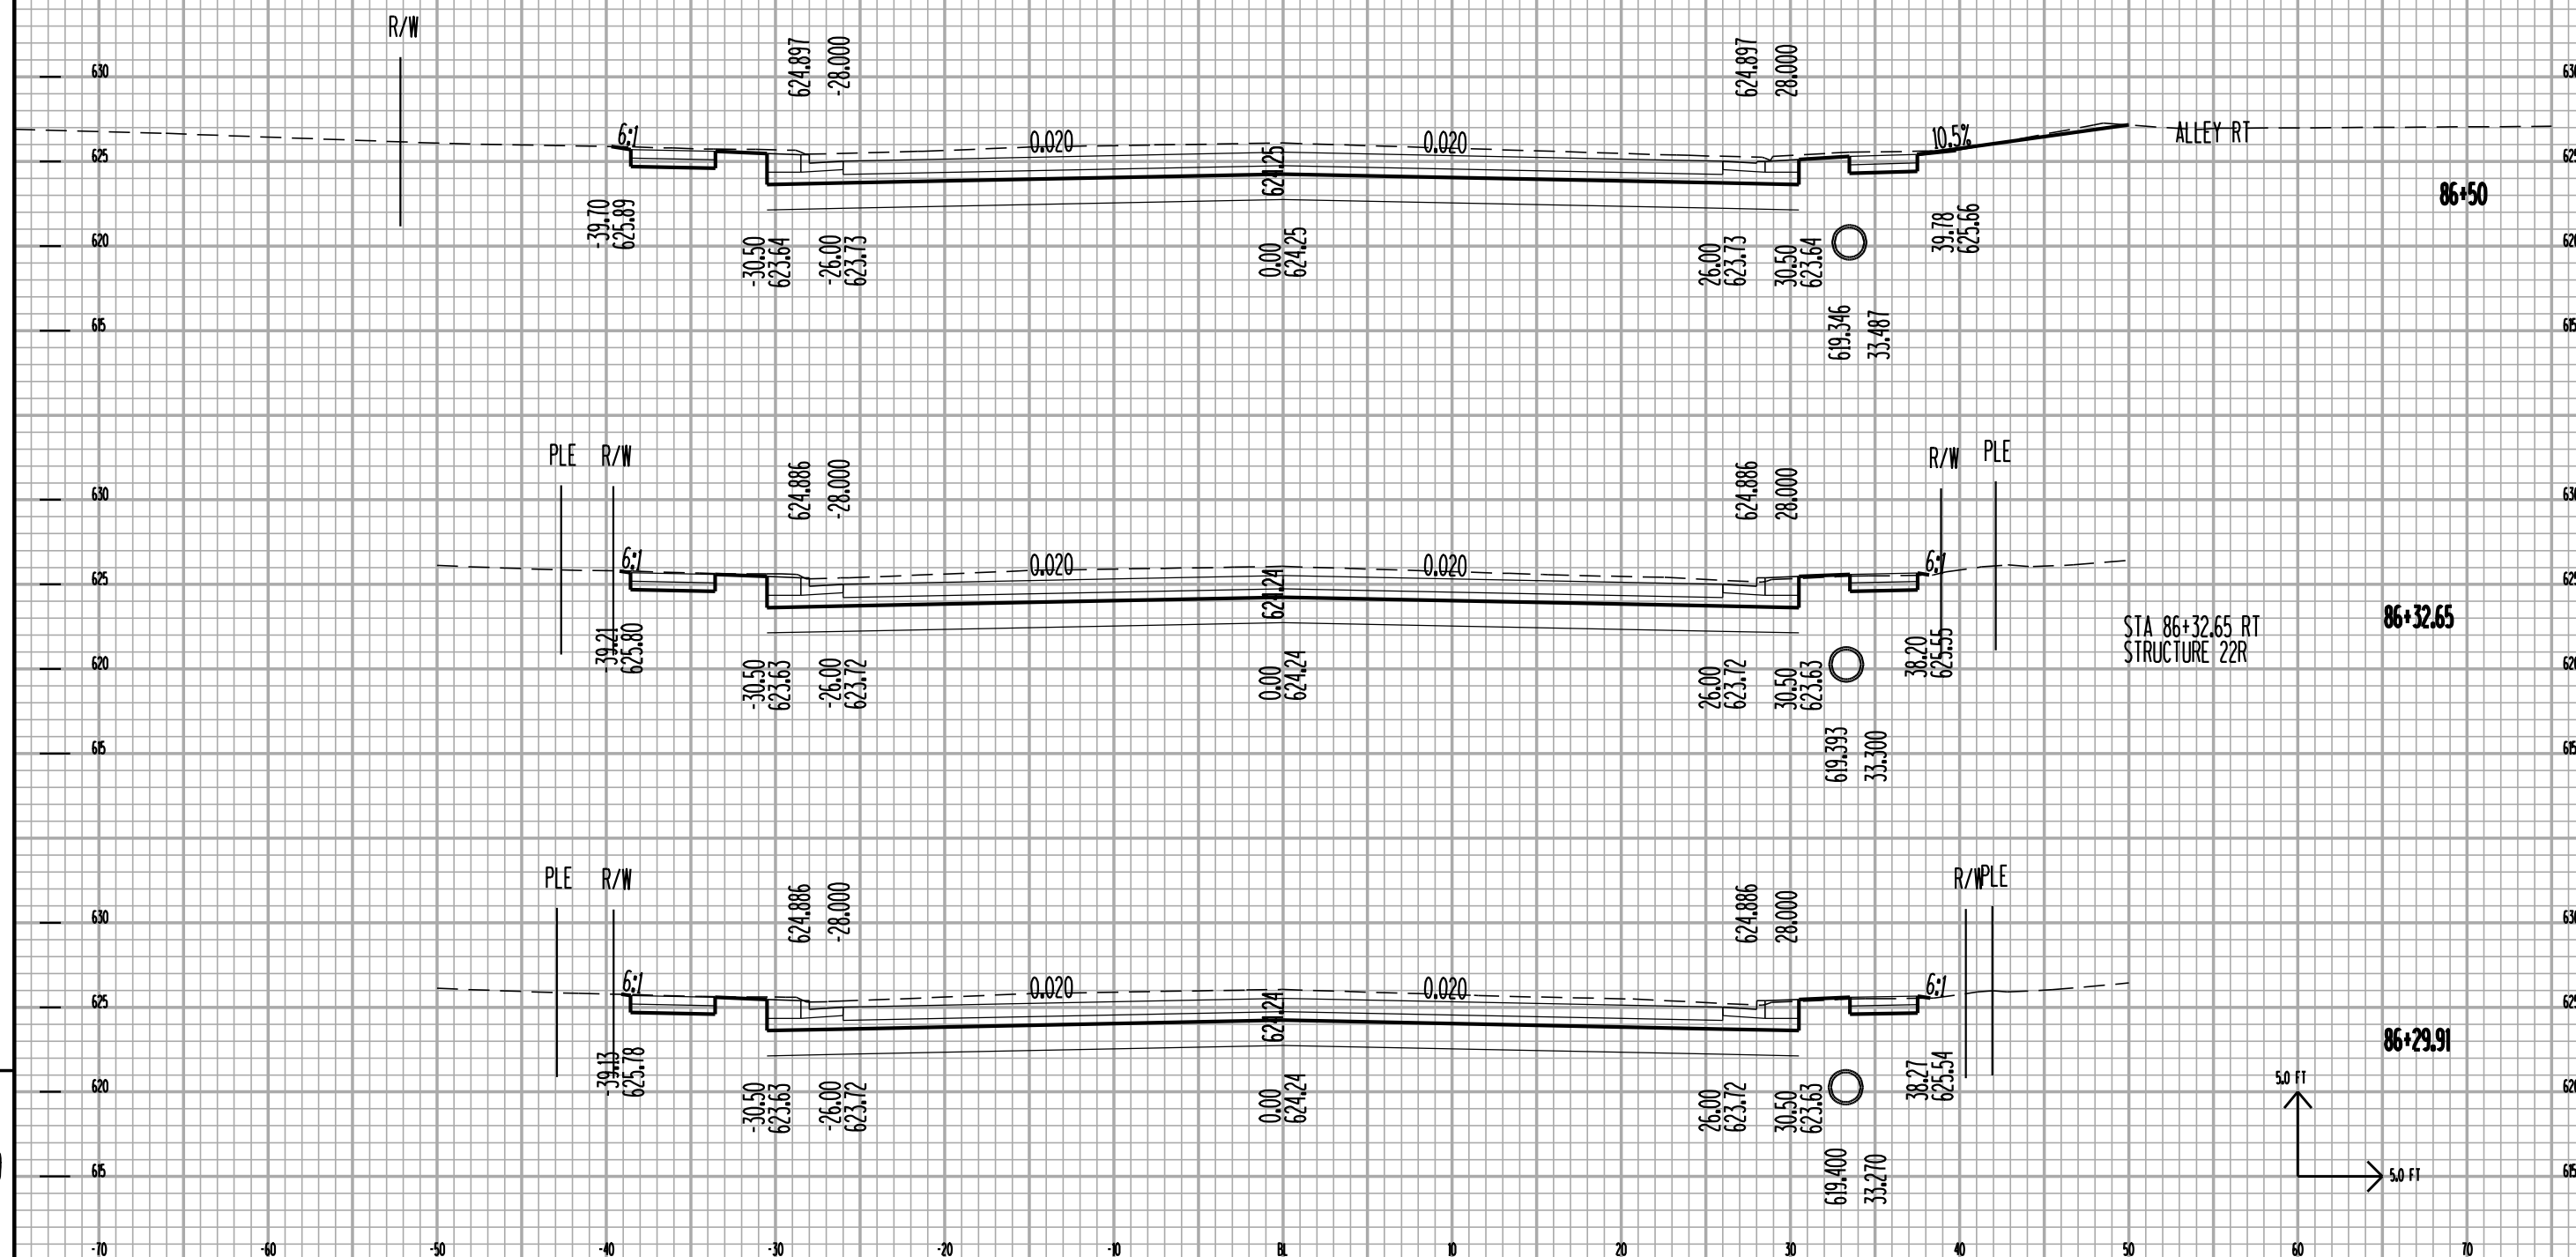




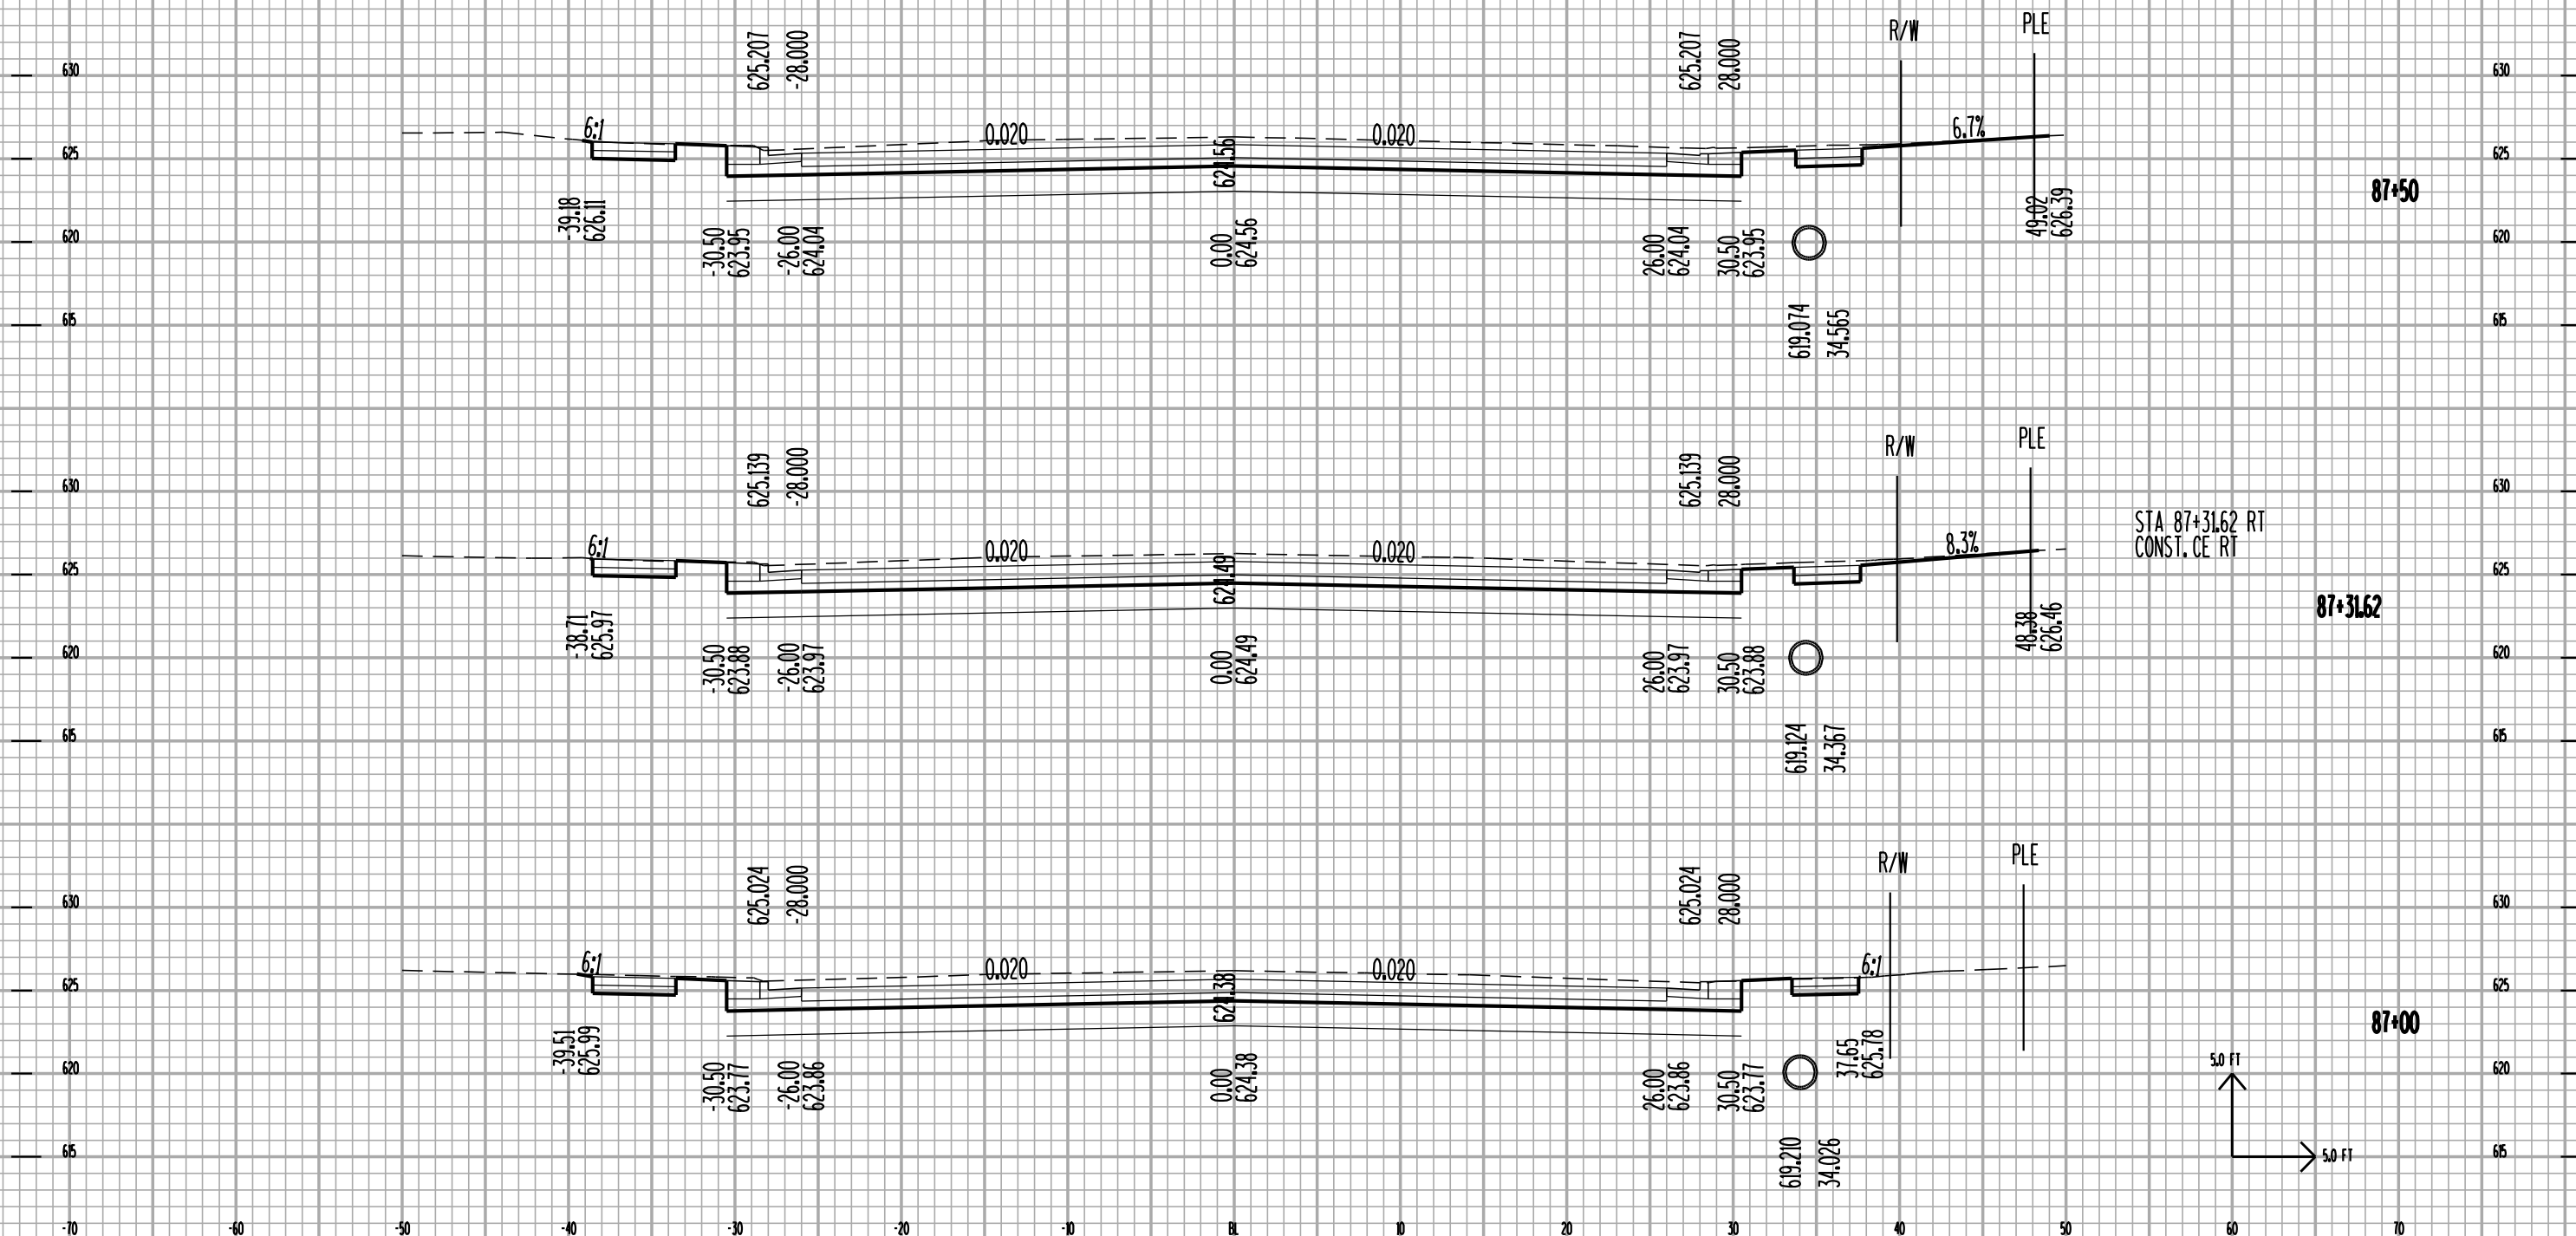


STA 87+52.4 LT  
BEGIN RADIUS  
(3RD STREET)


STA 87+50.1 LT  
STRUCTURE 17L

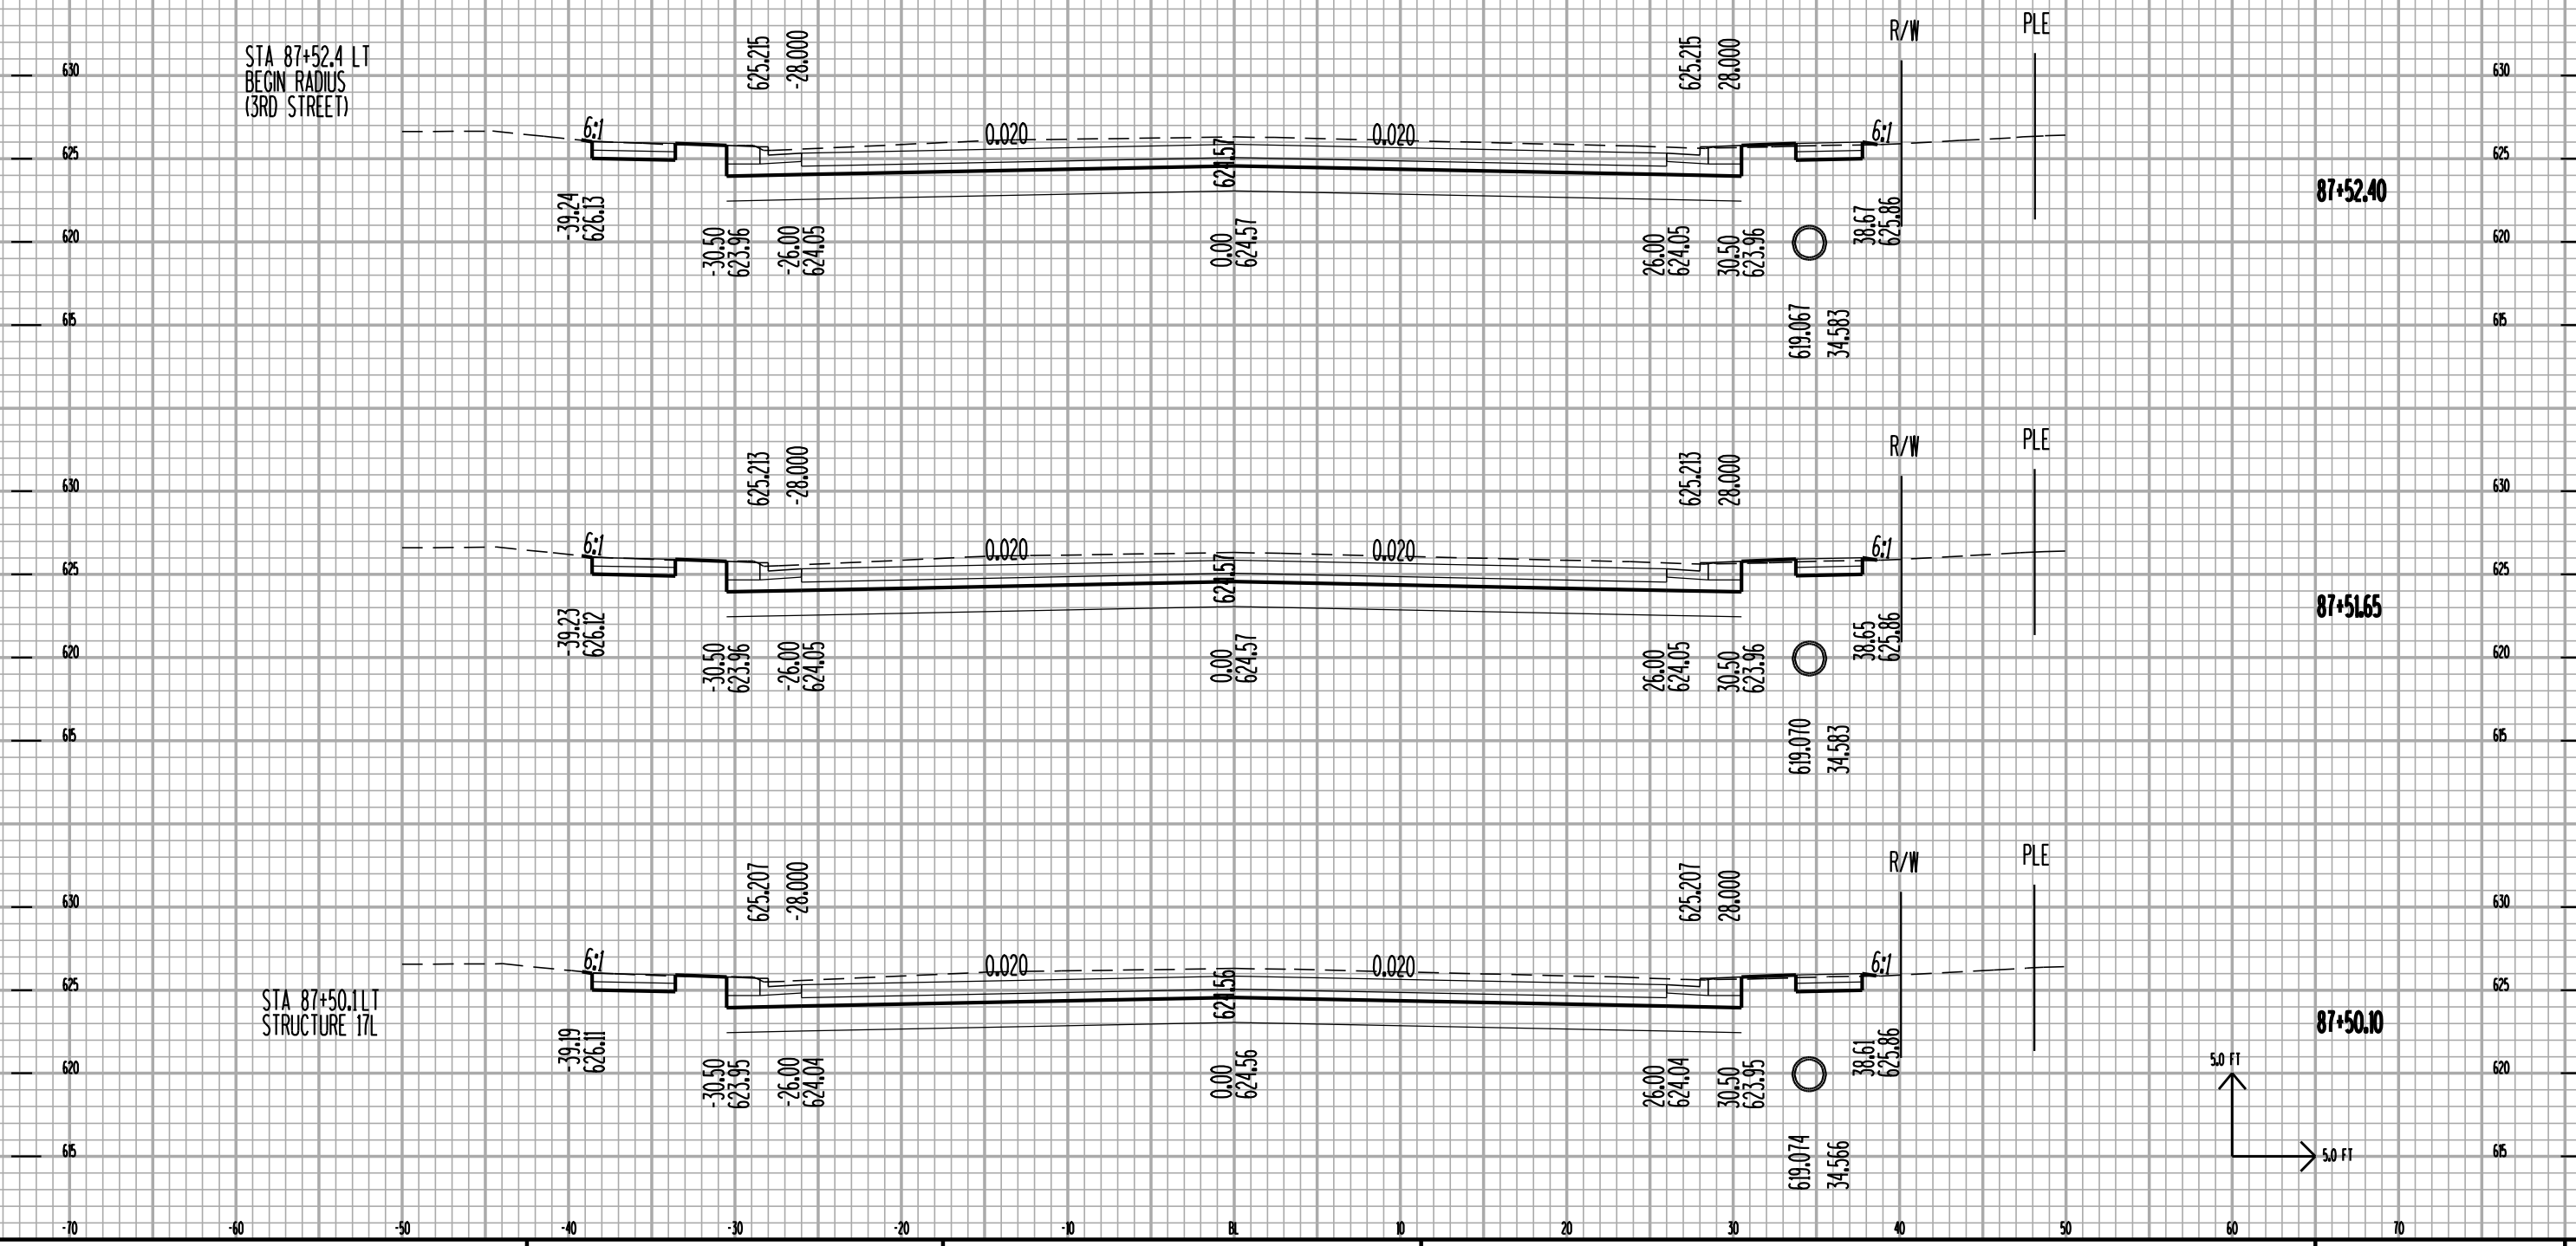



9


9

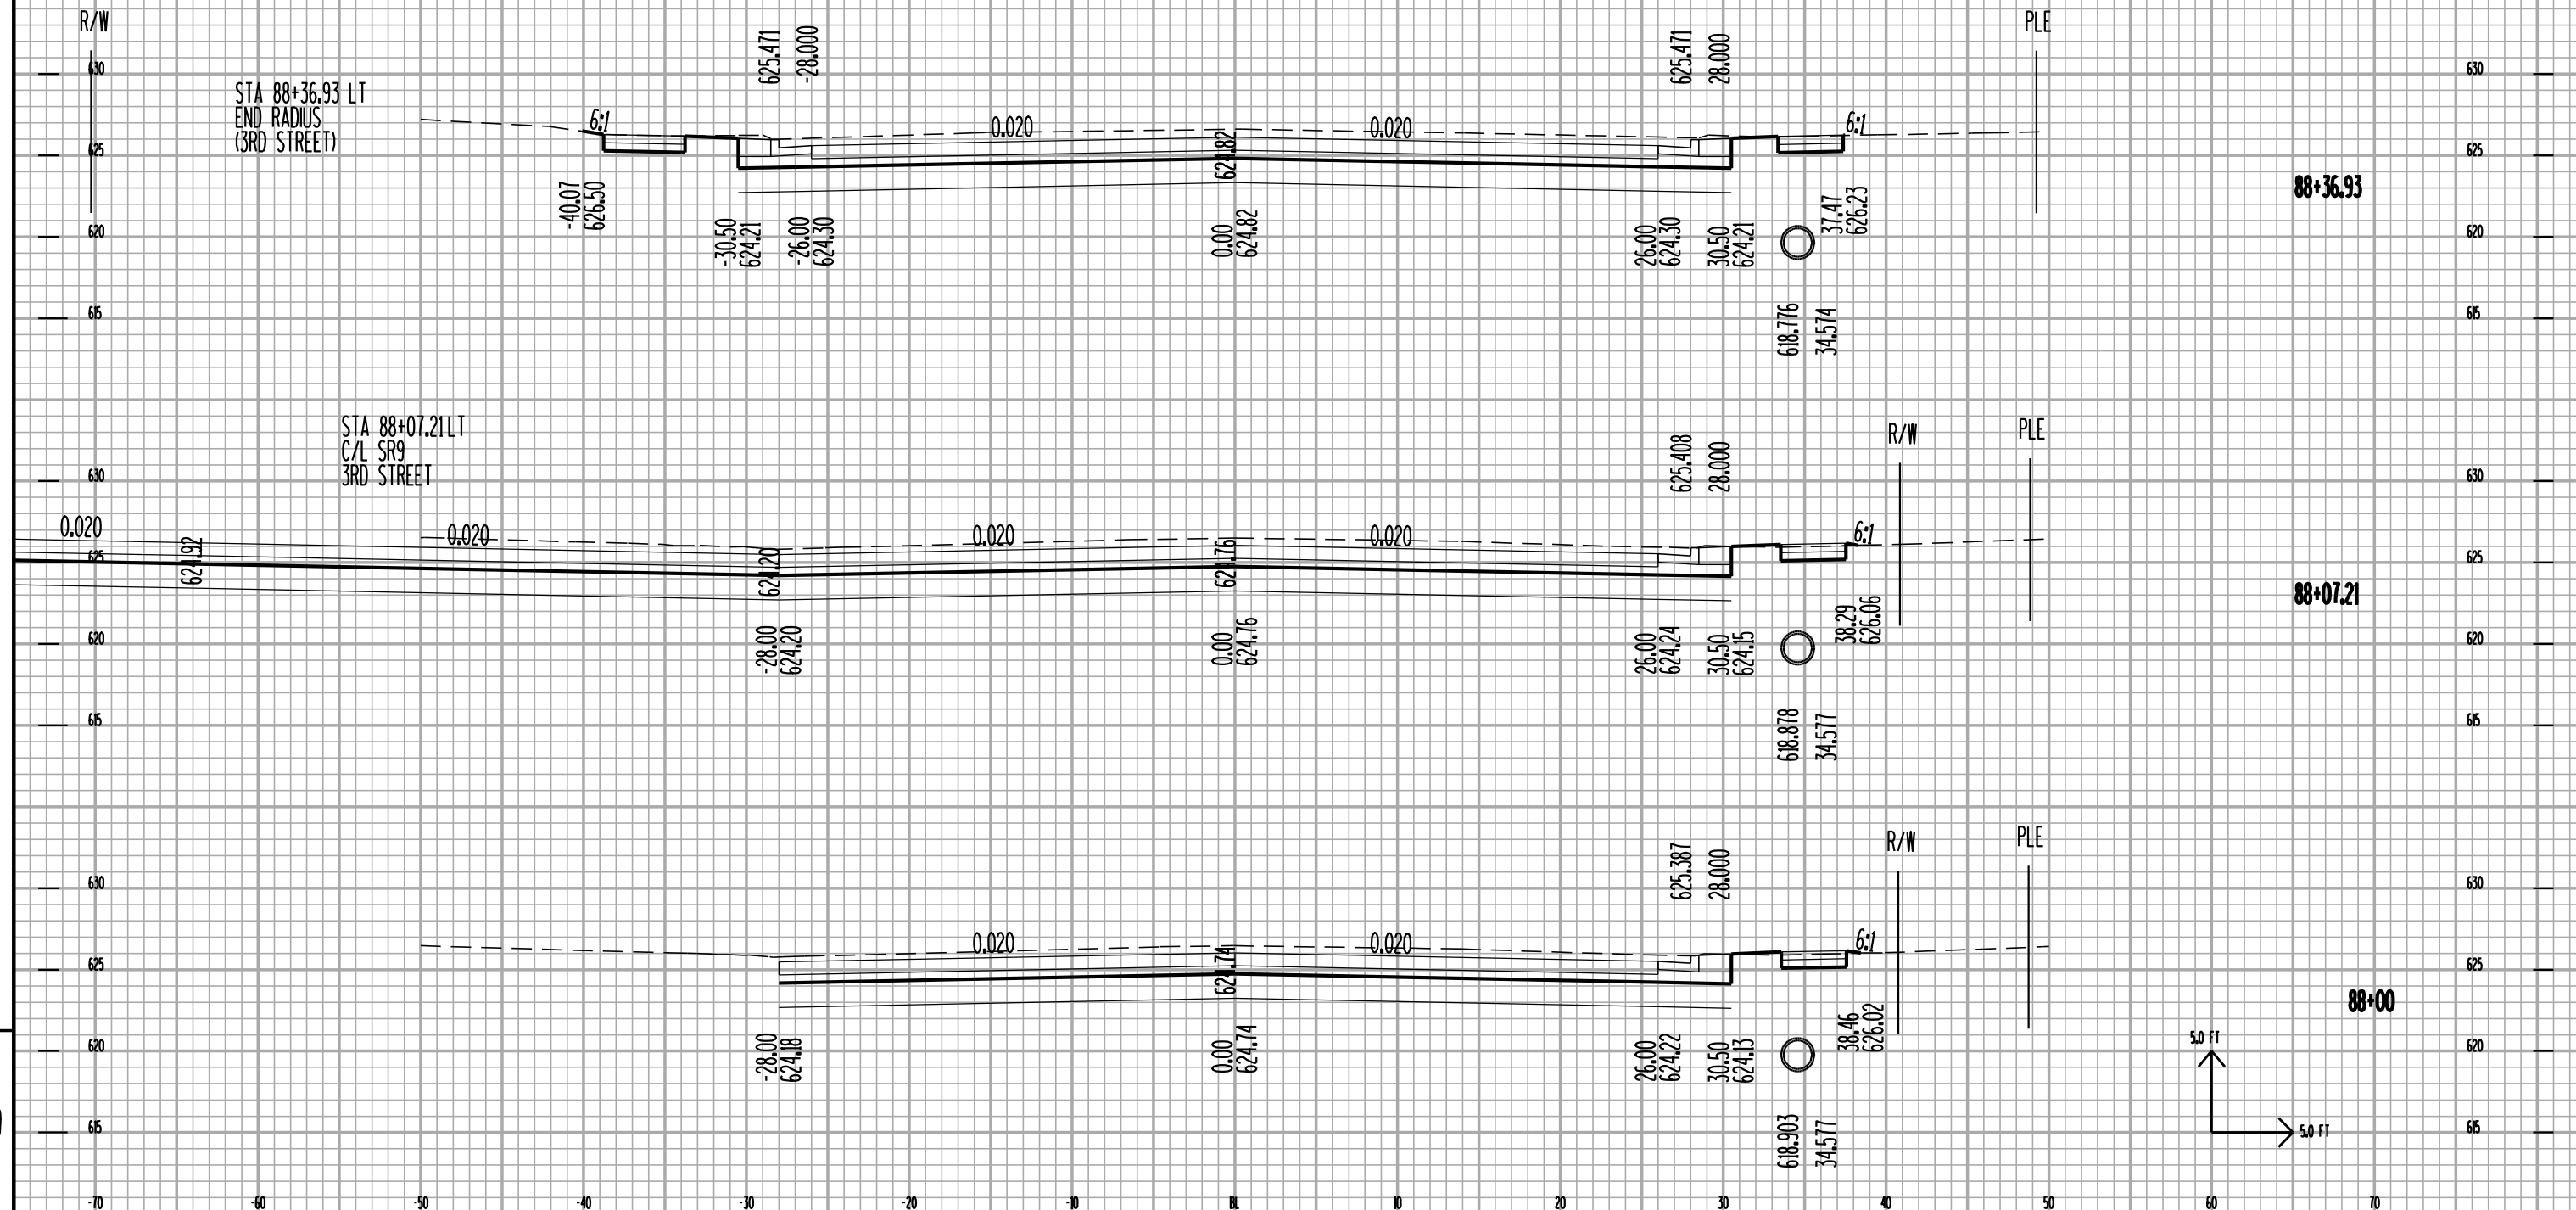


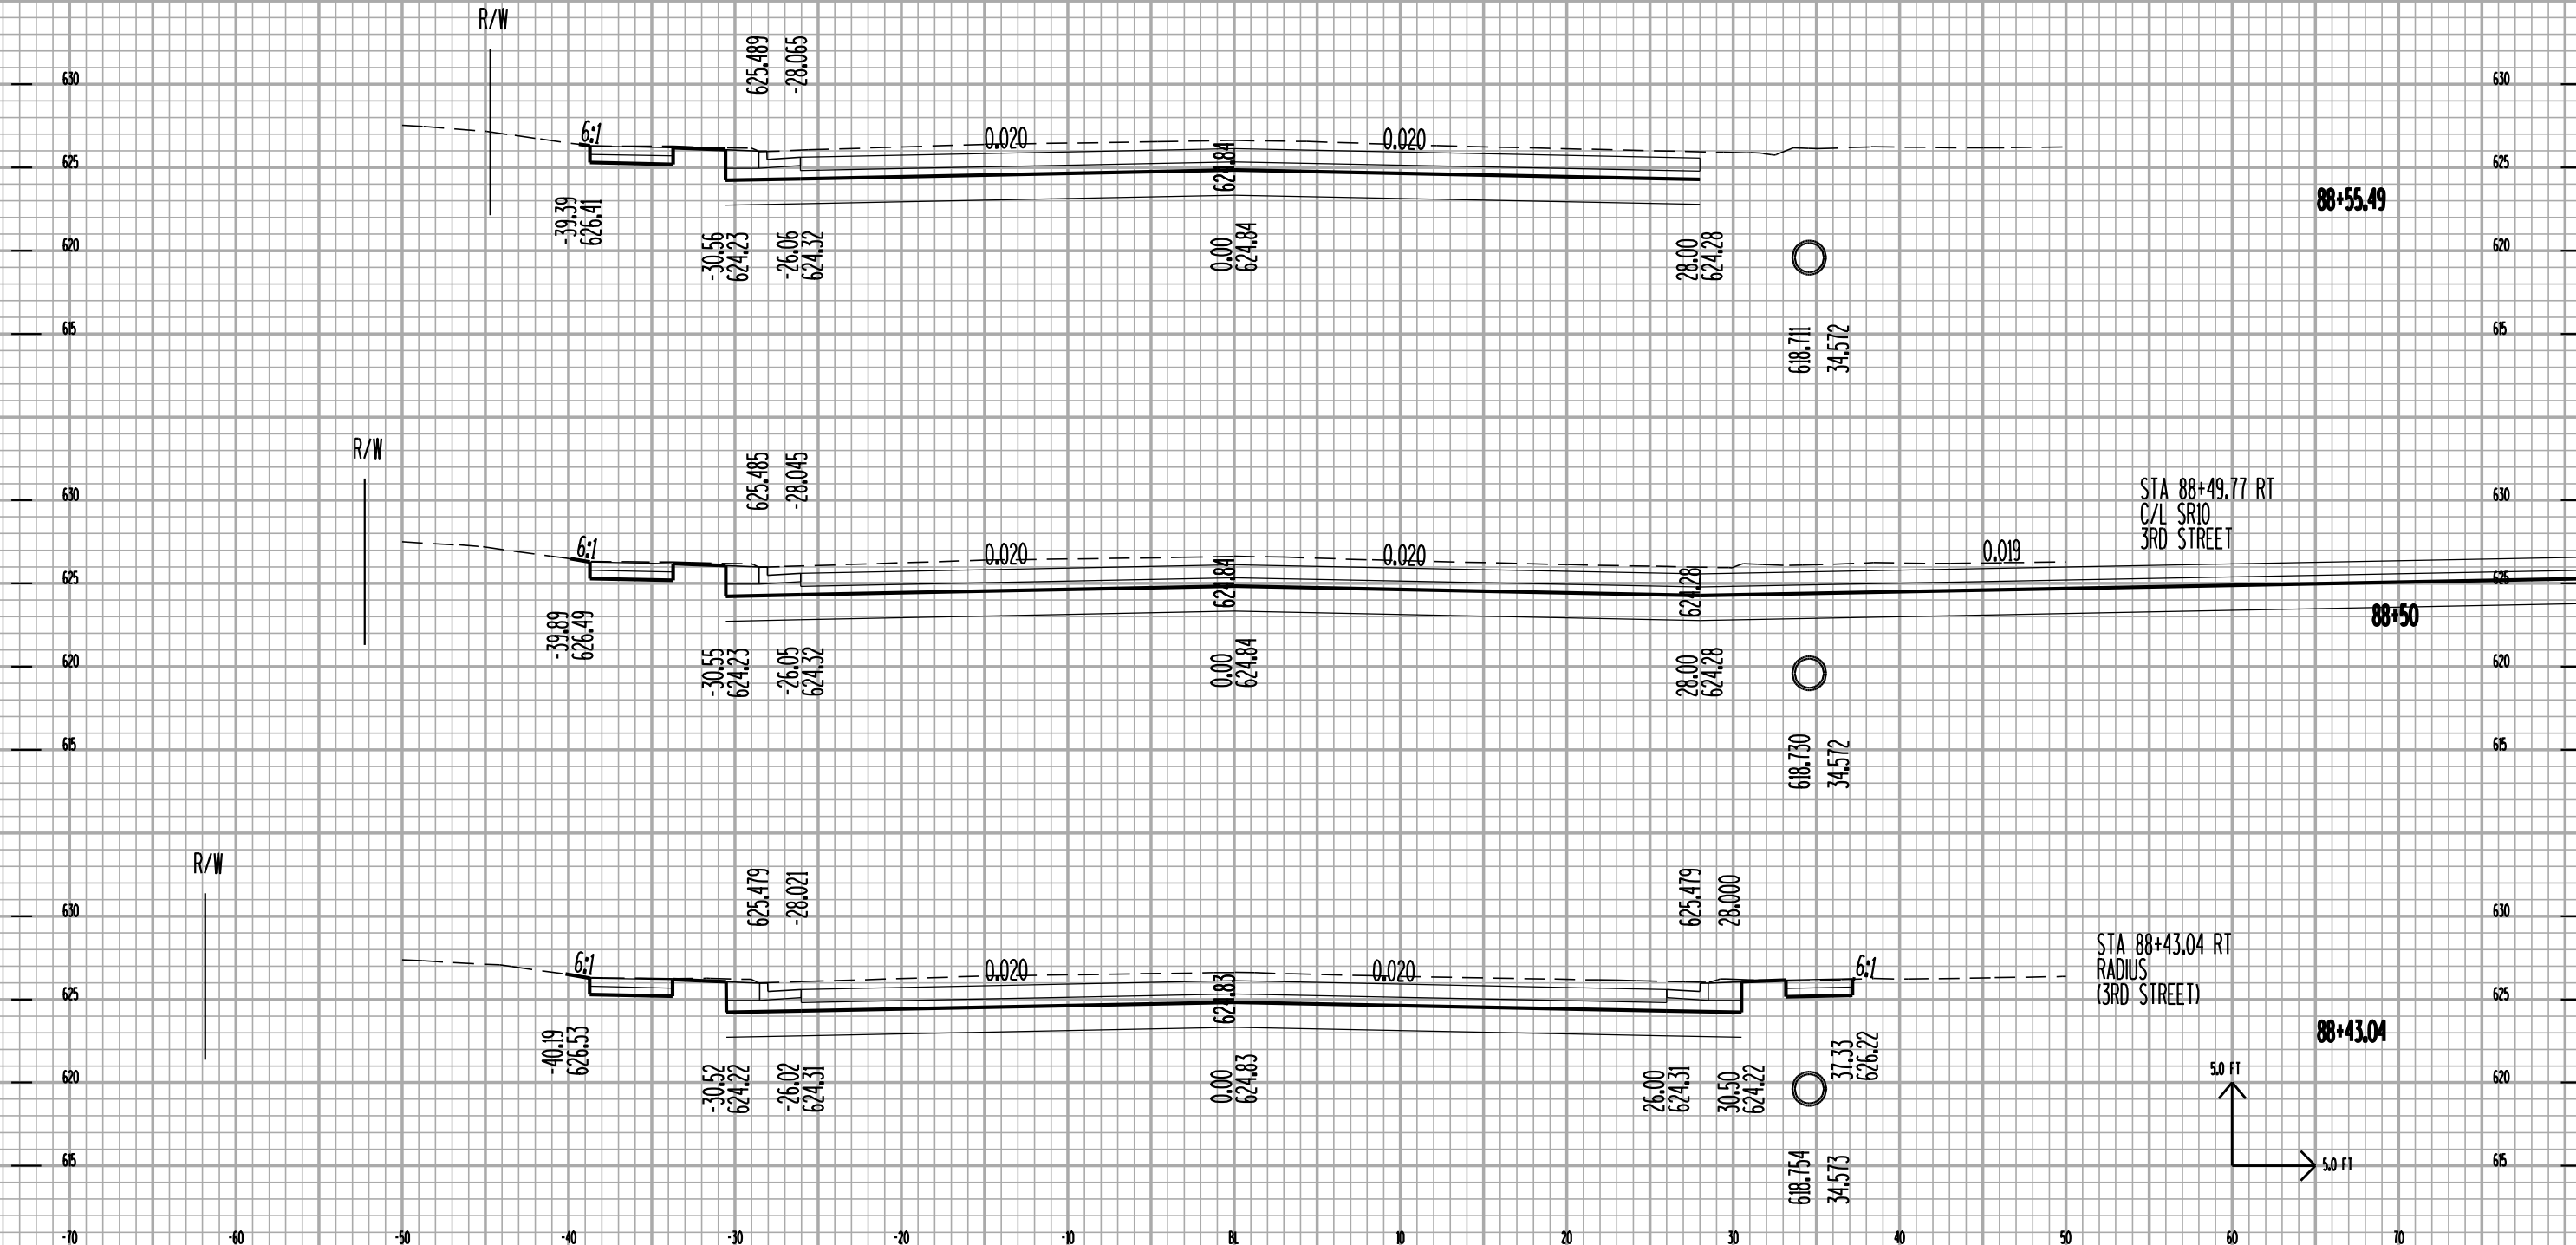

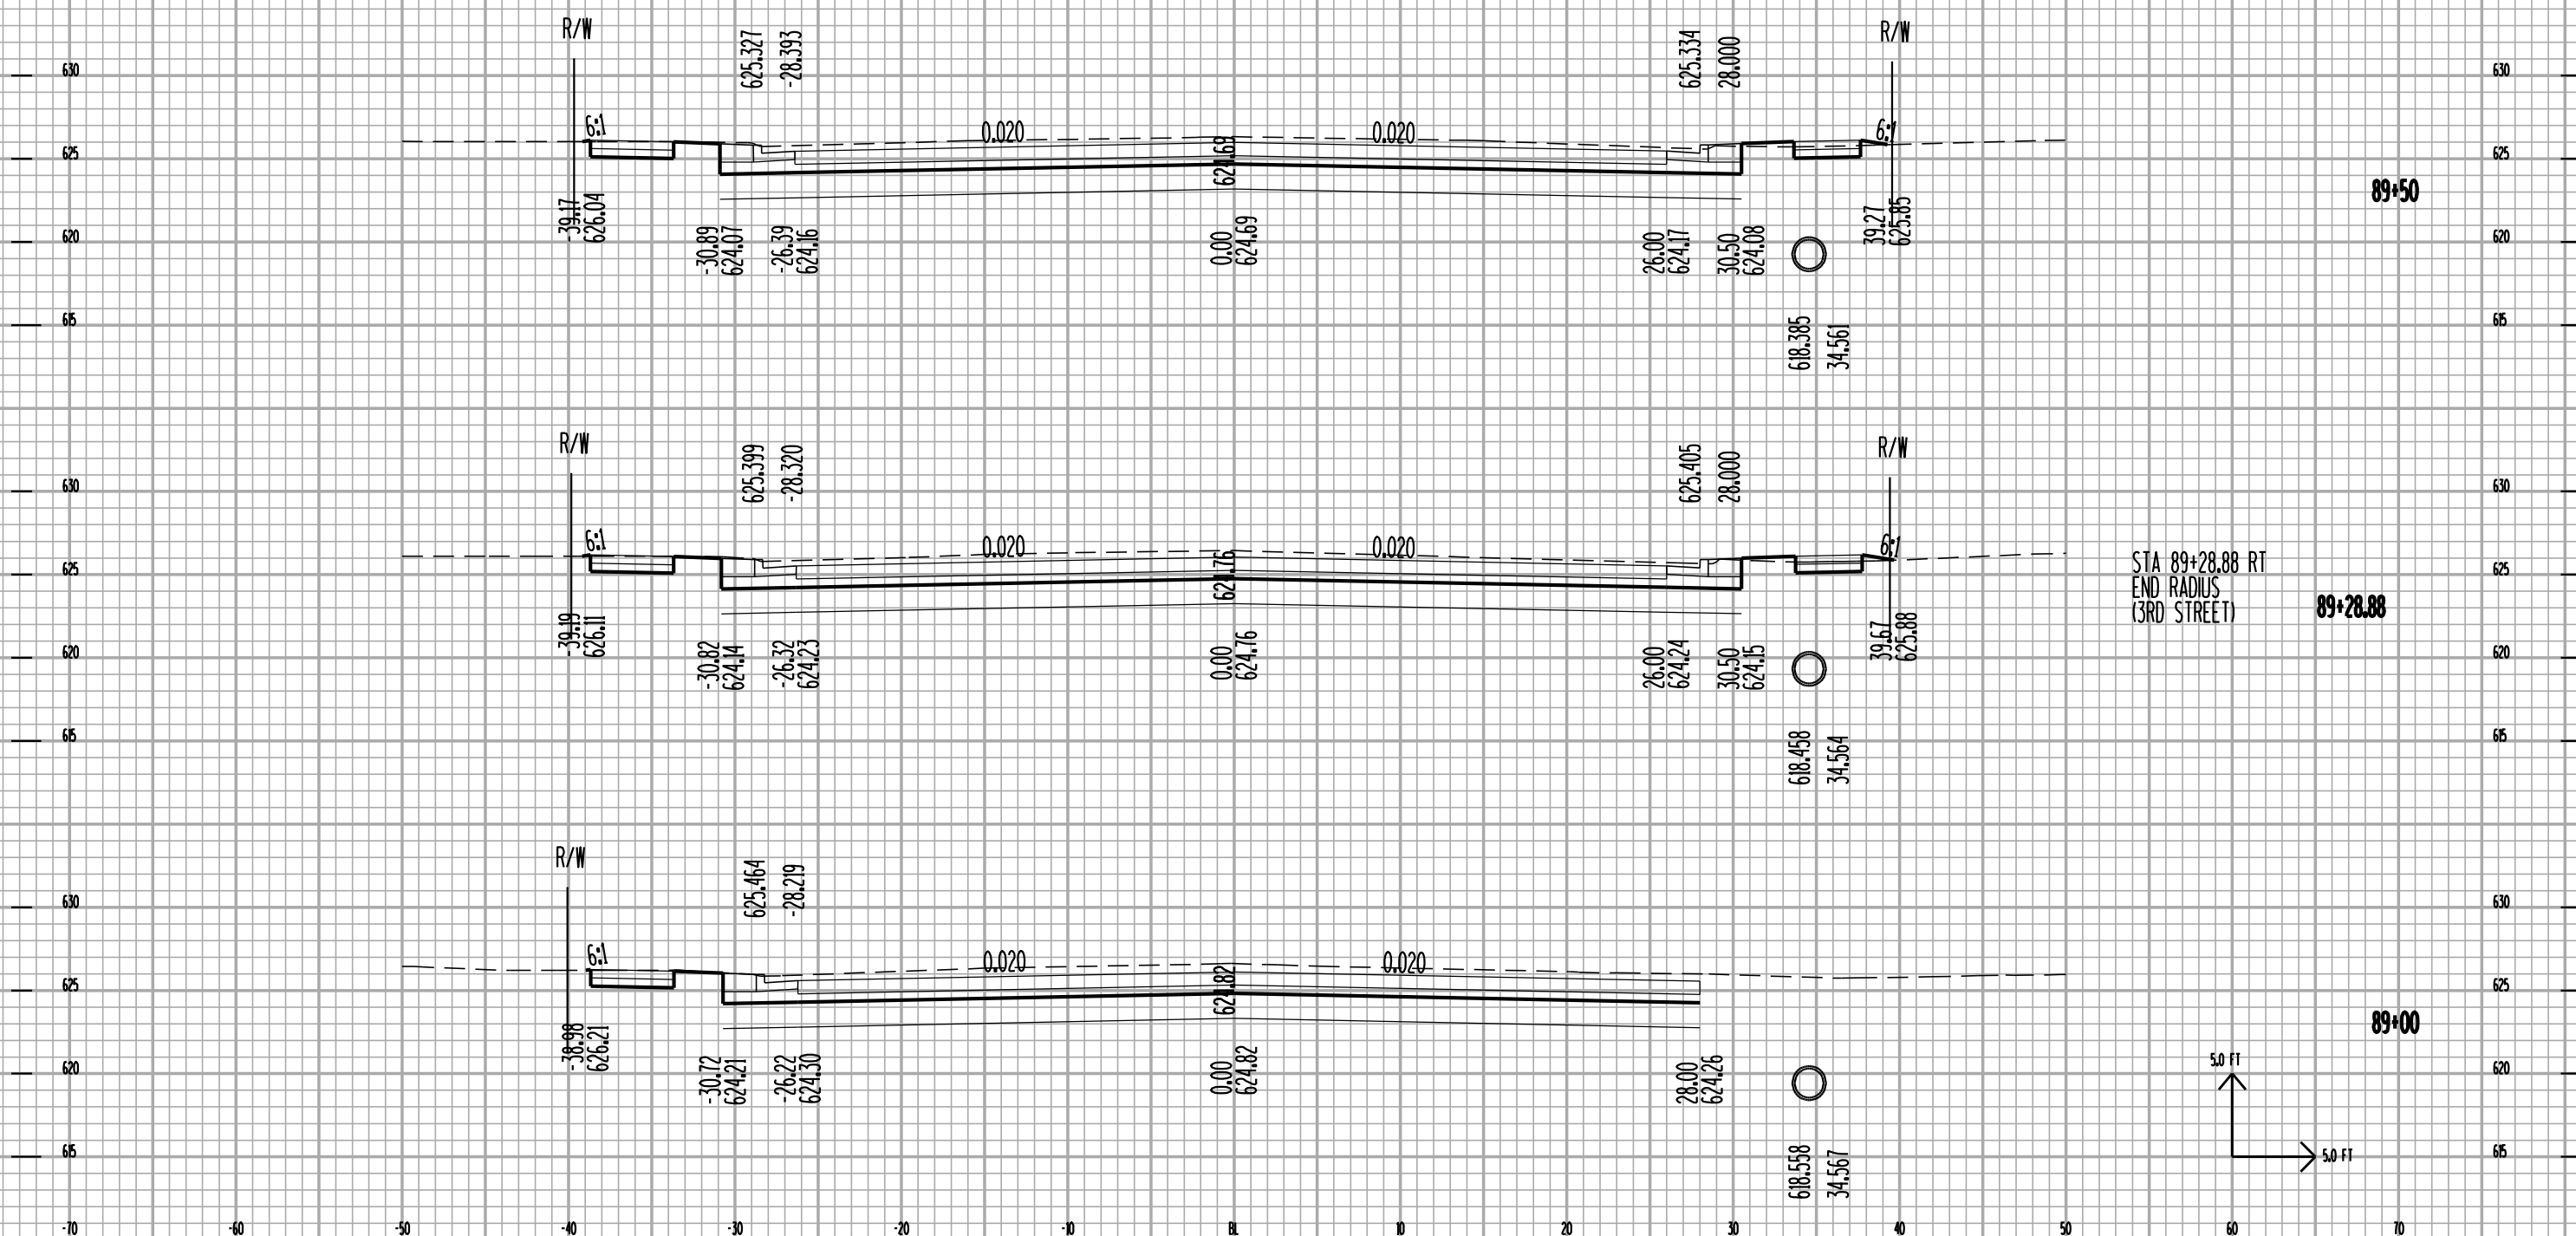


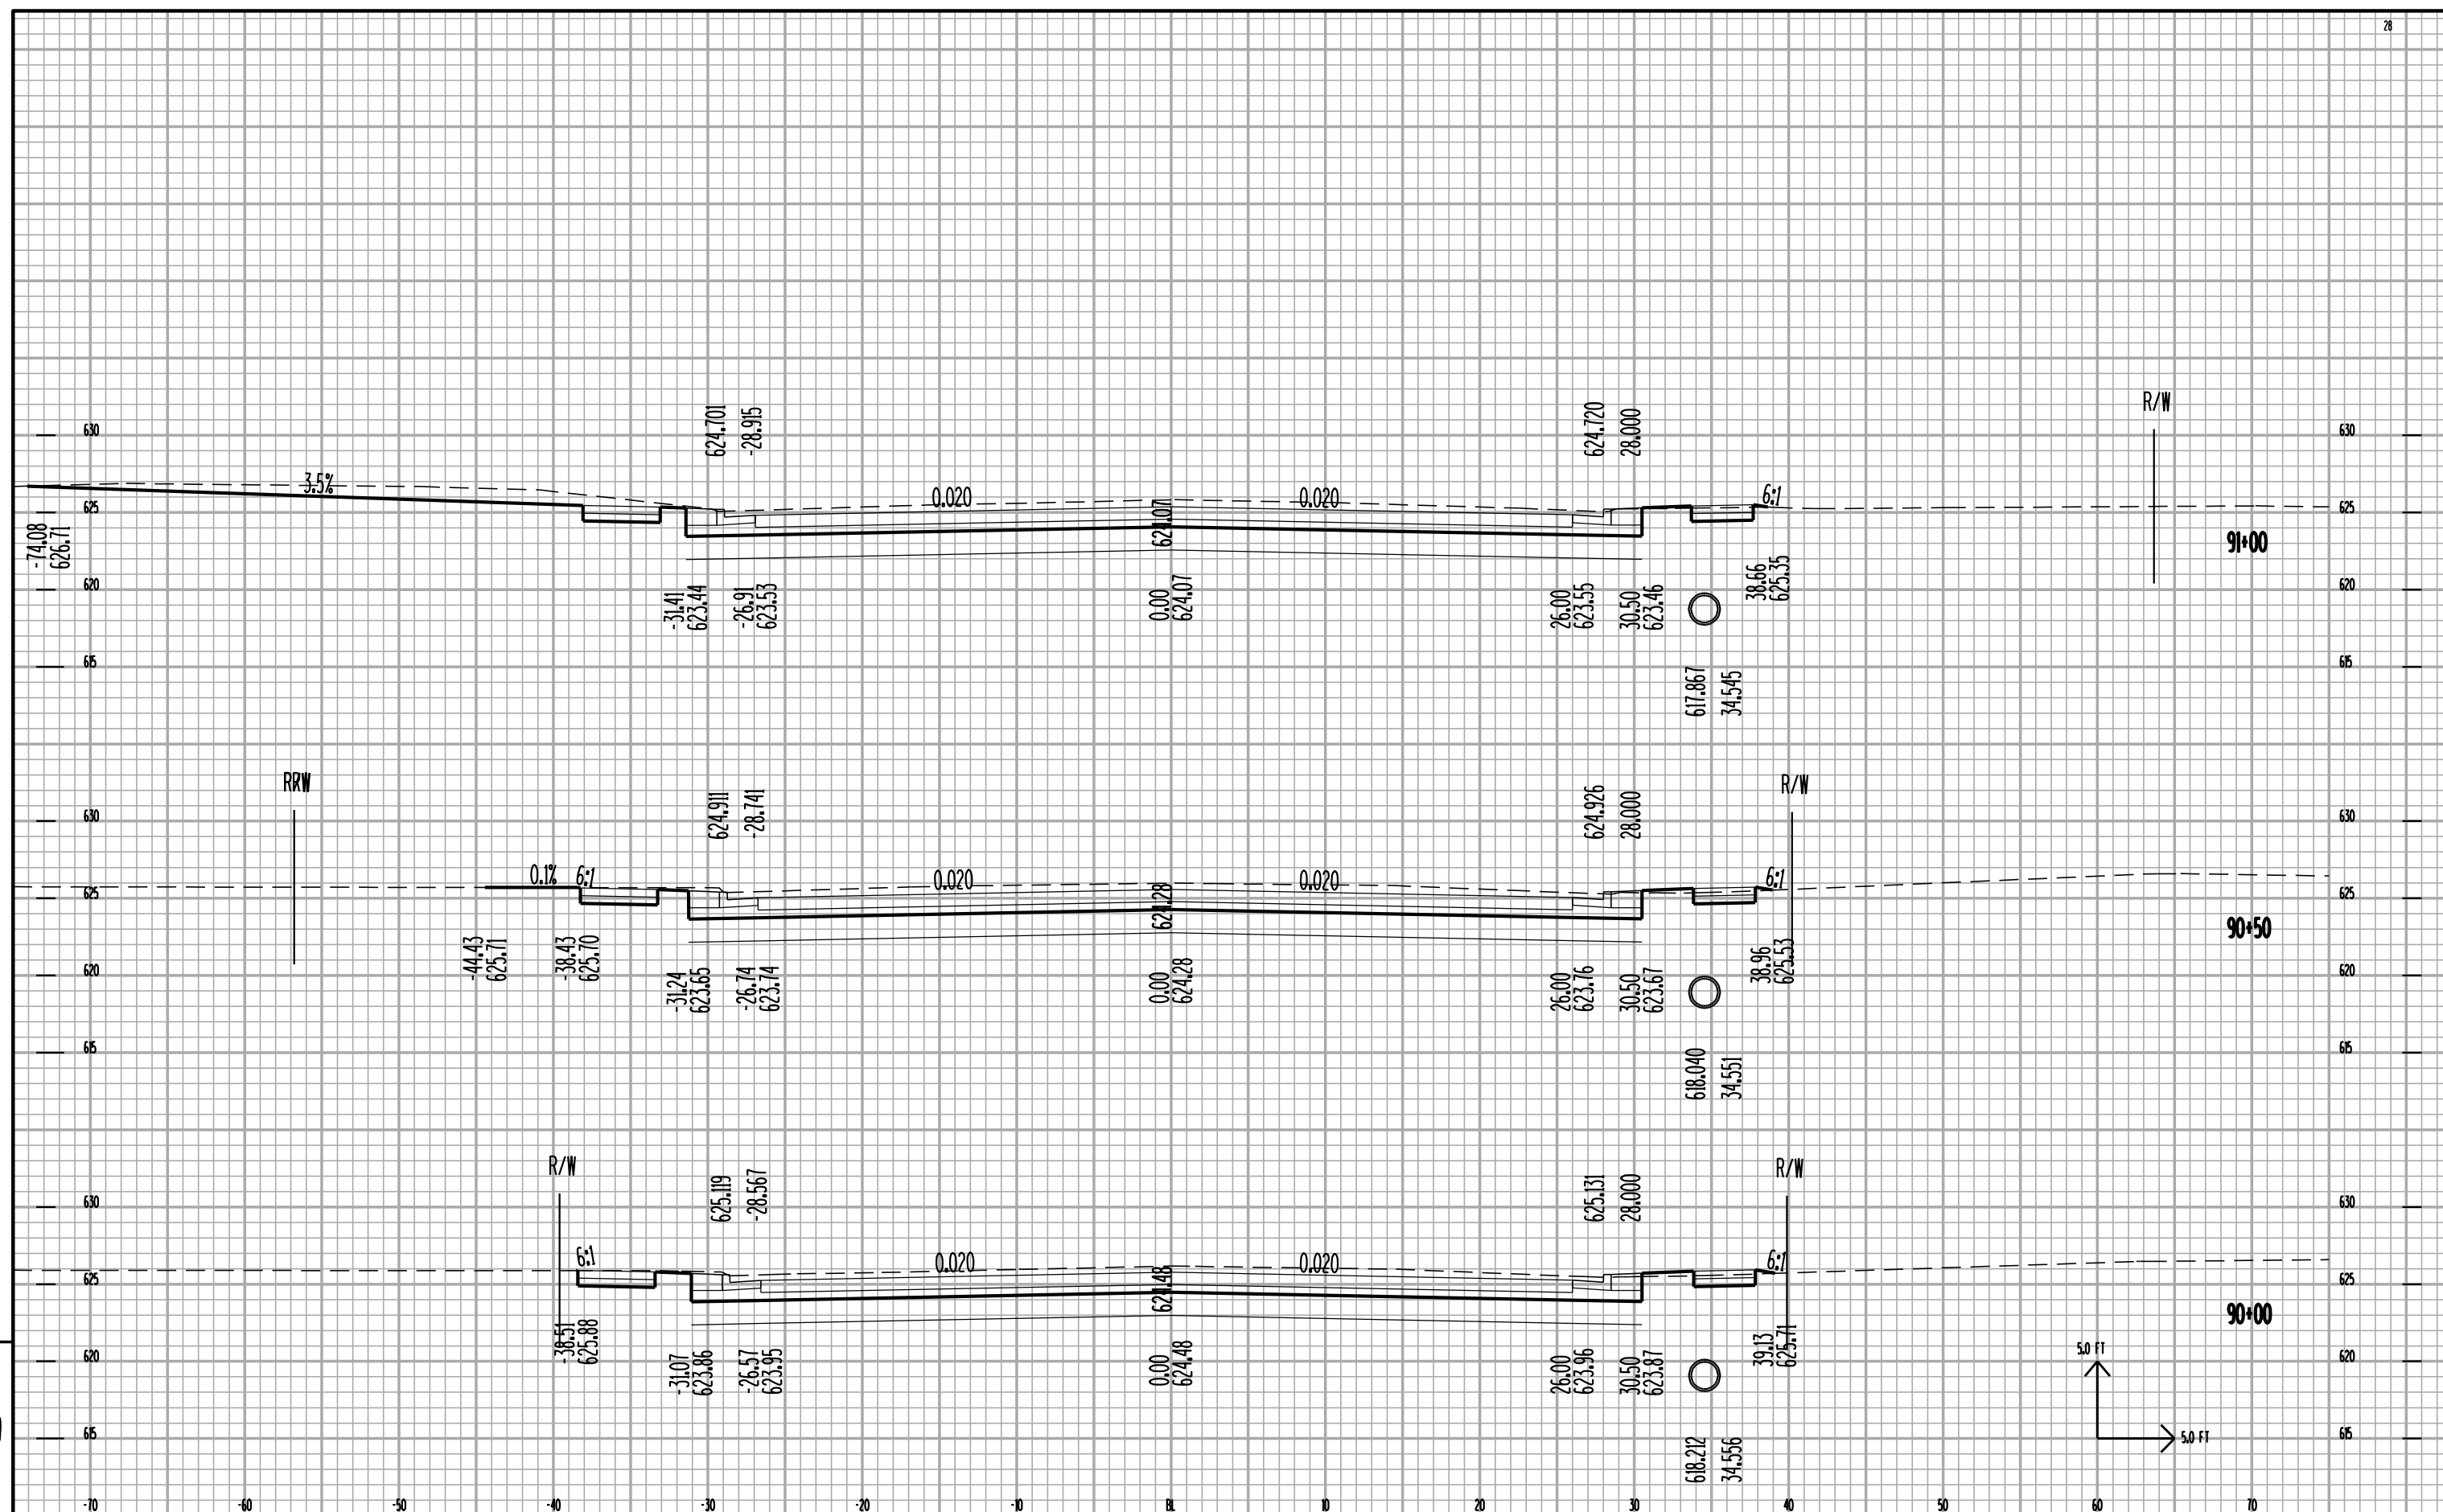

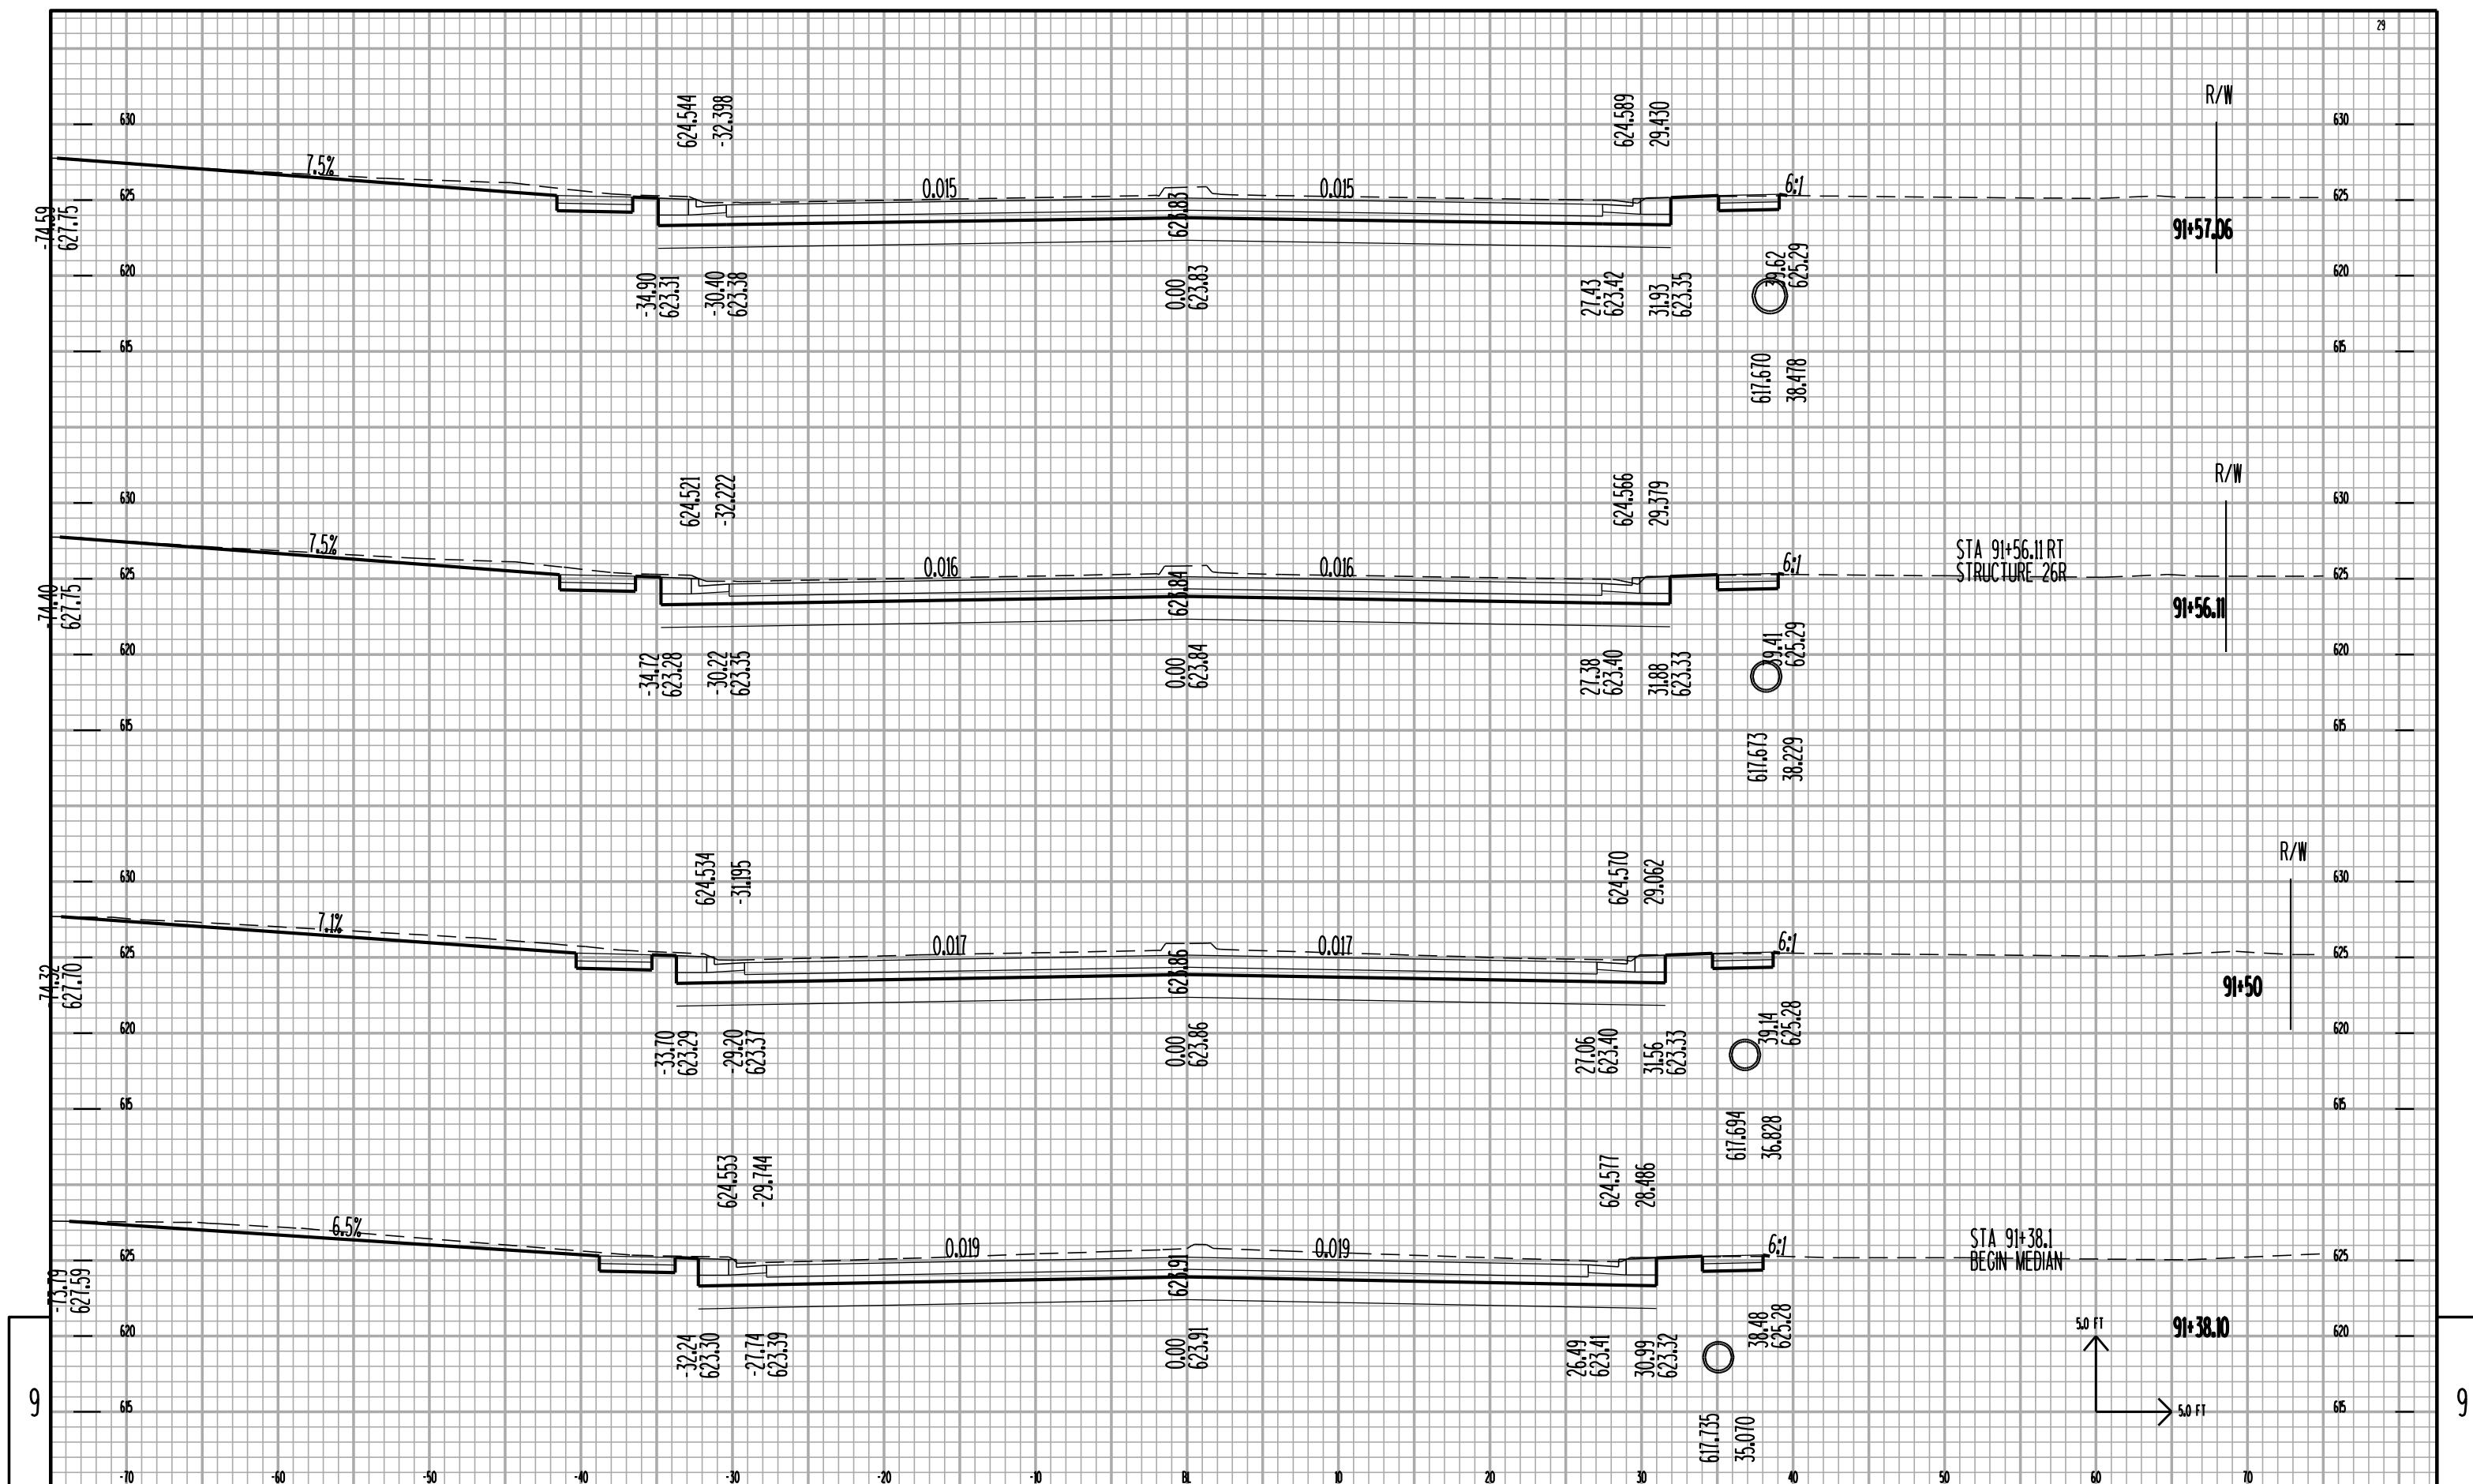

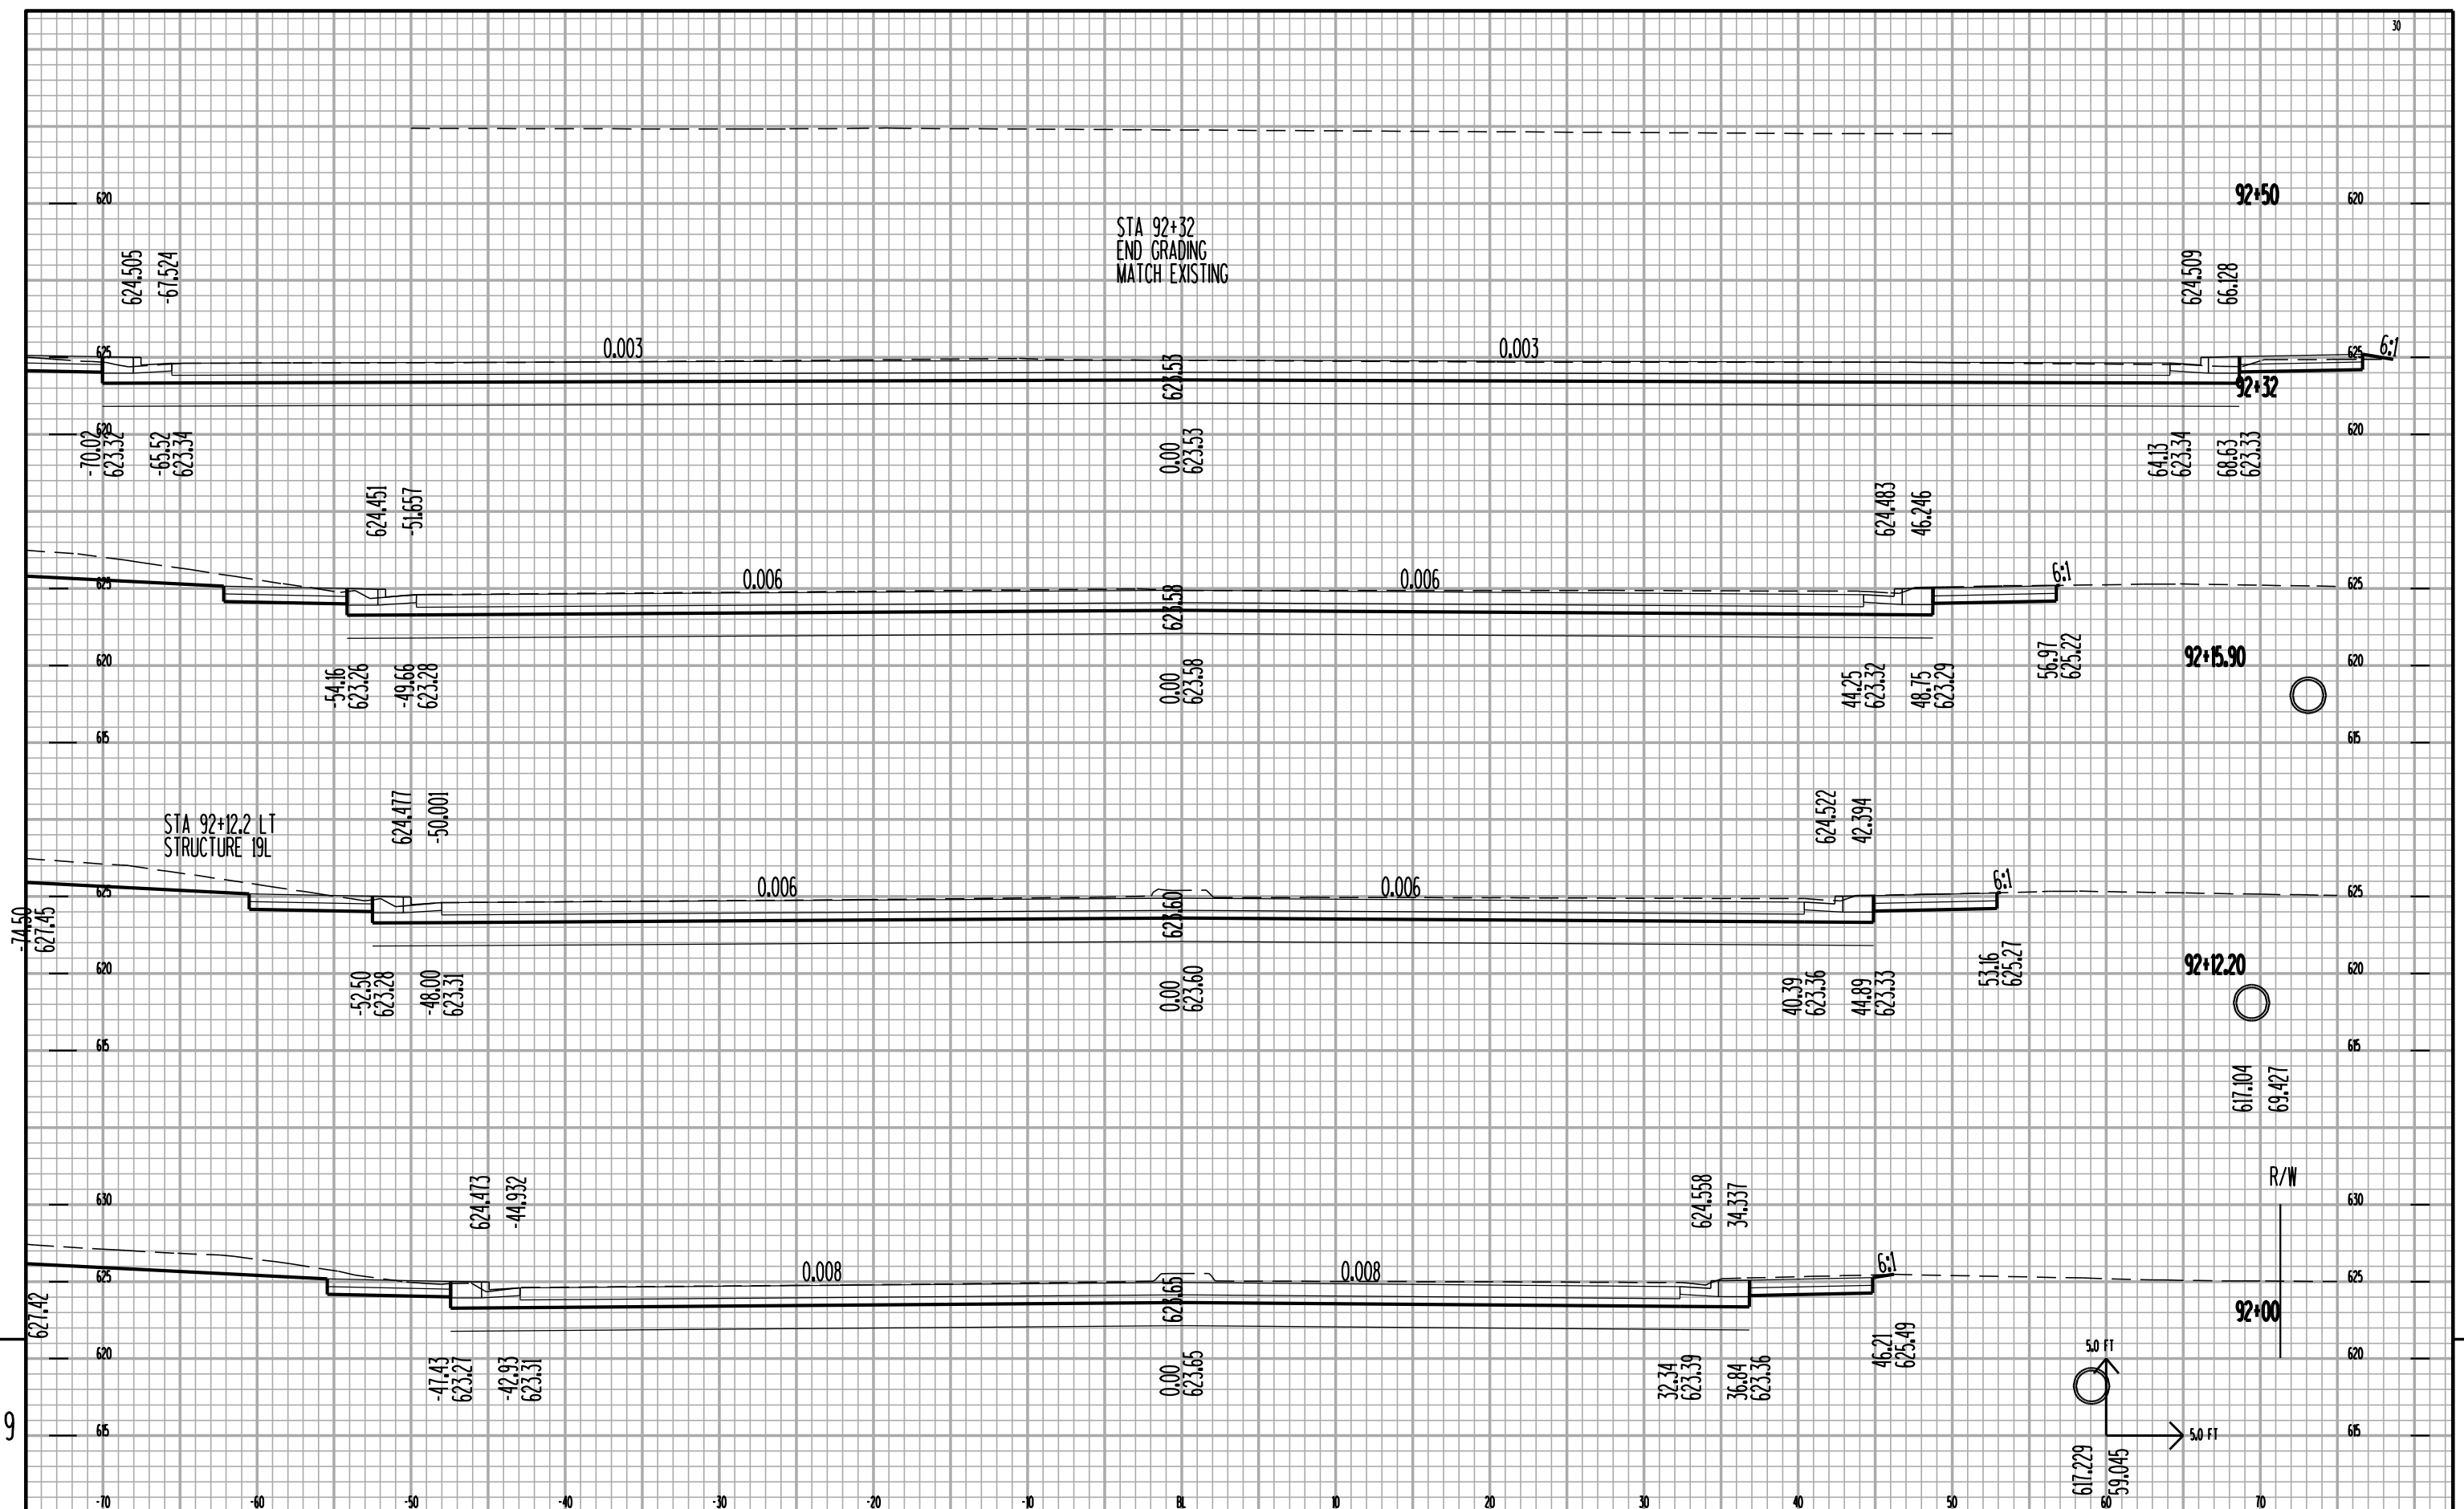



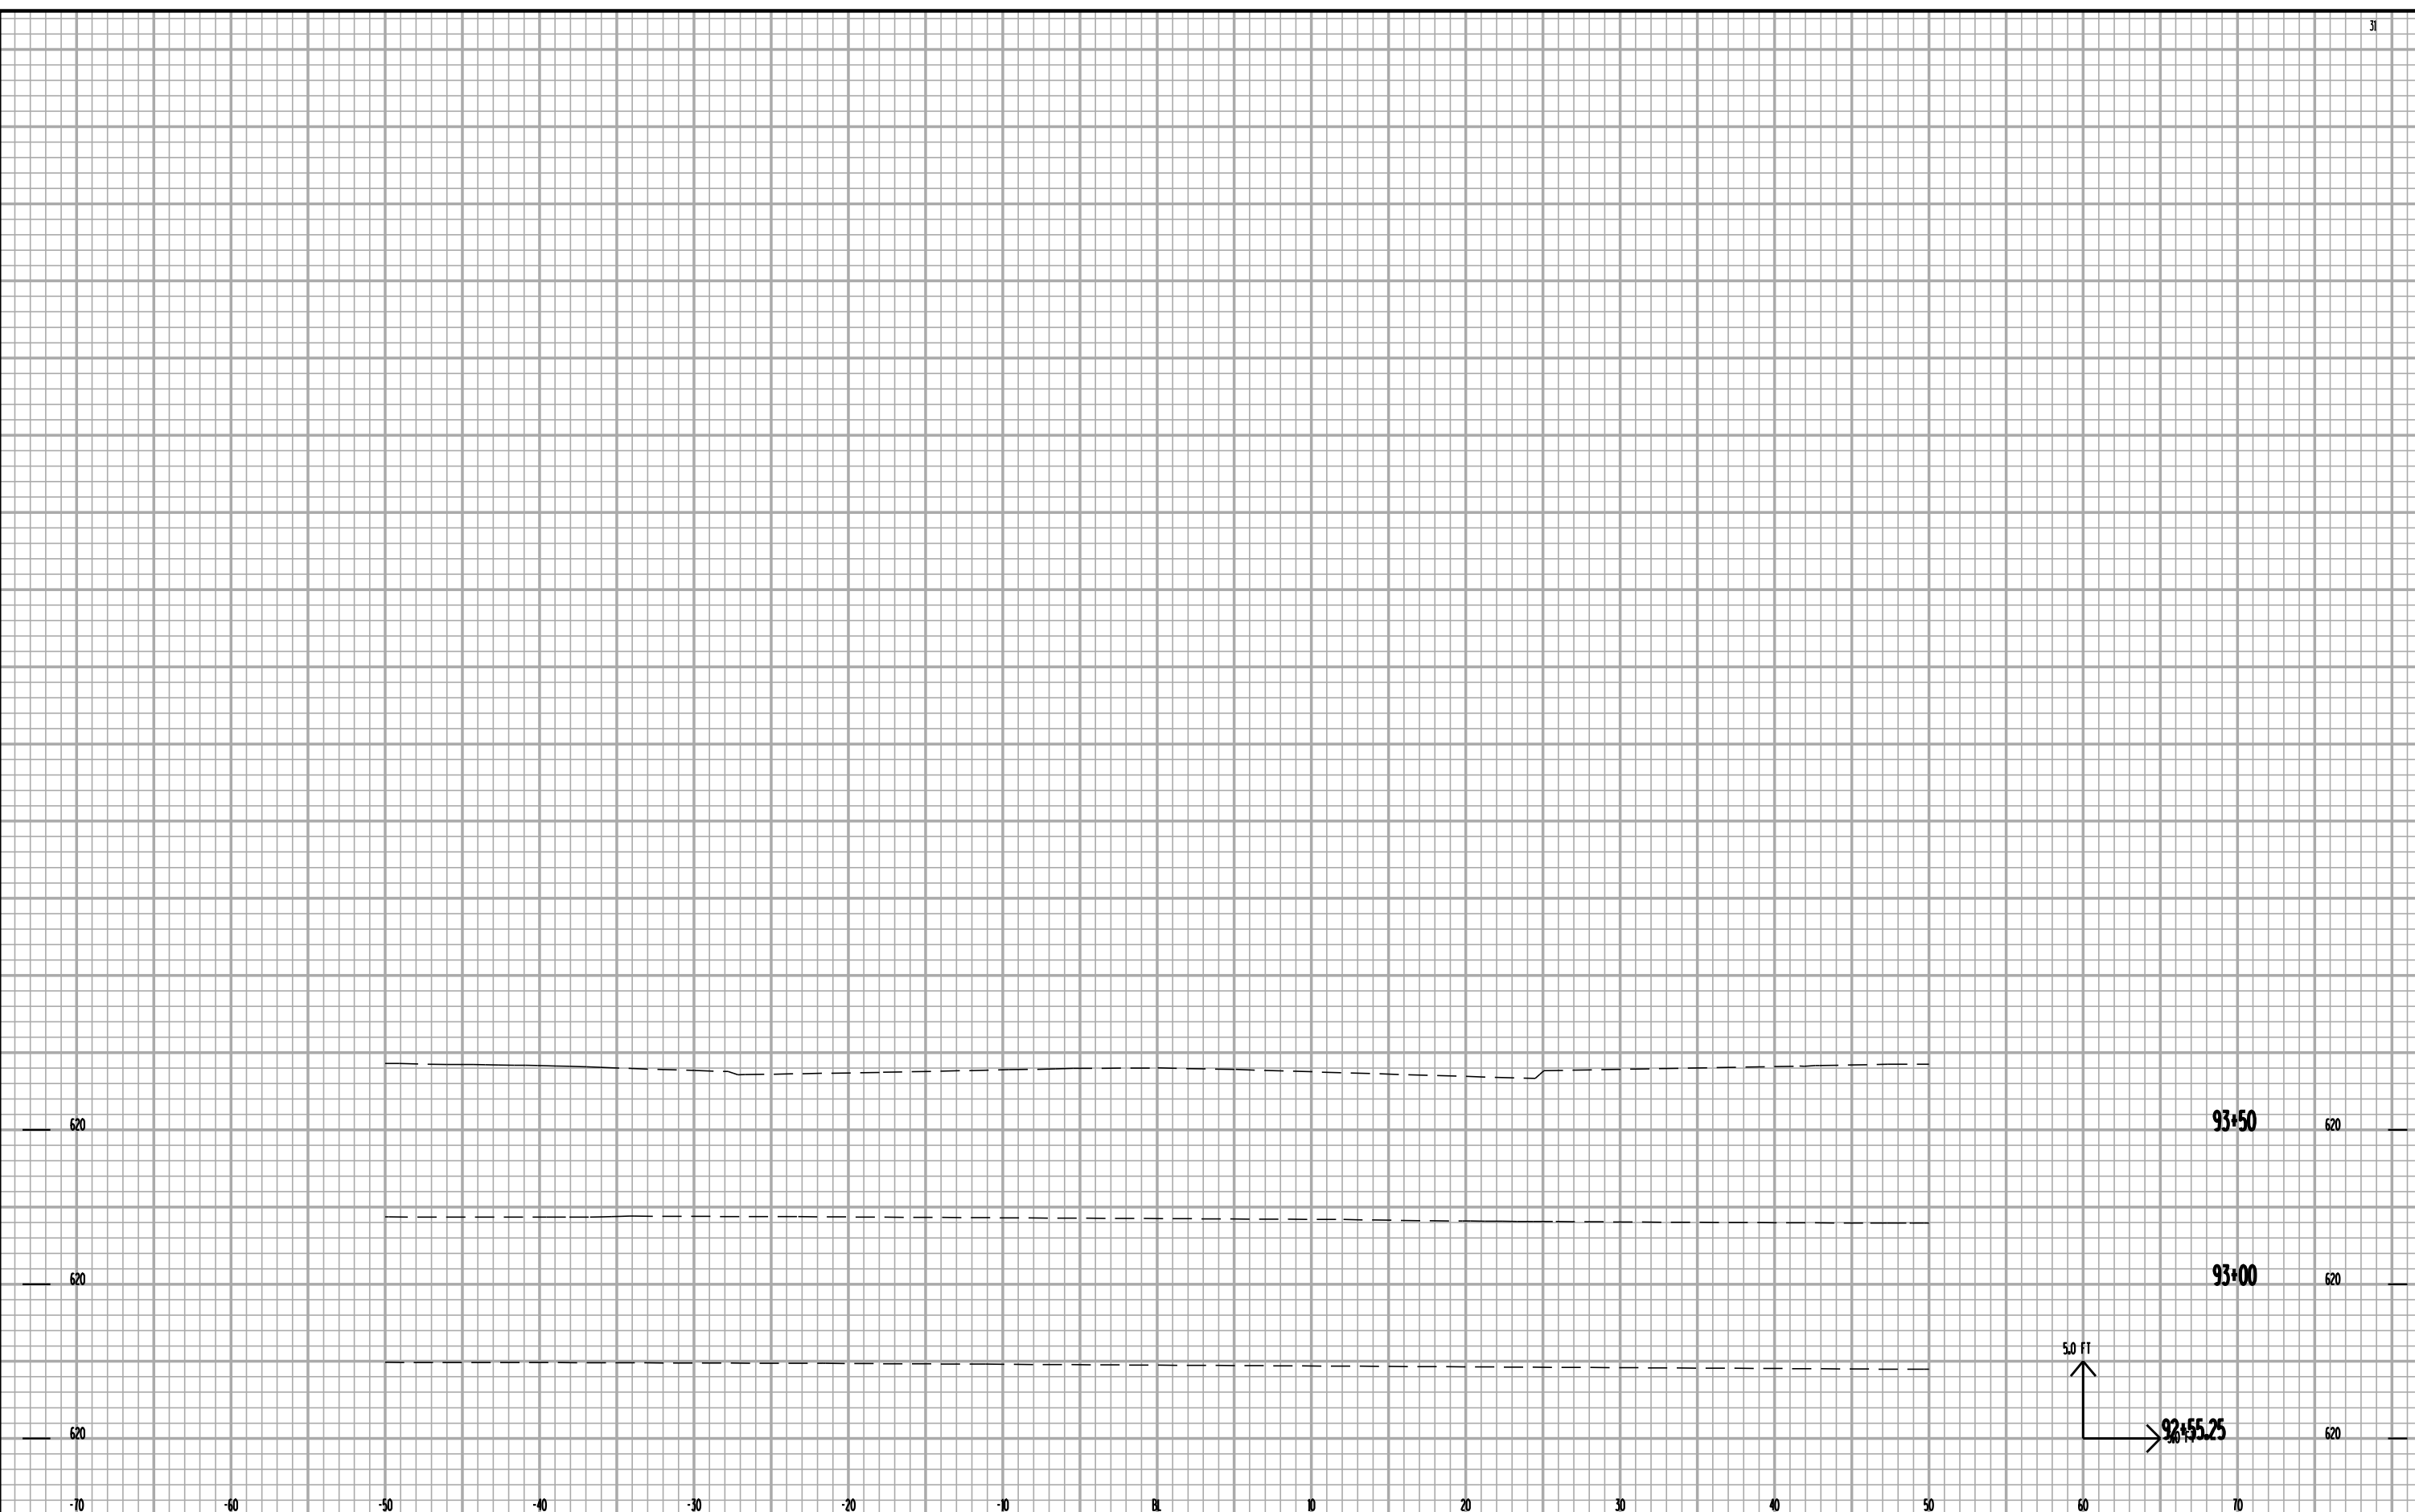

9


9



## *Wisconsin Department of Transportation*


Dedicated people creating transportation solutions through innovation and exceptional service.

<http://www.dot.wisconsin.gov>

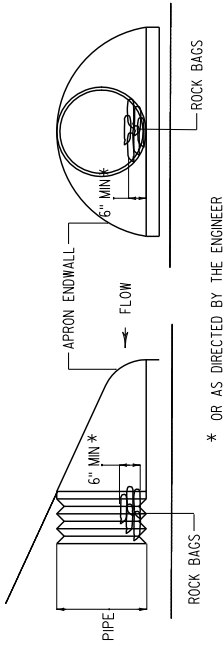


\* OR AS DIRECTED BY THE ENGINEER

CULVERT PIPE CHECK

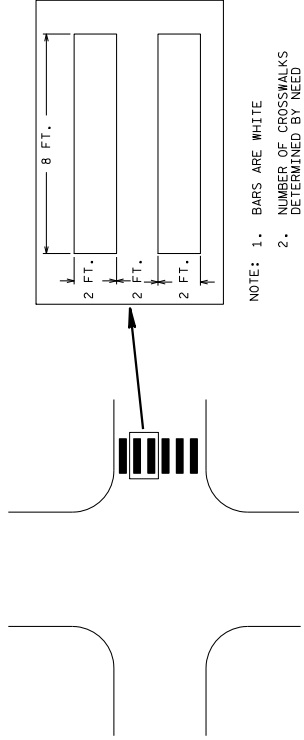


- NOTE:
1. BARS ARE WHITE
  2. NUMBER OF CROSSWALKS DETERMINED BY NEED
  3. NUMBER OF BARS IS DETERMINED BY HIGHWAY WIDTH

DETAIL FOR PAYMENT MARKING, CROSSWALK, EPOXY SPECIAL


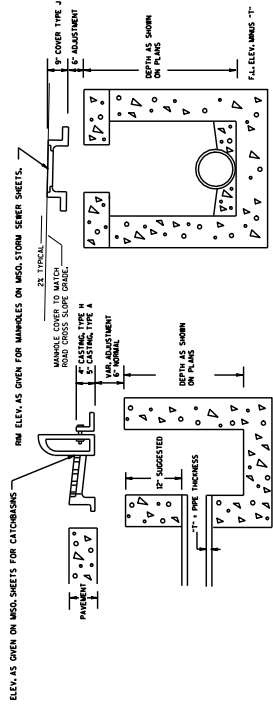


PIPE I.D.	"-"
12"	0.11'
24"	0.23'

1190-44-71  
Addendum #1  
Revised Sheet 9  
6/6/2011

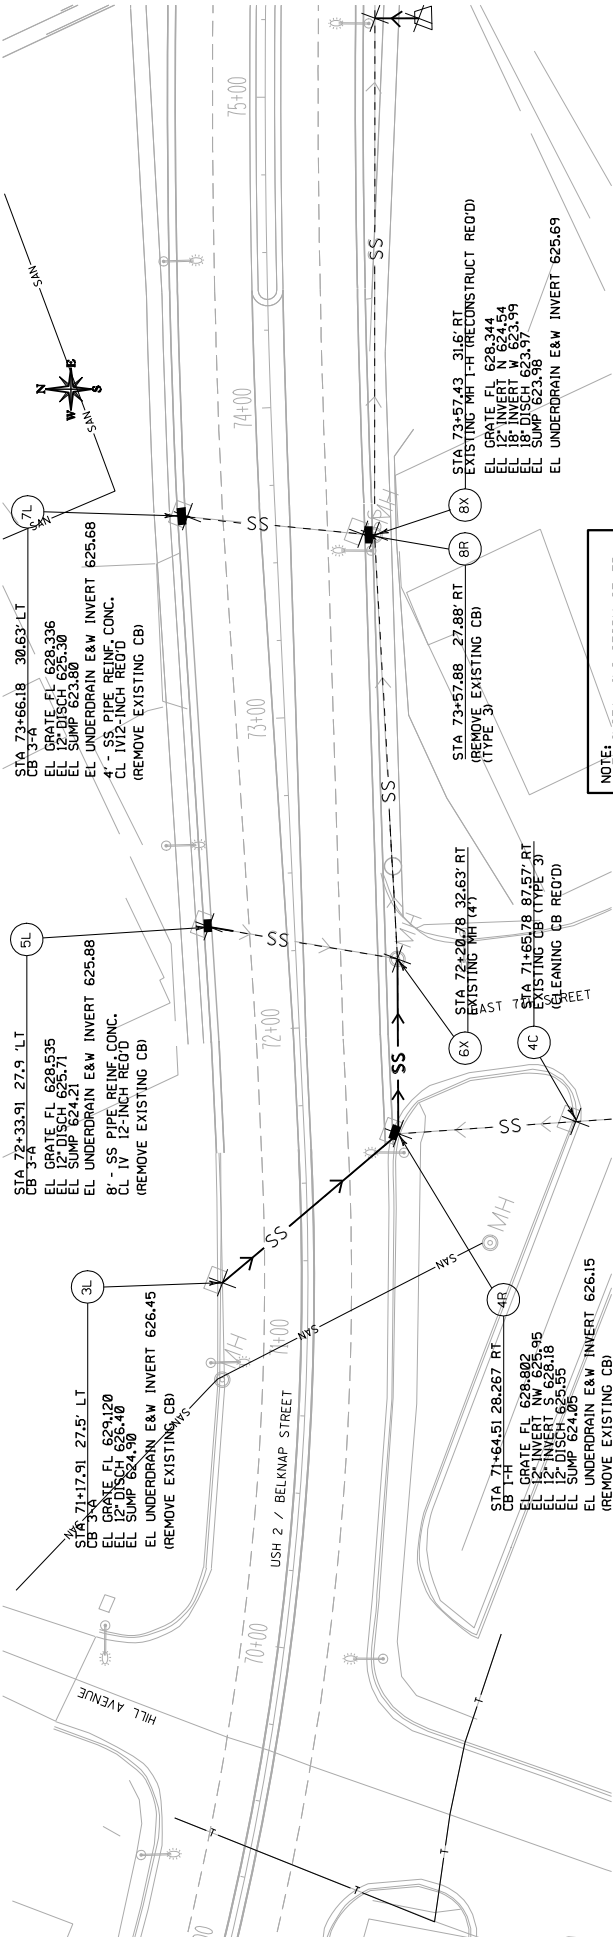


NOTE: WHEN INSTALLING STORM SEWER, AND OTHER UTILITIES, ALL TOLERANCES AND OTHER SPECIFICATIONS COLLECTED ARE NOT ACCOUNTED FOR WITH A BID ITEM ARE INCIDENTAL TO THIS PROJECT. CONTRACTOR PIPE REINFORCED CONCRETE CL IV.

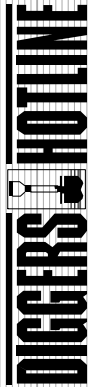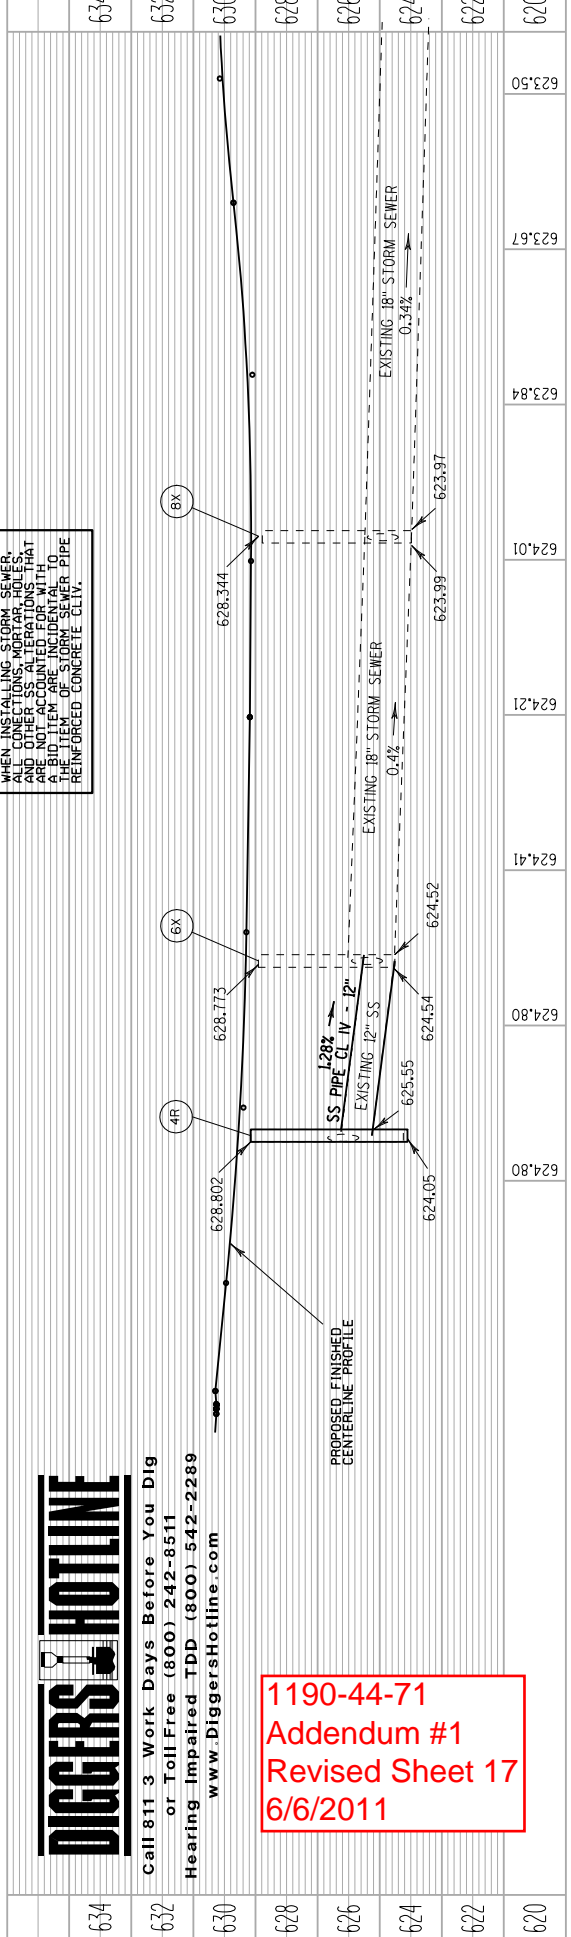


Call 811 3 Work Days Before You Dig  
or Toll Free (800) 242-8511  
Hearing Impaired TDD (800) 542-2289  
www.DiggersHotline.com

1190-44-71  
Addendum #1  
Revised Sheet 17  
6/6/2011

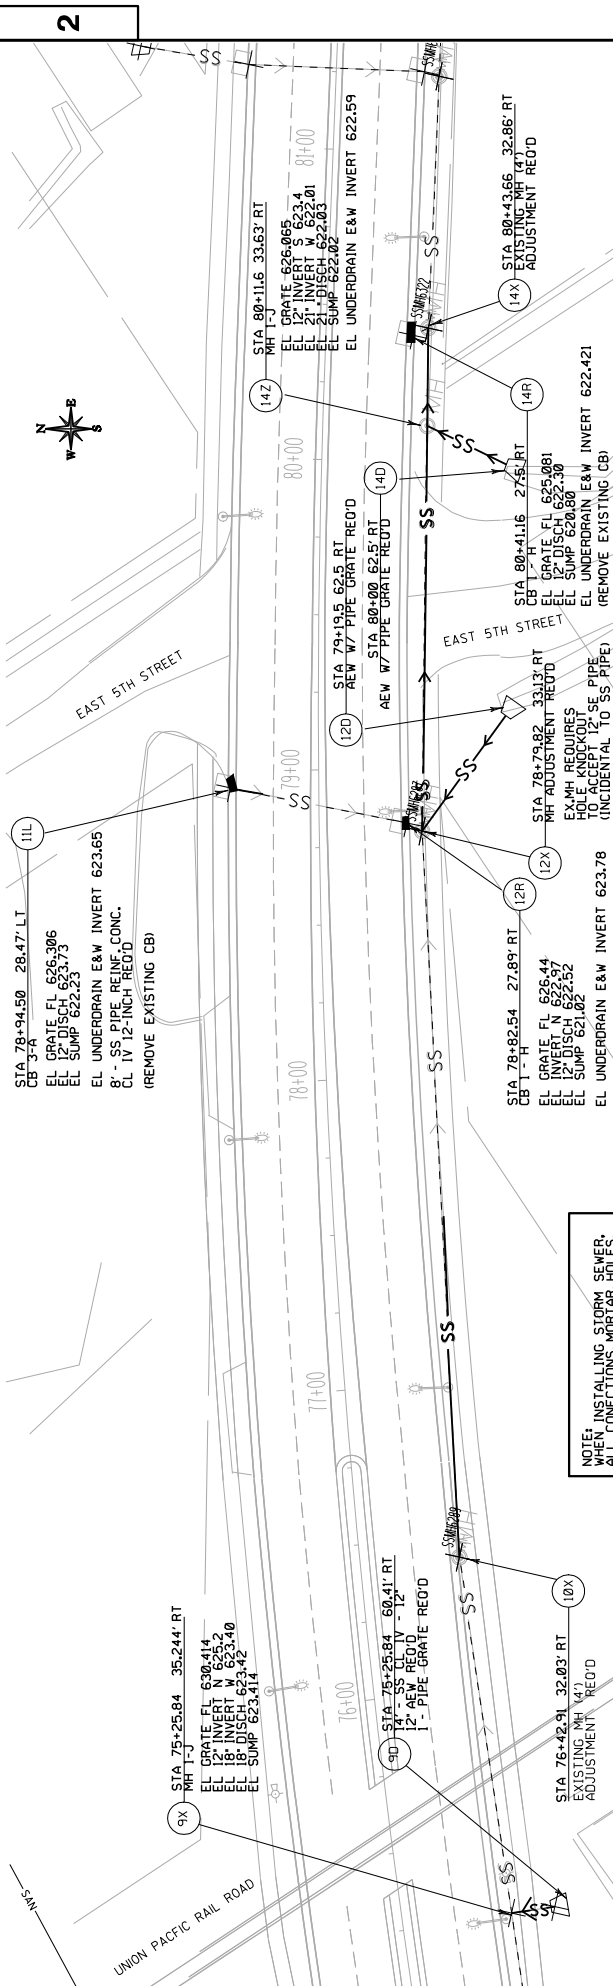

NOTE: INSTALLING STORM SEWER, WHEN CONSTRUCTION APPROXIMATIONS AND OTHER SS ALTERATIONS THAT ARE NOT ACCOUNTED FOR WITH THE 10% ALLOWANCE FOR STORM SEWER PIPE REINFORCED CONCRETE CLIV.

1190-44-71  
Addendum #1  
Revised Sheet 18  
6/6/2011

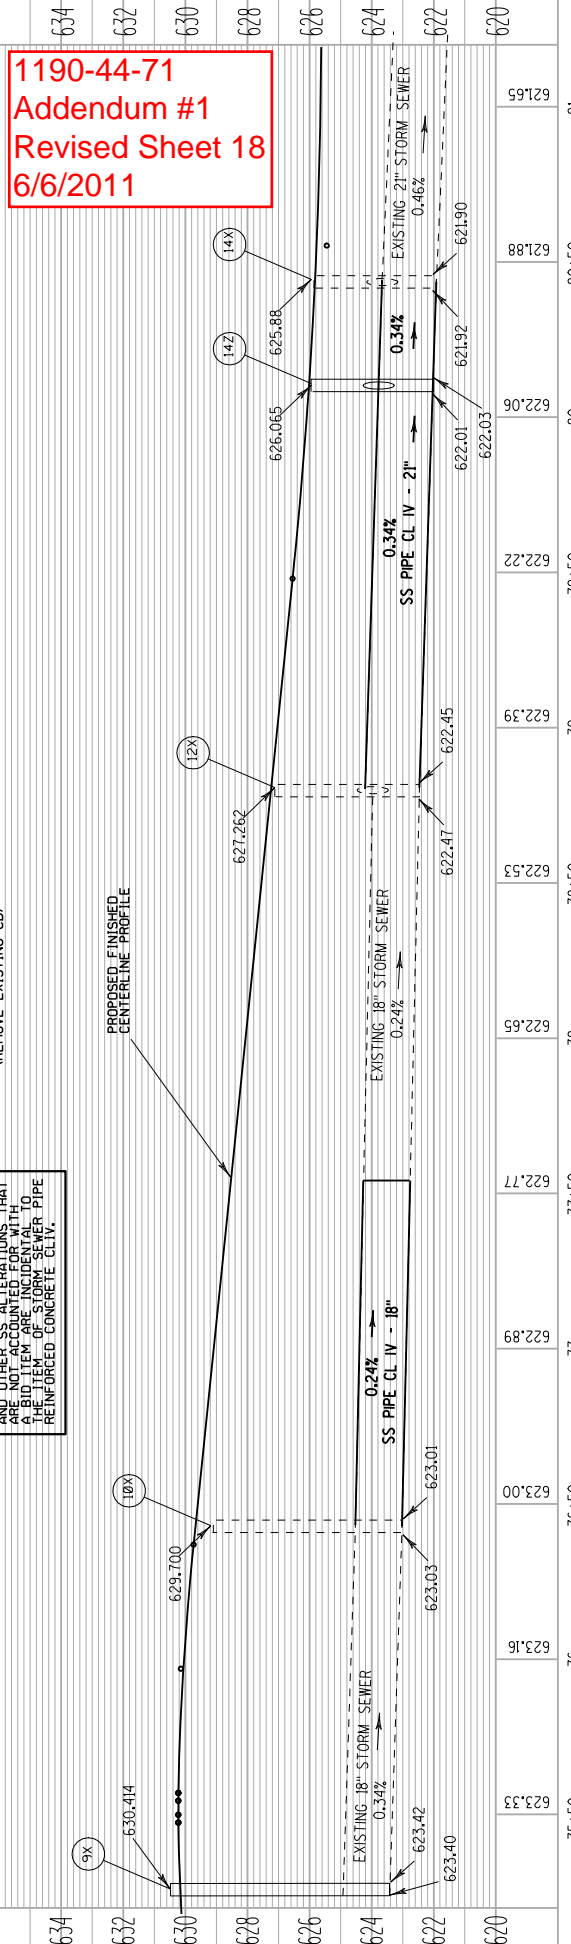

STATION	ELEVATION	DESCRIPTION
75+50	623.33	EXISTING 18" STORM SEWER
76+50	623.00	EXISTING 18" STORM SEWER
77+50	622.77	EXISTING 18" STORM SEWER
78+50	622.65	EXISTING 18" STORM SEWER
79+50	622.53	EXISTING 18" STORM SEWER
80+50	622.45	EXISTING 18" STORM SEWER
81+00	622.47	EXISTING 18" STORM SEWER
75+50	623.16	PROPOSED FINISHED CENTERLINE PROFILE
76+50	623.00	PROPOSED FINISHED CENTERLINE PROFILE
77+50	622.89	PROPOSED FINISHED CENTERLINE PROFILE
78+50	622.77	PROPOSED FINISHED CENTERLINE PROFILE
79+50	622.65	PROPOSED FINISHED CENTERLINE PROFILE
80+50	622.53	PROPOSED FINISHED CENTERLINE PROFILE
81+00	622.45	PROPOSED FINISHED CENTERLINE PROFILE

PROJECT NO: 1190-44-71


HWY: USH 2 (BELKNAP ST)

COUNTY: DOUGLAS

STORM SEWER DETAILS


SHEET

E

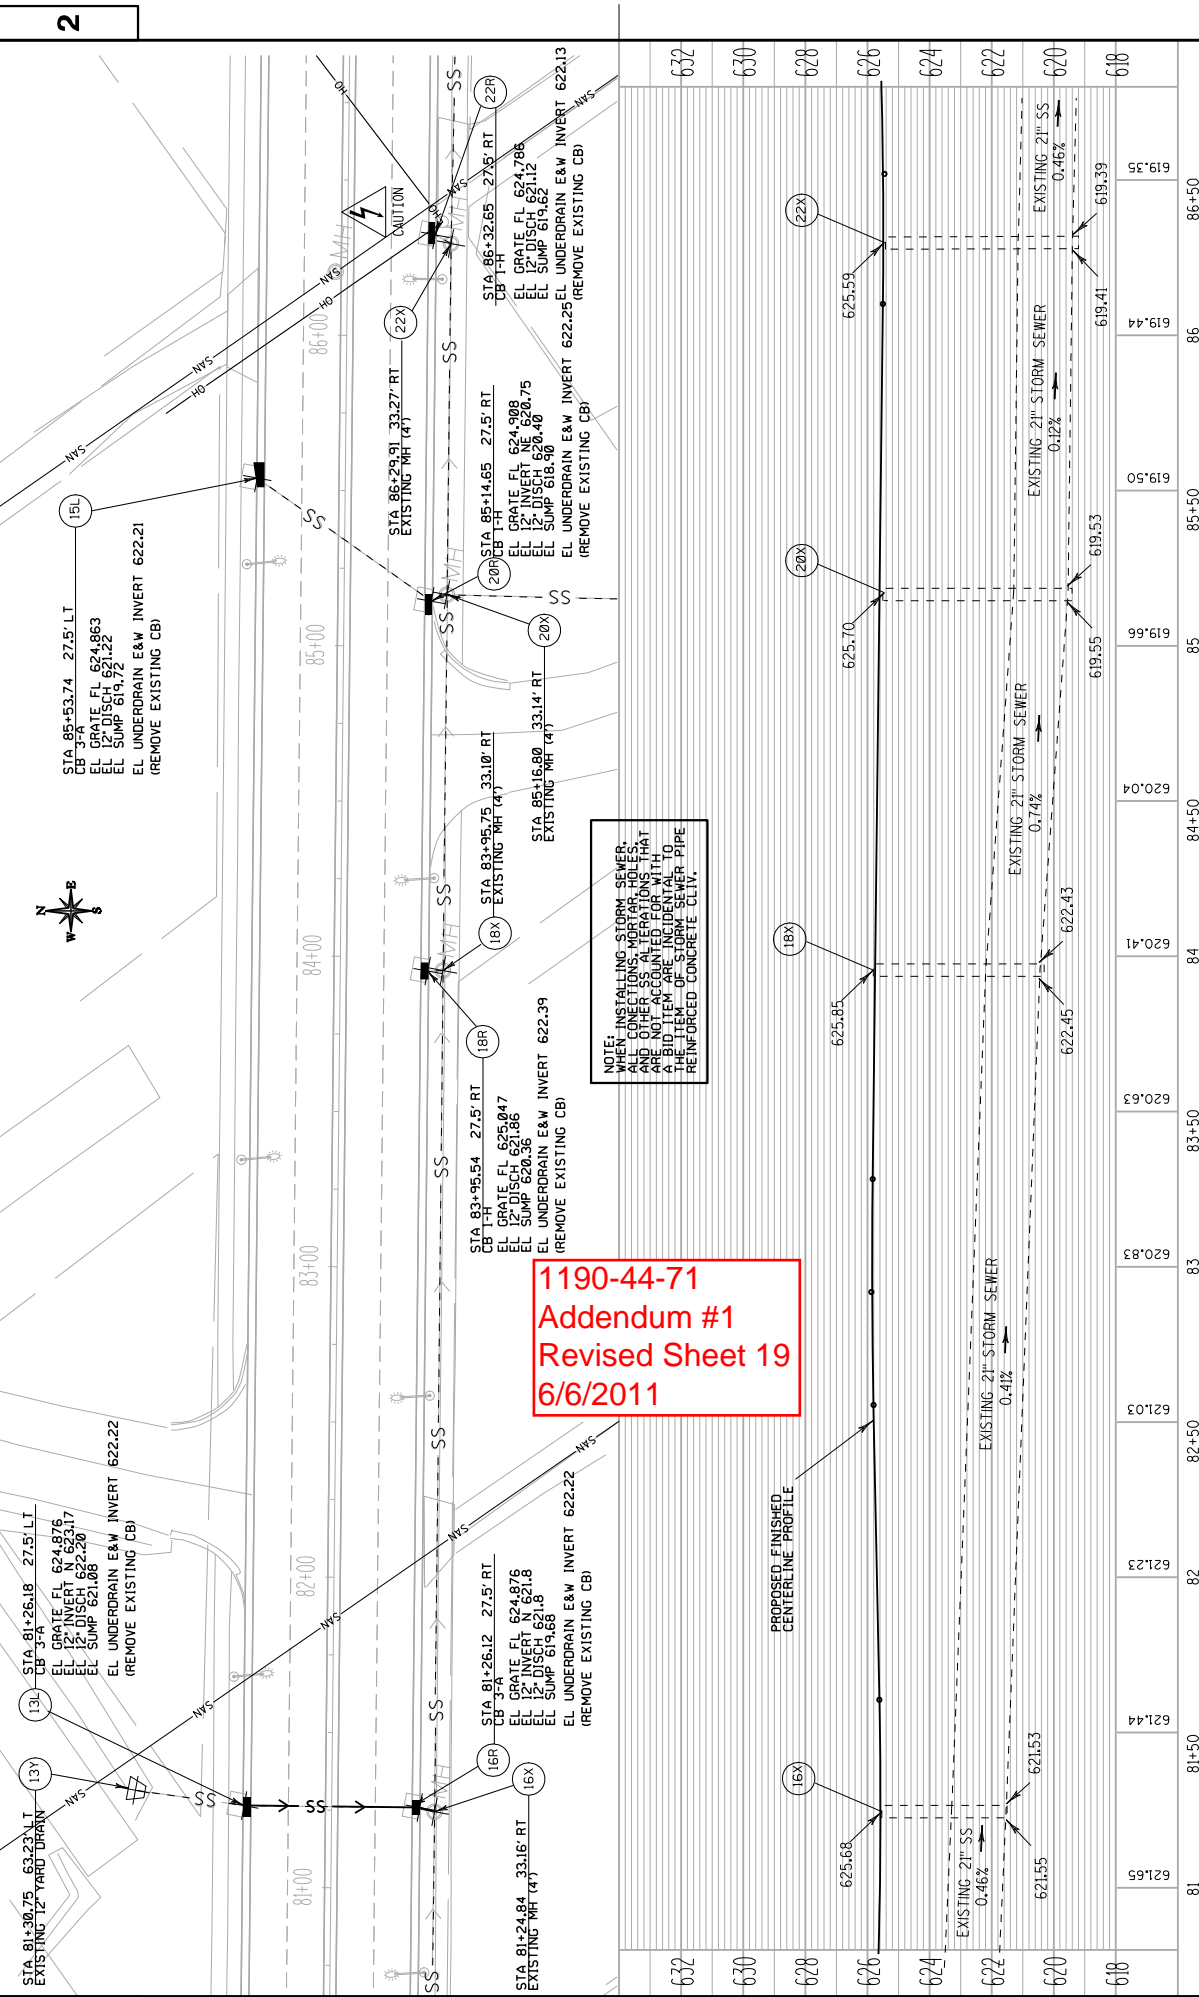

1190-44-71  
 Addendum #1  
 Revised Sheet 19  
 6/6/2011

STATION	PROPOSED FINISHED CENTERLINE PROFILE	EXISTING 21" STORM SEWER	EXISTING 21" STORM SEWER	EXISTING 21" STORM SEWER	EXISTING 21" STORM SEWER	EXISTING 21" STORM SEWER	EXISTING 21" STORM SEWER	EXISTING 21" STORM SEWER	EXISTING 21" STORM SEWER
81	621.65	621.55	621.55	621.55	621.55	621.55	621.55	621.55	621.55
81+50	621.44	621.44	621.44	621.44	621.44	621.44	621.44	621.44	621.44
82	621.23	621.23	621.23	621.23	621.23	621.23	621.23	621.23	621.23
82+50	621.03	621.03	621.03	621.03	621.03	621.03	621.03	621.03	621.03
83	620.83	620.83	620.83	620.83	620.83	620.83	620.83	620.83	620.83
83+50	620.63	620.63	620.63	620.63	620.63	620.63	620.63	620.63	620.63
84	620.41	620.41	620.41	620.41	620.41	620.41	620.41	620.41	620.41
84+50	620.04	620.04	620.04	620.04	620.04	620.04	620.04	620.04	620.04
85	619.66	619.66	619.66	619.66	619.66	619.66	619.66	619.66	619.66
85+50	619.50	619.50	619.50	619.50	619.50	619.50	619.50	619.50	619.50
86	619.44	619.44	619.44	619.44	619.44	619.44	619.44	619.44	619.44
86+50	619.35	619.35	619.35	619.35	619.35	619.35	619.35	619.35	619.35
618									

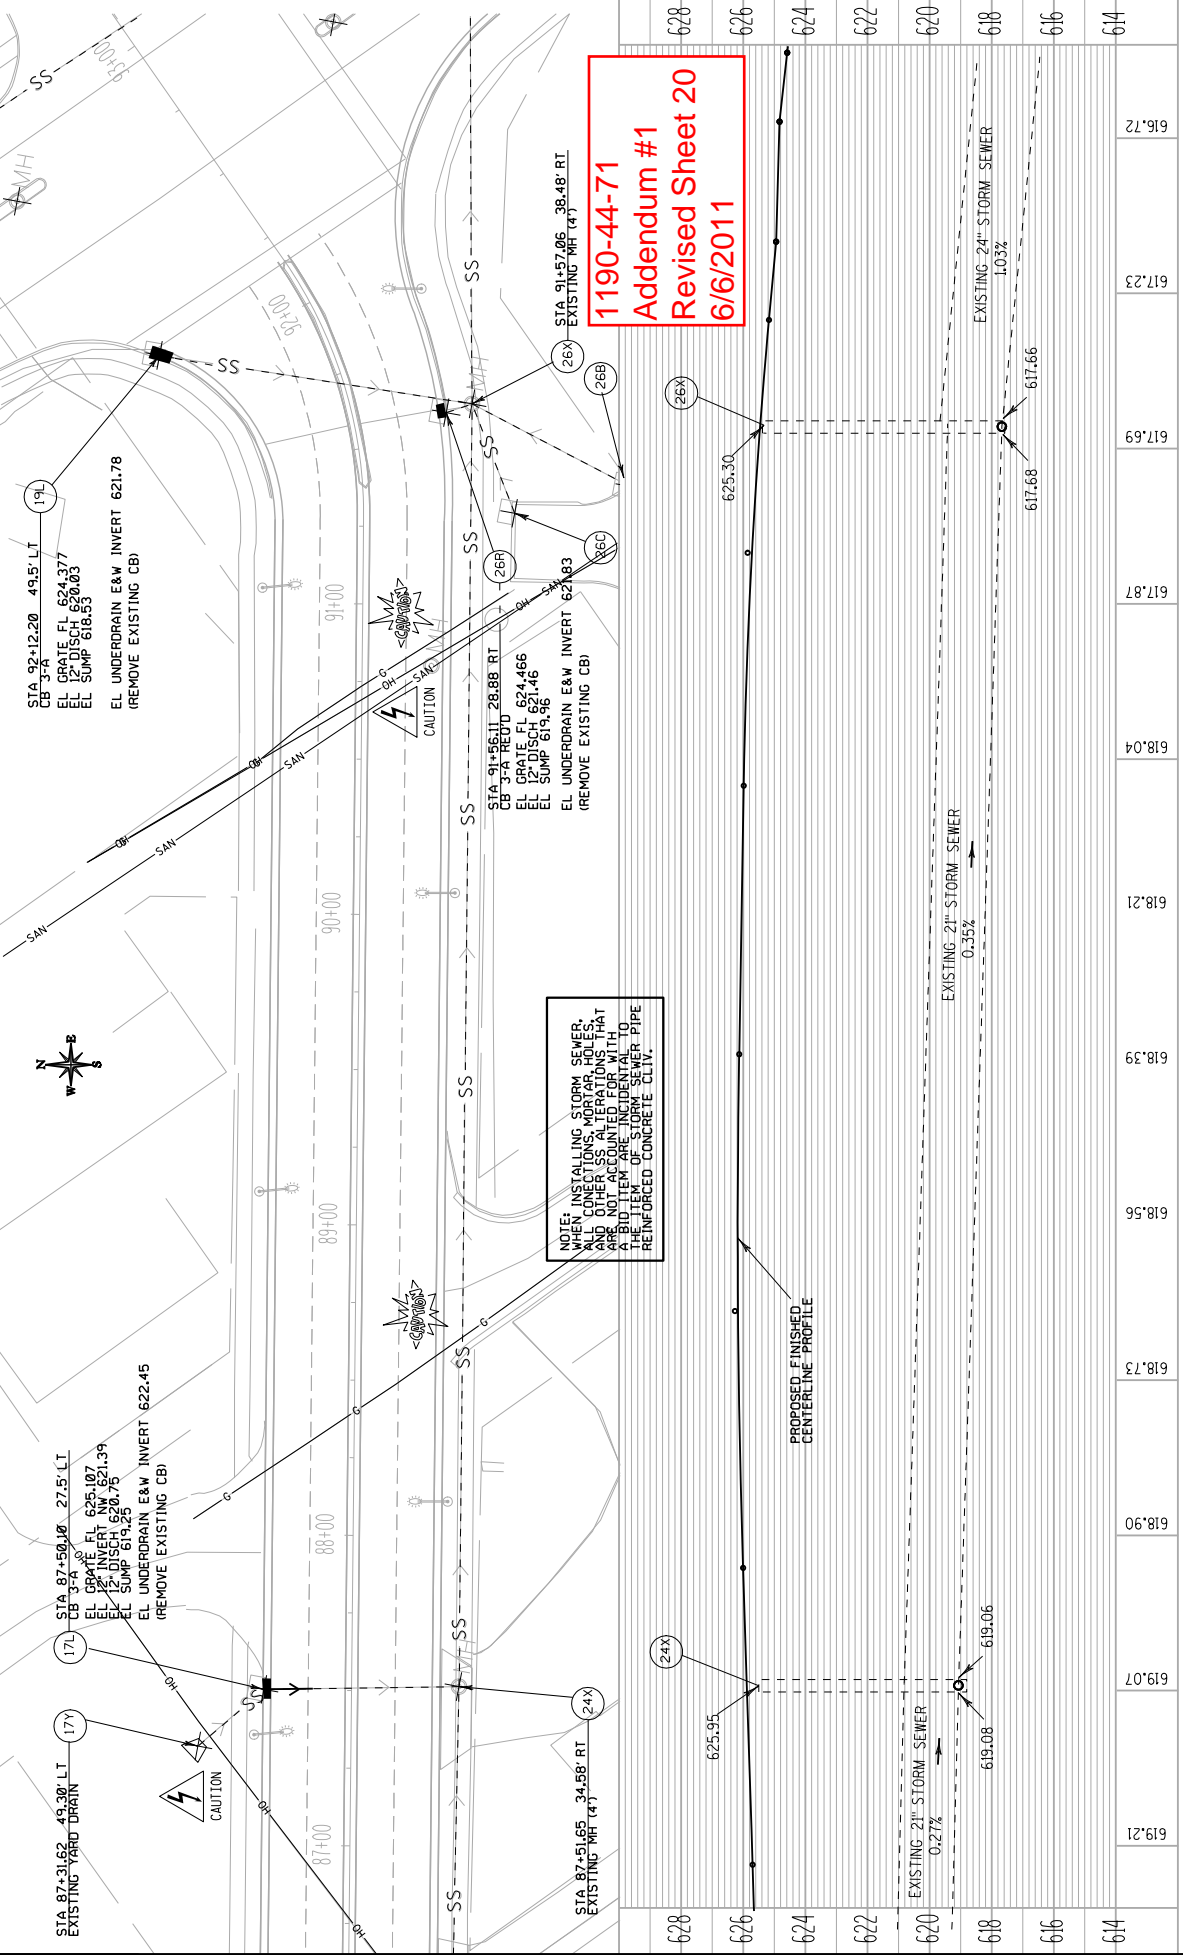

NOTE: INSTALLING STORM SEWER, WHEN CONNECTIONS, MORTAR, ALL OTHER SS ALLEGATIONS THAT A BID ITEM ARE IDENTICAL TO THE ITEM OF STORM SEWER PIPE REINFORCED CONCRETE CLIV.

1190-44-71  
Addendum #1  
Revised Sheet 20  
6/6/2011

628	626	624	622	620	618	616	614	87	87+50	88	88+50	89	89+50	90	90+50	91	91+50	92	92+50
								619.21	619.07	618.90	618.73	618.56	618.39	618.21	618.04	617.87	617.69	617.23	616.72

PROJECT NO: 1190-44-71

HWY: USH 2 (BELKNAP ST)

COUNTY: DOUGLAS

STORM SEWER DETAILS

SHEET

E

**CURB RAMP DETECTABLE WARNING FIELD NATURAL PATINA**

STATION TO	STATION	LOCATION	602.0405 SF	602.0415 SF	602.0415 SF	REMARKS
71+00	71+71	RT	444	444	444	6 FT WIDTH
72+31	72+32	RT	3495	3495	3495	5 FT WIDTH
79+92	75+30	LT	50	50	50	CURB RAMP
79+75	75+44	LT	1160	1160	1160	5 FT WIDTH
82+07	75+70	RT	80	80	80	ALLEY
84+43	75+82	RT	50	50	50	CURB RAMP
84+99	79+00	LT	50	50	50	CURB RAMP
86+60	79+70	LT	60	60	60	ALLEY
87+24	79+26	RT	195	195	195	CE
88+57	79+79	LT	50	50	50	CURB RAMP
89+15	80+00	RT	75	75	75	CURB RAMP
92+05	82+03	LT	86	86	86	E 2ND RADI US
93+23	82+61	LT	75	75	75	CURB RAMP
UNDI STRI BUTED	84+45	RT	2000	2000	2000	
73+05	84+97	RT	235	235	235	PE
76+72	87+65	LT	175	175	175	FE
77+07	88+24	LT	140	140	140	CE
77+92	88+57	LT	140	140	140	CE
73+50	89+16	LT	2615	2615	2615	5 FT WIDTH
79+69	92+16	LT	50	50	50	CURB RAMP
79+75	92+35	LT	1125	1125	1125	5 FT WIDTH
82+04	93+10	LT	50	50	50	CURB RAMP
82+60	93+21	LT	50	50	50	CURB RAMP
85+93		LT	80	80	80	ALLEY
85+90		LT	2595	2595	2595	5 FT WIDTH
87+65		LT	50	50	50	CURB RAMP
88+23		LT	50	50	50	CURB RAMP
93+23		LT	75	75	75	CURB RAMP
UNDI STRI BUTED		LT	2000	2000	2000	
TOTAL 0010			16195*	965	17160*	

\*ADDITIONAL QUANTITY SHOWN WITH 15 1/2" MEDIAN SPECIAL, SAFETY ISLAND, AND CATEGORY 0020 SI DEWALK  
 \*\*ADDITIONAL QUANTITY IN CATEGORY 0020

1190-44-71  
 Addendum #1  
 Revised Sheet 44  
 6/6/2011

**CONCRETE SIDEWALK**

STATION TO	STATION	LOCATION	602.0405 SF	602.0405 SF	602.0405 SF	REMARKS
91+25	92+44	LT	898	898	898	SI DEWALK
						4-INCH CURE & SEAL
						602.0405 SPV.0165(02)
TOTAL 0020			898	898	898	

\*\*\*ADDITIONAL QUANTITY SHOWN WITH 15 1/2" MEDIAN SPECIAL, SAFETY ISLAND, AND CATEGORY 0010 SI DEWALK



**1190-44-71**  
**Addendum #1**  
**Revised Sheet 47**  
**6/6/2011**

**STORM SEWER SUMMARY**

3

3

CAT.	STRUCTU NUMBER	RIM FEET	SUMP FEET	DEPTH FEET	STATION	OFFSET	LOCATION	RCP		RCP CLASS IV	PIPE	RCP CLASS IV	RCP CLASS IV	RECONSTRUCT.	MH COVER	CATCH BASIN	CATCH BASIN	MANHOLE	INLET COVER	INLET COVER	CONST.	REMARKS
								12" SS	12" SS													
0010	3L	629.12	624.9	3.30	71+17.9	-27.5	LT															
0010	4R	628.8	624.05	3.92	71+64.51	28.3	RT	74														
0010	4C	629.58	UNKNOWN	-	71+65.78	87.6	RT															
0010	5L	628.535	624.21	3.41	72+33.91	-27.9	LT	8														
0010	6X	628.773	624.53	-	72+20.78	32.6	RT															
0010	7L	628.336	623.8	3.62	73+66.18	-30.6	LT	4														
0010	8X	628.444	623.98	-	73+57.43	31.6	RT	4														
0010	9X	630.414	623.414	5.96	75+25.84	35.2	RT															
0010	90	626.2	-	-	75+25.84	60.4	RT	20														
0010	10X	629.7	623.02	-	76+42.91	32.0	RT															
0010	11L	626.306	622.23	3.16	78+94.5	-28.5	LT	8														
0010	12R	626.44	621.02	4.59	78+82.54	27.9	RT	6														
0010	12X	627.262	622.46	-	78+79.82	33.1	RT															
0010	12D	624.5	-	-	79+19.5	62.5	RT	50														
0010	14R	625.081	620.8	3.45	80+41.16	27.5	RT	5														
0010	14X	625.88	621.91	-	80+43.66	32.9	RT															
0010	14D	624.4	-	-	80+00	62.5	RT	34														
0010	14Z	626.065	622.02	3.04	80+11.6	33.6	RT															
0010	13L	624.876	621.08	2.88	81+26.18	-27.5	LT															
0010	16R	624.876	619.68	4.28	81+26.12	27.5	RT	57														
0010	16X	625.68	621.54	-	81+24.84	33.2	RT	5														
0010	18R	625.047	620.36	3.85	83+95.54	27.5	RT															
0010	18X	625.85	620.44	-	83+95.75	33.1	RT	5														
0010	15L	624.863	619.72	4.23	85+53.74	-27.5	LT															
0010	20R	624.908	618.9	5.17	85+14.65	27.5	RT															
0010	20X	625.7	619.54	-	85+16.8	33.1	RT	5														
0010	22R	624.786	619.62	4.33	86+32.65	27.5	RT															
0010	22X	625.59	619.4	-	86+29.91	33.3	RT	6														
0010	17L	625.107	619.25	4.94	87+50.1	-27.5	LT	16														
0010	24X	625.95	619.07	-	87+51.65	34.6	RT															
0010	19L	624.377	618.53	4.93	92+12.2	-49.5	LT															
0010	26R	624.466	619.96	3.59	91+56.11	28.9	RT															
0010	26X	625.3	617.67	-	91+57.06	38.5	RT	9														
TOTAL								316	3	3	113	164	10	1	2	6	10	2	10	7	32	

**PERMANENT SIGNING SUMMARY**

STATION	LOCATION	POSTS		TUBULAR STEEL 2X2-1 INCH X 8-FT 634.0808 EACH	TUBULAR STEEL 2X2-1 INCH X 12-FT 634.0812 EACH	MOVING SIGNS TYPE 11 638.2102 EACH	SIGN CODE	SIZE	SIGN MESSAGE	REFLECTIVE TYPE 11 637.0202 MESSAGE	AREA S.F.	REMARKS
		2X2-1 INCH X 8-FT 634.0808 EACH	2X2-1 INCH X 12-FT 634.0812 EACH									
73+25	RT			1			W10-1	36" X36"	RR CROSSING		7.07	
73+25	RT			-		1	R7-1D	24" X30"	NO HORN		5.00	(REUSE EXISTING SIGN)
71+60	RT			-			R7-1D	18" X24"	NO PARKING		3.00	ON LIGHT POLE
71+60	RT			-		1	R1-1	30" X36"	BONG HERTITAGE CENTER		7.50	(REUSE EXISTING SIGN)
72+25	E 7TH ST			1			R1-1	30" X30"	STOP		6.25	EAST 7TH STREET (RT)
72+60	LT			-			R7-1D	18" X24"	NO PARKING		3.00	ON LIGHT POLE
73+50	RT			-			MG3-2	24" X12"	EAST		2.00	ON LIGHT POLE
73+50	RT			-			M1-93	24" X24"	LK SUPERIOR CIRCLE TOUR		4.00	ON LIGHT POLE
73+50	RT			-			M3-2	24" X12"	EAST		2.00	ON LIGHT POLE
73+50	RT			-			M1-4	24" X24"	USH 2		4.00	ON LIGHT POLE
73+50	RT			-			R7-1D	18" X24"	NO PARKING		3.00	ON LIGHT POLE
74+35	MEDIAN	1					R4-7	24" X30"	KEEP RIGHT		5.00	ON LIGHT POLE
74+50	LT			-			W3-3	36" X36"	(STOP LIGHT)		9.00	ON LIGHT POLE
74+50	LT			-			R7-1D	18" X24"	NO PARKING		3.00	ON LIGHT POLE
75+25	RT			-			R7-1D	18" X24"	NO PARKING		3.00	ON LIGHT POLE
76+10	LT			-			R7-1D	18" X24"	NO PARKING		3.00	ON LIGHT POLE
76+70	MEDIAN	1					R4-7	24" X30"	KEEP RIGHT		5.00	ON LIGHT POLE
77+00	RT			-			R2-1	24" X30"	SPEED LIMIT 30		5.00	ON LIGHT POLE
77+00	RT			-			R7-1D	18" X24"	NO PARKING		3.00	ON LIGHT POLE
78+85	RT			-			R7-1D	18" X24"	NO PARKING		3.00	ON LIGHT POLE
79+00	LT			1			R1-1	30" X30"	STOP		6.25	EAST 5TH STREET (LT)
79+80	RT			1			R1-1	30" X30"	STOP		6.25	EAST 5TH STREET (RT)
77+85	LT			-		1	W10-1	36" X36"	RR CROSSING		7.07	ON LIGHT POLE
77+85	LT			-			R7-1D	18" X24"	NO HORN		5.00	(REUSE EXISTING SIGN)
79+80	LT			-		1	R7-1D	18" X24"	NO PARKING		3.00	ON LIGHT POLE
80+70	RT			-		1	R7-1D	18" X24"	TOURIST INFO CENTER		6.25	(REUSE EXISTING SIGN)
81+00	LT			1			R7-1D	18" X24"	NO PARKING		3.00	ON LIGHT POLE
81+00	LT			1			W5-56	18" X18"	(DOTS)		2.25	
81+00	LT			1			W5-56	18" X18"	(DOTS)		2.25	
81+70	LT			-			R7-1D	18" X24"	NO PARKING		3.00	ON LIGHT POLE
82+00	LT			1			R1-1	30" X30"	STOP		6.25	EAST 2ND AVE (LT)
82+60	RT			-			M2-1	21" X15"	JCT		3.00	ON LIGHT POLE
82+60	RT			-			M1-4	24" X24"	USH 53		3.00	ON LIGHT POLE
82+60	RT			-			R7-1D	18" X24"	NO PARKING		3.00	ON LIGHT POLE
83+30	LT			-			MG3-2	24" X12"	WEST		2.00	ON LIGHT POLE
83+30	LT			-			M1-93	24" X24"	LK SUPERIOR CIRCLE TOUR		4.00	ON LIGHT POLE
83+30	LT			-			M3-2	24" X12"	WEST		2.00	ON LIGHT POLE
83+30	LT			-			M1-4	24" X24"	USH 2		4.00	ON LIGHT POLE
83+30	LT			1			R7-1D	18" X24"	NO PARKING		3.00	ON LIGHT POLE
83+70	LT			1			W5-56	18" X18"	(DOTS)		2.25	
83+70	LT			1			W5-56	18" X18"	(DOTS)		2.25	
83+70	LT			1			W5-56	18" X18"	(DOTS)		2.25	
84+25	RT			-			R7-1D	18" X24"	NO PARKING		3.00	ON LIGHT POLE
85+00	RT			1			R1-1	30" X30"	STOP		6.25	EAST 4TH STREET (RT)
85+15	RT			1			W5-56	18" X18"	(DOTS)		2.25	
85+15	RT			1			W5-56	18" X18"	(DOTS)		2.25	
85+15	RT			1			W5-56	18" X18"	(DOTS)		2.25	

1190-44-71  
 Addendum #1  
 Revised Sheet 48  
 6/6/2011

CONTINUED ON FOLLOWING PAGE

**PERMANENT SIGNING SUMMARY**

STATION	LOCATION	POSTS		MOVING SIGNS TYPE 11 638.2102 EACH	SIGN CODE	SIZE	SIGN MESSAGE REFLECTIVE TYPE 11 637.0202	AREA S.F.	REMARKS
		TUBULAR STEEL 2X2-1 INCH X 8-FT 634.0808 EACH	TUBULAR STEEL 2X2-1 INCH X 12-FT 634.0812 EACH						
85+25	LT	-	-		R7-1D	18"X24"	NO PARKING	3.00	ON LIGHT POLE
86+20	RT	-	-		R7-1D	18"X24"	NO PARKING	3.00	ON LIGHT POLE
86+30	RT	1	-		R3-50R	30"X36"	ARROW RT - ONLY	7.50	ON LIGHT POLE
87+30	RT	-	-		R7-1D	18"X24"	NO PARKING	3.00	ON LIGHT POLE
87+55	LT	1	-		W5-56	18"X18"	(DOTS)	2.25	ON LIGHT POLE
87+55	LT	1	-		W5-56	18"X18"	(DOTS)	2.25	ON LIGHT POLE
87+55	LT	1	-		W5-56	18"X18"	(DOTS)	2.25	ON LIGHT POLE
87+70	LT	-	1		R1-1	30"X30"	STOP	6.25	EAST 3RD STREET (LT)
88+10	RT	-	-		W3-3	36"X36"	(STOP LIGHT)	9.00	ON LIGHT POLE
88+10	RT	-	-		R7-1D	18"X24"	NO PARKING	3.00	ON LIGHT POLE
89+10	LT	-	-		R2-1	24"X30"	SPEED LIMIT 30	5.00	ON LIGHT POLE
89+10	LT	-	-		R7-1D	18"X24"	NO PARKING	3.00	ON LIGHT POLE
89+10	RT	1	-		R1-1	30"X30"	STOP	6.25	EAST 3RD STREET (RT)
89+40	RT	2	-		M1-4	24"X24"	USH 53	4.00	
89+40	RT	-	-		M3-2	24"X12"	EAST		
89+40	RT	-	-		M6-4	21"X21"	DOUBLE ARROW	3.06	
89+40	RT	-	-		M1-4	24"X24"	USH 2	4.00	
89+40	RT	-	-		M6-1	21"X21"	ARROW	3.06	
89+80	RT	1	-		R3-8	36"X30"	LANE ARROWS	7.50	
90+10	RT	-	-		M3-2	24"X12"	EAST	2.00	ON LIGHT POLE
90+10	RT	-	-		M1-93	24"X24"	LK SUPERIOR CIRCLE TOUR	4.00	ON LIGHT POLE
90+10	RT	-	-		M66-1	21"X21"	ARROW	3.06	ON LIGHT POLE
90+10	RT	-	-		R7-1D	18"X24"	NO PARKING	3.00	ON LIGHT POLE
90+25	LT	1	-		W5-56	18"X18"	(DOTS)	2.25	ON LIGHT POLE
90+25	LT	1	-		W5-56	18"X18"	(DOTS)	2.25	ON LIGHT POLE
90+25	LT	1	-		W5-56	18"X18"	(DOTS)	2.25	ON LIGHT POLE
91+10	LT	-	-		M3-2	24"X12"	WEST	2.00	ON LIGHT POLE
91+10	LT	-	-		M1-4	24"X24"	USH 2	4.00	ON LIGHT POLE
91+10	LT	-	-		R7-1D	18"X24"	NO PARKING	3.00	ON LIGHT POLE
91+15	RT	2	-		D1-3	66"X36"	DULUTH /ASHLAND SPOONER	16.50	
91+20	RT	1	-		W5-56	18"X18"	(DOTS)	2.25	
91+20	RT	1	-		W5-56	18"X18"	(DOTS)	2.25	
91+20	RT	1	-		W5-56	18"X18"	(DOTS)	2.25	
91+40	MEDI AN	1	-		R4-7	24"X30"	KEEP RIGHT	5.00	EAST 2ND STREET
92+10	MEDI AN	1	-		R4-7	24"X30"	KEEP RIGHT	5.00	
12+24	MEDI AN	1	-		R4-7	24"X30"	KEEP RIGHT	5.00	
TOTALS		22	14	4				329	

1190-44-71  
Addendum #1  
Revised Sheet 49  
6/6/2011

PROJECT NO: 1190-44-71

HWY: USH 2

COUNTY: DOUGLAS

MISCELLANEOUS QUANTITIES

SHEET: E

FILE NAME: \_\_\_\_\_ PLOT DATE: \_\_\_\_\_ PLOT BY: \_\_\_\_\_ PLOT NAME: \_\_\_\_\_ PLOT SCALE: 1:1

STATE PROJECT	FEDERAL PROJECT	
	PROJECT	CONTRACT
1195-00-74		

**STATE OF WISCONSIN  
DEPARTMENT OF TRANSPORTATION**

PLAN OF PROPOSED IMPROVEMENT

**CITY OF SUPERIOR, EAST SECOND STREET**

(E STREET INTERSECTION)

U.S.H. 53

DOUGLAS COUNTY

**CHANGE ORDER WORK**


STATE PROJECT NUMBER  
**1195-00-74**

ORDER OF SHEETS

Section No. 1	Title
Section No. 2	Typical Sections and Details
Section No. 3	Estimate of Quantities
Section No. 3	Miscellaneous Quantities
Section No. 4	Right of Way Plat
Section No. 5	Plan and Profile
Section No. 6	Standard Detail Drawings
Section No. 7	Sign Plates
Section No. 8	Structure Plans
Section No. 9	Computer Earthwork Data
Section No. 9	Cross Sections

TOTAL SHEETS =

PROJECT ID: 1195-00-74  
WITH: K. SINGH & ASSOC., INC.

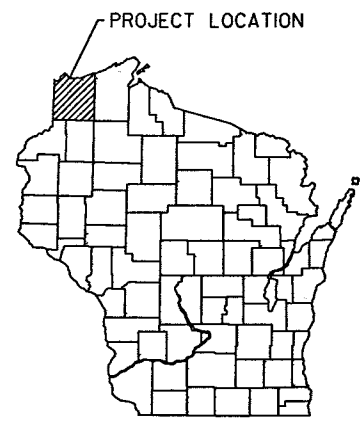

DESIGN DESIGNATION


A.A.D.T. (2010)	=	16,400
A.A.D.T. (2030)	=	18,800
D.H.V.	=	6.7
D.D.	=	---
T.	=	8.4
DESIGN SPEED	=	45 mph
ESALS	=	---

CONVENTIONAL SYMBOLS

PLAN	
CORPORATE LIMITS	
PROPERTY LINE	
LOT LINE	
LIMITED HIGHWAY EASEMENT	
EXISTING RIGHT OF WAY	
PROPOSED OR NEW R/W LINE	
SLOPE INTERCEPT	
REFERENCE LINE	
EXISTING CULVERT	
PROPOSED CULVERT (Box or Pipe)	
COMBUSTIBLE FLUIDS	
MARSH AREA	
WOODED OR SHRUB AREA	

PROFILE

GRADE LINE	
ORIGINAL GROUND	
MARSH OR ROCK PROFILE (To be noted as such)	
SPECIAL DITCH	
GRADE ELEVATION	
CULVERT (Profile View)	
UTILITIES	
ELECTRIC	
FIBER OPTIC	
GAS	
SANITARY SEWER	
STORM SEWER	
TELEPHONE	
WATER	
UTILITY PEDESTAL	
POWER POLE	
TELEPHONE POLE	

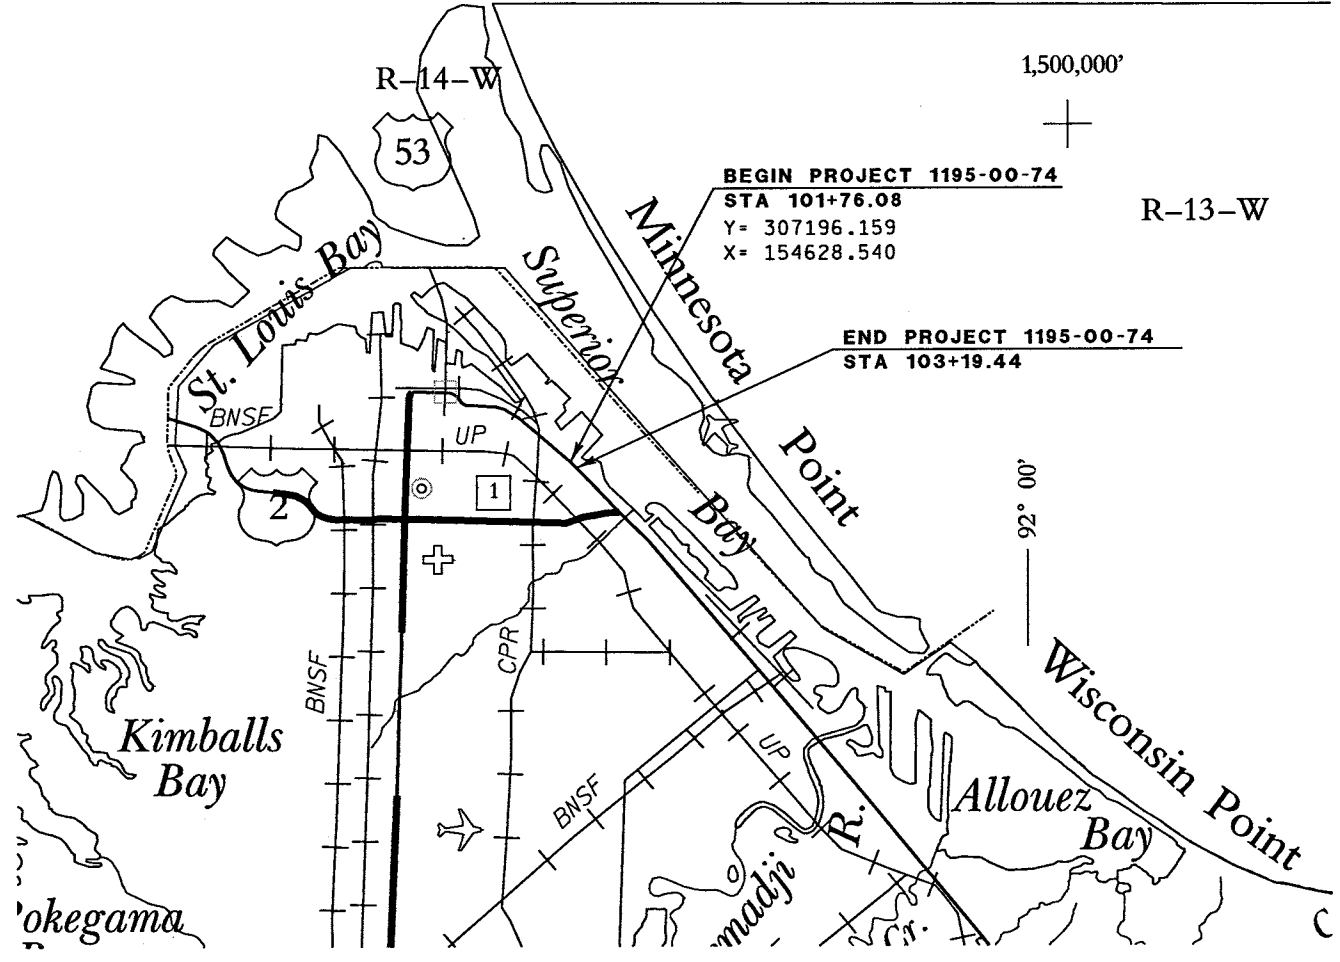

ORIGINAL PLANS PREPARED BY:

**SEH**

**WISCONSIN**

JARROD S. STARKEN  
38465  
EAU CLAIRE, WI  
8/18/11

**PROFESSIONAL ENGINEER**

STATE OF WISCONSIN  
DEPARTMENT OF TRANSPORTATION

PREPARED BY

Surveyor \_\_\_\_\_

Designer \_\_\_\_\_

Project Manager \_\_\_\_\_

Regional Examiner \_\_\_\_\_

Regional Supervisor \_\_\_\_\_

C.O. Examiner \_\_\_\_\_

APPROVED FOR THE DEPARTMENT

DATE: \_\_\_\_\_ (Signature)

**STANDARD ABBREVIATIONS**

ABUT	ABUTMENT	HYD	HYDRANT
AC	ACRE	ID	INSIDE DIAMETER
AGG	AGGREGATE	INV	INVERT
AECPRC	APRON ENDWALL FOR CULVERT PIPE REINFORCED CONCRETE	IP	IRON PIPE ON PIN
ASPH	ASPHALTIC	LHF	LEFT-HAND FORWARD
AVG	AVERAGE	L	LENGTH OF CURVE
ADT	AVERAGE DAILY TRAFFIC	LF	LINEAR FOOT
BF	BACK FACE	LC	LONG CHORD OF CURVE
BM	BENCH MARK	LS	LUMP SUM
BR	BRIDGE	MH	MANHOLE
CE	COMMERCIAL ENTRANCE	MOR	MID POINT OF RADIUS
CL OR C/L OR €	CENTER LINE	NC	NORMAL CROWN
CONC	CONCRETE	NO	NUMBER
CPRC	CULVERT PIPE REINFORCED CONCRETE	OBLIT	OBLITERATE
CPRCHE	CULVERT PIPE REINFORCED CONCRETE HORIZONTAL ELLIPTICAL	PAVT	PAVEMENT
CR	CREEK	PE	PRIVATE ENTRANCE
CY	CUBIC YARD	PVRC	POINT OF VERTICAL REVERSE CURVE
C & G	CURB AND GUTTER	QOR	QUARTER POINT OF RADIUS
D	DEGREE OF CURVE	R	RADIUS
DHV	DESIGN HOUR VOLUME	REQ'D	REQUIRED
DISCH	DISCHARGE	RES	RESIDENCE OR RESIDENTIAL
DG	DITCH GRADE	RHF	RIGHT-HAND FORWARD
DWY	DRIVEWAY	R/W	RIGHT-OF-WAY
X	EAST GRID COORDINATE	R	RIVER
EAT	STEEL PLATE BEAM GUARD ENERGY ABSORBING TERMINAL	RDWY	ROADWAY
EOR	END POINT OF RADIUS	R/L OR R	REFERENCE LINE
EL	ELEVATION	SALV	SALVAGED
ENT	ENTRANCE	SAN	SANITARY SEWER
ESALS	EQUIVALENT SINGLE AXLE LOADS	SF	SQUARE FEET
EXC	EXCAVATION	SY	SQUARE YARD
EBS	EXCAVATION BELOW SUBGRADE	SDD	STANDARD DETAIL DRAWINGS
EXIST	EXISTING	STA	STATION
FC	FACE OF CURB	SS	STORM SEWER
FF	FACE TO FACE	SSPRC	STORM SEWER PIPE REINFORCED CONCRETE
FERT	FERTILIZE	SE	SUPERELEVATION RATE
FE	FIELD ENTRANCE	TC	TOP OF CURB
FL	FLOW LINE	T OR TN	TOWN
FO	FIBER OPTIC	T	TRUCKS (PERCENT OF)
CWT	HUNDREDWEIGHT	TYP	TYPICAL
		VAR	VARIABLE
		VC	VERTICAL CURVE
		Y	NORTH GRID COORDINATE
		YD	YARD

**GENERAL NOTES**

ELEVATIONS SHOWN ON THE PLAN ARE REFERENCED TO THE APPROXIMATE USGS DATUM.

WHEN THE QUANTITY OF THE ITEMS OF BASE OR SURFACE COURSE IS MEASURED FOR PAYMENT BY THE TON THE DEPTH OR THICKNESS OF THE COURSE SHOWN ON THE PLANS IS APPROXIMATE AND THE ACTUAL THICKNESS WILL DEPEND ON THE DISTRIBUTION OF THE MATERIAL AS DIRECTED BY THE ENGINEER.

THE LOCATION OF EXISTING AND PROPOSED UTILITY INSTALLATIONS AS SHOWN ON THE PLANS ARE APPROXIMATE. THERE MAY BE OTHER UTILITY INSTALLATIONS WITHIN THE PROJECT AREA THAT ARE NOT SHOWN.

NO TREES OR SHRUBS ARE TO BE REMOVED WITHOUT THE APPROVAL OF THE ENGINEER.

ALIGNMENT DATA AND COORDINATE DATA ON THIS PLAN ARE BASED ON AERIAL PHOTOGRAPHY, A SURVEY WAS NOT COMPLETED FOR THIS PROJECT.

CURVE DATA IS BASED ON THE ARC DEFINITION.

THE EXACT LOCATION OF THE EROSION CONTROL DEVICES SHALL BE DETERMINED IN THE FIELD.

BEARINGS SHOWN ON THE PLANS ARE GRID BEARINGS TO THE NEAREST SECOND.

THE LOCATION OF ALL DRIVEWAYS WILL BE DETERMINED BY THE ENGINEER.

CONSTRUCT INSIDE EDGE OF SIDEWALK 1/4 INCH HIGHER THAN THE TOP OF CURB, WHEN THEY ARE ADJACENT TO EACH OTHER.

ALL CURB AND GUTTER RADII ARE SHOWN TO THE EDGE OF PAVEMENT UNLESS NOTED OTHERWISE.

TOP OF CASTING ELEVATIONS SHOWN FOR INLETS REFER TO THE CASTING ELEVATION AT THE EDGE OF PAVEMENT.

ALL STORM SEWER INVERTS, ELEVATIONS, PIPE LENGTHS, AND GRADES ARE COMPUTED CENTER-TO-CENTER OF STRUCTURES.

A VERTICAL SAWCUT SHALL BE MADE THROUGH EXISTING DRIVEWAYS AND PAVEMENTS AT REMOVAL LIMITS.

ASPHALTIC SURFACE TO BE PLACED IN THREE OR MORE LAYERS.

**ORDER OF DETAIL SHEETS**

- TYPICAL SECTIONS
- CONSTRUCTION DETAILS
- INTERSECTION DETAILS
- STORM SEWER AND EROSION CONTROL
- SIGNING AND PAVEMENT MARKING
- TRAFFIC CONTROL

**DESIGN CONTACT**

SEH INC.  
 1409 HAMMOND AVENUE SUITE 315  
 SUPERIOR, WI 54880  
 TELEPHONE: 218.969.9992  
 ATTENTION: SCOTT WEYANDT  
 EMAIL: SWEYANDT@SEHINC.COM

**DNR LIAISON**

STATE OF WISCONSIN  
 NORTHWEST DISTRICT  
 HWY 70 WEST  
 P.O. BOX 309  
 SPOONER, WI 54801  
 TELEPHONE: 715.635.4229  
 ATTENTION: AMY CRONK  
 EMAIL: AMY.CRONK@WISCONSIN.GOV

**UTILITY CONTACTS**





SUPERIOR WATER, LIGHT & POWER CO.  
 2915 HILL AVENUE  
 P.O. BOX 519  
 SUPERIOR, WISCONSIN 54880  
 TELEPHONE: 715.395.6315  
 ATTENTION: KEVIN HABERMAN  
 EMAIL: KHABERMAN@SWLP.COM

TELEPHONE: 218.355.5949  
 ATTENTION: TIM MELBY (WATER & GAS)  
 EMAIL: TMELBY@SWLP.COM


CITY OF SUPERIOR  
 PUBLIC WORKS  
 1316 N 14TH STREET  
 SUPERIOR, WISCONSIN 54880  
 TELEPHONE: 715.395.7539  
 ATTENTION: JEFF GOETZMAN  
 EMAIL: GOETZMAN@CI.SUPERIOR.WI.US




CALL 811 OR (800)242.8511  
 (877)500.9592 (EMERGENCY ONLY)  
 www.DiggersHotline.com

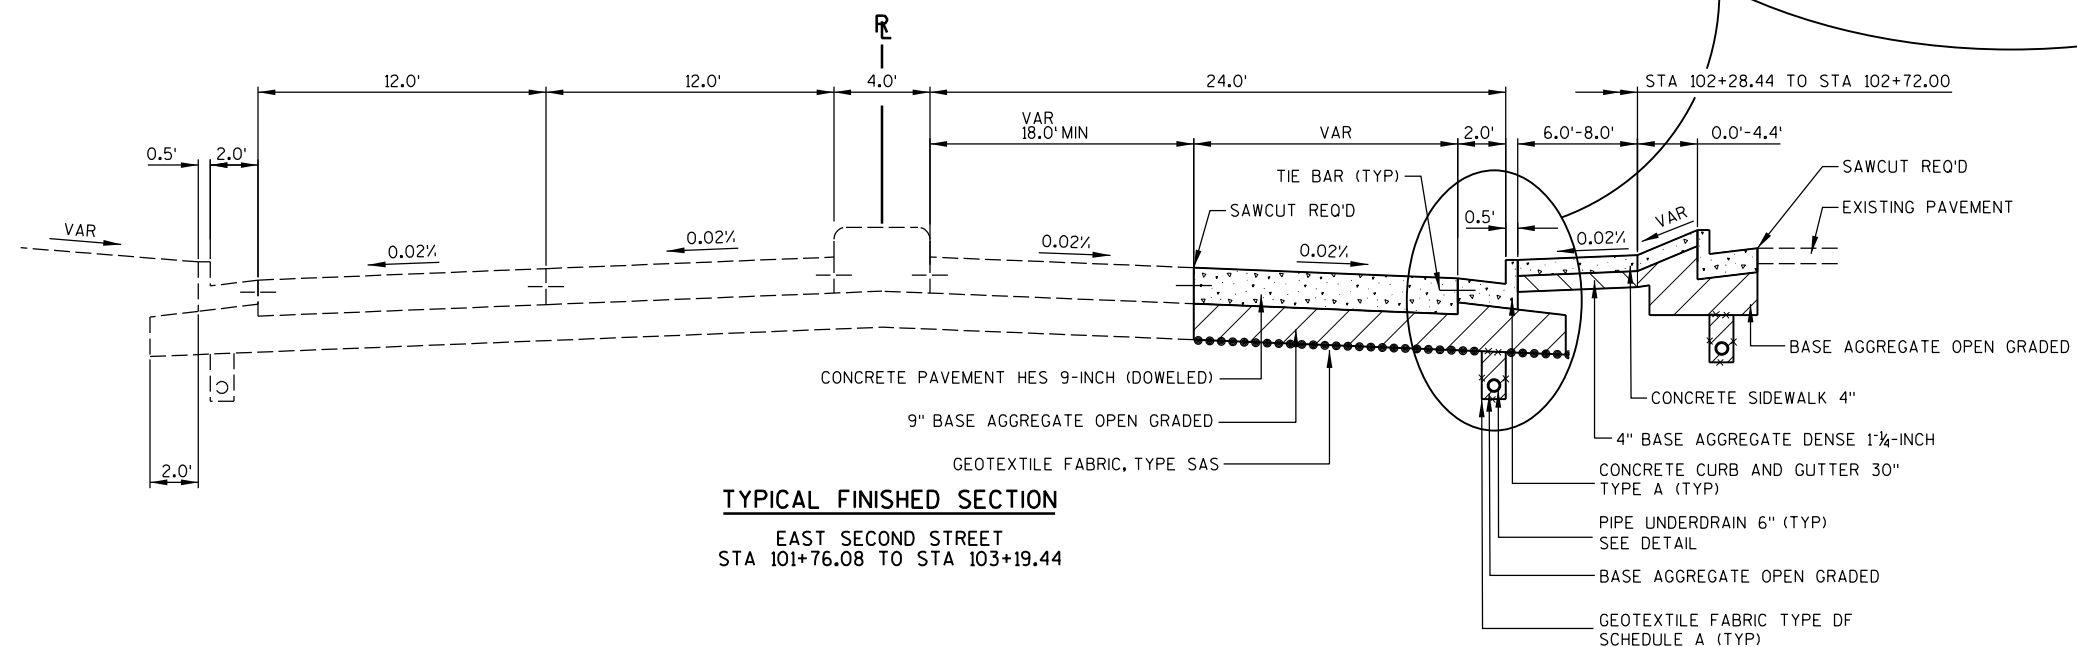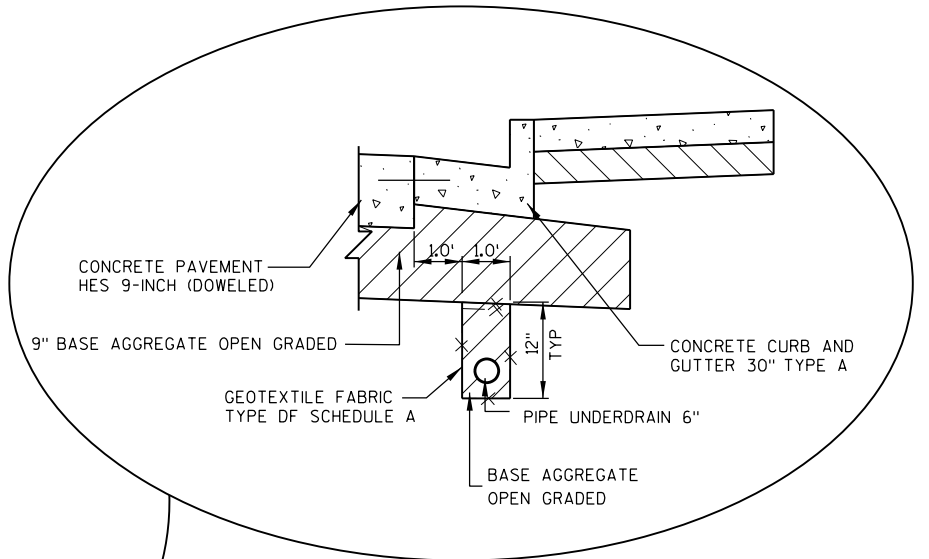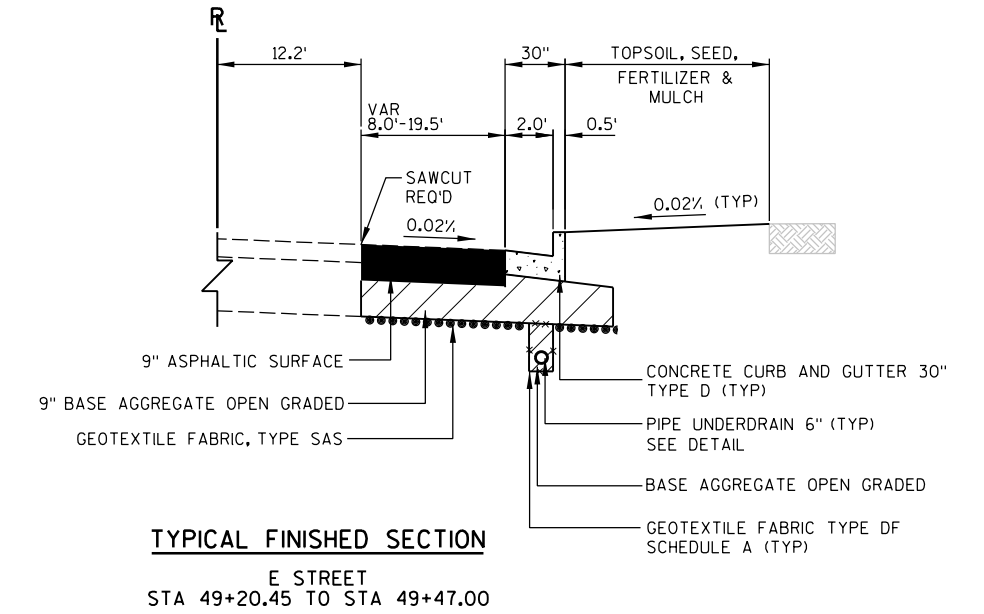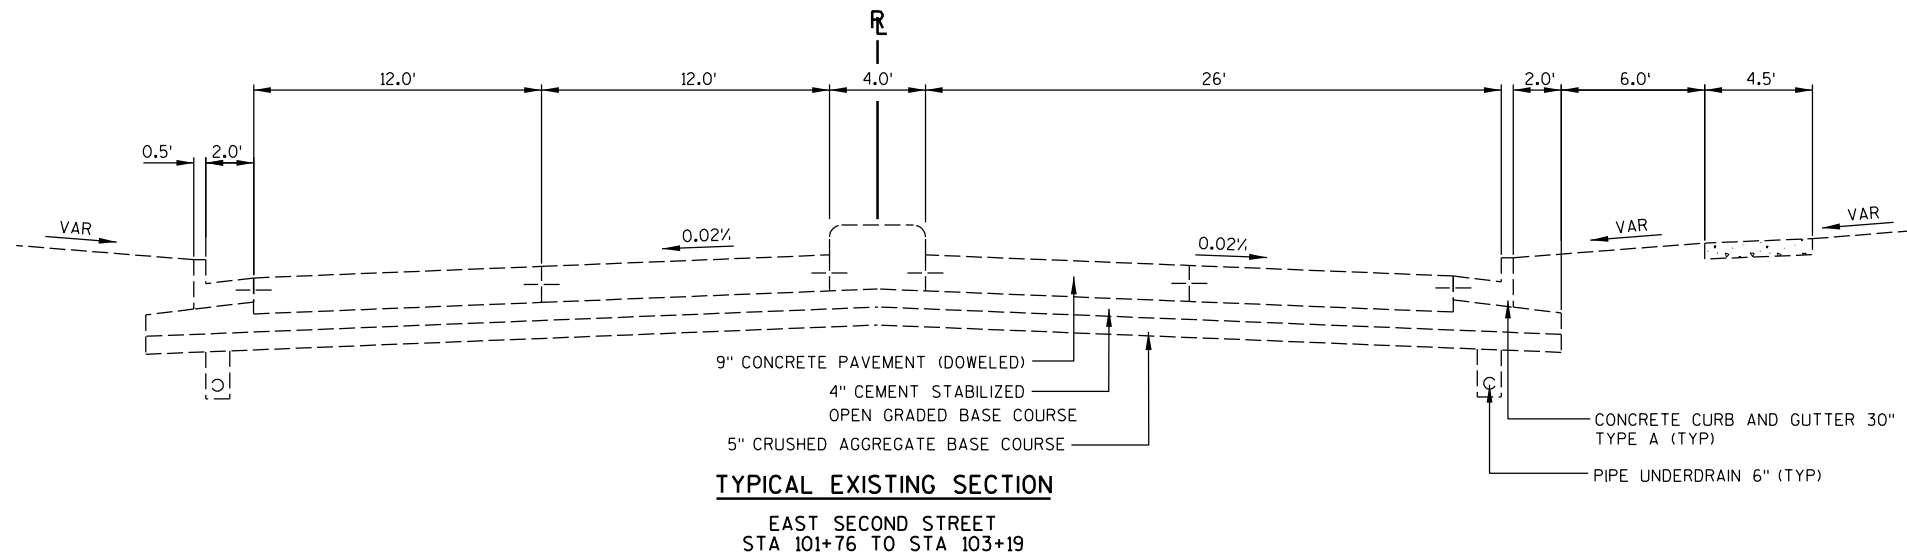


- ① PIPE UNDERDRAIN SHALL BE LAID PARALLEL TO THE GRADE OF THE ROADWAY.
- IF THERE IS A CONFLICT WITH THE STORM SEWER, THE PIPE UNDERDRAIN SHALL BE LAID PARALLEL TO THE STORM SEWER TOWARDS THE CENTER OF THE ROAD.
- TRENCH BACKFILL WILL BE PAID FOR AS BASE AGGREGATE OPEN GRADED.

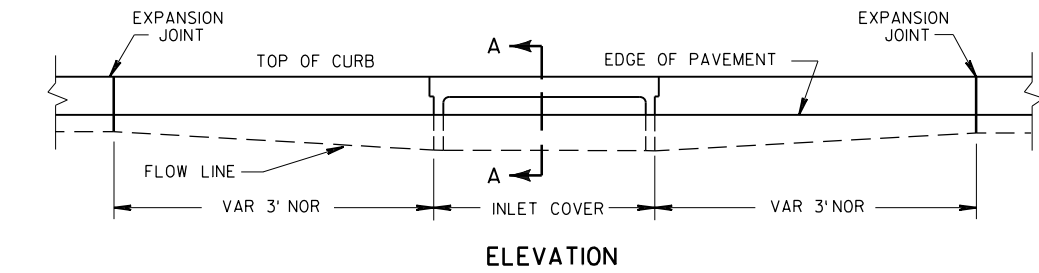


ELEVATION

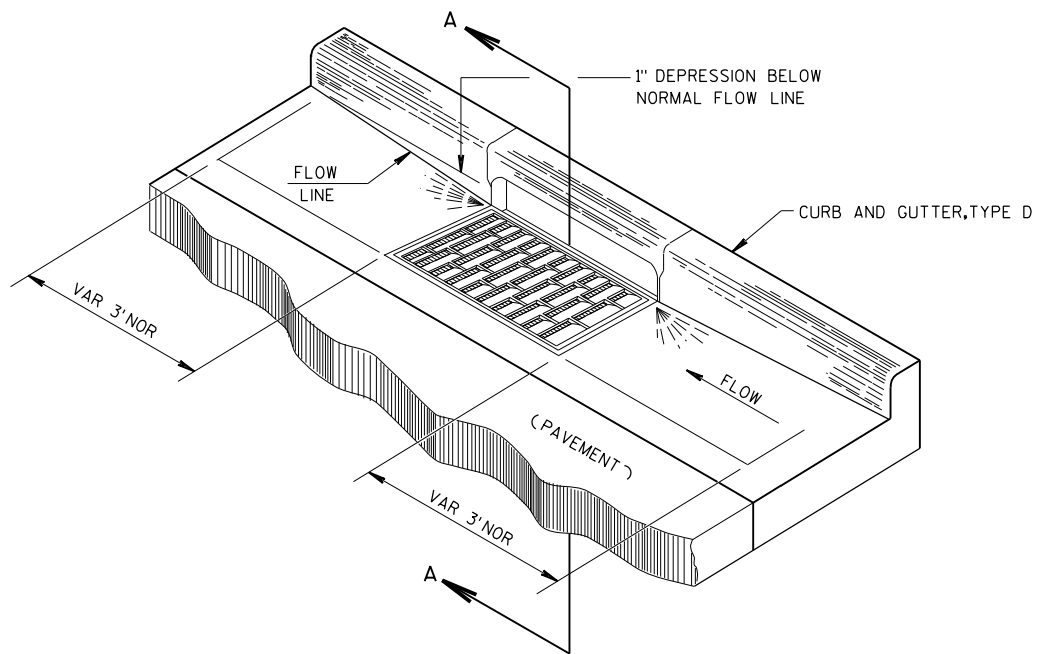

DETAIL OF CURB AND GUTTER AT CATCH BASINS

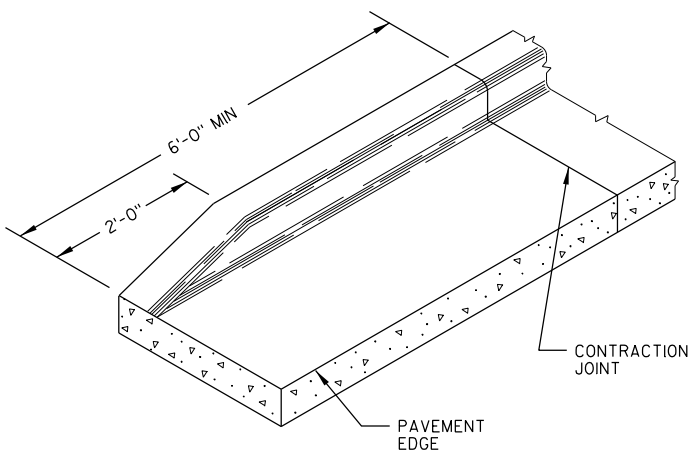


CURB END TREATMENT

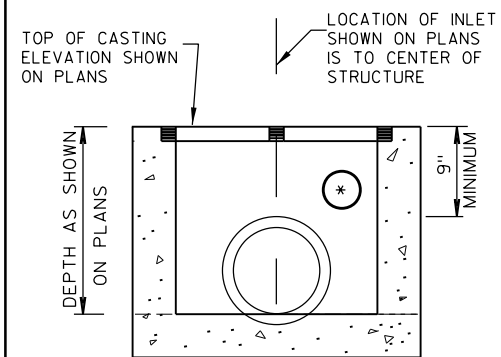


INLET, TYPE 8 MODIFIED  
FOR ADDITIONAL DETAILS SEE S.D.D.

\* CUT IN PIPE UNDERDRAIN, CUTTING AND CONNECTING INTO THE INLET IS CONSIDERED INCIDENTAL TO THE INLET ITEM

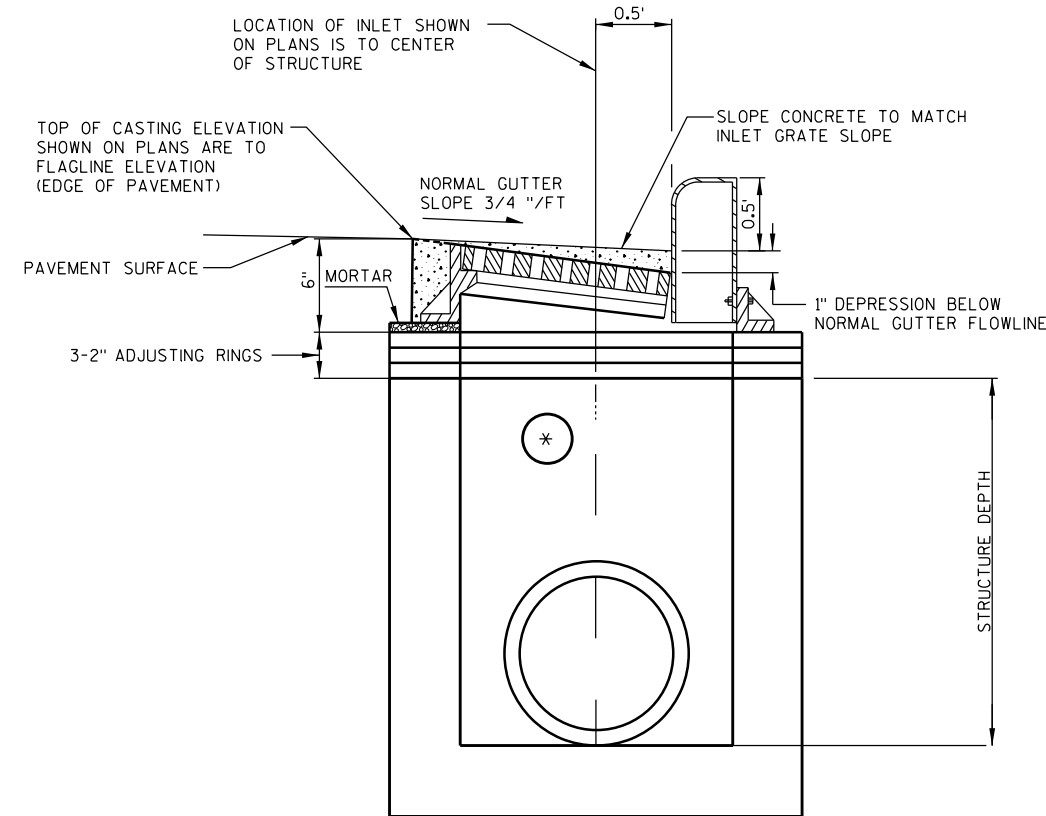

INLET LOCATION  
TYPE H-S INLET COVER

\* CUT IN PIPE UNDERDRAIN, CUTTING AND CONNECTING INTO THE INLET IS CONSIDERED INCIDENTAL TO THE INLET ITEM

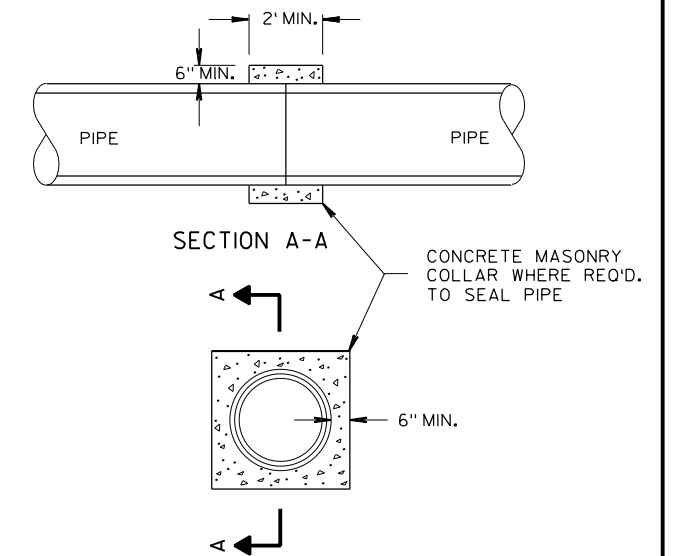


CONCRETE COLLAR DETAIL

RUNOFF COEFFICIENT TABLE

	HYDROLOGIC SOIL GROUP											
	A			B			C			D		
	SLOPE RANGE (PERCENT)			SLOPE RANGE (PERCENT)			SLOPE RANGE (PERCENT)			SLOPE RANGE (PERCENT)		
LAND USE:	0-2	2-6	6 & OVER	0-2	2-6	6 & OVER	0-2	2-6	6 & OVER	0-2	2-6	6 & OVER
ROW CROPS	.08	.16	.22	.12	.20	.27	.15	.24	.33	.19	.28	.38
	.22	.30	.38	.26	.34	.44	.30	.37	.50	.34	.41	.56
MEDIAN STRIP-TURF	.19	.20	.24	.19	.22	.26	.20	.23	.30	.20	.25	.30
	.24	.26	.30	.25	.28	.33	.26	.30	.37	.27	.32	.40
SIDE SLOPE-TURF			.25			.27			.28			.30
			.32			.34			.36			.38
PAVEMENT:												
ASPHALT	.70 - .95											
CONCRETE	.80 - .95											
BRICK	.70 - .80											
DRIVES, WALKS	.75 - .85											
ROOFS	.75 - .95											
GRAVEL ROADS, SHOULDERS	.40 - .60											

TOTAL PROJECT AREA = 0.21 ACRES  
TOTAL AREA EXPECTED TO BE DISTURBED BY CONSTRUCTION ACTIVITIES = 0.08 ACRES

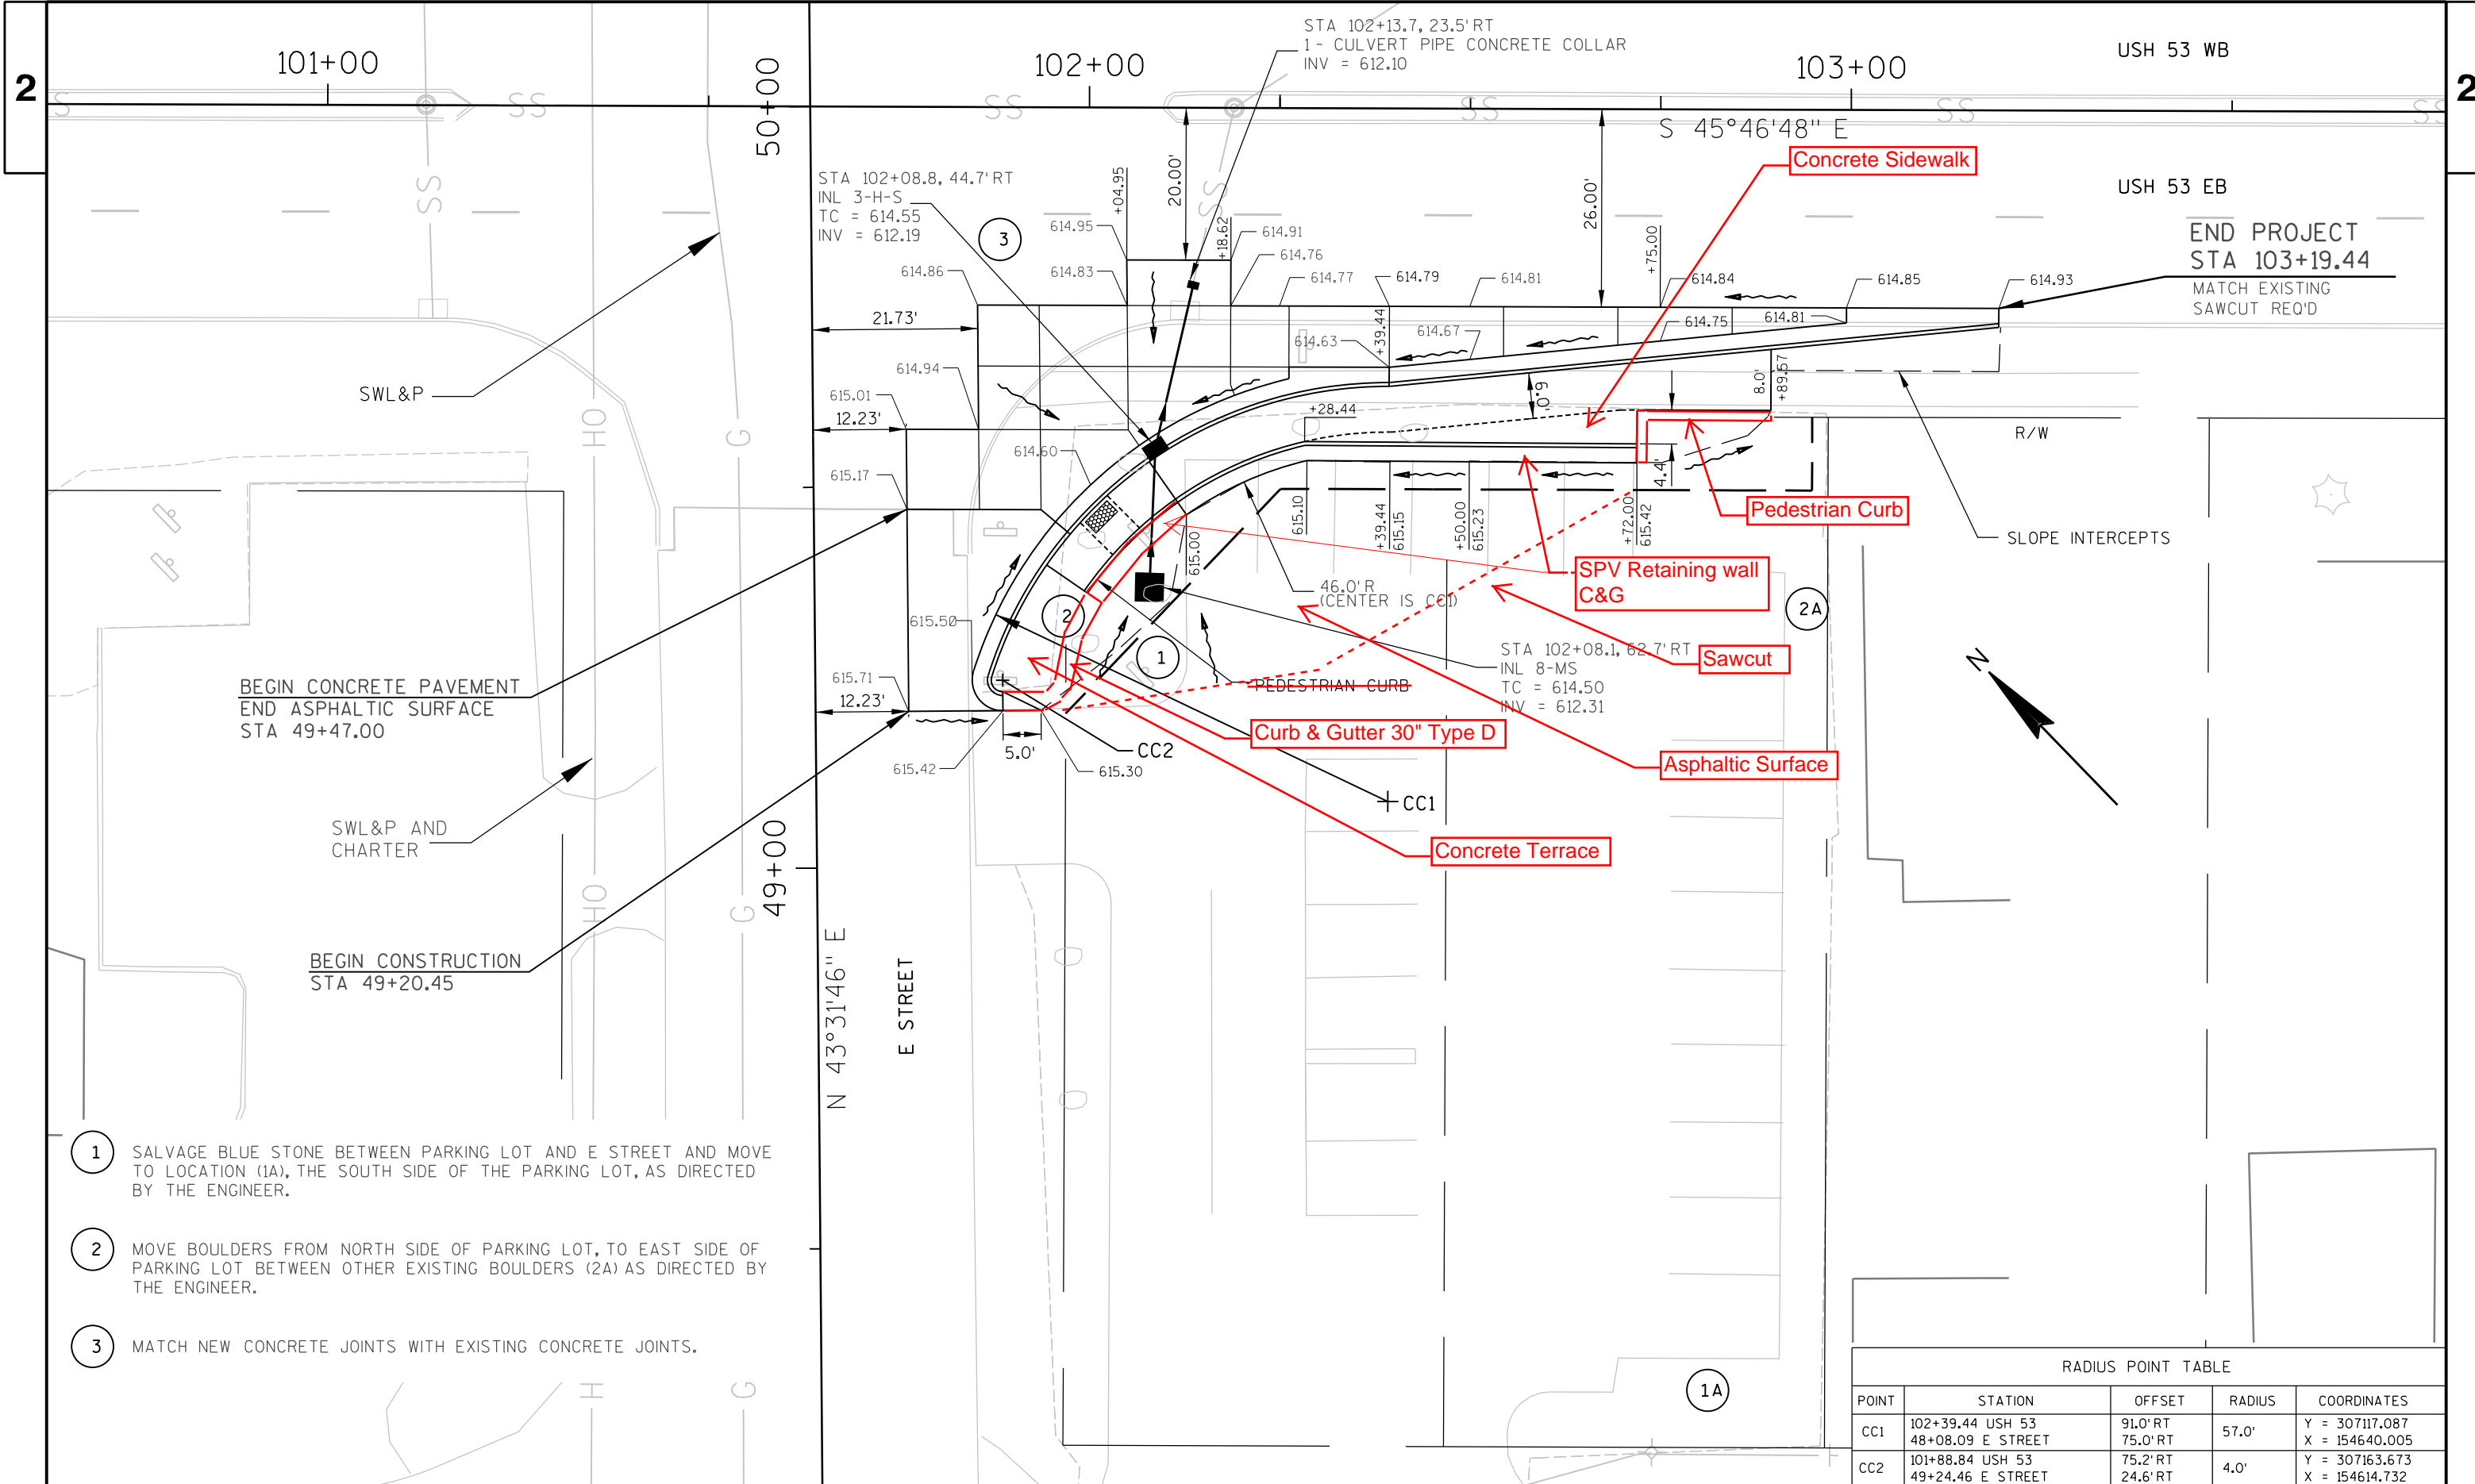

- 1 SALVAGE BLUE STONE BETWEEN PARKING LOT AND E STREET AND MOVE TO LOCATION (1A), THE SOUTH SIDE OF THE PARKING LOT, AS DIRECTED BY THE ENGINEER.
- 2 MOVE BOULDERS FROM NORTH SIDE OF PARKING LOT, TO EAST SIDE OF PARKING LOT BETWEEN OTHER EXISTING BOULDERS (2A) AS DIRECTED BY THE ENGINEER.
- 3 MATCH NEW CONCRETE JOINTS WITH EXISTING CONCRETE JOINTS.

RADIUS POINT TABLE				
POINT	STATION	OFFSET	RADIUS	COORDINATES
CC1	102+39.44 USH 53 48+08.09 E STREET	91.0' RT 75.0' RT	57.0'	Y = 307117.087 X = 154640.005
CC2	101+88.84 USH 53 49+24.46 E STREET	75.2' RT 24.6' RT	4.0'	Y = 307163.673 X = 154614.732



**GENERAL TRAFFIC CONTROL NOTES:**

THE EXACT NUMBER, LOCATION AND SPACING OF ALL SIGNS ARE APPROXIMATE AND SHALL BE ADJUSTED TO FIT FIELD CONDITIONS.

DURING HOURS OF DARKNESS ALL BARRICADES USED TO SHIELD A HAZARD SHALL BE EQUIPPED WITH WARNING LIGHTS, TYPE A.

ALL SIGNS ARE 48" X 48" UNLESS OTHERWISE NOTED.



UNLESS OTHERWISE NOTED, THE CONTRACTOR SHALL MAINTAIN ACCESS TO PROPERTIES ADJACENT TO THE PROJECT SITE AT ALL TIMES DURING CONSTRUCTION.

ALL SIGNS OR PAVEMENT MARKING, TEMPORARY OR EXISTING, WHICH MAY CONFLICT WITH THE CONSTRUCTION TRAFFIC PATTERN SHALL BE REMOVED OR COVERED.

ALL SIGNS AND DEVICES SHALL BE IN CONFORMANCE WITH THE "WISCONSIN MANUAL ON UNIFORM TRAFFIC CONTROL DEVICES" (WMUTCD), A SUPPLEMENT TO THE FEDERAL HIGHWAY ADMINISTRATION'S "MANUAL ON UNIFORM TRAFFIC CONTROL DEVICES".

"WO" SIGNS ARE THE SAME AS "W" SIGNS EXCEPT THE BACKGROUND COLOR IS ORANGE.

REMOVED SIDEWALKS SHALL BE BARRICADED AND SIGNED IN ACCORDANCE WITH SDD "TRAFFIC CONTROL, SIDEWALK CLOSURE".

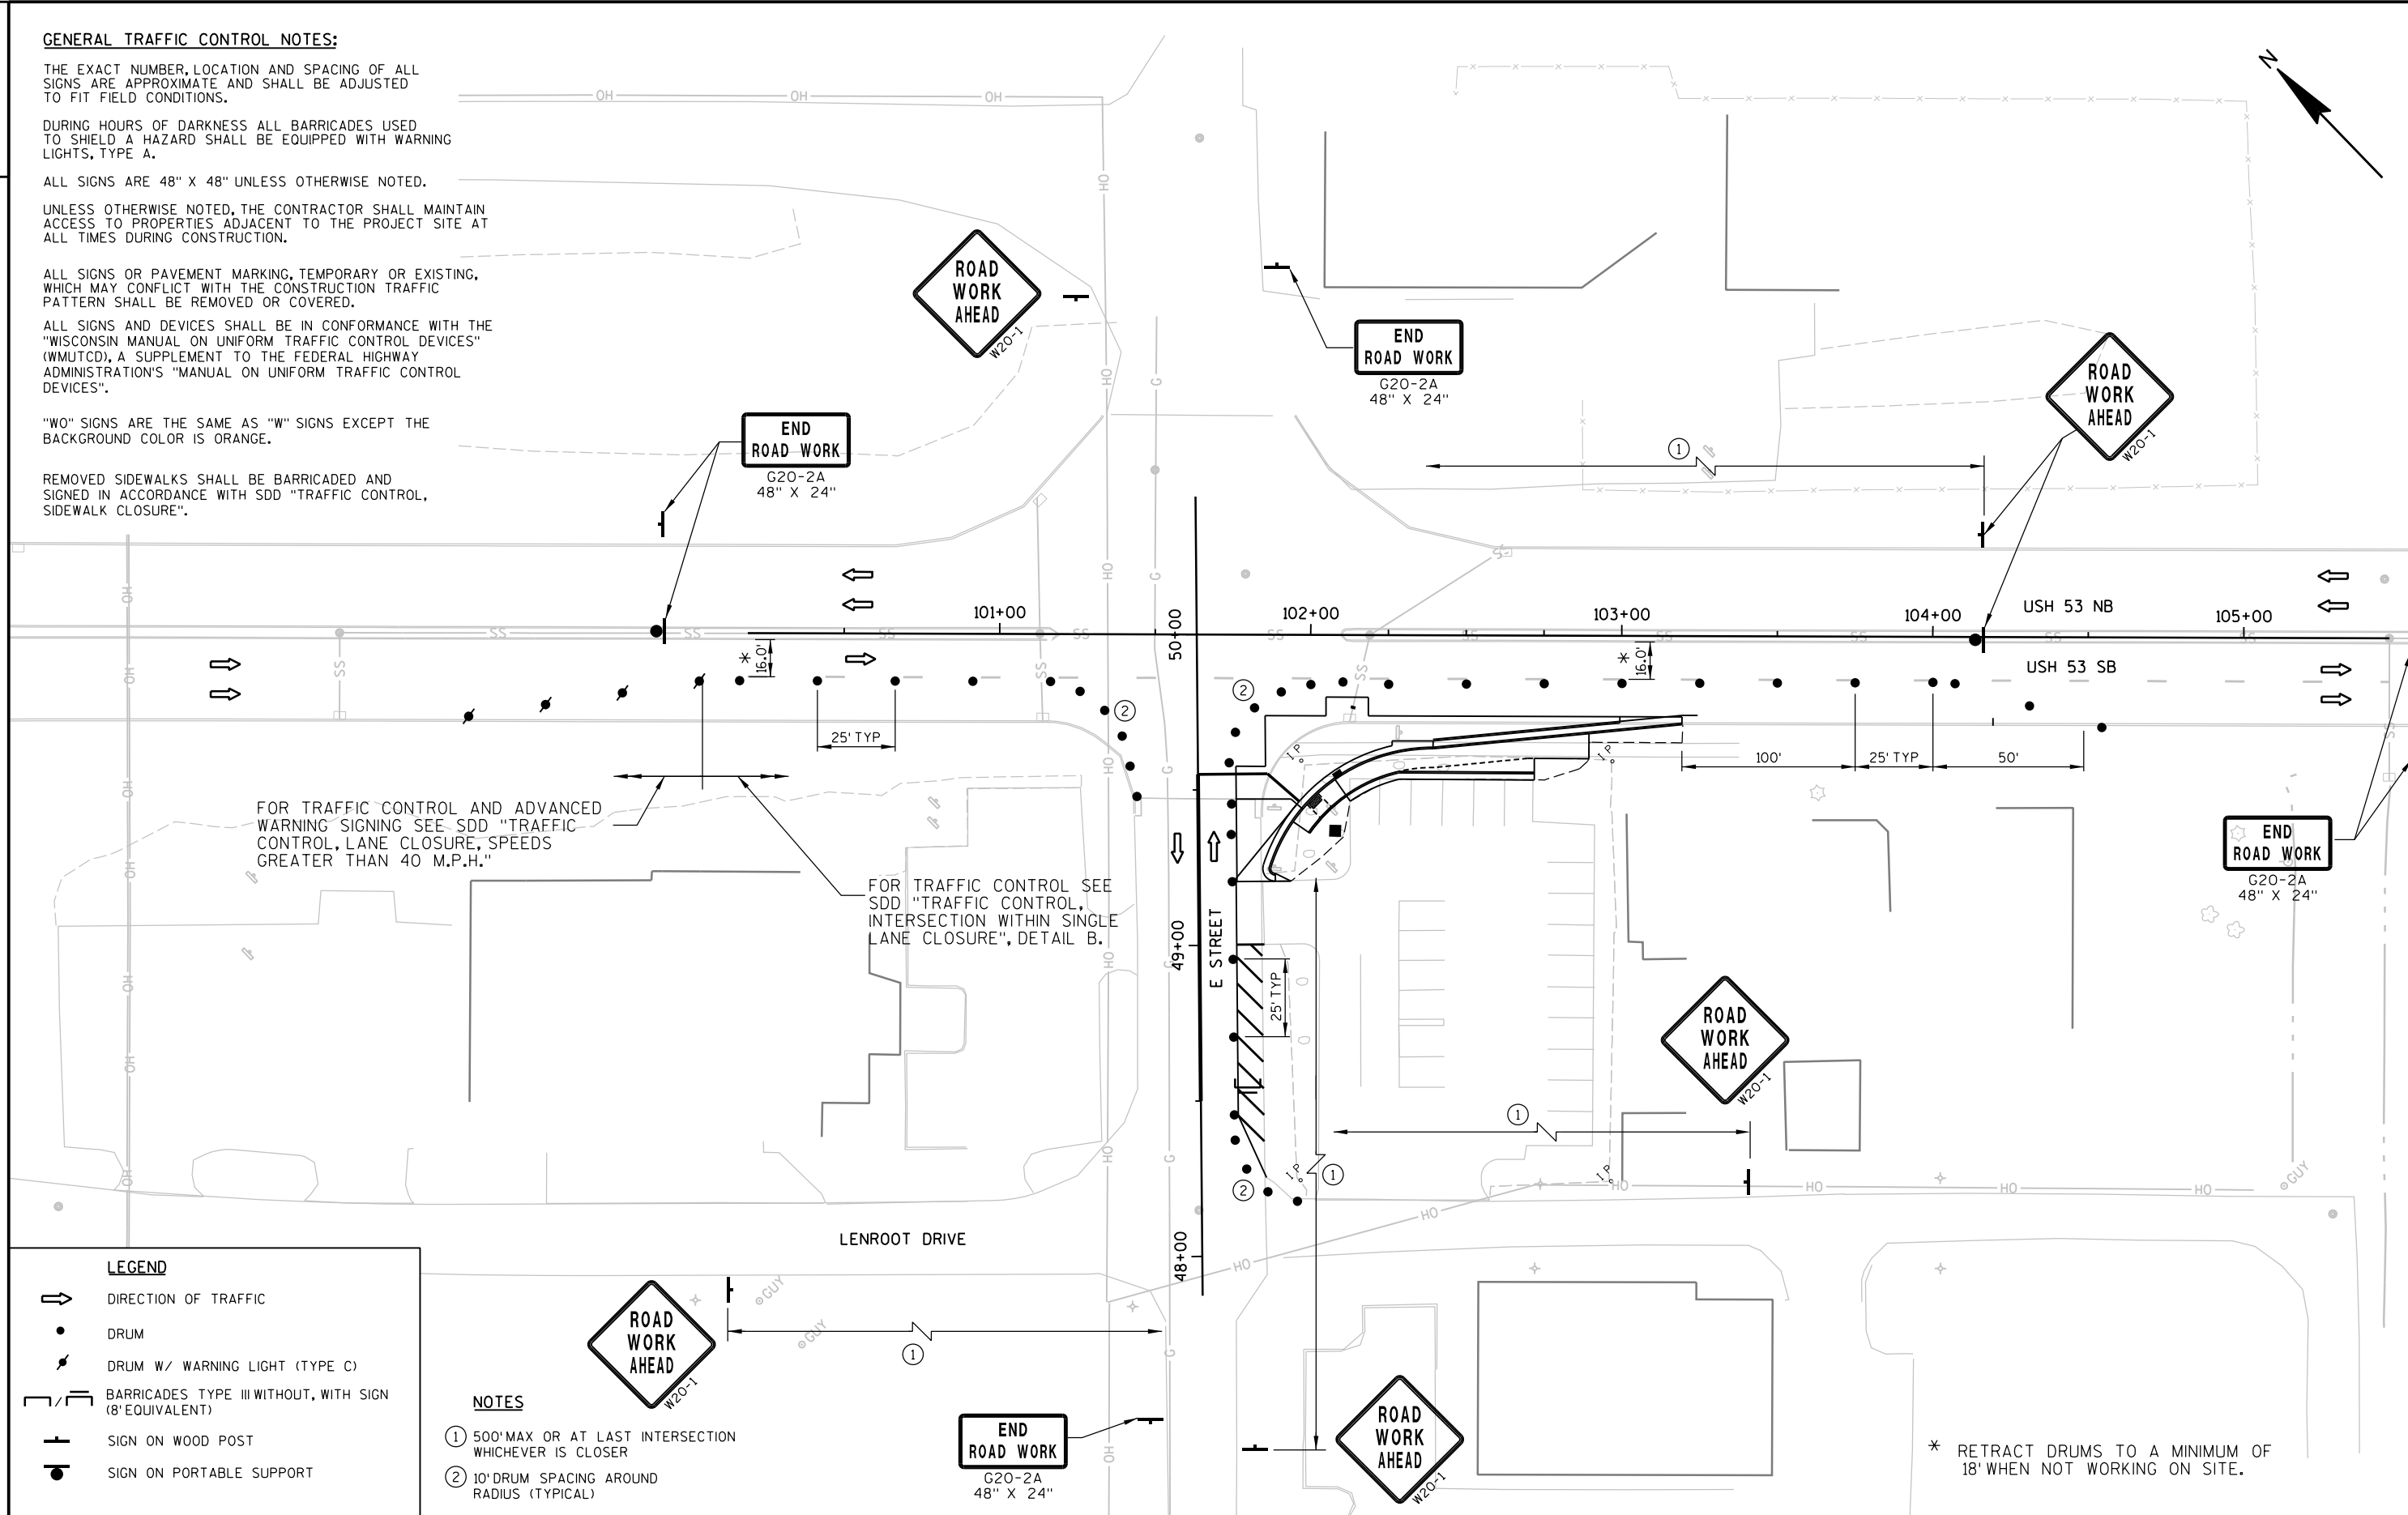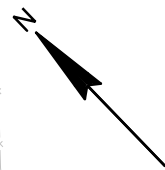

**LEGEND**

- DIRECTION OF TRAFFIC
- DRUM
- DRUM W/ WARNING LIGHT (TYPE C)
- BARRICADES TYPE III WITHOUT, WITH SIGN (8' EQUIVALENT)
- SIGN ON WOOD POST
- SIGN ON PORTABLE SUPPORT

**NOTES**

- ① 500' MAX OR AT LAST INTERSECTION WHICHEVER IS CLOSER
- ② 10' DRUM SPACING AROUND RADIUS (TYPICAL)

\* RETRACT DRUMS TO A MINIMUM OF 18' WHEN NOT WORKING ON SITE.

REMOVING PAVEMENT 204.0100

STATION	LOCATION	SY
EAST SECOND STREET 101+76.1 - 103+19.4	RT	33
<b>TOTAL</b>		<b>33</b>

BASE AGGREGATE 305.0125 310.0115

STATION	LOCATION	DENSE GRADED	
		1 1/4-INCH CY	OPEN GRADED CY
EAST SECOND STREET 101+76.1 - 103+19.4	RT- UNDER PAV'T AND C&G		75
101+76.1 - 103+19.4	UNDERDRAIN TRENCH		10
101+94.6 - 102+89.6	UNDER SIDEWALK	15	
102+11.7 - 102+72.0	UNDERDRAIN TRENCH		5
<b>TOTAL</b>		<b>15</b>	<b>90</b>

DRILLED DOWEL BARS 416.0620

STATION	LOCATION	EACH
EAST SECOND STREET 101+76.1	RT	9
101+85.6	RT	16
102+05.0	RT	5
102+18.6	RT	5
<b>TOTAL</b>		<b>35</b>

ASPHALTIC ITEMS 465.0105 455.0605

STATION	LOCATION	ASPHALTIC	
		SURFACE TON	TACK COAT GAL
E STREET 49+20 - 49+47	RT	20	3
<b>TOTAL</b>		<b>20</b>	<b>3</b>

CULVERT PIPE CONCRETE COLLAR 520.8000.S

STATION	LOCATION	EACH
EAST SECOND STREET 102+13.7	23.5' RT	1
<b>TOTAL</b>		<b>1</b>

CONCRETE CURB & GUTTER 601.0409 601.0411

STATION	LOCATION	30-INCH	
		TYPE A LF	TYPE D LF
EAST SECOND STREET 49+20.4 - 49+43.9	RADIUS - RT		27
101+97.3 - 102+39.4	RADIUS - RT	49	
102+39.4 - 103+19.4	TAPER - RT	81	
102+11.7 - 102+72.0	PARKING LOT - RT		63
<b>TOTAL</b>		<b>130</b>	<b>90</b>

REMOVING CURB AND GUTTER 204.0150

STATION	LOCATION	LF
EAST SECOND STREET 101+82.4 - 102+14.5	RADIUS - R	50
102+14.5 - 103+19.4	TAPER - RT	105
<b>TOTAL</b>		<b>155</b>

CONCRETE PAVEMENT HES 415.1090

STATION	LOCATION	9-INCH	
		SY	
EAST SECOND STREET 101+76.1 - 103+19.4	RT	160	
<b>TOTAL</b>		<b>160</b>	

DRILLED TIE BARS 416.0610

STATION	LOCATION	EACH
EAST SECOND STREET 101+76.1 - 101+85.6	RT	4
101+85.6 - 102+05.0	RT	8
102+05.0 - 102+18.6	RT	5
102+18.6 - 103+19.4	RT	40
<b>TOTAL</b>		<b>57</b>

REMOVING INLETS 204.0220

STATION	LOCATION	LF
EAST SECOND STREET 102+12.6	RADIUS - RT	1
<b>TOTAL</b>		<b>1</b>

COMMON EXCAVATION 205.0100

STATION	LOCATION	COMMON EXCAVATION (1) CUT (2)	SALVAGED/UNUSABLE PAVEMENT MATERIAL (4)	AVAILABLE MATERIAL (5)	EXPANDED FILL (13) UNEXPANDED FILL	MASS ORDINATE 1.30 +/- (14)	WASTE	BORROW	COMMENT	
										EAST SECOND STREET 23+00 - 29+20
E STREET 49+20 - 49+79	RT	60	2	58	1.5	2.0	56	56	0	PAVEMENT & BASE REMOVAL
UNDISTRIBUTED	RT	10	0	10	0.0	0.0	10	10	0	PAVEMENT & BASE REMOVAL
<b>TOTALS</b>		<b>195</b>	<b>35</b>	<b>160</b>	<b>1.5</b>	<b>2.0</b>	<b>158</b>	<b>158</b>	<b>0</b>	

- 1) Common Excavation is the sum of the Cut and EBS Excavation columns.
- 4) Salvaged/Unusable Pavement Curb & Gutter, Sidewalk and Asphalt Material
- 5) Available Material = Cut - Salvaged/Unusable Pavement Material
- 13) Expanded Fill Factor = 1.3
- 14) The Mass Ordinate + or - Qty calculated for the Division. Plus quantity indicates an excess of material within the Division. Minus indicates a shortage of material within the Division.

CONCRETE CURB PEDESTRIAN 601.0600

STATION	LOCATION	LF
EAST SECOND STREET 101+99.5 - 102+11.7	BACK OF SIDEWALK - RT	17
<b>TOTAL</b>		<b>17</b>

CONCRETE SIDEWALK 4-INCH 602.0405

STATION	LOCATION	SF
EAST SECOND STREET 101+94.6 - 102+89.6	RT	730
<b>TOTAL</b>		<b>730</b>

CURB RAMP DETECTABLE  
WARNING FIELD YELLOW 602.0505

STATION	LOCATION	SF
EAST SECOND STREET 101+01.8	RT	8
<b>TOTAL</b>		<b>8</b>

INLET PROTECTION 628.7005 628.7015

STATION	LOCATION	TYPE A EACH	TYPE C EACH
EAST SECOND STREET 102+08.1	62.7' RT	1	1
102+08.8	44.7' RT	1	
<b>TOTALS</b>		<b>2</b>	<b>1</b>

\* AS DIRECTED BY THE ENGINEER.

PIPE UNDERDRAIN 612.0106

STATION	LOCATION	6-INCH LF
EAST SECOND STREET 101+82.0 - 102+08.8	RT - FROM NORTH SIDE E STREET	40
101+84.8 - 102+39.4	RADIUS - RT	74
102+39.4 - 103+19.4	TAPER - RT	81
102+11.7 - 102+72.0	PARKING LOT - RT	65
<b>TOTAL</b>		<b>260</b>

\* TEES/WYES NEEDED FOR CONNECTION TO EXISTING UNDERDRAIN  
ARE CONSIDERED INCIDENTAL TO THE ITEM PIPE UNDERDRAIN.  
CONNECT PIPE UNDERDRAIN INTO NEW TYPE 3 AND TYPE 8 INLETS.  
LOCATE BELOW CURB AND GUTTER (SEE TYPICAL)

STORM SEWER 608.0315 608.0415 611.0303 611.0639 611.0642

STATION	LOCATION	SSPRC CLASS III 15-INCH LF	SSPRC CLASS IV 15-INCH LF	INLETS TYPE 3 EACH	INLETS TYPE 8 EACH	INLET COVERS TYPE H-S EACH	INLET COVERS TYPE MS EACH	TOP OF CASTING ELEV	INVERT ELEV	BOX DEPTH LF	COMMENTS
EAST SECOND STREET 102+08.1	62.7' RT	18			1		1	614.50	612.31	2.19	GRADE AREA BEHIND CURB TO INLET REMOVE EXISTING INLET, TIE INTO EXISTING PIPE WITH CONCRETE COLLAR
102+08.8	44.7' RT		22	1		1	614.55	612.19	2.05		
<b>TOTALS</b>		<b>18</b>	<b>22</b>	<b>1</b>	<b>1</b>	<b>1</b>	<b>1</b>				

SIGNING ITEMS

SIGN GROUP NUMBER	SIGN CODE	SIGN MESSAGE	SIGN SIZE W X H (INCHES)	SIGNS REFLECTIVE TYPE II SF	POSTS WOOD 4X6-INCH X 14-FT EACH	POSTS WOOD 4X6-INCH X 16-FT EACH	REMOVING SIGNS TYPE II EACH	REMOVING SMALL SIGN SUPPORTS EACH
1-1	J2-2	JCT 53 ARROW - LEFT/RIGHT TO 2	48 X 60	20.00		1	1	1
1-2	R1-1	STOP	36 X 36	7.46	1		1	1
1-3	R4-5L	TRUCKS USE LEFT LANE	24 X 30	5.00	1		1	2
<b>TOTALS</b>				<b>32.46</b>	<b>2</b>	<b>1</b>	<b>5</b>	<b>4</b>

TURF ESTABLISHMENT 625.0100 627.0200 629.0210 630.0140 630.0200

STATION	LOCATION	TOPSOIL SY	MULCHING SY	FERTILIZER TYPE B CWT	SEEDING MIXTURE NO. 40 LBS	SEEDING TEMPORARY LBS
EAST SECOND STREET 101+84.8 - 103+19.4	RT	113	113	0.1	2.0	3.0
UNDISTRIBUTED		7	27	0.1	1.0	1.0
<b>TOTALS</b>		<b>120</b>	<b>140</b>	<b>0.2</b>	<b>3</b>	<b>4</b>

TRAFFIC CONTROL 643.0300 643.0410 643.0420 643.0705 643.0715 643.0800 643.0900

STATION	DRUMS DAYS	BARRICADES TYPE II DAYS	BARRICADES TYPE III DAYS	WARNING LIGHTS TYPE A DAYS	WARNING LIGHTS TYPE C DAYS	ARROW BOARDS DAYS	SIGNS DAYS
EAST SECOND STREET 147+86 - 152+48	1000	75	75	225	350	50	300
E STREET 72+74 - 86+85	500	0	50	100	125	0	175
<b>TOTALS</b>		<b>1500</b>	<b>75</b>	<b>125</b>	<b>325</b>	<b>475</b>	<b>475</b>

MOBILIZATIONS 628.1905 628.1910

STATION	LOCATION	EROSION CONTROL EACH	EMERGENCY EROSION CONTROL EACH
EAST SECOND STREET 101+76.3 - 103+19.4	RT	1	1
<b>TOTALS</b>		<b>1</b>	<b>1</b>

GEOTEXTILE FABRIC 645.0111 645.0140

STATION	LOCATION	TYPE DF SCHEDULE A SY	TYPE SAS SY
EAST SECOND STREET 101+76.1 - 103+19.4	UNDER PAV'T & CURB - RT		270
101+76.1 - 103+19.4	UNDERDRAIN TRENCH	109	
102+11.7 - 102+72.0	UNDERDRAIN TRENCH	36	
<b>TOTALS</b>		<b>145</b>	<b>270</b>

PROJECT NO: 1195-00-74

HWY: EAST SECOND STREET

COUNTY: DOUGLAS

MISCELLANEOUS QUANTITIES

SHEET

E

3

STATION	LOCATION	LF	REMARKS
PAVEMENT MARKING			
		646.0106	647.0566 647.0716
		EPOXY 4-INCH	STOP LINE EPOXY 18-INCH
			DIAGONAL EPOXY 8-INCH
EAST SECOND STREET			
101+76.1 - 103+19.4	SB R	50	SKIP WHITE
102+39.0 - 103+19.4	RT	85	WHITE EDGELINE
E STREET			
48+25.0 - 49+25.0	RT	130	WHITE EDGELINE
48+25.0 - 49+00.0			100 12' LANE - SHLDR
48+50.0 - 49+55.0	R	210	DOUBLE YELLOW R
49+55.0	RT		R TO CURB WITH ANGLE
TOTALS		475	36 100

STATION	LOCATION	EACH	LF	LF	LF	LS	LF
CONSTRUCTION STAKING							
		650.4000	650.4500	650.5500	650.7000	650.9910	650.9920
		CONSTRUCTION STAKING STORM SEWER	CONSTRUCTION STAKING SUBGRADE	CONSTRUCTION STAKING CURB AND GUTTER	CONCRETE PAVEMENT	SUPPLEMENTAL CONTROL	SLOPE STAKES
EAST SECOND STREET							
49+20.4 - 49+43.9	RT			27			
101+76.1 - 103+19.4	RT		160		144	1	160
101+99.5 - 102+11.7	RT			17			
102+11.7 - 102+72.0	RT			63			
102+08.1	62.7' RT	1					
102+08.8	44.7' RT	1					
102+13.7	23.5' RT	1					
TOTALS		3	160	107	144	1	160

STATION	LOCATION	ASPHALT LF	CONCRETE LF	COMMENT
SAWING				
		690.0150	690.0250	
EAST SECOND STREET				
101+76.1 - 103+19.4	RT		192.5	BEGIN CONSTRUCTION, ALONG JOINTS, INCLUDES CURB & GUTTER
102+11.7 - 102+72	RT	63		PARKING LOT EDGE
102+89.6	RT		5.0	SIDEWALK
103+19.4	RT		2.5	END CONSTRUCTION - C&G
E STREET				
49+20.4 - 49+47.0	RT	37		12' RT TO SHLDR
TOTALS		100	200	

STATION	LOCATION	EACH
MOVING BOULDERS		
SPV.0060.01		
EAST SECOND STREET		
102+00.5	57' RT	1
102+05.7	47' RT	1
102+28.6	42' RT	1
102+42.8	43' RT	1
TOTAL		4



STATION	LOCATION	LF
CONCRETE CURB AND GUTTER CURE AND SEAL TREATMENT		
SPV.0090.01		
EAST SECOND STREET		
49+20.4 - 49+43.9	RADIUS - RT	27
101+97.3 - 102+39.4	RADIUS - RT	49
101+99.5 - 102+11.7	BACK OF SIDEWALK - RT	17
102+39.4 - 103+19.4	TAPER - RT	81
102+11.7 - 102+72.0	PARKING LOT - RT	63
TOTAL		237

STATION	LOCATION	LS
CONSTRUCTION STAKING CONCRETE PAVEMENT JOINT LAYOUT		
SPV.0105.01		
EAST SECOND STREET		
101+76 - 103+19	RT	1
TOTAL		1

STATION	LOCATION	LS
SALVAGING BLUE STONE		
SPV.0105.02		
EAST SECOND STREET		
102+00	RT	1
TOTAL		1

STATION	LOCATION	SF
CONCRETE SIDEWALK 4-INCH PROTECTIVE SURFACE TREATMENT		
SPV.0165.01		
EAST SECOND STREET		
101+94.6 - 102+89.6	RT	730
TOTAL		730

3

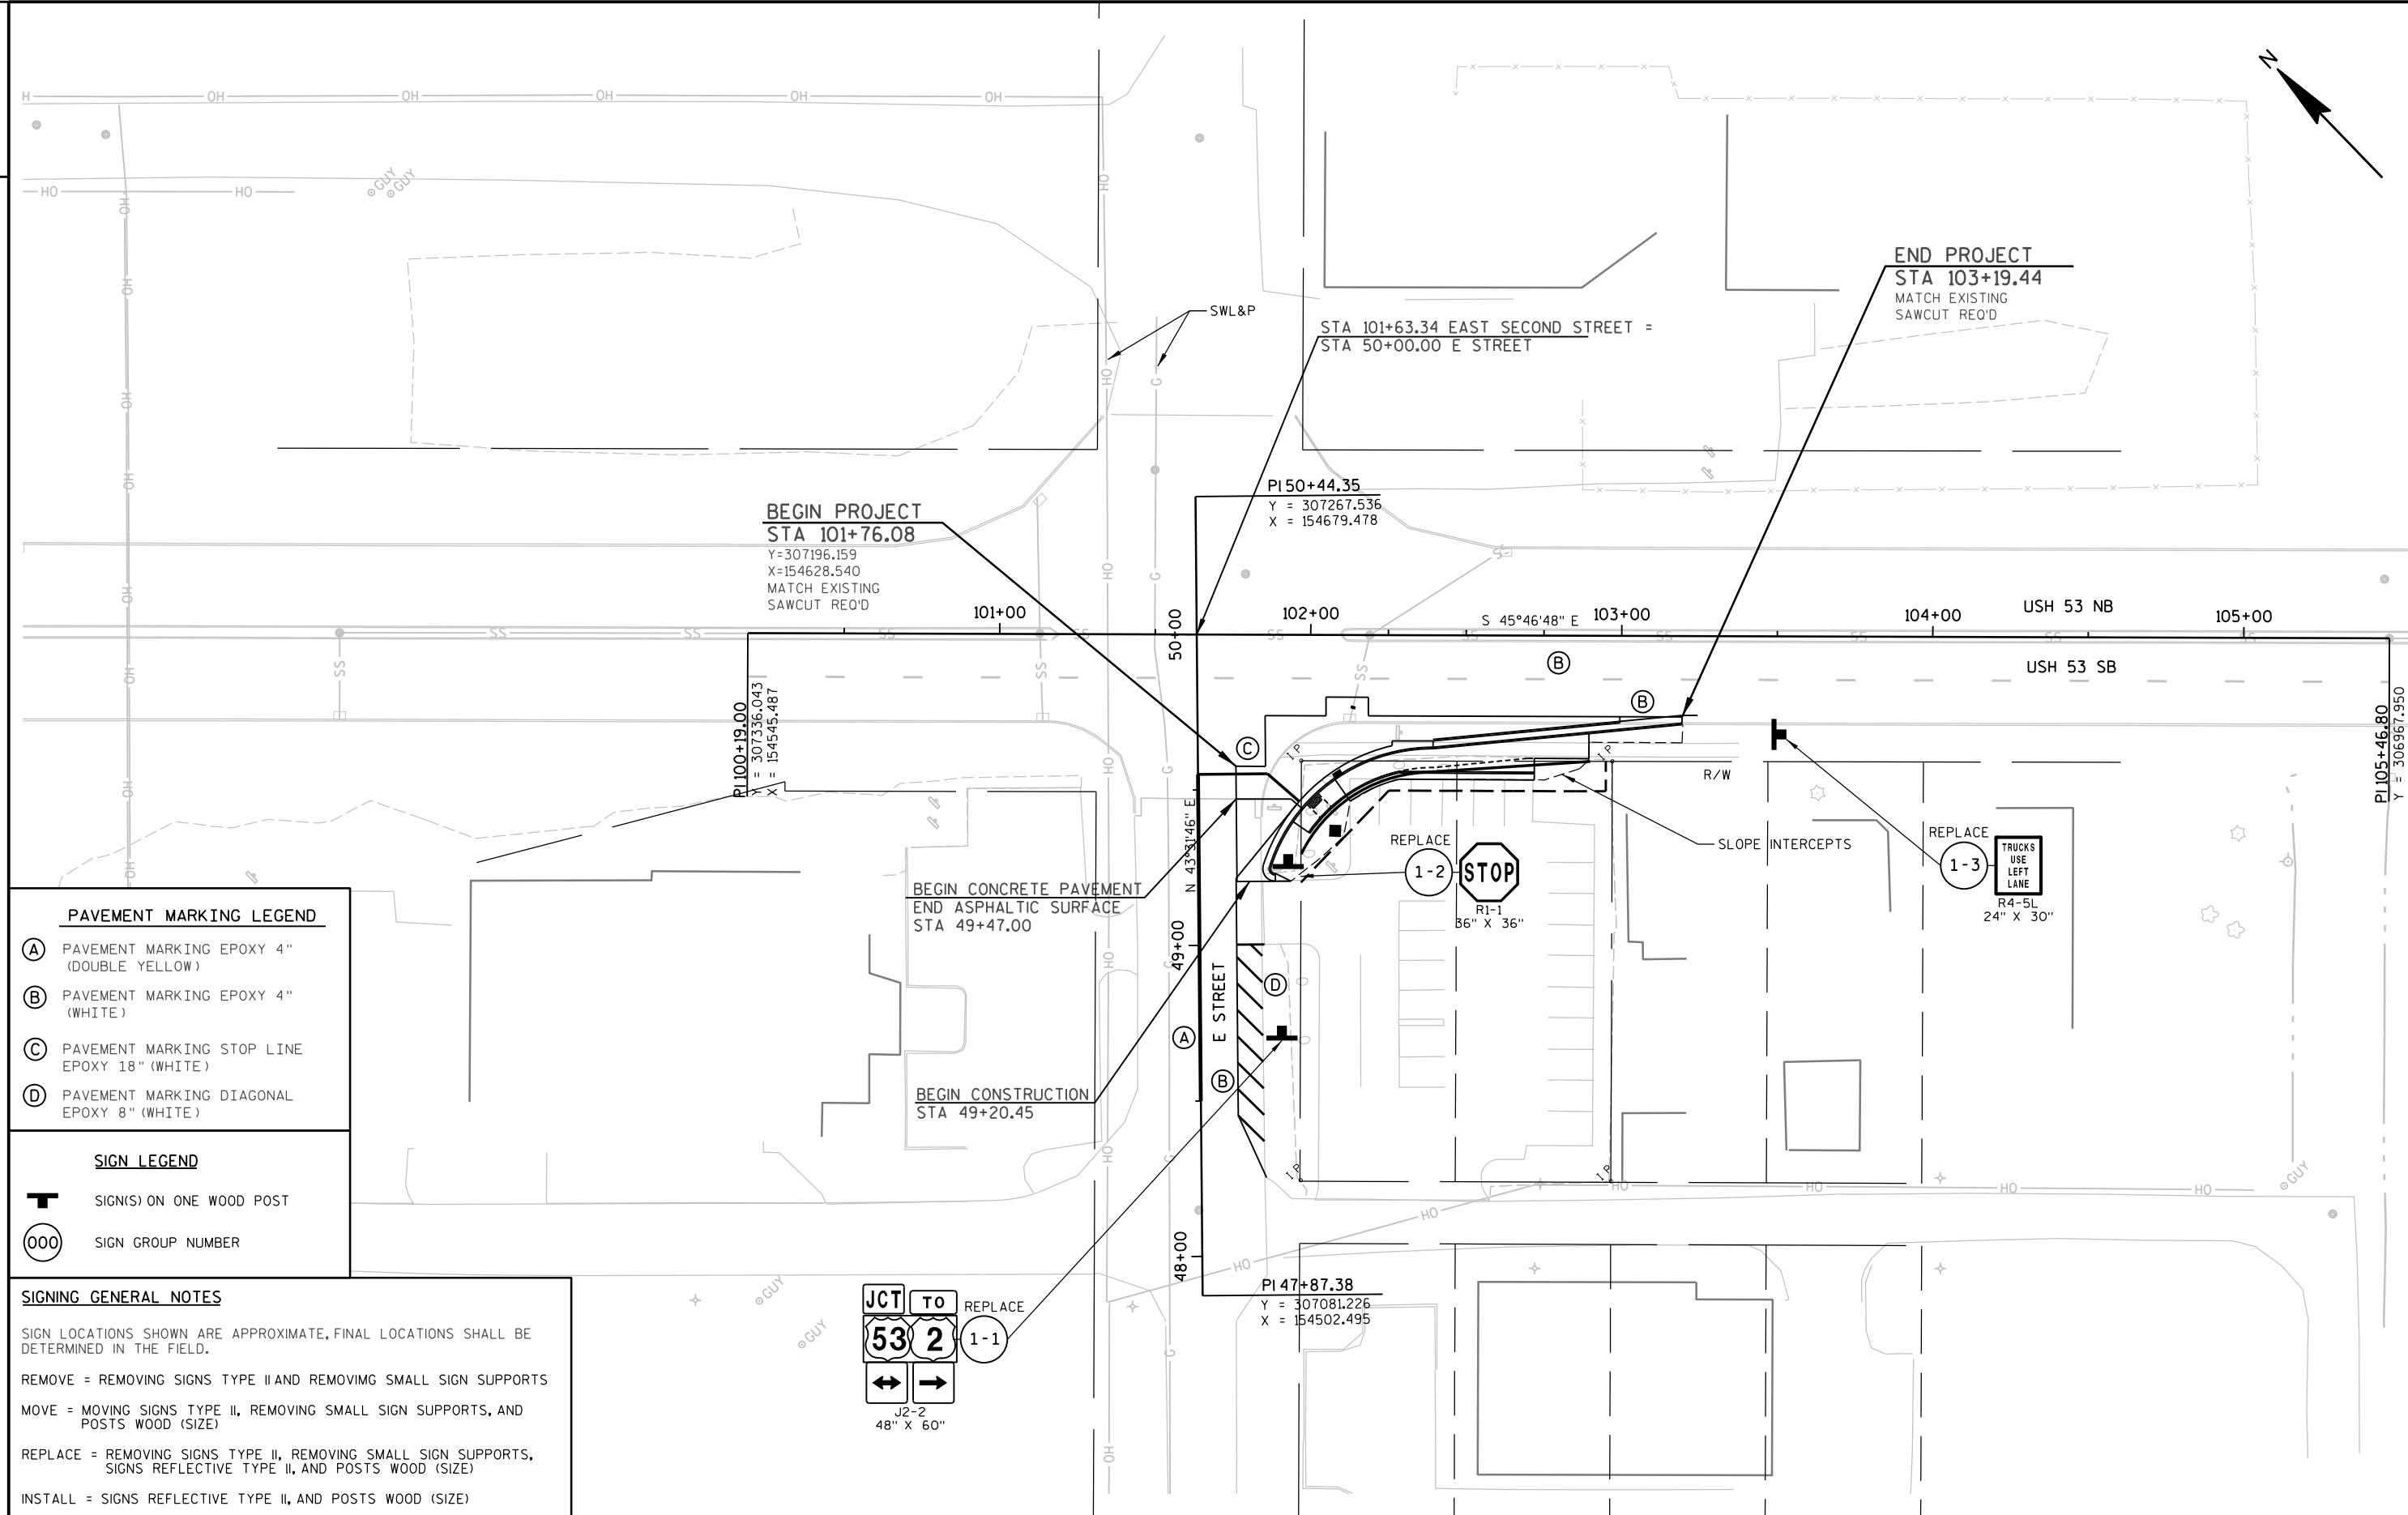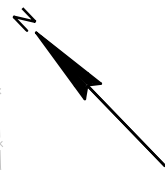

**PAVEMENT MARKING LEGEND**

(A)	PAVEMENT MARKING EPOXY 4" (DOUBLE YELLOW)
(B)	PAVEMENT MARKING EPOXY 4" (WHITE)
(C)	PAVEMENT MARKING STOP LINE EPOXY 18" (WHITE)
(D)	PAVEMENT MARKING DIAGONAL EPOXY 8" (WHITE)

**SIGN LEGEND**

	SIGN(S) ON ONE WOOD POST
	SIGN GROUP NUMBER

**SIGNING GENERAL NOTES**


SIGN LOCATIONS SHOWN ARE APPROXIMATE, FINAL LOCATIONS SHALL BE DETERMINED IN THE FIELD.

REMOVE = REMOVING SIGNS TYPE II AND REMOVING SMALL SIGN SUPPORTS

MOVE = MOVING SIGNS TYPE II, REMOVING SMALL SIGN SUPPORTS, AND POSTS WOOD (SIZE)



REPLACE = REMOVING SIGNS TYPE II, REMOVING SMALL SIGN SUPPORTS, SIGNS REFLECTIVE TYPE II, AND POSTS WOOD (SIZE)

INSTALL = SIGNS REFLECTIVE TYPE II, AND POSTS WOOD (SIZE)

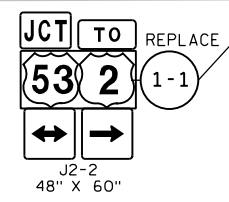




NOTE:  
GRATE IS REVERSIBLE.

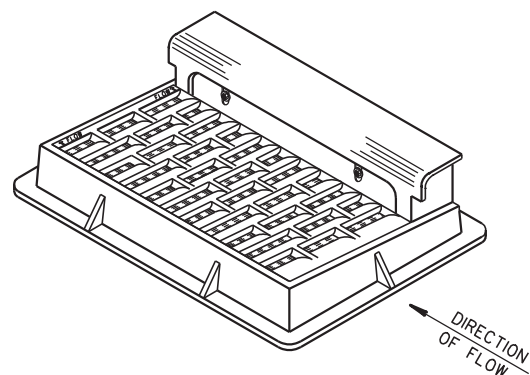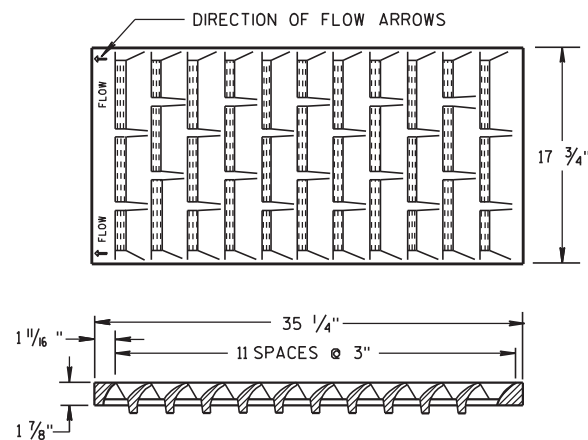


NOTE: CURB BOX HEIGHT ADJUSTABLE 6" TO 9"

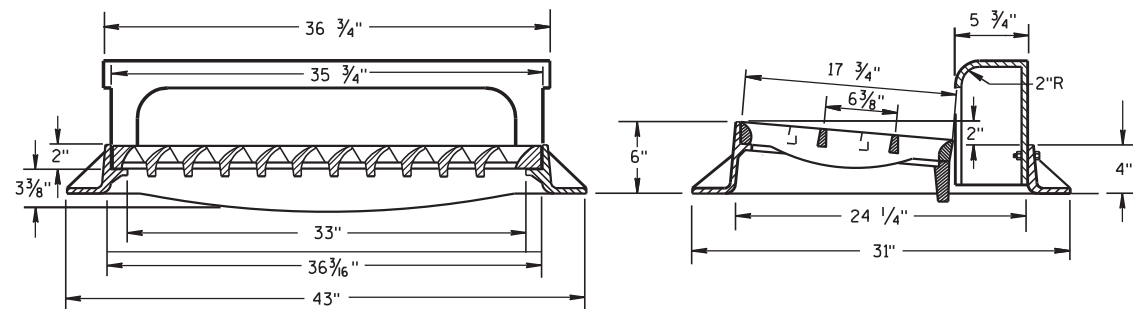

**TYPE "H"**

(APPROXIMATE WEIGHT 422 LBS.)  
FRAME..... 175 LBS.  
GRATE..... 138 LBS.  
CURB BOX..... 109 LBS.

1 1/8" DIAGONAL BARS WITH 1 5/8" OPENINGS

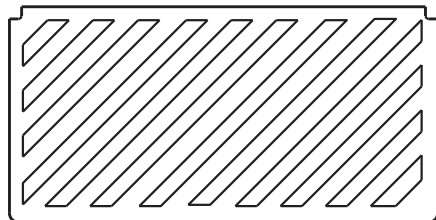

**SPECIAL GRATE FOR TYPE "H" COVER**

(MEASURES 35 1/4" X 17 3/4" X 2")  
(APPROXIMATE WEIGHT 172 LBS.)  
GRATE..... 172 LBS.

(NOTED AS TYPE H-S ON DRAINAGE TABLE)



**GENERAL NOTES**

DETAILS OF CONSTRUCTION, MATERIALS AND WORKMANSHIP NOT SHOWN ON THIS DRAWING SHALL CONFORM TO THE PERTINENT REQUIREMENTS OF THE STANDARD SPECIFICATIONS AND THE APPLICABLE SPECIAL PROVISIONS.



DETAIL DRAWINGS FOR PROPOSED ALTERNATE DESIGNS FOR CATCH BASIN, MANHOLE AND INLET COVERS SHALL BE SUBMITTED TO THE ENGINEER FOR APPROVAL PROVIDING THAT SUCH ALTERNATE DESIGNS MAKE PROVISION FOR EQUIVALENT CAPACITY AND STRENGTH.

ROUND FRAMES AND COVERS SHALL HAVE CONTINUOUSLY MACHINED BEARING SURFACES TO PREVENT ROCKING AND RATTLING.

THE ACTUAL WEIGHT OF COVERS MAY VARY WITHIN 5 PERCENT, PLUS OR MINUS, OF THE APPROXIMATE WEIGHT.

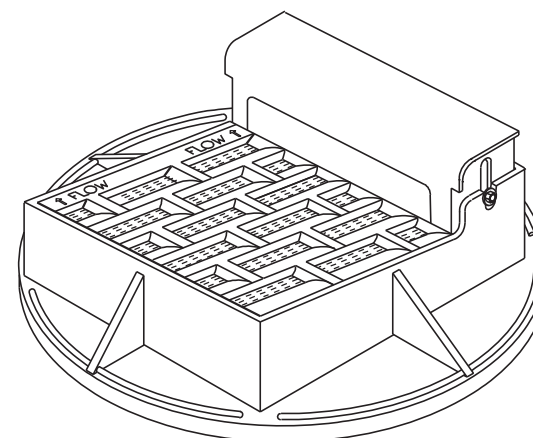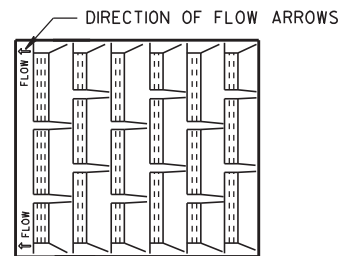

NOTE: CURB BOX ADJUSTABLE 4" TO 9"

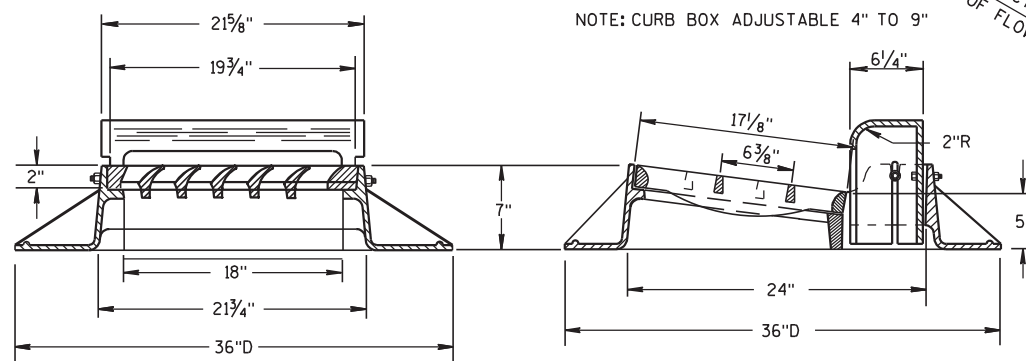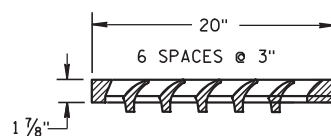


**TYPE "A"**

(APPROXIMATE WEIGHT 325 LBS.)  
FRAME..... 157 LBS.  
GRATE..... 84 LBS.  
CURB BOX..... 84 LBS.

NOTE:  
GRATE IS REVERSIBLE.

1" DIAGONAL BARS WITH 1 1/2" OPENINGS

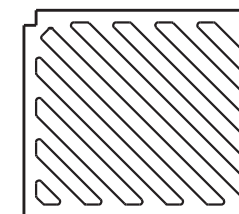

**SPECIAL GRATE FOR TYPE "A" COVER**

(MEASURES 19 3/4" X 17" X 1 7/8")  
GRATE..... 84 LBS.

(NOTED AS TYPE A-S ON DRAINAGE TABLE)



6

6



**INLET COVERS  
TYPE A, H, A-S, & H-S**

STATE OF WISCONSIN  
DEPARTMENT OF TRANSPORTATION



APPROVED  
10/4/1999 /S/ Rory L. Rhinesmith  
DATE CHIEF ROADWAY DEVELOPMENT ENGINEER  
FHWA

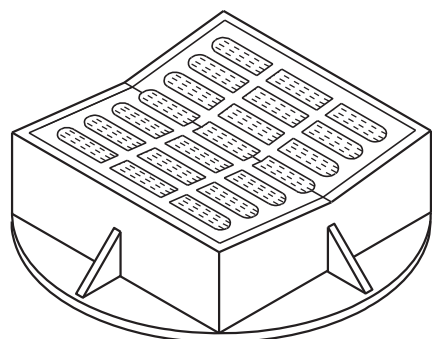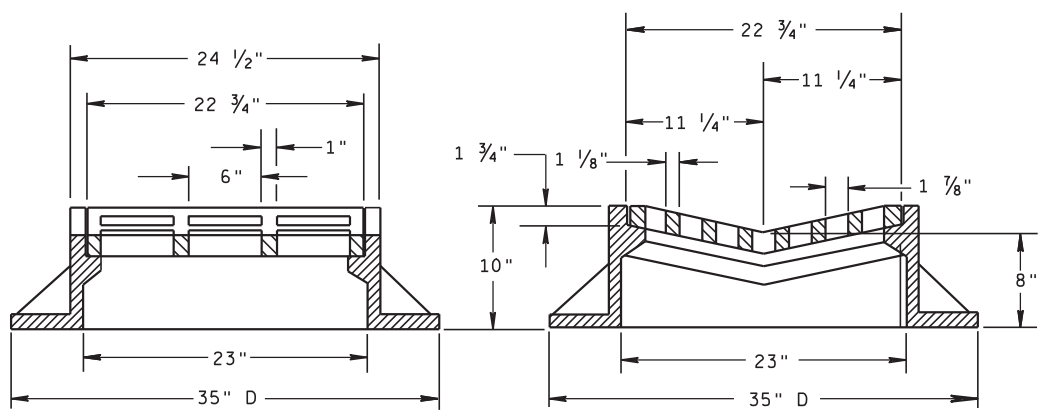

**TYPE "B"**  
(APPROXIMATE WEIGHT 395 LBS.)  
FRAME..... 285 LBS.  
GRATE..... 110 LBS.

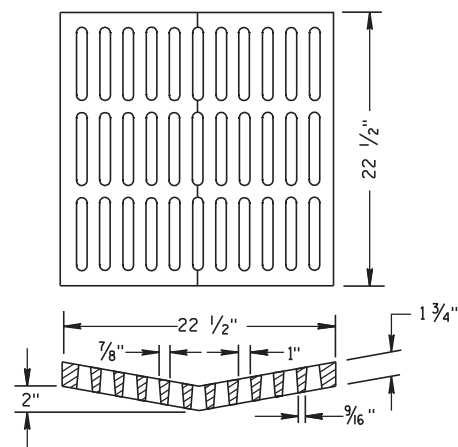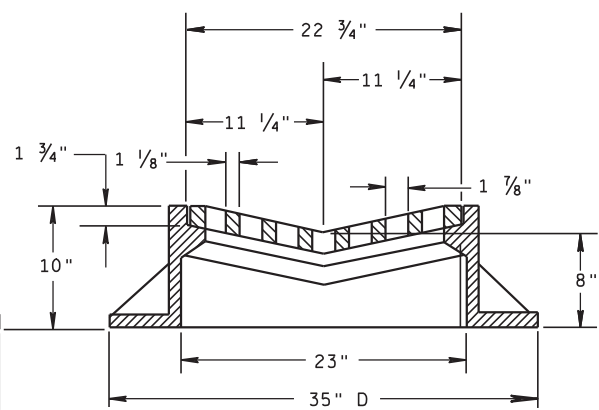

**ALTERNATIVE GRATE FOR TYPE "B" COVER**  
(APPROXIMATE GRATE WEIGHT 125 LBS.)  
GRATE.....125 LBS.  
USE WHERE PEDESTRIAN OR BICYCLE TRAFFIC IS POSSIBLE.  
**NOTED AS TYPE B-A ON THE DRAINAGE TABLE**

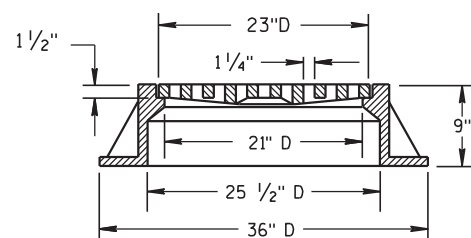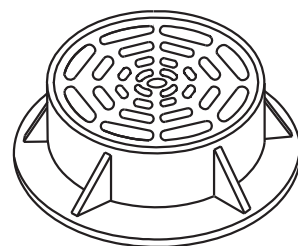

**TYPE "C"**  
(APPROXIMATE WEIGHT 340 LBS.)  
FRAME..... 235 LBS.  
GRATE..... 105 LBS.


**GENERAL NOTES**

DETAILS OF CONSTRUCTION, MATERIALS AND WORKMANSHIP NOT SHOWN ON THIS DRAWING SHALL CONFORM TO THE PERTINENT REQUIREMENTS OF THE STANDARD SPECIFICATIONS AND THE APPLICABLE SPECIAL PROVISIONS.

DETAIL DRAWINGS FOR PROPOSED ALTERNATE DESIGNS FOR CATCH BASIN, MANHOLE AND INLET COVERS SHALL BE SUBMITTED TO THE ENGINEER FOR APPROVAL PROVIDING THAT SUCH ALTERNATE DESIGNS MAKE PROVISION FOR EQUIVALENT CAPACITY AND STRENGTH.


ROUND FRAMES AND COVERS SHALL HAVE CONTINUOUSLY MACHINED BEARING SURFACES TO PREVENT ROCKING AND RATTLING.

THE ACTUAL WEIGHT OF COVERS MAY VARY WITHIN 5 PERCENT, PLUS OR MINUS, OF THE APPROXIMATE WEIGHT.

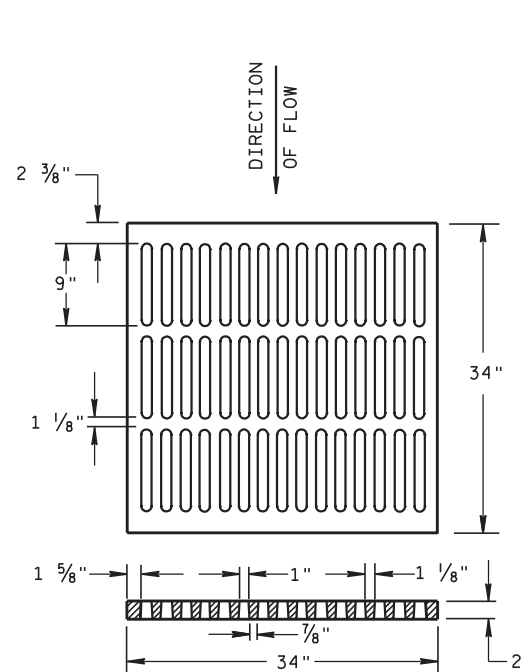



**ALTERNATIVE TYPE "MS"**  
(APPROXIMATE GRATE WEIGHT 365 LBS.)  
GRATE.....365 LBS.

USE WHERE PEDESTRIAN OR BICYCLE TRAFFIC IS PERMITTED  
**NOTED AS TYPE MS-A ON THE DRAINAGE TABLE**

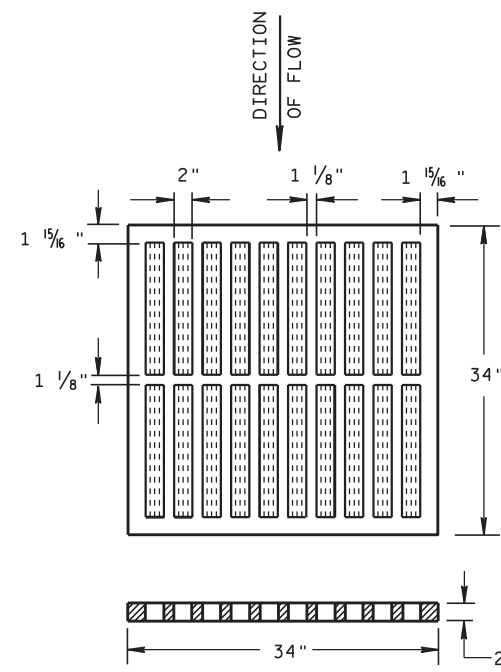

**TYPE "MS"**  
(APPROXIMATE GRATE WEIGHT 270 LBS.)  
GRATE.....270 LBS.

USE ON FREEWAYS AND EXPRESSWAYS  
**NOTED AS TYPE MS ON DRAINAGE TABLE**

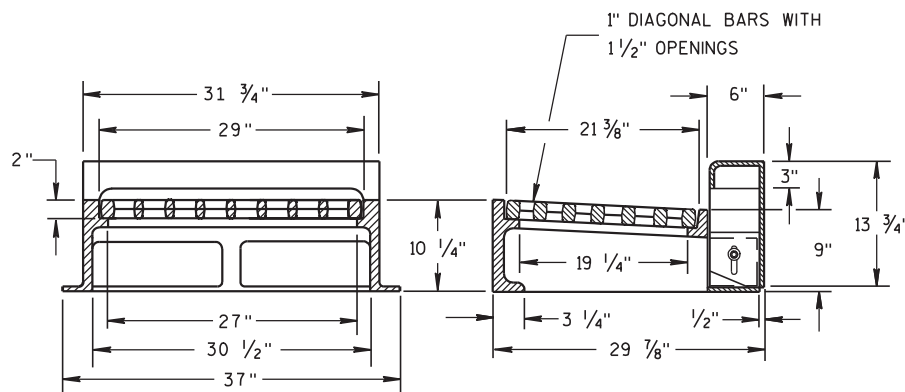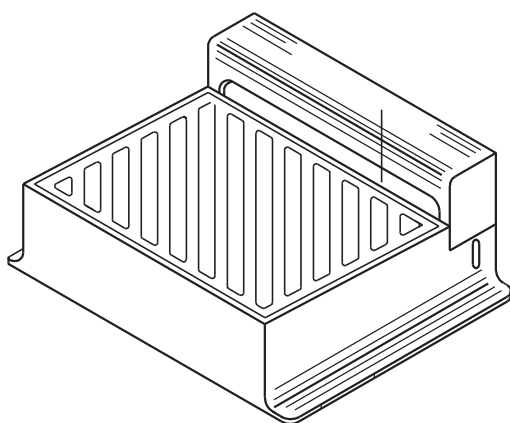

NOTE: CURB BOX HEIGHT ADJUSTABLE 6" TO 9"

**TYPE "WM"**  
(APPROXIMATE WEIGHT 670 LBS.)  
FRAME..... 360 LBS.  
GRATE..... 160 LBS.  
CURB BOX..... 150 LBS.


DIAGONAL SLOTS, SHALL BE ORIENTED TO THE DIRECTION OF FLOW AS ILLUSTRATED. GRATES ARE MANUFACTURED TO BE REVERSIBLE.

DIRECTION OF FLOW

**INLET COVERS**  
**TYPE B, B-A, C, MS, MS-A, & WM**



STATE OF WISCONSIN  
DEPARTMENT OF TRANSPORTATION

APPROVED  
10/4/1999 /S/ Rory L. Rhinesmith  
DATE CHEIF ROADWAY DEVELOPMENT ENGINEER  
FHWA

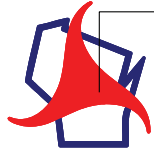

# 8C1: Inlets Type 1, 2, 3 & 4

\*SELECTION OF SQUARE OR CIRCULAR DESIGN WILL BE BASED ON THE PIPE SIZES AND THE INLET COVER BEING UTILIZED

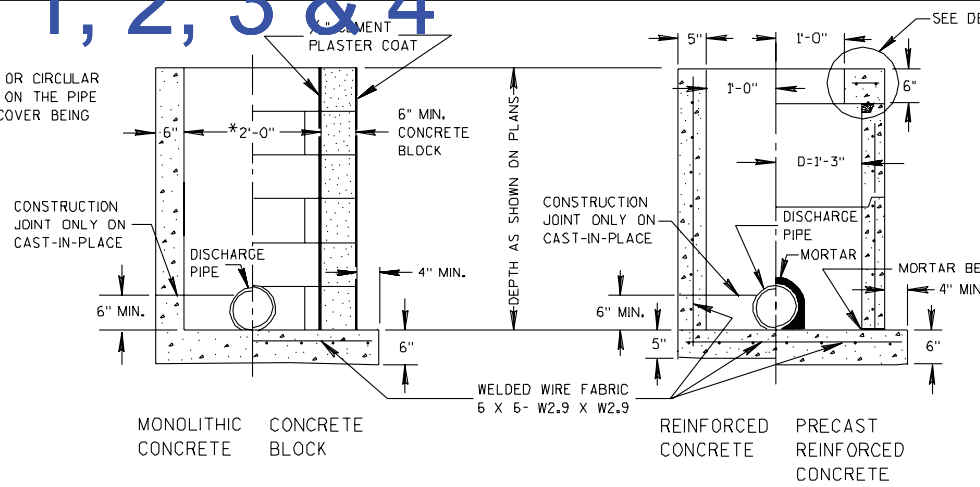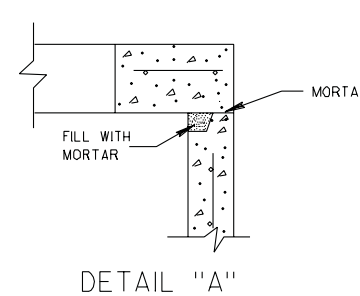

## GENERAL NOTES

DETAILS OF CONSTRUCTION, MATERIALS AND WORKMANSHIP NOT SHOWN ON THIS DRAWING SHALL CONFORM TO THE PERTINENT REQUIREMENTS OF THE STANDARD SPECIFICATIONS AND THE APPLICABLE SPECIAL PROVISIONS.

DETAILED DRAWINGS FOR PROPOSED ALTERNATE DESIGNS FOR UNDERGROUND DRAINAGE STRUCTURES SHALL BE SUBMITTED TO THE ENGINEER FOR APPROVAL PROVIDING THAT SUCH ALTERNATE DESIGNS MAKE PROVISION FOR EQUIVALENT CAPACITY AND STRENGTH.

ALL PRECAST INLET UNITS SHALL CONFORM TO THE PERTINENT REQUIREMENTS OF AASHTO DESIGNATION M 199.

ALL DRAINAGE STRUCTURES ARE DESIGNATED ON THE PLANS AS "MANHOLES I-C", "CATCH BASINS I-B", "INLETS 3-H", ETC. THE FIRST DIGIT DESIGNATES THE MASONRY PORTION OF THE STRUCTURE, AND THE FOLLOWING LETTER DESIGNATES THE TYPE OF COVER TO BE USED TO COMPRISE THE COMPLETE UNIT.





PRECAST REINFORCED BASES SHALL BE PLACED ON A BED OF MATERIAL AT LEAST 6 INCHES IN DEPTH, WHICH MEETS THE REQUIREMENTS OF GRANULAR BACKFILL. THIS BEDDING SHALL BE COMPACTED AND PROVIDE UNIFORM SUPPORT FOR THE ENTIRE AREA OF THE BASE.

PRECAST REINFORCED CONCRETE FLAT SLAB TOPS MAY BE USED ON THE STRUCTURES. THE TOPS SHALL BE INSTALLED ON A BED OF MORTAR.

ALL BAR STEEL REINFORCEMENT SHALL BE EMBEDDED 2 INCHES CLEAR UNLESS OTHERWISE SHOWN OR NOTED.

PRECAST REINFORCED CONCRETE RISERS SHALL BE PLACED WITH TONGUE DOWN.

- ① USE 2'-6" OPENING FOR TYPE 2 INLETS, 3'-0" OPENING FOR TYPE 3 INLETS, AND 2'-11" FOR TYPE 4 INLETS.
- ② USE 2'-0" OPENING FOR TYPE 1, 2 & 3 INLETS, 2'-6 1/2" OPENING FOR TYPE 4 INLETS.

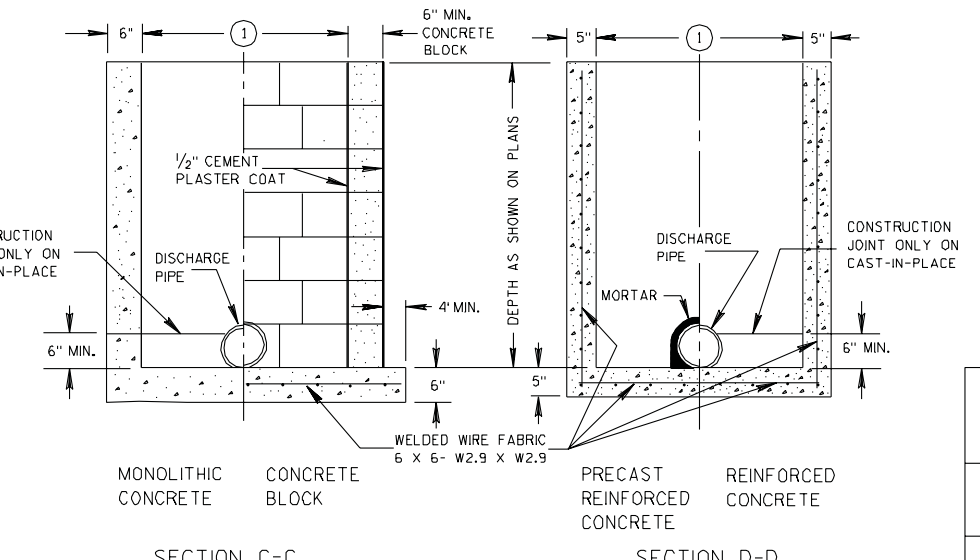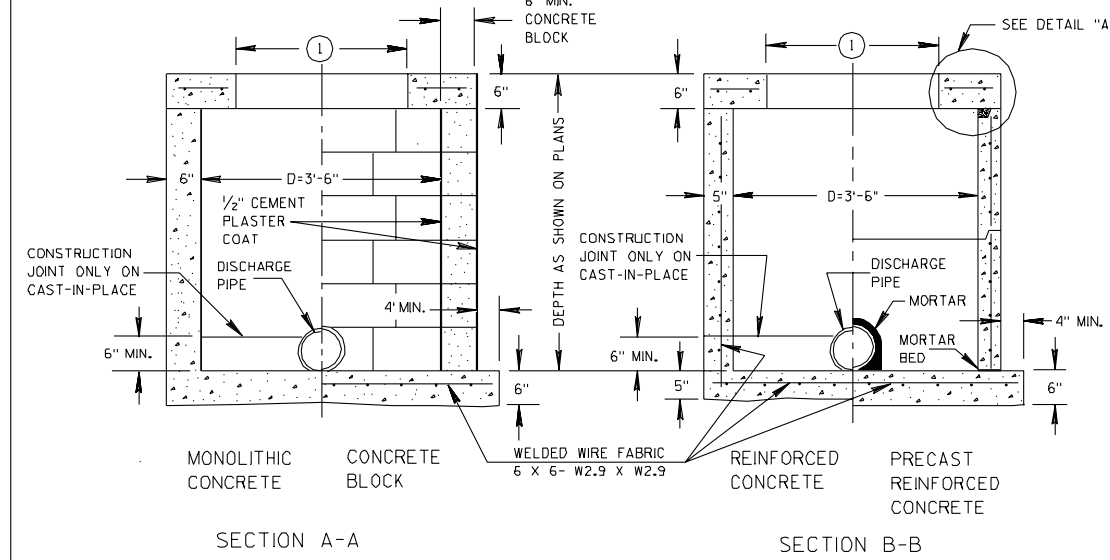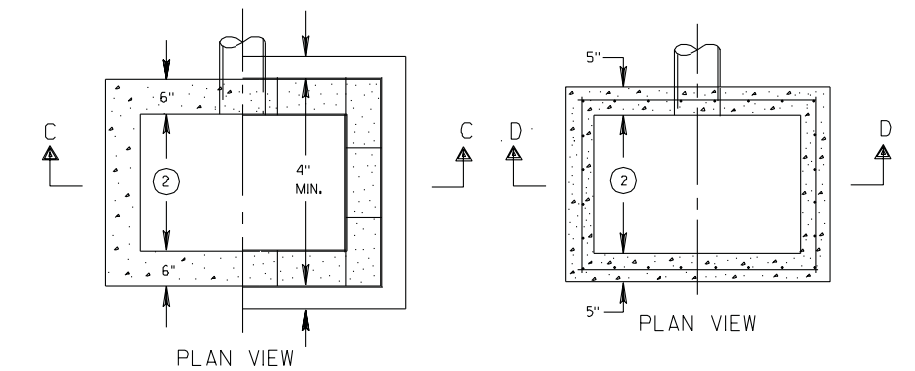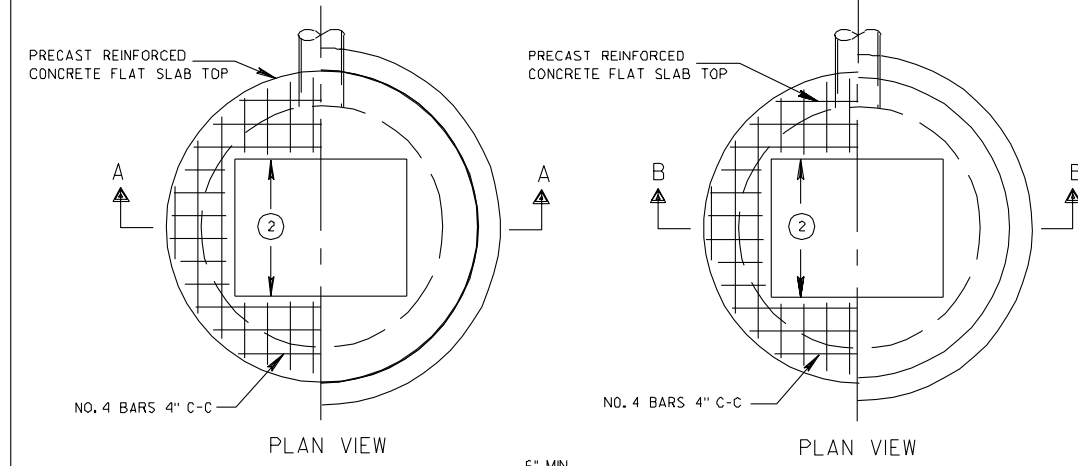

INLETS TYPE 2, 3 & 4

INLETS TYPE 1, 2, 3 & 4

STATE OF WISCONSIN  
DEPARTMENT OF TRANSPORTATION

APPROVED \_\_\_\_\_  
DATE \_\_\_\_\_ CHIEF ROADWAY DEVELOPMENT ENGINEER  
FHWA

REVISION DATE: \_\_\_\_\_

FILE NAME: \_\_\_\_\_

PLOT SCALE: 1/4

PLOT NAME: \_\_\_\_\_

DATE \_\_\_\_\_ STATE MAT'L'S ENGINEER FOR HWYS

APPROVED \_\_\_\_\_

DATE \_\_\_\_\_ STATE CONST. ENGINEER FOR HWYS


APPROVED \_\_\_\_\_

DATE \_\_\_\_\_ STATE DESIGN ENGINEER FOR HWYS

APPROVED \_\_\_\_\_

S.D.D. 8 C 1-5



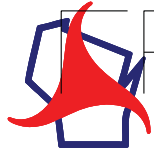

# 8C5: Inlets Type 8, 9, 10 and 11

## GENERAL NOTES


DETAILS OF CONSTRUCTION, MATERIALS AND WORKMANSHIP NOT SHOWN ON THIS DRAWING SHALL CONFORM TO THE PERTINENT REQUIREMENTS OF THE STANDARD SPECIFICATIONS AND THE APPLICABLE SPECIAL PROVISIONS.

DETAILED DRAWINGS FOR PROPOSED ALTERNATE DESIGNS FOR INLETS WHICH MAY INCLUDE PRECAST REINFORCED CONCRETE INLETS, SHALL BE SUBMITTED TO THE ENGINEER FOR APPROVAL PROVIDING THAT SUCH ALTERNATE DESIGNS MAKE PROVISION FOR EQUIVALENT CAPACITY AND STRENGTH.


PRECAST REINFORCED CONCRETE INLET UNITS, IF USED, SHALL CONFORM TO THE REQUIREMENTS OF THE CATCH BASINS, MANHOLES AND INLETS SECTION OF THE STANDARD SPECIFICATIONS. UNLESS OTHERWISE AUTHORIZED IN WRITING BY THE ENGINEER, THE CONTRACTOR SHALL NOT ORDER AND DELIVER PRECAST INLET UNITS REQUIRED FOR THE PROJECT UNTIL A CORRECTED LIST OF SIZES IS FURNISHED BY THE ENGINEER.

ALL INLETS ARE DESIGNATED ON THE PLANS AS "INLETS, 8-MS", ETC. THIS DESIGNATION IS INTERPRETED TO MEAN THAT THE NUMBER, OR FIRST DIGIT DESIGNATES THE MASONRY PORTION OF THE STRUCTURE AND THE FOLLOWING LETTER DESIGNATES THE TYPE OF COVER OR IRON CASTING TO BE USED THEREWITH TO COMPRISE THE COMPLETE UNIT.

ALL BAR STEEL REINFORCEMENT SHALL BE EMBEDDED 2 INCHES CLEAR UNLESS OTHERWISE SHOWN OR NOTED.

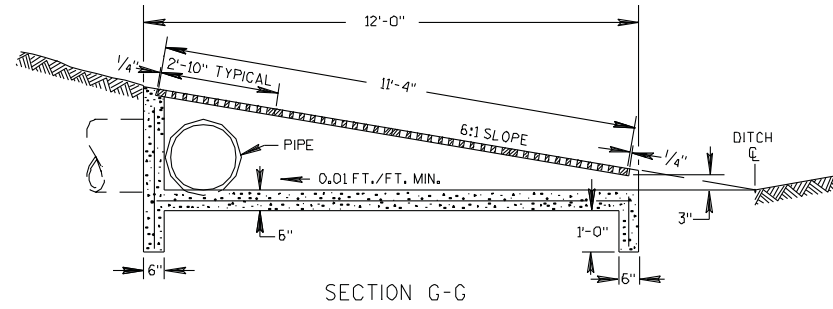


SECTION G-G

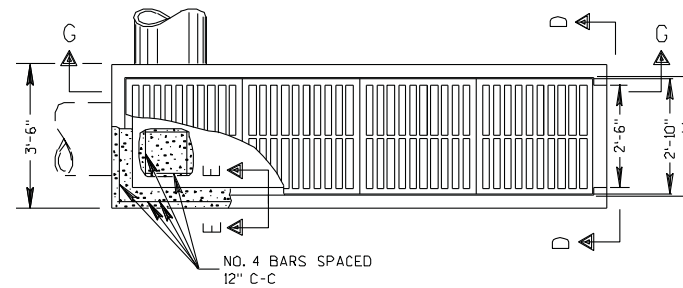


PLAN VIEW

REINFORCED CONCRETE INLET TYPE 11

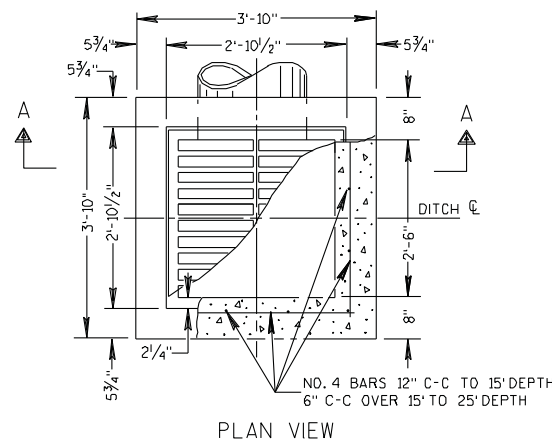


PLAN VIEW

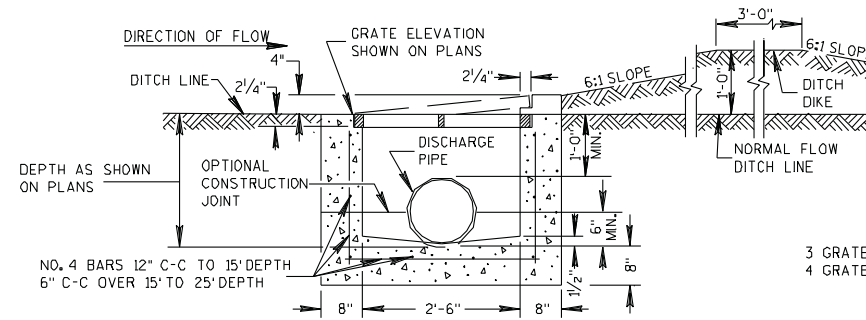


SECTION A-A


REINFORCED CONCRETE INLET TYPE 8

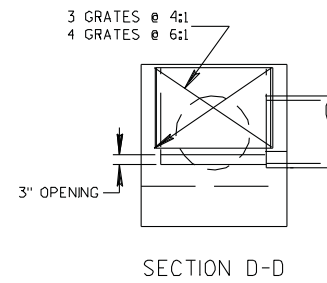

SECTION D-D

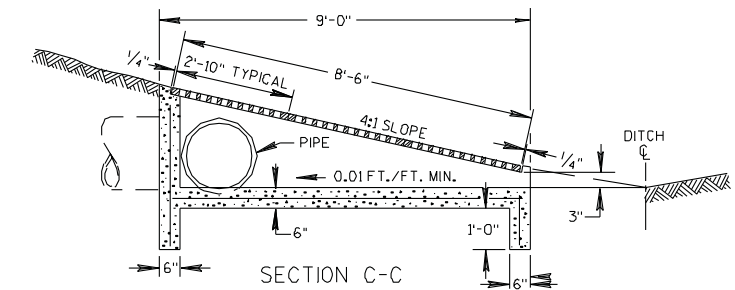


SECTION C-C

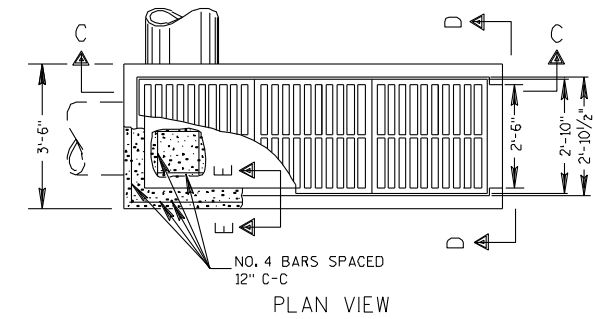


PLAN VIEW

REINFORCED CONCRETE INLET TYPE 10

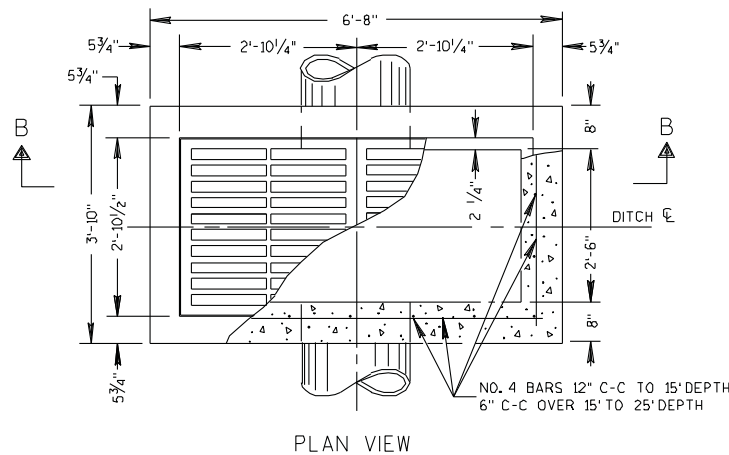


PLAN VIEW

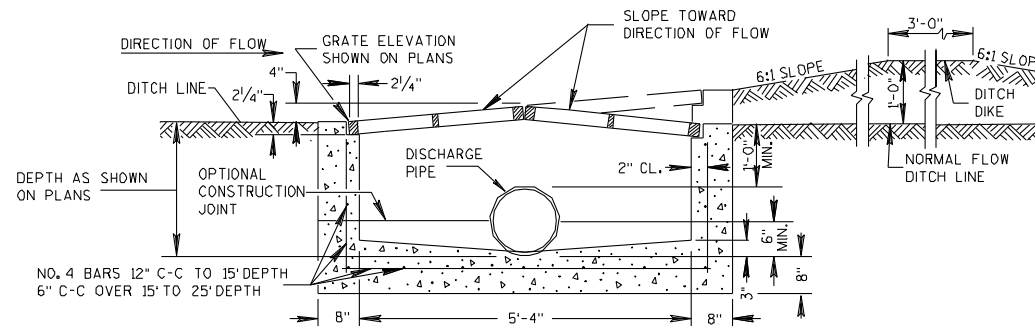

SECTION B-B

REINFORCED CONCRETE INLET TYPE 9

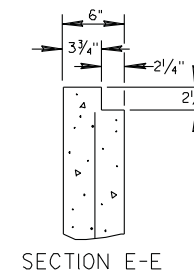

SECTION E-E

INLETS TYPE 8, 9, 10 AND 11

STATE OF WISCONSIN  
DEPARTMENT OF TRANSPORTATION

APPROVED  
DATE \_\_\_\_\_ CHIEF ROADWAY DEVELOPMENT ENGINEER  
FHWA

S.D.D. 8 C 5-2

REVISION DATE: 4/11/91

PLOT NAME

PLOT SCALE: 24

FILE NAME


ORIGINATOR: MEL ZEMLICKA 6-2782  
LEVELS ON: 1, 2, 3, 62, 63

APPROVED  
DATE \_\_\_\_\_ STATE CONST. ENGINEER FOR HWYS


S.D.D. 8 C 5-2




# 8D1: Concrete Curb, Concrete Curb & Gutter and Ties

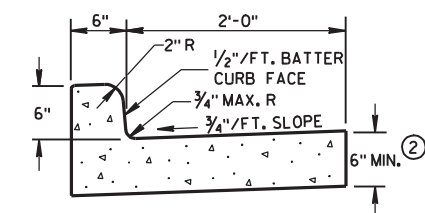


TYPES A & D ①

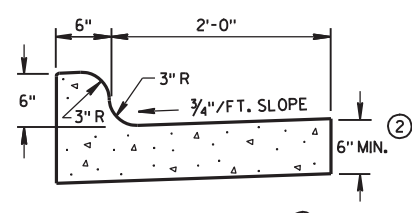


TYPES K & L ①

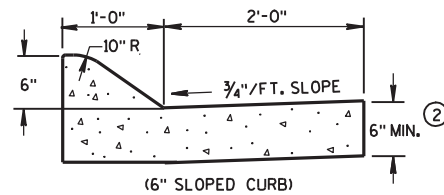


(6" SLOPED CURB) ②

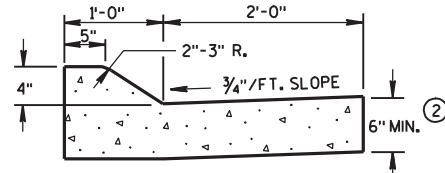


(4" SLOPED CURB) ②

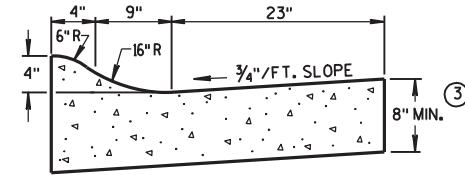


4" SLOPED CURB TYPES R & T ① ④

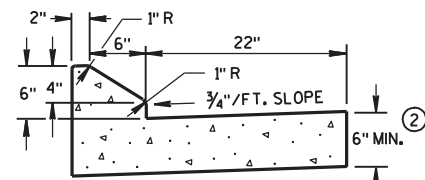

6" SLOPED CURB TYPES G & J ①

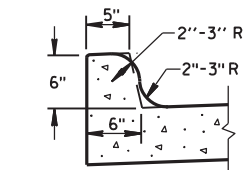


OPTIONAL CURB SHAPE FOR TYPES K & L ①

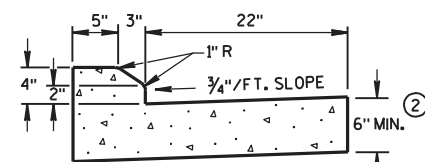


4" SLOPED CURB TYPES G & J ①


CONCRETE CURB & GUTTER 30"

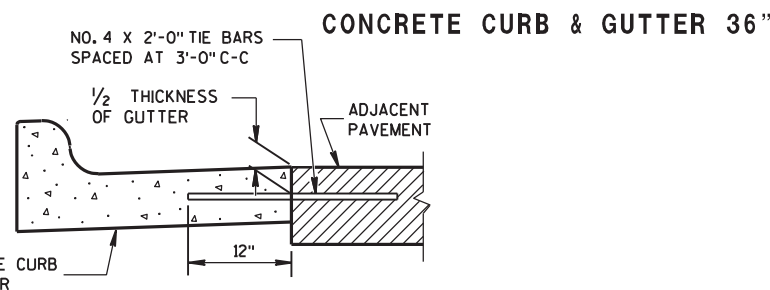


TYPICAL TIE BAR LOCATION ①

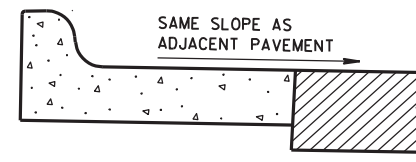

REVERSE SLOPE GUTTER (TYPICAL FOR ALL CURB & GUTTER TYPES) ⑤

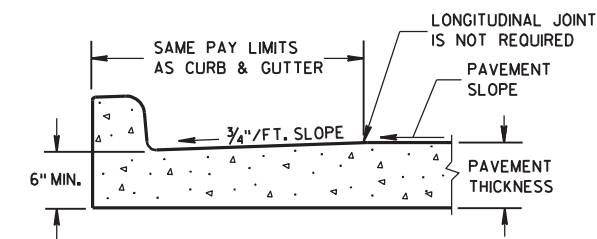


PARTIAL SECTION OF PAVEMENT WITH INTEGRAL CURB & GUTTER

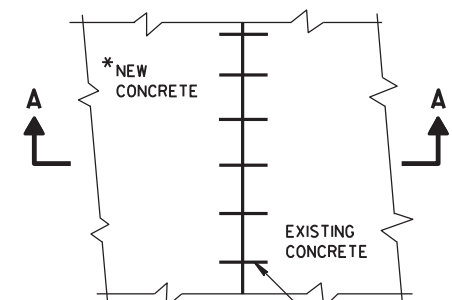


PLAN VIEW

\*NEW CURB & GUTTER, SURFACE DRAINS, CONCRETE PAVEMENT OR OTHER NEW CONCRETE.


NO. 6 TIE BARS SPACED 2'-6" C-C, INSTALLED PERPENDICULAR TO THE LONGITUDINAL JOINT.

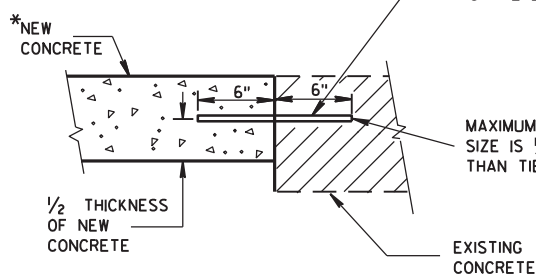


SECTION A-A TIE BARS DRILLED INTO EXISTING PAVEMENT

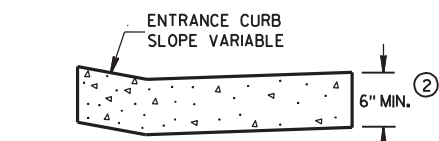


DRIVEWAY ENTRANCE CURB (WHEN DIRECTED BY THE ENGINEER)

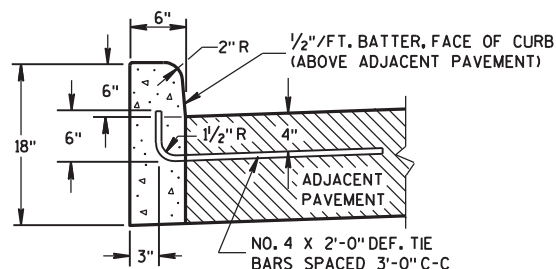


TYPES A & D ①

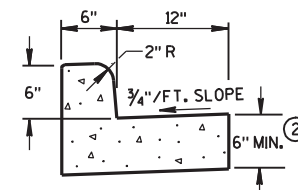

TYPES A & D CONCRETE CURB & GUTTER 18" ②

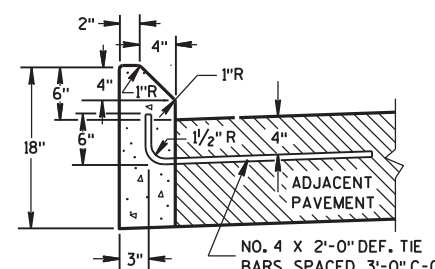

TYPES G & J ①

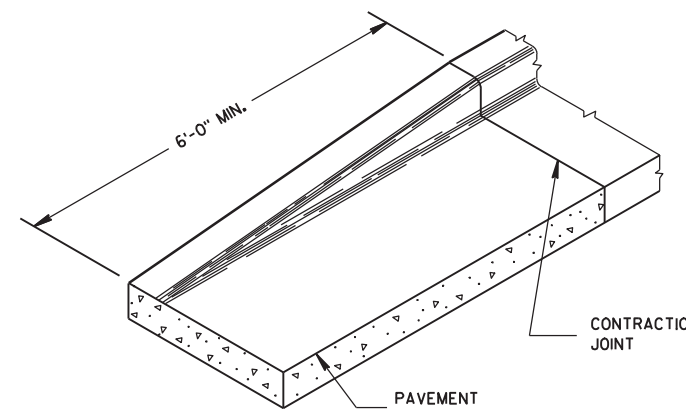

END SECTION CURB & GUTTER

## GENERAL NOTES

DETAILS OF CONSTRUCTION, MATERIALS AND WORKMANSHIP NOT SHOWN ON THIS DRAWING SHALL CONFORM TO THE PERTINENT REQUIREMENTS OF THE CONTRACT. PAVEMENT TIES AND TIE BARS SHALL BE EPOXY COATED IN CONFORMANCE WITH SUBSECTION 505.2.6.2 OF THE STANDARD SPECIFICATIONS.

INTEGRAL CURB & GUTTER SHALL CONFORM TO THE DETAILS SHOWN FOR CONCRETE CURB & GUTTER INCLUDING THE TRANSVERSE GUTTER SLOPE. A LONGITUDINAL CONSTRUCTION JOINT IS NOT REQUIRED WITH INTEGRAL CURB AND GUTTER.

WHERE THE TRANSVERSE JOINTS IN THE PAVEMENT ARE REQUIRED TO BE SEALED, THE JOINTS IN THE INTEGRAL CURB AND GUTTER SHALL BE SEALED TO THE FACE OF CURB WITH THE SAME TYPE OF SEALANT. THE COST OF FURNISHING AND INSTALLING THIS SEALANT SHALL BE INCIDENTAL TO THE ITEM CONCRETE CURB AND GUTTER.

UNLESS OTHERWISE SHOWN ON THE TYPICAL CROSS SECTIONS, THE BASE AGGREGATE AND COMMON EXCAVATION LIMITS ARE 2'-0" BEHIND THE BACK OF CURBS.

- ① TIE BARS ARE REQUIRED FOR CURB AND GUTTER TYPES A, G, K AND R.
- ② THE BOTTOM OF CURB AND GUTTER MAY BE CONSTRUCTED EITHER LEVEL OR PARALLEL TO THE SLOPE OF THE SUBGRADE OR BASE AGGREGATE PROVIDED A 6" MINIMUM GUTTER THICKNESS IS MAINTAINED.
- ③ THE BOTTOM OF CURB AND GUTTER MAY BE CONSTRUCTED EITHER LEVEL OR PARALLEL TO THE SLOPE OF THE SUBGRADE OR BASE AGGREGATE PROVIDED A 8" MINIMUM GUTTER THICKNESS IS MAINTAINED.
- ④ THE FACE OF CURB IS 6" FROM THE BACK OF CURB.
- ⑤ WHEN REVERSE SLOPE GUTTER IS REQUIRED, THE LOCATION(S) WILL BE SHOWN ELSEWHERE IN THE PLAN.

6

6


S.D.D. 8 D 1-17

S.D.D. 8 D 1-17


CONCRETE CURB, CONCRETE CURB & GUTTER AND TIES

STATE OF WISCONSIN DEPARTMENT OF TRANSPORTATION

APPROVED	/S/ Jerry H. Zogg
9/4/08	ROADWAY STANDARDS DEVELOPMENT
DATE	ENGINEER
FHWA	

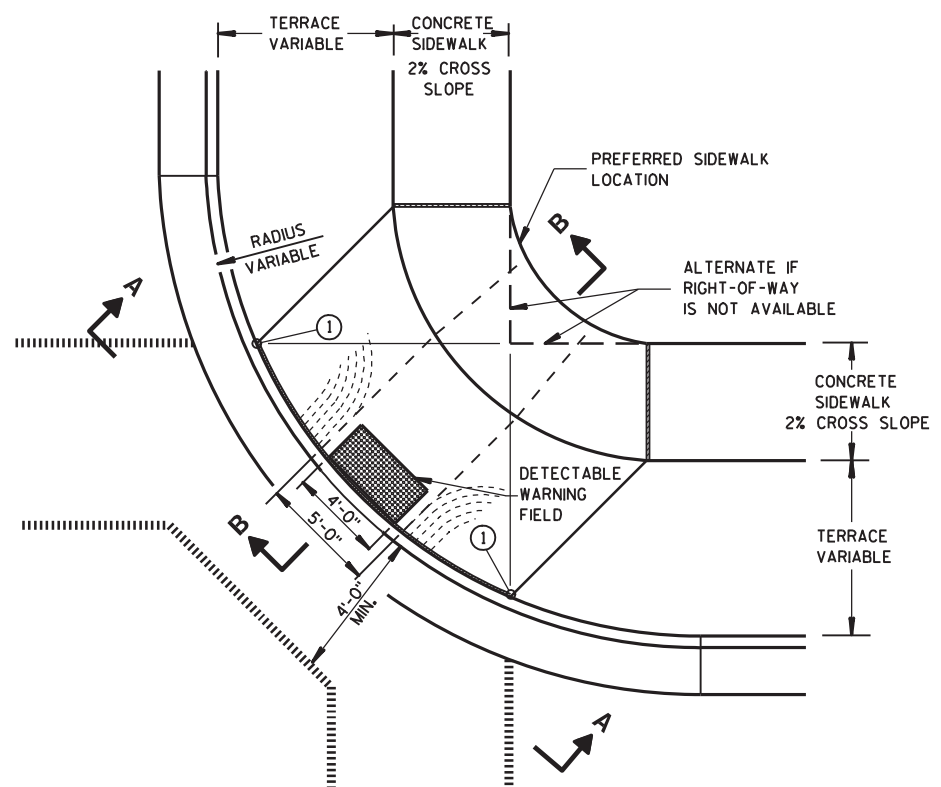

PLAN VIEW  
TYPE 1 RAMP  
(CENTER OF CORNER RADIUS)

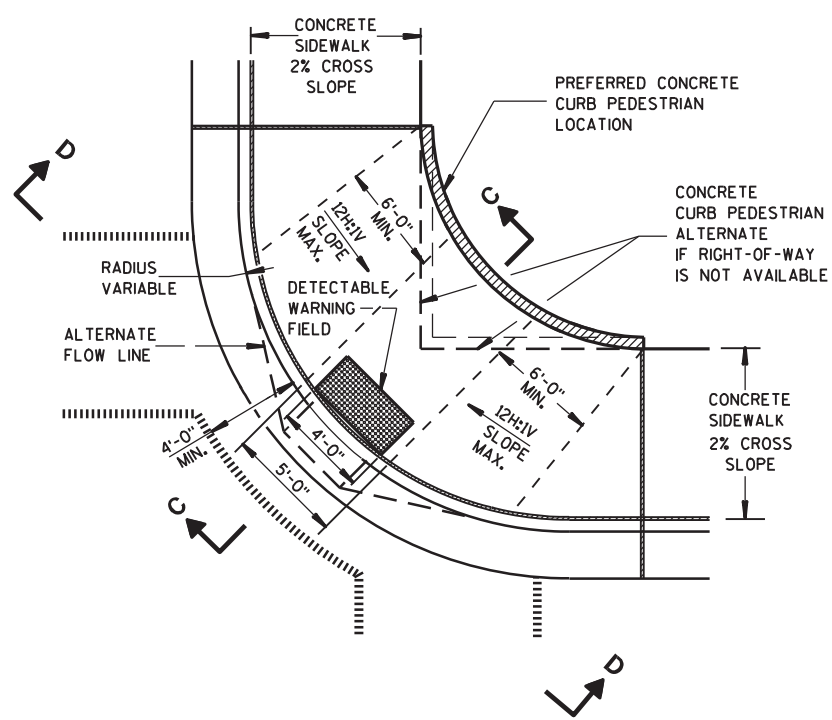

PLAN VIEW  
TYPE 1-A RAMP  
(NO TERRACE)

### GENERAL NOTES

DETAILS OF CONSTRUCTION, MATERIALS AND WORKMANSHIP NOT SHOWN ON THIS DRAWING SHALL CONFORM TO THE PERTINENT REQUIREMENTS OF THE STANDARD SPECIFICATIONS AND THE APPLICABLE SPECIAL PROVISIONS.

RAMPS SHALL BE BUILT AT 12H:1V OR FLATTER. WHEN NECESSARY, THE SIDEWALK ELEVATION MAY BE LOWERED TO MEET THE HIGH POINT ON THE RAMP.

TYPE 1 RAMPS SHALL HAVE A NORMAL SIDEWALK APRON AND CURB ON BOTH SIDES OF RAMP.

DETECTABLE WARNING FIELD SHALL BE MEASURED AND PAID BY THE SQUARE FOOT AS "CURB RAMP DETECTABLE WARNING FIELD". THE CONCRETE PEDESTRIAN CURB, IF NEEDED, SHALL BE MEASURED AND PAID BY THE LINEAL FOOT AS "CONCRETE CURB PEDESTRIAN". CONCRETE SIDEWALK IN THE CURB RAMP AREA SHALL BE MEASURED AND PAID BY THE SQUARE FOOT AS CONCRETE SIDEWALK, INCLUDING THE AREA UNDER THE DETECTABLE WARNING FIELD.


SELECT CURB RAMP DETECTABLE WARNING FIELD MATERIALS AND DEVICES FROM THE DEPARTMENT'S APPROVED MATERIALS LIST. THE COLOR OF THE DETECTABLE WARNING FIELD IS SPECIFIED ELSEWHERE AND IS INCIDENTAL TO THE BID ITEM OF "CURB RAMP DETECTABLE WARNING FIELD".

SURFACE TEXTURE OF THE RAMP SHALL BE OBTAINED BY COARSE BROOMING TRANSVERSE TO THE SLOPE OF THE RAMP.


- ① THIS POINT IS AN EXTENSION OF OUTSIDE EDGE OF APPROACHING SIDEWALK WHERE IT MEETS THE BACK OF CONCRETE CURB.
- ② GRADE CHANGE BETWEEN GUTTER FLAG SLOPE AND THE CURB RAMP SLOPE SHALL NOT EXCEED 11%. PROVIDE DRAINAGE AWAY FROM CURB RAMP AT GUTTER FLAG INTERFACE.

### LEGEND


- 1/2" EXPANSION JOINT-SIDEWALK
- CONTRACTION JOINT FIELD LOCATED
- PAVEMENT MARKING CROSSWALK (WHITE)
- ALTERNATIVE LAYOUT

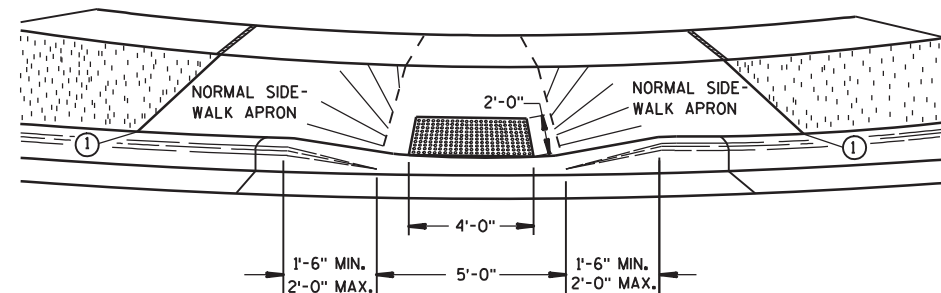


VIEW A-A

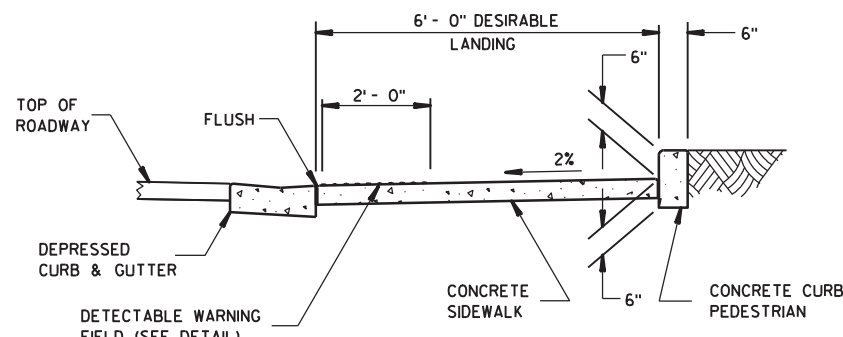

SECTION C-C

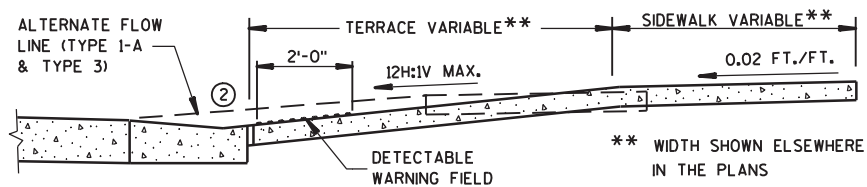

SECTION B-B

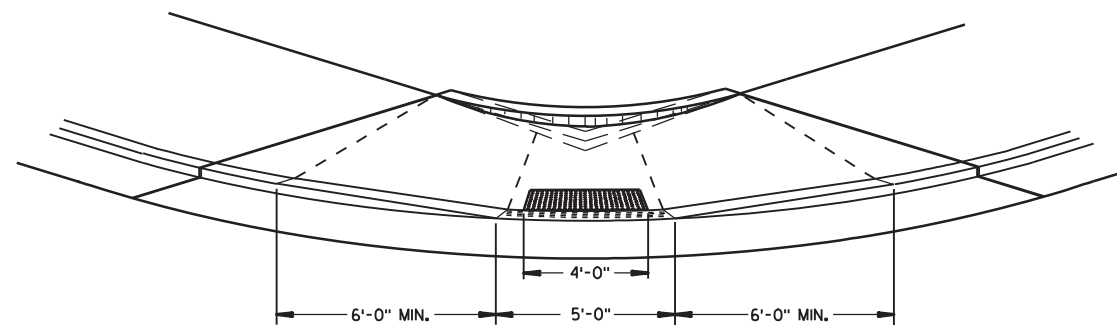

VIEW D-D

**CURB RAMPS  
TYPES 1 AND 1-A**


STATE OF WISCONSIN  
DEPARTMENT OF TRANSPORTATION

6

6

S.D.D. 8 D 5-140

S.D.D. 8 D 5-140

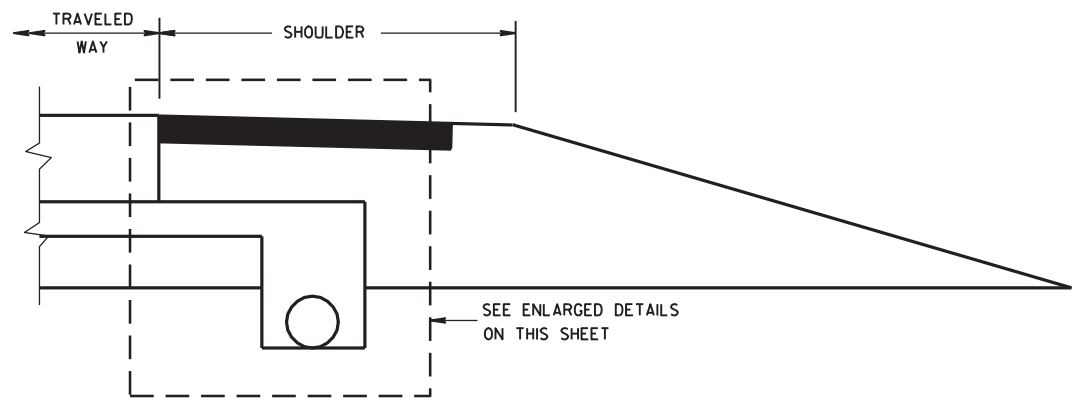


RURAL CROSS SECTION

GENERAL NOTES

THE DIMENSIONS SHOWN ON THE TYPICAL CROSS SECTIONS WILL GOVERN IN THE EVENT THERE IS A CONFLICT WITH THE DETAILS SHOWN ON THIS DRAWING.


PIPE UNDERDRAIN SHALL BE LAID PARALLEL TO THE GRADE OF THE ROADWAY.

- ① TRENCH BACKFILL WILL BE PAID FOR AS BASE AGGREGATE OPEN GRADED.
- ② FOLD OVER EXCESS GEOTEXTILE FABRIC AT THIS LOCATION.
- ③ TOTAL FABRIC WIDTH IS 6'-3" FOR PAYMENT.

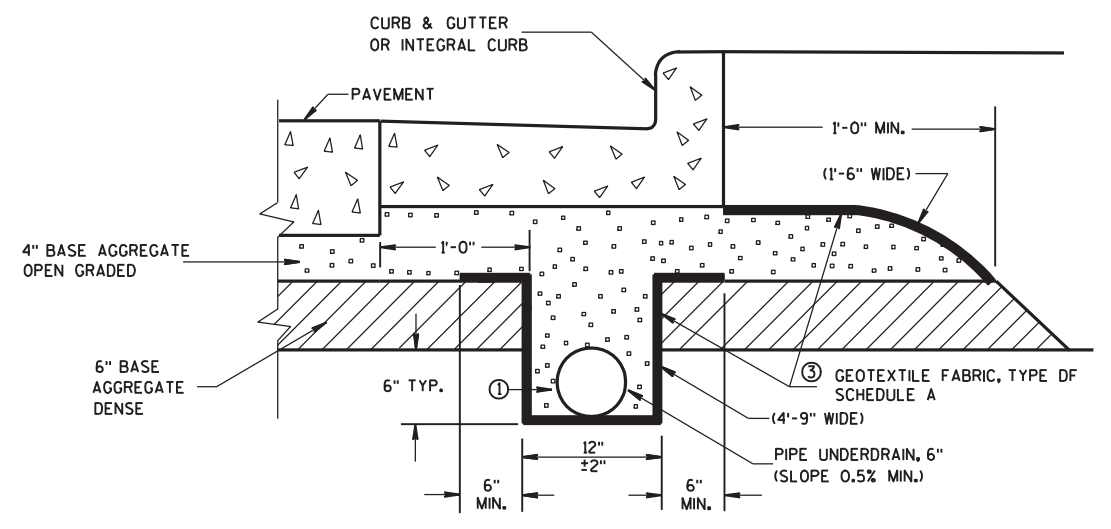


EDGEDRAIN IN URBAN ROADWAY

6

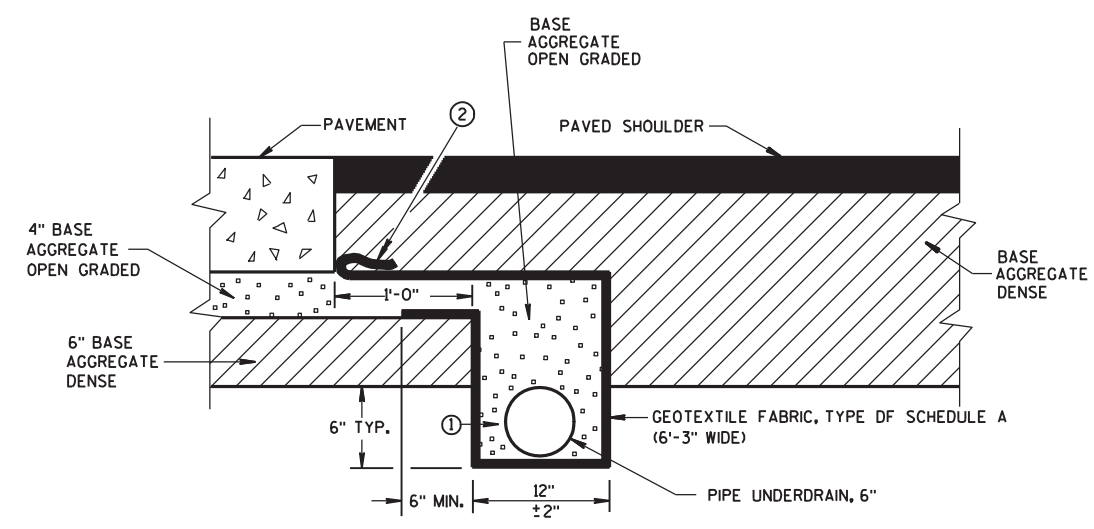

POST PAVING INSTALLATION  
(QUANTITIES ARE BASED ON THIS DETAIL)

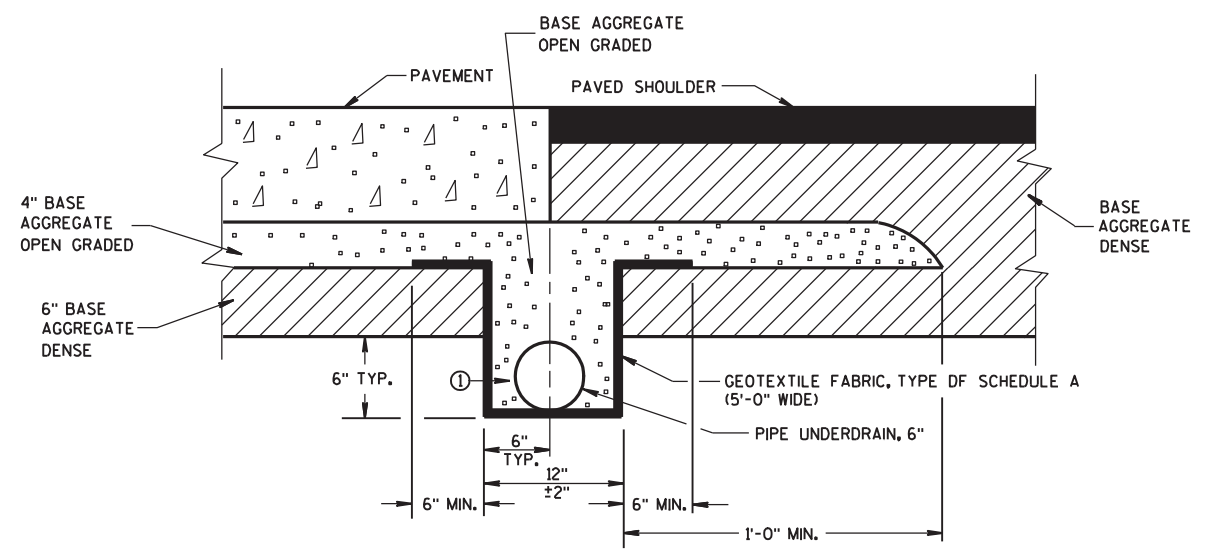


PRE-PAVING INSTALLATION ALTERNATE

EDGEDRAIN IN RURAL ROADWAY

<b>EDGEDRAIN AND BASE AGGREGATE OPEN GRADED</b>	
STATE OF WISCONSIN DEPARTMENT OF TRANSPORTATION	
APPROVED 3/21/07 DATE	/S/ Steven W. Krebs CHIEF MATERIALS MANAGEMENT ENGINEER
FHWA	

S.D.D. 8 D 15-4b

S.D.D. 8 D 15-4b

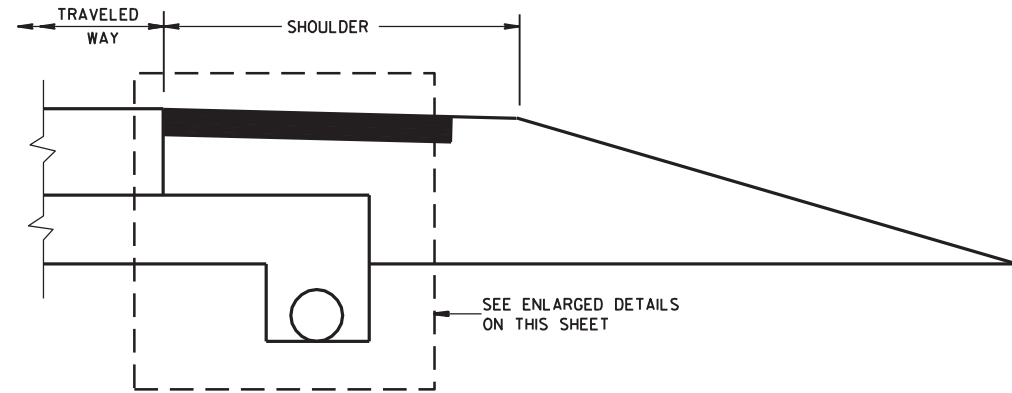


RURAL CROSS SECTION

GENERAL NOTES


THE DIMENSIONS SHOWN ON THE TYPICAL CROSS SECTIONS WILL GOVERN IN THE EVENT THERE IS A CONFLICT WITH THE DETAILS SHOWN ON THIS DRAWING.

PIPE UNDERDRAIN SHALL BE LAID PARALLEL TO THE GRADE OF THE ROADWAY.


- ① TRENCH BACKFILL WILL BE PAID FOR AS BASE AGGREGATE OPEN GRADED.

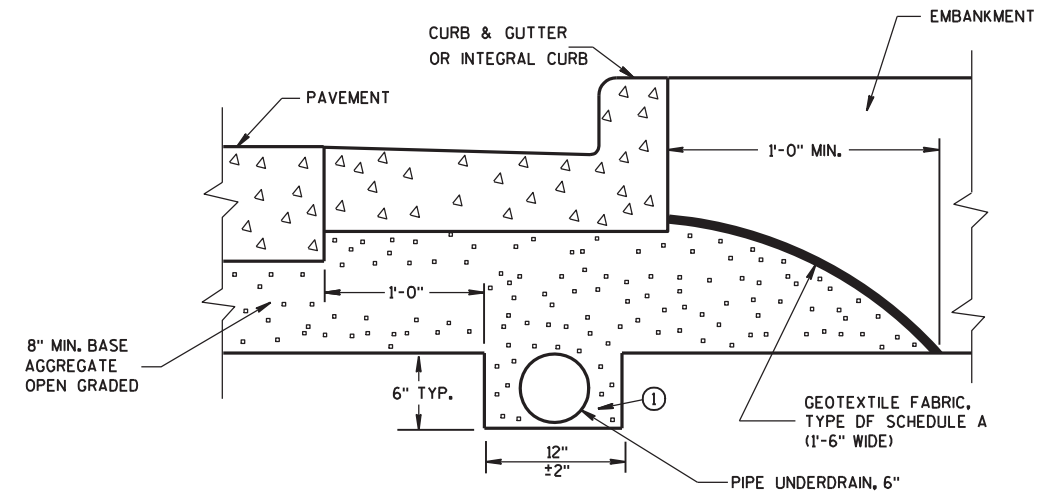

EDGEDRAIN IN URBAN ROADWAY

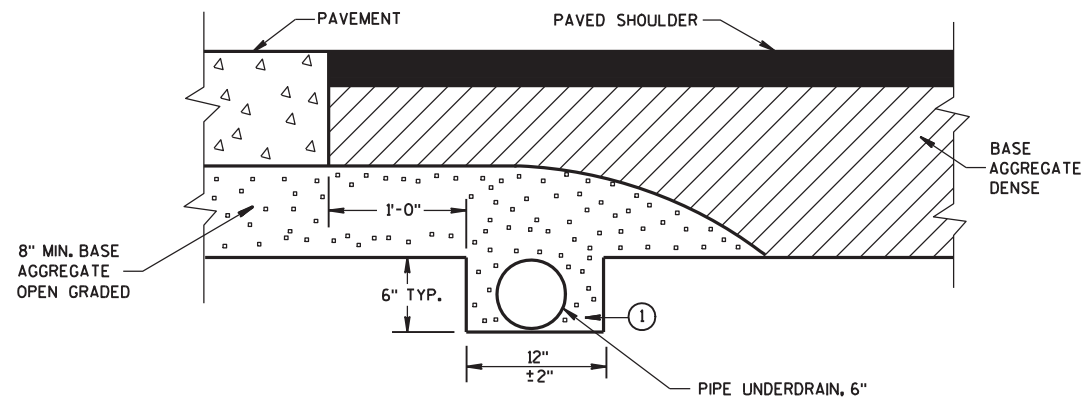

POST PAVING INSTALLATION  
(QUANTITIES ARE BASED ON THIS DETAIL)

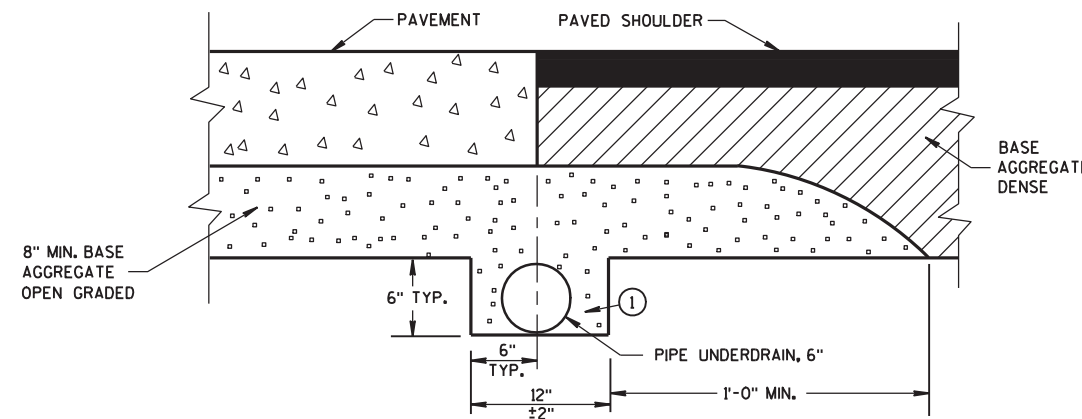



PRE-PAVING INSTALLATION ALTERNATIVE

EDGEDRAIN IN RURAL ROADWAY

<b>EDGEDRAIN AND BASE AGGREGATE OPEN GRADED</b>	
STATE OF WISCONSIN DEPARTMENT OF TRANSPORTATION	
APPROVED	
3/21/07	/S/ Steven W. Krebs
DATE	CHIEF MATERIALS MANAGEMENT ENGINEER
FHWA	



# 8E10: Inlet Protection Type A, B, C and D

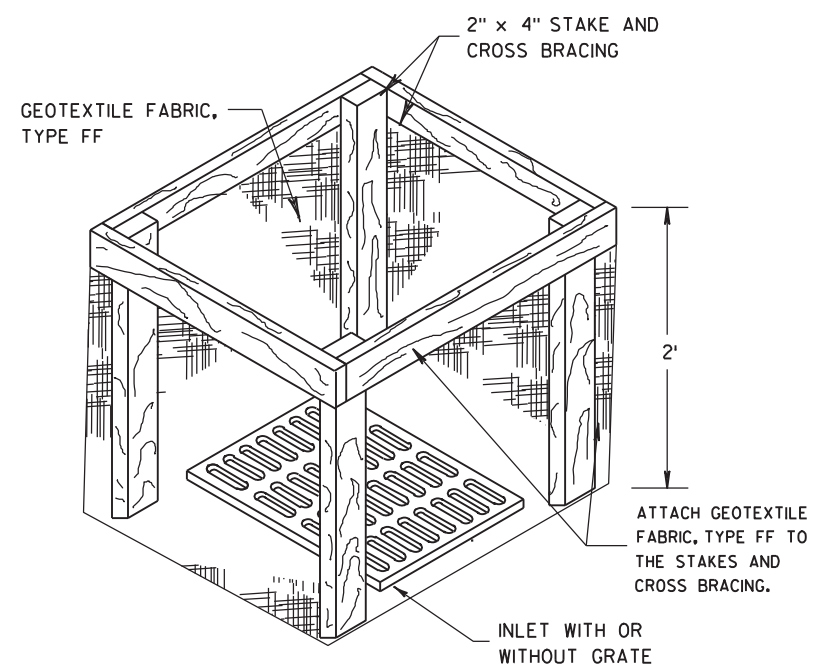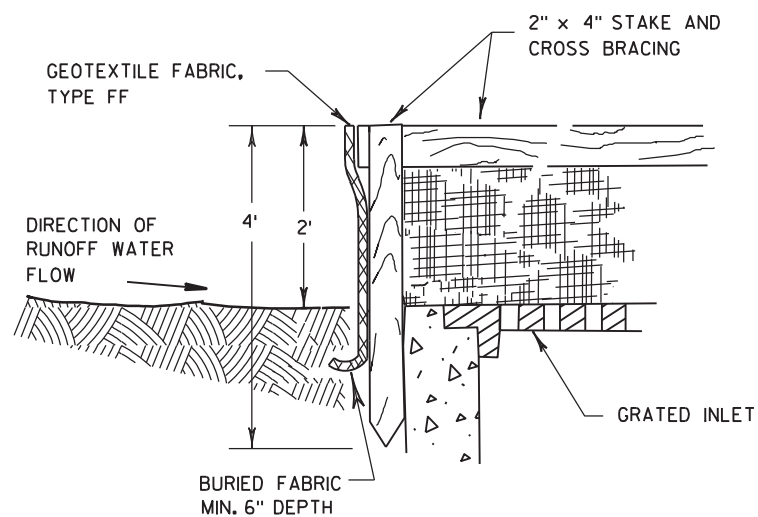

### INLET PROTECTION, TYPE A


#### GENERAL NOTES

INLET PROTECTION DEVICES SHALL BE MAINTAINED OR REPLACED AT THE DIRECTION OF THE ENGINEER.

MANUFACTURED ALTERNATIVES APPROVED AND LISTED ON THE DEPARTMENT'S EROSION CONTROL PRODUCT ACCEPTABILITY LIST MAY BE SUBSTITUTED.


WHEN REMOVING OR MAINTAINING INLET PROTECTION, CARE SHALL BE TAKEN SO THAT THE SEDIMENT TRAPPED ON THE GEOTEXTILE FABRIC DOES NOT FALL INTO THE INLET. ANY MATERIAL FALLING INTO THE INLET SHALL BE REMOVED IMMEDIATELY.

- ① FINISHED SIZE, INCLUDING FLAP POCKETS WHERE REQUIRED, SHALL EXTEND A MINIMUM OF 10" AROUND THE PERIMETER TO FACILITATE MAINTENANCE OR REMOVAL.
- ② FOR INLET PROTECTION, TYPE C (WITH CURB BOX), AN ADDITIONAL 18" OF FABRIC IS WRAPPED AROUND THE WOOD AND SECURED WITH STAPLES. THE WOOD SHALL NOT BLOCK THE ENTIRE HEIGHT OF THE CURB BOX OPENING.
- ③ FLAP POCKETS SHALL BE LARGE ENOUGH TO ACCEPT WOOD 2X4.

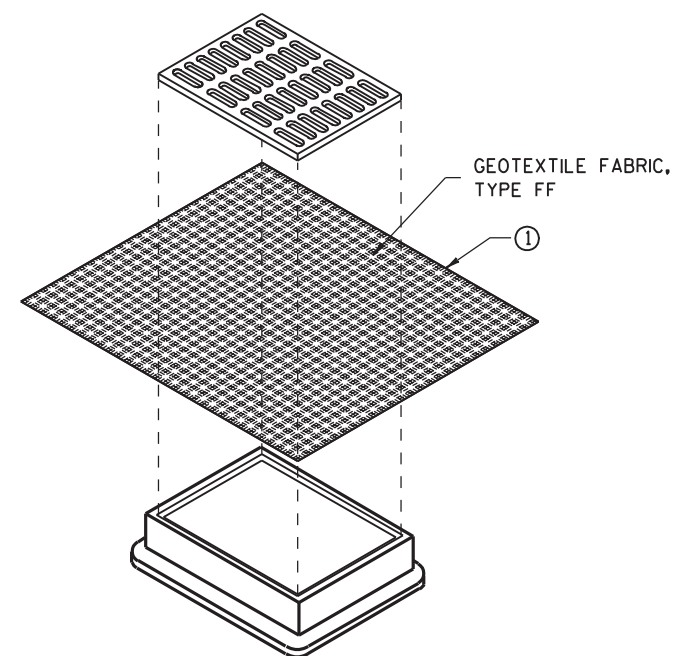

### INLET PROTECTION, TYPE B (WITHOUT CURB BOX)

(CAN BE INSTALLED IN ANY INLET WITHOUT A CURB BOX)

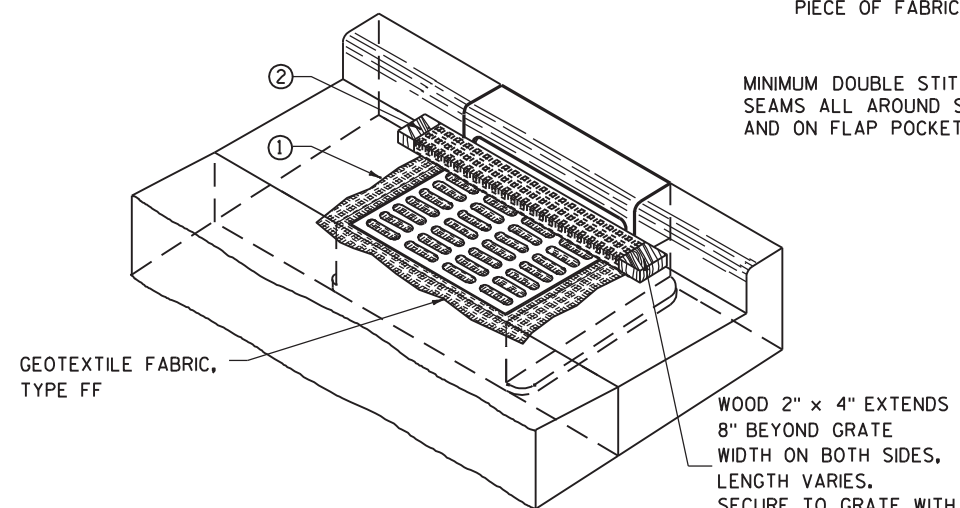

### INLET PROTECTION, TYPE C (WITH CURB BOX)

#### INSTALLATION NOTES

##### TYPE B & C

TRIM EXCESS FABRIC IN THE FLOW LINE TO WITHIN 3" OF THE GRATE.


THE CONTRACTOR SHALL DEMONSTRATE A METHOD OF MAINTENANCE, USING A SEWN FLAP, HAND HOLDS OR OTHER METHOD TO PREVENT ACCUMULATED SEDIMENT FROM ENTERING THE INLET.

##### TYPE D

DO NOT INSTALL INLET PROTECTION TYPE D IN INLETS SHALLOWER THAN 30", MEASURED FROM THE BOTTOM OF THE INLET TO THE TOP OF THE GRATE.

TRIM EXCESS FABRIC IN THE FLOW LINE TO WITHIN 3" OF THE GRATE.

THE INSTALLED BAG SHALL HAVE A MINIMUM SIDE CLEARANCE, BETWEEN THE INLET WALLS AND THE BAG, MEASURED AT THE BOTTOM OF THE OVERFLOW HOLES, OF 3". WHERE NECESSARY THE CONTRACTOR SHALL CINCH THE BAG, USING PLASTIC ZIP TIES, TO ACHIEVE THE 3" CLEARANCE. THE TIES SHALL BE PLACED AT A MAXIMUM OF 4" FROM THE BOTTOM OF THE BAG.

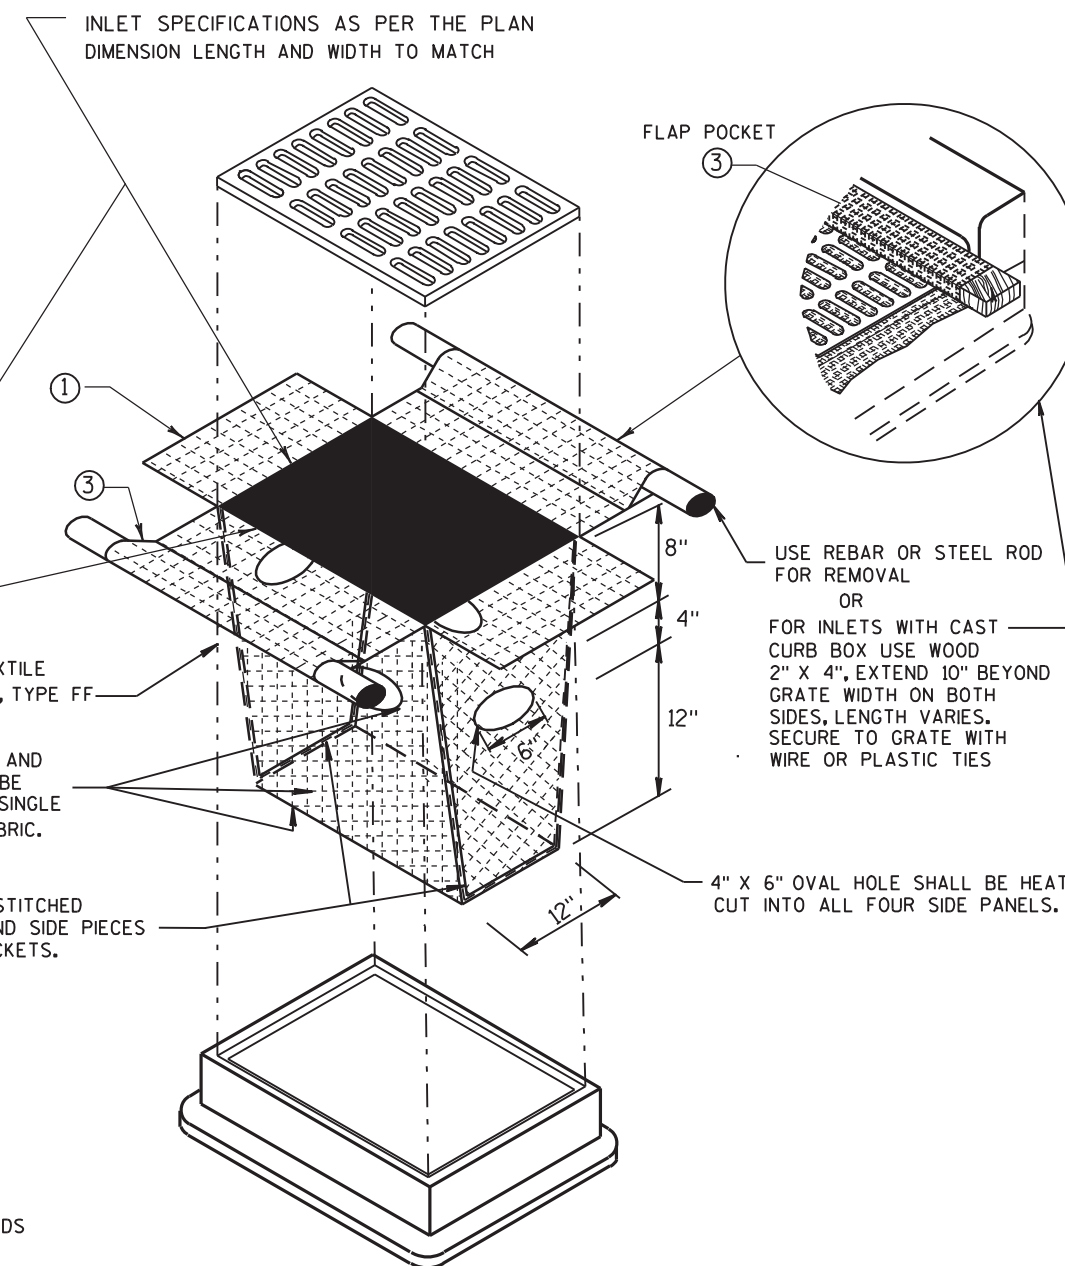

### INLET PROTECTION, TYPE D

(CAN BE INSTALLED IN ANY INLET TYPE WITH OR WITHOUT A CURB BOX AS PER NOTE ②)

INLET PROTECTION  
TYPE A, B, C, AND D


STATE OF WISCONSIN  
DEPARTMENT OF TRANSPORTATION

APPROVED


DATE \_\_\_\_\_ CHIEF ROADWAY DEVELOPMENT ENGINEER  
FHWA



# 13C1: Concrete Pavement Longitudinal Joints and Ties

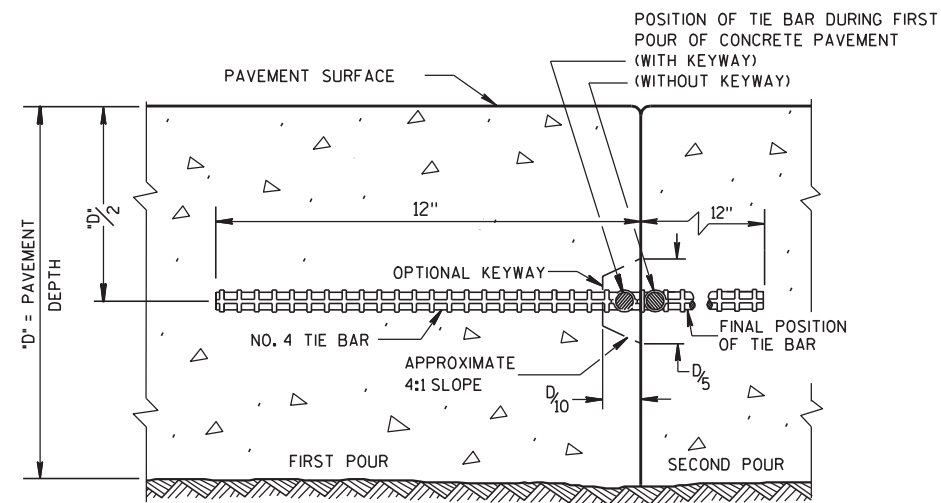


**CONSTRUCTION JOINT**

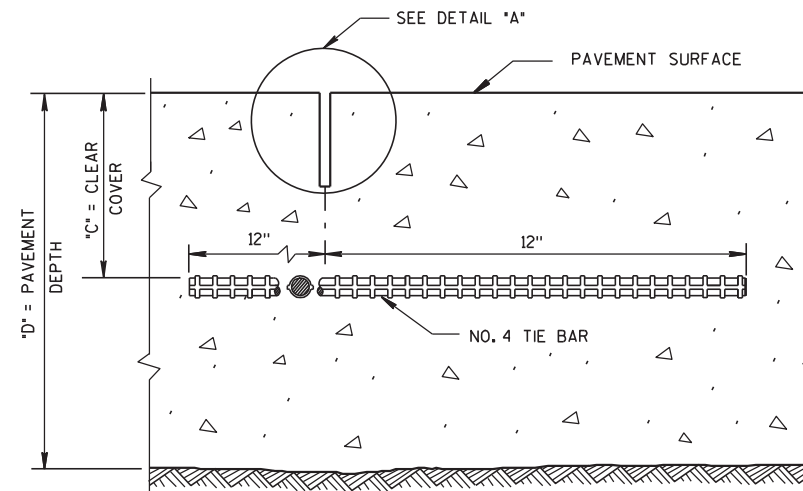

**SAWED JOINT**


## GENERAL NOTES

- DO NOT SEAL OR FILL LONGITUDINAL JOINTS.
- CREATE A LONGITUDINAL JOINT FOR PAVEMENT WIDTHS GREATER THAN 15 FEET.
- CORRELATE LONGITUDINAL JOINTS WITH LANE LINES WHEN POSSIBLE.
- ① ANCHOR TIE BARS INTO DRILLED HOLES WITH AN EPOXY.

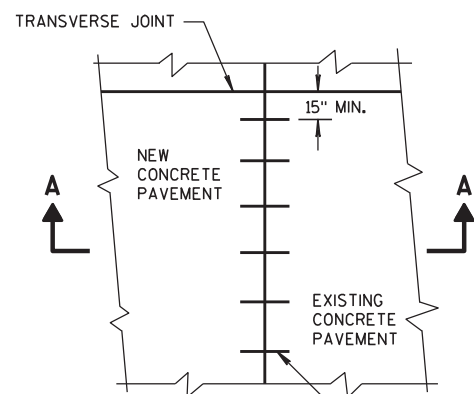


**PLAN VIEW**

NO. 6 TIE BARS SPACED 2'-6" C-C, INSTALLED PERPENDICULAR TO THE LONGITUDINAL JOINT. ①

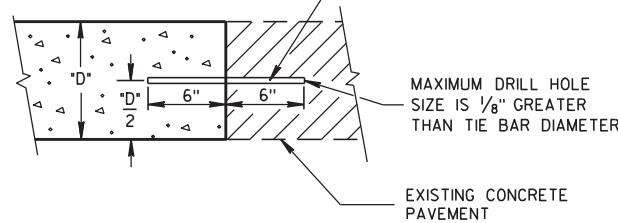


**SECTION A-A  
LONGITUDINAL CONSTRUCTION JOINT  
TIE BARS ANCHORED  
INTO EXISTING PAVEMENT**

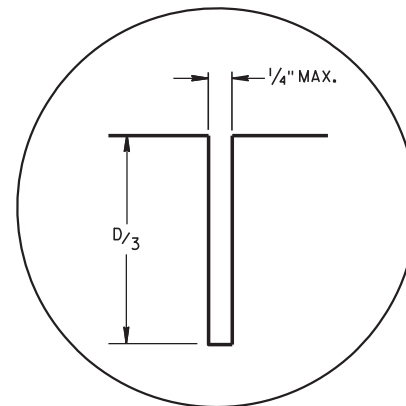

**DETAIL "A"**

PAVEMENT DEPTH "D"	CLEAR COVER "C"	MAXIMUM TIE BAR SPACING "S"	
		PAVEMENT WIDTH 24' OR 26'	≥ 30'
6. 6 1/2"	3" ± 1/2"	48"	42"
7. 7 1/2"	3 1/4" ± 1"	45"	36"
8. 8 1/2"	3 3/4" ± 1"	39"	30"
9. 9 1/2"	4 1/4" ± 1"	33"	27"
10. 10 1/2"	4 3/4" ± 1"	30"	24"
11. 11 1/2"	5 1/4" ± 1"	27"	21"
12"	5 3/4" ± 1"	24"	21"

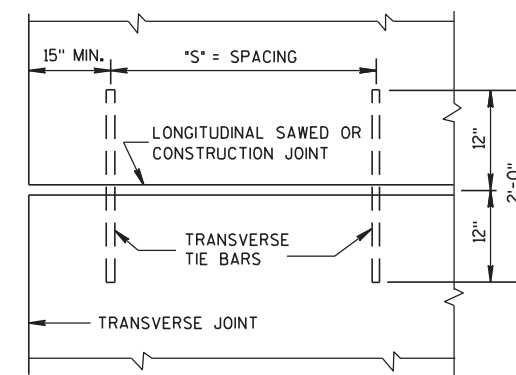


**PLAN VIEW  
SHOWING LOCATION OF TIE BARS**


<b>CONCRETE PAVEMENT LONGITUDINAL JOINTS AND TIES</b>	
STATE OF WISCONSIN DEPARTMENT OF TRANSPORTATION	
APPROVED 10-5-2010 DATE FHWA	/S/ Deb Bischoff PAVEMENT POLICY & DESIGN ENGINEER

**GENERAL NOTES**


- ① WITH THE APPROVAL OF THE ENGINEER, FOR SINGLE LANE PAVEMENT REPLACEMENTS LESS THAN 30 FEET IN LENGTH, THE CONTRACTOR MAY INSTALL DRILLED TIE BARS ON 6:1 SKEW HORIZONTALLY, DIRECTION OF SKEW ALTERNATING WITH EACH SUCCESSIVE BAR. DRIVE SKEWED TIE BARS TO A DEPTH OF 6 INCHES AND TO SUCH A DIAMETER AS TO PROVIDE A TIGHT DRIVEN FIT.
- ② USE AN ENGINEER-APPROVED BOND BREAKER FOR SINGLE LANE REPAIRS UP TO 15 FEET IN LENGTH.

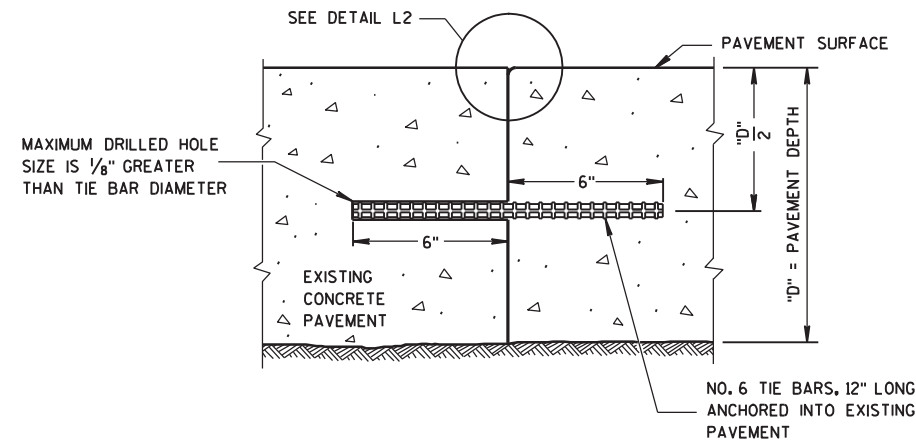

SECTION G-G  
**TIE BARS ANCHORED INTO EXISTING PAVEMENT**

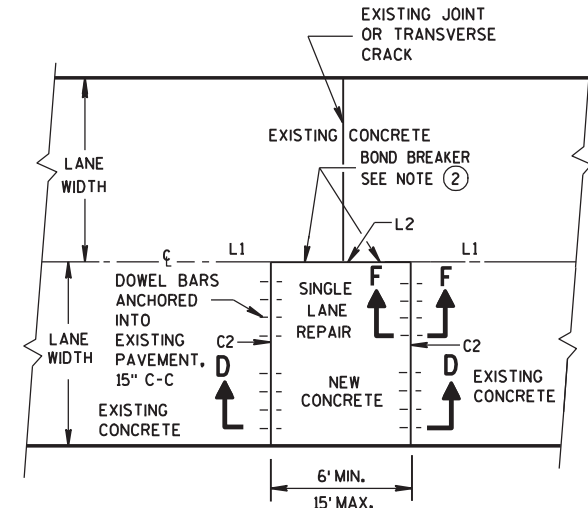

PLAN VIEW  
**SINGLE LANE CONCRETE PAVEMENT REPAIR**

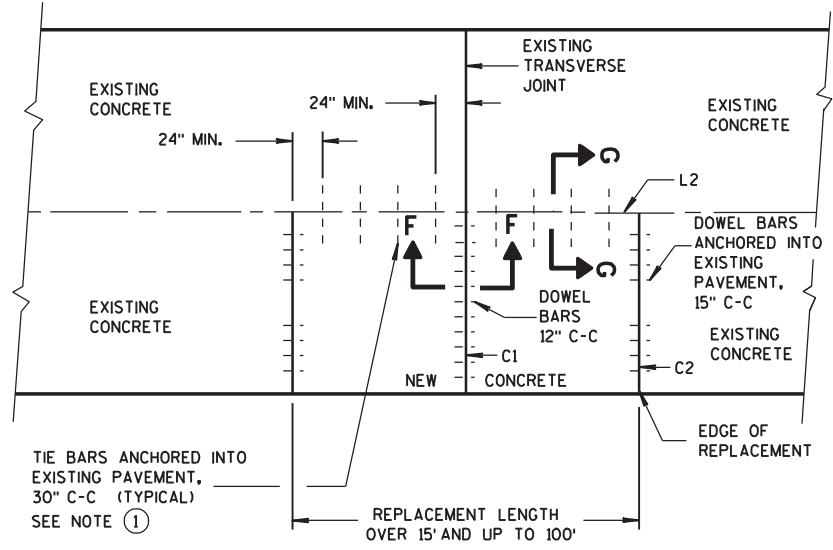

PLAN VIEW  
**SINGLE LANE CONCRETE PAVEMENT REPLACEMENT**

<b>CONCRETE PAVEMENT REPAIR AND REPLACEMENT</b>	
STATE OF WISCONSIN DEPARTMENT OF TRANSPORTATION	
APPROVED 12-11-09 DATE	/S/ Deb Bischoff PAVEMENT POLICY & DESIGN ENGINEER
FHWA	

6

6


S.D.D. 13 C 9-8C

S.D.D. 13 C 9-8C






# 13C13: Urban Doweled Concrete Pavement

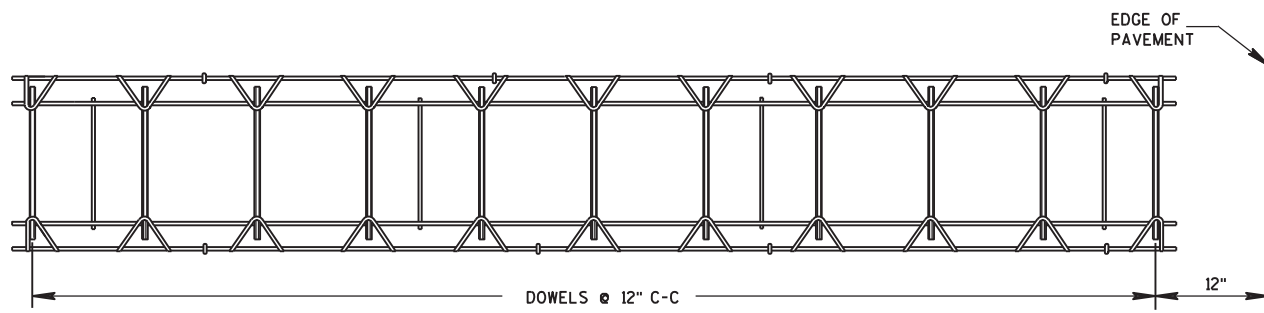

PLAN VIEW

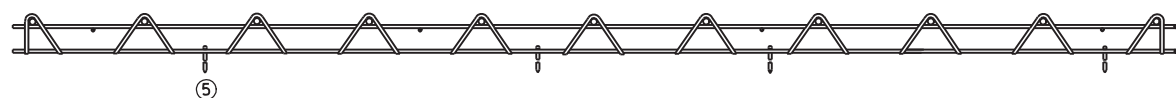


SIDE VIEW


CONTRACTION JOINT DOWEL ASSEMBLY

PAVEMENT DEPTH, DOWEL BAR SIZE AND JOINT SPACING TABLE


PAVEMENT DEPTH (D)	DOWEL BAR DIAMETER	CONTRACTION JOINT SPACING
5 1/2", 6", 6 1/2"	NONE	12"
7", 7 1/2"	1"	14"
8", 8 1/2"	1 1/4"	15"
9", 9 1/2"	1 1/4"	15"
10" & ABOVE	1 1/2"	15"

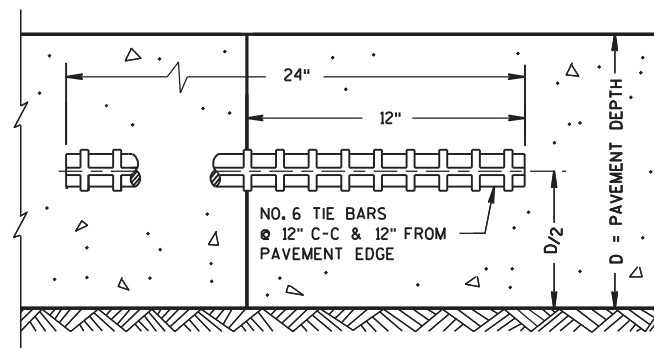

TRANSVERSE CONSTRUCTION JOINT

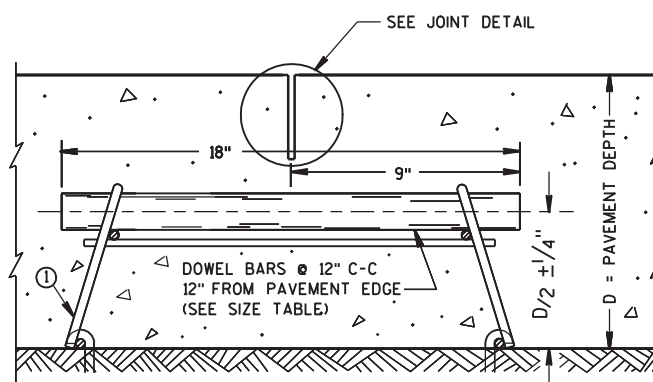


DOWELED CONTRACTION JOINT

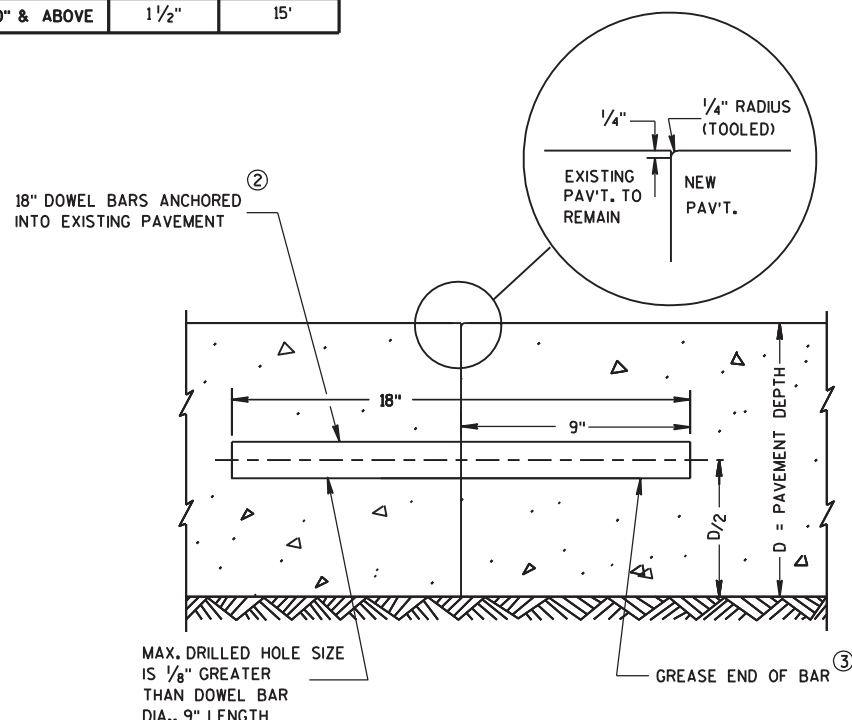


TRANSVERSE CONTRACTION JOINTS ABUTTING EXISTING PAVEMENT

DOWEL BAR DETAIL

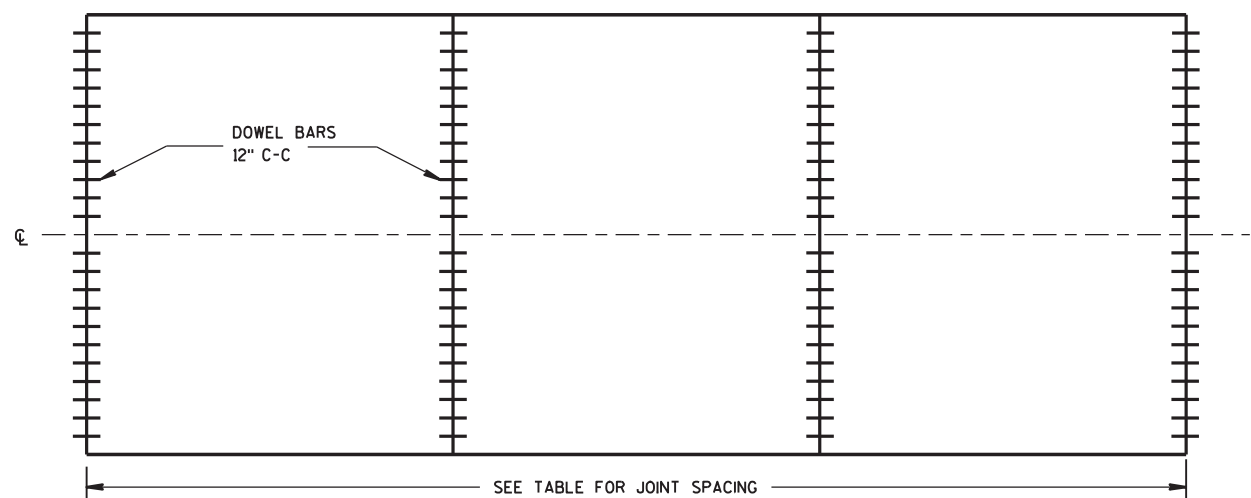

CONTRACTION JOINT LOCATIONS

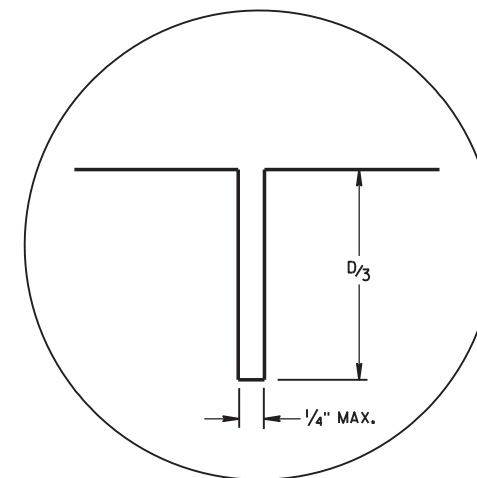

JOINT DETAIL

## GENERAL NOTES

### CONTRACTION JOINTS

CONSTRUCT CONTRACTION JOINTS NORMAL TO THE CENTERLINE. SHOW THE LOCATION OF CONTRACTION JOINTS THROUGH INTERSECTIONS ON THE PLANS OR AS DIRECTED BY THE ENGINEER.

DO NOT SEAL OR FILL CONTRACTION JOINTS.

INSTALL DOWEL BARS PARALLEL TO THE PAVEMENT CENTERLINE AND PAVEMENT SURFACE.

FOR PAVEMENT SLABS OF VARYING WIDTHS, CENTER THE DOWEL ASSEMBLY ACROSS THE LANES. LOCATE THE INNER AND OUTER MOST DOWEL BARS SO THAT THE CENTER OF THE BARS ARE A MINIMUM OF 6 INCHES AND A MAXIMUM OF 12 INCHES FROM THE LONGITUDINAL JOINT AND THE EDGE OF PAVEMENT.

### CONSTRUCTION JOINTS

LOCATE CONSTRUCTION JOINTS A MINIMUM OF 4 FEET FROM THE NEAREST CONTRACTION JOINT AND ALIGN PARALLEL TO CONTRACTION JOINTS.

THE CONTRACTOR MAY INSERT TIE BARS THROUGH THE HEADER BOARD AFTER THE CONCRETE HAS BEEN PLACED.

① THE ENGINEER MAY APPROVE THE USE OF ALTERNATIVE DESIGNS OF THE DOWEL ASSEMBLY. THE CONTRACTOR MAY USE MECHANICAL DOWEL BAR INSERTERS INSTEAD OF DOWEL ASSEMBLIES.

② ANCHOR DOWEL BARS INTO DRILLED HOLES WITH AN EPOXY.

③ APPLY A THIN UNIFORM COATING OF SURFACE TREATMENT TO THE FREE END OF DOWEL BARS TO PREVENT BONDING.

④ SPACE DOWEL BARS INSTALLED BY DRILLING 1'-3" ON CENTER. CENTER THE GROUPING OF DOWEL BARS INSIDE THE SLAB BASED ON ALL THE FOLLOWING SITUATIONS:


BETWEEN THE EDGES OF PAVEMENTS WITHOUT LONGITUDINAL JOINTS OR BETWEEN THE EDGE OF PAVEMENT AND NEAREST LONGITUDINAL JOINT OR BETWEEN TWO ADJACENT LONGITUDINAL JOINTS.

⑤ SECURE BASKETS WITH ANCHORS TO HOLD DOWEL BARS IN THE CORRECT POSITION AND ALIGNMENT. TYPE, LOCATION, NUMBER AND LENGTH OF ANCHORS ARE DEPENDENT UPON FIELD CONDITIONS.

URBAN DOWELED CONCRETE PAVEMENT


STATE OF WISCONSIN DEPARTMENT OF TRANSPORTATION

APPROVED  
 12/11/2009 /S/ Deb Bischoff  
 DATE PAVEMENT POLICY & DESIGN ENGINEER  
 FHWA

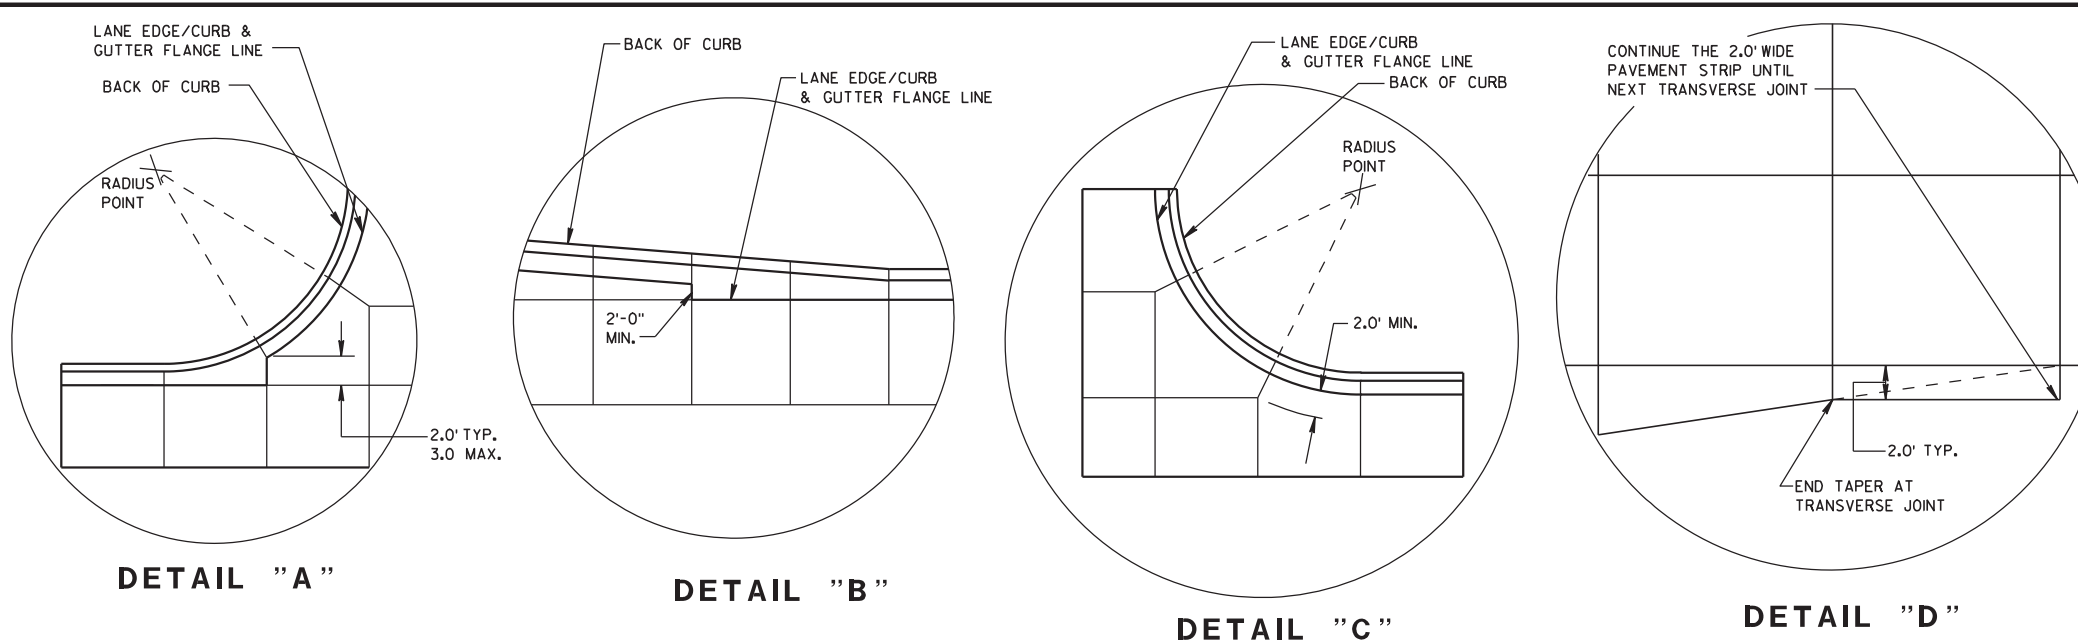


### GENERAL NOTES

- THE PRIMARY ROADWAY CONTROLS THE TRANSVERSE JOINT PATTERN.
  - ALIGN NEW JOINTS WITH EXISTING JOINTS OR CRACKS.
  - CONSTRUCT TRANSVERSE JOINTS PERPENDICULAR TO THE ROADWAY.
  - ADJUST TRANSVERSE JOINTS TO ALIGN WITH UTILITY FIXTURES (E.G. MANHOLES AND INLETS) IN THE PAVEMENT STRUCTURE WHEN POSSIBLE. WATER VALVES DO NOT REQUIRE JOINT ADJUSTMENT.
  - AVOID SLABS LESS THAN 2 FEET WIDE OR GREATER THAN 15 FEET WIDE.
  - SEE TABLE FOR TRANSVERSE JOINT SPACING. JOINT SPACING SPECIFIED IS MAXIMUM AND ACTUAL SPACING CAN BE ADJUSTED TO ACCOMMODATE INTERSECTIONS.
  - AVOID ANGLES LESS THAN 60° BY DOGLEGGING JOINTS THROUGH CURVE RADIUS POINTS. USE 90° ANGLES WHEN POSSIBLE.
  - CORRELATE LONGITUDINAL JOINTS WITH LANE LINES WHEN POSSIBLE.
- PROVIDE TRANSVERSE JOINTS AT ALL PAVEMENT WIDTH CHANGES.
  - CONSTRUCT DOWELED EXPANSION JOINT ON THE SIDE ROAD OF AN INTERSECTION IF THE SIDE ROAD IS CONCRETE PAVEMENT AND GREATER THAN 300 FEET IN LENGTH. ALIGN EXPANSION JOINT WITH EDGE OF RADIUS.
  - THE ENGINEER MAY APPROVE SLIGHT VARIATIONS FROM THESE JOINTING DETAILS.

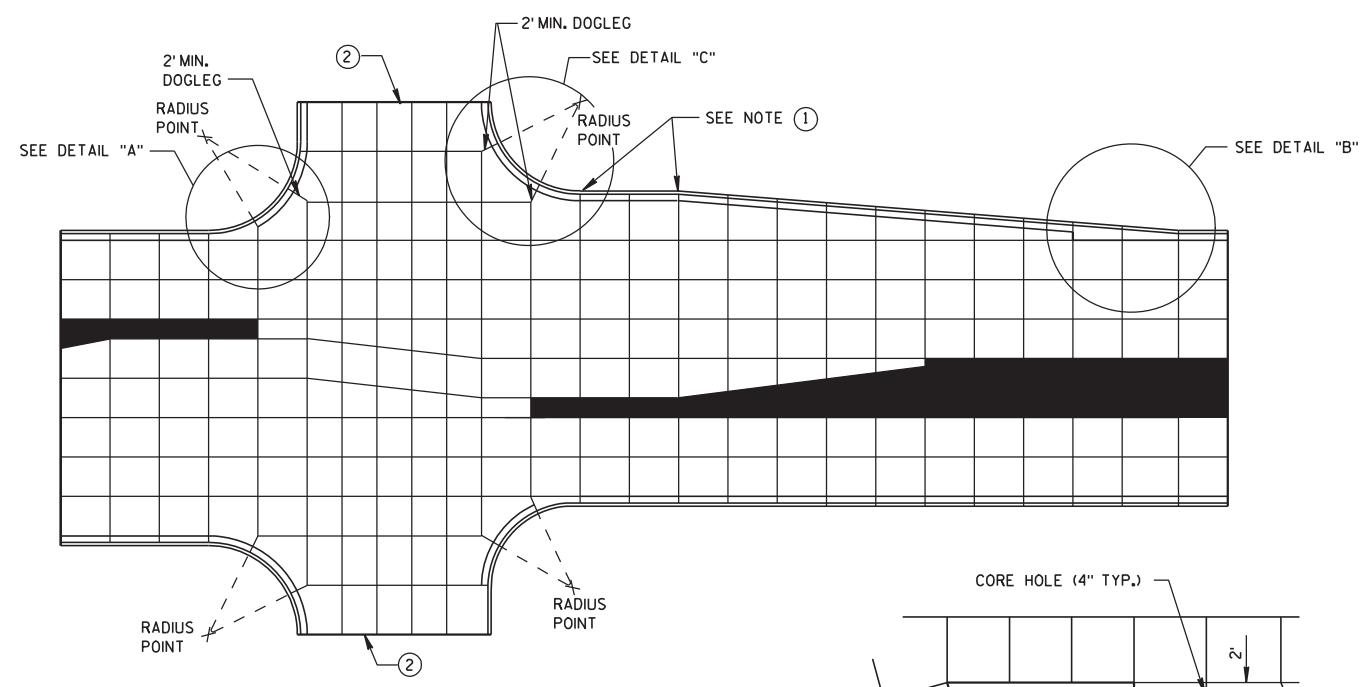


PAVEMENT DEPTH AND JOINT SPACING TABLE


PAVEMENT DEPTH (D)	CONTRACTION JOINT SPACING
6", 6 1/2"	12'
7", 7 1/2"	14'
8" & ABOVE	15'

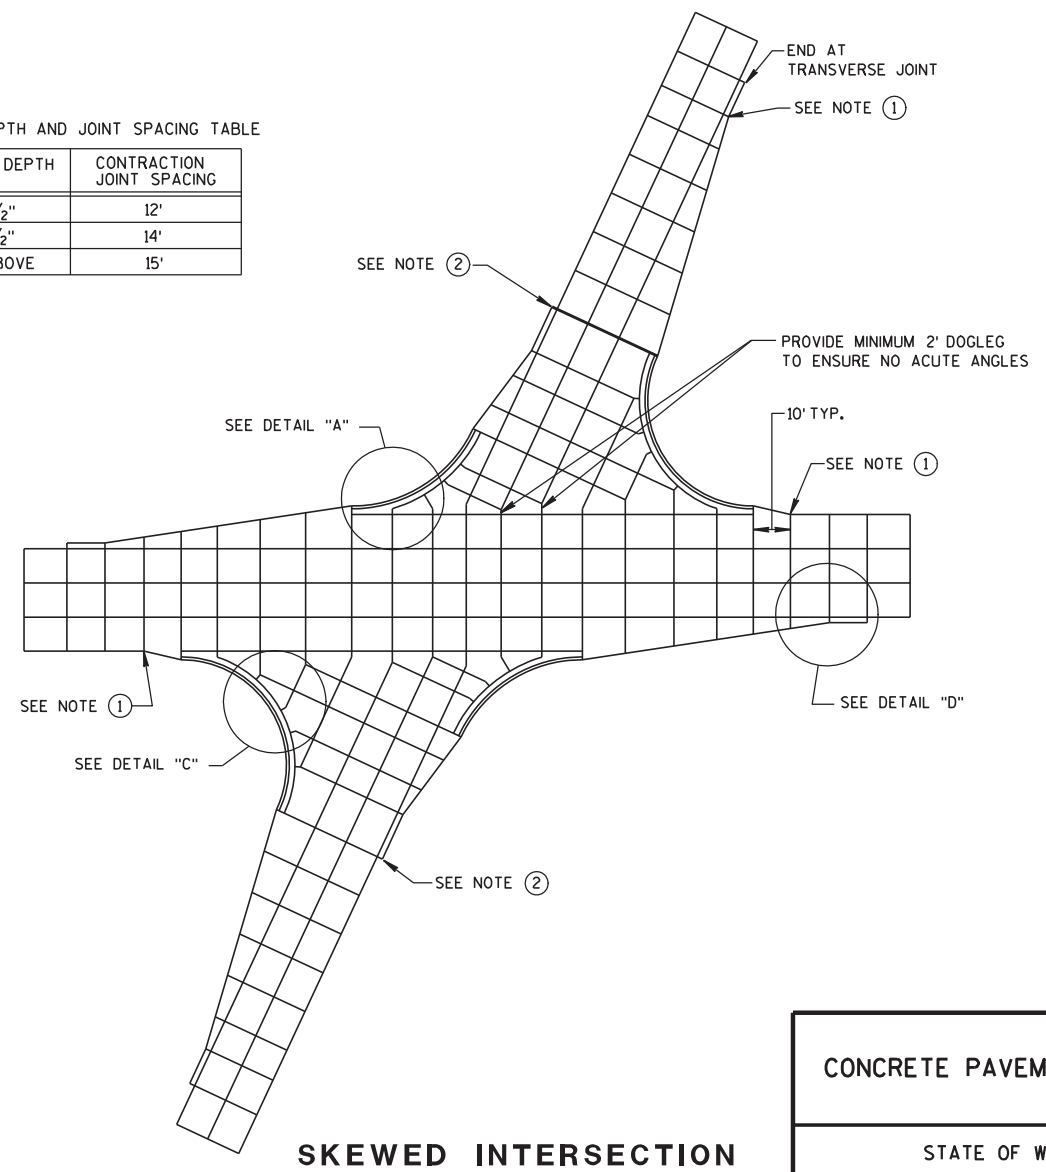

STANDARD INTERSECTION

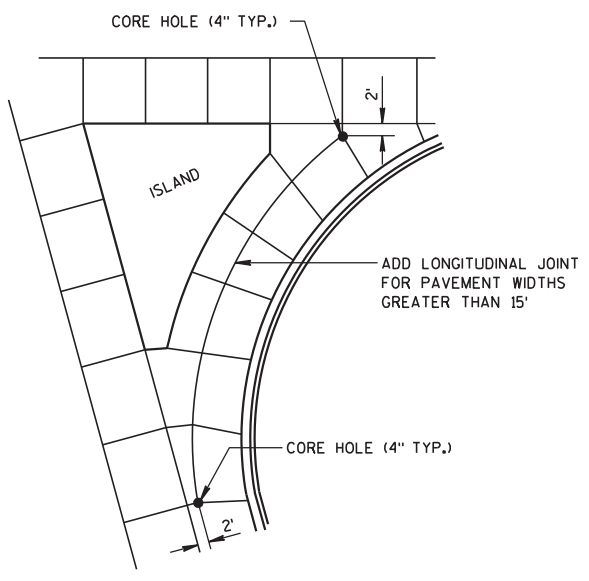

LARGE RIGHT TURN

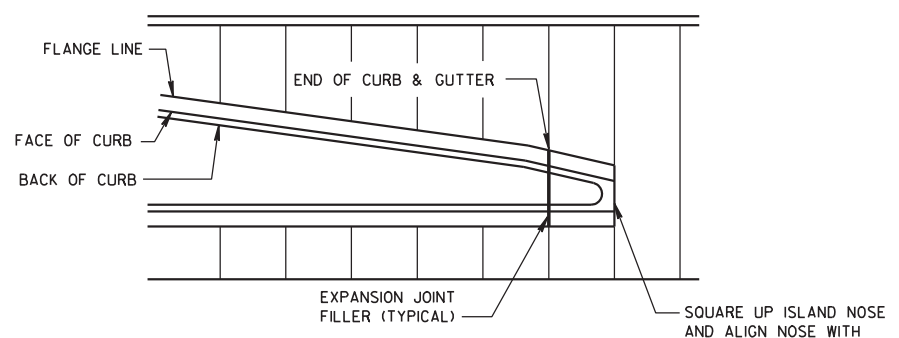

APPROACH TO MEDIAN

SKewed INTERSECTION

CONCRETE PAVEMENT JOINTING

STATE OF WISCONSIN  
 DEPARTMENT OF TRANSPORTATION

6

6


S.D.D. 13C18-1a

S.D.D. 13C18-1a



**LEGEND**


- POTENTIAL DOWELED EXPANSION JOINT
- - - DOWELED JOINT
- TIED JOINT

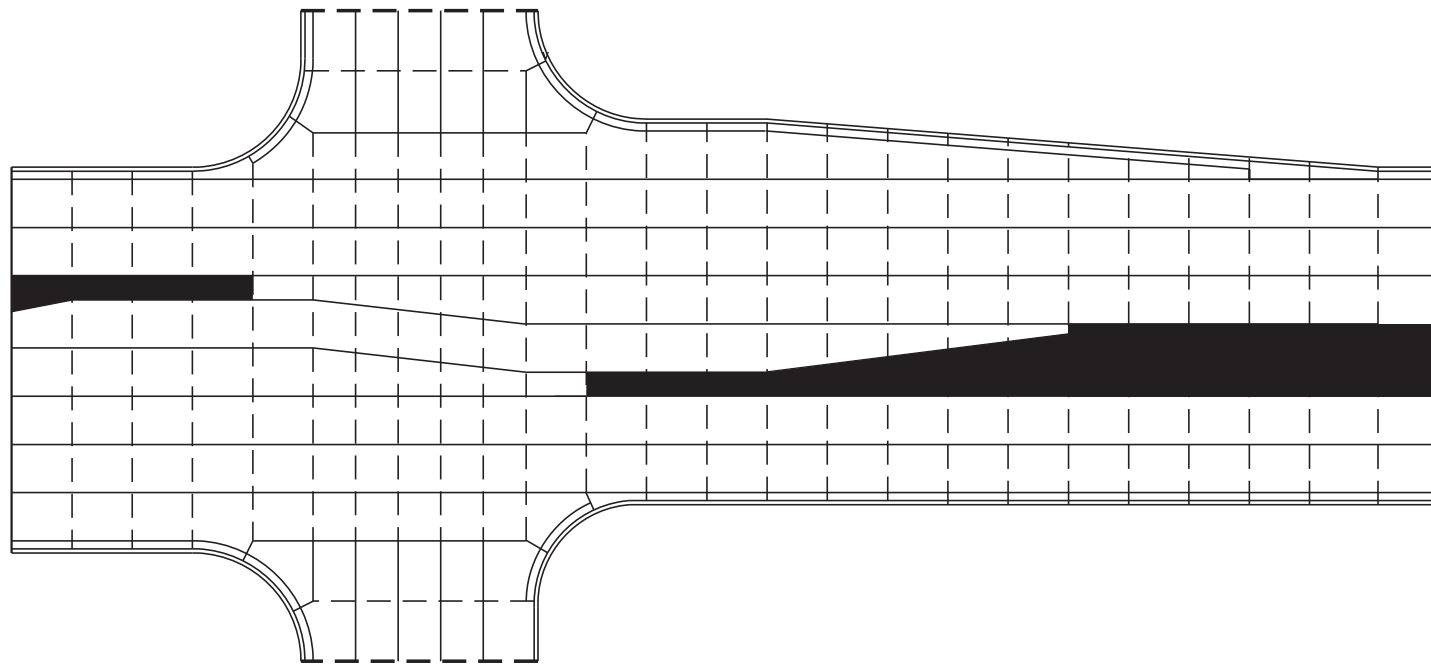

**STANDARD INTERSECTION**

**GENERAL NOTES**


USE AN EXPANSION JOINT FILLER MEETING THE REQUIREMENTS OF STANDARD SPECIFICATION 415.

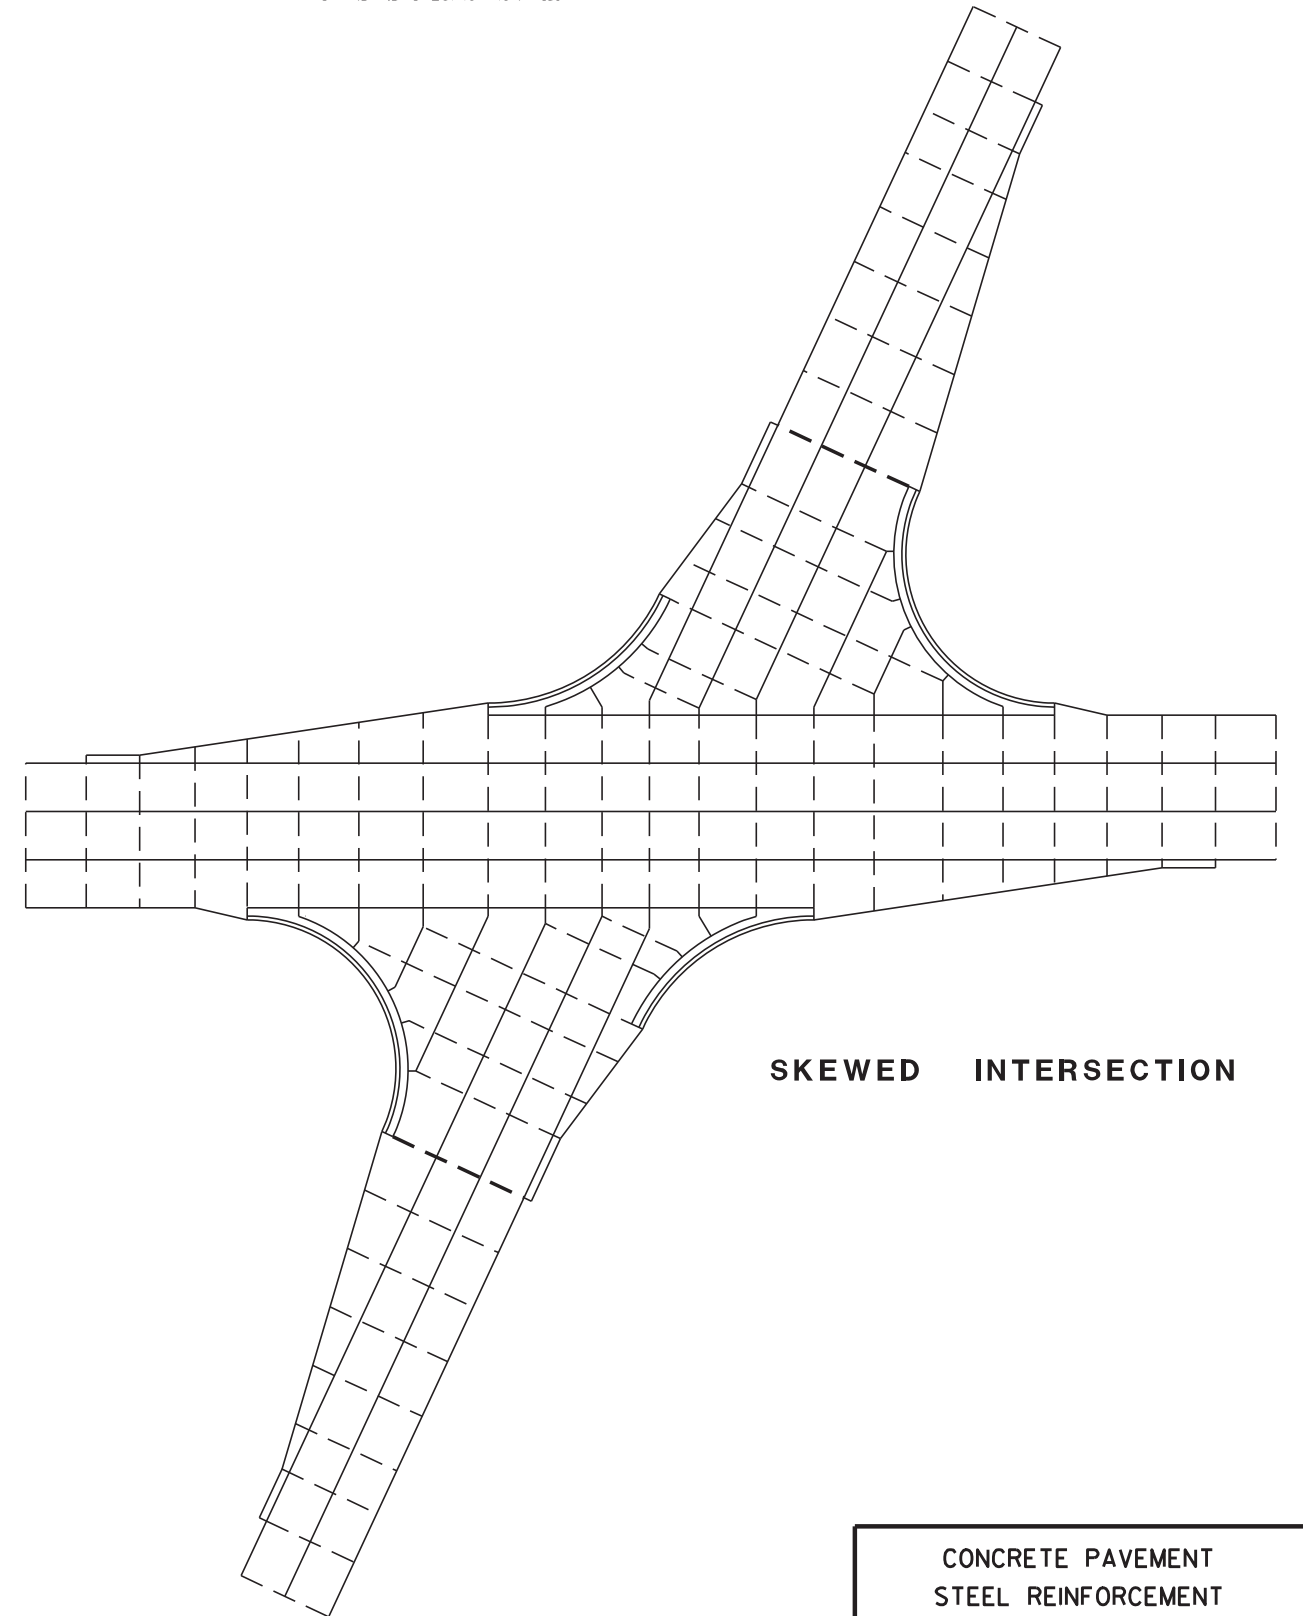


**SKewed INTERSECTION**

CONCRETE PAVEMENT  
STEEL REINFORCEMENT


STATE OF WISCONSIN  
DEPARTMENT OF TRANSPORTATION

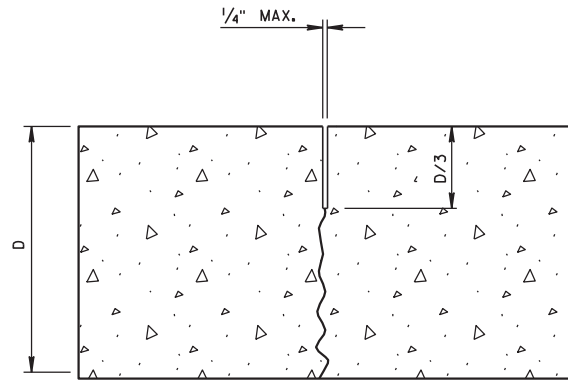

UNDOWELED-TRANSVERSE

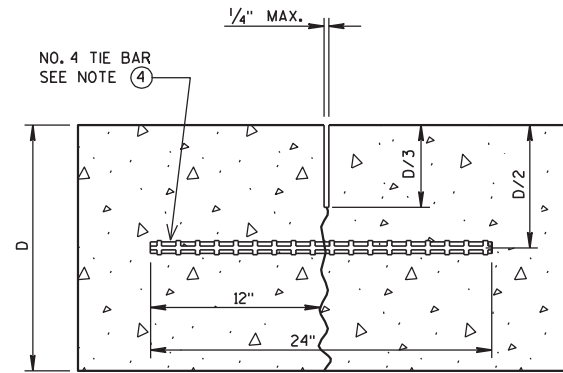


TIED LONGITUDINAL

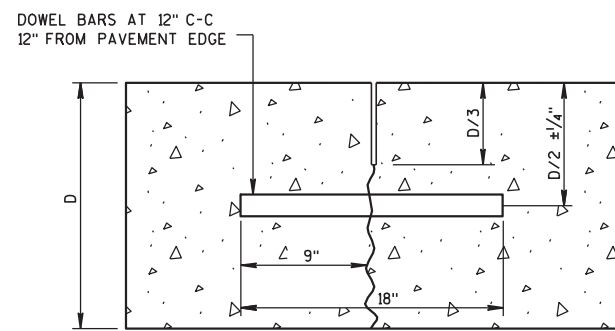


DOWELED-TRANSVERSE

CONTRACTION JOINTS

SEE NOTE ②

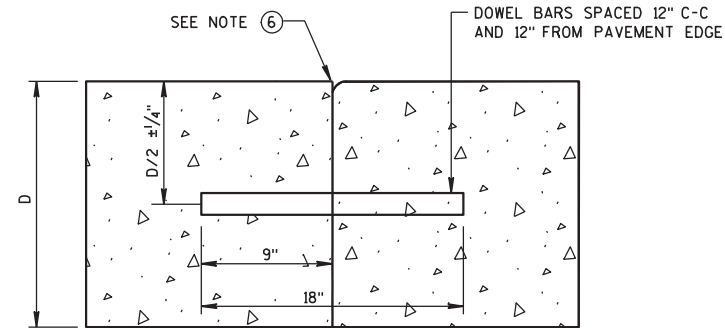


DOWELED TRANSVERSE

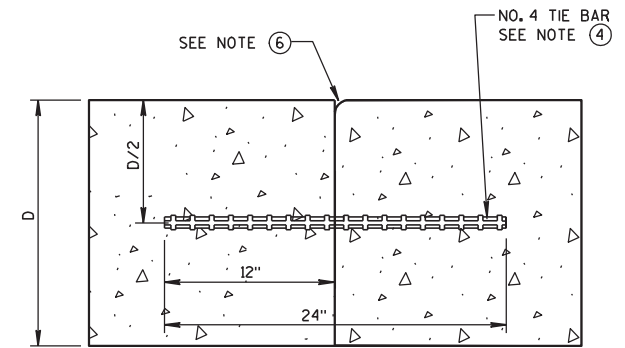

TIED LONGITUDINAL


6

6

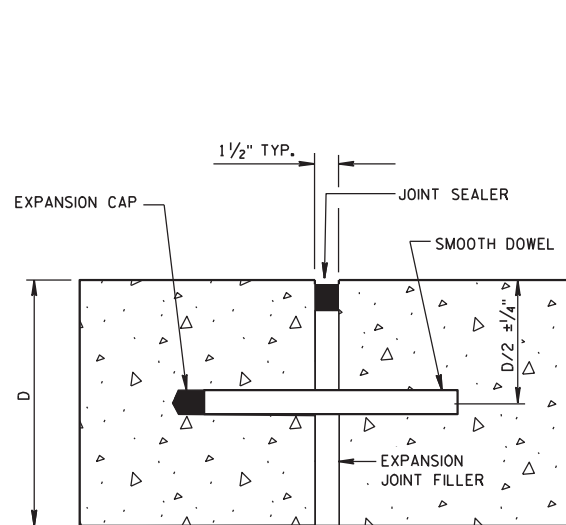


DOWELED-TRANSVERSE

SEE NOTE ①

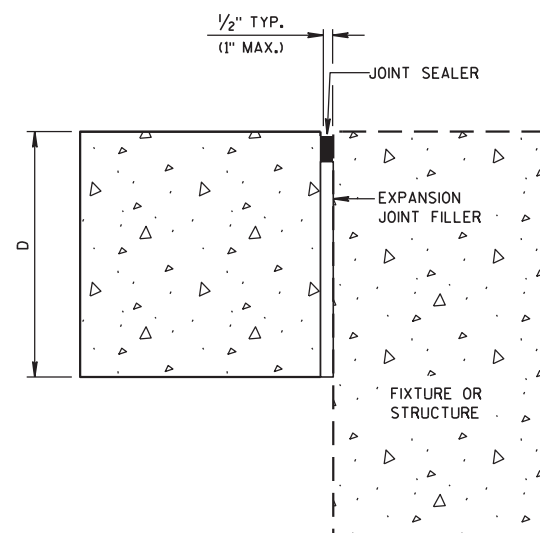


UNTIED-LONGITUDINAL

EXPANSION JOINTS

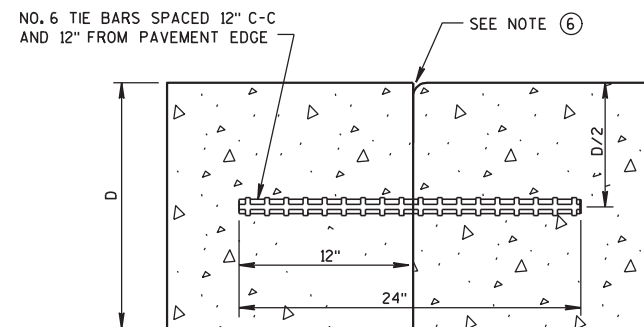

TIED TRANSVERSE

SEE NOTE ③

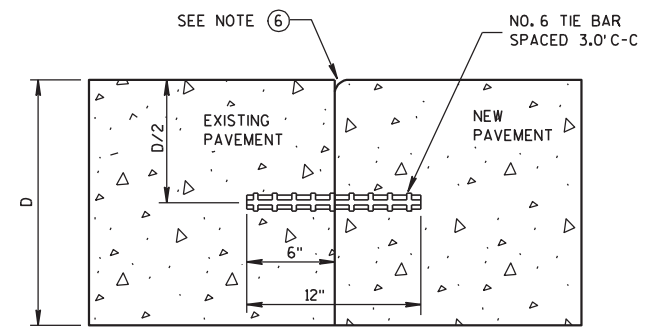


TIED LONGITUDINAL TO EXISTING

CONSTRUCTION JOINTS


SEE NOTE ⑤

GENERAL NOTES

1. USE DOWELED EXPANSION JOINTS ON SIDE ROADS AT INTERSECTIONS (TO ISOLATE THE SIDE ROAD FROM THE THROUGH STREET) IF THE SIDE ROAD IS CONCRETE PAVEMENT AND GREATER THAN 300 FEET IN LENGTH.
2. SPACE CONTRACTION JOINTS IN ACCORDANCE WITH 13C4, 13C11 OR 13C13.
3. LOCATE CONSTRUCTION JOINTS A MINIMUM OF 4 FEET FROM THE NEAREST CONTRACTION JOINT AND ALIGN PARALLEL TO THE CONTRACTION JOINTS.
4. SPACE TIE BARS AT LONGITUDINAL CONSTRUCTION OR CONTRACTION JOINTS IN ACCORDANCE WITH SDD 13C1.
5. CONSTRUCTION JOINTS CAN BE FORMED OR SAWED.
6. IF JOINT IS FORMED, PROVIDE A 1/4-INCH RADIUS.

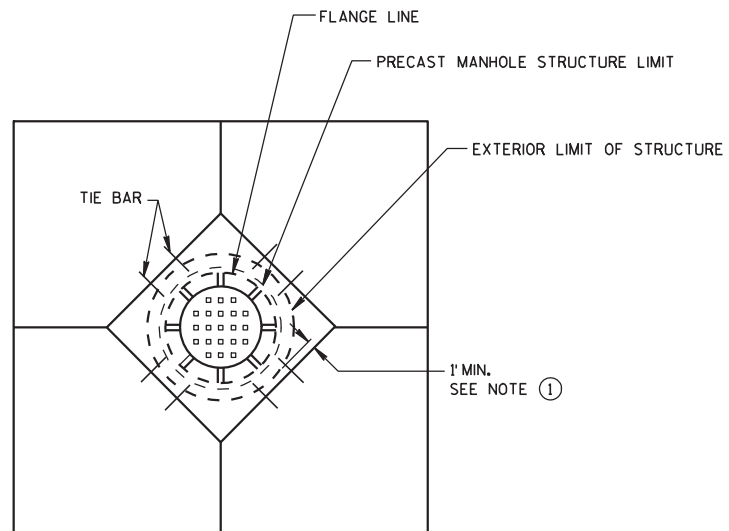

**DIAGONAL MANHOLE BOXOUT FOR CONSTRUCTION JOINTS**

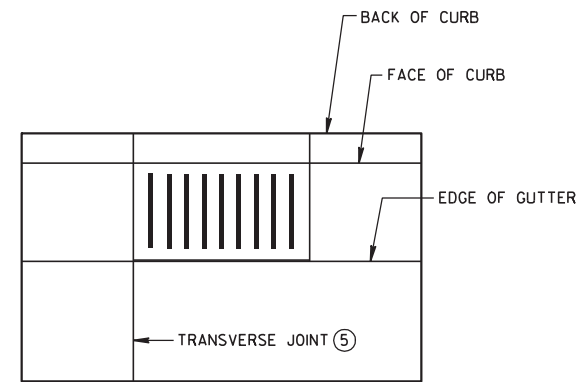


**INLET WITH TRANSVERSE JOINT**


**GENERAL NOTES**

1. USE BOXOUTS WHEN UTILITY STRUCTURE IS IN THE PATH OF CONSTRUCTION JOINTS. PROVIDE A 1 FOOT MINIMUM CLEARANCE BETWEEN THE EXTERIOR LIMIT OF THE STRUCTURE TO THE DIAMOND BOXOUT.
2. ADJUST TRANSVERSE JOINT TO INTERSECT MANHOLE IF POSSIBLE.
3. IF DISTANCE BETWEEN THE LONGITUDINAL JOINT AND THE EDGE OF MANHOLE IS GREATER THAN 2 FEET, DO NOT DIVERT JOINT AND SAW LONGITUDINAL JOINT AS NORMAL. IF DISTANCE IS 2 FEET OR LESS, DIVERT LONGITUDINAL JOINT AT A 2:1 TAPER RATE TO THE CENTER OF THE MANHOLE.
4. IF DISTANCE FROM THE EDGE OF MANHOLE TO THE NEAREST TRANSVERSE JOINT IS GREATER THAN 4 FEET, REDIRECT JOINT TO INTERSECT MANHOLE. IF DISTANCE IS 4 FEET OR LESS, PLACE REBAR REINFORCEMENT AROUND MANHOLE.
5. ALIGN TRANSVERSE JOINT WITH ONE EDGE OF INLET WHEN PRACTICAL.

6

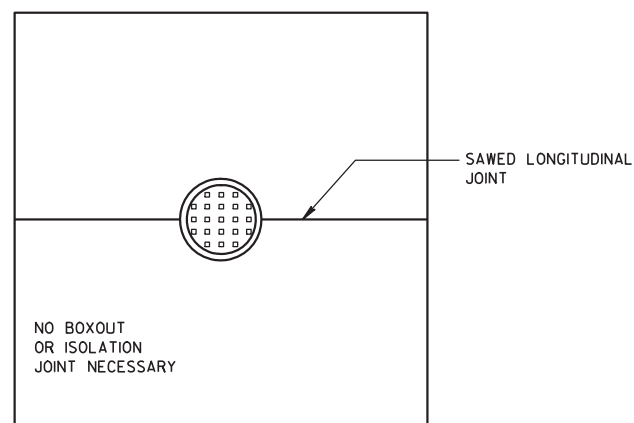


**MANHOLE WITH LONGITUDINAL JOINT**

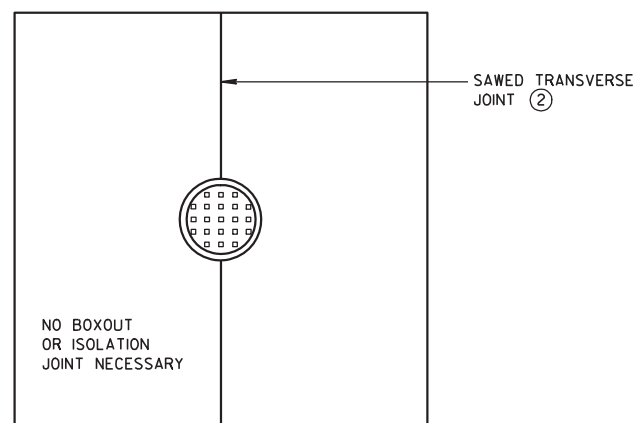


**MANHOLE WITH TRANSVERSE JOINT**

6

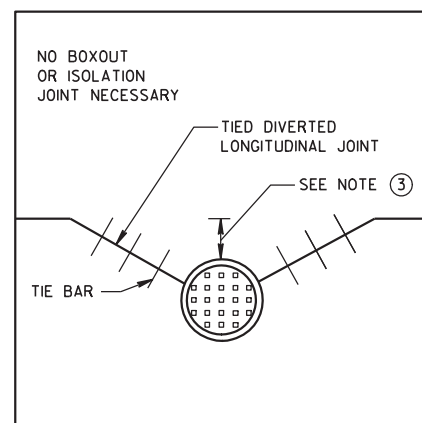

**MANHOLE WITH DIVERTED LONGITUDINAL CONTRACTION JOINT**

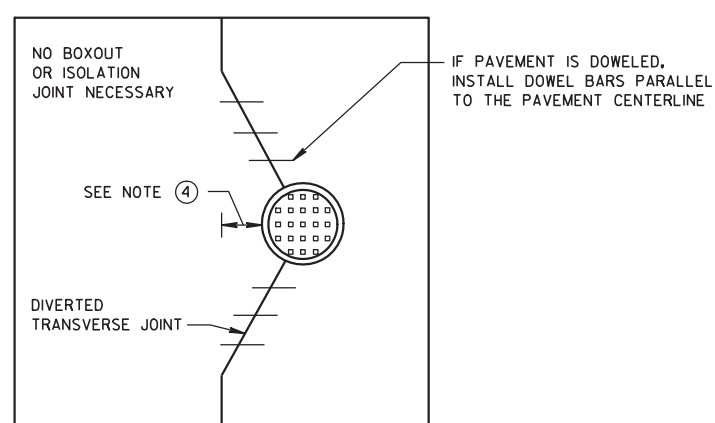

**MANHOLE WITH DIVERTED TRANSVERSE CONTRACTION JOINT**

S.D.D. 13C18-1d

S.D.D. 13C18-1d

<b>CONCRETE PAVEMENT JOINTING AT UTILITY FIXTURES</b>	
STATE OF WISCONSIN DEPARTMENT OF TRANSPORTATION	
APPROVED 10-5-2010	/S/ Deb Bischoff
DATE	PAVEMENT POLICY & DESIGN ENGINEER
FHWA	



**THIS DRAWING PROVIDES GENERAL GUIDANCE ON TYPICAL DETOUR SIGN LAYOUT AND SPACING. SEE PROJECT DETOUR SIGNING SHEETS FOR SPECIFIC DETAILS FOR EACH PROJECT.**

### GENERAL NOTES

THE EXACT NUMBER, LOCATION AND SPACING OF ALL SIGNS SHALL BE ADJUSTED TO FIT FIELD CONDITIONS AS APPROVED BY THE ENGINEER.

IF THERE ARE EXISTING ROUTE MARKER ASSEMBLIES THAT WILL REMAIN IN PLACE, ADJUST THE LOCATION OF THE DETOUR ROUTE SIGNS TO CORRESPOND WITH THE EXISTING ASSEMBLIES. SEE SPECIFIC PROJECT DETOUR SIGNING DETAIL SHEETS. MODIFY EXISTING SIGNS WHERE POSSIBLE.

THE SPACING BETWEEN TRAFFIC CONTROL AND DETOUR SIGNS SHOULD BE ADJUSTED TO NOT CONFLICT WITH AND TO PROVIDE A DESIRABLE MINIMUM OF 200 FEET CLEARANCE TO EXISTING SIGNS THAT WILL REMAIN IN PLACE.

ANY SIGNS TEMPORARY OR EXISTING, WHICH CONFLICT WITH TRAFFIC CONTROL "IN USE", SHALL BE REMOVED OR COVERED AS NEEDED AND AS APPROVED BY THE ENGINEER.

SIGNS THAT WILL BE IN PLACE LESS THAN 7 CONTINUOUS DAYS AND NIGHTS MAY BE MOUNTED ON PORTABLE SUPPORTS.


"MO" SIGNS ARE THE SAME AS "M" SIGNS EXCEPT THE BACKGROUND IS ORANGE.

SIGN SIZES SHALL BE AS FOLLOWS:

- M3-X AND M4-8 SHALL BE 24" X 12". (30" X 15" IF NEEDED TO MATCH EXISTING SIGNS.)
- M1-4, M1-5A, AND M1-6 SHALL BE 24" X 24". (36" X 36" IF NEEDED TO MATCH EXISTING SIGNS.)
- M05-1 AND M06-1 SHALL BE 21" X 21". (30" X 30" IF NEEDED TO MATCH EXISTING SIGNS.)
- M4-9 SHALL BE 30" X 24".
- M4-8a SHALL BE 24" X 18".
- G20-51 SHALL BE 60" X 24".
- W20-2 SHALL BE 48" X 48".
- D1-X SHALL BE AS SHOWN ON SPECIFIC PROJECT SIGNING DETAIL SHEETS.

\* OPTIONAL SIGNS. SEE SPECIFIC PROJECT DETOUR SIGNING DETAIL SHEETS.

\*\* FOR A TOWN ROAD OR LOCAL STREET DETOURED ONTO A STATE TRUNK HIGHWAY, PLACE A ROAD NAME PLAQUE ABOVE THE M4-9 SIGN AS SPECIFIED IN THE CONTRACT.

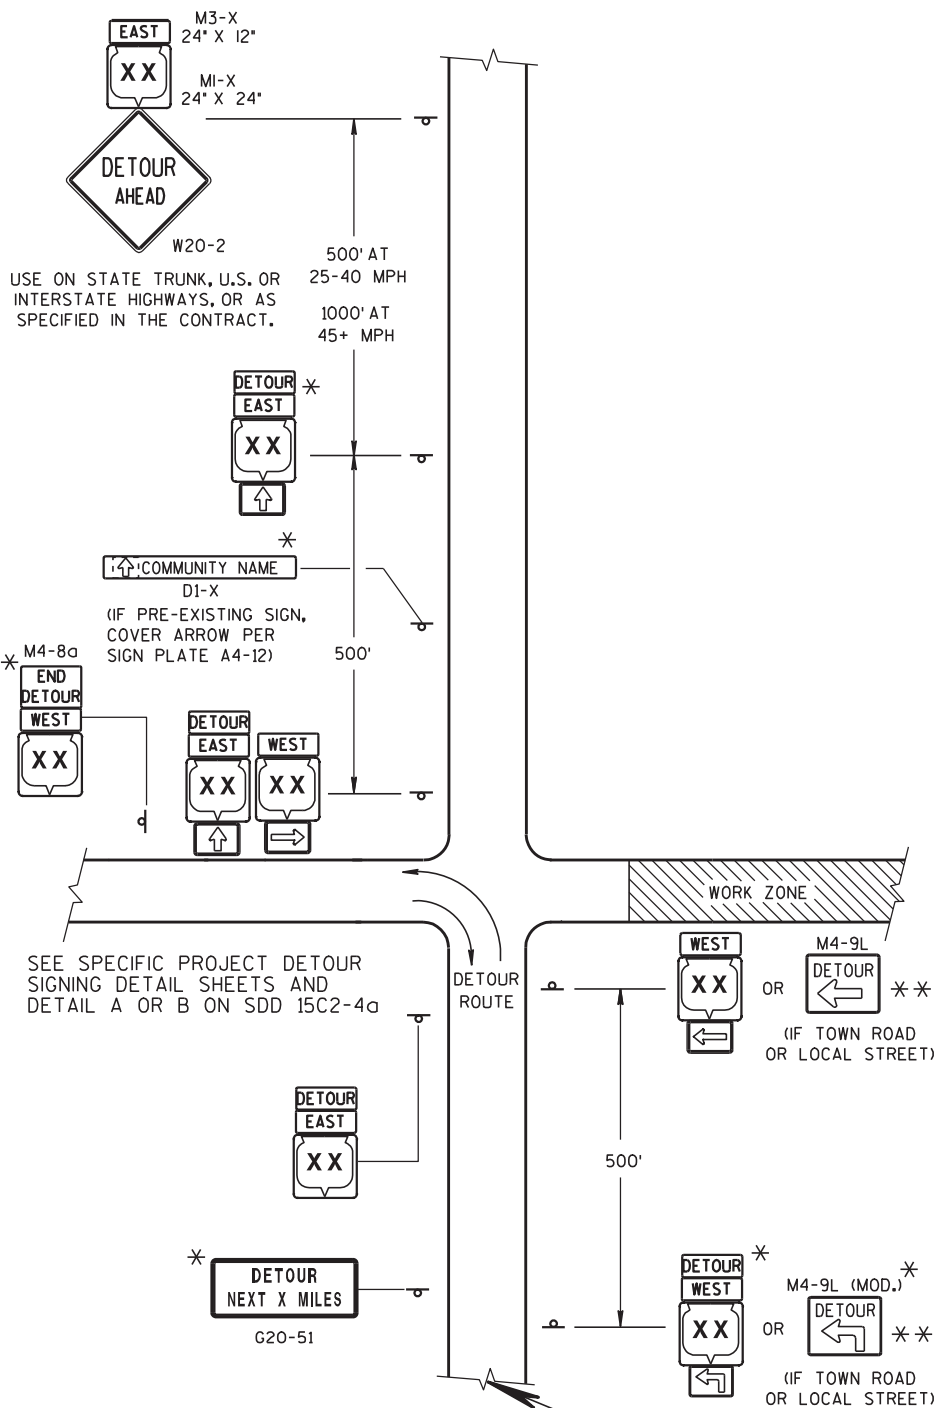

SEE SPECIFIC PROJECT DETOUR SIGNING DETAIL SHEETS AND DETAIL A OR B ON SDD 15C2-4a

### LEGEND

⌋ POST MOUNTED SIGN


▨ WORK ZONE

DETOUR EAST M4-8  
DETOUR WEST M3-X

XX OR XX OR XX  
M1-4 M1-5A M1-6




OR OR OR  
M05-1 M06-1 M06-1

### MATCH POINT

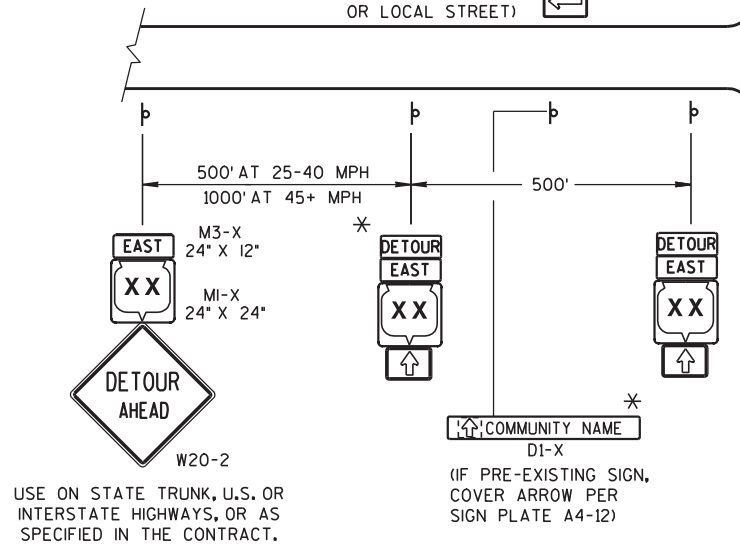

USE ON STATE TRUNK, U.S. OR INTERSTATE HIGHWAYS, OR AS SPECIFIED IN THE CONTRACT.


### DETAIL F DETOUR SIGNING

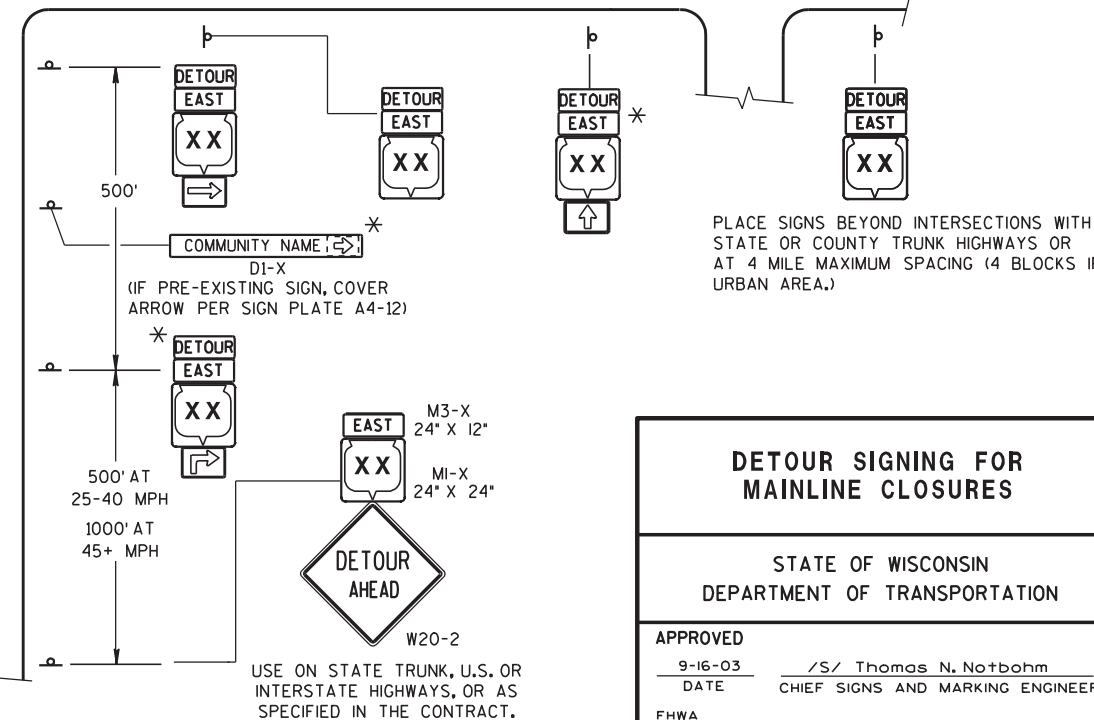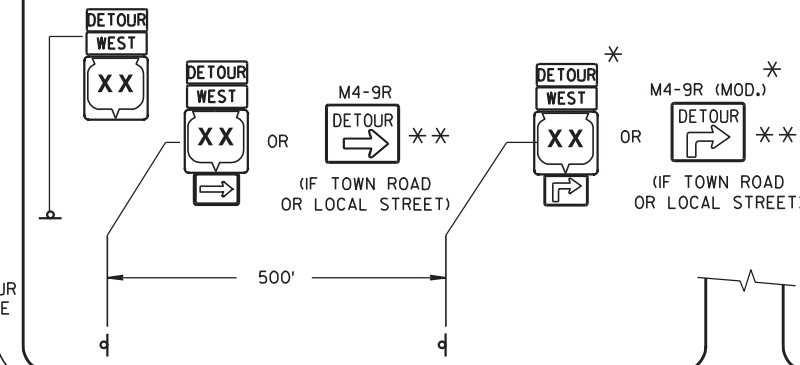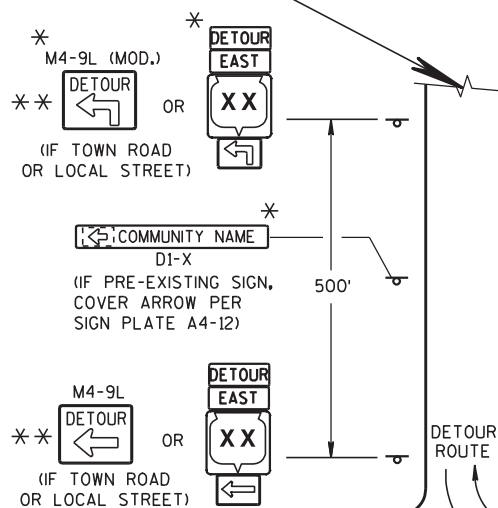


### DETOUR SIGNING FOR MAINLINE CLOSURES

STATE OF WISCONSIN  
DEPARTMENT OF TRANSPORTATION

APPROVED	/s/ Thomas N. Notbohm
DATE 9-16-03	CHIEF SIGNS AND MARKING ENGINEER
FHWA	

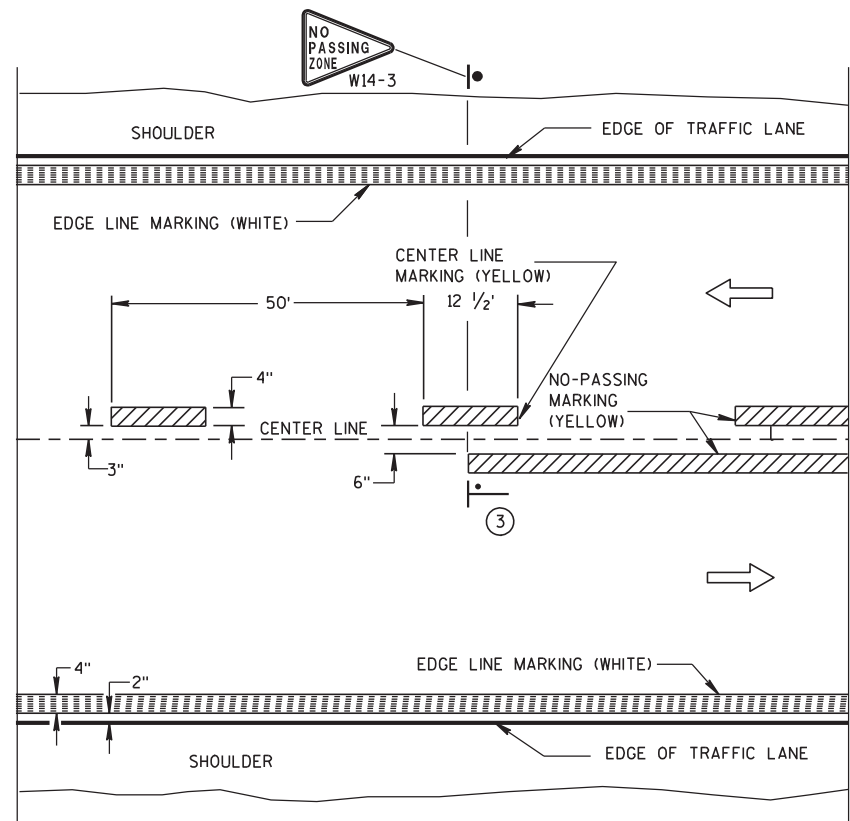


TWO WAY TRAFFIC

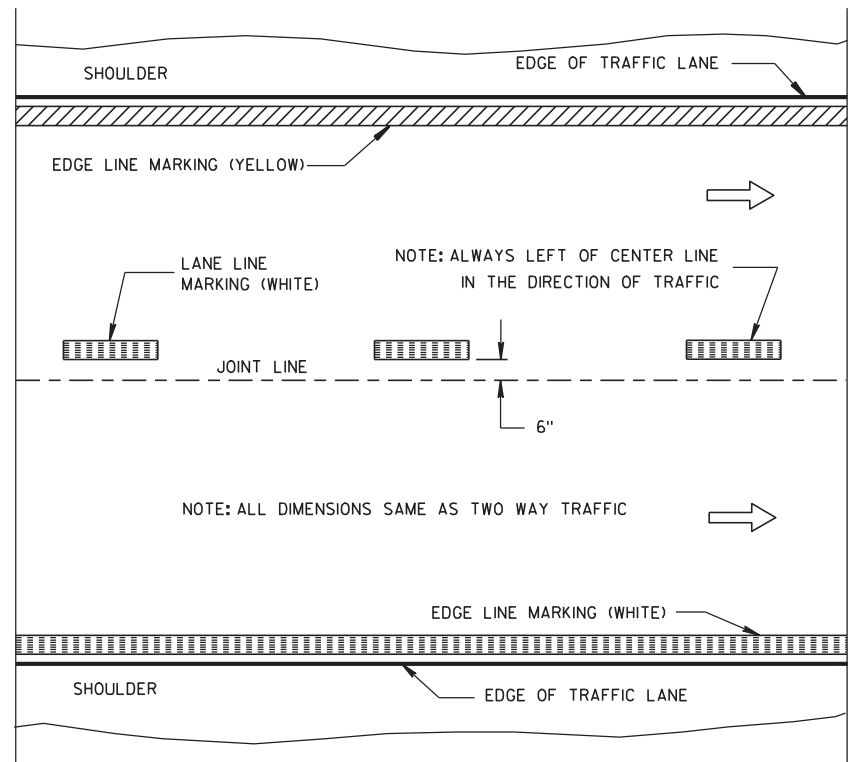


ONE WAY TRAFFIC

## PERMANENT PAVEMENT MARKING

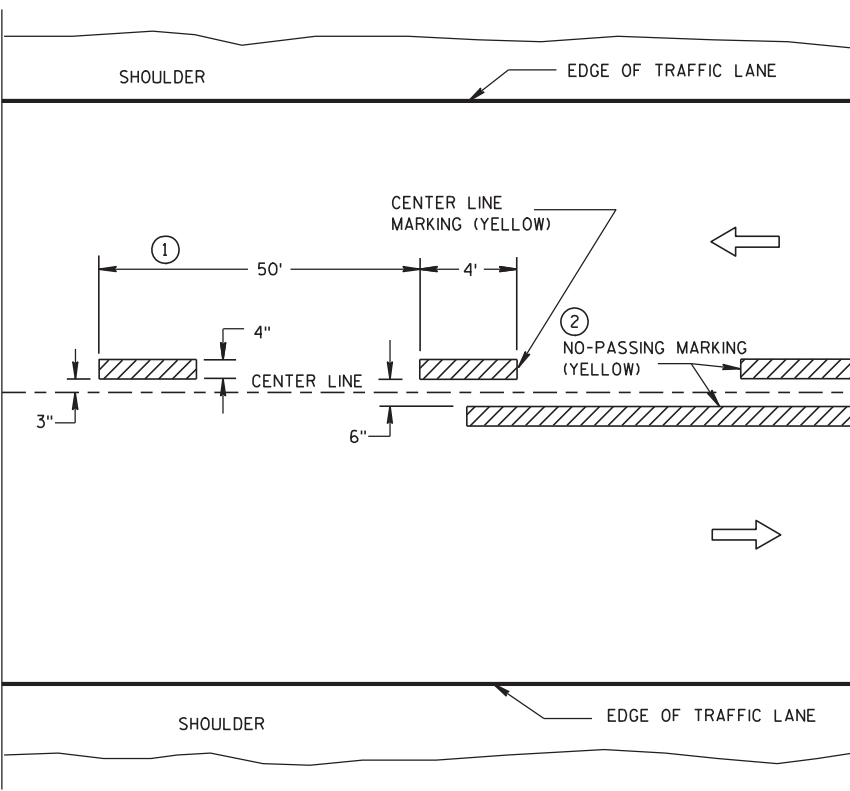

TWO WAY TRAFFIC

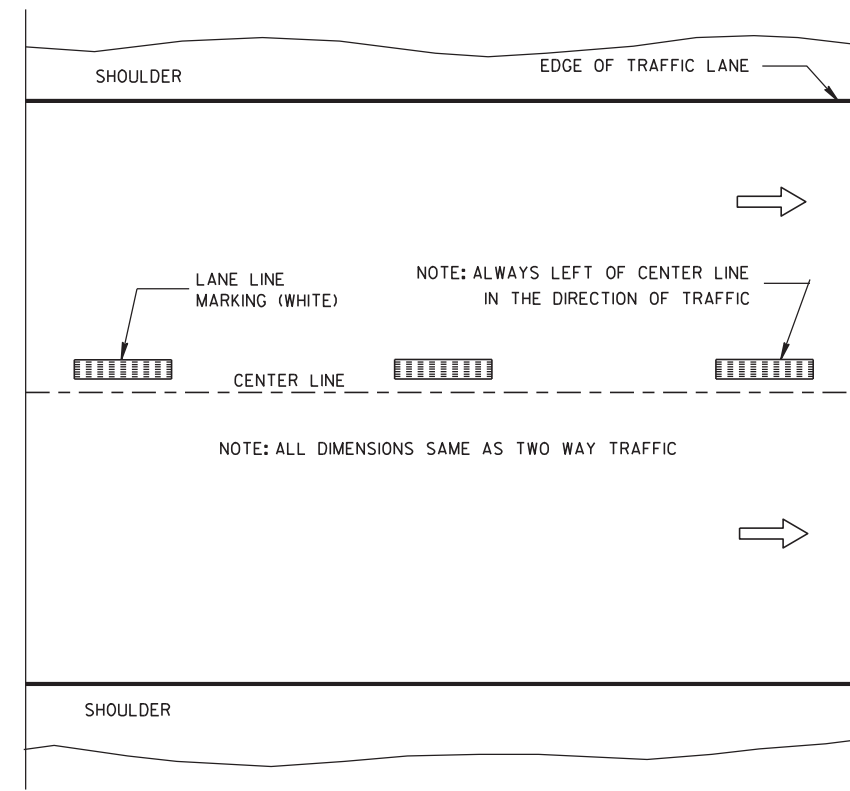

ONE WAY TRAFFIC

## TEMPORARY (INTERMEDIATE) PAVEMENT MARKING (SHOWS CYCLE FOR TEMPORARY CENTER LINE OR TEMPORARY LANE LINE MARKING)


## GENERAL NOTES

DETAILS OF CONSTRUCTION NOT SHOWN ON THIS DRAWING SHALL CONFORM TO STANDARD SPECIFICATIONS AND SPECIAL PROVISIONS.

- ① HALF CYCLE LENGTHS (25'±) WITH 2' MINIMUM STRIPE LENGTHS SHALL BE PROVIDED ON ROADWAYS (INCLUDING TEMPORARY TRAVELED WAYS) WITH REVERSE CURVATURE, CURVATURE OF OVER 5 DEGREES OR WHEN DIRECTED BY THE ENGINEER TO MARK UNUSUAL ALIGNMENT OF THE TRAVELED WAY.
- ② NO PASSING ZONE TEMPORARY PAVEMENT MARKING IS REQUIRED TO BE PLACED, WHERE APPROPRIATE, ALONG WITH CENTERLINE TEMPORARY PAVEMENT MARKING WHEN A SAME DAY PERMANENT PAVEMENT MARKING ITEM IS INCLUDED IN THE CONTRACT.
- ③ NO PASSING ZONE MARKINGS ARE PLACED ACCORDING TO "T" MARKINGS. IF EXISTING NO PASSING ZONE W14-3 SIGNS ARE BEYOND 50 FEET IN EITHER DIRECTION, THE SIGNS SHALL BE MOVED TO THE "T" MARKINGS.

## NOTE

ARROW SYMBOL ( → ) SHOWS DIRECTION OF TRAVEL

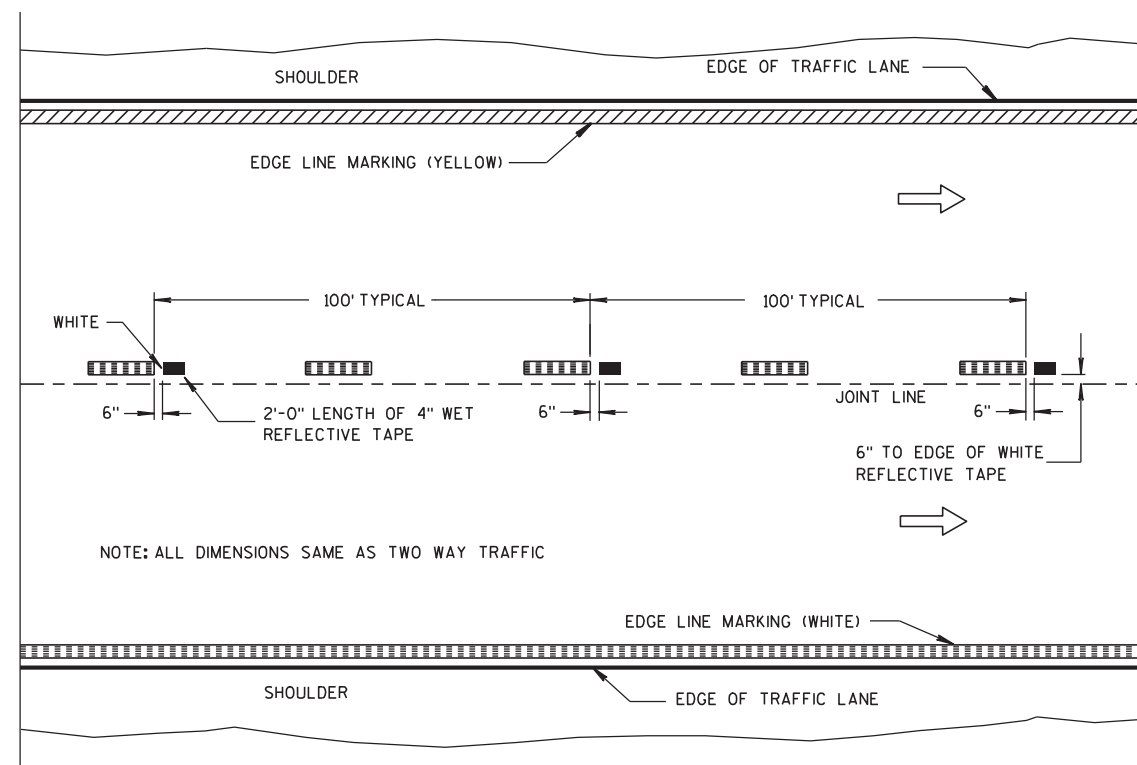

## WET REFLECTIVE TAPE SUPPLEMENT TO SPRAYED OR NON WET REFLECTIVE TAPE LANE LINE


## LEGEND

- "T" MARKING
- POST MOUNTED SIGN

## PAVEMENT MARKING (MAINLINE)


STATE OF WISCONSIN  
DEPARTMENT OF TRANSPORTATION

APPROVED  
6-23-11 /S/ Thomas N. Notbohm  
DATE STATE TRAFFIC ENGINEER OF DESIGN  
FHWA

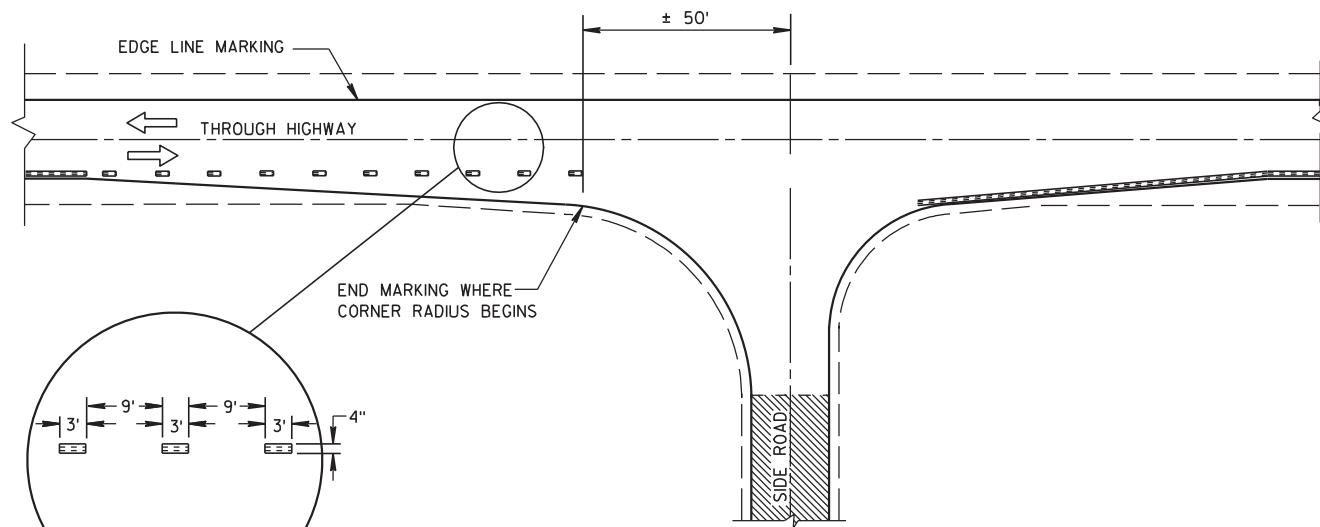

### MINOR INTERSECTION WITHOUT CURBS

POSTED SPEED (MPH)	MINIMUM DISTANCE BETWEEN ZONES (FEET)
25 - 30	528
35 - 40	528
45 - 50	686
55	792

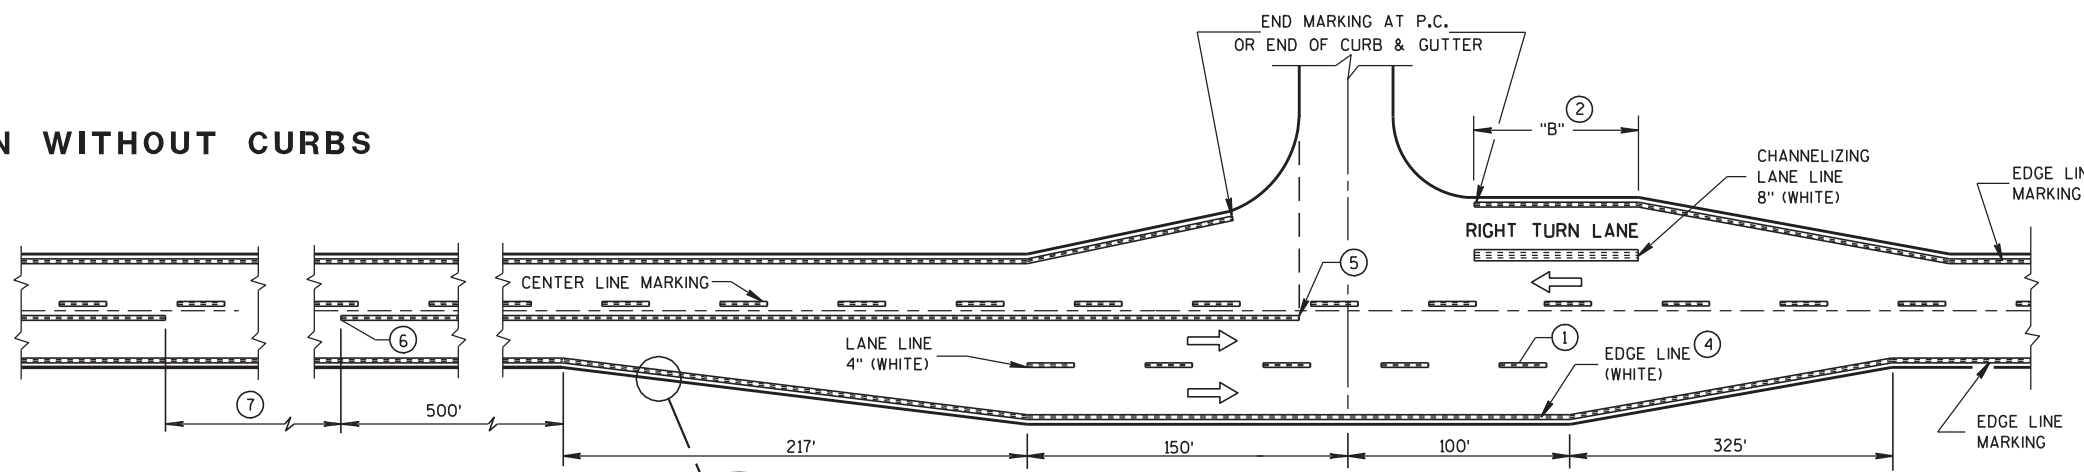

### MAJOR INTERSECTIONS (INTERSECTION WITH FULL RIGHT TURN LANE OR BYPASS LANES)

## GENERAL NOTES

EDGE LINES SHALL BE OMITTED THROUGH INTERSECTIONS. EDGE LINES SHALL BE CONTINUED THROUGH DRIVEWAYS.


- ① WHEN DISTANCE "A" IS LESS THAN 250 FEET, OMIT LANE LINE.
- ② WHEN DISTANCE "B" IS LESS THAN 100 FEET, OMIT CHANNELIZING LANE LINE.
- ③ ALTERNATIVE MARKING SHALL BE PROVIDED WHEN SPECIFIED IN THE CONTRACT. TYPICAL SITUATIONS WHERE THIS MARKING MAY BE REQUIRED ARE WHERE THE INTERSECTION IS ON A SHARP HORIZONTAL CURVE OR CREST VERTICAL CURVE IN AN UNLIGHTED AREA SUCH THAT THE EDGE LINE MAY BE MISLEADING TO THE MOTORIST OR DISAPPEAR FROM SIGHT.
- ④ THE EDGE LINE IN THE TAPER AREAS OF THE BYPASS LANE AND THE BYPASS LANE SHALL BE LOCATED 1-FOOT FROM EDGE OF PAVEMENT TO THE OUTSIDE EDGE OF EDGE LINE.

- ⑤ BARRIER LINE ENDS AT SIDE ROAD PAVEMENT/SURFACE EDGE EXTENSION.
- ⑥ BARRIER LINE STARTS 500 FEET PRIOR TO THE BYPASS TAPER.
- ⑦ IF THE DISTANCE BETWEEN 2 SUCCESSIVE NO-PASSING ZONES IS LESS THAN THE MINIMUM DISTANCE BETWEEN ZONES, CONNECT THE 2 ZONES.
- ⑧ 3' LINE 9' GAP, EXCEPT RETRACE THE EXISTING LINE - GAP PATTERN WHERE EXISTING MARKINGS ARE IN PLACE.


ARROW SYMBOL ( ) SHOWS DIRECTION OF TRAVEL

6

6

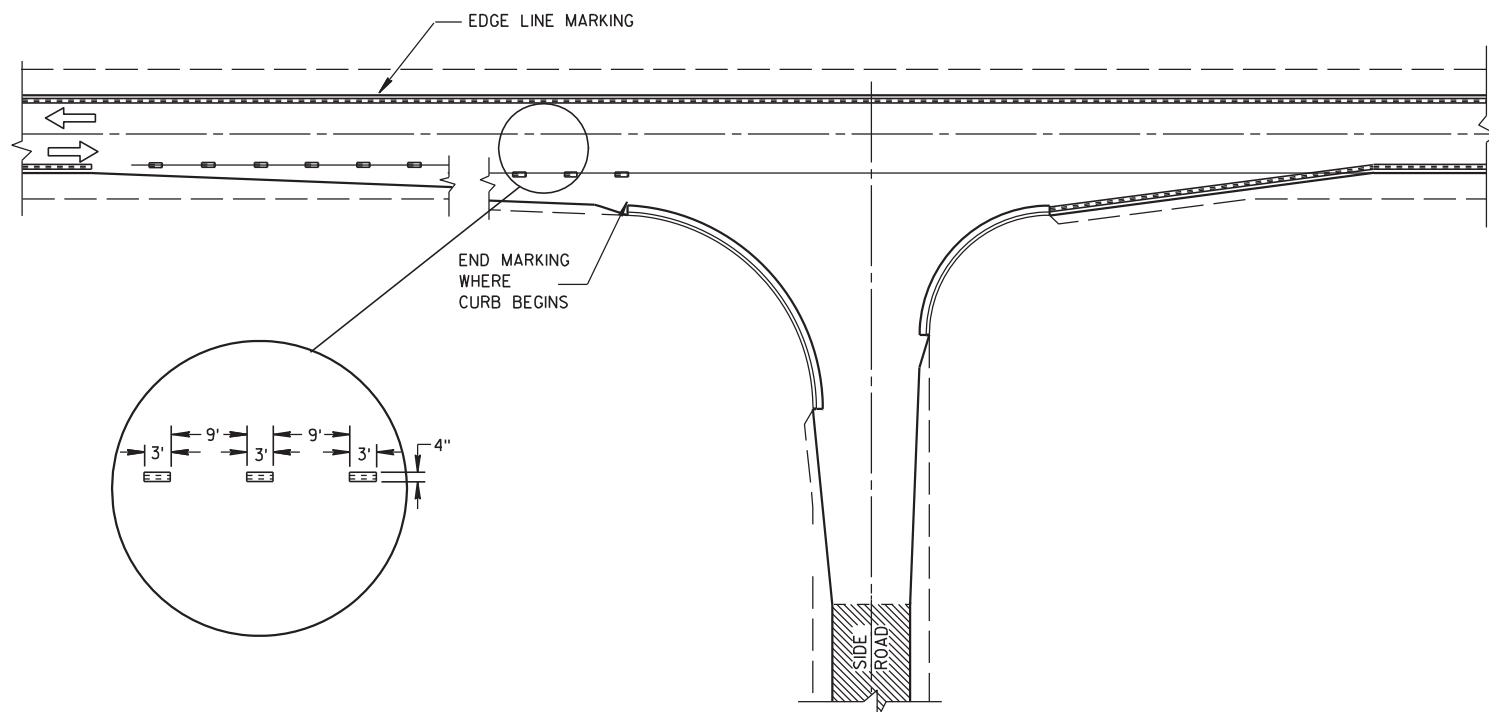

### MINOR INTERSECTION WITH CURBS (TYPICAL MARKING)

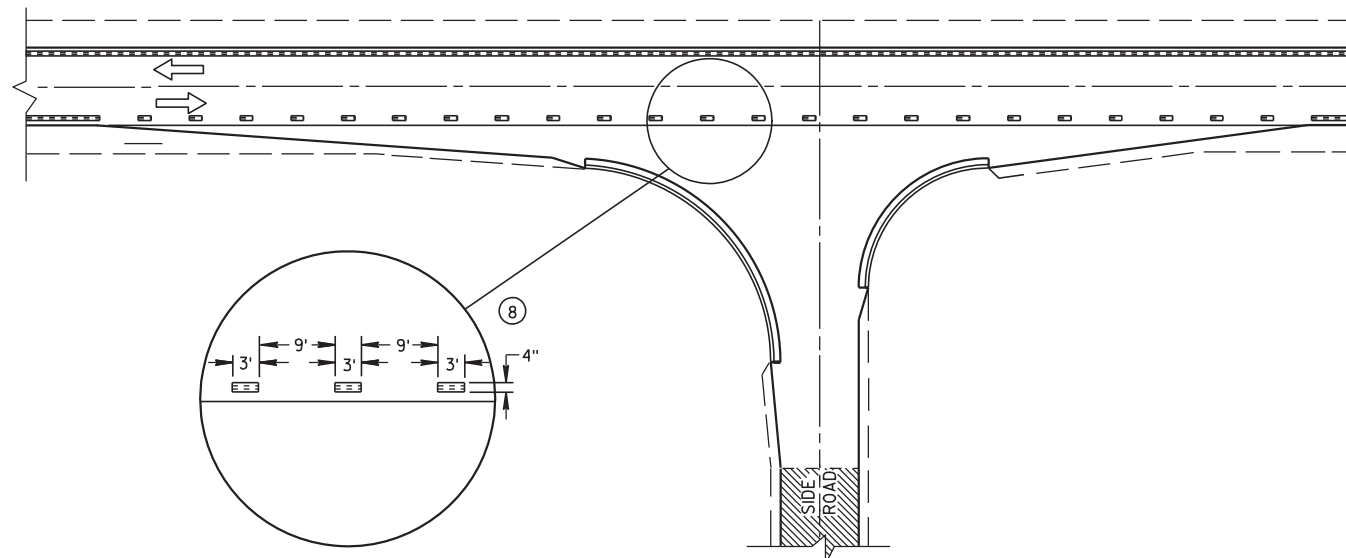


### MINOR INTERSECTION WITH CURBS ③ (FOR SPECIAL CONDITIONS AS SPECIFIED)


PAVEMENT MARKING  
(INTERSECTIONS)

STATE OF WISCONSIN  
DEPARTMENT OF TRANSPORTATION




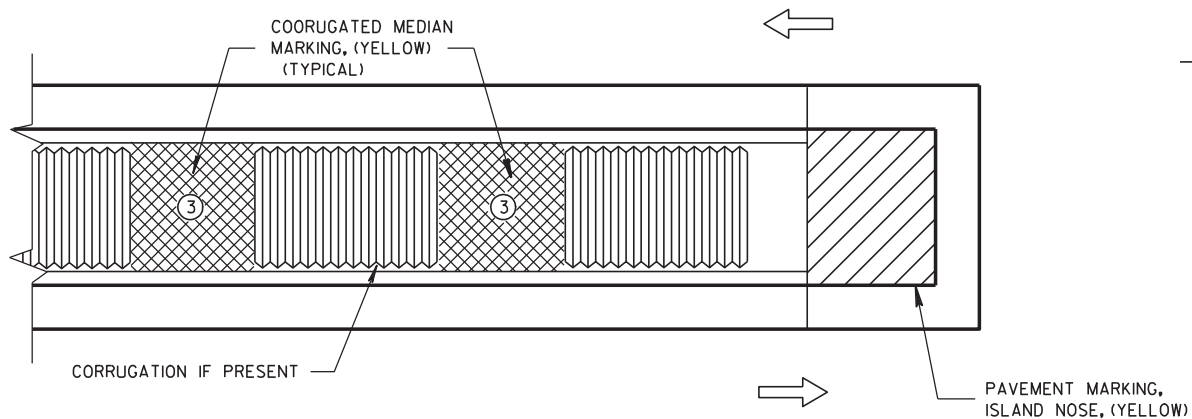

**MEDIAN ISLAND WITH SQUARE BLUNT NOSE**

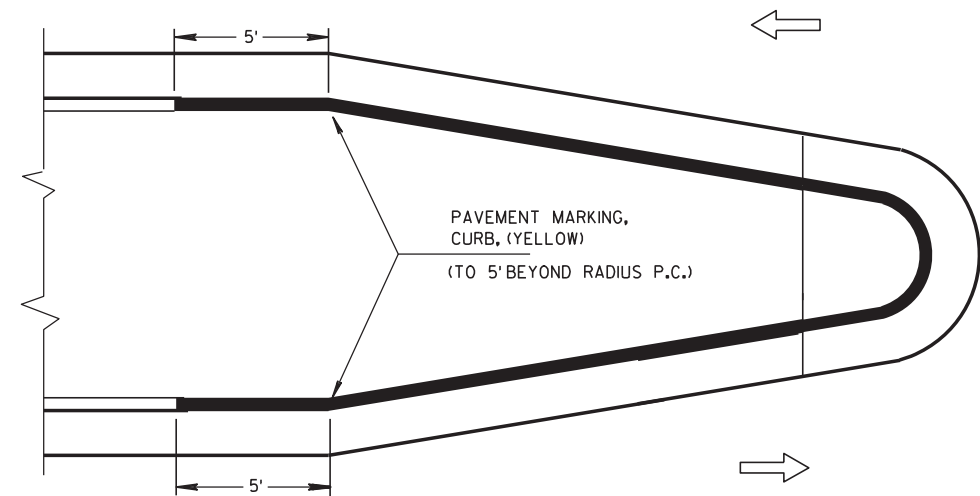


**MEDIAN ISLAND WITH ROUND BLUNT NOSE**

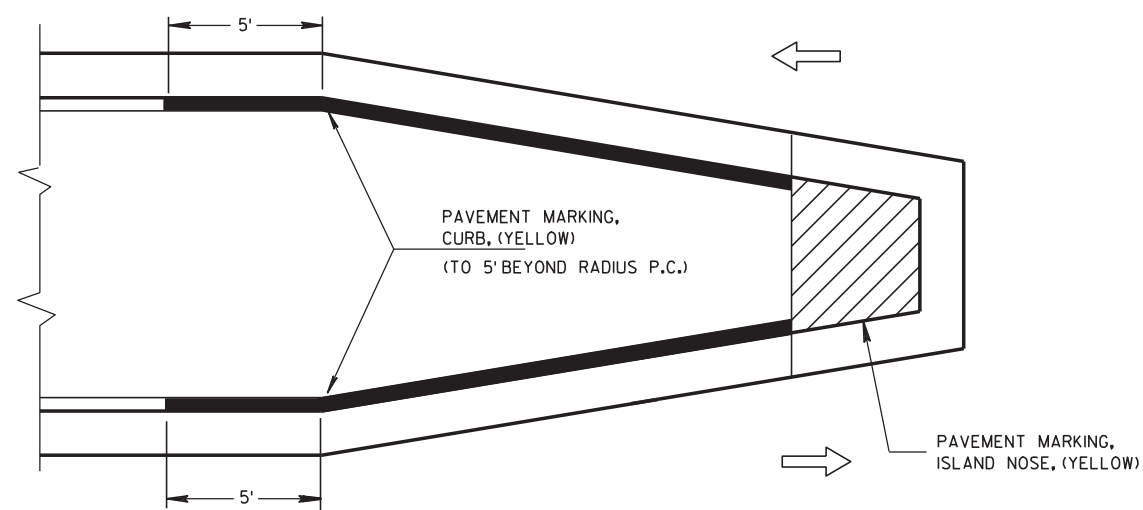

**MEDIAN ISLAND WITH SLOPED NOSE**


**TYPICAL PLACEMENT OF PAVEMENT MARKING ON MEDIAN ISLANDS**

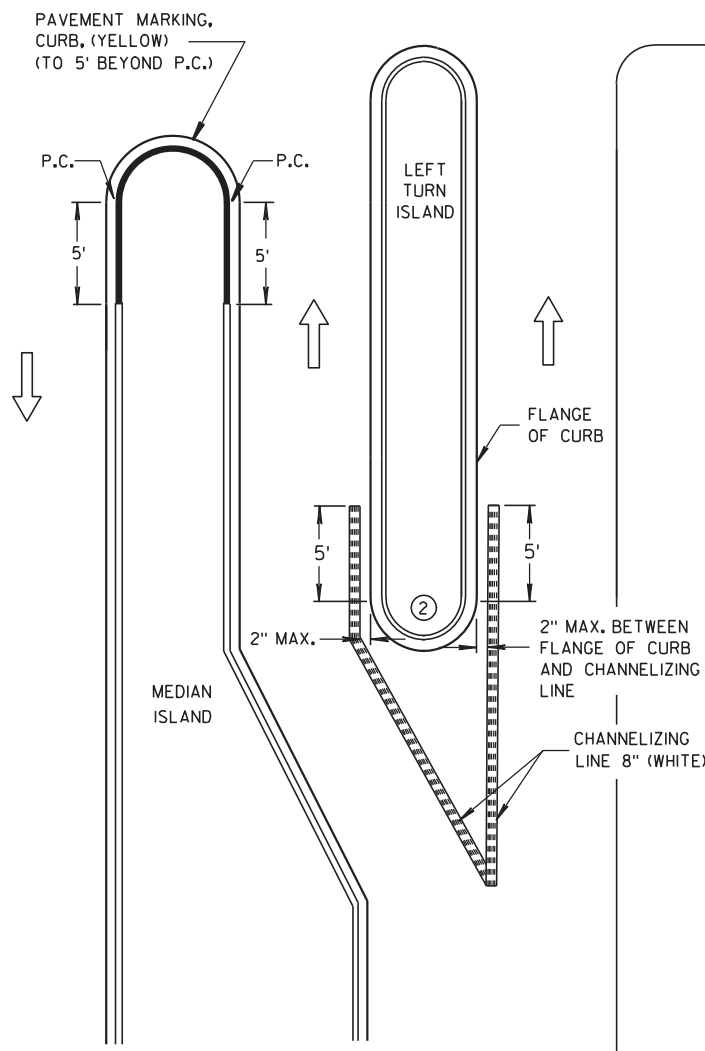


**LEFT TURN & MEDIAN ISLAND**

**GENERAL NOTES**

- ① STOP LINE IS REQUIRED ONLY WHEN SPECIFIED IN THE CONTRACT.
- ② DO NOT MARK CURB NOSES THAT SEPARATE LANES OF TRAFFIC TRAVELING IN THE SAME DIRECTION.
- ③ WHEN CONCRETE CORRUGATED MEDIAN IS CONSTRUCTED TO SEPARATE TRAFFIC OPERATING IN THE OPPOSING DIRECTION YELLOW PAVEMENT MARKING SHALL BE APPLIED TO THE FLAT PORTION OF THE CONCRETE CORRUGATED MEDIAN. THE ITEM OF PAVEMENT MARKING, CONCRETE CORRUGATED MEDIAN, WILL BE MEASURED IN PLACE AND ACCEPTED IN ACCORDANCE WITH THE CONTRACT AND PAID FOR AT THE CONTRACT UNIT PRICE PER SQUARE FOOT.

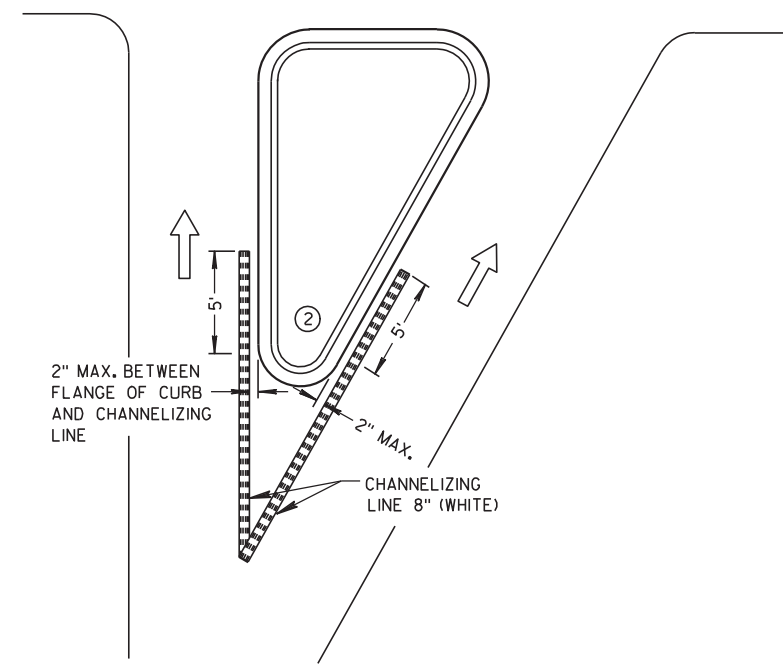

**RIGHT TURN ISLAND**

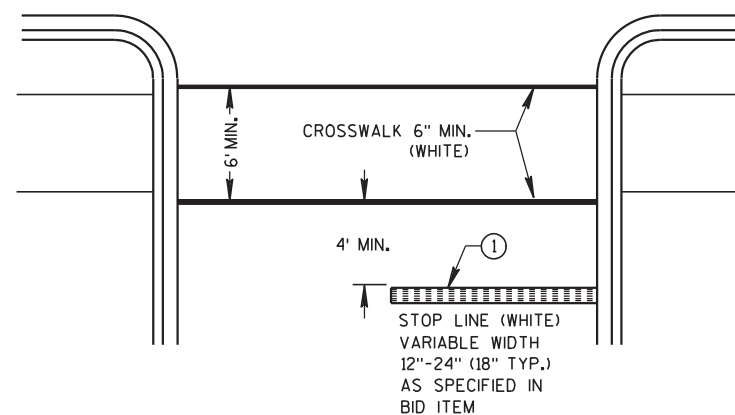

**STOP LINE AND CROSSWALK**

**LEGEND**

- ISLAND NOSE MARKING
- CURB MAKING
- CORRUGATED MEDIAN MARKING
- DIRECTION OF TRAVEL

**PAVEMENT MARKING (ISLANDS, STOP LINE & CROSS WALK)**

STATE OF WISCONSIN  
DEPARTMENT OF TRANSPORTATION




6

6

# 15C12: Traffic Control for Lane Closure (Suitable for Moving Operations)


## TWO-LANE ROADWAY

**SYMBOLS**

-  WORK AREA
-  FLAGGER, EQUIPPED WITH STOP/SLOW PADDLE FASTENED ON SUPPORT STAFF
-  SIGN ON PORTABLE OR PERMANENT SUPPORT



USE OF THE "BE PREPARED TO STOP" SIGN IS OPTIONAL. WHEN USED, THIS SIGN SHALL BE LOCATED BETWEEN THE W20-7a AND W20-4 SIGNS. A 500' TYPICAL SPACING SHALL BE PROVIDED BETWEEN THE SIGNS.

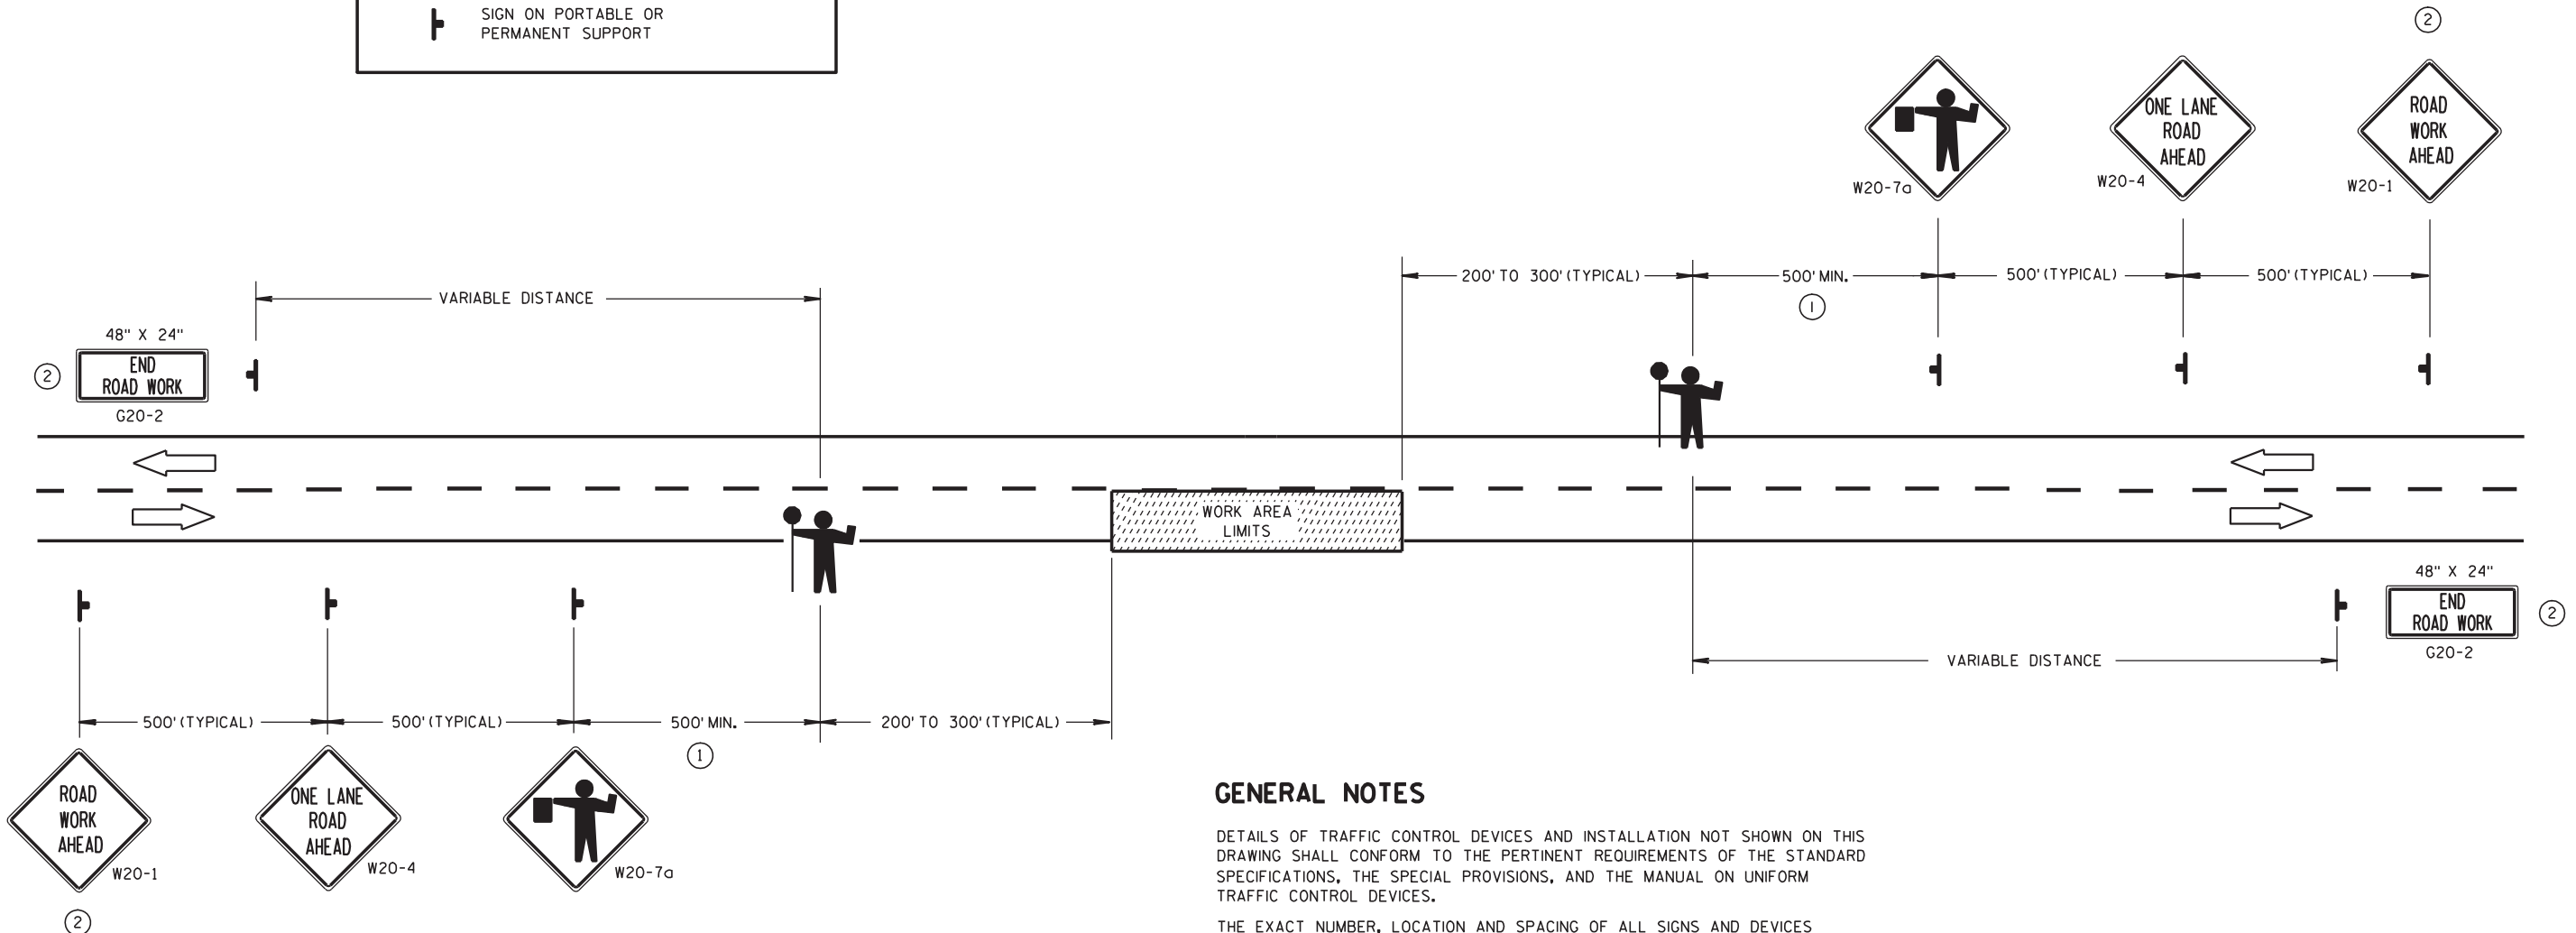

### GENERAL NOTES

DETAILS OF TRAFFIC CONTROL DEVICES AND INSTALLATION NOT SHOWN ON THIS DRAWING SHALL CONFORM TO THE PERTINENT REQUIREMENTS OF THE STANDARD SPECIFICATIONS, THE SPECIAL PROVISIONS, AND THE MANUAL ON UNIFORM TRAFFIC CONTROL DEVICES.

THE EXACT NUMBER, LOCATION AND SPACING OF ALL SIGNS AND DEVICES (AND THE LOCATION OF ALL FLAGGERS) SHALL BE ADJUSTED TO FIT FIELD CONDITIONS AS APPROVED BY THE ENGINEER.

THE FIRST ADVANCE WARNING SIGN SHOULD TYPICALLY BE LOCATED IN ADVANCE OF THE ANTICIPATED TRAFFIC BACKUP OR QUEUE.

WHEN A SIDE ROAD OR RAMP INTERSECTS THE FACILITY ON WHICH THE WORK IS BEING PERFORMED, ADDITIONAL TRAFFIC CONTROLS SHALL BE PROVIDED AS SPECIFIED IN THE PLANS AND/OR THE SPECIAL PROVISIONS OR AS APPROVED BY THE ENGINEER.

FLAGGERS SHALL BE IN SIGHT OF EACH OTHER OR IN DIRECT COMMUNICATION AT ALL TIMES. THEY SHALL BE EQUIPPED WITH STOP/SLOW PADDLES FASTENED ON SUPPORT STAFFS. WHEN THE FLAGGING OPERATION IS NOT IN EFFECT, THE "FLAGGER AHEAD", THE "ROAD WORK AHEAD" AND THE ONE LANE ROAD AHEAD" SIGNS SHALL BE COVERED OR REMOVED AND THE HIGHWAY RESTORED TO NORMAL OPERATION.

ALL SIGNS ARE 48" X 48" UNLESS OTHERWISE NOTED.

- ① FOR A MOVING WORK OPERATION, SIGNING FOR BOTH DIRECTIONS SHALL BE REESTABLISHED (AS SIMULTANEOUSLY AS PRACTICAL) AT APPROXIMATELY 3500 FOOT INTERVALS IN THE MOVING WORK OPERATION OR AS APPROVED BY THE ENGINEER.
- ② SIGN NOT REQUIRED IF FLAGGING OPERATION OCCURS WITHIN A SIGNED ROAD WORK ZONE AREA.

### TRAFFIC CONTROL FOR LANE CLOSURE (SUITABLE FOR MOVING OPERATIONS)

STATE OF WISCONSIN  
DEPARTMENT OF TRANSPORTATION

APPROVED  
9/5/06 /S/ Thomas N. Notbohm  
DATE STATE TRAFFIC ENGINEER OF DESIGN  
FHWA

# 15D12: Traffic Control, Lane Closure, Speeds Greater than 40 M.P.H.

## LEGEND

- ⊣ POST WITH ATTACHED SIGN
- Ⓞ POST WITH ATTACHED SIGN IN DRUM
- ⚡ DRUM WITH WARNING LIGHT (TYPE C)
- DRUM
- ➔ ARROW BOARD
- 8' TYPE III BARRICADE
- \*-x-\* REMOVING PAVEMENT MARKING
- ➔ DIRECTION OF TRAFFIC

## GENERAL NOTES :

THE EXACT NUMBER, LOCATION, AND SPACING OF ALL SIGNS AND DEVICES SHALL BE ADJUSTED TO FIT FIELD CONDITIONS AS APPROVED BY THE ENGINEER.

THE SPACING BETWEEN SIGNS SHOULD BE ADJUSTED TO NOT CONFLICT WITH AND TO PROVIDE A MINIMUM OF 200 FEET, (500 FEET DESIREABLE) DISTANCE TO EXISTING SIGNS.

THIS LANE CLOSURE IS TYPICAL FOR CLOSING RIGHT LANE - REVERSE FOR CLOSING LEFT LANE.

ALL SIGNS ARE 48"x48" UNLESS OTHERWISE NOTED.

"WO" IS THE SAME AS "W" EXCEPT THE BACKGROUND IS ORANGE.

ANY SIGNS TEMPORARY OR EXISTING, WHICH CONFLICT WITH TRAFFIC CONTROL "IN USE" SHALL BE REMOVED OR COVERED AS NEEDED AND AS APPROVED BY THE ENGINEER. NO WARNING LIGHTS SHALL BE WORKING ON "COVERED" OR "DOWNED" SIGNS.

- ① CONSIDER GEOMETRICS WHEN LOCATING SIGNS AND ARROW BOARD SO THE DRIVER HAS A CLEAR VIEW OF THE ARROW BOARD AND LANE CLOSURE DRUMS FOR A MINIMUM 1500 FEET IN FRONT OF DRUMS.

FOR A LANE CLOSURE THAT IS IN PLACE LESS THAN 7 CONTINUOUS DAYS AND NIGHTS, THE ADVANCED WARNING SIGNS MAY BE MOUNTED ON PORTABLE SUPPORTS.

## GENERAL NOTES CONTINUED:

REMOVE PAVEMENT MARKINGS IF LANE CLOSURE IS TO BE IN PLACE FOR LONGER THAN 7 CONTINUOUS DAYS AND NIGHTS.

WARNING LIGHTS ARE NOT REQUIRED IF THE LANE CLOSURE IS A DAYTIME ONLY OPERATION.

IF THE HORIZONTAL ALIGNMENT IS SUCH THAT A CURVE MAY REQUIRE ADDITIONAL DELINEATION, THE DEVICE SPACING MAY BE DECREASED TO 50 FEET.


IF LANE CLOSURE IS MORE THAN 1 MILE, PLACE A TYPE III BARRICADE APPROXIMATELY EVERY 1/4 MILE ACROSS THE CLOSED LANE TO HELP ENFORCE THE DRUM LINE.

ADJUSTMENTS IN BUFFER SPACE NEED TO BE INCORPORATED WHEN THE LANE CLOSURE OCCURS NEAR AN INTERCHANGE EXIT OR ENTRANCE RAMP. THE LANE CLOSURE MUST TAKE PLACE FAR ENOUGH IN ADVANCE OF AN EXIT OR ENTRANCE RAMP TO STILL ALLOW FOR ADEQUATE BUFFER SPACE. THE MINIMUM LENGTH OF THE BUFFER SPACE BEFORE AN EXIT RAMP SHOULD BE 1/2 THE LENGTH OF THE TRANSITION AREA. THE ENTRANCE RAMP SHOULD BE FOLLOWED BY THE ORIGINAL BUFFER SPACE LENGTH OF 800 FEET DESIRABLE PRIOR TO ANOTHER TRAFFIC CONTROL CHANGE SUCH AS A CROSSOVER MANEUVER.

- \* THE LEFT REVERSE CURVE SIGN (W01-4L) IS ONLY REQUIRED WHEN THIS DETAIL IS USED IN COMBINATION WITH "SINGLE LANE CROSSOVER" DETAIL.

6


6

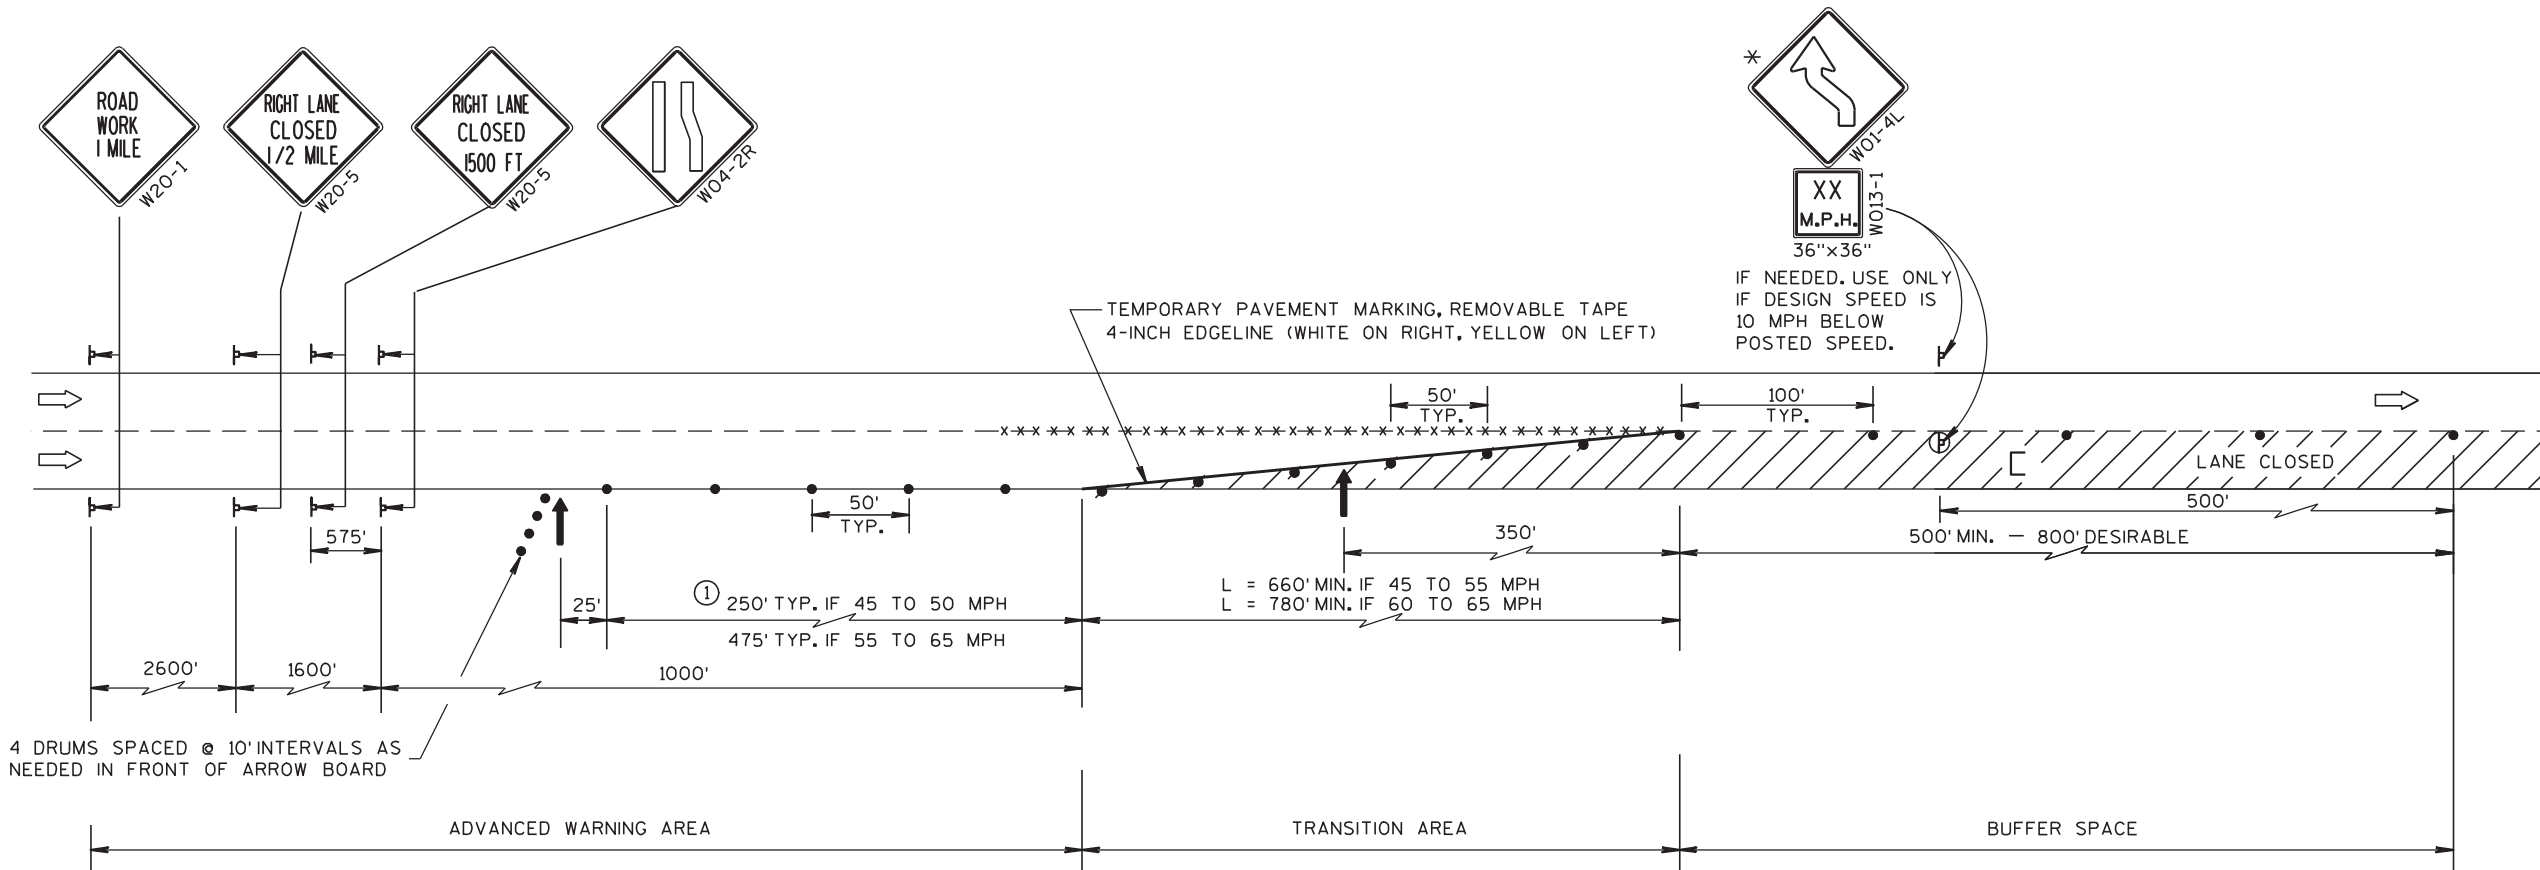

S.D.D. 15 D 12-2

S.D.D. 15 D 12-2

<b>TRAFFIC CONTROL, LANE CLOSURE, SPEEDS GREATER THAN 40 M.P.H.</b>	
STATE OF WISCONSIN DEPARTMENT OF TRANSPORTATION	
APPROVED 8-7-95 DATE	/s/ Chester J. Spang DIRECTOR, OFFICE OF TRAFFIC
FHWA	

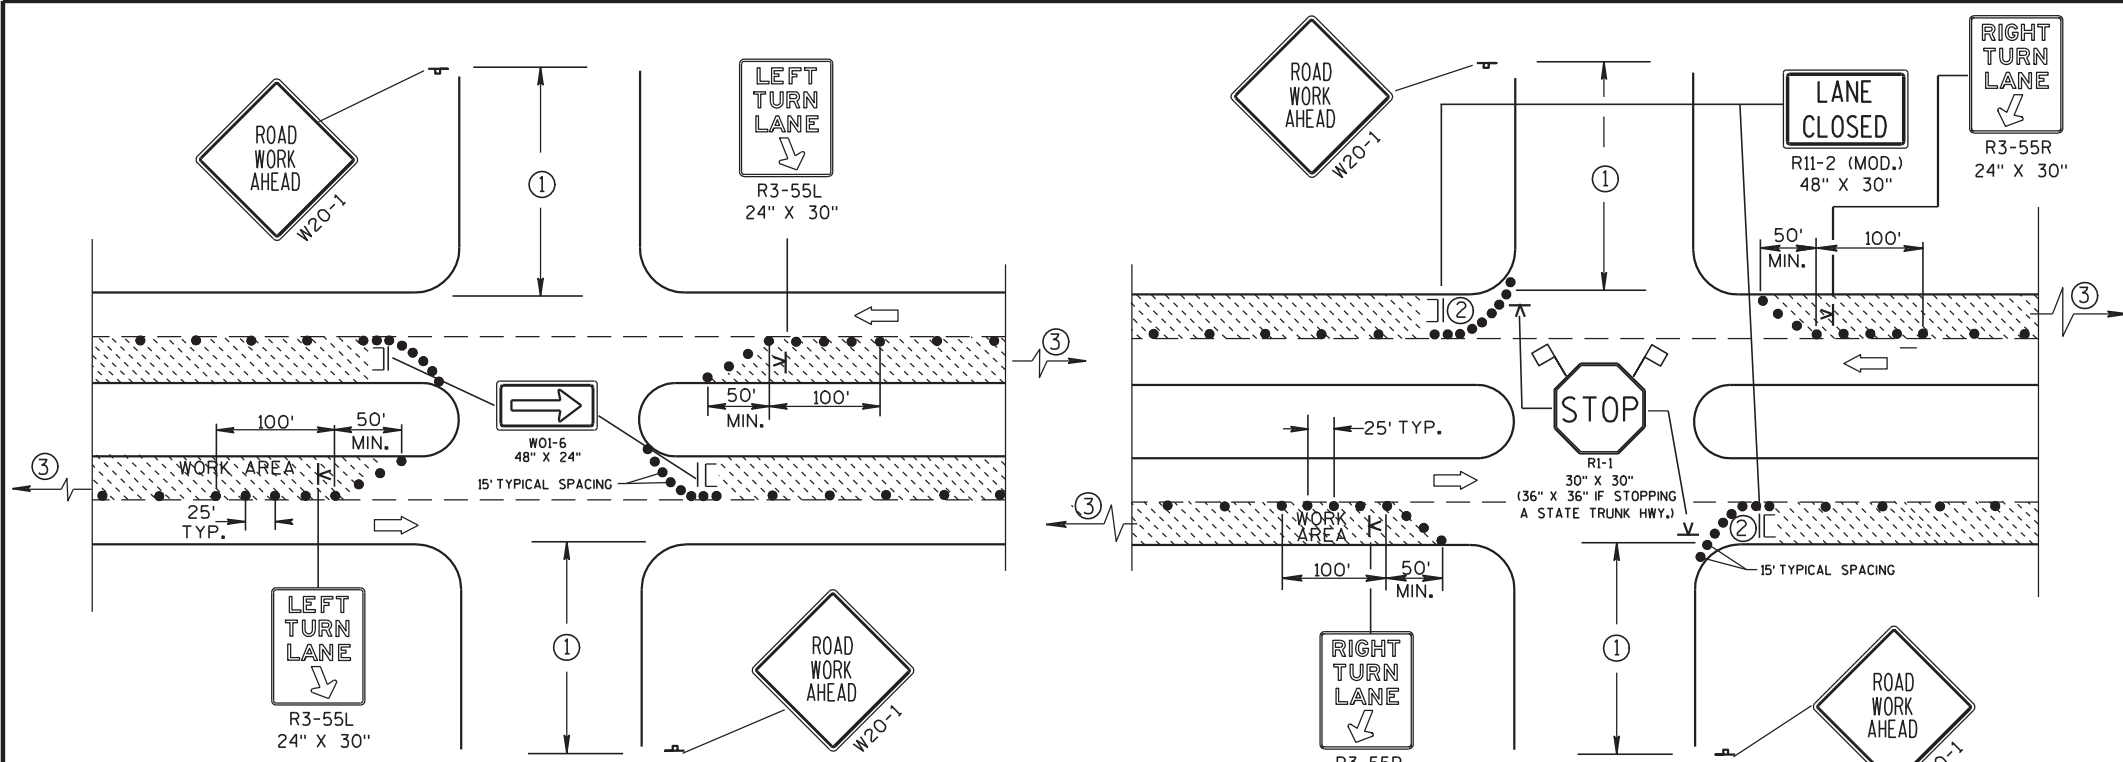

**DETAIL A**  
FOR LEFT LANE CLOSURE AT INTERSECTION OR MEDIAN OPENING

PROVIDE TURN LANES AT INTERSECTIONS WHENEVER STAGING OF WORK ALLOWS. TAPER AND TURN LANE LENGTHS BASED ON FIELD CONDITIONS AS APPROVED BY THE ENGINEER.

**DETAIL B**  
FOR RIGHT LANE CLOSURE AT INTERSECTION

**GENERAL NOTES**

THE EXACT NUMBER, LOCATION, AND SPACING OF ALL SIGNS AND DEVICES SHALL BE ADJUSTED TO FIT FIELD CONDITIONS AS APPROVED BY THE ENGINEER.

THE SPACING BETWEEN SIGNS SHOULD BE ADJUSTED TO NOT CONFLICT WITH AND SHOULD PROVIDE A DESIRABLE MINIMUM OF 200 FEET CLEARANCE TO EXISTING SIGNS THAT WILL REMAIN IN PLACE.

ALL SIGNS ARE 48"X48" UNLESS OTHERWISE NOTED. IF NECESSARY DUE TO SPACE CONSTRAINTS IN URBAN AREAS, 36" X 36" SIGNS MAY BE USED IF APPROVED BY DISTRICT TRAFFIC UNIT.

"WO" SIGNS ARE THE SAME AS "W" SIGNS EXCEPT THE BACKGROUND IS ORANGE.

SIGN LAYOUTS SHALL BE IN ACCORDANCE WITH THE FHWA'S MANUAL OF STANDARD HIGHWAY SIGNS OR THE WISCONSIN STANDARD SIGN PLATES.

SIGNS THAT WILL BE IN PLACE LESS THAN 7 CONTINUOUS DAYS AND NIGHTS, OR THAT WILL BE PLACED IN A CLOSED LANE, MAY BE MOUNTED ON PORTABLE SUPPORTS.

ANY SIGNS TEMPORARY OR EXISTING, WHICH CONFLICT WITH TRAFFIC CONTROL "IN USE" SHALL BE REMOVED OR COVERED AS NEEDED AND AS APPROVED BY THE ENGINEER.


CHANNELIZING DEVICES PLACED ADJACENT TO WORK AREA SHALL BE PULLED BACK FROM THE TRAVEL LANE WHEN WORK IS NOT IN PROGRESS.

BARRICADES IN A CLOSED LANE THAT MUST BE MOVED FOR A WORK OPERATION SHALL BE IMMEDIATELY RE-ESTABLISHED UPON COMPLETION OF THE OPERATION OR, FOR CONTINUING OPERATIONS, AT THE END OF EACH WORKING DAY.

- ① 500' TYPICAL OR AT LAST INTERSECTION, WHICHEVER IS CLOSER. 350' IF 35-40 MPH. 200' IF 25-30 MPH.
- ② ALSO USE BARRICADE AND 15' TYPICAL DRUM SPACING AT COMMERCIAL DRIVEWAYS.
- ③ SEE SEPARATE LANE CLOSURE DETAIL FOR ADDITIONAL TRAFFIC CONTROL.

6

6

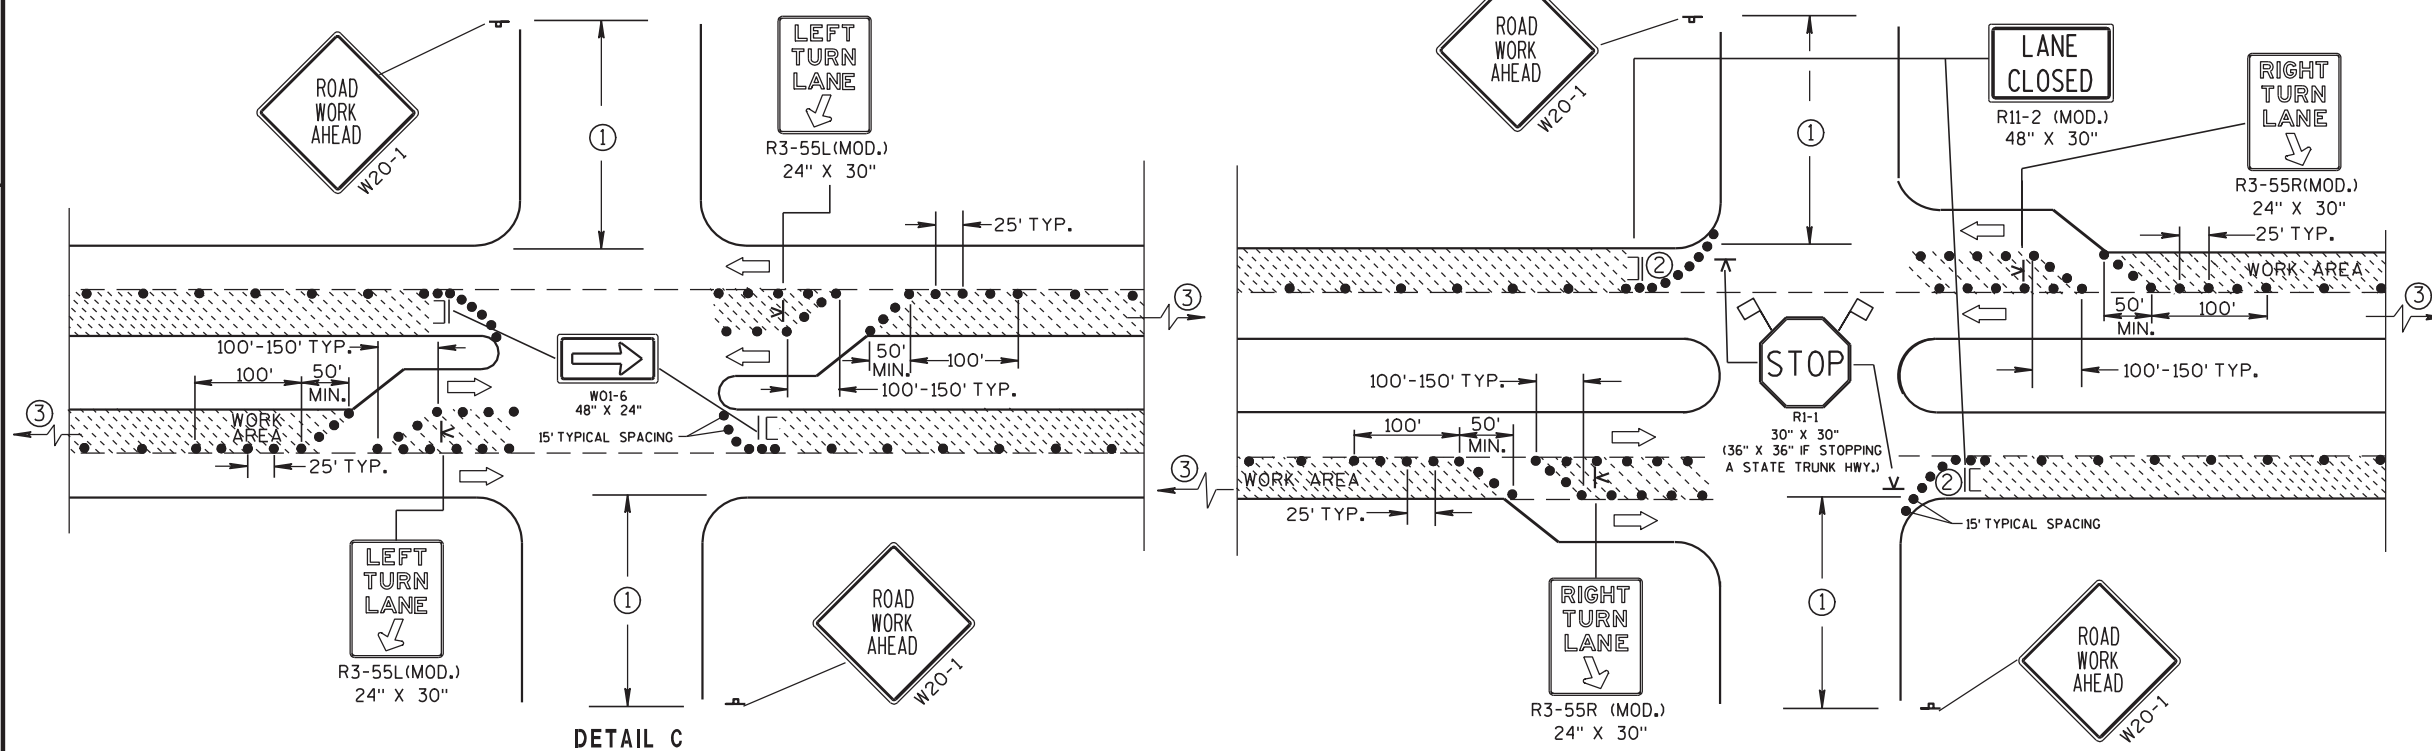

**DETAIL C**  
FOR LEFT LANE CLOSURE AT INTERSECTION OR MEDIAN OPENING (WITH LEFT TURN BAY OPEN)

**DETAIL D**  
FOR RIGHT LANE CLOSURE AT INTERSECTION (WITH RIGHT TURN BAY OPEN)

**LEGEND**

- DRUM
- ⊣ POST MOUNTED SIGN
- K SIGN ON PORTABLE SUPPORT (5' MIN. MOUNTING HEIGHT)
- ⌈ TYPE III BARRICADE (8' EQUIVALENT) AND WARNING LIGHT, TYPE A (FLASHING) WITH SIGN
- ➡ DIRECTION OF TRAFFIC FLOW
- 🚩 FLAGS, 16" X 16" MIN., ORANGE

<b>TRAFFIC CONTROL, INTERSECTION WITHIN SINGLE LANE CLOSURE</b>	
STATE OF WISCONSIN DEPARTMENT OF TRANSPORTATION	
APPROVED 5/23/00 DATE	/S/ Chester J. Spang CHIEF SIGNS AND MARKING ENGINEER
FHWA	




S.D.D. 15 D 21-1

S.D.D. 15 D 21-1



# 15D30: Traffic Control, Sidewalk Closure

## WARNING OF LOCALIZED SIDEWALK WORK AREAS

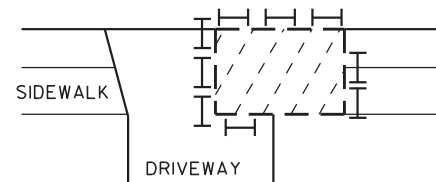
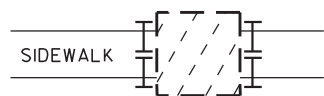
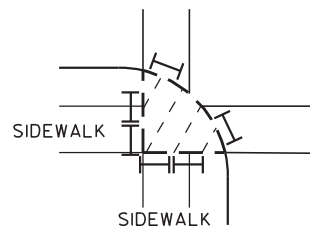


6





6

200' TYP.

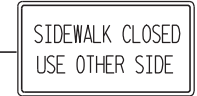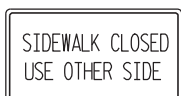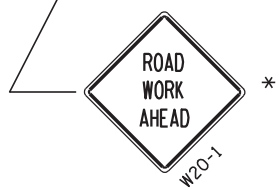IF WORK AREA ENCROACHES INTO THE ROADWAY, SEE OTHER TRAFFIC CONTROL DETAILS FOR ADDITIONAL TRAFFIC CONTROL



### LEGEND

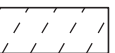-  POST MOUNTED SIGN
-  TYPE II BARRICADE WITH/WITHOUT SIGN (ALL WITH ONE WARNING LIGHT, TYPE A, LOW-INTENSITY FLASHING)
-  WORK AREA
-  DIRECTION OF TRAFFIC FLOW

### GENERAL NOTES :

- ALL SIGNS ARE 48"x48" UNLESS OTHERWISE NOTED. IF NECESSARY DUE TO SPACE CONSTRAINTS, 36"x36" SIGNS MAY BE USED INSTEAD OF 48"x48" SIGNS, IF APPROVED BY DISTRICT TRAFFIC UNIT.
- THE EXACT LOCATION AND PLACEMENT OF ALL SIGNS AND DEVICES SHALL BE ADJUSTED TO FIT FIELD CONDITIONS.
- "WO" SIGNS ARE THE SAME AS "W" SIGNS EXCEPT THE BACKGROUND IS ORANGE.
- \* "ROAD WORK AHEAD" SIGNS ARE NOT REQUIRED IF THE SIDEWALK CLOSURE OCCURS WITHIN A LARGER WORK ZONE WHERE ADVANCE WARNING SIGNS ARE ALREADY PRESENT, OR IF THE WORK AREA AND EQUIPMENT ARE MORE THAN 2 FEET BEHIND THE CURB.
- WARNING SIGNS THAT WILL BE IN PLACE LESS THAN 7 CONTINUOUS DAYS AND NIGHTS MAY BE MOUNTED ON PORTABLE SUPPORTS.

### TRAFFIC CONTROL, SIDEWALK CLOSURE

### TRAFFIC CONTROL, SIDEWALK CLOSURE

STATE OF WISCONSIN  
DEPARTMENT OF TRANSPORTATION

APPROVED  
 5/23/2000 /S/ Chester J. Spang  
 DATE DATE CHIEF SIGNS AND MARKING ENGINEER  
 FHWA

S.D.D. 15 D 30-1


S.D.D. 15 D 30-1

E STREET: STA 49+20 - STA 49+79								EXP Fact=	1.3
STATION	END AREA		VOLUME		CUMULATIVE VOLUME		MASS HAUL (CY)		
	CUT (SF)	FILL (SF)	CUT (CY)	FILL (CY)	CUT (CY)	FILL (CY)			
49+20.5	6.5	0.6							
49+25.0	11.3	3.0	2	0	2	0	2		
49+50.0	42.6	0.4	25	2	27	2	25		
49+57.5	43.5	0.0	12	0	39	2	37		
49+73.7	27.0	0.0	21	0	60	2	58		



EAST SECOND STREET: STA 102+00 - STA 103+19								EXP Fact=	1.3
STATION	END AREA		VOLUME		CUMULATIVE VOLUME		MASS HAUL (CY)		
	CUT (SF)	FILL (SF)	CUT (CY)	FILL (CY)	CUT (CY)	FILL (CY)			
102+00.0	65.2	0.0							
102+25.0	40.2	0.0	49	0	49	0	49		
102+39.4	28.0	0.0	18	0	67	0	67		
102+50.0	25.3	0.0	10	0	77	0	77		
102+75.0	23.8	0.0	23	0	100	0	100		
103+00.0	12.4	0.0	17	0	117	0	117		
103+19.4	8.5	0.0	8	0	125	0	125		


9

9

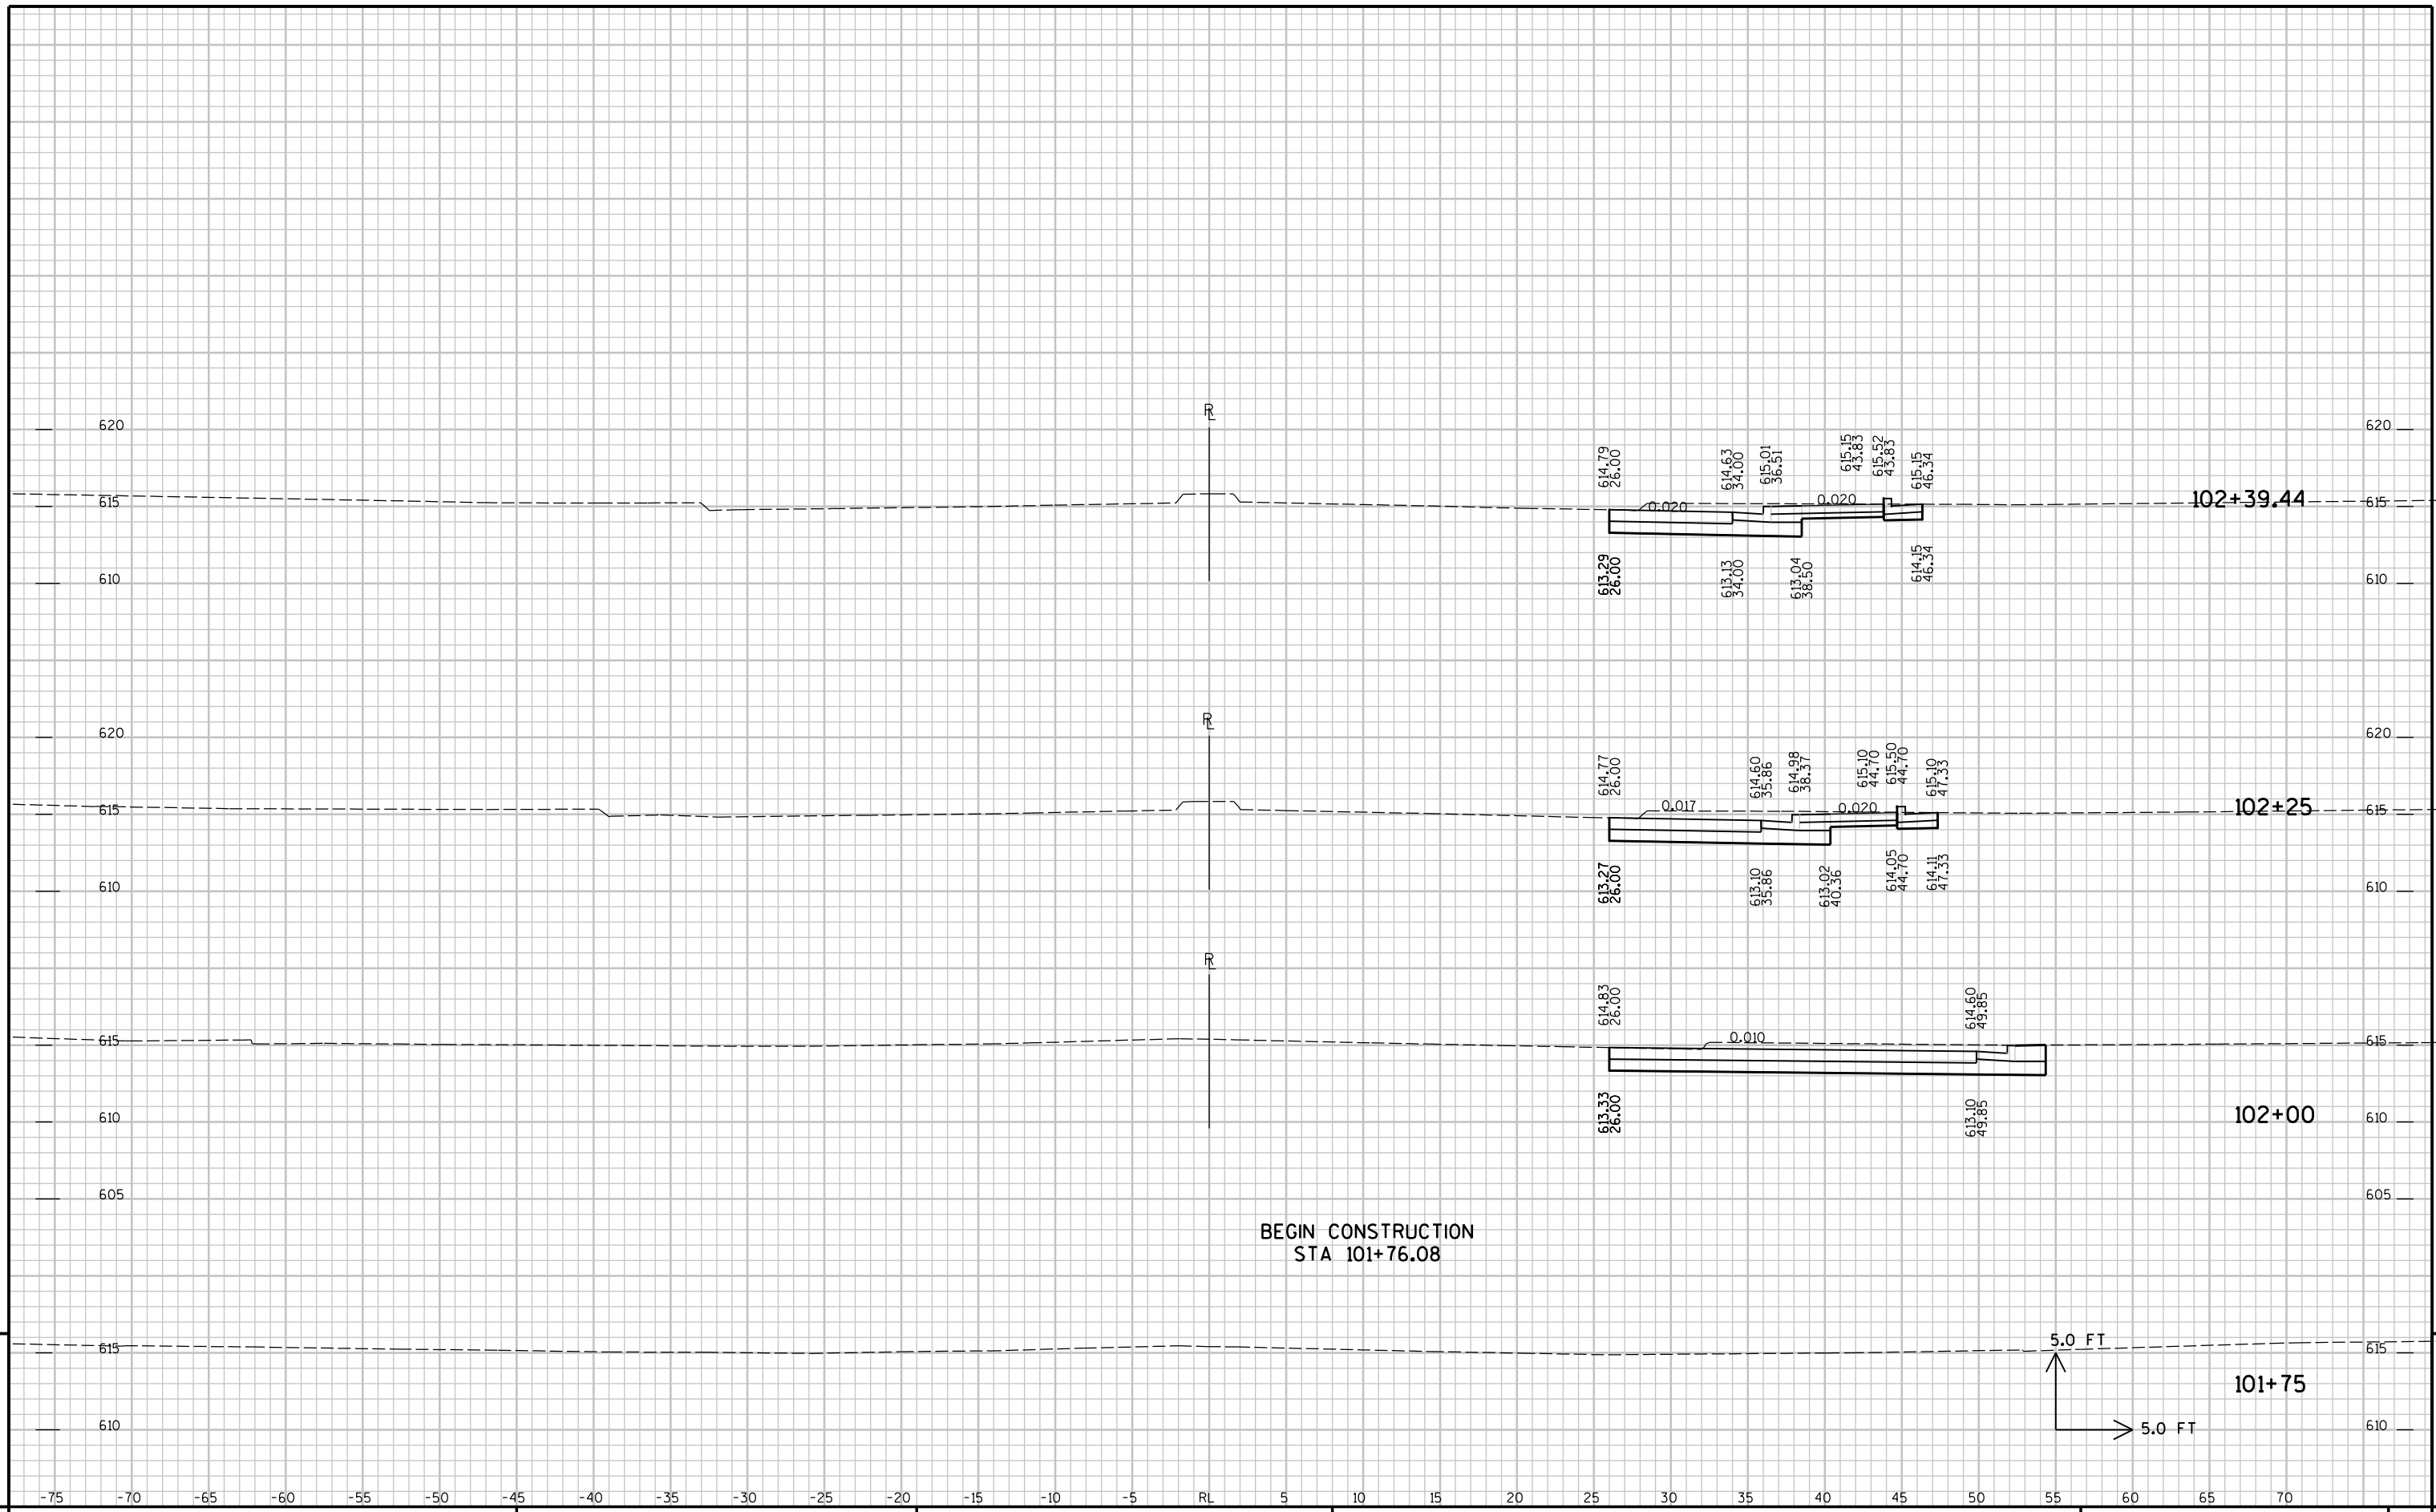

BEGIN CONSTRUCTION  
STA 101+76.08

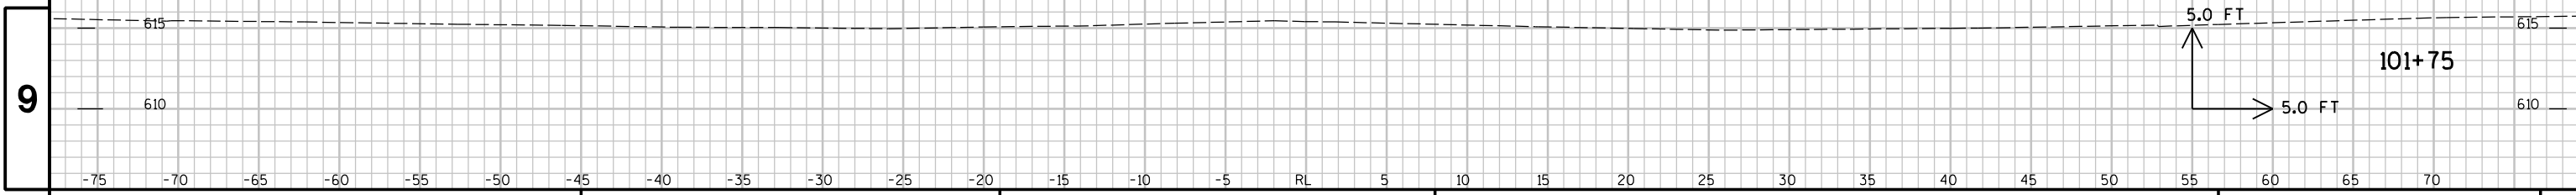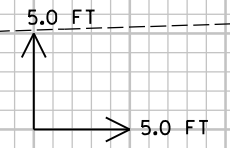


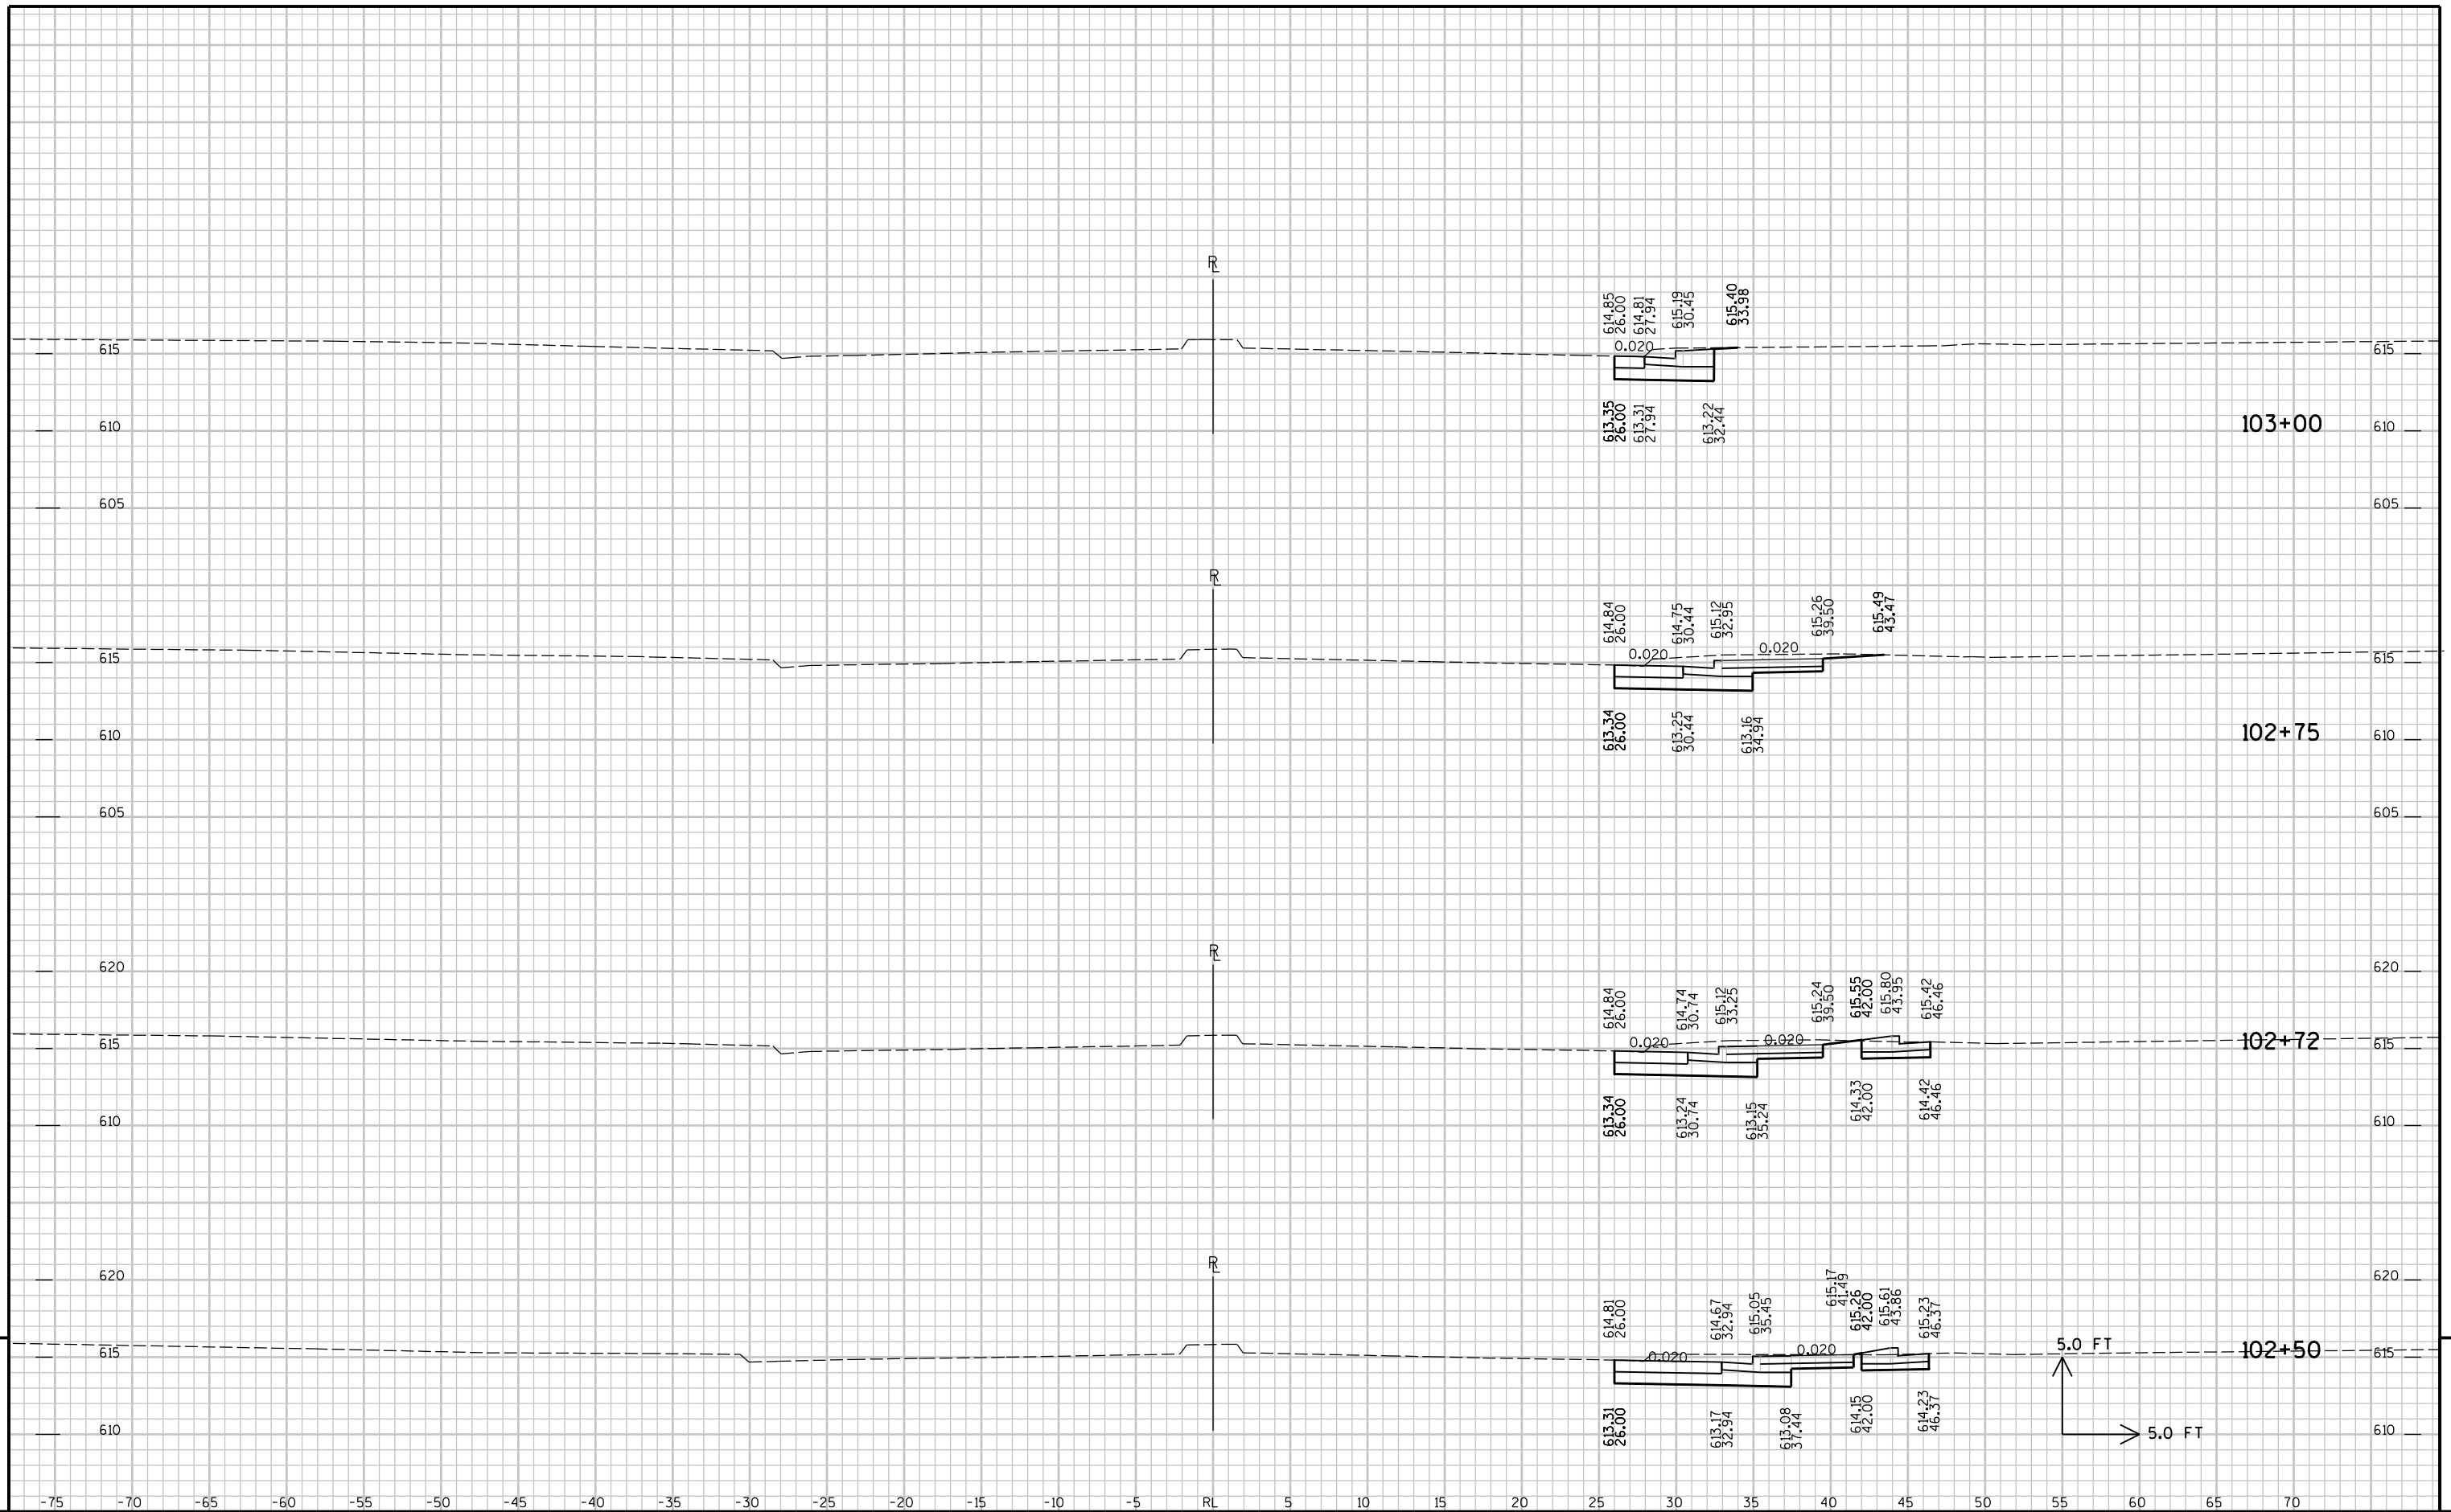

9

9



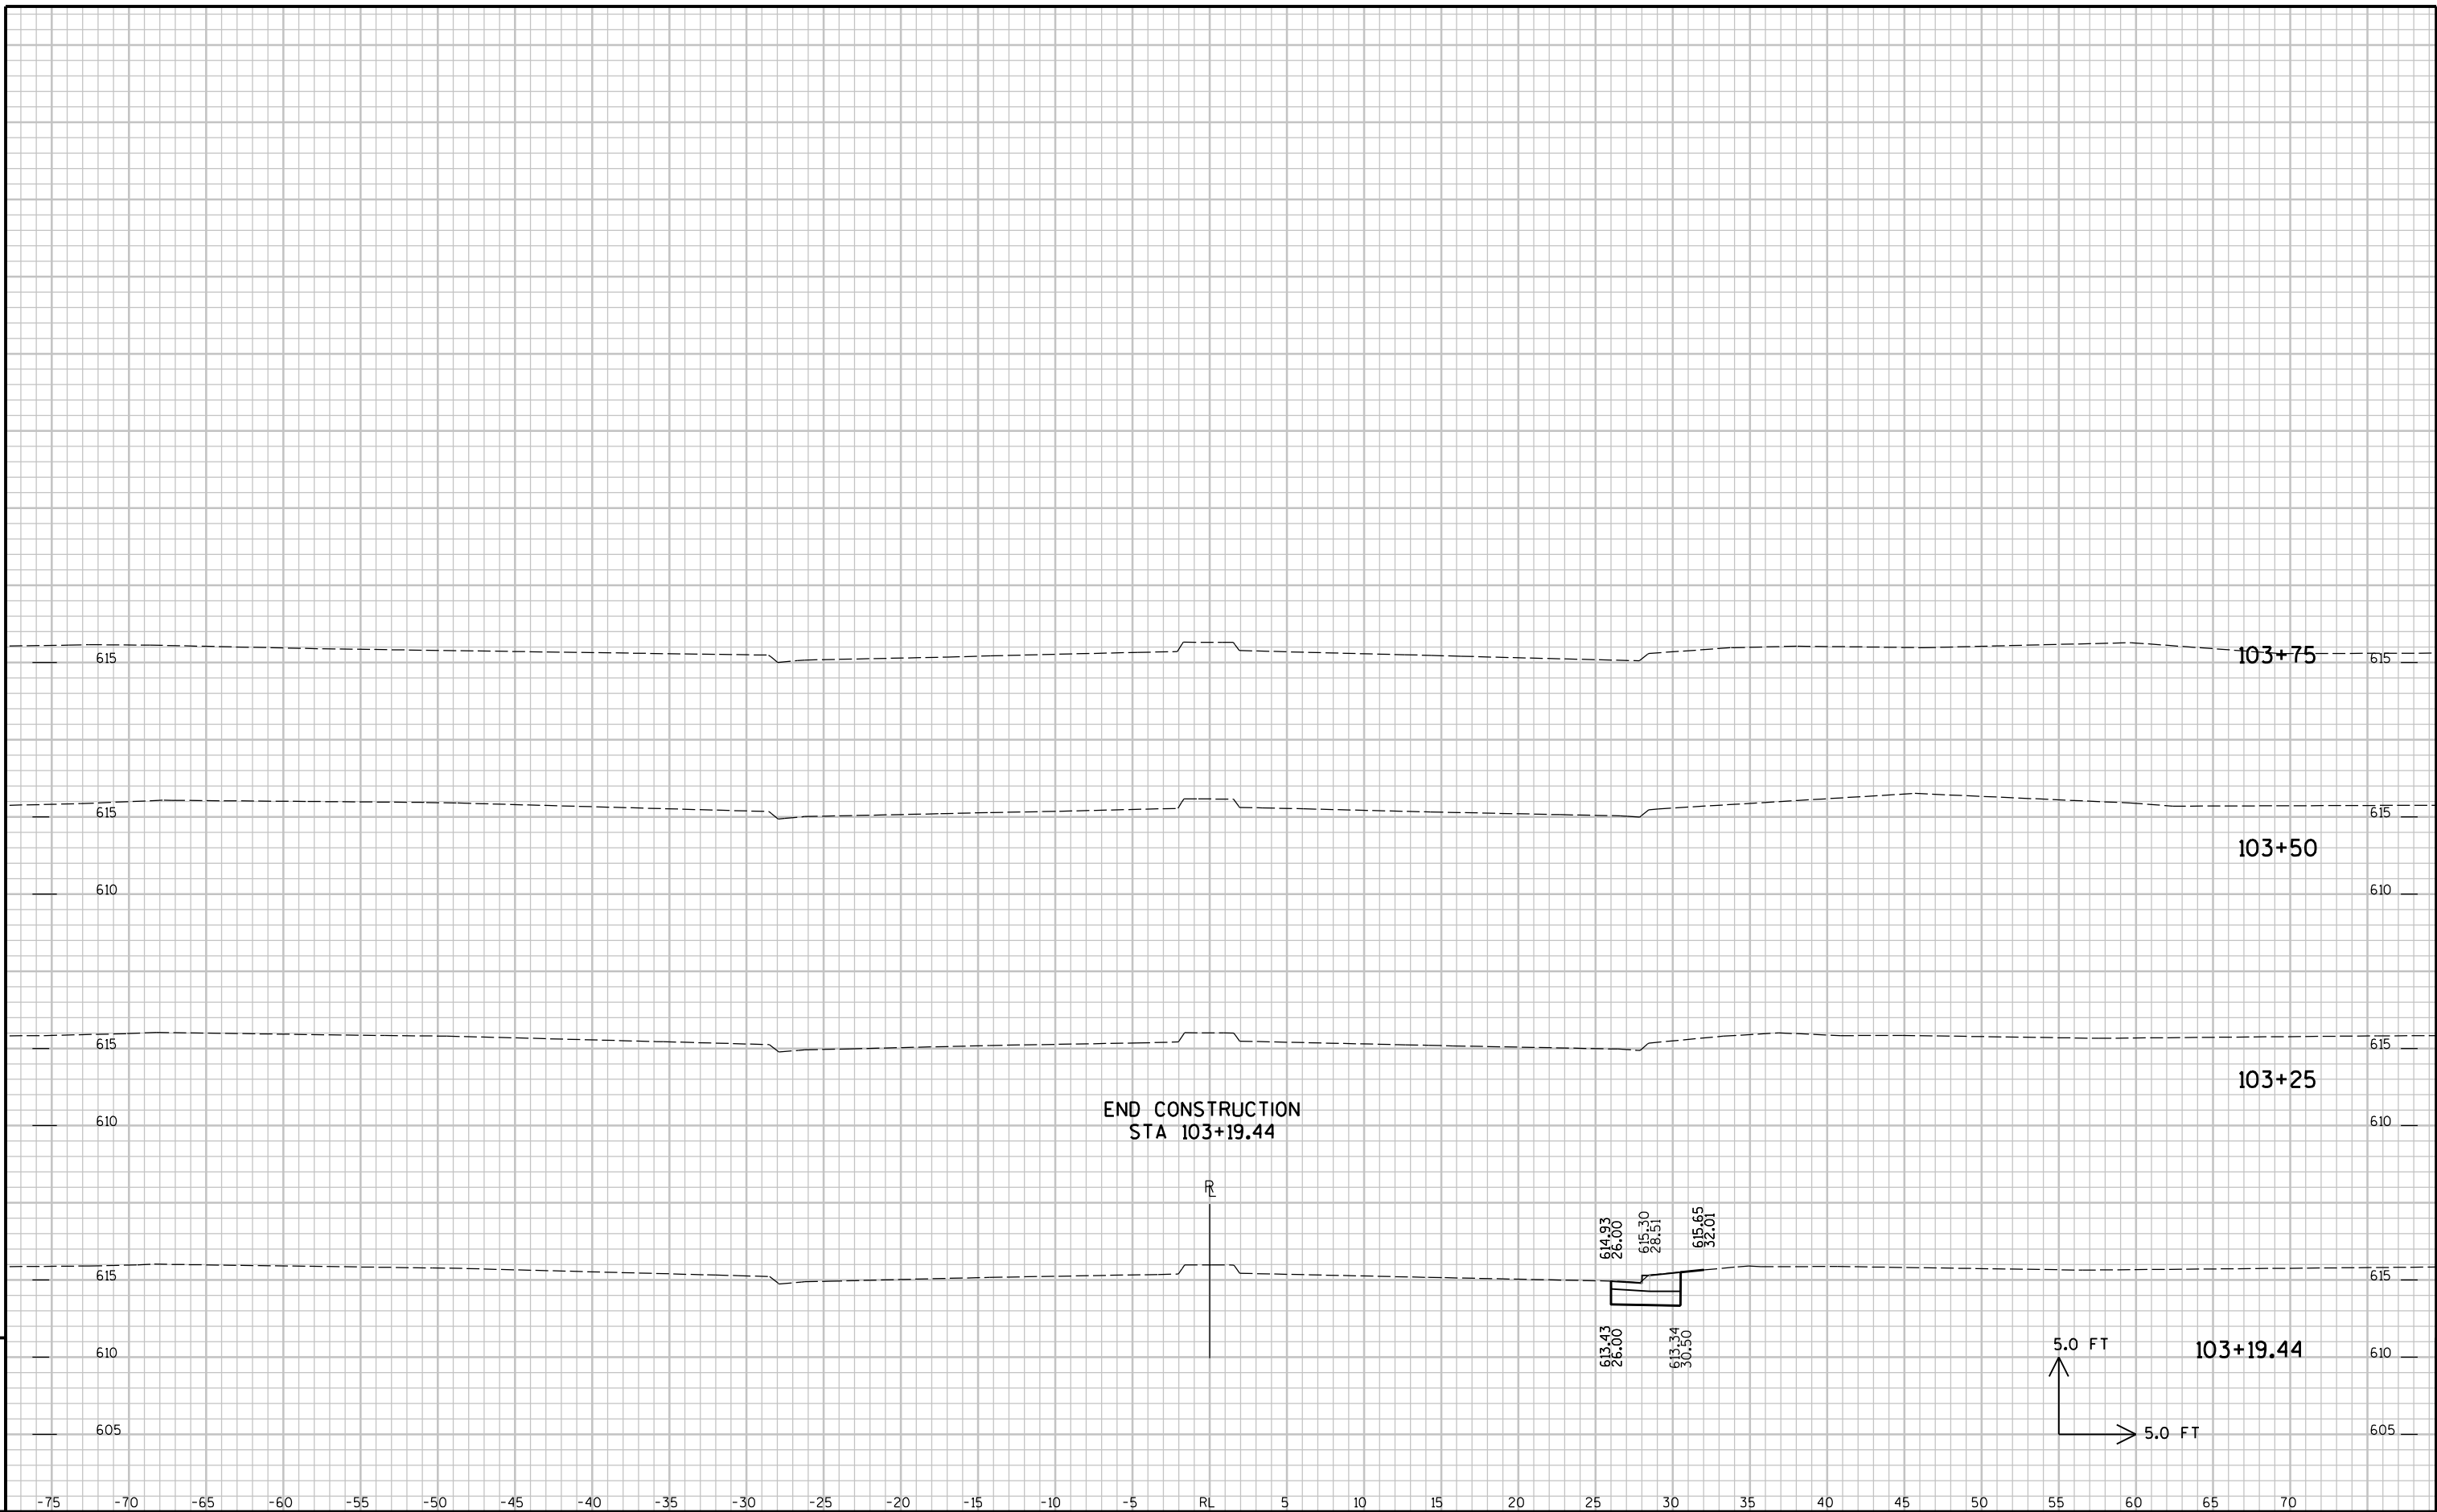


9

9

PROJECT NO : 1195-00-74	HWY : EAST SECOND STREET	COUNTY : DOUGLAS	CROSS SECTIONS - EAST SECOND STREET	SHEET NO:	E
-------------------------	--------------------------	------------------	-------------------------------------	-----------	---

FILE NAME : P:\AE\Besco\113989\CAD\XBEST00.DGN      PLOT TIME : 11:29:57 PM      PLOT DATE : 8/18/2011      PLOT BY : SEH      PLOT NAME :      PLOT SCALE : N/A

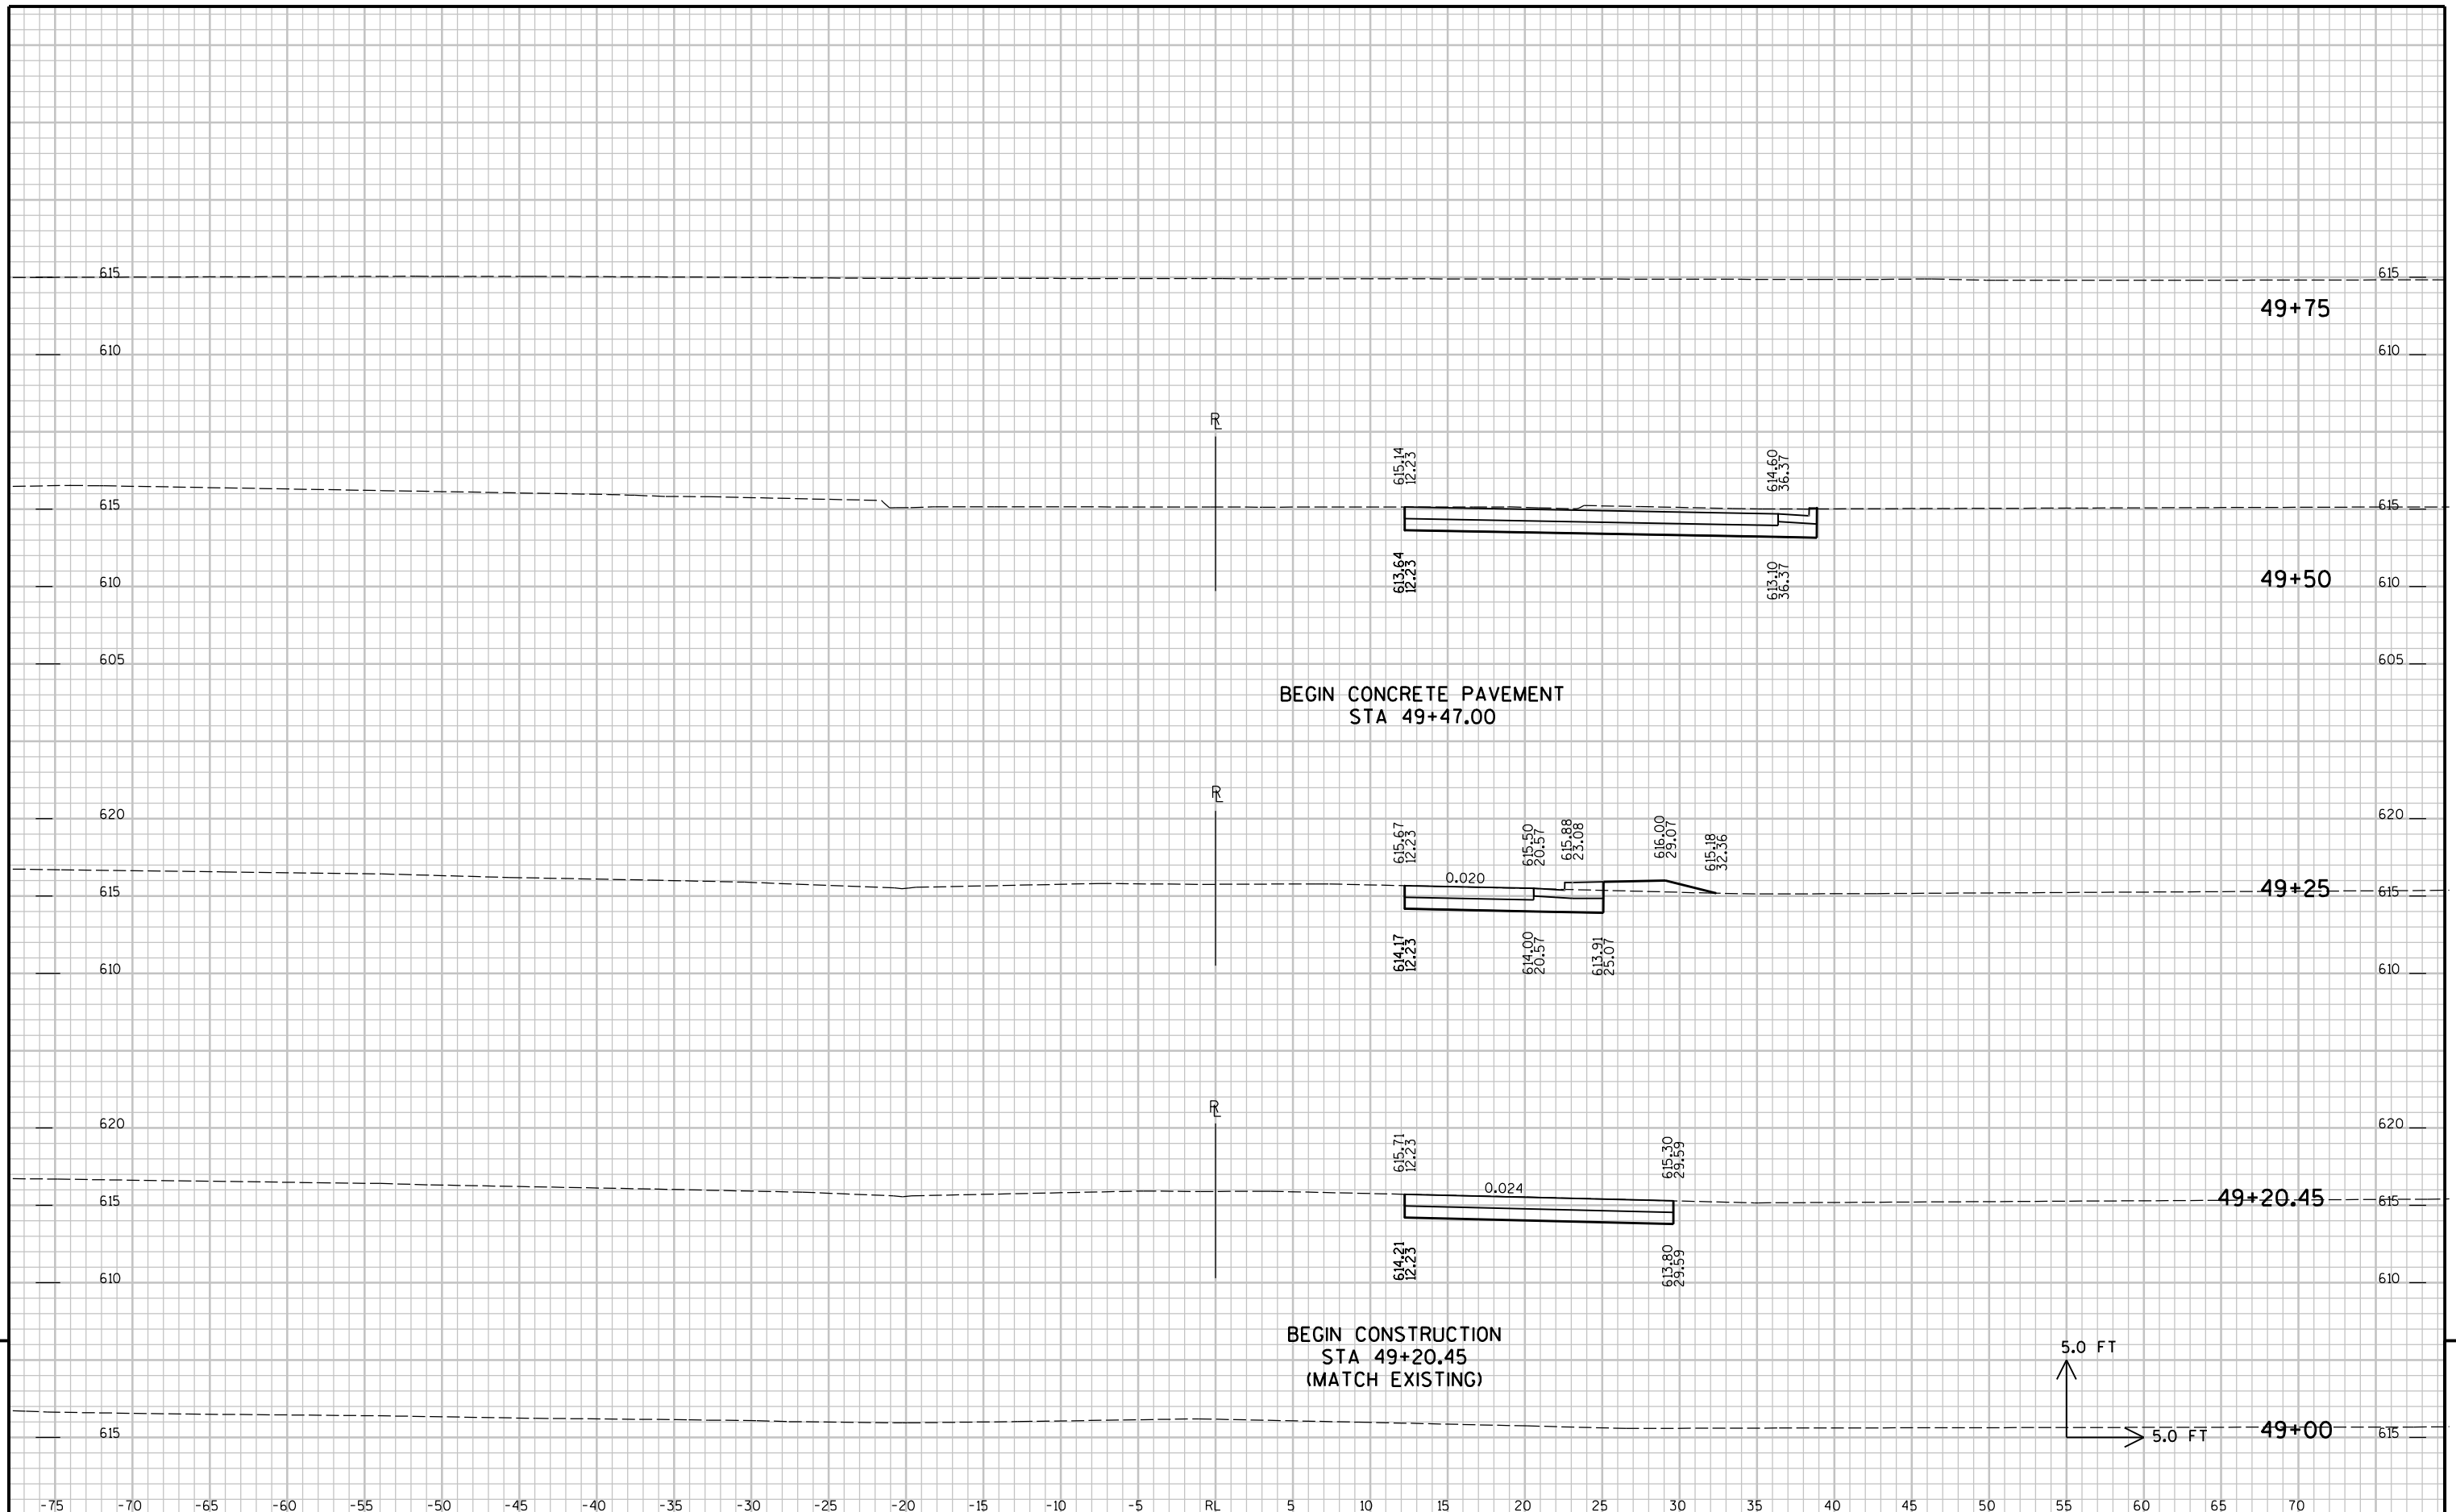

9

9