
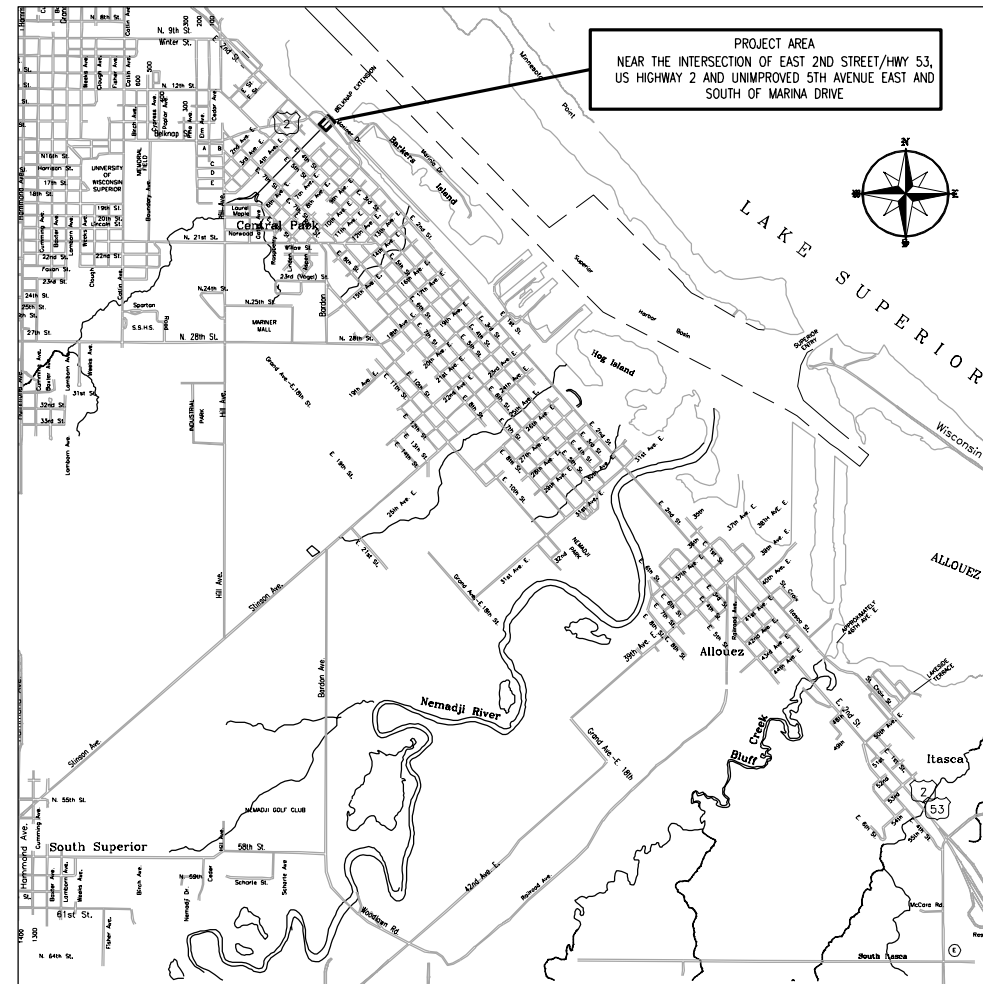


CITY OF SUPERIOR EAST 2ND STREET RELIEF SEWER CONTROL STRUCTURE

SUPERIOR, WISCONSIN JULY 2012

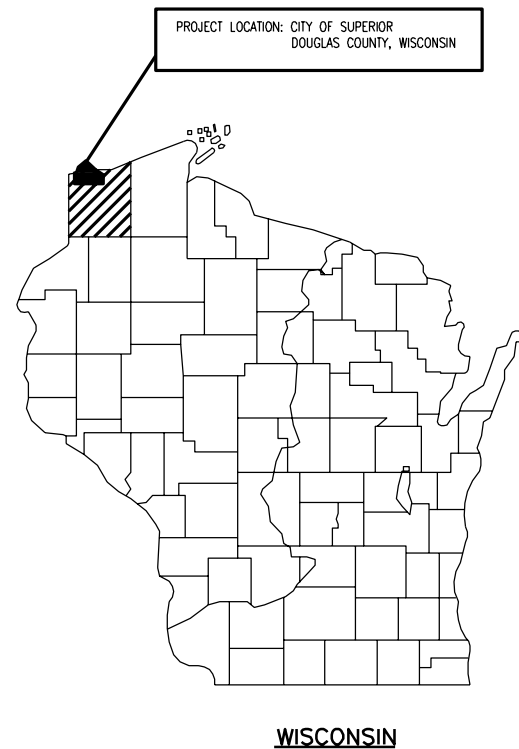

001-GENERAL	COVER SHEET
1	
002- SITE DEVELOPMENT	
2	
3	
007- ELECTRICAL DISTRIBUTION	
4	
100- VALVE AND METER VAULT	
5	
6	
7	
999- STANDARD DETAILS	
8	
9	
10	
11	


RECORD DRAWING
REVISED TO CONFORM TO
CONSTRUCTION RECORDS
PROVIDED BY CONTRACTOR
BY: MIKE JENSEN DATE: 08/28/2014

PREPARED FOR




CITY OF SUPERIOR
1316 NORTH 14TH STREET
SUPERIOR, WI 54880

PREPARED BY

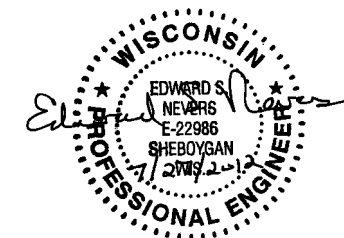

3311 WEEDEN CREEK ROAD
SHEBOYGAN, WISCONSIN 53081
920-208-0296

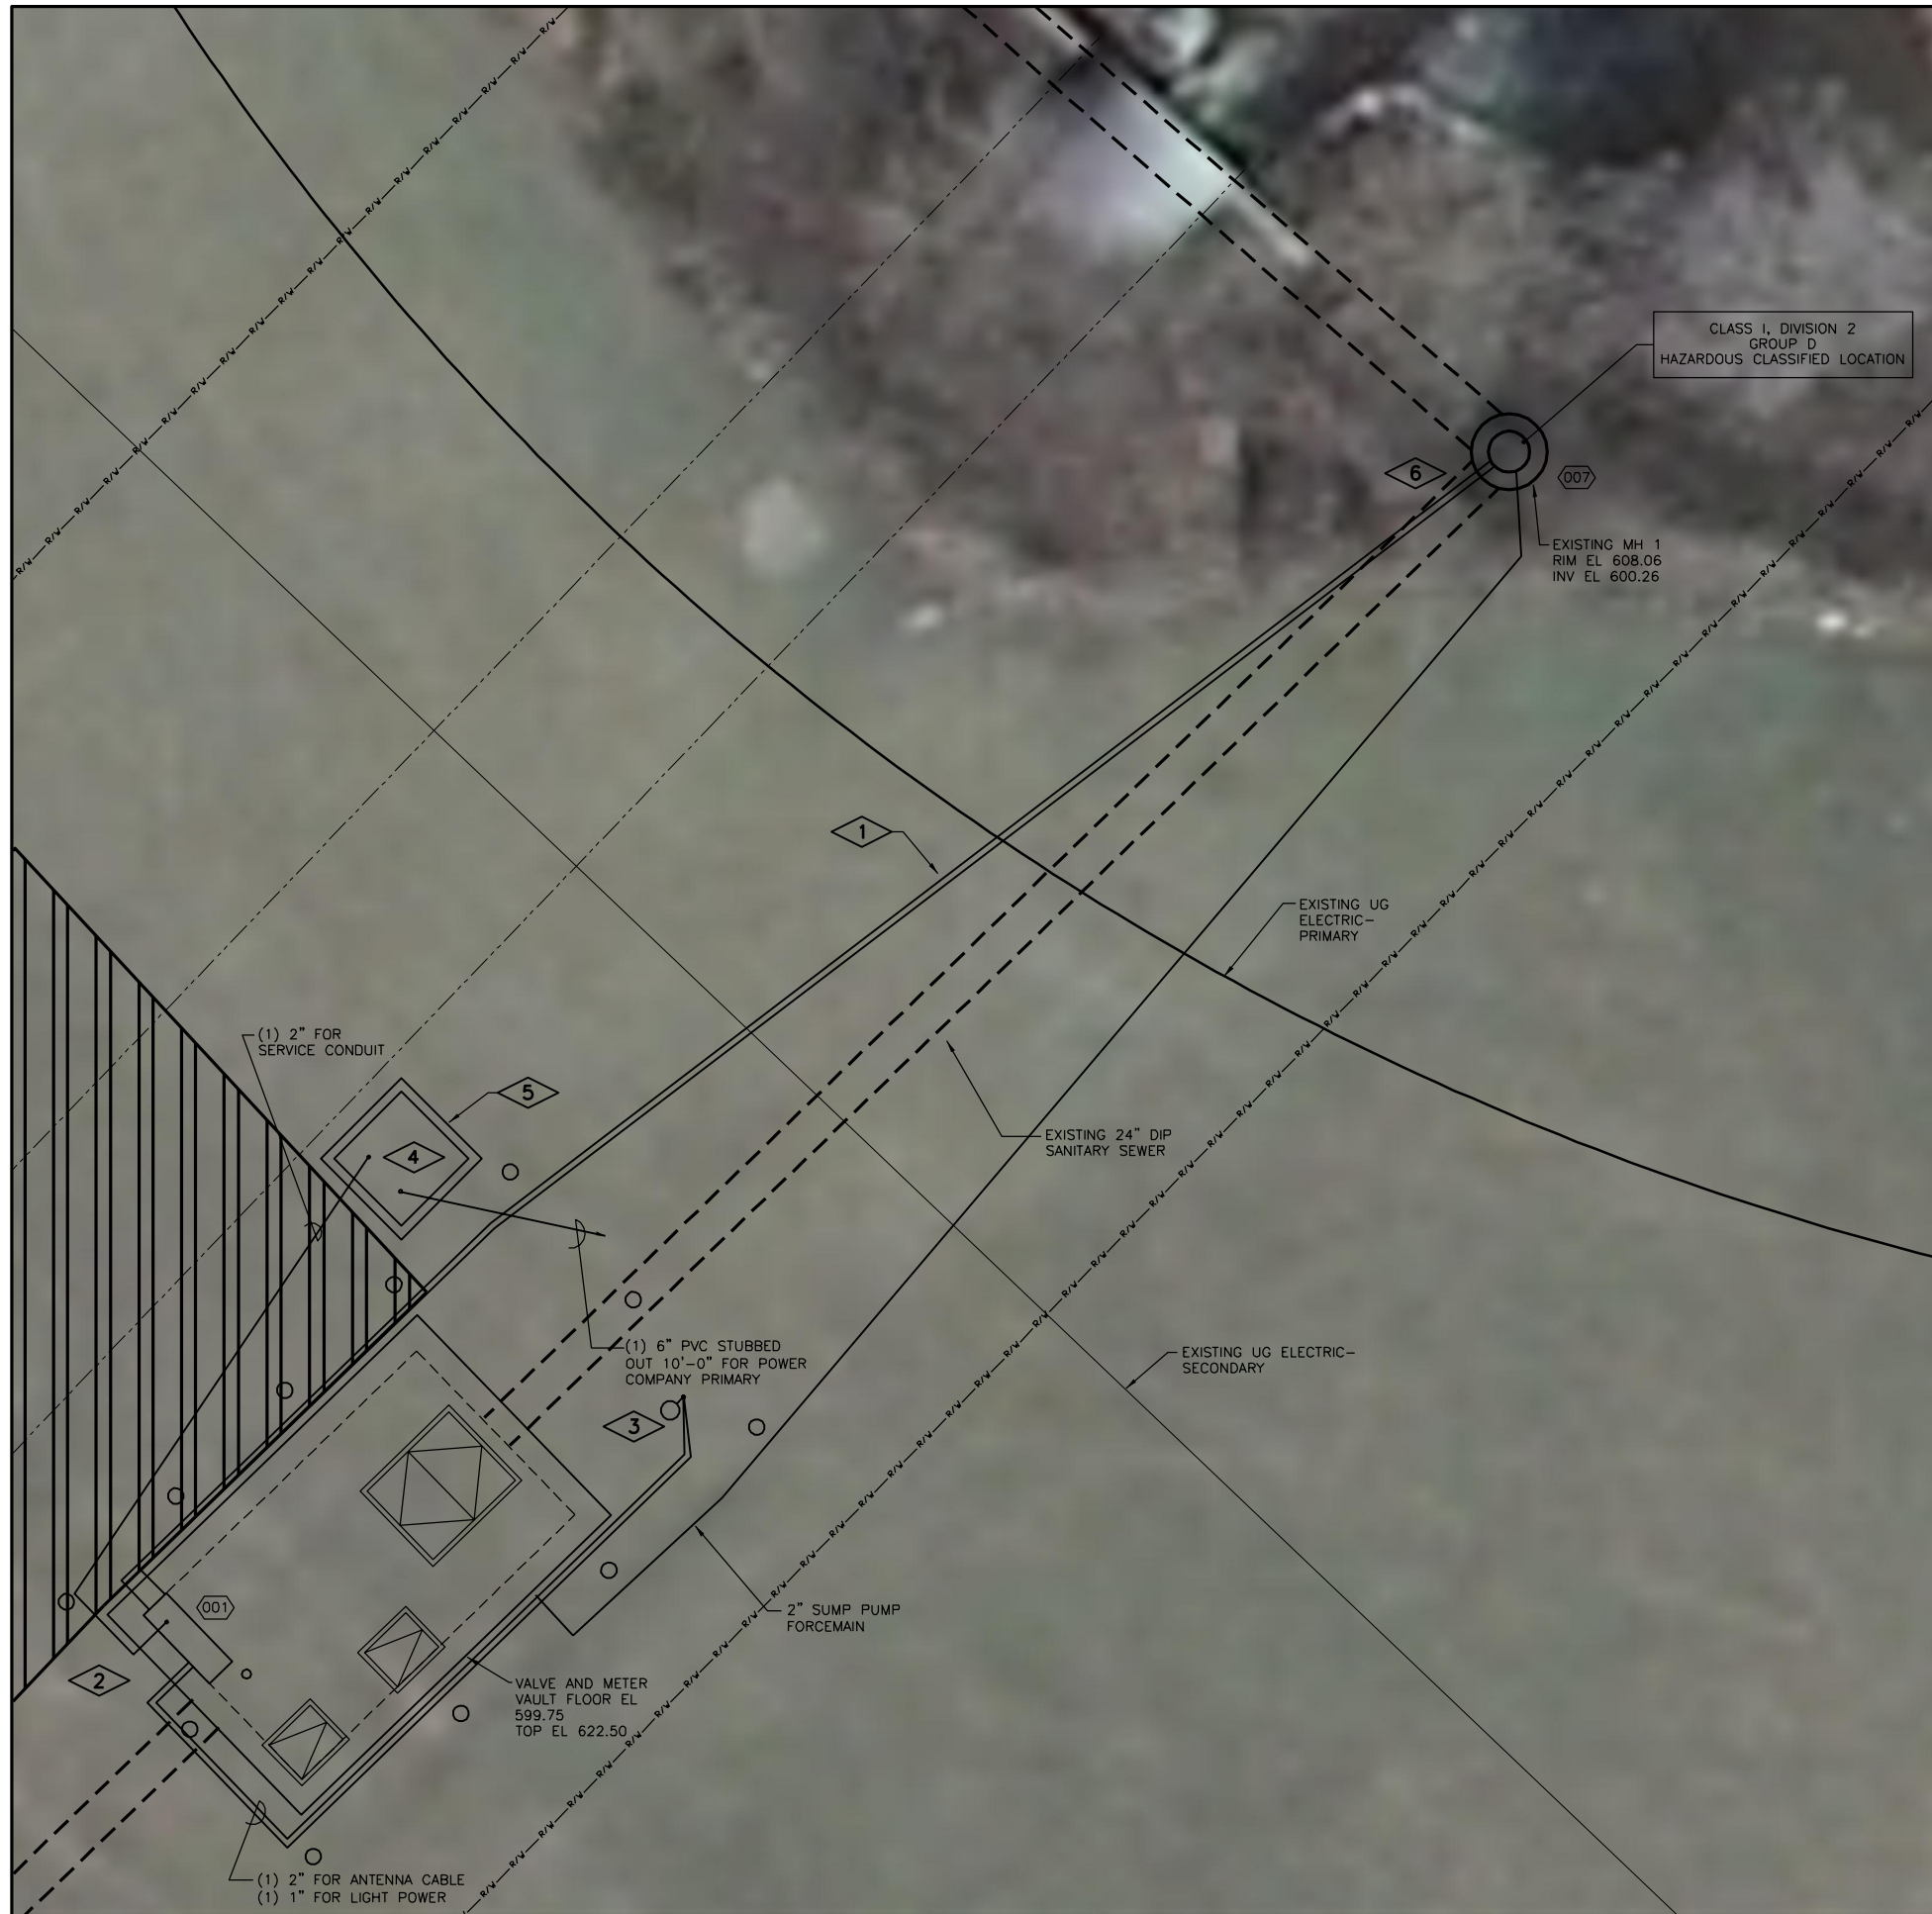


GENERAL NOTES:

1. CONTRACTOR SHALL COORDINATE WITH ELECTRIC UTILITY TO BRING IN PRIMARY FEED TO UTILITY TRANSFORMER. CONTRACTOR SHALL COORDINATE COST FOR INSTALLATION OF UTILITY TRANSFORMER AND ASSOCIATED CONDUIT AND CONDUCTORS WITH UTILITY COMPANY.
2. COORDINATE BURIED CONDUIT TO NOT INTERFERE WITH BOLLARD LOCATIONS.

PLAN NOTES:

1. CONDUIT FROM VALVE VAULT TO EXISTING MANHOLE NO. 1. SEE DRAWING 007-E-1 FOR CONDUIT DETAIL. PITCH CONDUIT TOWARD MANHOLE.
2. CONTROL PANEL.
3. LIGHT POLE. SEE DETAIL (E999) ON DRAWING 999-EN-1.
4. ELECTRIC UTILITY TRANSFORMER 240/120V, 3 ϕ , 4W SECONDARY. CONTRACTOR SHALL COORDINATE CONDUIT RUN TO UTILITY TRANSFORMER WITH UTILITY.
5. TRANSFORMER EQUIPMENT PAD SHALL BE IN ACCORDANCE WITH ELECTRIC UTILITY REQUIREMENTS.
6. LEVEL SENSOR LOCATION AT MANHOLE. SEE DETAIL (N275) FOR INSTALLATION GUIDELINES. RUN FOUR SHIELDED PAIR CABLES FROM SENSOR TO CONTROL PANEL AT VALVE VAULT. CORE DRILL MANHOLE AT TOP OF MANHOLE BELOW GRADE. CONTRACTOR SHALL INSTALL EXPLOSION PROOF SEAL OFFS ON CONDUITS GOING FROM MANHOLE TO PANEL.

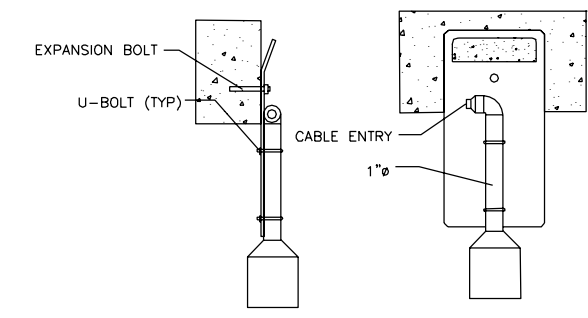

ULTRASONIC LEVEL MOUNTING DETAIL
NO SCALE
ULTRASONIC LEVEL MOUNTING DETAIL
NTS **N275**

INSTRUMENTATION & CONTROL - FIELD WIRING REQUIREMENTS

ID	TAG NAME	DETAIL	WIRING	DESTINATION	ID	COMMENTS
001	100-LCP	E061	120 VAC	100-LP	002	
007	100-LE/LT	MNFC	4 SH.PR.	100-LCP (PLC)	001	SEE DETAIL ON 100-EN-1

RECORD DRAWING
REVISED TO CONFORM TO
CONSTRUCTION RECORDS
PROVIDED BY CONTRACTOR
BY: MIKE JENSEN DATE: 08/28/2014


Date	
Checked By	
Drawn By	
Revision Description	
Revision Number	
Designed By	MRS/CRP
Drawn By	MRS/CRP
Checked By	JAB/MLM
Approved By	ESN
Filename	002CE1.DWG
Project No.	11699
Project Date	JULY 2012

CITY OF SUPERIOR, WISCONSIN
EAST 2ND STREET
RELIEF SEWER CONTROL STRUCTURE
SUPERIOR, WISCONSIN

ELECTRICAL SITE PLAN AND DETAILS

DONOHUE & ASSOCIATES

Sheet No. **3**
Drawing No. **002-EN-1**

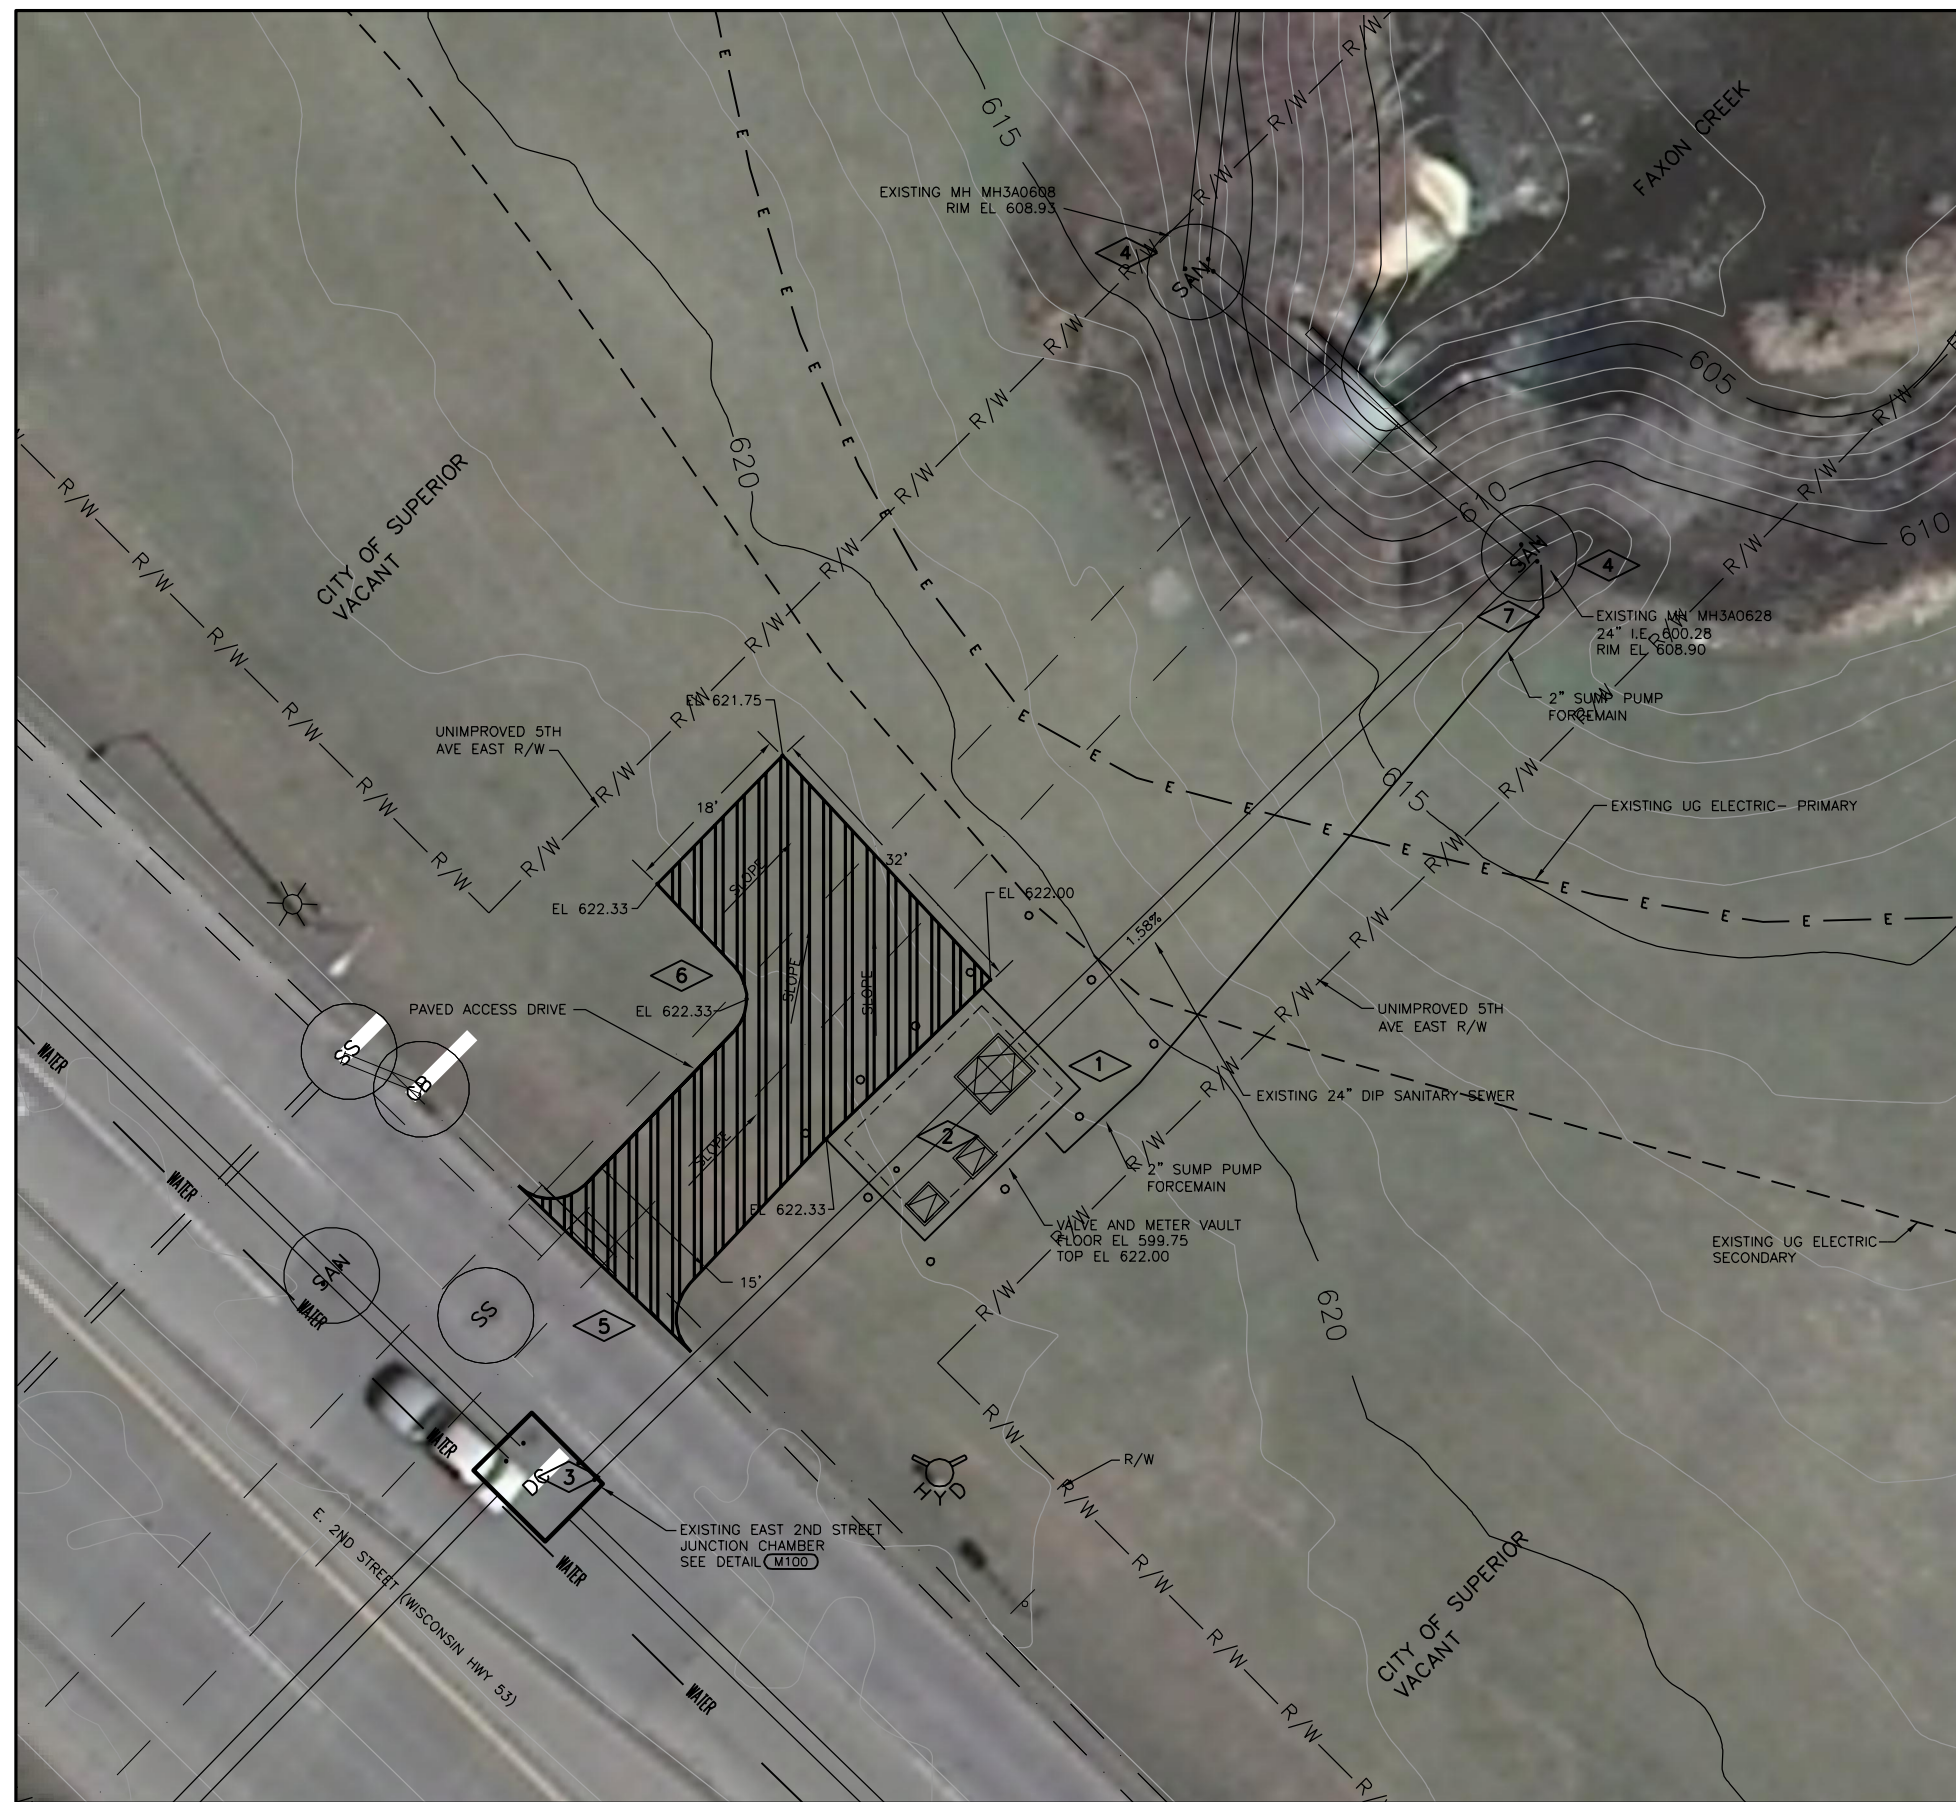


PLAN NOTES:

1. MATCH EXISTING GRADE
2. CLASS I, DIVISION 2
HAZARDOUS CLASSIFIED LOCATION
3. CLASS I, DIVISION 1
GROUP D
HAZARDOUS CLASSIFIED LOCATION
4. MANHOLE MAY BE USED FOR LOCAL BENCHMARK.
5. SAWCUT AND REMOVE 25' OF CURB AND GUTTER FOR DRIVEWAY ACCESS. INSTALL A 10' CONCRETE APRON PER DETAIL C200.
6. INSTALL ASPHALT PAVEMENT TO LIMITS SHOWN PER DETAIL C200.
7. CONNECT 2" SUMP PUMP FORCEMAIN TO EXISTING MANHOLE. CORE DRILL AT ϕ EL 603.00 AND SEAL WITH TWO STAINLESS STEEL MECHANICAL SEALS.

GENERAL NOTES:

1. DIMENSIONS TAKE PRECEDENCE OVER SCALE. CONTRACTOR TO VERIFY ALL DIMENSIONS AND COORDINATES IN THE FIELD FOR PROPER FIT AND ALIGNMENT.
2. THE CONTRACTOR SHALL CONTACT THE WISCONSIN ONE-CALL SYSTEM, AT 1-800-242-8511 A MINIMUM OF 72 HOURS PRIOR TO PERFORMING ANY EARTH MOVING OR EXCAVATION ACTIVITIES. THE CONTRACTOR SHALL ALSO CONTACT ANY OTHER UTILITIES WHICH MAY BE PRESENT WHICH ARE NOT PART OF THE ONE CALL SYSTEM. NOTIFY PLANT STAFF ONE WEEK IN ADVANCE OF PLANT UTILITY LOCATION NEEDS TO ALLOW ADEQUATE RESPONSE TIME FOR PLANT STAFF.
3. EXISTING BURIED UTILITIES SHOWN ON THE DRAWINGS ARE INDICATED IN ACCORDANCE WITH THE AVAILABLE RECORDS AND FIELD INFORMATION AVAILABLE TO THE ENGINEER. OTHER UTILITIES MAY ALSO BE PRESENT. THE CONTRACTOR SHALL BE RESPONSIBLE FOR OBTAINING FROM THE OWNERS OF THE EXISTING UTILITIES THE LOCATION OF THEIR BURIED FACILITIES. ANY UTILITIES DAMAGED OR DESTROYED BY THE CONTRACTOR'S OPERATIONS WHETHER SHOWN ON THE DRAWINGS OR NOT, SHALL BE REPLACED OR REPAIRED TO THE UTILITY'S SATISFACTION AT NO COST TO THE OWNER.
4. IF UTILITY FACILITIES OTHER THAN THOSE SHOWN ARE LOCATED, OR IF UTILITIES ARE LOCATED WHICH ARE NOT IN ACCORDANCE WITH THE LOCATION SHOWN ON THE DRAWINGS, THE ENGINEER SHALL BE NOTIFIED TO DETERMINE IF PLAN REVISIONS ARE NEEDED. CONTRACTOR IS REQUIRED TO FIELD LOCATE ALL CROSSING UTILITIES SUFFICIENTLY IN ADVANCE OF CONSTRUCTION ACTIVITIES TO ALLOW ENGINEER TO REVISE LOCATIONS OF NEW FACILITIES TO AVOID CONFLICTS WITHOUT ADDITIONAL COST TO OWNER.
5. ACCESS CONSTRAINTS TO BE PLACED ON THE CONTRACTOR FOR THE PROJECT ARE SPECIFIED IN SECTION 01110 OF THE SPECIFICATIONS.
6. CONTRACTOR SHALL MAINTAIN ACCESS TO ALL SITE FACILITIES DURING CONSTRUCTION. CONTRACTOR SHALL PLAN HIS WORK SEQUENCE AND ACTIVITIES TO ENSURE THAT HIS WORK DOES NOT INTERFERE WITH PUBLIC NEEDS OR PUBLIC FACILITIES OPERATIONS, DELIVERIES, PICKUPS OR OTHER ACCESS NEEDS.
7. THE CONTRACTOR SHALL COORDINATE THE ACTIVITIES OF HIS PERSONNEL, SUBCONTRACTORS, AND UTILITIES PERFORMING WORK ON THIS PROJECT. THE CONTRACTOR SHALL ALSO COORDINATE WITH ANY OTHER CONTRACTORS WORKING IN OR NEAR THE PROJECT AREA.
8. ELEVATIONS CALLED OUT ON THE CIVIL DRAWINGS ARE TYPICALLY AT THE "INVERT" OR BOTTOM OF PIPES AND STRUCTURES, ALONG THE FLOW LINE IN GUTTERS AND SWALES, AND AT THE "RIM" OR TOP (FINISHED GRADE) OF THE FRAME AND COVERS. OTHER ELEVATIONS ARE SPECIFICALLY NOTED.
9. UNLESS NOTED OTHERWISE RESTORATION OF EXISTING SANITARY SEWERS AND SERVICE LINES, WATER MAINS AND SERVICE LINES, STORM SEWERS, OTHER UTILITIES, SIDEWALKS, CURBS, DRIVEWAYS, STREETS OR OTHER IMPROVEMENTS NOT SHOWN AS BEING REMOVED, REPLACED OR MODIFIED BY THE PROJECT IS REQUIRED ONLY TO THE EXTENT THEY ARE DAMAGED OR DISTURBED BY CONSTRUCTION ACTIVITIES. THE CONTRACTOR SHALL RESTORE ALL DAMAGED AND DISTURBED IMPROVEMENTS TO THE IMPROVEMENT OWNERS AND ENGINEERS SATISFACTION.
10. WHERE NEW WORK ABUTS EXISTING CURBS, SIDEWALK, DRIVES, OR OTHER PAVEMENTS WHICH ARE TO REMAIN IN PLACE, THE CONTRACTOR SHALL PROVIDE NEAT SAWCUTS, FULL DEPTH AT THE LIMIT OF CONSTRUCTION.
11. CONTRACTOR SHALL PROVIDE SUPPORT AND SHALL MAINTAIN SERVICE TO ALL ABOVE AND BELOW GRADE UTILITIES INCLUDING POLES, CABLES, WIRES, WATER, GAS, STORM, AND SANITARY FACILITIES, OR WITH THE WRITTEN CONCURRENCE OF THE UTILITY OWNER, MAY REMOVE, STORE, REINSTALL AND REPLACE AS NECESSARY.
12. THE CONTRACTOR SHALL MAKE PROVISIONS TO MAINTAIN FLOWS IN ALL SANITARY, STORM, COMBINED SEWERS AND OVERFLOWS AT ALL TIMES. BYPASS PUMPING MAY BE REQUIRED AND SHALL BE SUFFICIENT TO CONVEY THE FLOWS UNDER ALL CONDITIONS INCLUDING WET WEATHER OR ALTERNATE PROVISIONS ARE MADE FOR FLOW CONTROL.
13. CONTRACTOR IS RESPONSIBLE FOR SITE SAFETY DURING CONSTRUCTION OF THE PROJECT.
14. THE CONTRACTOR SHALL PROTECT ALL PROPERTY PINS (STEEL REBARS, PIPES, CAPPED PINS, ETC.) WHETHER SHOWN ON THE PLANS OR ENCOUNTERED DURING CONSTRUCTION FROM BEING DAMAGED, DESTROYED OR MOVED. IF PROPERTY PINS ARE DAMAGED, DESTROYED OR MOVED, THE CONTRACTOR SHALL PROVIDE THE SERVICES OF A REGISTERED WISCONSIN LAND SURVEYOR TO REPLACE THEM AT NO COST TO THE OWNER.
15. CONTRACTOR SHALL ACCESS THE SITE FROM WISCONSIN STATE HIGHWAY 53. CONTRACTOR SHALL PROVIDE AND MAINTAIN TRACKING PADS AT THE ACCESS SITE.
16. CONTRACTOR SHALL PROTECT EXISTING UTILITIES, STORM SEWERS, WATERWAYS AND WETLANDS.
17. SEE K-STREET STORM SEWER RECONSTRUCTION DRAWINGS FOR OTHER UTILITIES IN THE WORKING AREA, STAGING AREA AND SITE RESTORATION.

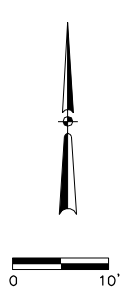

Date	Checked By	Drawn By	Revision Description	Revision Number

Designed By	EJM
Drawn By	EJM
Checked By	ESN
Approved By	ESN
Filename	002CFP1.DWG
Project No.	11699
Project Date	JULY 2012

CITY OF SUPERIOR, WISCONSIN
EAST 2ND STREET
RELIEF SEWER CONTROL STRUCTURE
SUPERIOR, WISCONSIN

FACILITIES AND PIPING PLAN

RECORD DRAWING

REVISED TO CONFORM TO
CONSTRUCTION RECORDS
PROVIDED BY CONTRACTOR

BY: MIKE JENSEN DATE: 08/28/2014



Sheet No. 2
Drawing No.

002-CFP-1


Date	
Checked By	
Drawn By	
Revision Description	
Revision Number	

Designed By	MRS
Drawn By	MRS
Checked By	JAB
Approved By	ESN
Filename	007E1.DWG
Project No.	11699
Project Date	JULY 2012


CITY OF SUPERIOR, WISCONSIN
EAST 2ND STREET
RELIEF SEWER CONTROL STRUCTURE
SUPERIOR, WISCONSIN

**ELECTRICAL
ONE-LINE, PANEL & CONDUIT SCHEDULE, SECTION, & DETAIL**


RECORD DRAWING	
REVISED TO CONFORM TO CONSTRUCTION RECORDS PROVIDED BY CONTRACTOR	
Sheet No.	4
Drawing No.	007-E-1
BY: MIKE JENSEN	DATE: 08/28/2014

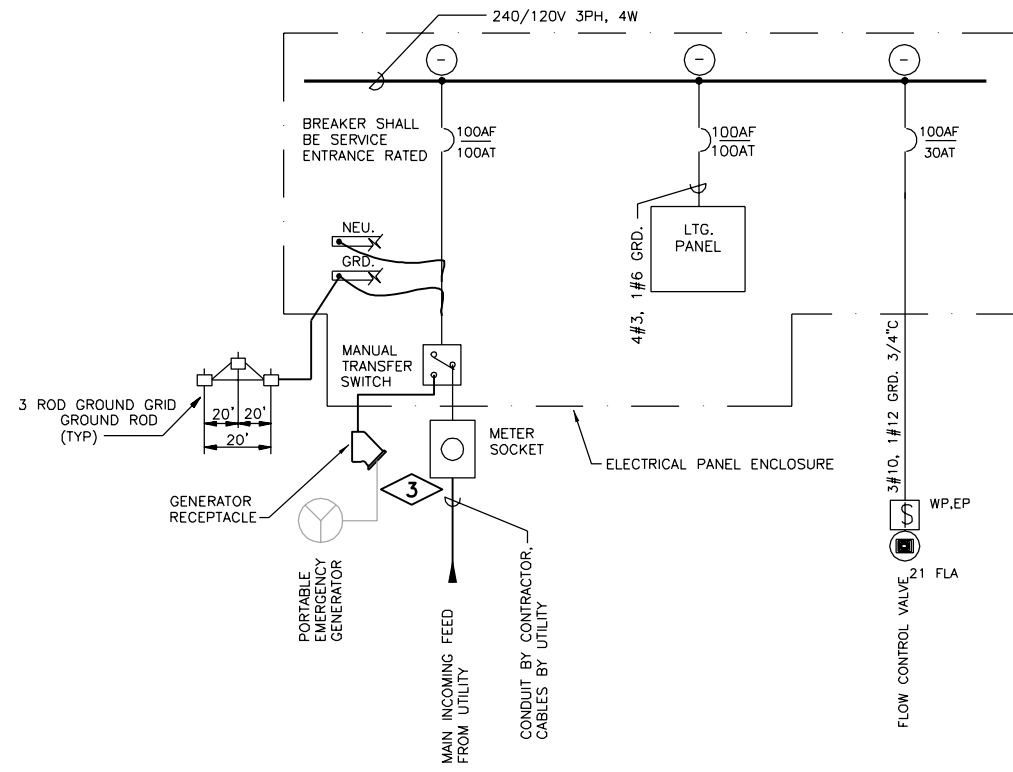

DUCTBANK SCHEDULE					
NUMBER	SIZE	FROM	TO	CONTENTS	REMARKS
1	2"	VALVE VAULT PANEL	EXIST. MH NO. 1	CONTROL	LEVEL ELEMENT, 4 SHIELDED PAIR
2	2"	VALVE VAULT PANEL	EXIST. MH NO. 1	SPARE	-

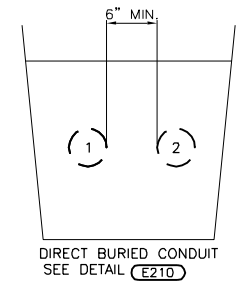

CONDUIT SECTION **A**
NTS 002-EN-1

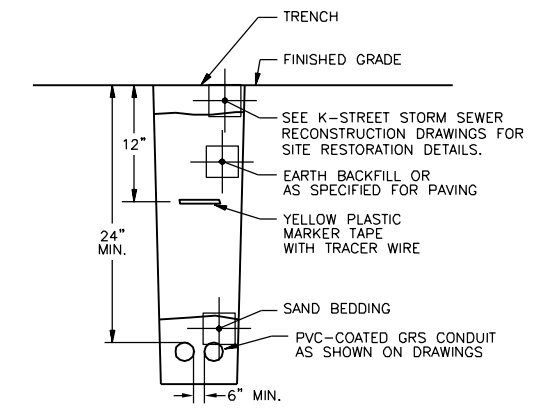






UNDERGROUND CONDUIT DETAIL **E210**
NTS

PLAN NOTES:

1. OUTLET SHALL BE MOUNTED INSIDE OF PANEL. CIRCUITS 2 AND 4 MUST HAVE MEANS TO SIMULTANEOUSLY DISCONNECT PER NEC 210.7-B. THESE CIRCUITS ARE ON THE SAME YOKE. VERIFY WITH NEC CODE
2. INTRINSICALLY SAFE OUTLET SHALL BE MOUNTED INSIDE VAULT FOR SUMP PUMP. VERIFY BREAKER SIZE WITH PUMP MANUFACTURER RECOMMENDATIONS. VERIFY RECEPTACLE CONFIGURATION WITH SUMP PUMP MANUFACTURER.
3. PROVIDE GENERATOR RECEPTACLE IN ELECTRICAL ENCLOSURE. PRIOR TO ENCLOSURE CONSTRUCTION, COORDINATE THE TYPE OF GENERATOR RECEPTACLE COMPATIBLE WITH THE OWNER'S GENERATOR EQUIPMENT. CONTRACTOR SHALL WIRE RECEPTACLE TO MANUAL TRANSFER SWITCH INSIDE ELECTRICAL PANEL. SEE E061 ON PAGE 999-EN-1 FOR RECEPTACLE AND MANUAL TRANSFER SWITCH LOCATIONS.

LIGHTING PANEL 100LP-1 SCHEDULE								
120 / 240 V, 3 PHASE, 4 WIRE				100A MAIN BREAKER				
RATING 22,000 A.I.C.				100A MAIN BUS				
				100A GRD. BUS				
CKT. NO.	TRIP/P	DESCRIPTION	PHASE			DESCRIPTION	TRIP/P	CKT. NO.
			A	B	C			
1			•			GFCI OUTLET NON-INTRINSICALLY SAFE	20/1	2
3	100/3	MAIN BREAKER		•		GFCI OUTLET NON-INTRINSICALLY SAFE	20/1	4
5					•	PLC CONTROL POWER	20/1	6
7	20/1	MAIN PANEL HEATER	•			VALVE VAULT LIGHT FIXTURE	20/1	8
9	20/1	100-LCP CONTROLS CABINET		•		GFCI OUTLET - SUMP PUMP	20/1	10
11	20/1	SITE LIGHTING			•	SPARE	20/1	12
13	30/1	SPARE	•			SPARE	20/1	14
15		SPACE		•		SPACE		16
17		SPACE			•	SPACE		18
TOTALS:			-	-	-			

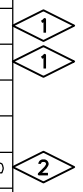

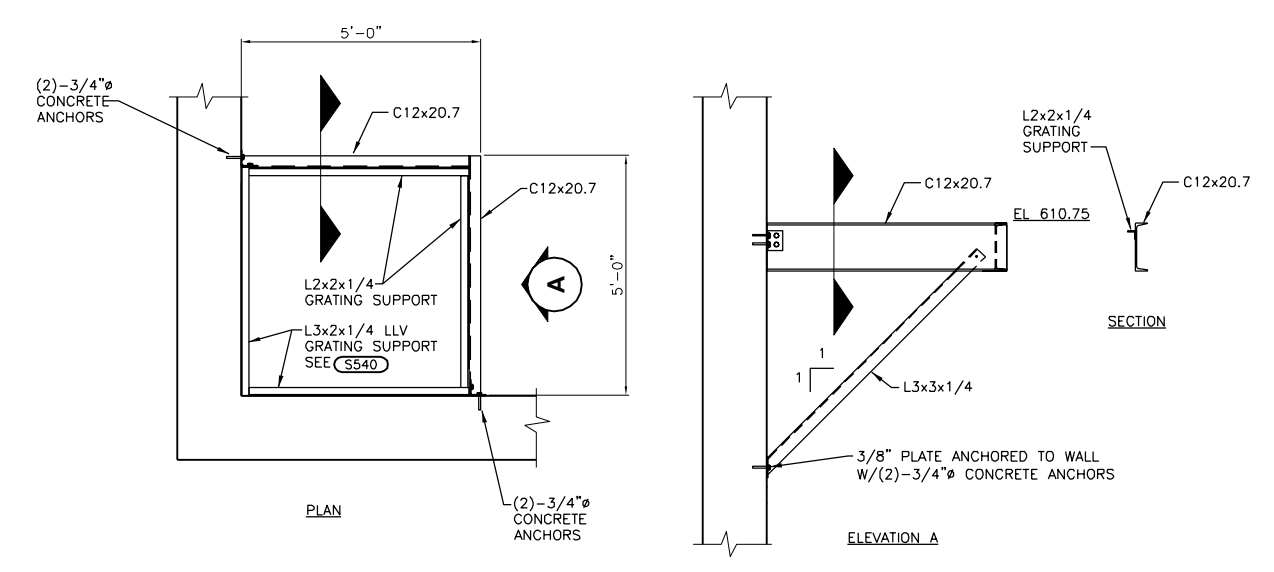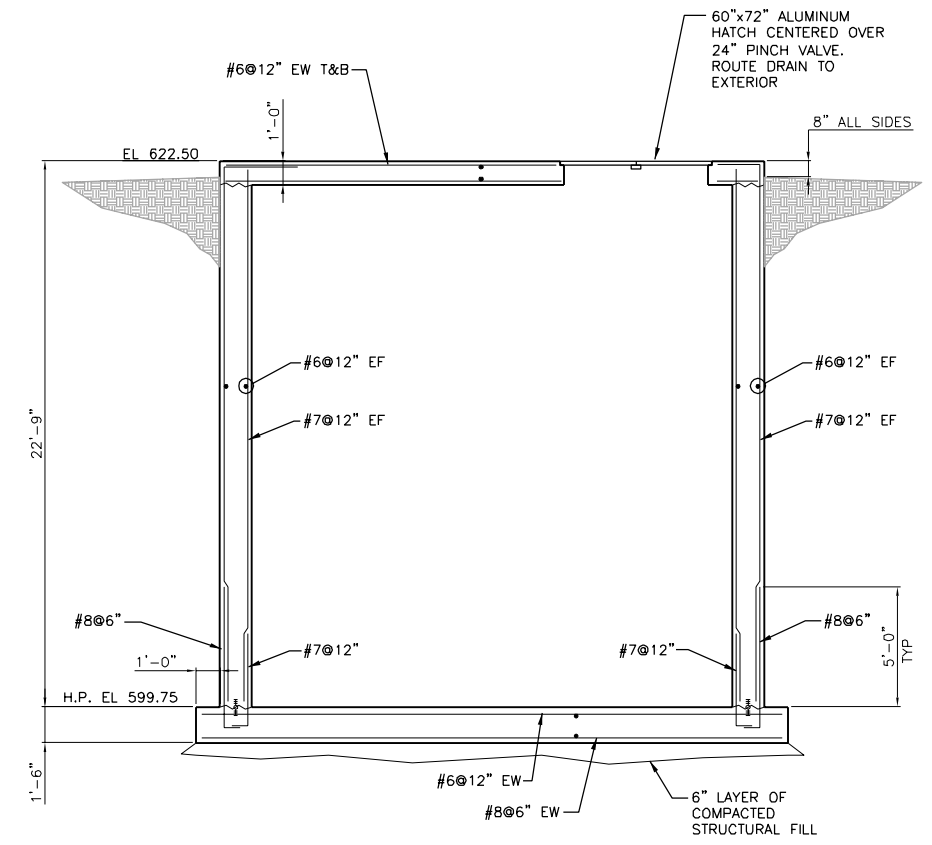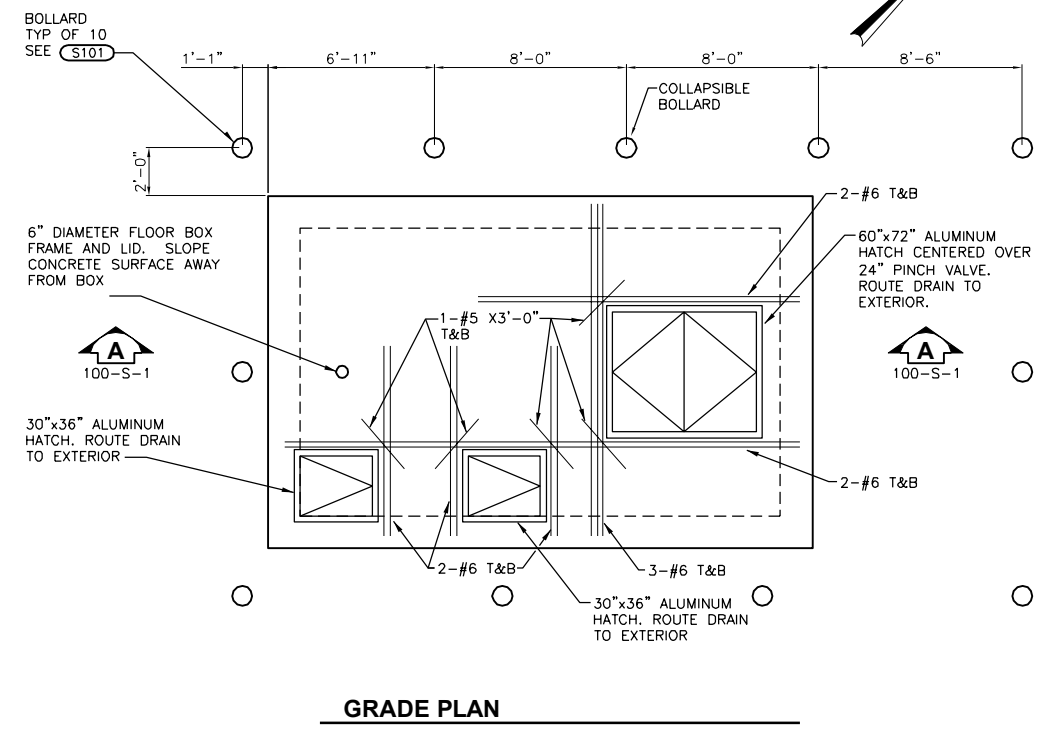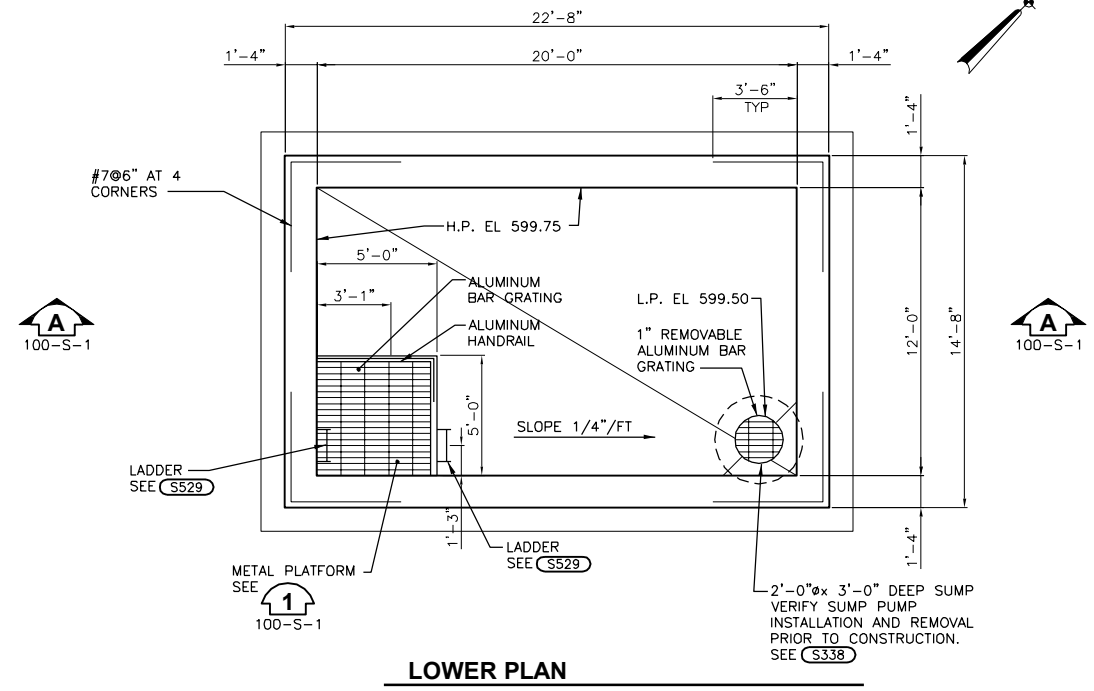

NOTE: HOT-DIP GALVANIZE ALL STRUCTURAL STEEL

0 1' 4'

Revision Number	Description	Date

Designed By	AJT
Drawn By	AJT
Checked By	PJE
Approved By	ESN
Filename	100SP1.DWG
Project No.	11699
Project Date	JULY 2012

CITY OF SUPERIOR, WISCONSIN
 EAST 2ND STREET
 RELIEF SEWER CONTROL STRUCTURE
 SUPERIOR, WISCONSIN


PLANS AND SECTION

RECORD DRAWING
 REVISED TO CONFORM TO
 CONSTRUCTION RECORDS
 PROVIDED BY CONTRACTOR



BY: MIKE JENSEN DATE: 08/28/2014

DONOHUE
 & ASSOCIATES

Sheet No. 5
 Drawing No. 100-S-1

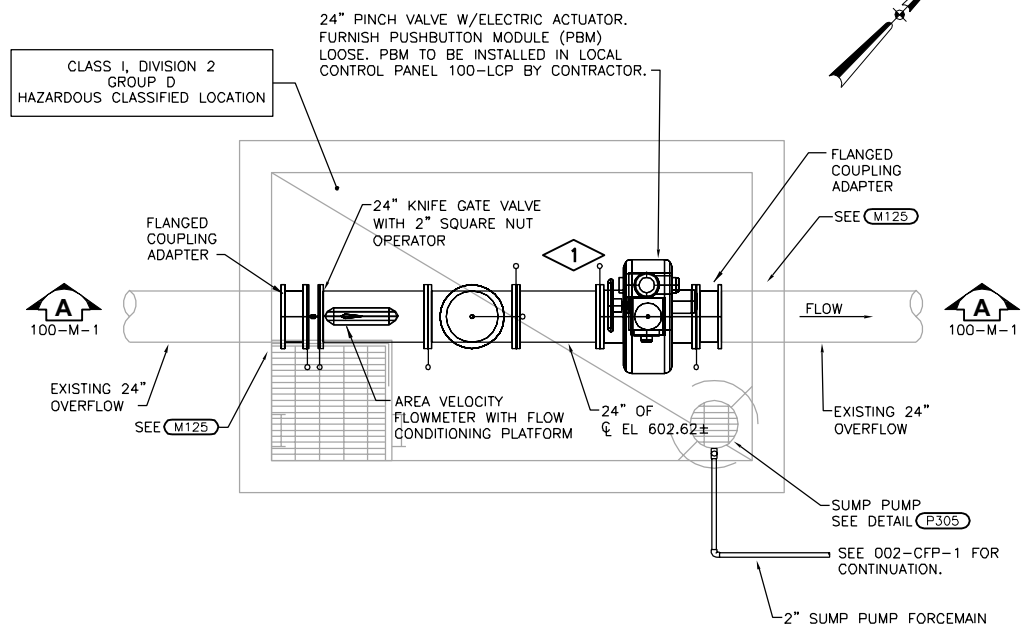


LOWER PLAN

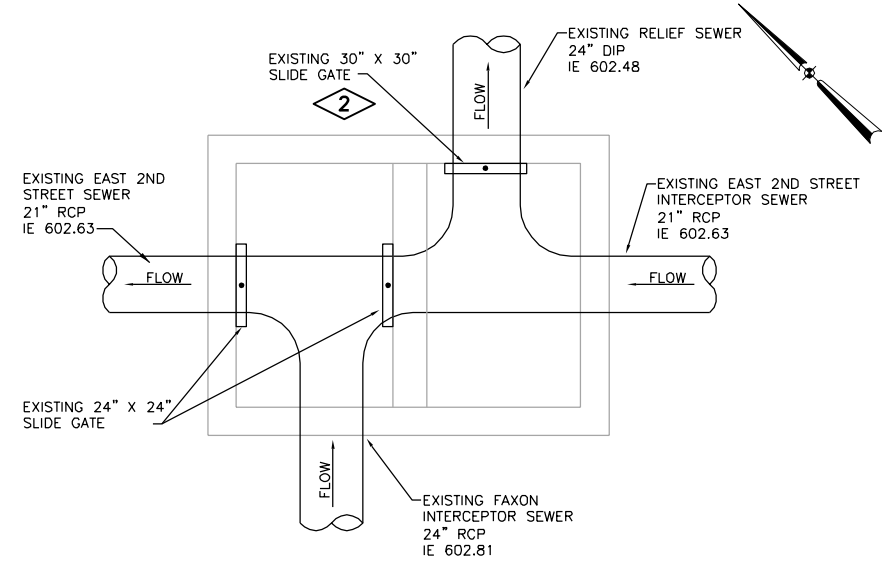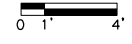



EXISTING EAST STREET JUNCTION CHAMBER DETAIL M100
NTS

MINIMUM DIMENSIONS			
NOMINAL PIPE DIA (INCHES)	T THICKNESS (INCHES)	C DIAMETER (INCHES)	W WELD SIZE (INCHES)
4	0.375	8.00	3/16
6	0.375	10.00	3/16
8	0.375	12.50	3/16
10	0.375	14.50	3/16
12	0.375	16.50	3/16
14	0.50	19.50	1/4
16	0.50	21.75	1/4
18	0.50	23.75	1/4
20	0.50	25.75	1/4
24	0.50	30.25	1/4
30	0.75	36.50	5/16
36	0.75	43.00	5/16
42	0.75	49.50	5/16
48	1.25	56.50	5/16
54	1.50	63.00	5/16

STEEL WALL AND FLOOR PIPE COLLAR DIMENSION DETAIL M115
NTS

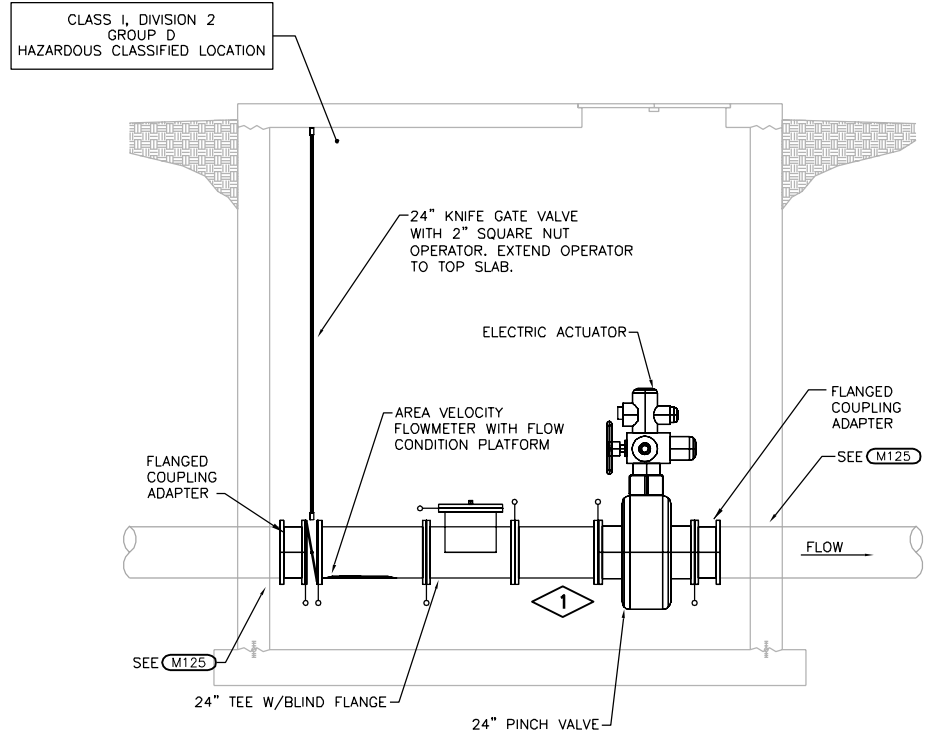

SECTION A

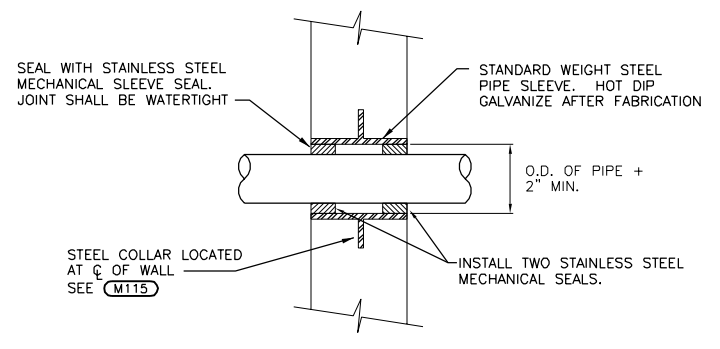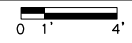


WALL SLEEVE DETAIL M125
NTS

GENERAL NOTES:

- CONTRACTOR SHALL VERIFY DIMENSIONS, ELEVATIONS AND LOCATIONS PRIOR TO WORK.

PLAN NOTES:


- SUPPORT VALVE AND PIPE AS REQUIRED.
- EXISTING 30" X 30" SLIDE GATE TO REMAIN FULLY OPEN AT THE CLOSE OF THE PROJECT. CONDITION OF SLIDE GATE IS UNKNOWN. CONTRACTOR MAY UTILIZE SLIDE GATE FOR ISOLATION OF 24" RELIEF SEWER DURING DRY WEATHER FLOW CONDITIONS AND OWNER'S APPROVAL.

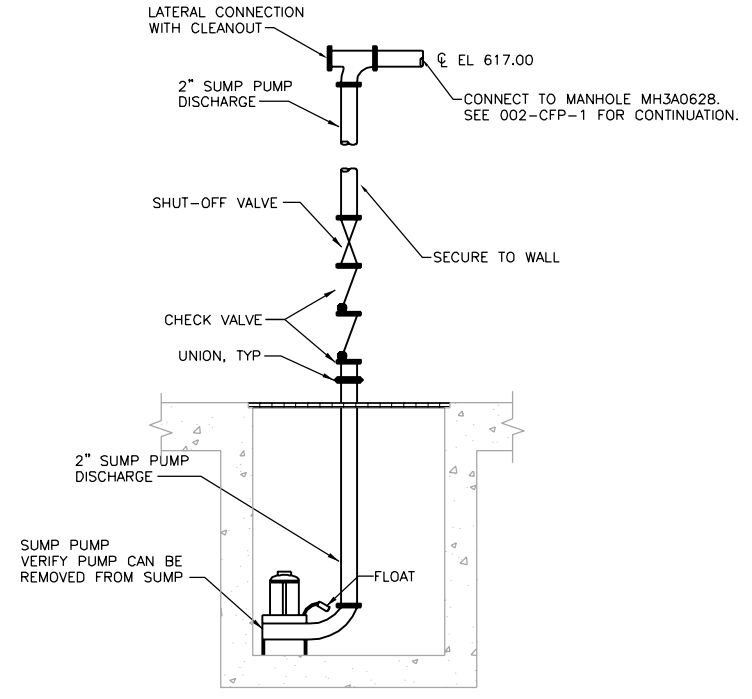



SUBMERSIBLE SUMP PUMP DETAIL P305
NTS

RECORD DRAWING
REVISED TO CONFORM TO CONSTRUCTION RECORDS PROVIDED BY CONTRACTOR
BY: MIKE JENSEN DATE: 08/28/2014


Date	
Checked By	
Drawn By	
Revision Description	
Revision Number	
Designed By	EJM
Drawn By	EJM
Checked By	ESN
Approved By	ESN
Filename	100MP1.DWG
Project No.	11699
Project Date	JULY 2012
CITY OF SUPERIOR, WISCONSIN EAST 2ND STREET RELIEF SEWER CONTROL STRUCTURE SUPERIOR, WISCONSIN	
PLAN, SECTION AND DETAILS	
DONOHUE & ASSOCIATES	
Sheet No.	6
Drawing No.	100-M-1

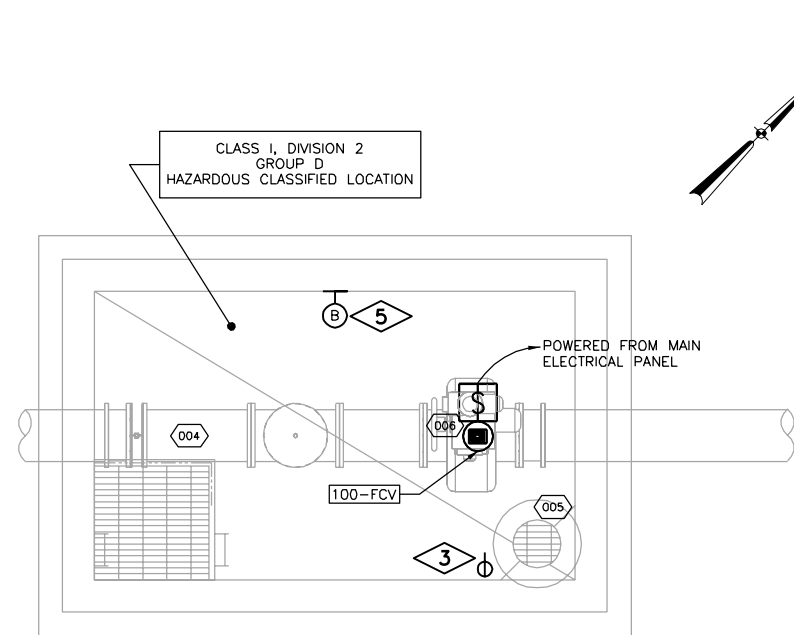

LOWER PLAN

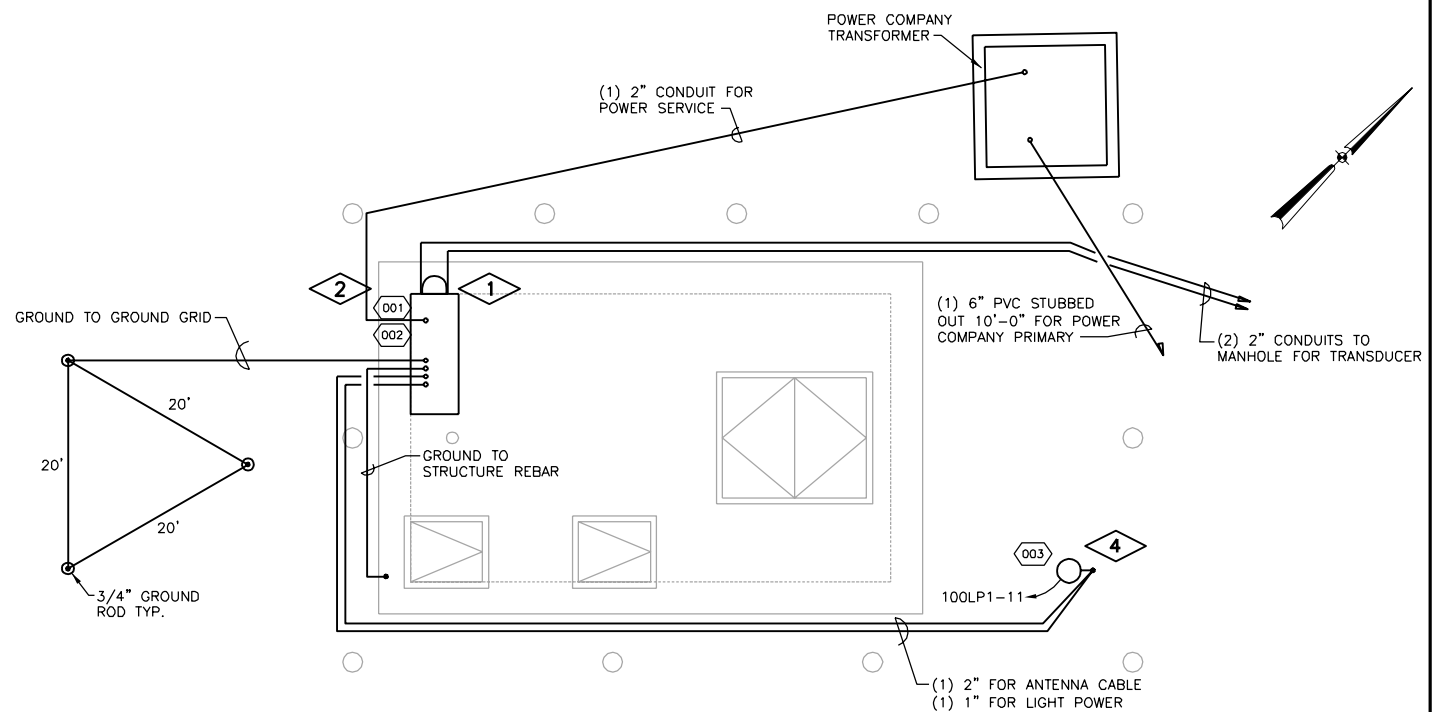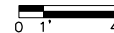

GRADE PLAN

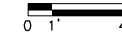

INSTRUMENTATION & CONTROL - FIELD WIRING REQUIREMENTS


ID	TAG NAME	DETAIL	WIRING	DESTINATION	ID	COMMENTS
001	100-LCP	E061	120VAC	100-LP	002	
003	100-ANT	E061	1 ACAB	100-LCP (MDM)	001	SEE DETAIL AT RIGHT
004	100-FE/LE	N322	1 VFC	100-LCP (FE/LE)	001	SEE DETAIL AT RIGHT
005	100-LSH	N270	1 VFC	100-LCP (PLC)	001	SEE DETAIL AT RIGHT
006	100-FCV	MNFC	6#14	100-LCP (HS)	001	SEE DETAIL AT RIGHT

INSTRUMENTATION & CONTROL GENERAL NOTES

- TABLE ABOVE SHOWS CONTROL, SIGNAL AND ASSOCIATED SINGLE PHASE POWER WIRING REQUIREMENTS.
- CONTRACTOR SHALL BE RESPONSIBLE FOR ALL WIRING, WHETHER SHOWN OR NOT, NECESSARY FOR A COMPLETE AND OPERABLE SYSTEM.
- SHIELDED AND UNSHIELDED CONDUCTORS SHALL BE RUN IN CONDUIT. SHIELDED CONDUCTORS SHALL NOT BE COMBINED WITH UNSHIELDED CONDUCTORS IN ANY CONDUIT. NEITHER SHIELDED NOR UNSHIELDED CONDUCTORS SHALL BE INCLUDED IN THE SAME CONDUIT AS POWER WIRING.
- CONDUCTORS SHALL NOT BE SPLICED EXCEPT AT TERMINALS OR AS DESIGNATED BY ENGINEER.
- ONLY REQUIRED CONDUCTORS ARE SHOWN ON PLAN. SPARE CONDUCTORS NOT SHOWN.
- FOR EACH CONDUIT CONTAINING MORE THAN TWO CONDUCTORS, PROVIDE A MINIMUM OF TWO CONDUCTORS OR 10% OF TOTAL CONDUCTORS IN CONDUIT, WHICHEVER IS GREATER AS SPARES. TAG BOTH ENDS OF EACH SPARE. TERMINATE EACH END OF SPARE CONDUCTOR AT TERMINALS WHENEVER POSSIBLE.
- CONDUIT SHALL BE SIZED TO ACCOMMODATE REQUIRED CONDUCTORS AND ANTICIPATED SPARES.
- THIS DRAWING DOES NOT SHOW CONDUIT SYSTEMS. PROVIDE, AS A MINIMUM, PULL BOXES AS RECOMMENDED BY CONDUCTOR MANUFACTURER. CONDULETS SHALL NOT BE USED AS PULL BOXES.
- PROVIDE EXPLOSION-PROOF SEAL-OFF FITTINGS ON ALL CONDUIT EXITING CLASSIFIED OR RATED LOCATIONS. FITTINGS SHALL BE INSTALLED IN THE CLASSIFIED OR RATED LOCATION.

INSTRUMENTATION & CONTROL LEGEND

120VAC	I&C POWER WIRING, SIZED BY CONTRACTOR
() #14	(QUANTITY) #14 THWN CONDUCTORS - CONTROL
() SH.PR.	(QUANTITY) #16 SHIELDED PAIR CABLE - ANALOG
() CAT6	(QUANTITY) DATA HIGHWAY CABLE
() ACAB	(QUANTITY) ANTENNA CABLE SPECIFIC TO RADIO TYPE
() VFC	(QUANTITY) VENDOR FURNISHED CABLE
MNFC	MANUFACTURER DIRECTED MOUNTING
N/A	NOT APPLICABLE

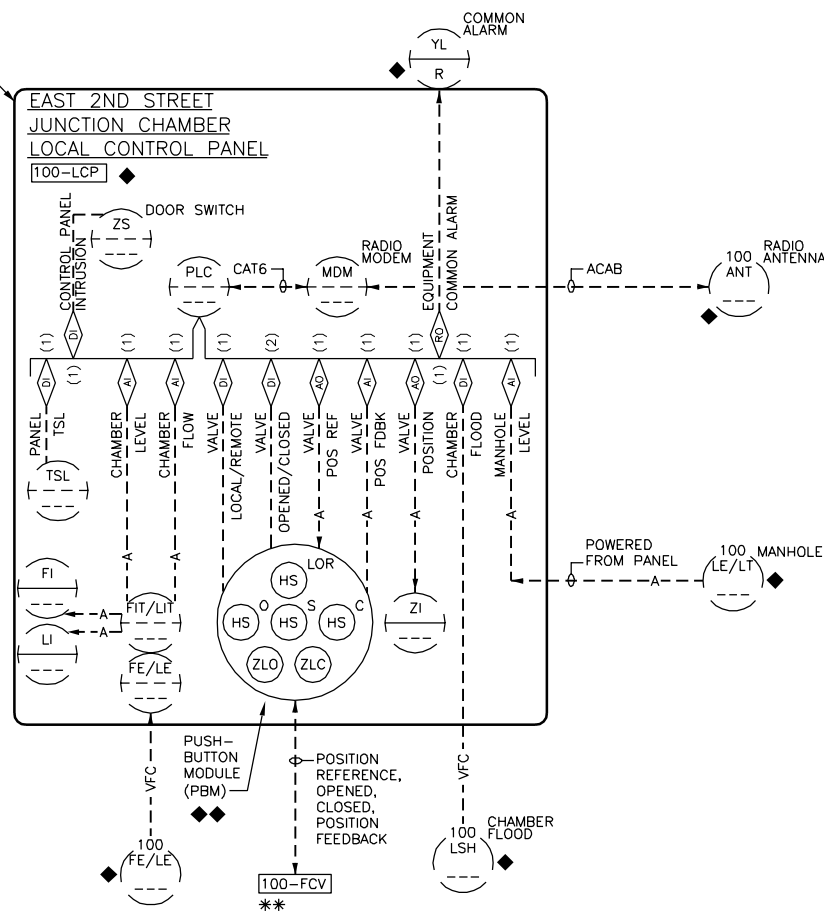

- ◆ PROVIDE COMPONENT IN ACCORDANCE WITH DIVISION 13.
- ◆◆ FURNISHED AS PART OF A MANUFACTURER'S OR VENDOR'S EQUIPMENT PACKAGE TO BE INSTALLED IN ACCORDANCE WITH DIVISION 13.
- ** FURNISHED AS PART OF A MANUFACTURER'S OR VENDOR'S EQUIPMENT PACKAGE, TO BE INSTALLED IN ACCORDANCE WITH DIVISION 11 AND DIVISION 15.

PROCESS & INSTRUMENTATION DETAIL N100

PLAN NOTES:

- OUTDOOR ELECTRICAL CONNECTION POINT. REFER TO SHEET 999-EN-1 FOR MOUNTING DETAILS. REFER TO SHEET 007-E-1 FOR SCHEDULES. COORDINATE UTILITY CONDUIT AND CABLE WITH LOCAL UTILITY. ENSURE SERVICE RATED CONNECTION. INTERIOR OF VAULT IS CLASS 1 DIVISION 2 RATED. PROVIDE AIR GAP OR SEAL ALL CONNECTIONS AND INTERIOR OF CONDUITS AS REQUIRED BY NEC.
- PERFORM RADIO PATH STUDY FOR DETERMINING ANTENNA REQUIREMENTS.
- INSTALL EXPLOSION PROOF DUPLEX OUTLET WHICH IS CLASS 1 DIVISION 2 FOR SUMP PUMP. POWERED FROM 100LP1-10.
- ANTENNA SHALL BE MOUNTED TO LIGHT POLE AS SHOWN ON DRAWING 999-EN-1 DETAIL (E999).
- WALL MOUNTED LIGHT FIXTURE SHALL BE POWERED FROM 100LP1-8. SEE DETAIL (E500).

Date	
Checked By	
Drawn By	
Revision	
Description	
Revision Number	
Designed By	MRS/CRP
Drawn By	MRS/CRP
Checked By	JAB/MLM
Approved By	SLY
Filename	100ENP1.DWG
Project No.	11699
Project Date	JULY 2012

CITY OF SUPERIOR, WISCONSIN
EAST 2ND STREET
RELIEF SEWER CONTROL STRUCTURE
SUPERIOR, WISCONSIN

PLANS AND DETAILS

RECORD DRAWING

REVISED TO CONFORM TO
CONSTRUCTION RECORDS
PROVIDED BY CONTRACTOR

BY: MIKE JENSEN DATE: 08/28/2014




Sheet No. 7
Drawing No.

100-EN-1

GENERAL NOTES:


1. THIS SAMPLE TRAFFIC AND PEDESTRIAN CONTROL PLAN IS FOR REFERENCE ONLY. CONTRACTOR SHALL SUBMIT TRAFFIC AND PEDESTRIAN CONTROL PLAN AS OUTLINED IN SPECIFICATION SECTION 01550.
2. CONTRACTOR SHALL PROVIDE VEHICULAR AND PEDESTRIAN TRAFFIC CONTROL PLANS TO THE WISCONSIN DEPARTMENT OF TRANSPORTATION (MORRIS LUKE (715) 392-7886) 21 DAYS PRIOR TO LANE CLOSURE.
3. VEHICULAR AND PEDESTRIAN TRAFFIC CONTROL PLANS MUST BE APPROVED PRIOR TO LANE CLOSURE.
4. ALL TRAFFIC AND PEDESTRIAN CONTROL DEVICES, SIGNS AND PLACEMENT SHALL CONFORM TO THE DOT MANUAL ON UNIFORM TRAFFIC CONTROL DEVICES.
5. ALL LANES SHALL REMAIN OPEN AFTER 5PM DAILY AND ALL DAY EVERY SATURDAY AND SUNDAY

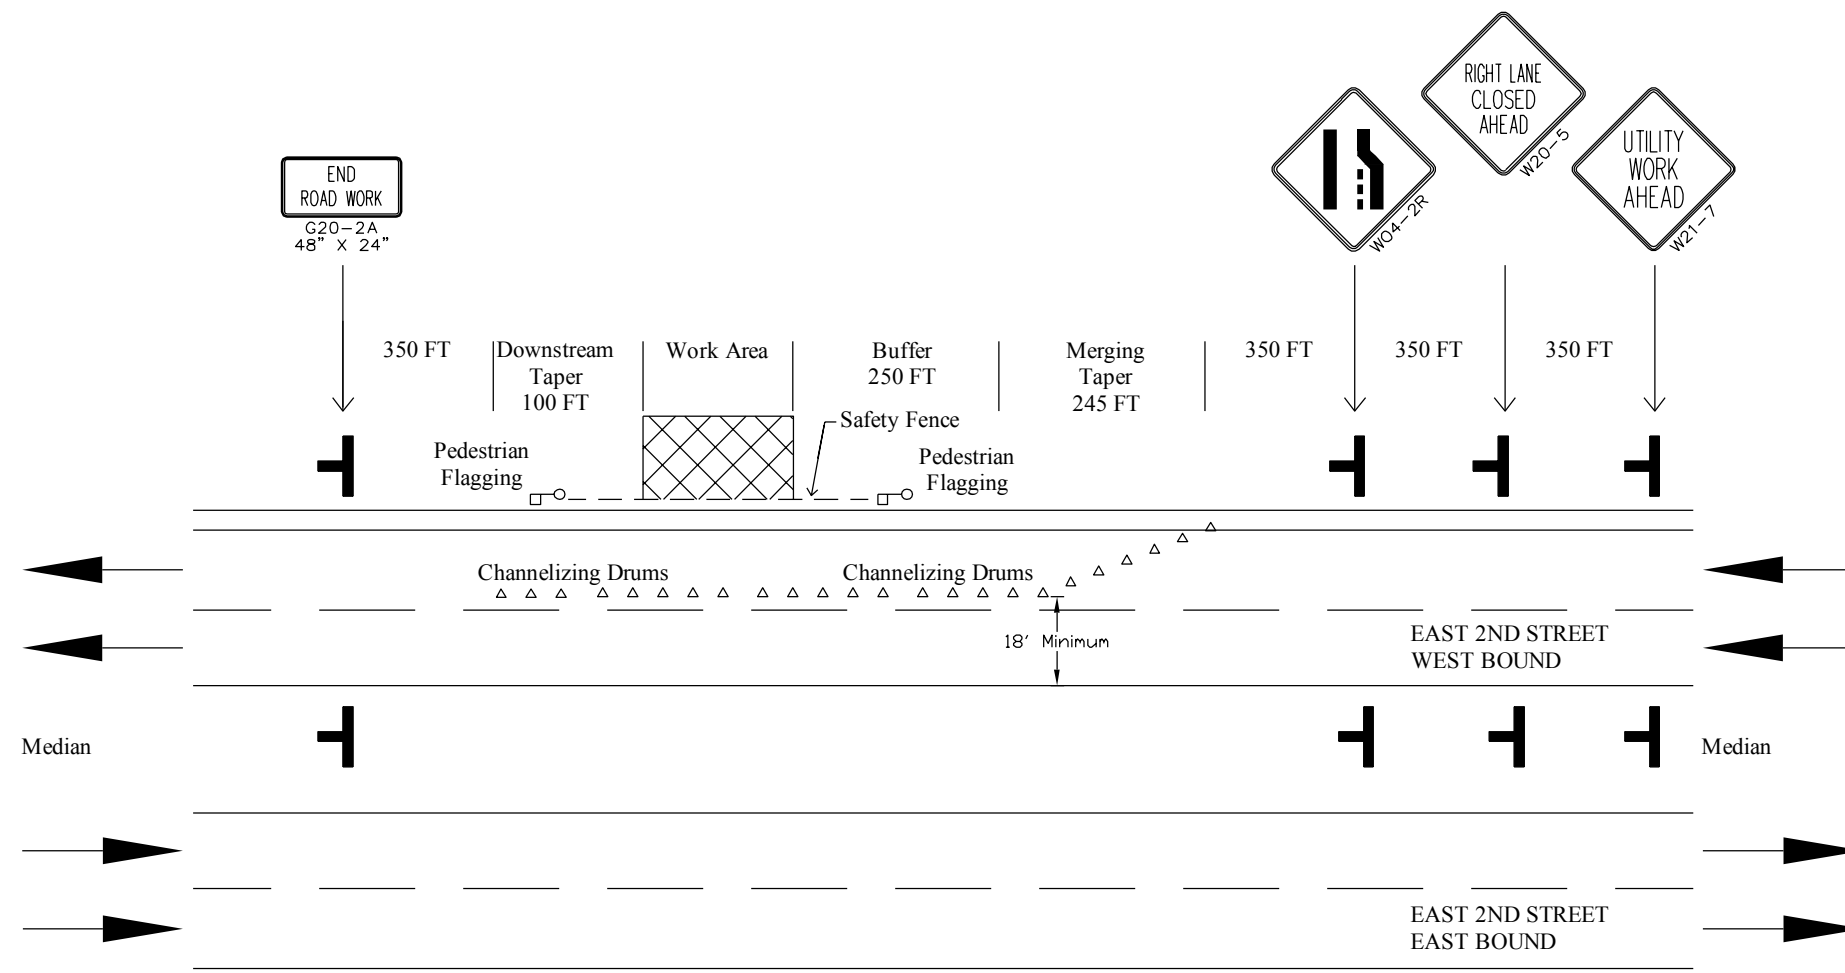

SAMPLE TRAFFIC AND PEDESTRIAN CONTROL PLAN

NTS


CONCRETE CEMENT APRON & SIDEWALK REPLACEMENT SURFACE DETAIL

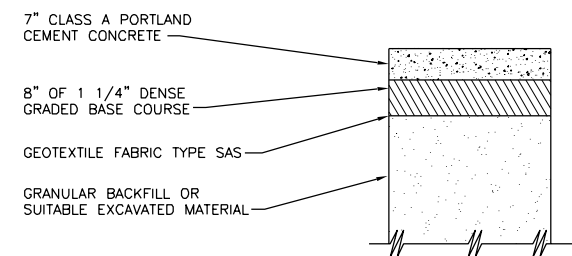

RESURFACING DETAILS C200

NTS

ASPHALT ALLEY & DRIVEWAY SURFACE DETAIL

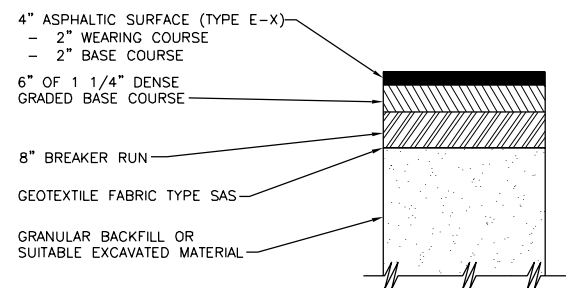

Revision Number	Description	Drawn By	Checked By	Date

Designed By	EJM
Drawn By	EJM
Checked By	ESN
Approved By	ESN
Filename	999CD1.DWG
Project No.	11699
Project Date	JULY 2012

CITY OF SUPERIOR, WISCONSIN
 EAST 2ND STREET
 RELIEF SEWER CONTROL STRUCTURE
 SUPERIOR, WISCONSIN

CIVIL
 STANDARD DETAILS

RECORD DRAWING

REVISED TO CONFORM TO CONSTRUCTION RECORDS PROVIDED BY CONTRACTOR

BY: MIKE JENSEN DATE: 08/28/2014

Sheet No. 8

Drawing No. 999-C-1

GENERAL STRUCTURAL NOTES

GENERAL

- THE GENERAL STRUCTURAL NOTES AND STANDARD STRUCTURAL DETAILS APPLY TO THE ENTIRE PROJECT UNLESS SPECIFICALLY NOTED OTHERWISE.

DESIGN CRITERIA

- DESIGN AND CONSTRUCT IN CONFORMANCE WITH THE LATEST INTERNATIONAL BUILDING CODE WITH WISCONSIN AMENDMENTS

2. SUPERIMPOSED DESIGN LOADS

- SNOW LOAD (GROUND): 30 PSF + DRIFT
- MECHANICAL EQUIPMENT: VERIFY WITH EQUIPMENT SUPPLIER
- VALVE VAULT TOP SLAB: H-20 LOAD RATED

FOUNDATIONS

- GEOTECHNICAL INVESTIGATION BY BRAUN INTERTEC. GEOTECHNICAL EVALUATION REPORT AVAILABLE UPON REQUEST.
- NET SOIL BEARING CAPACITIES PER GEOTECHNICAL INVESTIGATION: 3000 PSF
- PLACE FOOTINGS ON NATURAL UNDISTURBED EARTH OR STRUCTURAL FILL.
- PLACE FILL SIMULTANEOUSLY ON BOTH SIDES OF FREE-STANDING STRUCTURES.
- PLACE FILL AGAINST FOUNDATION WALLS ENCLOSING INTERIOR SPACES AFTER CONSTRUCTION SUCH AS CROSS WALLS, BEAMS, OR SLABS ARE IN PLACE TO BRACE WALL AND SUCH CONSTRUCTION HAS REACHED ITS DESIGN STRENGTH.
- TO MINIMIZE LATERAL FORCES AGAINST THE STRUCTURE DUE TO WEDGING ACTION OF THE SOIL, BEGIN COMPACTION OF EACH LAYER AT THE STRUCTURE WALL.

REINFORCEMENT

- REINFORCING STEEL
 - DEFORMED BARS: ASTM A615 - GRADE 60
 - UNLESS NOTED OTHERWISE PROVIDE CLEAR COVER FOR REINFORCEMENT AS FOLLOWS:
 - CAST AGAINST
 - EARTH: 3 INCHES
 - EXPOSED TO EARTH, WEATHER, OR WATER
 - WALLS AND SLABS
 - #5 BARS OR SMALLER: 1 1/2 INCHES
 - #6 THROUGH #11 BARS: 2 INCHES
- PLACE DOWELS BEFORE PLACING CONCRETE.
- DO NOT FIELD WELD OR FIELD BEND REINFORCING BARS.

CONCRETE


- DESIGN STRENGTH
 - ALL LOCATIONS CLASS A: $F'_c = 4000$ PSI
- PROVIDE WATERSTOP IN CONSTRUCTION JOINTS IN
 - WALLS AND SLABS SEPARATING DRY INTERIOR FROM EARTH OR LIQUID.
 - OTHER LOCATIONS SHOWN.
- UNLESS NOTED OTHERWISE, CONSTRUCTION JOINTS SHOWN ARE OPTIONAL. CONSTRUCTION JOINTS NOT SHOWN SHALL BE APPROVED BY ENGINEER.
- BEFORE CONCRETE IS PLACED, CONSTRUCTION JOINTS SHALL BE CLEANED, LAITANCE REMOVED, AND SURFACE WETTED. REMOVE STANDING WATER.
- CONSTRUCTION JOINTS SHALL HAVE KEYS OR ROUGHENED SURFACES. WHERE ROUGHENED SURFACE USED, SURFACE SHALL HAVE AMPLITUDE OF 1/4 IN. MIN.
- PROVIDE 3/4 IN. CHAMFER ON EXTERNAL CORNERS OF EXPOSED CONCRETE WALLS, BEAMS, COLUMNS, EQUIPMENT BASES AND EXPOSED EDGES OF CONSTRUCTION JOINTS.

METALS

- STEEL
 - SHAPES AND PLATES: ASTM A36 OR A992
- ALUMINUM
 - SHAPES AND PLATES: ALLOY 6061-T6 OR 6063-T6
- WELD ALUMINUM IN ACCORDANCE WITH AWS AND AA REQUIREMENTS.
- COAT ALUMINUM SURFACES IN CONTACT WITH CONCRETE IN ACCORDANCE WITH AA REQUIREMENTS. UNDER NO CIRCUMSTANCES SHALL ALUMINUM CONTACT DISSIMILAR METALS.

MISCELLANEOUS

- VERIFY PERTINENT EXISTING CONDITIONS AND DIMENSIONS BEFORE STARTING CONSTRUCTION AND/OR FABRICATION.
- FOR ADDITIONAL OPENINGS, ANCHORS, AND EMBEDDED ITEMS SEE PROCESS, PLUMBING, MECHANICAL, AND ELECTRICAL DRAWINGS.

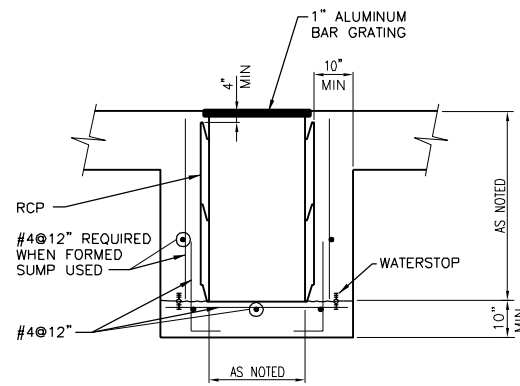

- NOTES:
- FORMED SUMP OPTIONAL.

SUMP DETAIL

S338


NTS

MINIMUM REINFORCEMENT BAR SPLICE AND ANCHORAGE LENGTH (INCHES) S010

BAR SIZE	LAPPED SPLICE LENGTH		EMBEDMENT LENGTH		COMPRESSION LAP LENGTH
	TOP BARS	OTHERS	TOP BARS	OTHERS	
3	18	16	14	12	12
4	24	19	19	15	15
5	30	23	23	18	19
6	36	28	28	22	23
7	43	33	33	26	26
8	57	44	44	34	30
9	72	56	56	43	34
10	92	70	70	54	38
11	112	86	86	67	42

NOTES:

- TOP BARS ARE HORIZONTAL BARS SO PLACED THAT MORE THAN 12" OF CONCRETE IS CAST IN THE MEMBER BELOW THE BAR.
- FOR BARS SPACED LESS THAN 6 BAR DIAMETER OC INCREASE LENGTH BY 25%.
- WHEN LAPPING TWO DIFFERENT SIZE BARS USE THE LAP LENGTH OF THE SMALLER BAR UNLESS NOTED OTHERWISE.
- EMBEDMENT LENGTH IS MINIMUM LENGTH OF EMBEDMENT FOR STRAIGHT DOWELS WHERE END HOOK IS NOT SHOWN, UNLESS OTHERWISE NOTED.
- COMPRESSION LAP LENGTH FOR VERICAL COLUMN BARS ONLY.
- HOOKS SHALL BE ACI STANDARD UNLESS OTHERWISE NOTED.
- FOR EPOXY COATED REINFORCEMENT, INCREASE LENGTH BY 20% FOR TOP BARS AND 50% FOR OTHERS.

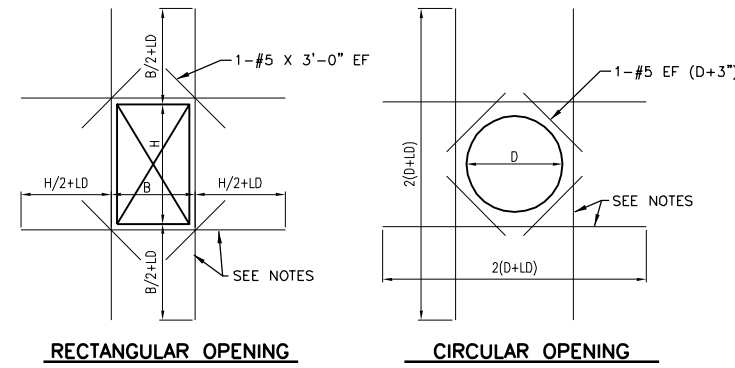

RECTANGULAR OPENING


CIRCULAR OPENING

NOTES:

- THESE DETAILS APPLY TO ALL OPENINGS IN CONCRETE WALLS AND SLABS WHEN THE LARGEST OPENING DIMENSION IS GREATER THAN TWO TIMES SECTION THICKNESS OR GREATER THAN REINFORCING SPACING IN THE SECTION, UNLESS OTHERWISE INDICATED IN THE DRAWINGS.
- THE AREA OF ADDITIONAL REINFORCING REQUIRED IN EACH FACE ON EACH SIDE OF AN OPENING SHALL EQUAL OR EXCEED ONE-HALF OF THE AREA OF THE INTERCEPTED BARS IN EACH FACE, IN EACH DIRECTION, RESPECTIVELY WITH A MINIMUM OF 1-#5 BAR EACH FACE.
- PLACE THE ADDED BARS IN THE SAME LAYERS AS THE WALL OR SLAB REINFORCING.
- LD = EMBEDMENT LENGTH. SEE S010

ADDITIONAL REINFORCEMENT AT OPENINGS IN WALLS AND SLABS DETAIL S020

NTS

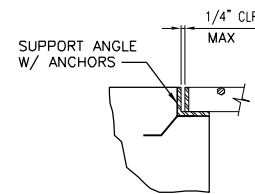


NOTES:

- SUPPORT MATERIAL TO MATCH GRATING MATERIAL UNLESS OTHERWISE NOTED.
- PROVIDE GRATING SUPPORTS ALL AROUND OPENING UNLESS OTHERWISE NOTED.
- GRATING MAY BE CONTINUOUS OVER INTERIOR SUPPORT UNLESS OTHERWISE NOTED.

GRATING SUPPORT DETAIL **S540**

NTS

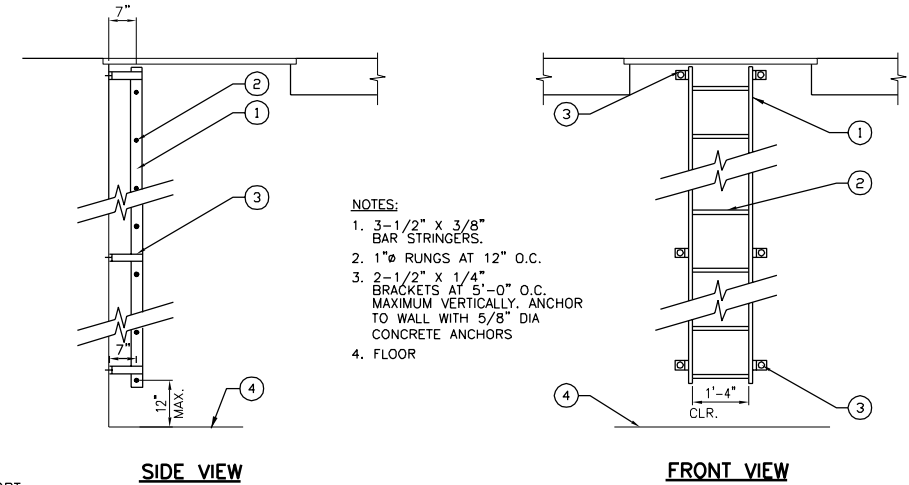

NOTES:

- 3-1/2" X 3/8" BAR STRINGERS.
- 1"Ø RUNGS AT 12" O.C.
- 2-1/2" X 1/4" BRACKETS AT 5'-0" O.C. MAXIMUM VERTICALLY. ANCHOR TO WALL WITH 5/8" DIA CONCRETE ANCHORS
- FLOOR

SIDE VIEW


FRONT VIEW

LADDER DETAIL **S529**

NTS

BOLLARD DETAIL S101

NTS

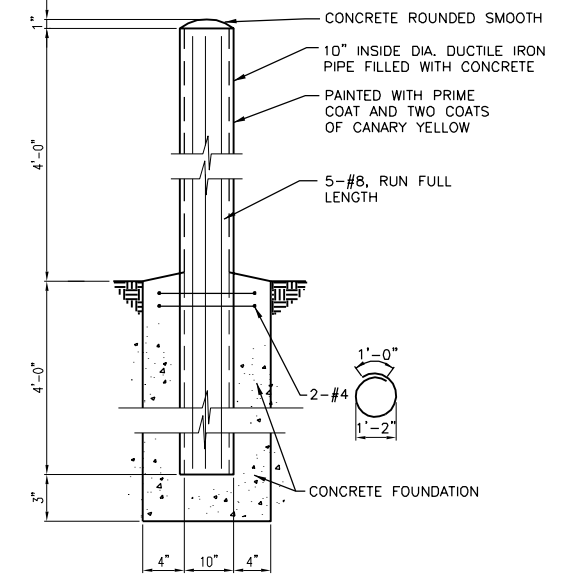

SECTION

Revision Description

Revision Number

Designed By AJT

Drawn By AJT

Checked By PJE

Approved By ESN

Filename 999SD1.DWG

Project No. 11699

Project Date JULY 2012

CITY OF SUPERIOR, WISCONSIN
EAST 2ND STREET
RELIEF SEWER CONTROL STRUCTURE
SUPERIOR, WISCONSIN
STRUCTURAL
STANDARD DETAILS

RECORD DRAWING


REVISED TO CONFORM TO CONSTRUCTION RECORDS PROVIDED BY CONTRACTOR

BY: MIKE JENSEN DATE: 08/28/2014




Sheet No. 9

Drawing No. 999-S-1

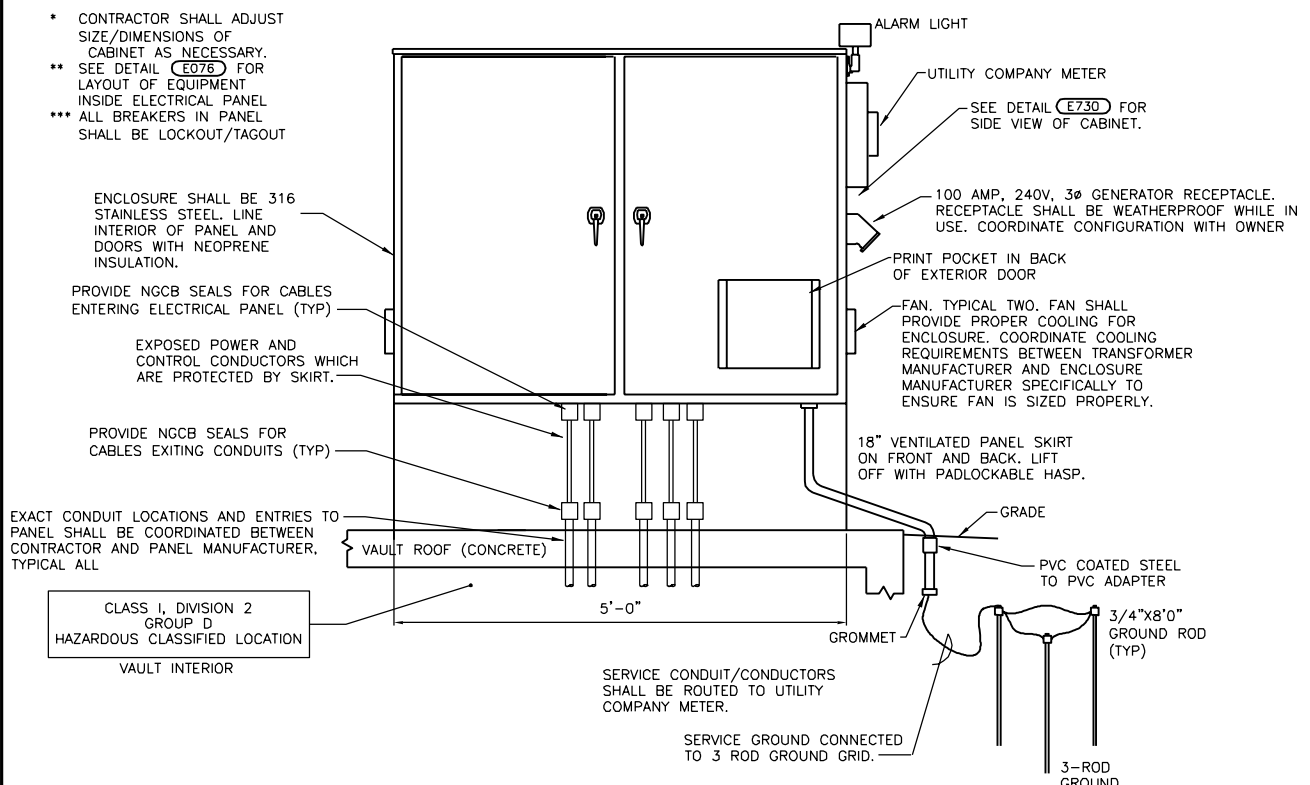


EQUIPMENT MOUNTING DETAIL OUTSIDE ELECTRICAL ENCLOSURE E061
 NTS

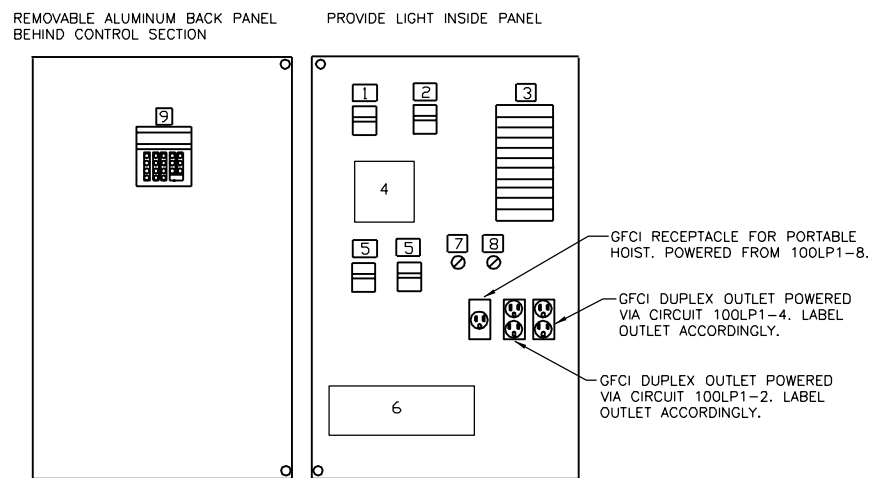

NAME	SCHEDULE
1	MAIN DISCONNECT, 100A, 240V BREAKER
2	DISCONNECT FOR LIGHTING PANEL TRANSFORMER
3	LIGHTING PANEL
4	MANUAL TRANSFER SWITCH
5	LOCATION FOR BREAKERS
6	PLC
7	OPEN-CLOSE-AUTO LIGHT SWITCH
8	ON-OFF LIGHT SWITCH
9	OPERATOR INTERFACE


EQUIPMENT MOUNTING DETAIL INSIDE ELECTRICAL ENCLOSURE E076
 NTS

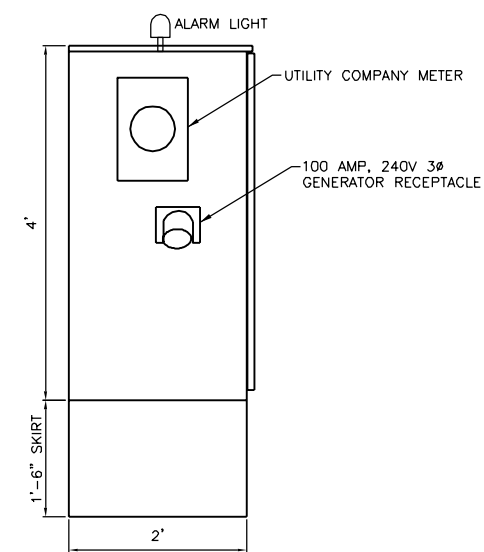


SIDE VIEW OF ELECTRICAL ENCLOSURE E730
 NTS

PLAN NOTES:

- TERMINATE VENDOR PROVIDED SENSOR CABLE AT THE PLC CABINET.

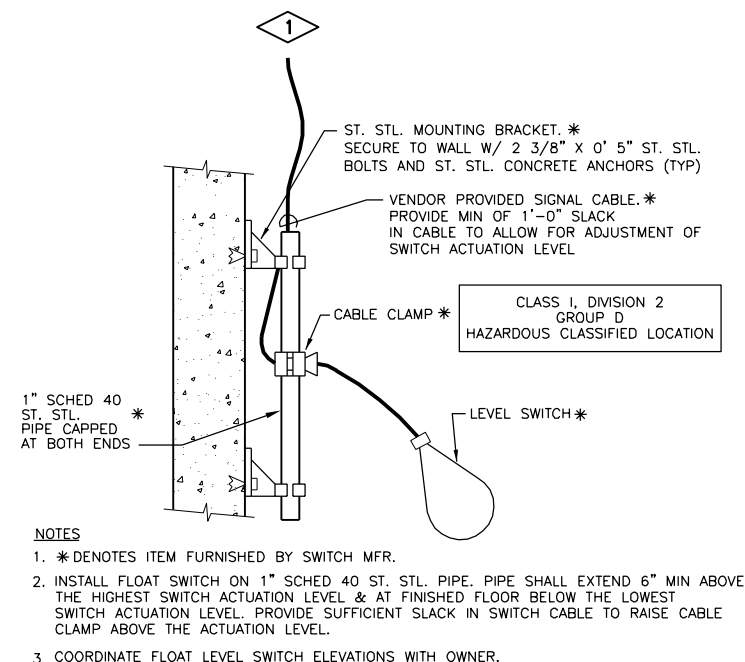

BALL FLOAT ON FIXED ARM N270
 NTS

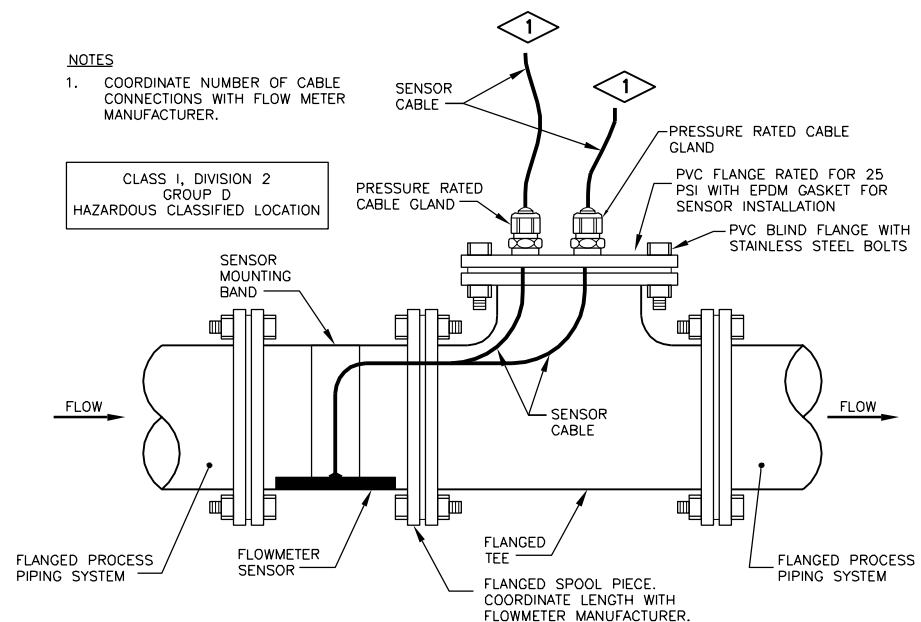

AREA VELOCITY FLOWMETER PIPE MOUNT N322
 NTS

RECORD DRAWING

REVISED TO CONFORM TO CONSTRUCTION RECORDS PROVIDED BY CONTRACTOR

BY: MIKE JENSEN DATE: 08/28/2014

Revision Number	Description	Drawn By	Checked By	Date

Designed By: MRS/CRP
 Drawn By: MRS/CRP
 Checked By: JAB/MLM
 Approved By: ESN
 Filename: 999EN1.DWG
 Project No: 11699
 Project Date: JULY 2012


CITY OF SUPERIOR, WISCONSIN
 EAST 2ND STREET
 RELIEF SEWER CONTROL STRUCTURE
 SUPERIOR, WISCONSIN

ELECTRICAL AND INSTRUMENTATION DETAILS


DONOHUE & ASSOCIATES

Sheet No. 10
 Drawing No. 999-EN-1

FIXTURE SCHEDULE										
TYPE	DESCRIPTION	NO. OF LEADS	DRIVE CURRENT	COLOR TEMPERATURE	VOLTAGE	HOUSING COLOR	MOUNTING	OPTICS	OPTONS AND ACCESSORIES	REMARKS
A	ROADWAY LED 120 LED MOUNTED ON 25' POLE	120	350 mA EXTENDED LIFE DRIVER	5,000 K CCT ±250K	AUTO SENSING	GRAY	25' POLE	TYPE III WIDE ASYMETRIC	P2 TENON ADAPTER, DTL SOLID-STATE LIGHTING PHOTOCONTROL, NEMA TWIST-OFF PHOTOCONTROL RECEPTACLE	INCLUDE MANUFACTURER INSTALLED PHOTOCELL LIGHT SHALL BE WIRED TO SWITCH TO BYPASS PHOTOCELL. LOCATE SWITCH IN CONTROL PANEL.
B	WET LOCATION LED LIGHTING	98	350 mA EXTENDED LIFE DRIVER	5,000 K CCT ±250K	120 VOLT	GRAY	WALL	TYPE 5, HIGH ANGLE GLASS	CORROSION RESISTANT GRAY LUMINAIRE COLOR, 40C MAXIMUM AMBIENT	

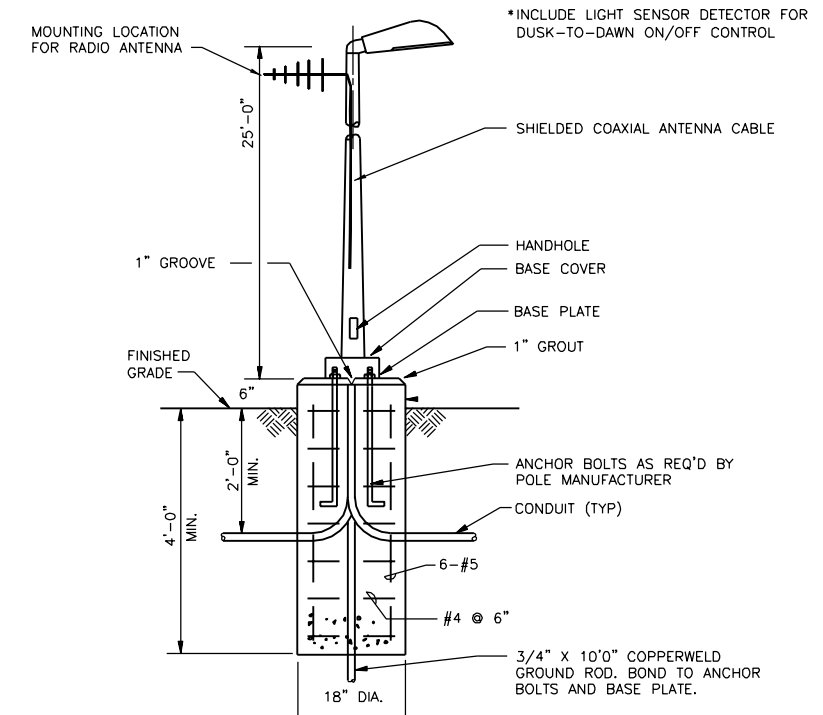

SITE LIGHTING E999
NTS

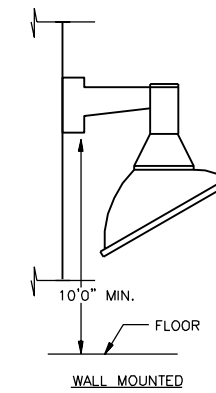

FIXTURE MOUNTING DETAIL E500
NTS

Date	Checked By	Drawn By	Revision Description	Revision Number

Designed By	MRS/CRP
Drawn By	MRS/CRP
Checked By	JAB/MLM
Approved By	ESN
Filename	999EN1.DWG
Project No.	11699
Project Date	JULY 2012

CITY OF SUPERIOR, WISCONSIN
EAST 2ND STREET
RELIEF SEWER CONTROL STRUCTURE
SUPERIOR, WISCONSIN
ELECTRICAL AND INSTRUMENTATION
DETAILS

RECORD DRAWING
REVISED TO CONFORM TO
CONSTRUCTION RECORDS
PROVIDED BY CONTRACTOR
BY: MIKE JENSEN DATE: 08/28/2014

DONOHUE
ASSOCIATES

Sheet No. 11
Drawing No. 999-EN-2