
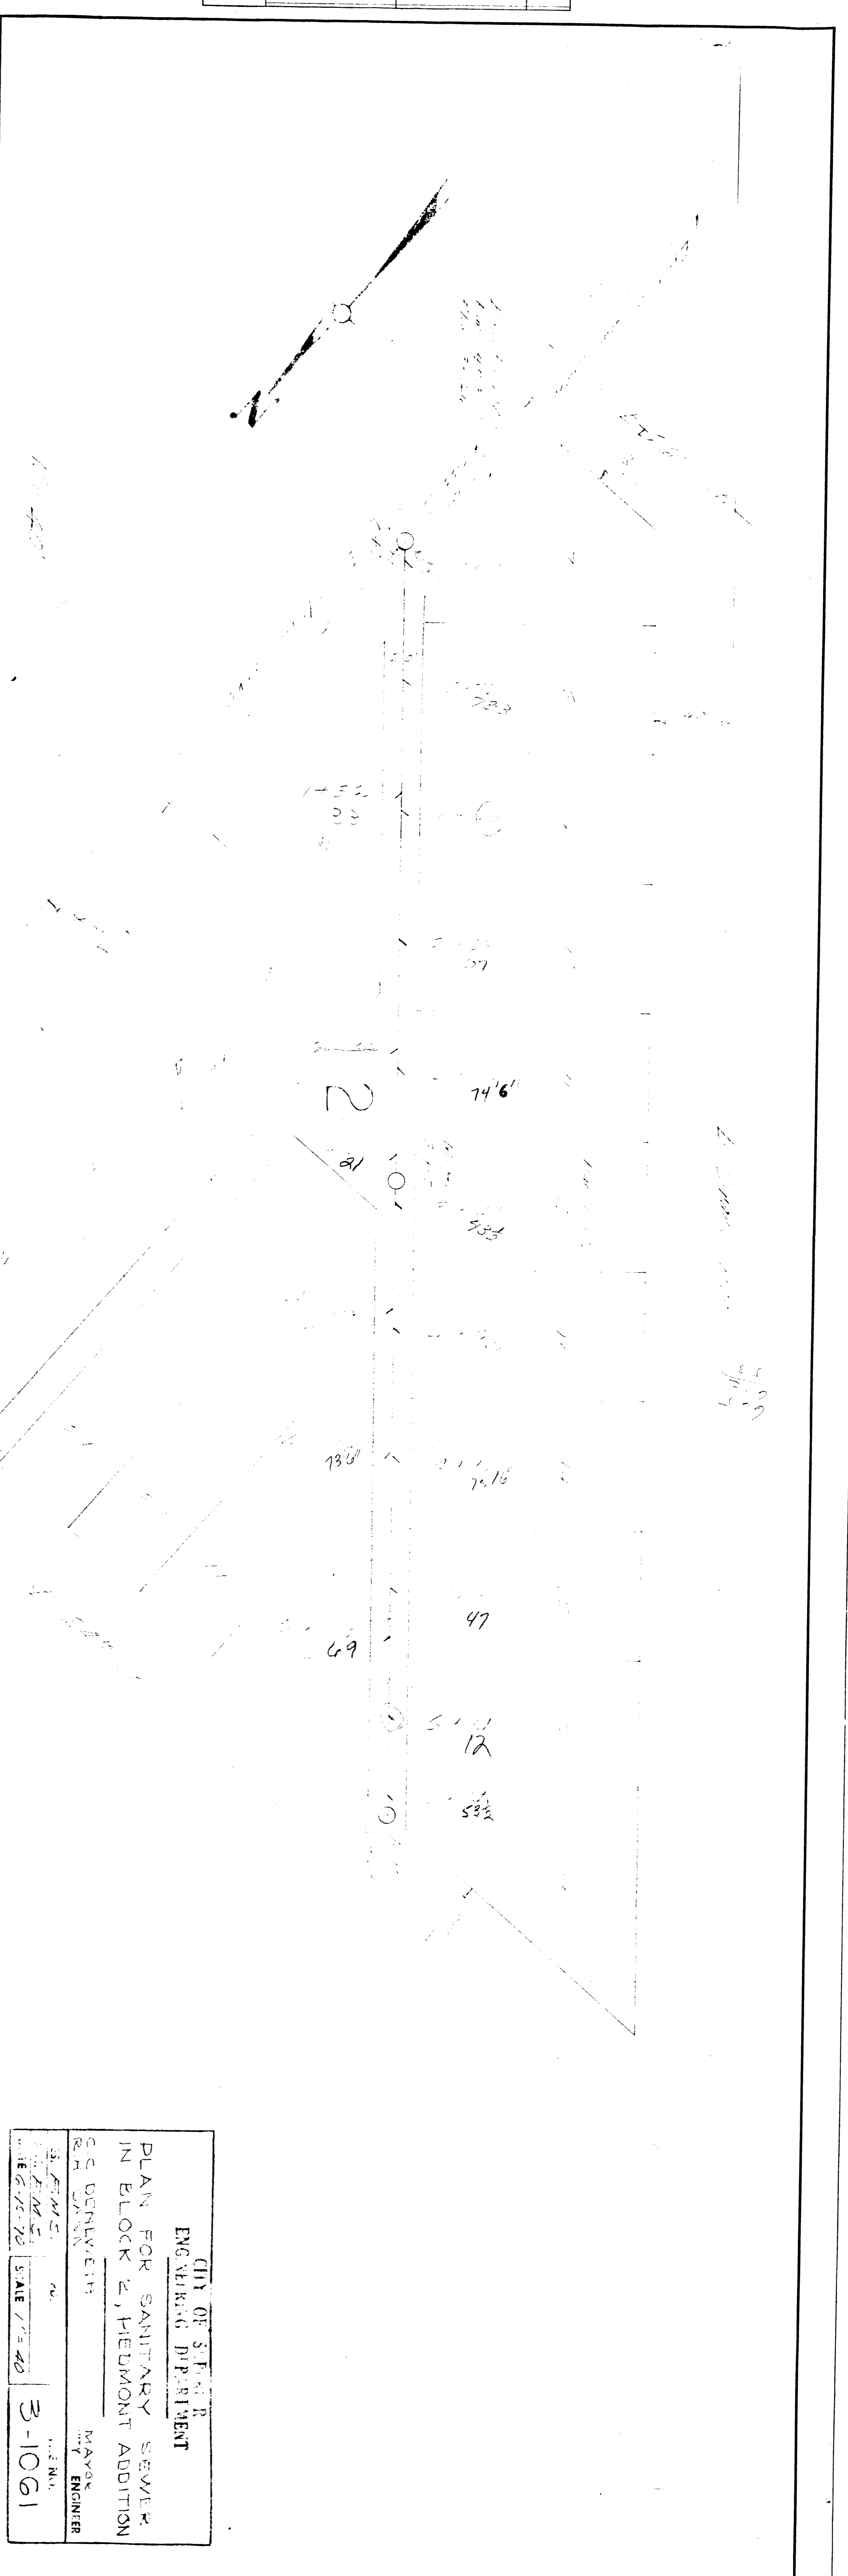


PROFILE	SURVEYED	BY	DATE
	NOTE BOOK	GRADES CHECKED	
	NO.	S. M. S. NOTED	
		STRUCTURE NOTATIONS CH'KD	

PLAN	SURVEYED	BY	DATE
	NOTE BOOK	ALIGNMENT CHECKED	
	NO.	RT. OF WAY CHECKED	

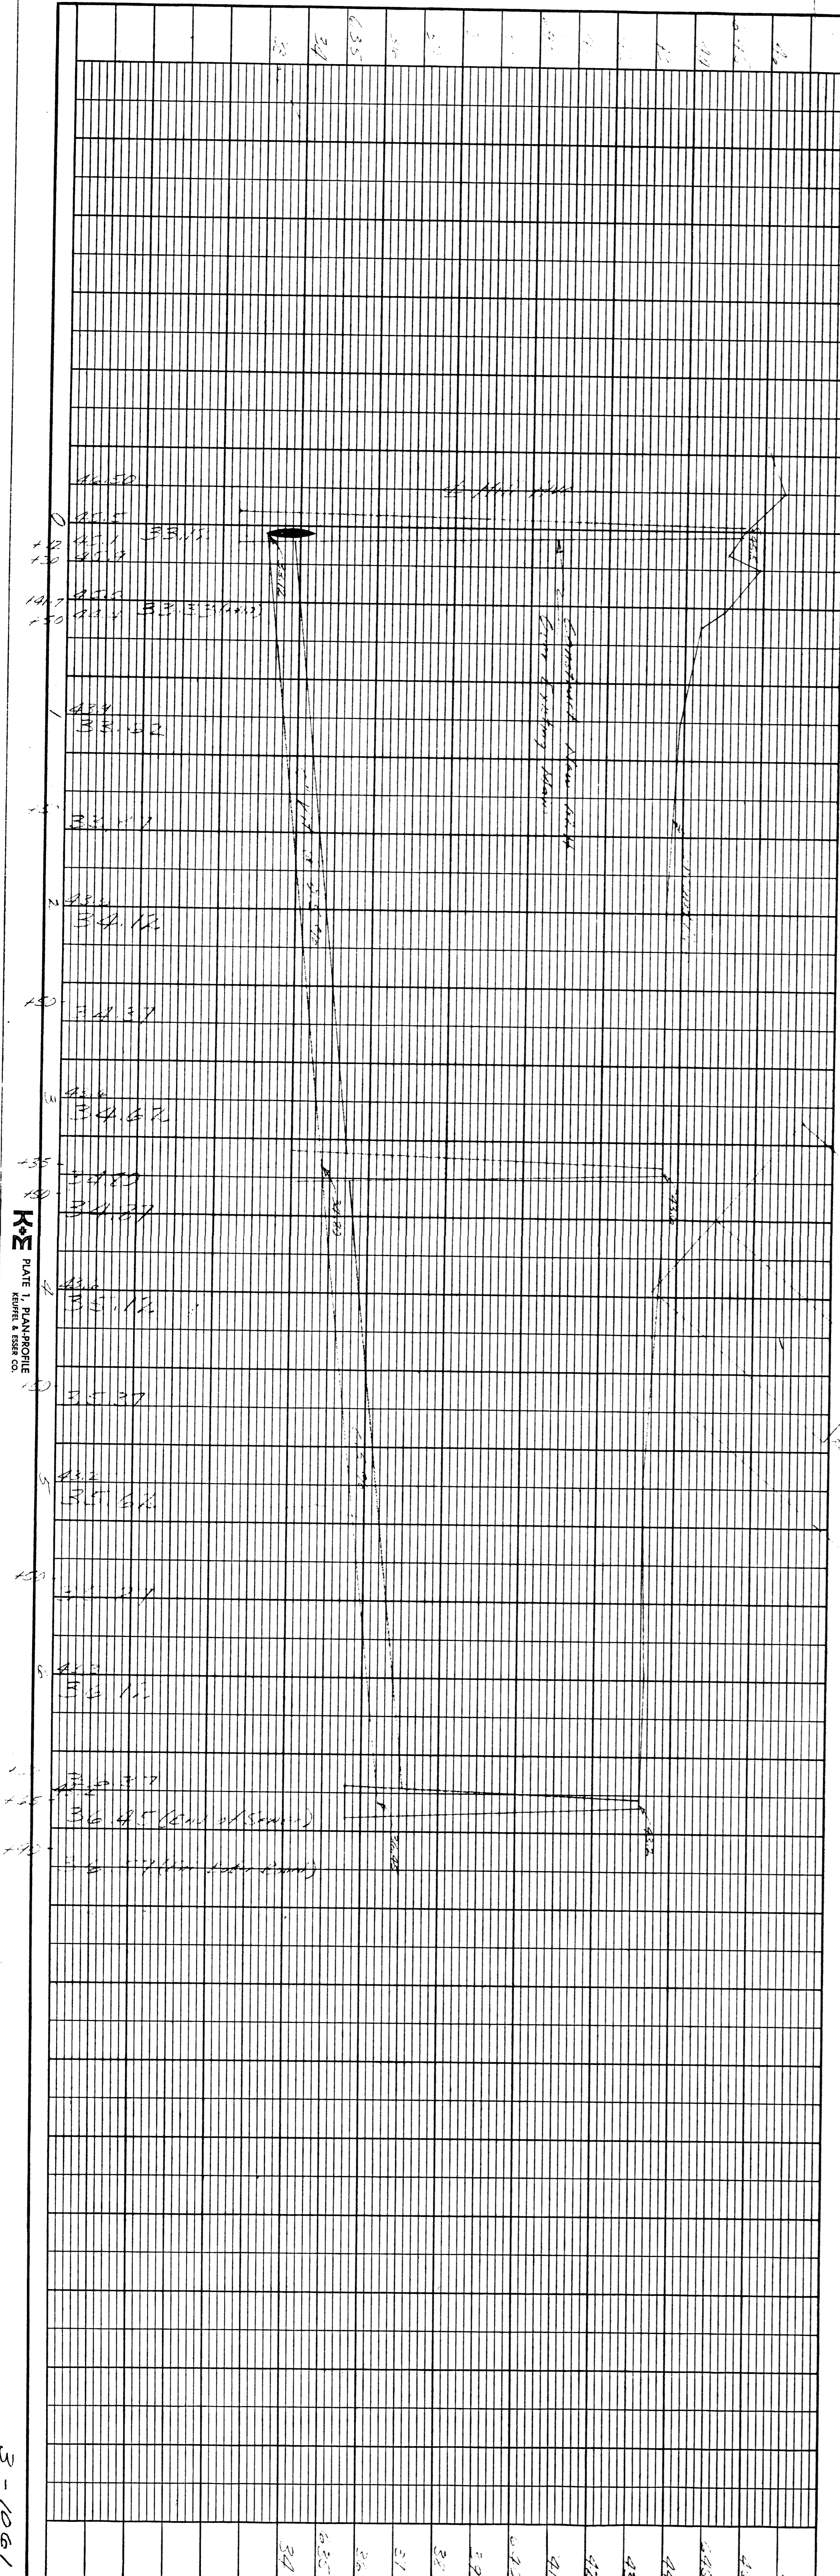

CITY OF SEAFORD
 ENGINEERING DEPARTMENT
 PLAN FOR SANITARY SEWER
 IN BLOCK 2, PIEDMONT ADDITION
 C. G. DENLWELT
 R. H. DENLWELT
 MAYOR
 CITY ENGINEER
 SCALE 1" = 40'
 3-1061

48708 ALABAMA ENGINEERING & SURVEYING BOARD
 REGISTERED PROFESSIONAL ENGINEER
 R. E. KEEFER & SONS CO.
 3793

3-1061
 A-4-5