
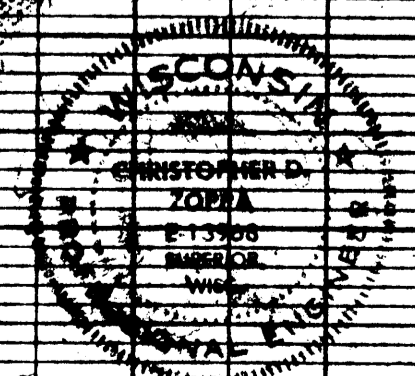
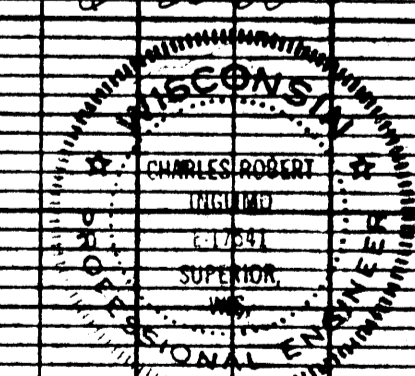
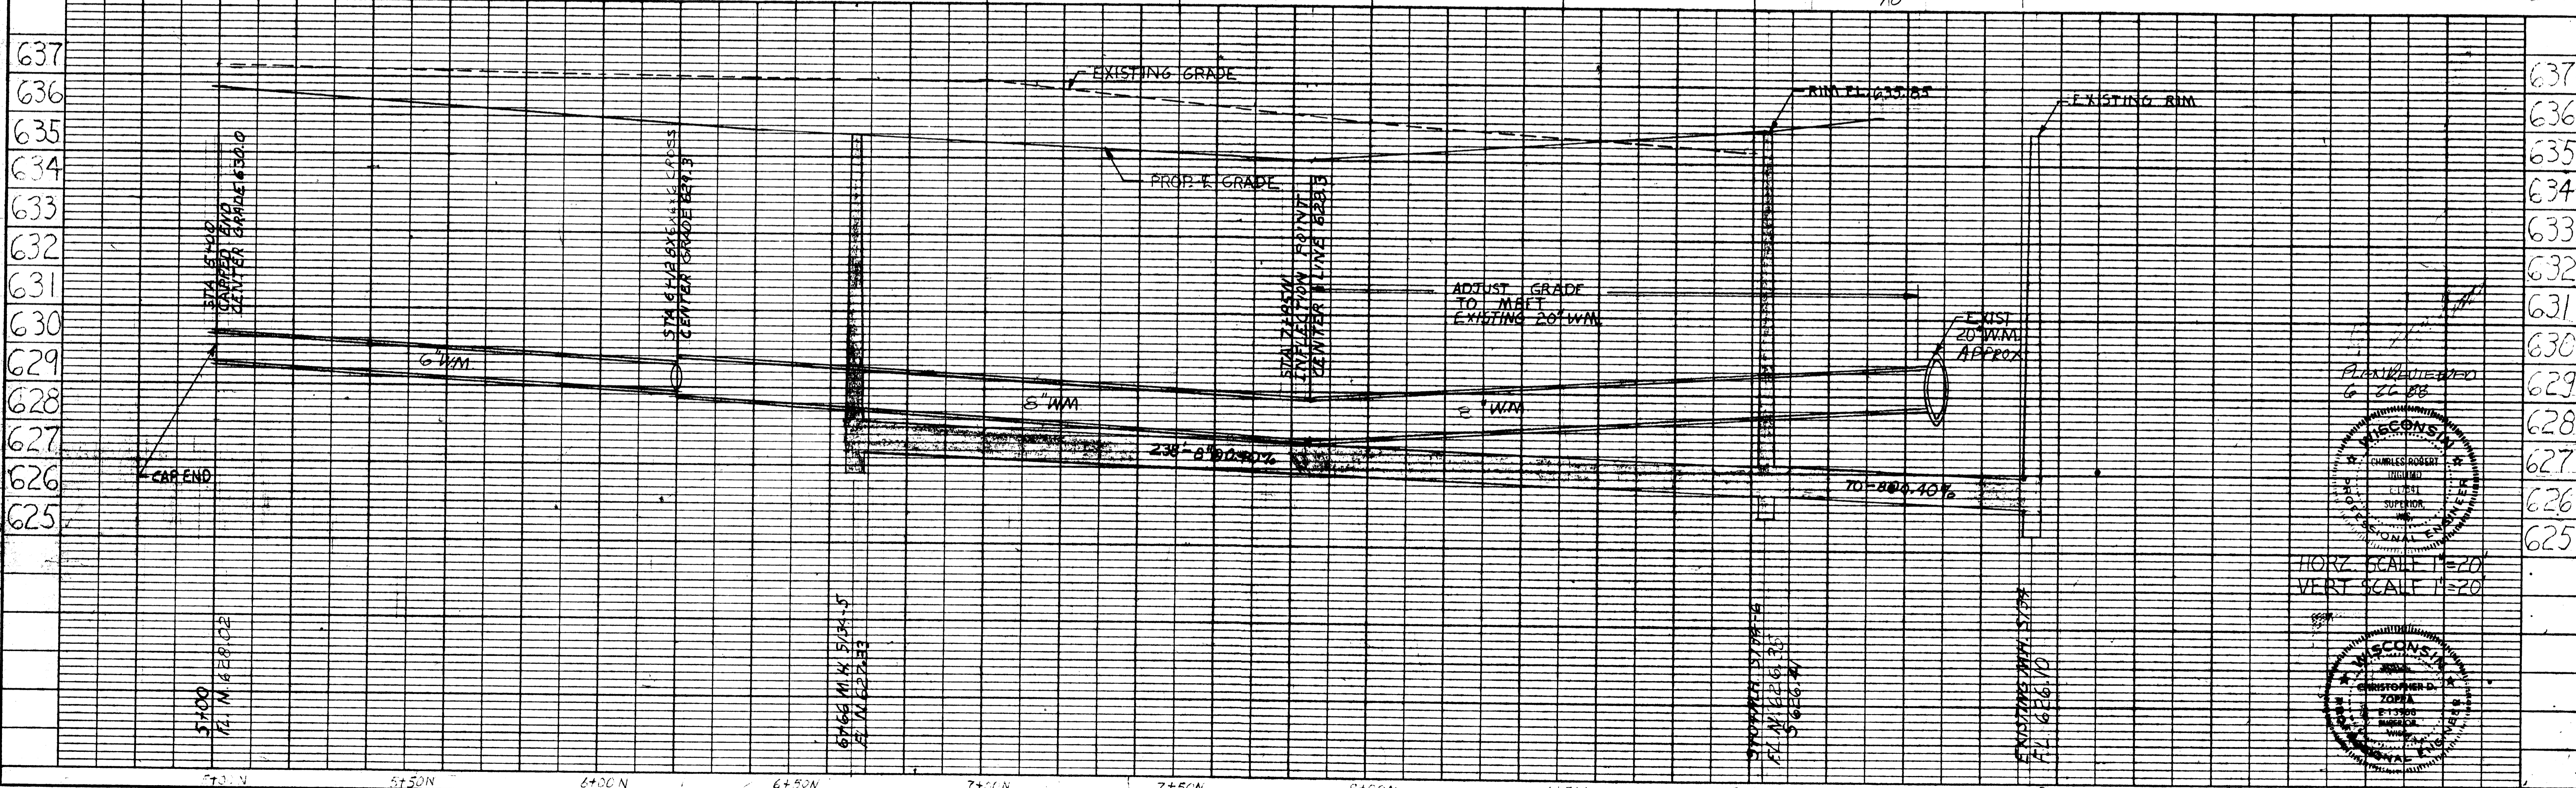


4
COLOR CODE

PLAN	DATE
SURVEYED	BY
NOTED	NO.
ALIGNED	NO.
CHECKED	NO.
RT. OF WAY	NO.
CHECKED	NO.

PROFILE	DATE
SURVEYED	BY
PLOTTED	NO.
GRADES CHECKED	NO.
STRUCTURE NOTATIONS	NO.
CHECKED	NO.

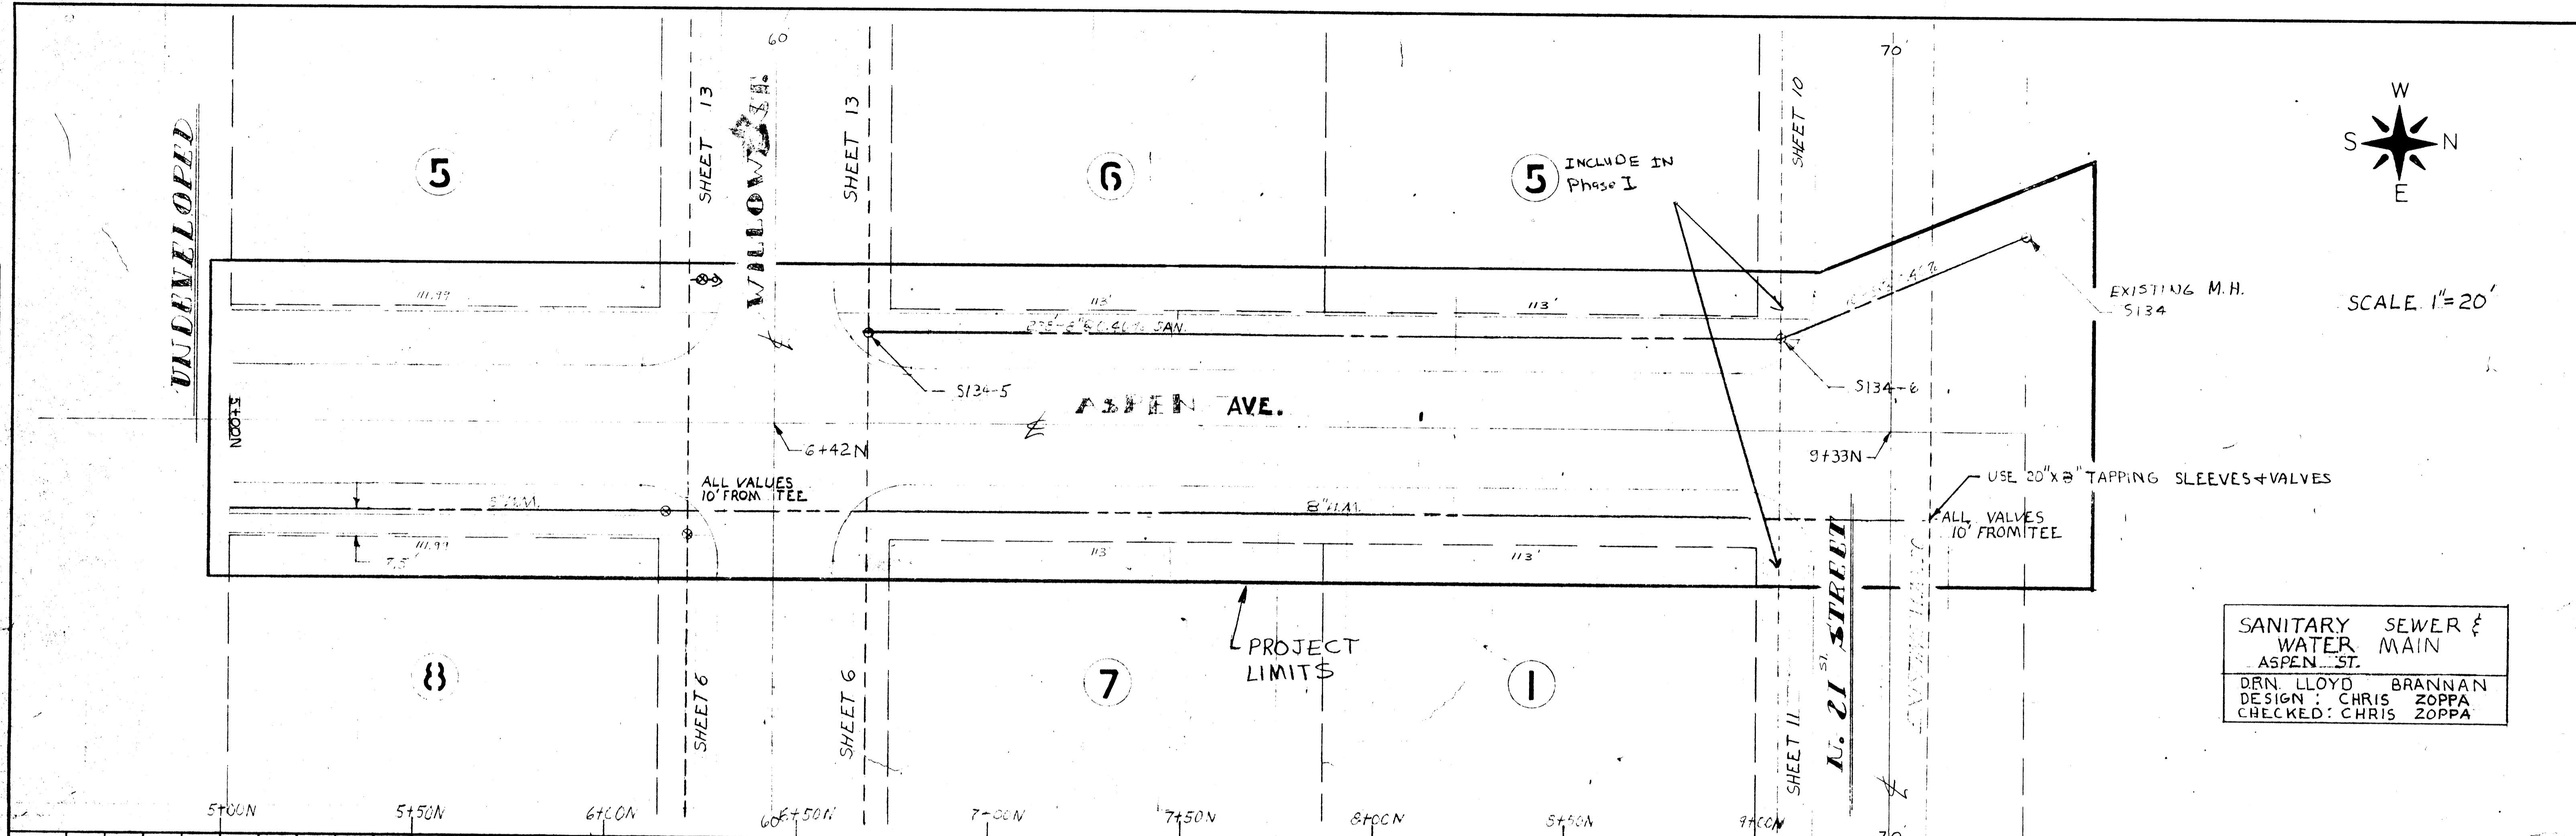

K&E PLATE 1, PLAN/PROFILE
KEUFFEL & ESSER CO.