


13




PLAN SURVEYED, PLOTTED, ALIGNED, CHECKED, BY DATE  
 NOTE BOOK NO. OF W.M. CHECKED

PROFILE SURVEYED, PLOTTED, GRADES CHECKED, BY DATE  
 NOTE BOOK NO. OF W.M. CHECKED


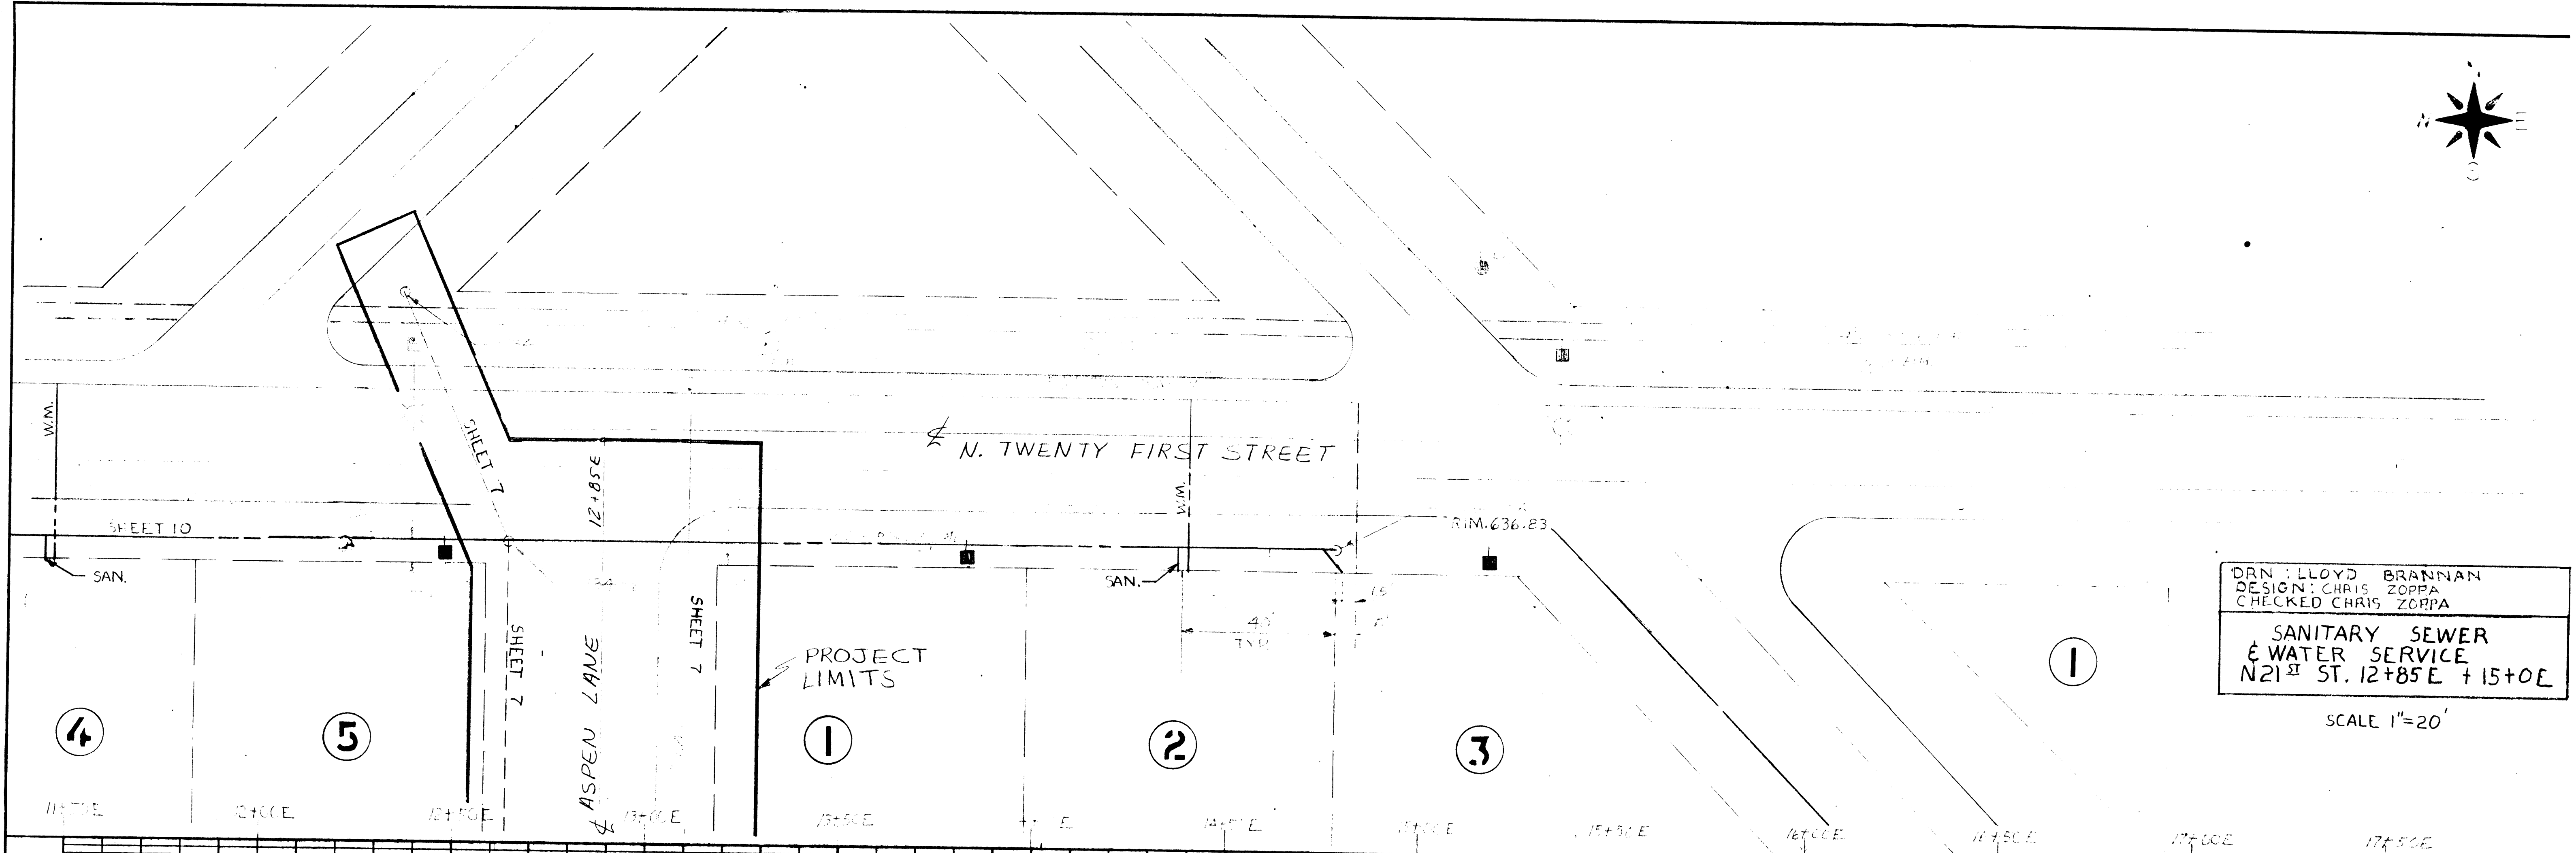


DRN: LLOYD BRANNAN  
 DESIGN: CHRIS ZOPPA  
 CHECKED: CHRIS ZOPPA  
 SANITARY SEWER & WATER SERVICE  
 N 21<sup>ST</sup> ST. 12+85 E + 15+0 E

SCALE 1"=20'

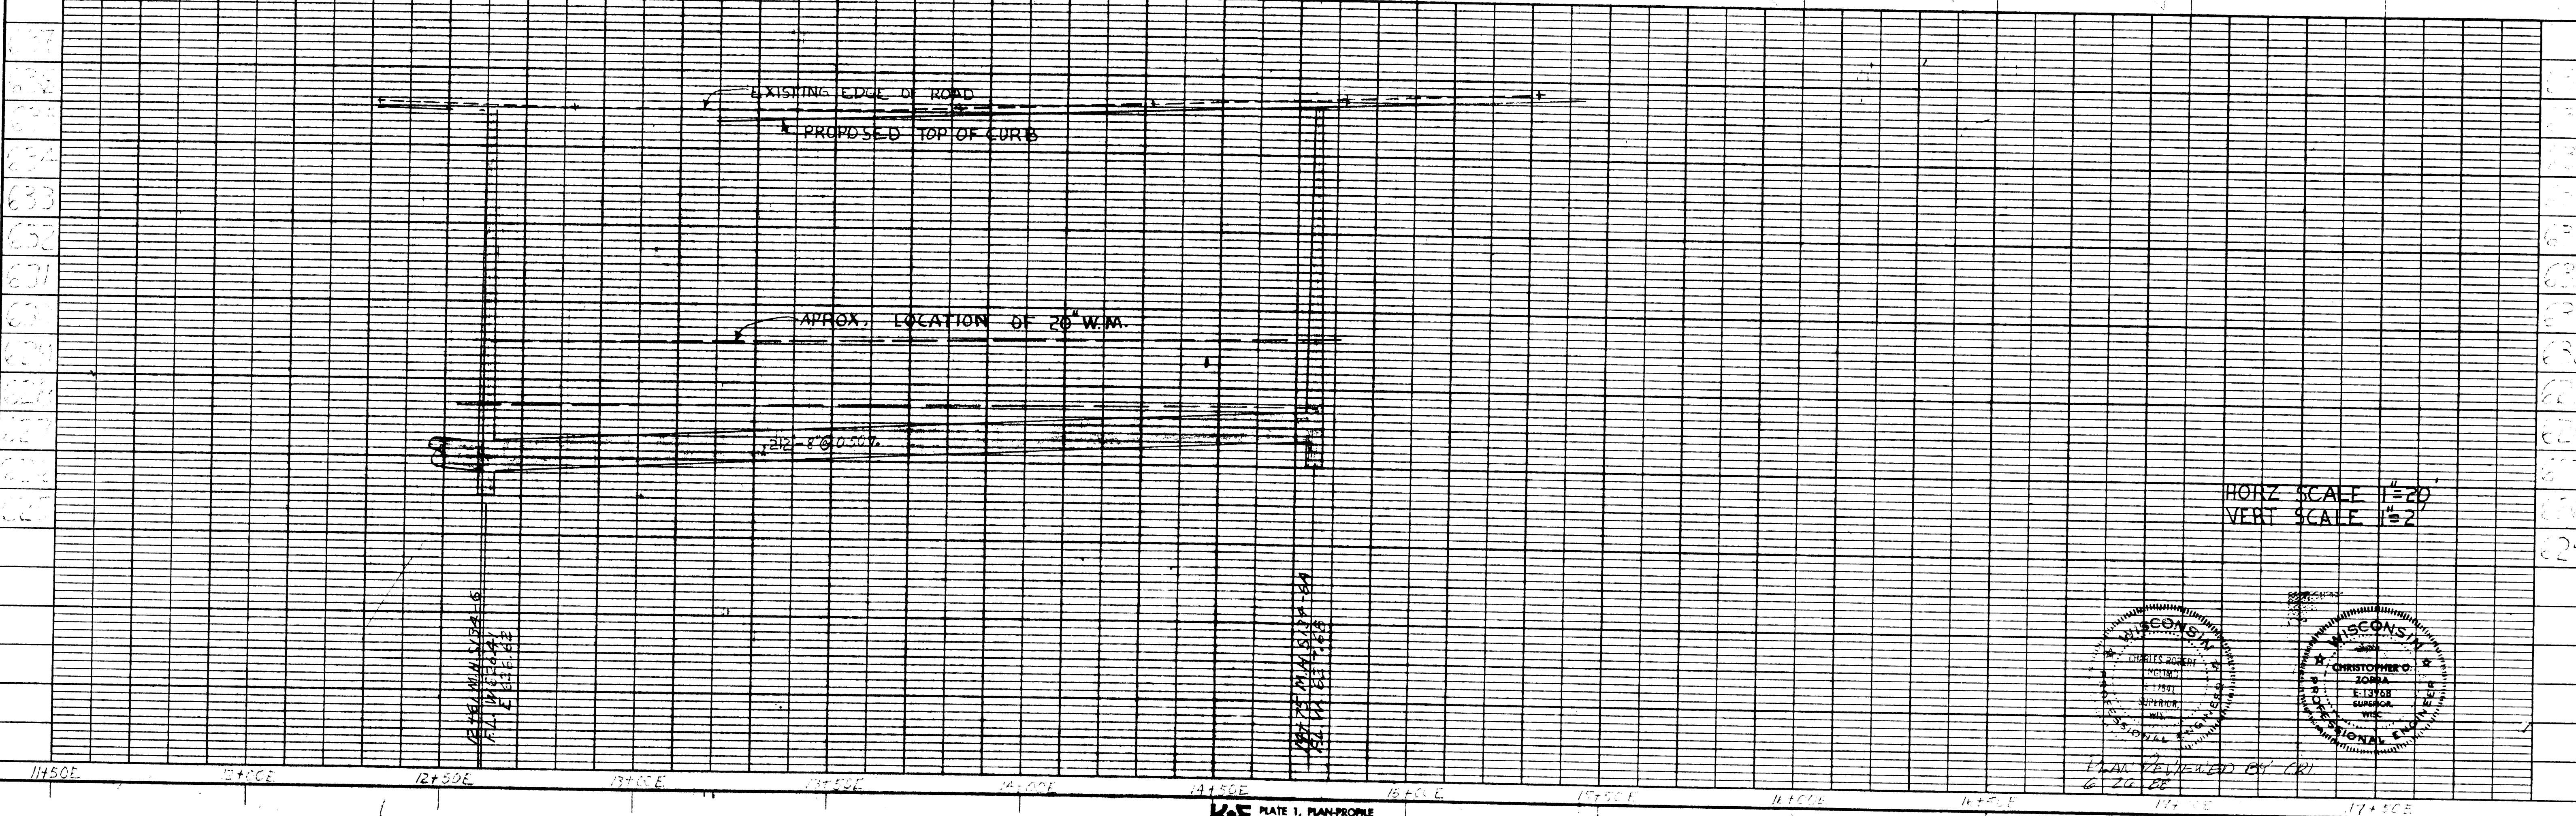

HORIZ SCALE 1"=20'  
 VERT SCALE 1"=2'

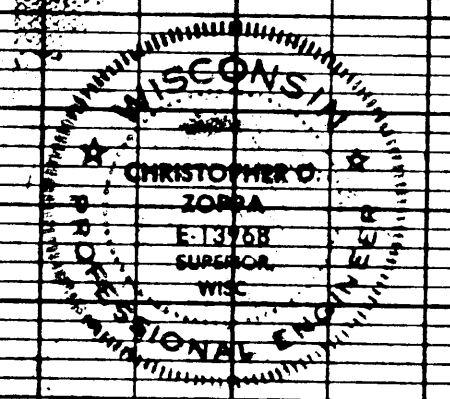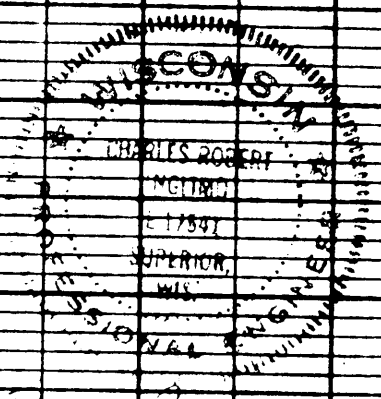

PLAN REVIEWED BY (CR)  
 6/20/00