




STORM SEWER EXTENSION

DRW. D.E. SARCO
DES. C. ZOPPA
CHKD. C. ZOPPA
DATE: 4-16-79

As Built
12-3-79

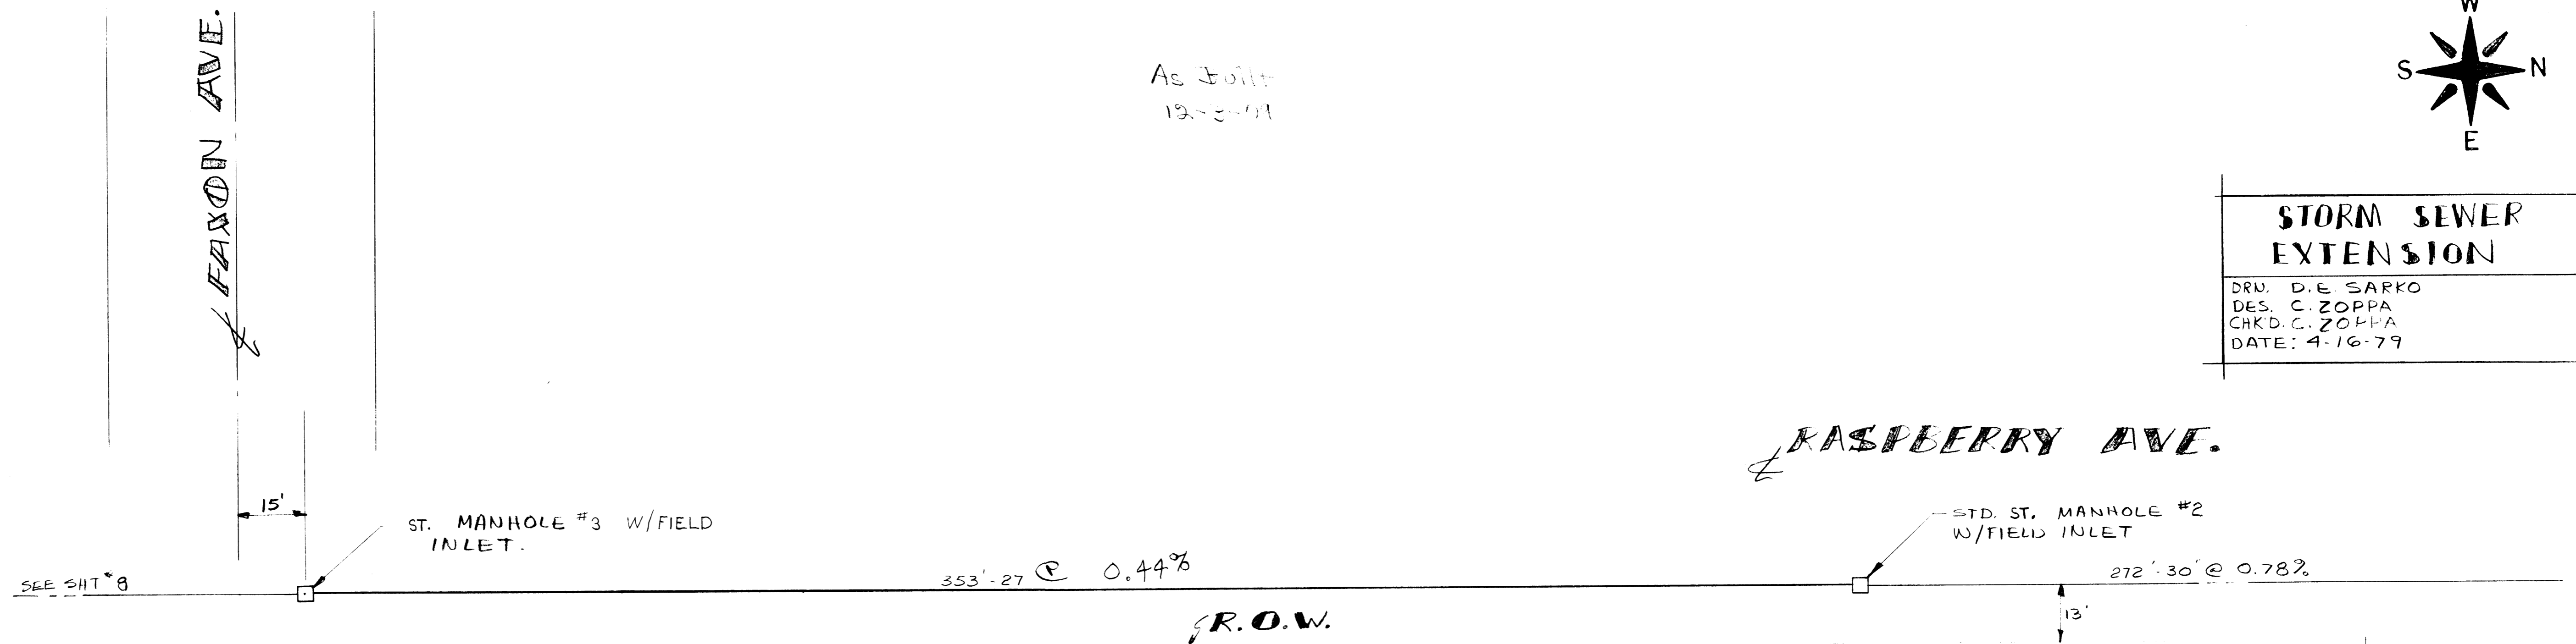


NOTE:
C.A.P. = CORRUGATED ALUMINUM PIPE.

10- RASPBERRY HCPES MANHOLE #1
107 NUMBER
(FOR REFERENCE ONLY)

11+00N 10+50N 10+00N 9+50N 9+00N 8+50E 8+00N 7+50N 7+00N 6+50N

637
636
635
637
636
635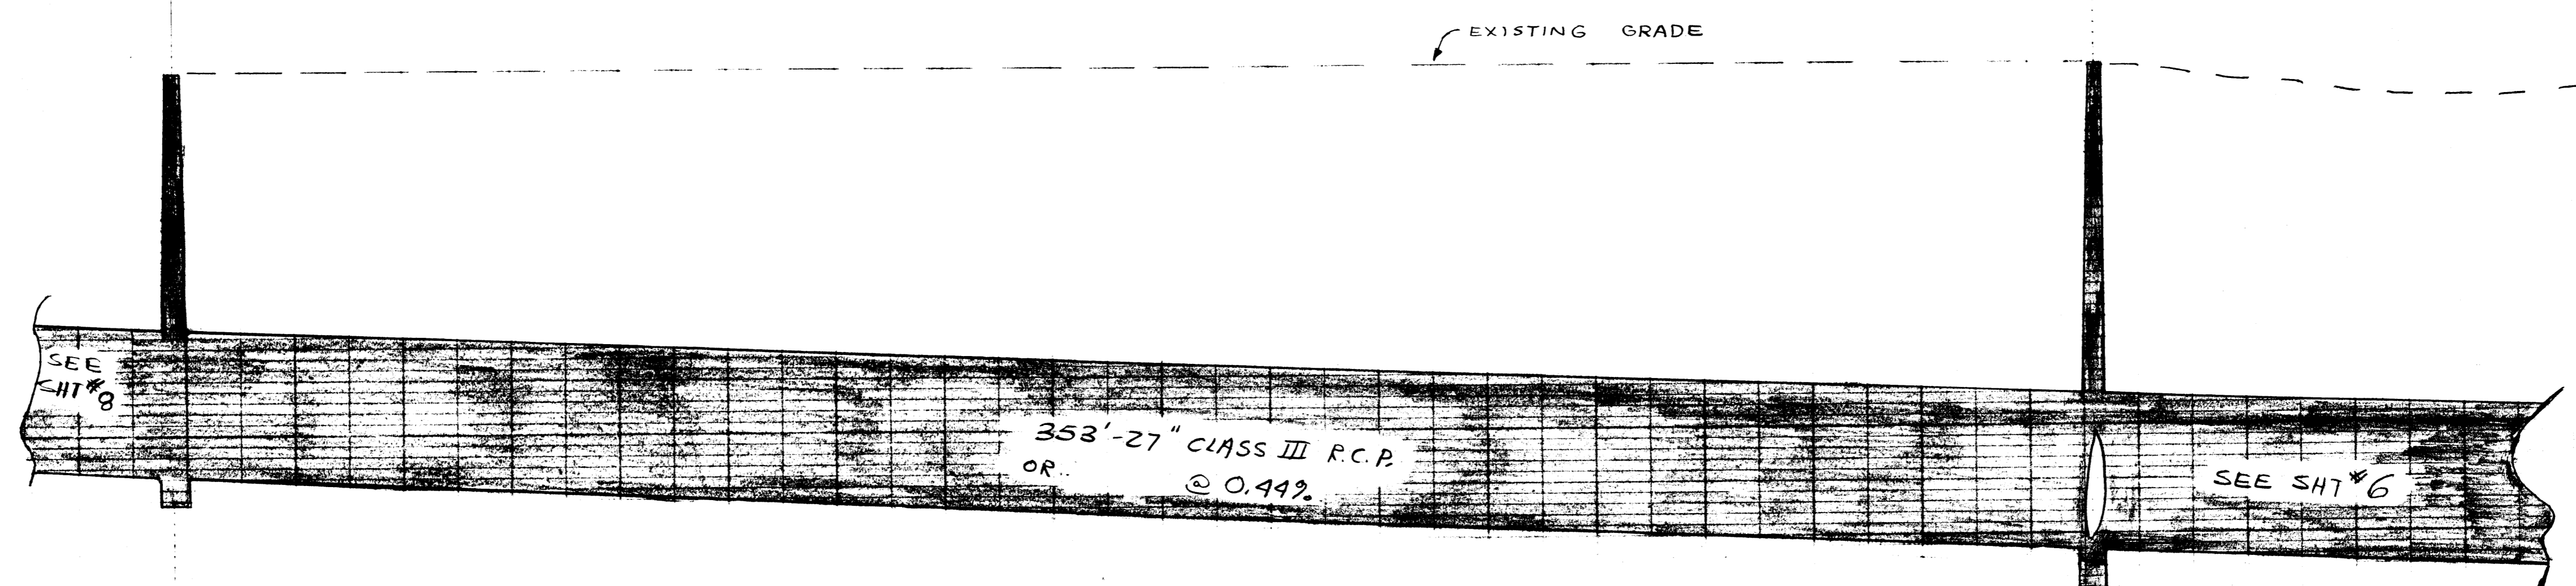
10+53 C.B.3
GRT 626.7
OUT EL. 628.15

6+99 C.B.2
GRT 635.70
OUT EL. 626.57
IN EL. 626.72

HORZ. SCALE 1"=20'
VERT. SCALE 1"=2'