


SUPERIOR, WISCONSIN

DISTRICT 3A-CENTRAL PARK STORM SEWER SEPARATION

AND SANITARY SEWER

1974

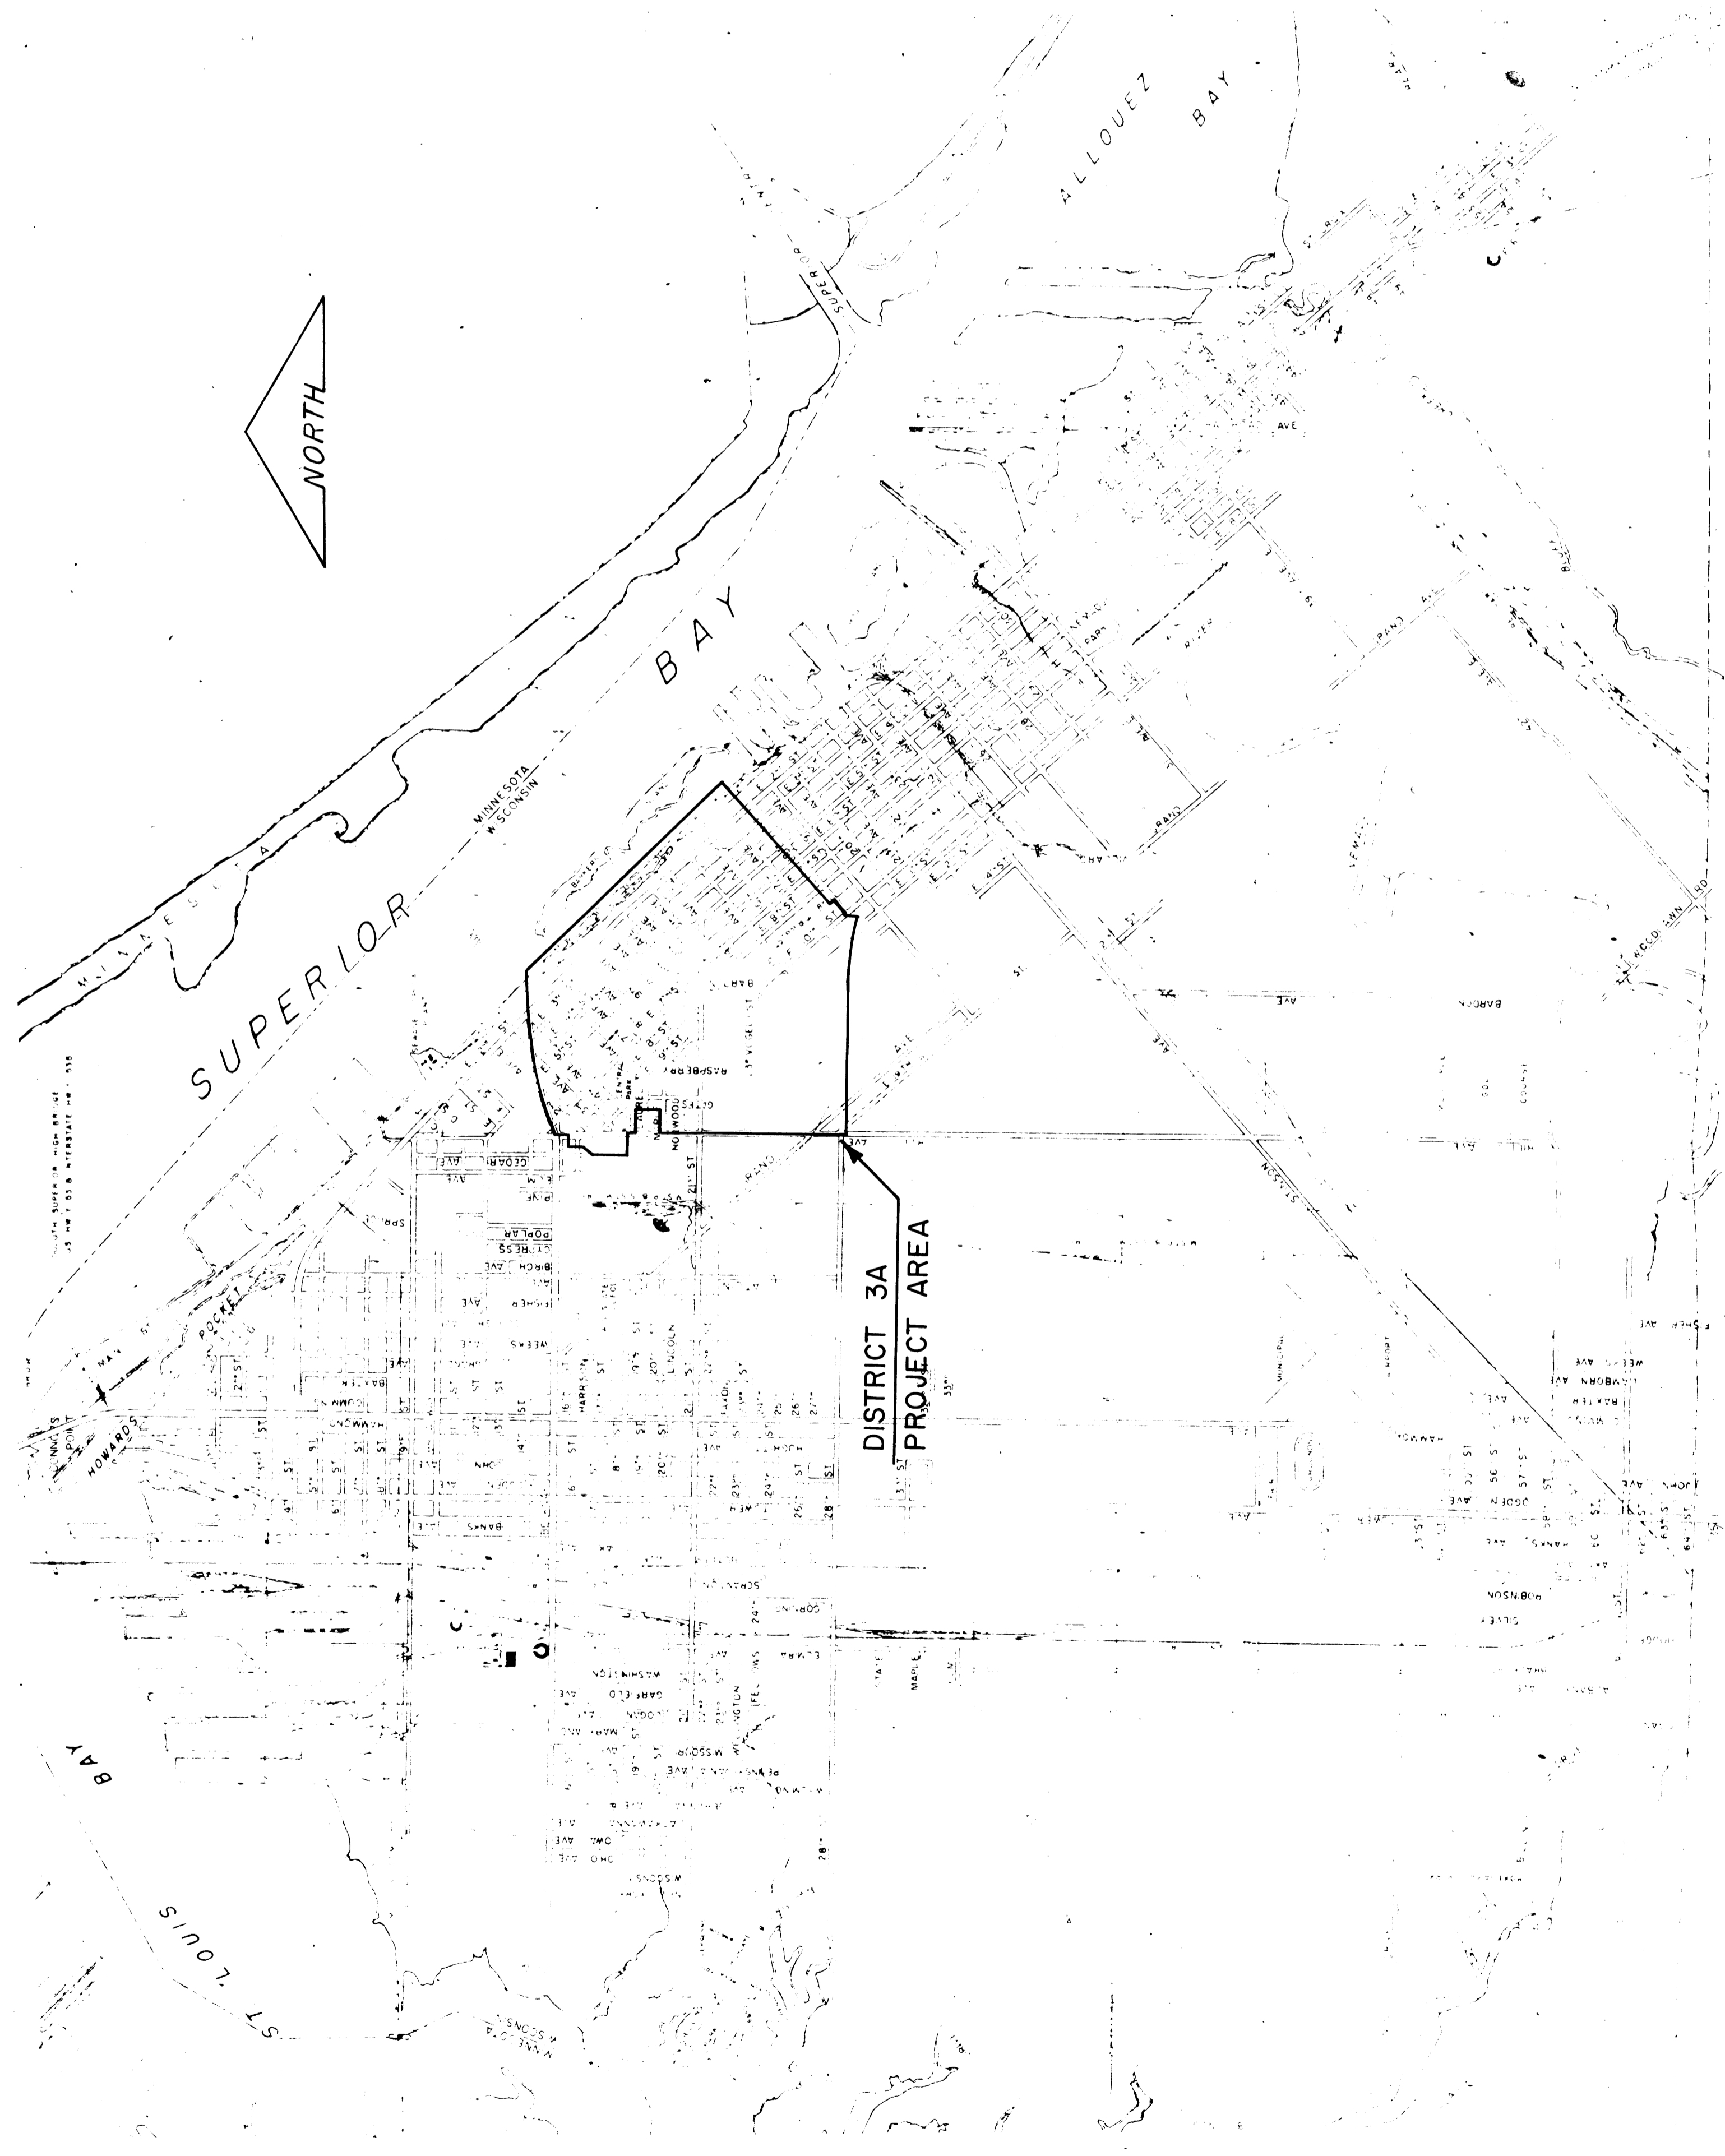

CITY COUNCIL

CHARLES C. DENEWETH	MAYOR
THOMAS P. STROOZAS, JR.	COUNCILMAN
ROBERT DIMONSAU	COUNCILMAN
CARL DAHLIN	COUNCILMAN
HERBERT C. WALLIN	COUNCILMAN
LOWELL W. BANKS	COUNCILMAN
PATRICIA PAQUETTE	COUNCILWOMAN
THOMAS J. GODFREY	COUNCILMAN
JAMES McHUGH	COUNCILMAN
JAMES E. JOHNSON	COUNCILMAN
KITCHENER THOMPSON	COUNCILMAN
WILLIAM A. HAMMANN	CITY ATTORNEY
FRED M. SEGUIN	PUBLIC WORKS DIRECTOR
GEORGE HOWELL	CITY PLANNER

LOCATION PLAN

Scale: 1"=2,000'

SURVEY DRAWN BY APPROVED BY	M.S. L.S.B. E.S.C.	RECORD DATE 11/30/77	PLAN HBR	BOESTDORF, ROSENE, AMERLIK & ASSOC., INC. ST. PAUL, MINNESOTA	SUPERIOR, WISCONSIN DATE: MAY 1, 1974 COMM. 8888 I	DISTRICT 3A-CENTRAL PARK STORM SEWER SEPARATION & SANITARY SEWER 1974
					Storm Sewer Separation - District 3A - Central Park	28