


Section of 15 in. Reinforced Concrete Pipe

NOTE: Relaid To Increase Pipe Size See Original, Page 15

### CITY OF SUPERIOR SEWER PLAN

Horizontal Scale: 1 in. = 60 ft.  
 Vertical Scale: 1 in. = 4 ft.  
 Job Started Feb. 1, 1936  
 Job Completed July 9, 1936  
 W. P. A. Labor  
 R. H. Dann Inspector  
 L. W. Peleske City Engineer

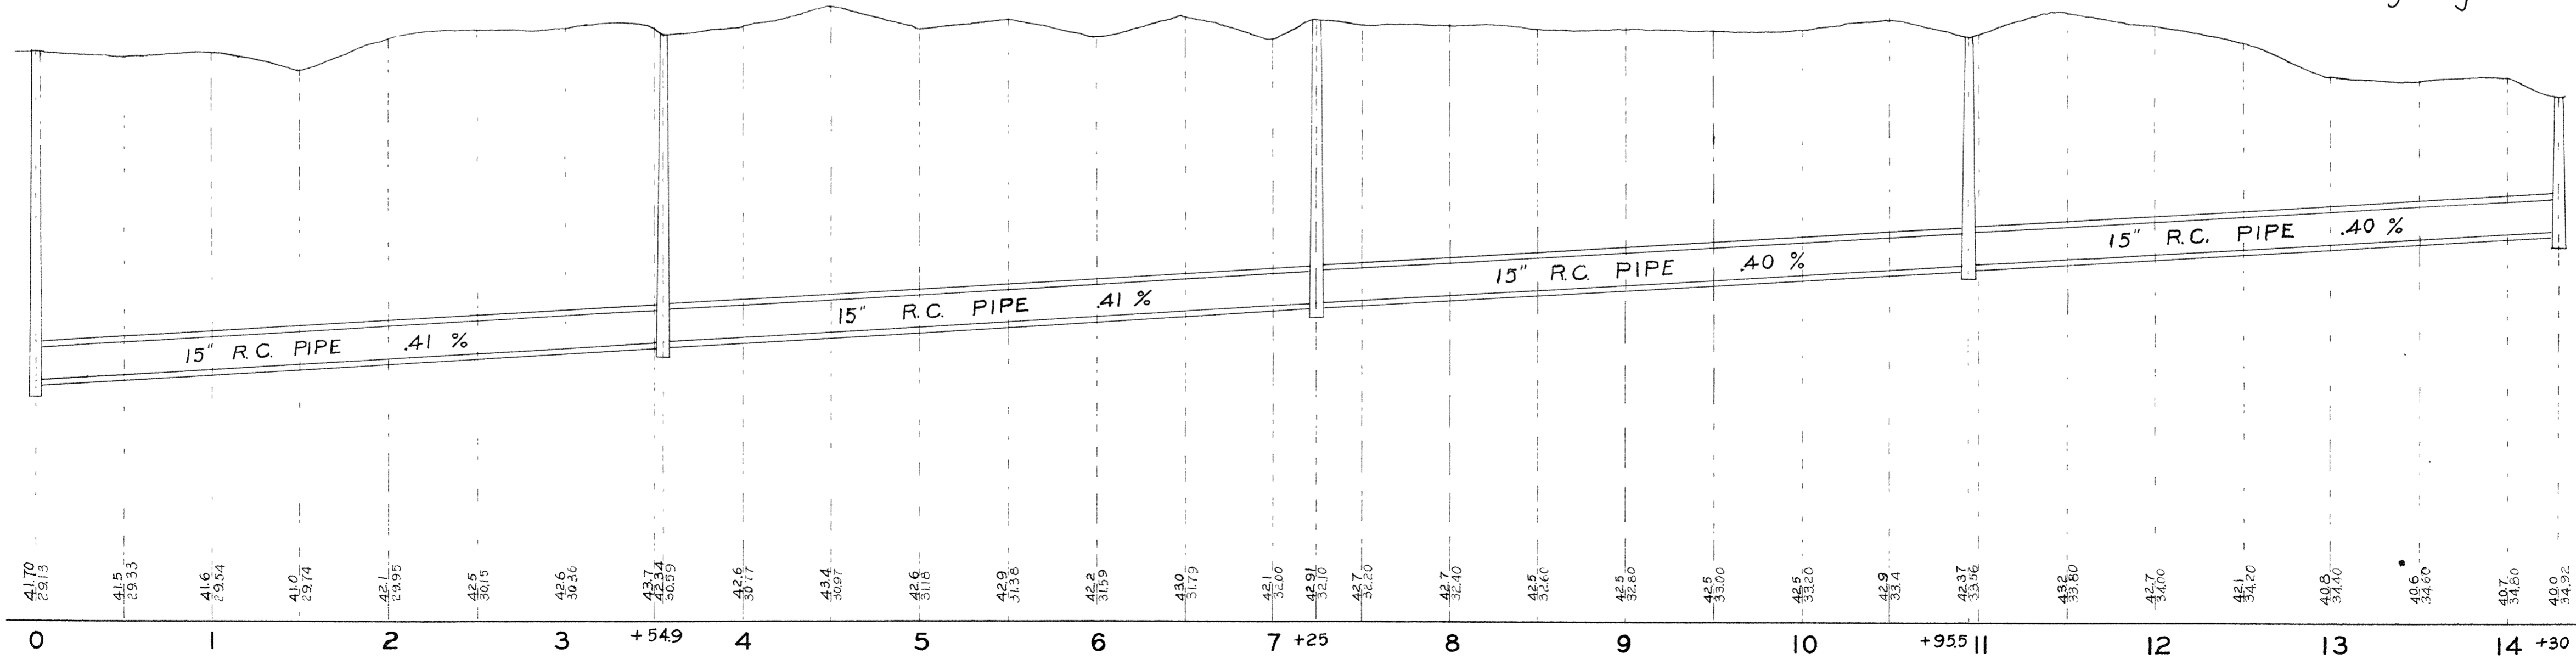

Base Line 20 ft Above City Datum

PLAN & PROFILE OF SEWER IN ALLEY BET. FAXON & 22<sup>ND</sup> ST. FROM FISHER TO BAXTER AVE.

3B-15A