

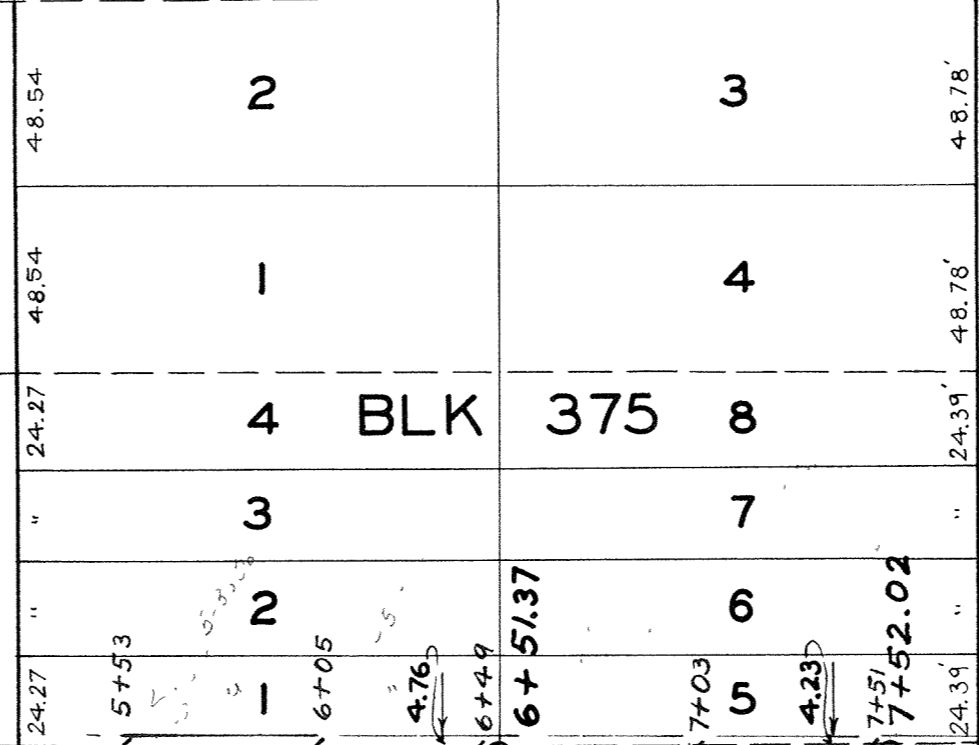
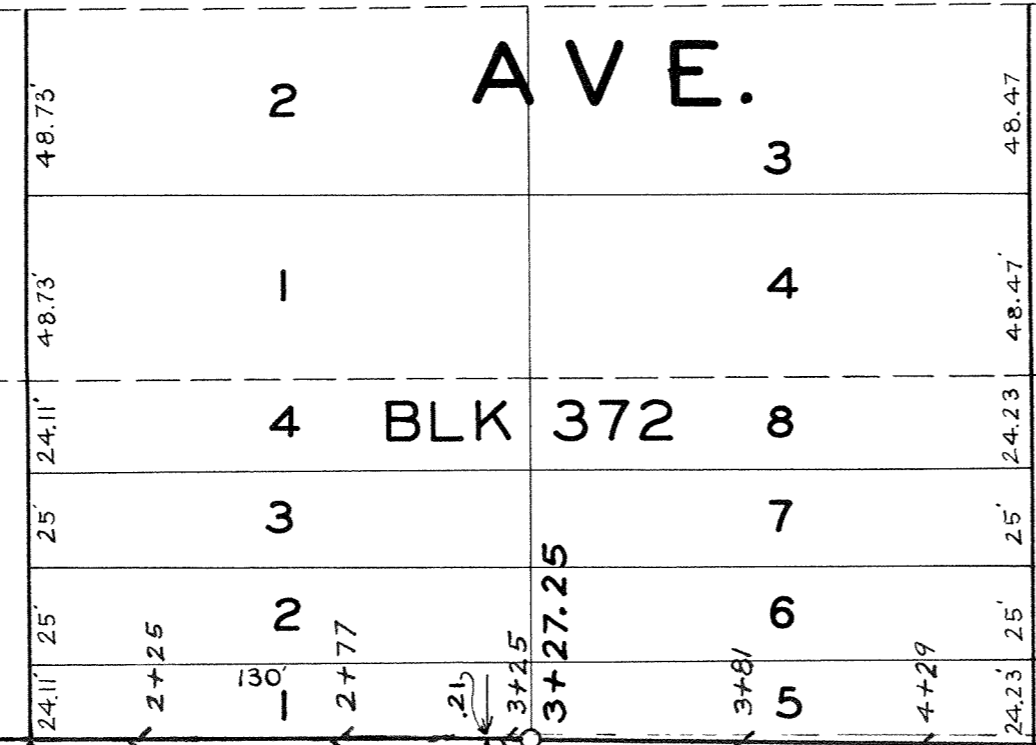


CUMMING


AVE.

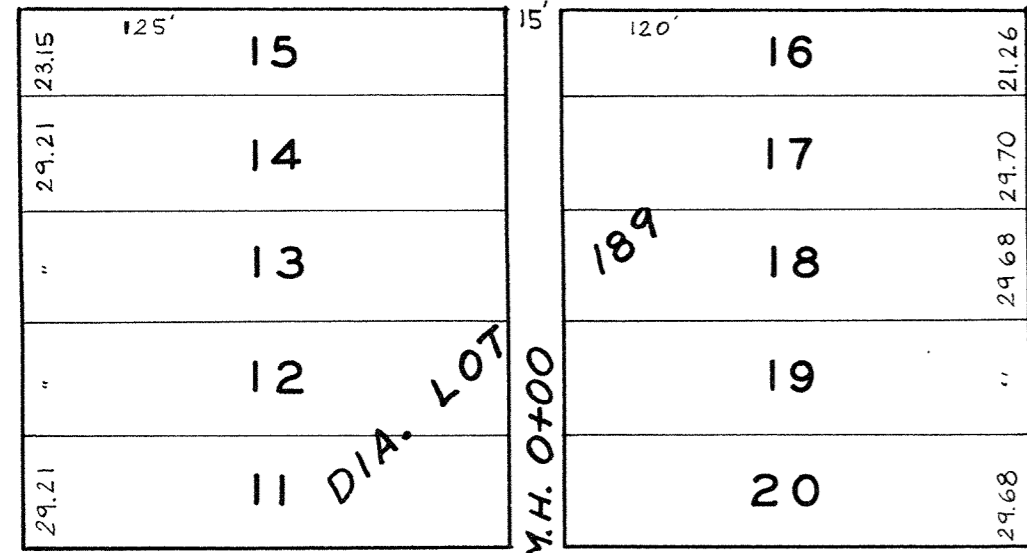


25<sup>TH</sup> ST.

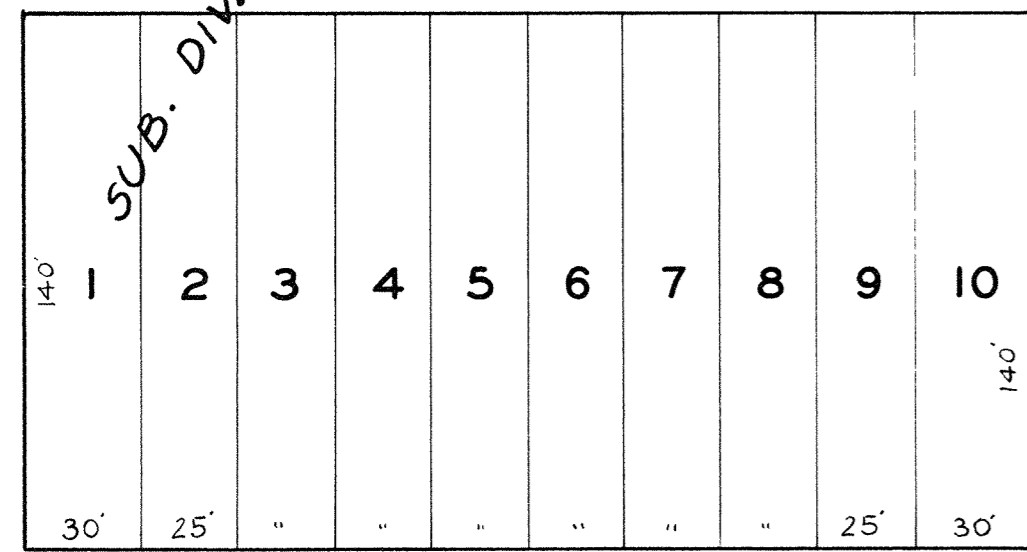

26<sup>TH</sup> ST.

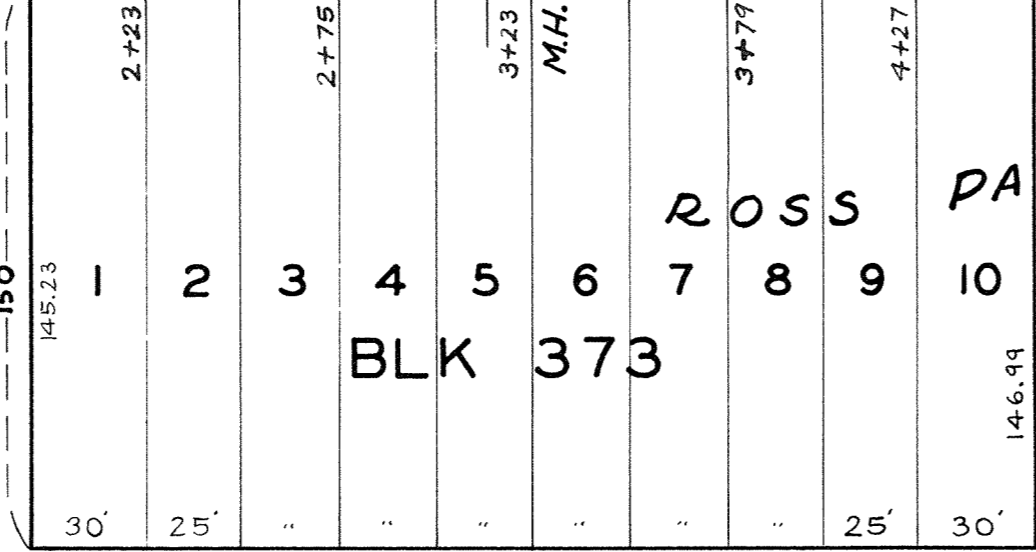


27<sup>TH</sup> ST.

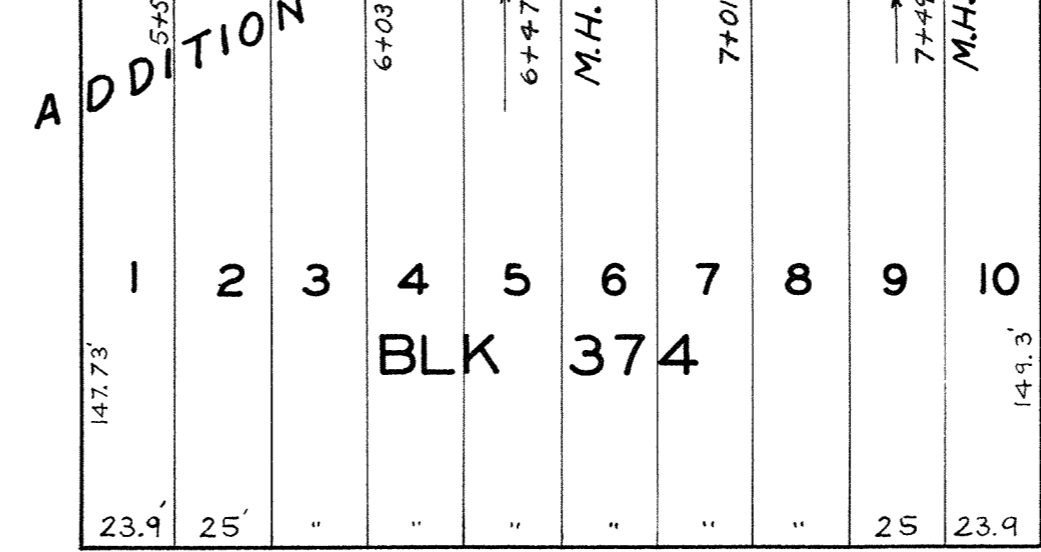

28<sup>TH</sup> ST.

HAMMOND

AVE.

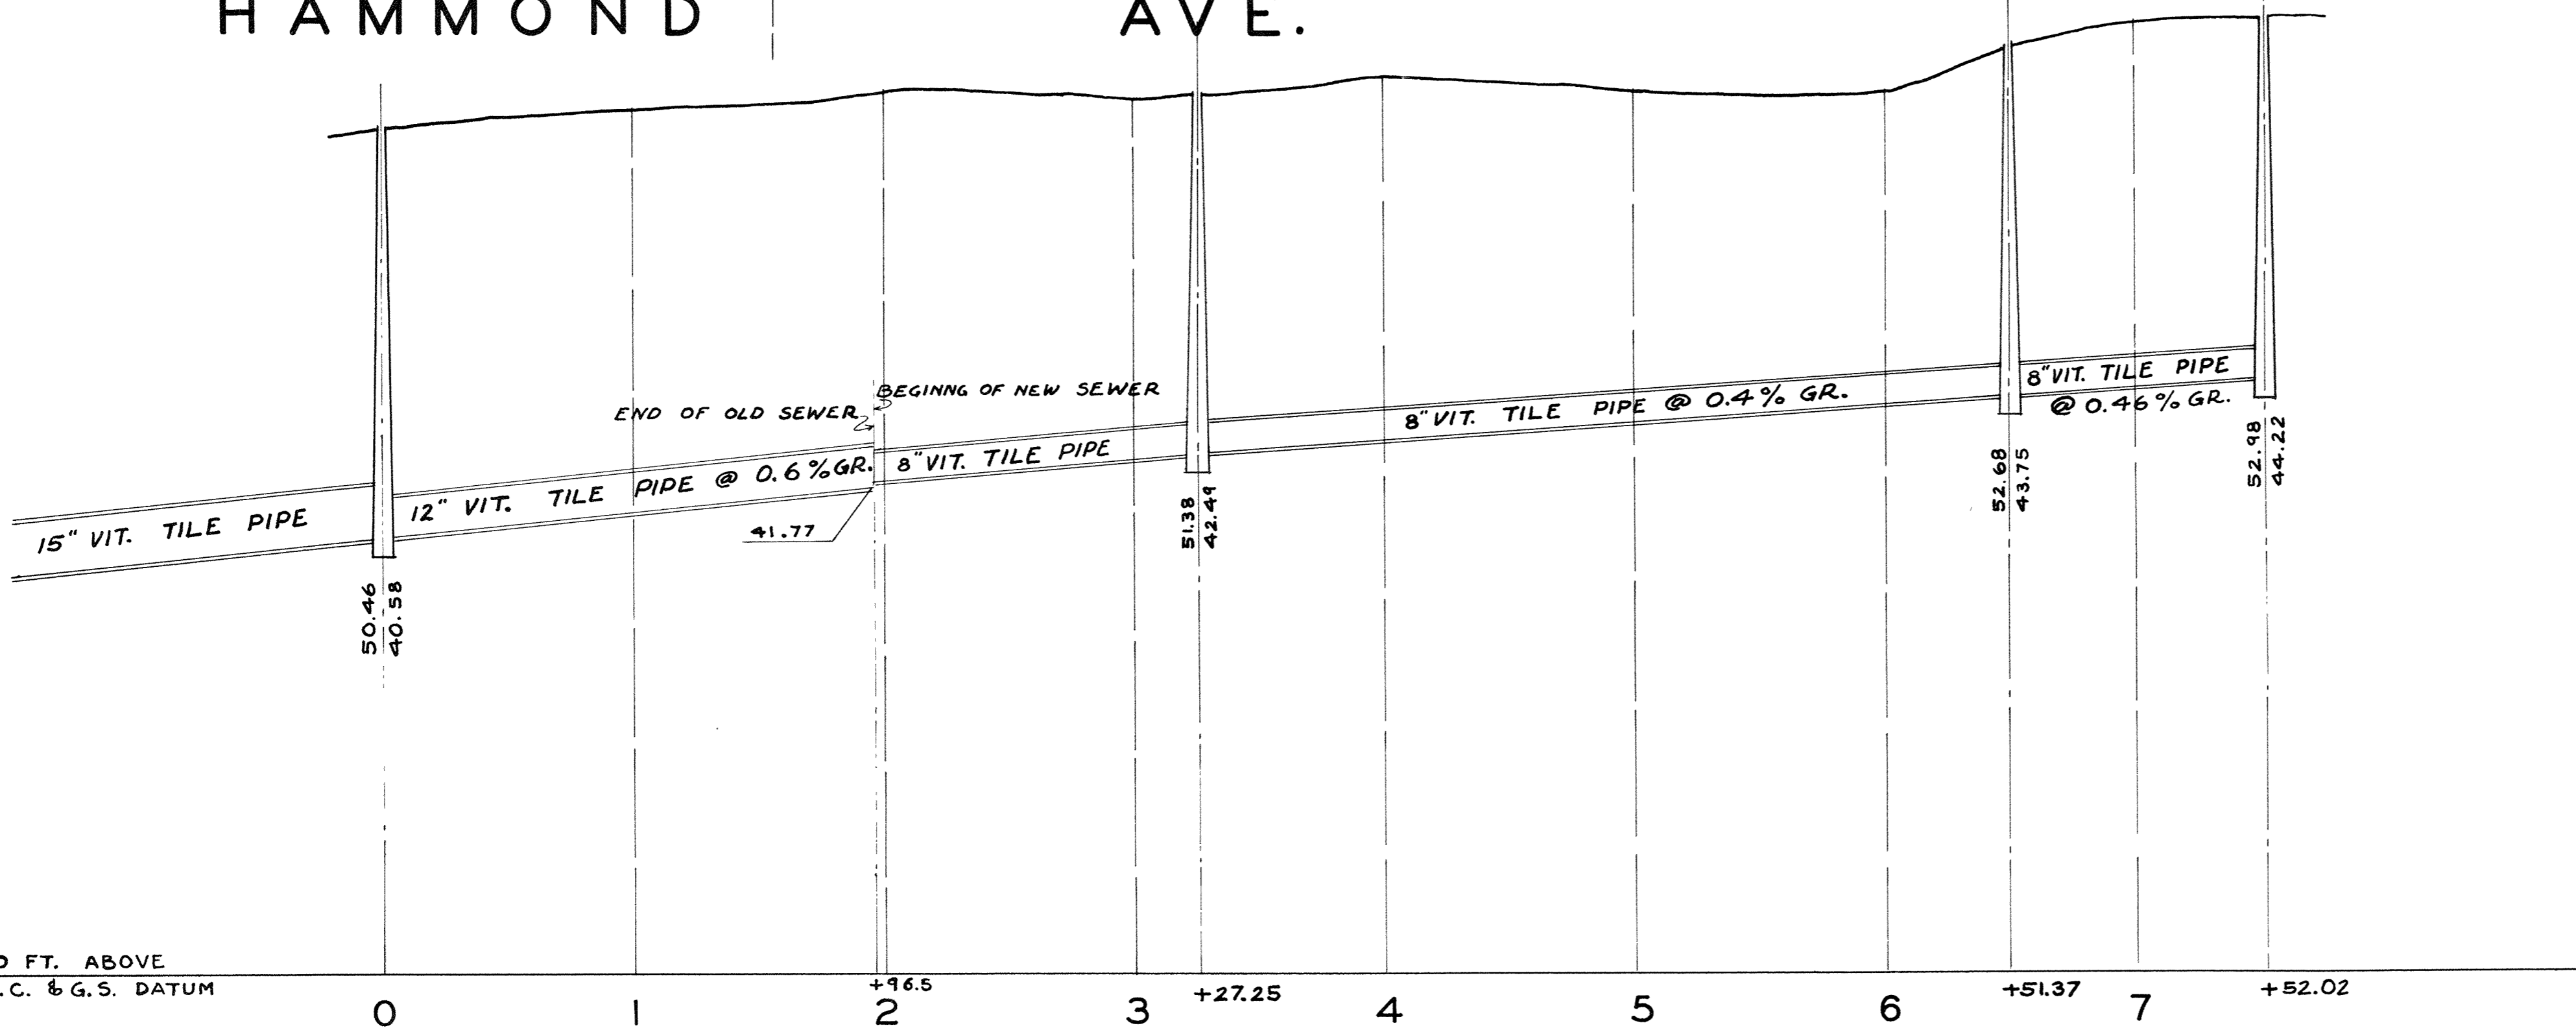

CITY OF SUPERIOR  
 PLAN AND PROFILE OF  
**SAN. SEWER EXTENSION**  
 WORKS PROGRESS ADM. W.P. NO. 9540  
 JOB STARTED  
 JOB COMPLETED  
 HORIZONTAL SCALE 1" = 50'  
 VERTICAL SCALE 1" = 3'  
 SANITARY ENGINEER H. DANN  
 CITY ENGINEER T. M. BASTERASH

3B-17