


CITY OF SUPERIOR
SANITARY SEWER DIST. 3B
 JOB COMPLETED AUG. 1964
 CITY ENGINEER E. W. BERG
 CONTRACTOR BUILDERS SUPPLY CO.
 HORIZONTAL SCALE 1" = 60'
 VERTICAL SCALE 1" = 4'

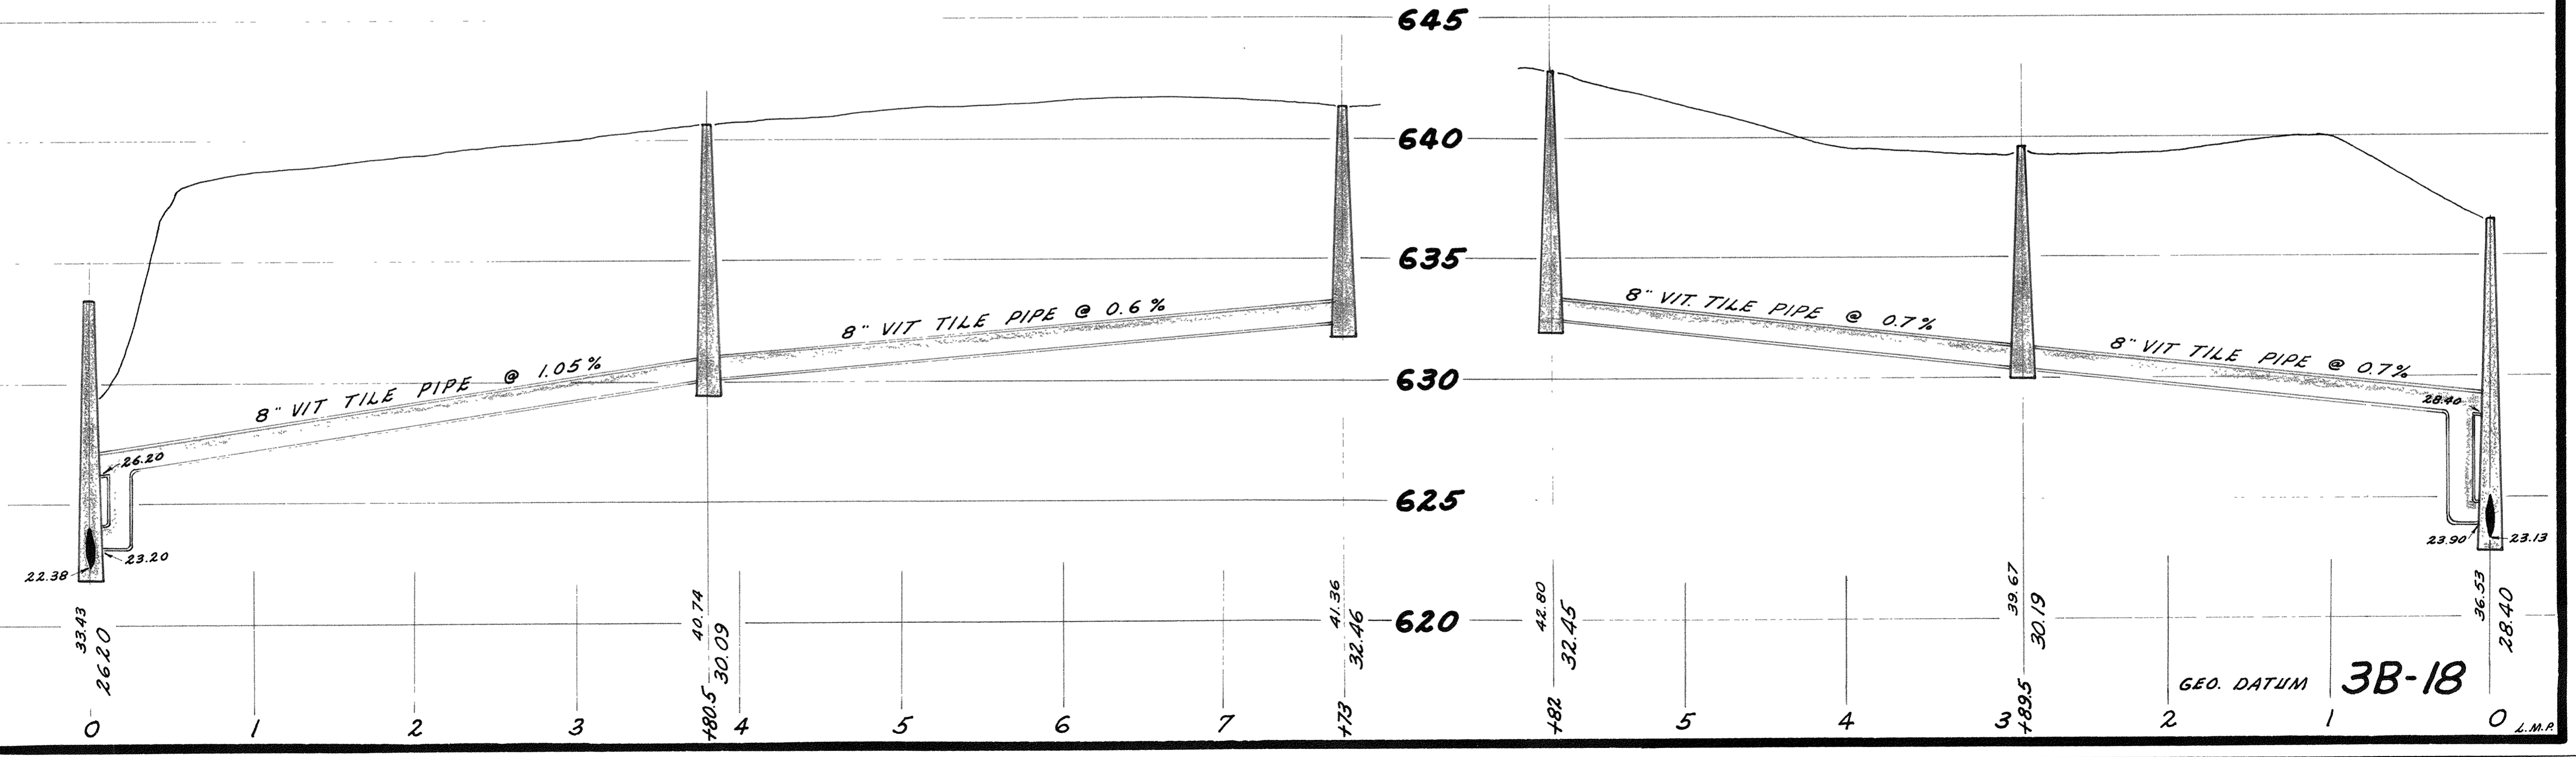

GEO. DATUM **3B-18**