
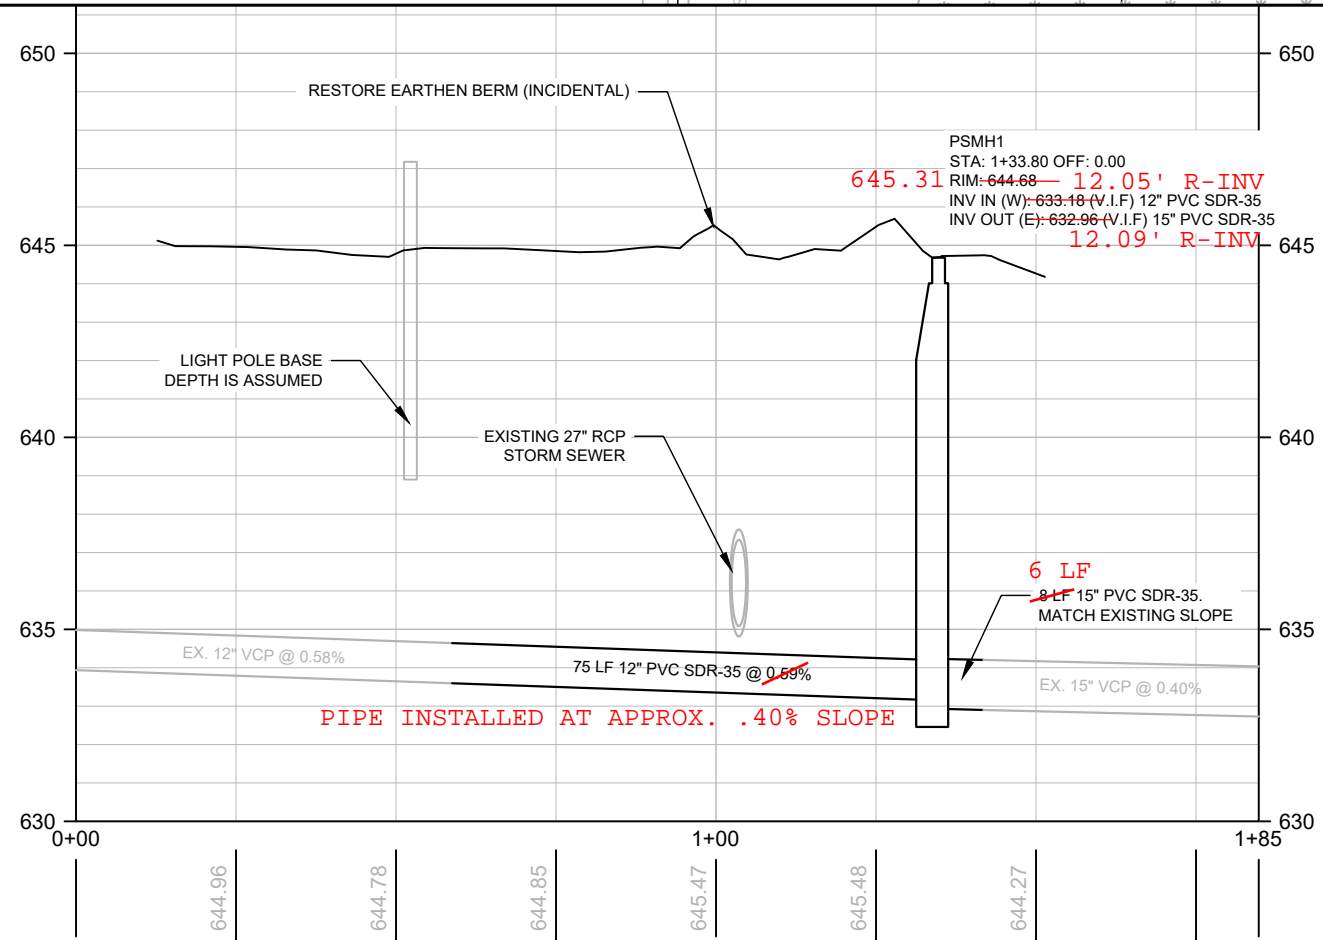


ELECTRIC NEVER FOUND

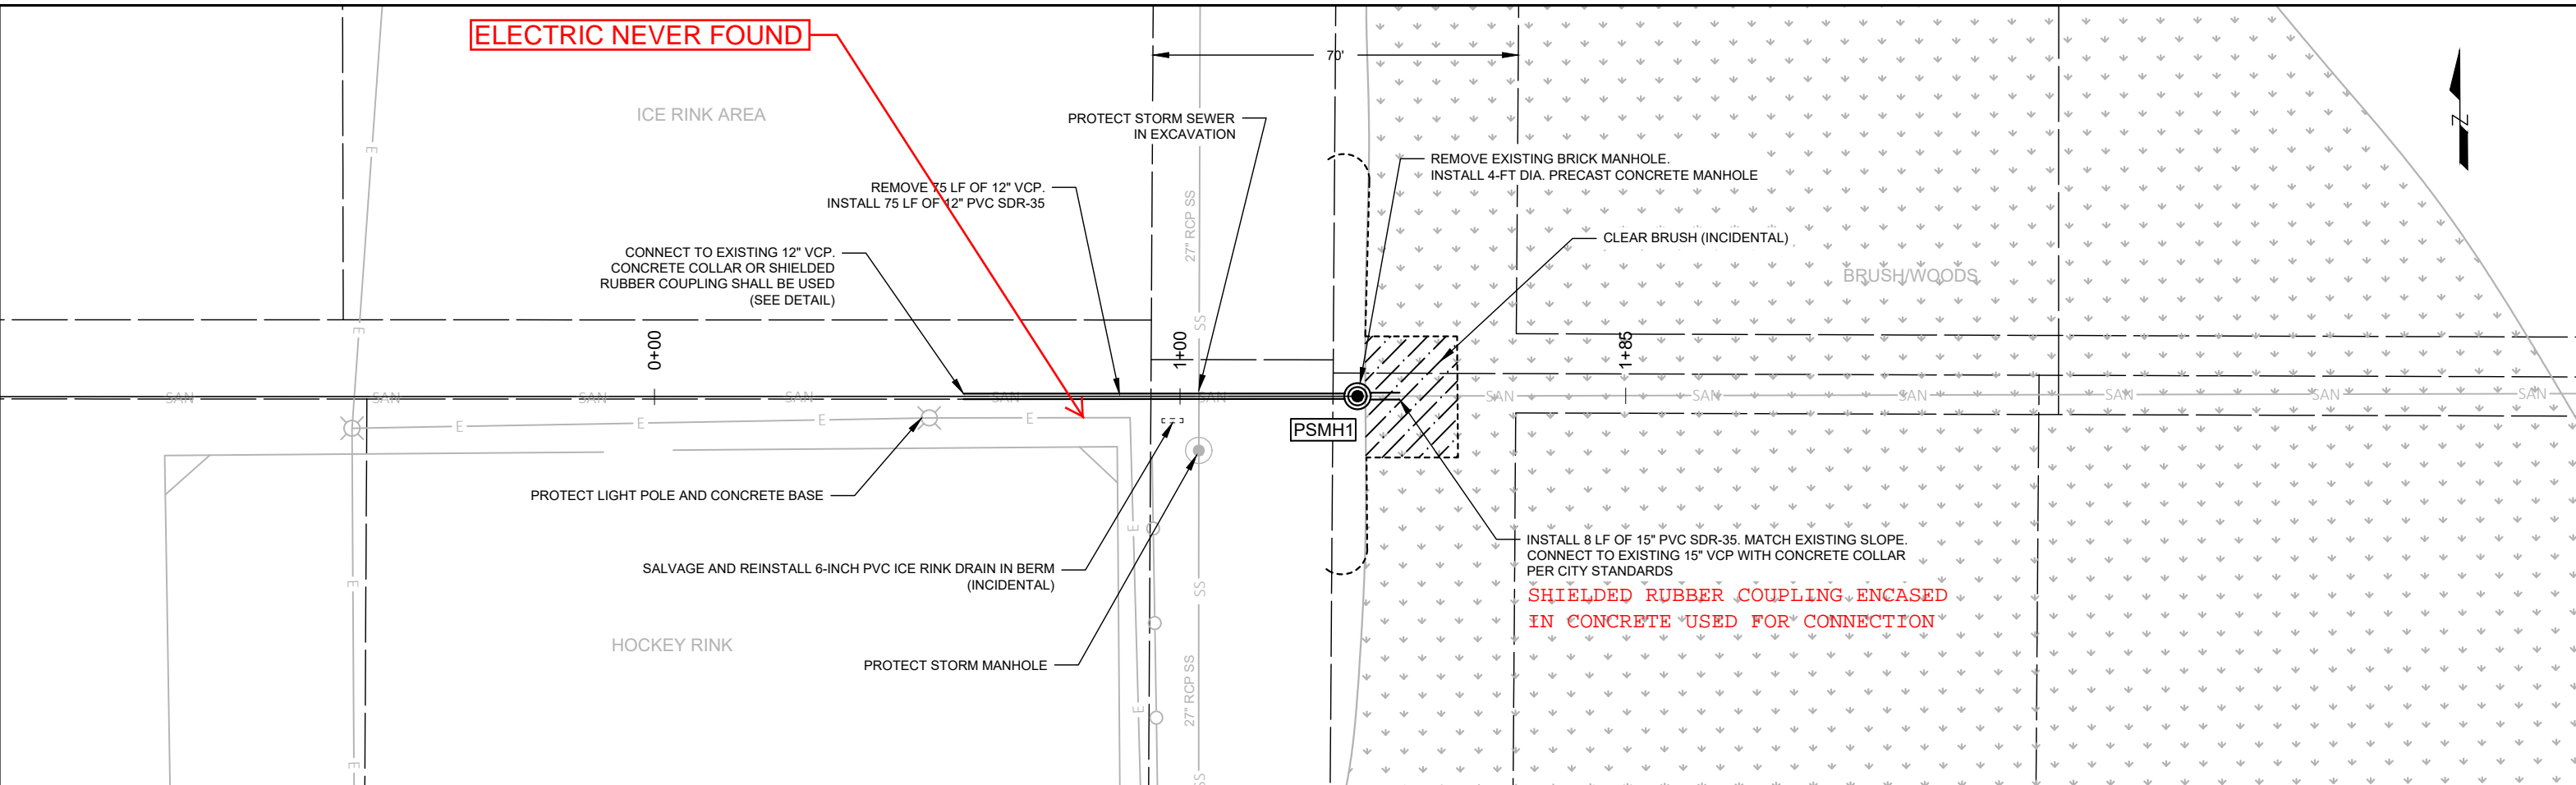

STRUCTURE TABLE			
STRUCTURE	DETAILS	TYPE/COVER	LOCATION
PSMH1	RIM = 644.68 645.31 INV IN (W) = 633.18 (FIELD VERIFY) INV OUT (E) = 632.96 (FIELD VERIFY)	4-FT DIA. MH/ SOLID COVER	1+33.80 0.0

633.26
633.22

**PROJECT COMPLETED
JULY 2020**