


BENCH MARKS			
NO.	STA.	DESCRIPTION	ELEV.
1	0+00	RIM OF MANHOLE	637.04

N. 22ND ST.

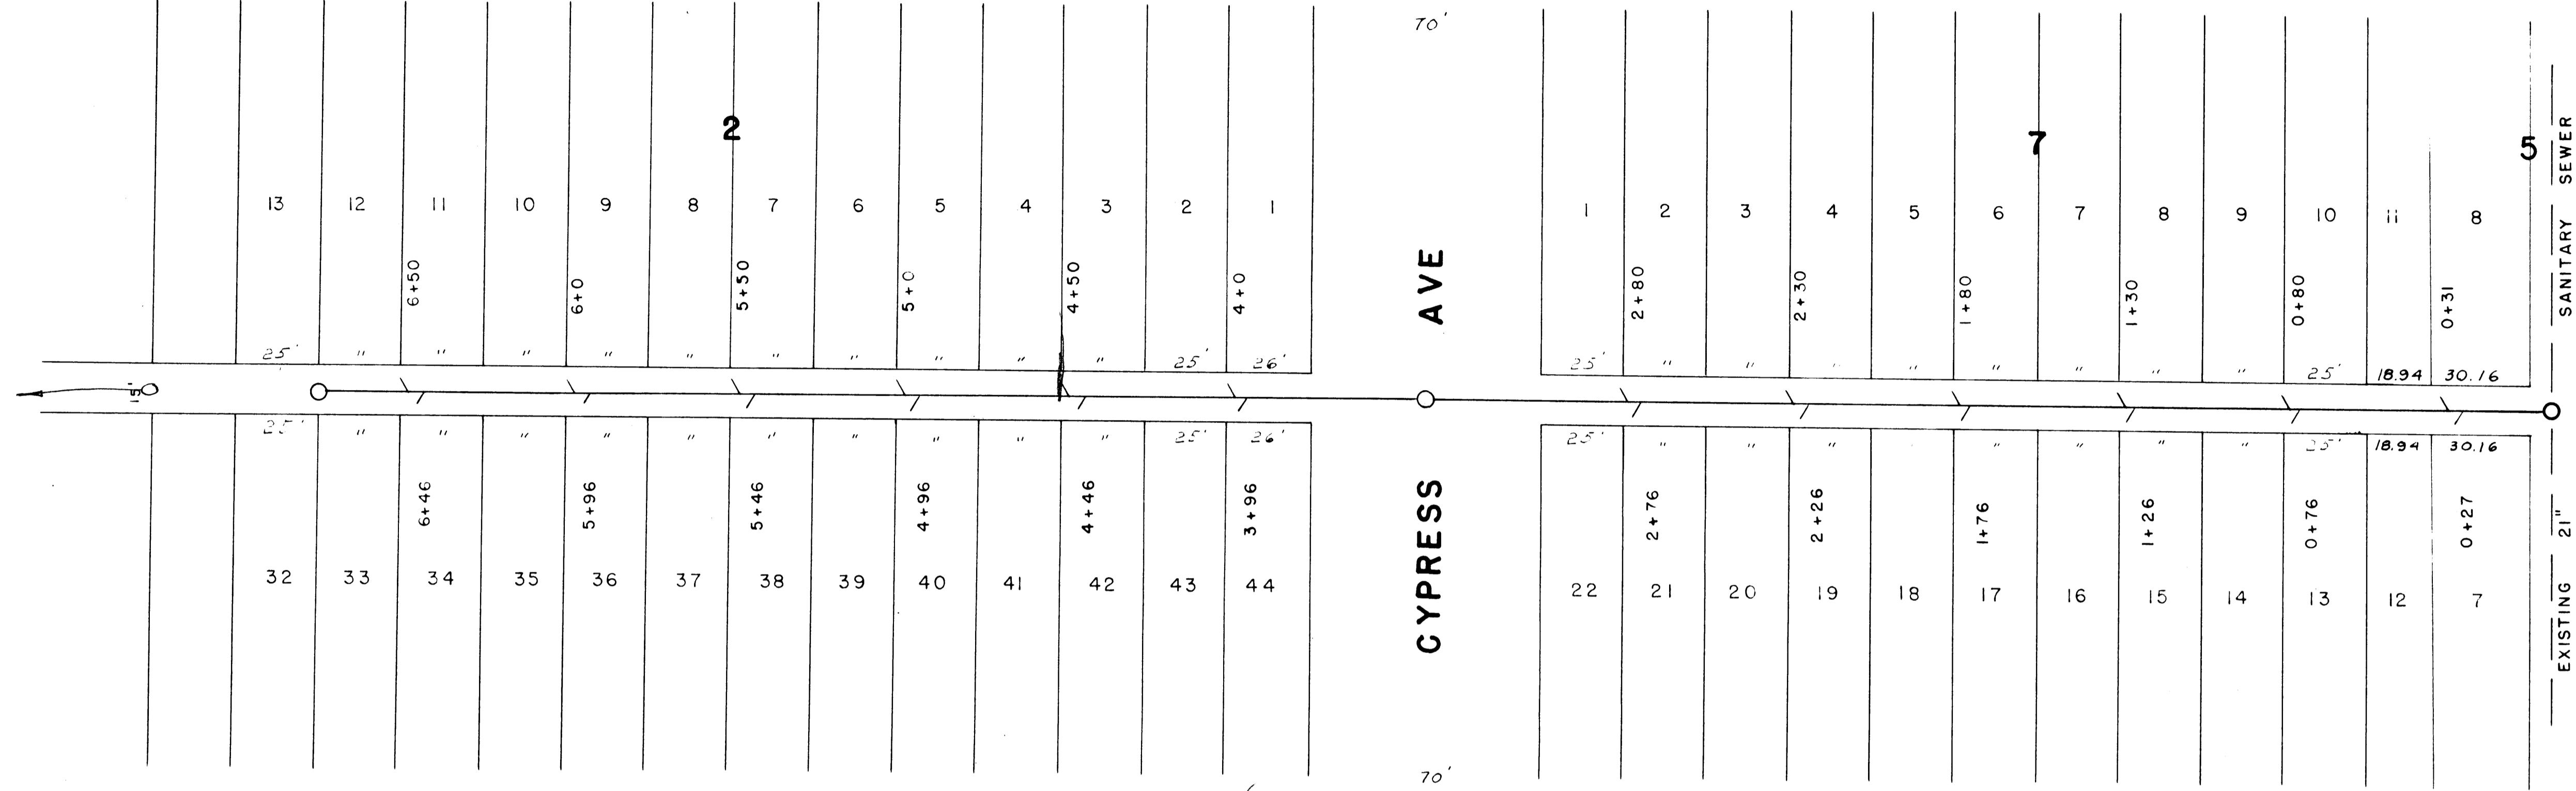


Dissected Benefits Revised
Approx. according to Bid
FMS 5-3-60

CITY OF SUPERIOR ENGINEERING DEPARTMENT			
PROPOSED EXT. SAN. SEWER			
BLK. 2 & 7 NORMAL VIEW ADD.			
BLK. 5 SCHROEDER PARK			
L.M. HAGEN	MAYOR		
E.W. BERG	CITY ENGINEER		
DES.	F.M.S.	APPD.	FILE NO.
DRN.	G.C.W.	<i>EvB</i>	
DATE	1-12-60 SCALE 1" = 30'		

$$\begin{array}{r} 37.04 \\ 30.25 \\ \hline 6.80 \end{array}$$

$$\begin{array}{r} 31.5 \\ 32.2 \\ \hline 4.25 \end{array}$$

$$\begin{array}{r} 34.6 \\ 11 \\ \hline 452.6 \end{array}$$

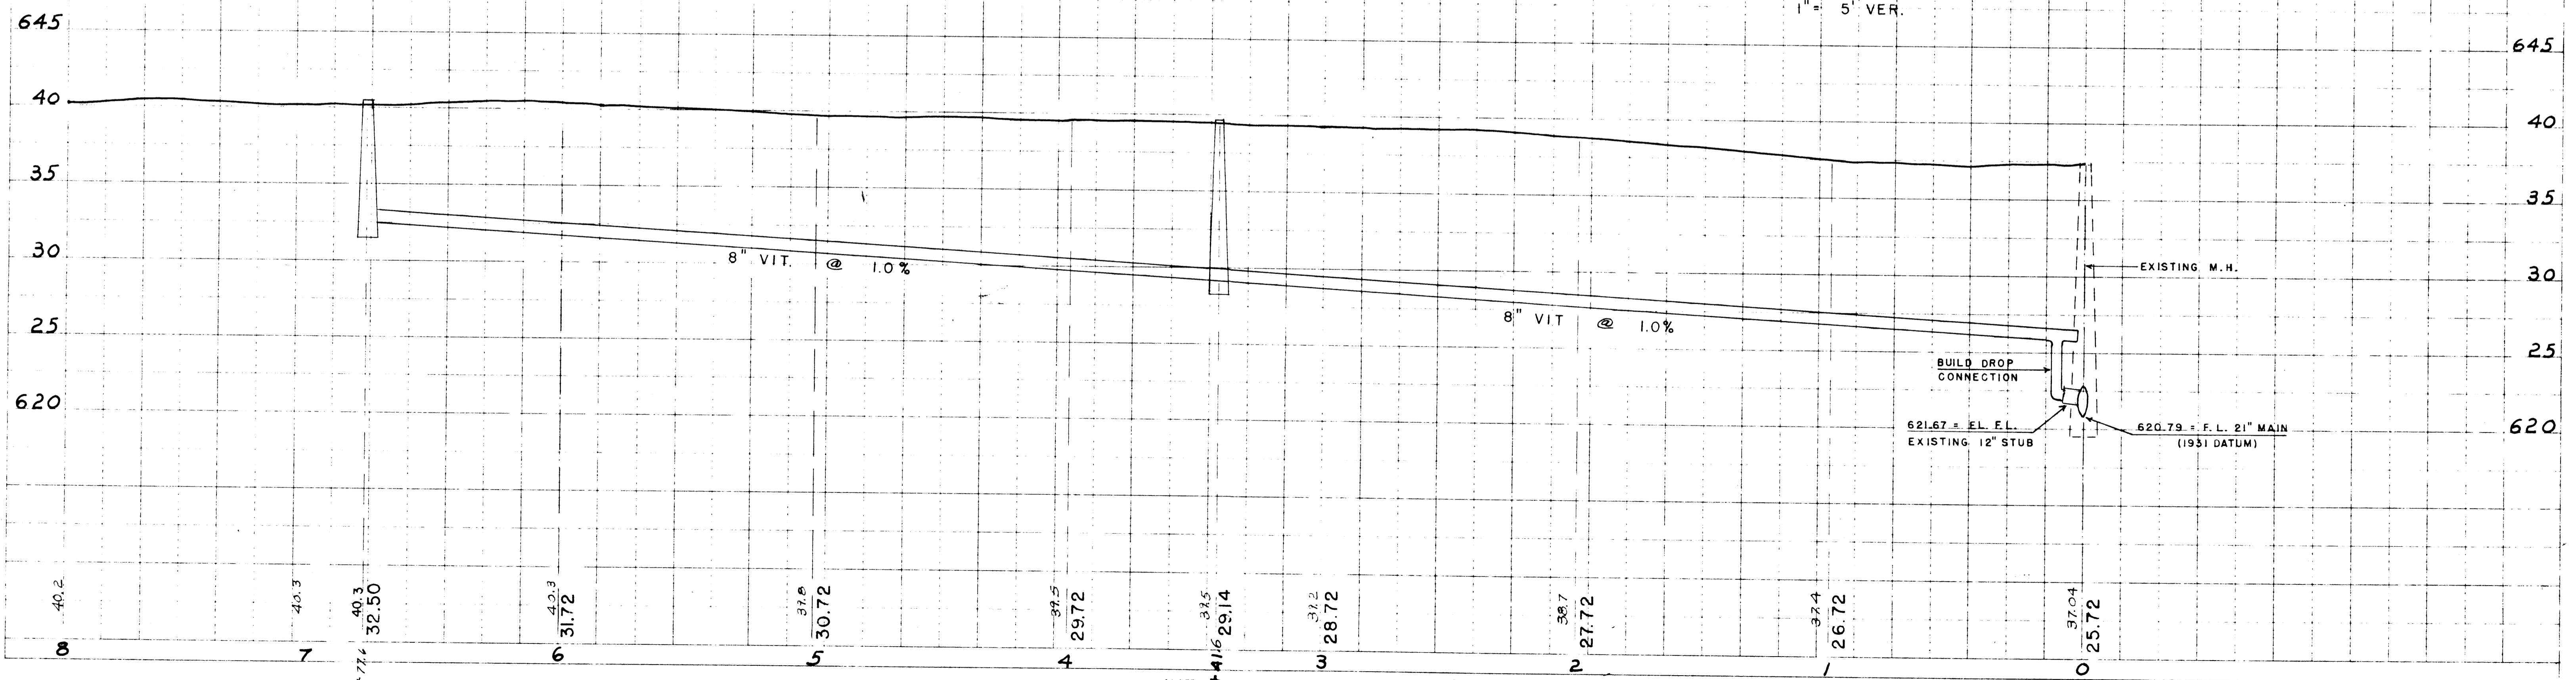

PROFILE SCALE 1" = 30' HOR.
1" = 5' VER.

PLAN
F.M.S.
G.C.W.

PROFILE
F.M.S.
G.C.W.

$$\begin{array}{r} 37.04 \\ 16.25 \\ \hline 20.79 \end{array}$$

$$\begin{array}{r} 37.02 \\ 16.25 \\ \hline 20.77 \end{array}$$

$$\begin{array}{r} 37.02 \\ 15.40 \\ \hline 21.62 \end{array}$$

$$\begin{array}{r} 21.42 \\ 21.11 \\ \hline 0.63 \end{array}$$

Proposed Ext. San. Sewer Blk. 2 & 7 Normal View add.
& Blk. 5 Schroeder Park 3-937A-5-B