
INDEX OF SHEETS STATE OF WISCONSIN STATE PROJECT DEPARTMENT OF TRANSPORTATION Sheet No. 2 -2.167 Typical Sections and Details Sheet No. 3-3.10 Estimate of Quantities Sheet No. 3A -3'00' Miscellaneous Quantities Sheet No. 4-4.11 Right of Way Plat PLAN OF PROPOSED IMPROVEMENT Sheet No. 5-5.29 Plan and Profile Sheet No. 6-6.46Standard Detail Drawings TOWER AVENUE, CITY OF SUPERIOR Sheet No. 7 -7.29 Sign Plates Sheet No. — Structure Plans Sheet No. 9-9.4 Computer Earthwork Data (34TH ST. - BELKNAP ST.) Sheet No. 9. 5-9.99 Cross Sections TOTAL SHEETS = 440 S.T.H. 35 DOUGLAS COUNTY PROJECT LOCATION STATE PROJECT NUMBER BEGIN PROJECT 8010-07-73 DESIGN DESIGNATION STA. 602+00 = 16,824 A.D.T. (2015) = 25,880N= 565,113.47 D.H.V. (2015) = 2,847 E= 1,472,204.92 = 60 - 40= 5.8END PROJECT 8010-07-73 = 35 MPH = 3,788,700STA. 689+50 CONVENTIONAL SIGNS COUNTY LINE CORPORATE LIMITS Inderground Utilities Gas ELECTRIC SERVICE PEDESTA CABLE MARKER **R14W** POWER POLE SLOPE INTERCEPTS ORIGINAL CROUND COORDINATE NOTE ALL COORDINATES ON THIS PLAN ARE REFERENCED TO THE WISCONSIN COORDINATE SYSTEM CENTRAL ZONE
AND SCALED FROM U.S.G.S. TOPOGRAPHIC MAP
SUPERIOR, WIS.—MINN., 1983, 7.5 MINUTE WISCONSIN
QUADRANGLE, FOR IDENTIFICATION ONLY. CULVERT REQUIRED TOTAL NET LENGTH OF CENTERLINE = 1.657 MI. RIGHT OF WAY MARKER POST CULVERT REQUIRED (Profile)

> ACCEPTED FOR STATE OF WISCONSIN DEPARTMENT OF TRANSPORTATION AUTHORIZED FOR CENTRAL OFFICE TRAFFIC AUTHORIZED FOR CENTRAL OFFICE DESIGN DATE: 18 45


> > WISDOT/VEHICLE NO. 1

	STANDARD ABBREVIATIONS						UTILITY CONTACTS			SHEET NO.
ABUT	ABUTMENT	`JT	JOINT	STD	STANDARD	Control of the Contro	**************************************		8010-07-73	2.0
AP AC	ACCESS POINT ACRE	JCT	JUNCTION	SDD STH	STANDARD DETAIL DRAWINGS STATE TRUCK HIGHWAYS	CITY OF SUPERIOR	DNR LIAISON HWY 70 W. P.O. BOX	<b>309</b>		
AGG AH	AGGREGATE AHEAD	LC LHF	LAND CONTRACT LEFT-HAND FORWARD	STA	STATION	SANITARY SEWER SYSTEM (PUBLIC WORKS) SUPERIOR, WISCONSIN 54880	SPOONER, WISCONSIN	V 54801	STANDARD ABBREVIATIONS, GENERAL STANDARD DETAIL DRAWINGS & UTIL	NOTES,
<	ANGLE	L	LENGTH OF CURVE	SSD SS	STOPPING SIGHT DISTANCE STORM SEWER	TELEPHONE: (715) 394-0333	TELEPHONE: (715) 6 ATTENTION: DAN MIC	35-4228 HELS	STANDARD DETAIL DRAWINGS & UTIL	IT CONTACTS
AEW ASPH	APRON ENDWALLS ASPHALTIC	LIN FT OR LF LC	LINEAR FOOT LONG CHORD OF CURVE	SPP SPPA	STRUCTURAL PLATE PIPE STRUCTURAL PLATE PIPE ARCH	ATTENTION: PAUL KING (CITY ENGINEER)	_			
AC APM	ASPHALT CEMENT ASPHALTIC PLANT MIX	LS	LUMP SUM	STR	STRUCTURE OR STRUCTURAL	CURRENCE WATER LIGHT A ROUTE OF	2	STANDARD D	ETAIL DRAWINGS	
AVG	AVERAGE	MAINT	MAINTENANCE	Subd Se	SUBDIVISION SUPERELEVATION	SUPERIOR WATER, LIGHT & POWER CO. 1230 TOWER AVE.				
ADT	AVERAGE DAILY TRAFFIC	MGR MH	MANAGER MANHOLE	SURF SL OR S/L	SURFACE SURVEY LINE	Superior, Wisconsin 54880 Telephone: (715) 394—5511	8A5-11a, b, & c			
8 & B 8 & P	BALLED AND BURLAPPED BALLED AND POTTED	MP U	MARKER POST MARSH	SE ON S/E	•	ATTENTION: DAVID SMITH (ELECTRIC)	8A5-11d		MANHOLE COVERS	
BK	BACK	ML_ORM/L	MATCH LINE	T TEL	TANGENT TELEPHONE	ATTENTION: DALE GROTHE (WATER & GAS)	8A6-3		NNS, TYPE 1 & 2	
BF BR	BACK FACE BARE ROOT	MATL	MATERIAL	TEMP TLE	TEMPORARY	AMERITECH	8A7-3 8B6-3	MANHOLES.	NNS, TYPE 3 & 5	
BRP BL OR B/L	BARE ROOT POTTED BASE LINE	NOM: NRCPSS	NOMINAL NONREINFORCED CONCRETE PIPE STORM SEWER	TPM	TEMPORARY LIMITED EASEMENT TEMPORARY PAVEMENT MARKING	304 S. DEWEY STREET, 4TH FLOOR	887-3		TYPES 2 AND 3	
BM '	BENCH MARK	NC NW OR N/W	NORMAL CROWN	TPMRT	TEMPORARY PAVMENT MARKING, REMOVEABLE TAPE	EAU CLAIRE, WISCONSIN 54703 TELEPHONE: (715) 839-5819	8C1-5		PES 1, 2, 3 AND 4	
BLK BR	BLOCK BRIDGE	NW OR N/W	NORMAL WATER NORTH OR NORTH PROJECT COORDINATE	MBM	THOUSAND FEET BOARD MEASURE	ATTENTION: PAM PARKER	8D1-11		CURB, CONCRETE CURB AND GUTTER AND	
СВ	CATCH BASIN	Y NB	NORTH GRID COORDINATE NORTHBOUND	TC TORTN	TOP OF CURB			PAVEMENT	TIES	
ÇOR C∕L .	CENTER LINE	NO	NUMBER	TRANS TL OR T/L	TRANSITION TRANSIT LINE	BRESNAN COMMUNICATIONS	8D4—3		SURFACE DRAIN & ASPHALTIC FLUME	
CC ~	CENTER TO CENTER	OBLIT	OBLITERATE	T '	TRUCKS (PERCENT OF)	302 E. SUPERIOR ST. DULUTH, MINNESOTA 55802	805-8	CURB RAMI		. [
CONC	CENTRAL ANGLE OR DELTA CONCRETE	OL OD	OUT LOT OUTSIDE DIAMETER	TYP	TYPICAL	TELEPHONE: (218) 722-2815 ATTENTION: JM MATUSZEWSKI	8D15-1a		OUTLET DETAILS	
CORR CACP	CORRUGATED CORRUGATED ALUMINUM CULVERT PIPE			UNCL UG	UNCLASSIFIED UNDERGROUND CABLE	ATTENTION: UM MATUSELTONI	8D15-1b	GRADED NO	AND CRUSHED AGGREGATE BASE COURSE, ( ). 1 OR NO. 2	PEN
CAPA	CORRUGATED ALUMINUM PIPE ARCH	PSD PAVT	PASSING SIGHT DISTANCE PAVEMENT	USH	UNITED STATES HIGHWAY	MURPHY OIL COMPANY	8E8-2		STALLATIONS OF EROSION BALES	J
CSCP CSPA	CORRUGATED STEEL CULVERT PIPE CORRUGATED STEEL PIPE ARCH	PCP PLE	PIPE CATTLE PASS PERMANENT LIMITED EASEMENT	VAR	VARIABLE	2407 STINSON AVENUE P.O. BOX 2086	8E9-4	SILT FENCE		
CSPCP CO	CORRUGATED STEEL PIPE CATTLE PASS COUNTY	PU	PIPE UNDERDRAIN	V Vert	VELOCITY OR DESIGN SPEED VERTICAL	SUPERIOR, WISCONSIN 54880	8F1—11	APRON EN	WALLS FOR CULVERT PIPE	ı
СТН	COUNTY TRUCK HIGHWAY	PUDT PUU	PIPE UNDERDRAIN DRAIN TILE PIPE UNDERDRAIN UNPERFORATED	VC	VERTICAL CURVE	TELEPHONE: (715) 398-8235 ATTENTION: WILLIAM CHELLEW	9B2-5	CONDUIT	·	
CR CR	CREEK CRUSHED	PT PC	POINT OF CURVATURE	VIT VOL	VITRIFIED VOLUME	ATTENTION: HILLIAM CHELLEN	9B4—1	PULL BOX		
CY OR CU YD CULT	CUBIC YARD CULTIVATED	PI PRC	POINT OF INTERSECTION	WM	WATER MAIN	DIGGERS HOTLINE	9C3-1	CAST BASE		İ
CULV	CULVERT	PT	POINT OF REVERSE CURVATURE POINT OF TANGENCY	wv	WATER VALVE	2040 WEST WISCONSIN AVENUE	9C5—1 9D1—1		CONTROL CABINET BASES	
CP C&G	CULVERT PIPE CURB AND GUTTER	POC POT	POINT ON CURVE POINT ON TANGENT	w	WELL WEST	SUITE 10 MILWAUKEE, WISCONSIN 53233	9D2-1		RVICE INSTALLATION LIGHTING CONTROL CABINET	1
(0)	DEED	PVC	POLYVINYL CHLORIDE	WB	WESTBOUND	TELEPHONE: 1-800-242-8511	9E1-1a		TINGS FOR TRAFFIC SIGNALS, TYPE 2	l
DEF	DEFORMED	PCC LB	PORTLAND CEMENT CONCRETE POUND	YD	YARD		9E1—1b		TINGS FOR TRAFFIC SIGNALS & LIGHT UNITS,	TYPE 3
DHV	DEGREE OF CURVE DESIGN HOUR VOLUME	PSI PE	POUNDS PER SQUARE INCH PRIVATE ENTRANCE		GENERAL NOT	ES .	9E11c	POLE MOUN	TING FOR TRAFFIC SIGNALS AND LIGHTING U	
DIA D	DIAMETER DIRECTIONAL DISTRIBUTION	PROJ	PROJECT	ELEVA	ATIONS SHOWN ON THE PLAN ARE REFE		D.W. 4	TYPE 4		
DISCH	DISCHARGE	QCD	QUITCLAIM DEED				9E1—1e 9E3—1		DETAILS FOR POLE MOUNTINGS	
DIST DG	DISTRICT DITCH GRADE	R	RADIUS	FOR F	THE QUANTITY OF THE ITEMS OF BASI PAYMENT BY THE TON, THE DEPTH OR	THICKNESS OF THE COURSE SHOWN ON	9F2-1		VAY LIGHTING UNIT POLE WIRING CTOR INSTALLED IN NEW CONCRETE PAVEMEN	
DWY	DRIVEWAY	RP RR	RADIUS POINT RAILROAD	THE F	PLANS IS APPROXIMATE AND THE ACTU IBUTION OF THE MATERIAL AS DIRECTED	AL THICKNESS WILL DEPEND ON THE	01 <u>2</u> 1	8X8X8-INC	I JUNCTION BOX.	
E	EAST OR EAST PROJECT COORDINATE	RY	RAILWAY				9F3-1	LOOP DETE	CTOR INSTALLED IN NEW CONCRETE PAVEMEN	IT
ÉB	EAST GRID COORDINATE EASTBOUND	RECY	RANGE RECYCLED	ON TI	OCATION OF EXISTING AND PROPOSED HE PLANS ARE APPROXIMATE. THERE	MAY BE OTHER UTILITY INSTALLATIONS	059.4		I JUNCTION BOX (MULTIPLE LEAD-OUT).	
ELEC EL OR ELEV	ELECTRIC(AL) ELEVATION	RL OR R/L RP	REFERENCE LINE REFERENCE POINT	МІНП	THE PROJECT AREA THAT ARE NOT	SHOWN.	9F8 <b>–</b> 1	(NEW ASPH	CTOR PLACED IN CRUSHED AGGREGATE BASE ALTIC PAVEMENT)	
EMB	EMBANKMENT	RCCP	REINFORCED CONCRETE CULVERT PIPE	IN PE	RFORMANCE OF THE WORK UNDER THE	ITEMS "CLEARING" AND "GRUBBING"	9F12-1	-	CTOR INSTALLED IN EXISTING CONCRETE PAY	EMENT
EW ENT	ENDWALL ENTRANCE	RCHECP	REINFORCED CONCRETE HORIZONTAL ELLIPTICAL CULVERT PIPE	ENGIN	REES OR SHRUBS ARE TO BE REMOVED EER.	WITHOUT THE APPROVAL OF THE	9F13-1	LOOP DETEC	CTOR INSTALLED IN EXISTING ASPHALTIC PAY	EMENT
ESALS EXC	EQUIVALENT SINGLE AXLE LOADS EXCAVATION	RCPA RCPCP	REINFORCED CONCRETE PIPE ARCH REINFORCED CONCRETE PIPE CATTLE PASS	OUD.	* DATA IS DASS ON THE ADDRESS OF	·	13C1-9	CONCRETE	PAVEMENT LONGITUDINAL JOINTS AND PAVEM	ENT TIES
EBS	EXCAVATION BELOW SUBGRADE	RCPSS	REINFORCED CONCRETE PIPE STORM SEWER		E DATA IS BASED ON THE ARC DEFINIT		13013-1	DOWELED N	ON-REINFORCED CONCRETE PAVEMENT	I
EXIST EXP	EXISTING EXPANSION	REBAR REINF	REINFORCEMENT BAR REINFORCING OR REINFORCEMENT		TILITIES WILL BE MOVED BY THEIR OWN		14A2-1	TREE PLANT	E JOINTS SPACED AT 20' AND NORMAL)	
FF	FACE TO FACE	REL REM	RELOCATE (d) REMANING	THE E	XACT LOCATION OF THE EROSION CONT	TROL DEVICES WILL BE DETERMINED IN	14B3-2		STEEL PLATE BEAM GUARD	
FP FERT	FENCE POST FERTI⊔ZE	REP REQD	REPRESENTATIVE		IELD BY THE ENGINEER.		1487-9A		PRECAST CONCRETE BARRIER	
FE	FIELD ENTRANCE	RES	REQUIRED RESIDENCE OR RESIDENTIAL	DISTUI RF FF	RBED AREAS WITHIN THE CONSTRUCTION RTILIZED, SEEDED, OR SODDED.	N LIMITS, EXCLUDING ROADBED, ETC. ARE TO	1487-9b	PRECAST C	ONCRETE BARRIER END SECTION AND PORTAI	<sub>BLE</sub>
F FG	FILL FINISHED GRADE	RW RT	RETAINING WALL RIGHT		•			CRASH CUS	HION	
FL OR F/L FT	FLOW LINE FOOT	RHF R/W	RIGHT-HAND FORWARD RIGHT-OF-WAY		MIXTURE #10 SHALL BE USED.		1502-3		AND TRAFFIC CONTROL FOR ROAD CLOSURI	ES
FTG	FOOTING	R <sup>*</sup>	RIVER	BEARI	NGS SHOWN ON THE PLANS ARE GRID	BEARINGS TO THE NEAREST SECOND.	15C7-5a 15C8-7a		MARKING SYMBOLS	
FDN	FOUNDATION	RD RDWY	ROAD ROADWAY	THE E	XACT LOCATION OF P.E.'S AND C.E.'S	SHALL BE DETERMINED IN THE FIELD	15C8-7a 15C8-7b		MARKING (MAINLINE) MARKING (INTERSECTIONS)	İ
GN	GRID NORTH	SALV	SALVAGED	BY TH	E ENGINEER.				MARKING (LEFT TURN LANE)	, [
HR HT	HANDICAP RAMP HEIGHT	SAN S SEC	SANITARY SEWER	SIGN	PLATE DETAILS SHALL BE IN ACCORDAN	ICE WITH THE FEDERAL HIGHWAY	15C8-7d		MARKING (ISLANDS, STOP LINE & CROSS WAL	<sub>K)</sub> [
HES	HIGH EARLY STRENGTH	SHLDR	SECTION SHOULDER	AUMIN	ISTRATION "MANUAL OF UNIFORM TRAFI WISE PROVIDED FOR IN THE PLAN.	FIC CONTROL DEVICES" UNLESS	15C9-3	PAVEMENT I	MARKING DETAILS FOR RAILROAD-HIGHWAY G	RADE
CWT HYD	HUNDREDWEIGHT HYDRANT	SHR SW	SHRINKAGE SIDEWALK			HISER TO DAI ANOT VARRAGE AVE.	15010 0	CROSSINGS		
IN DIA	INCH DIAMETER	S S8	SOUTH	SHOW	N ON CROSS SECTIONS BUT IS MEASUR	USED TO BALANCE YARDAGE AND IS NOT ED AND PAID FOR AS UNCLASSIFIED EXCAVATION.	15C12-2	TRAFFIC COL	NTROL FOR LANE CLOSURE (SUITABLE FOR M )	OVING
INL DIA	INLET	SP	SOUTHBOUND SPECIAL		RUCTION PERMITS FOR DRIVEWAY CONS				•	ĺ
INTERS	INSIDE DIAMETER INTERSECTION	SC SPECS	SPECIAL CROSSING SPECIFICATIONS	AND S	SUCH RIGHTS WILL BE EXTENDED TO TH	E CONTRACTOR.				
I INV	INTERSECTION ANGLE INVERT	SQ	SQUARE	TACK	COAT HAS BEEN ESTIMATED AT AN AP	PLICATION RATE OF 0.025 GALLONS PER				
I IP	IRON PIPE OR PIN	SF OR SQ FT SY OR SQ YD	SQUARE FEET SQUARE YARD	SUUAN	RE YARD AND SHALL BE PLACED BETWEEN THE EXISTING CONCRETE PAVEMENT	FN LAYERS OF ASPHALTIC DAVEMENT AND				
<u> </u>					Dustille College PACMEN	AND ADDITION PAYENCY!				

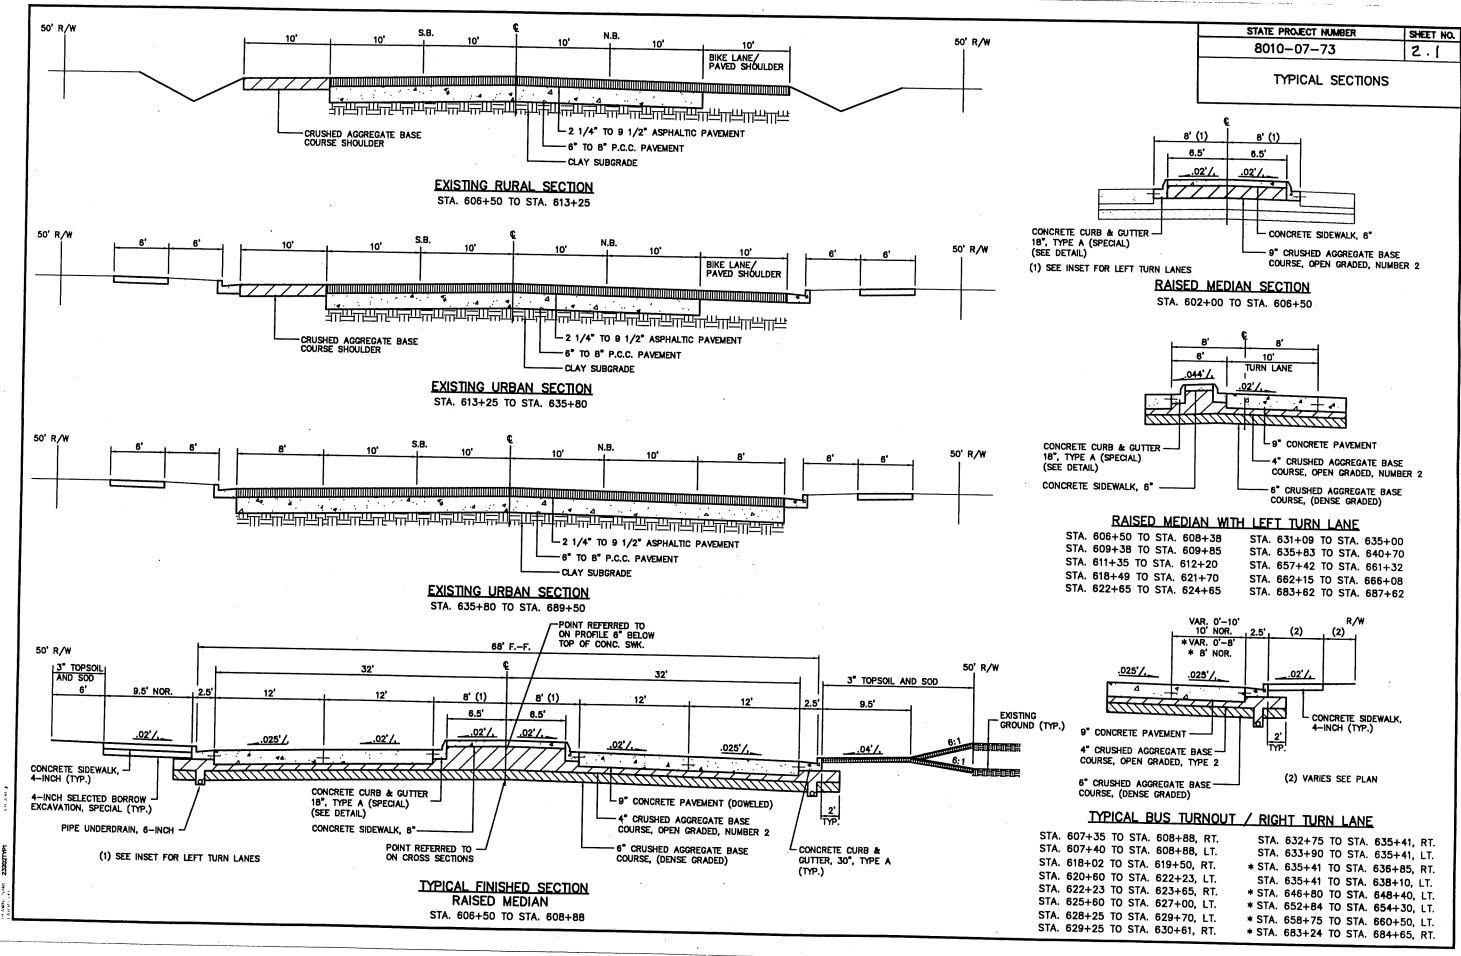

STATE PROJECT NUMBER SHEET NO. 8010-07-73 2.2


TYPICAL SECTIONS

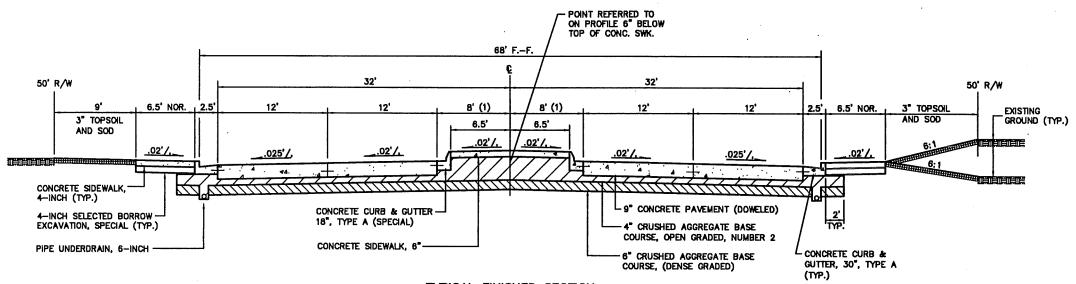

TYPICAL FINISHED SECTION
RAISED MEDIAN

(1) SEE INSET FOR LEFT TURN LANES


STA. 608+88 TO STA. 609+85 STA. 611+35 TO STA. 641+11 STA. 657+04 TO STA. 661+74

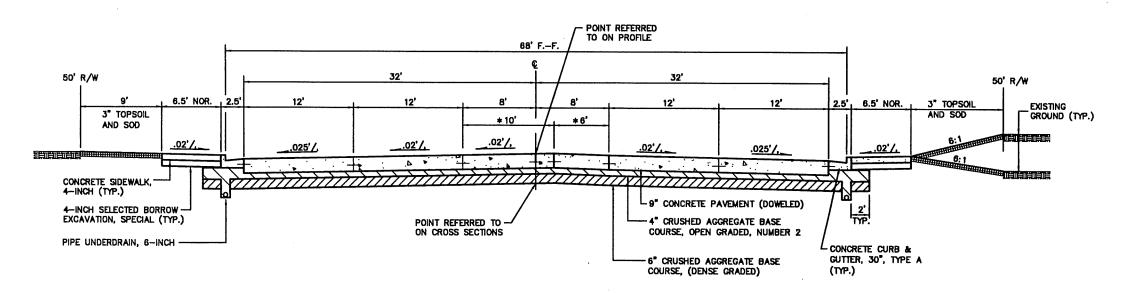


## TYPICAL FINISHED SECTION FLUSH MEDIAN

\* STA. 609+85 — STA. 611+35 STA. 641+11 — STA. 657+04 STA. 688+11 — STA. 688+75

STATE PROJECT NUMBER	SHEET NO.			
8010-07-73	2.3			
TYPICAL SECTIONS				

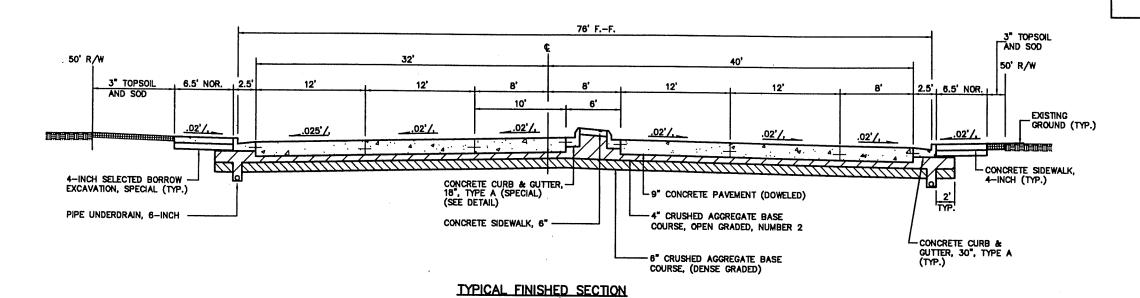



WTH PARKING (RT. SIDE) STA. 661+74 - STA. 666+46

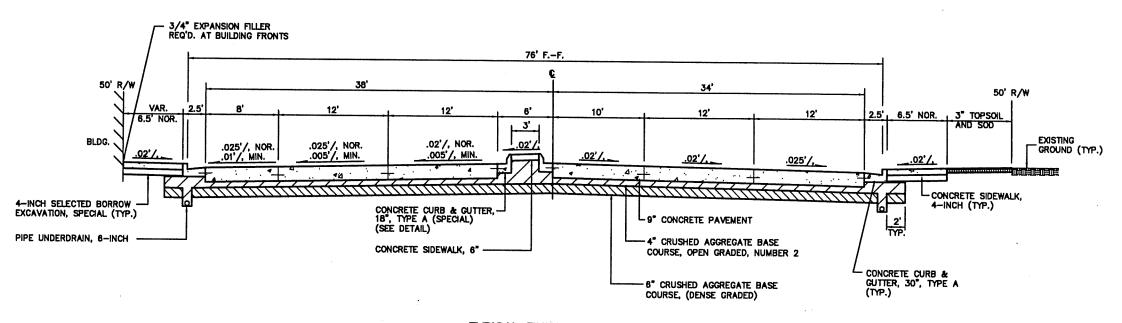



TYPICAL FINISHED SECTION WITH PARKING (LT. SIDE)
STA. 683+24 - STA. 688+11

3

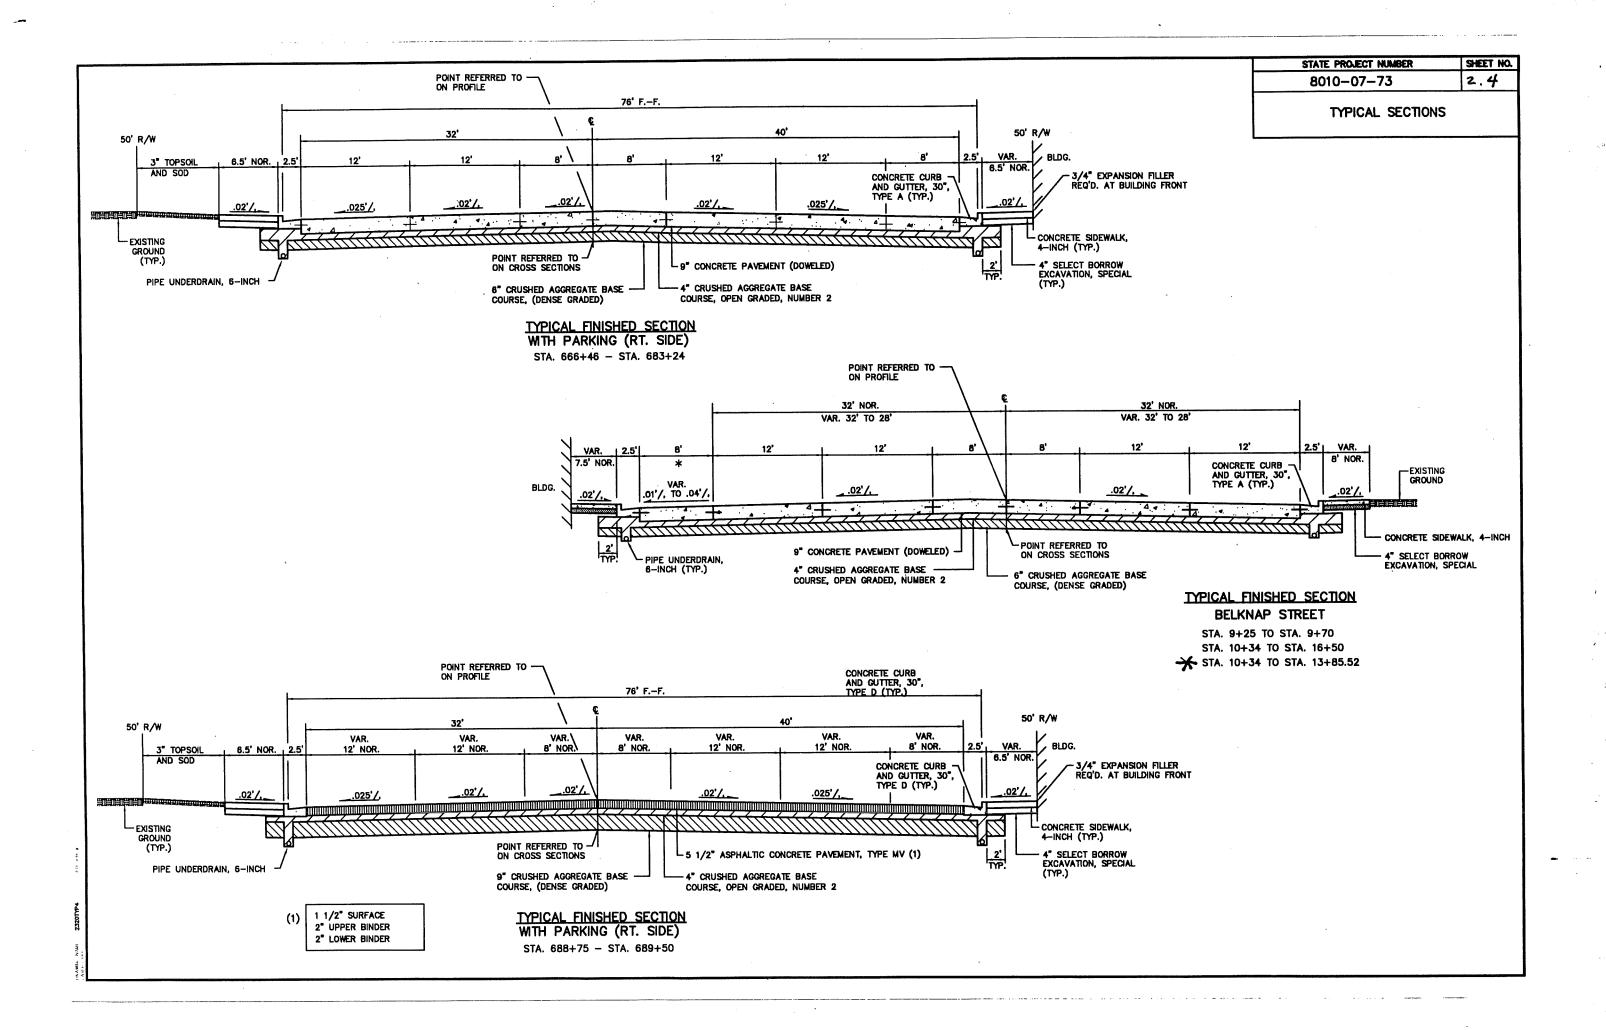

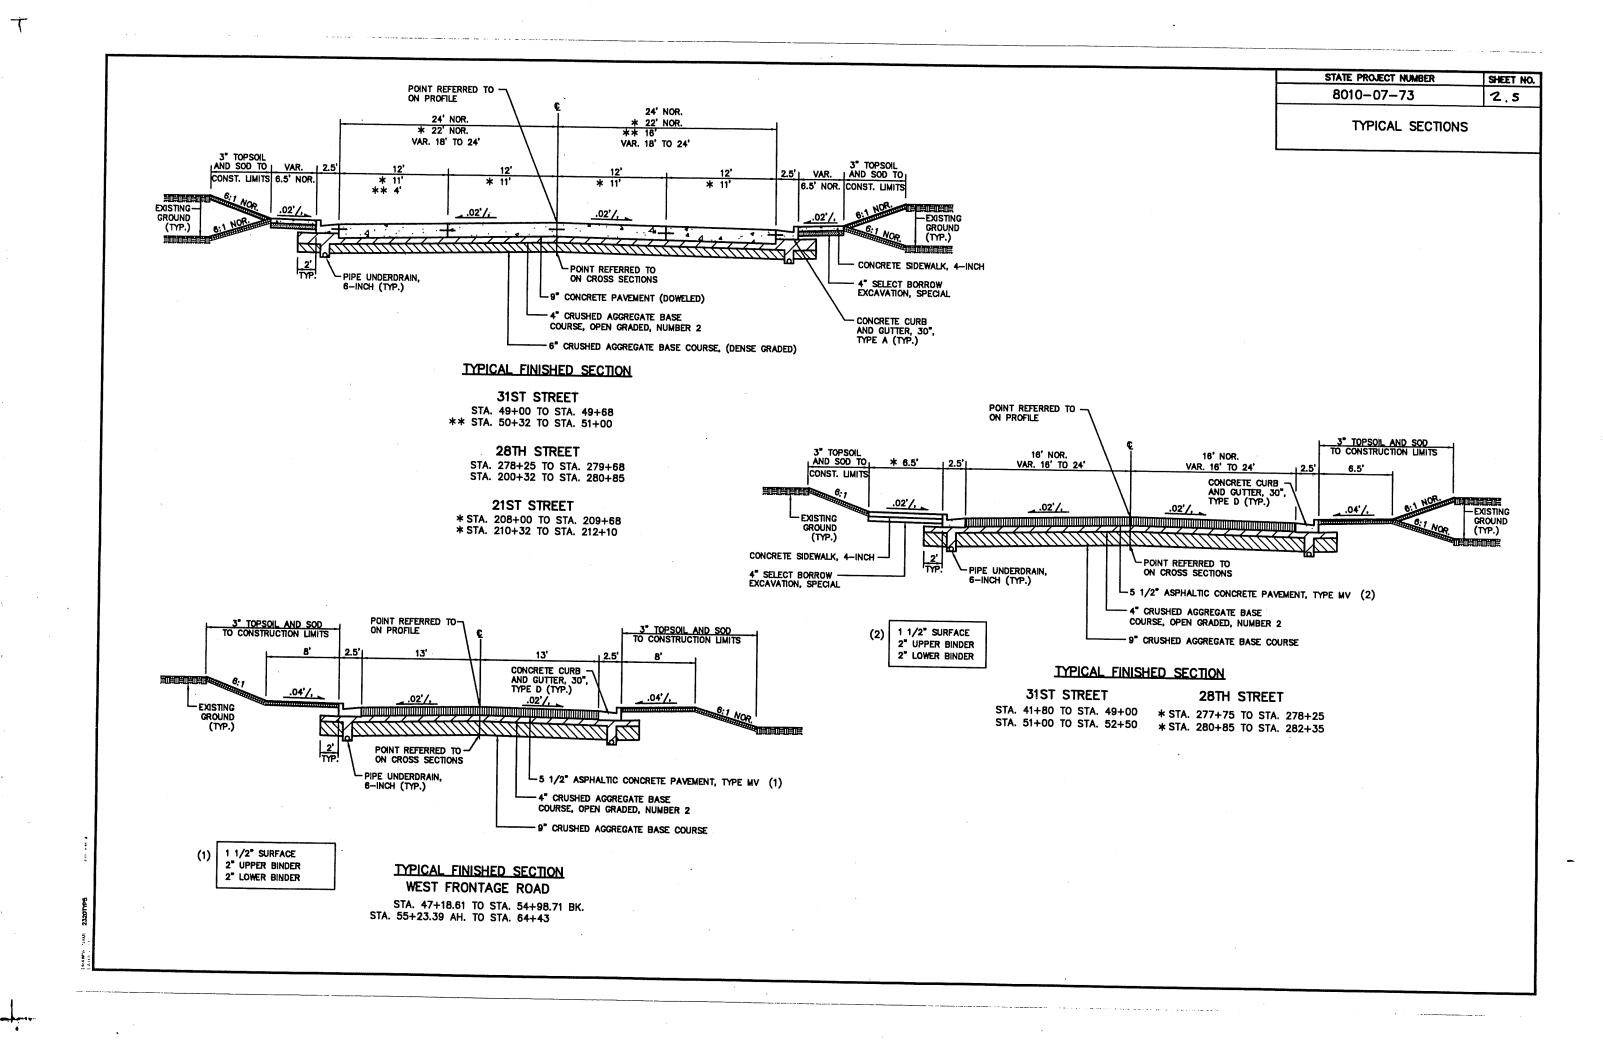

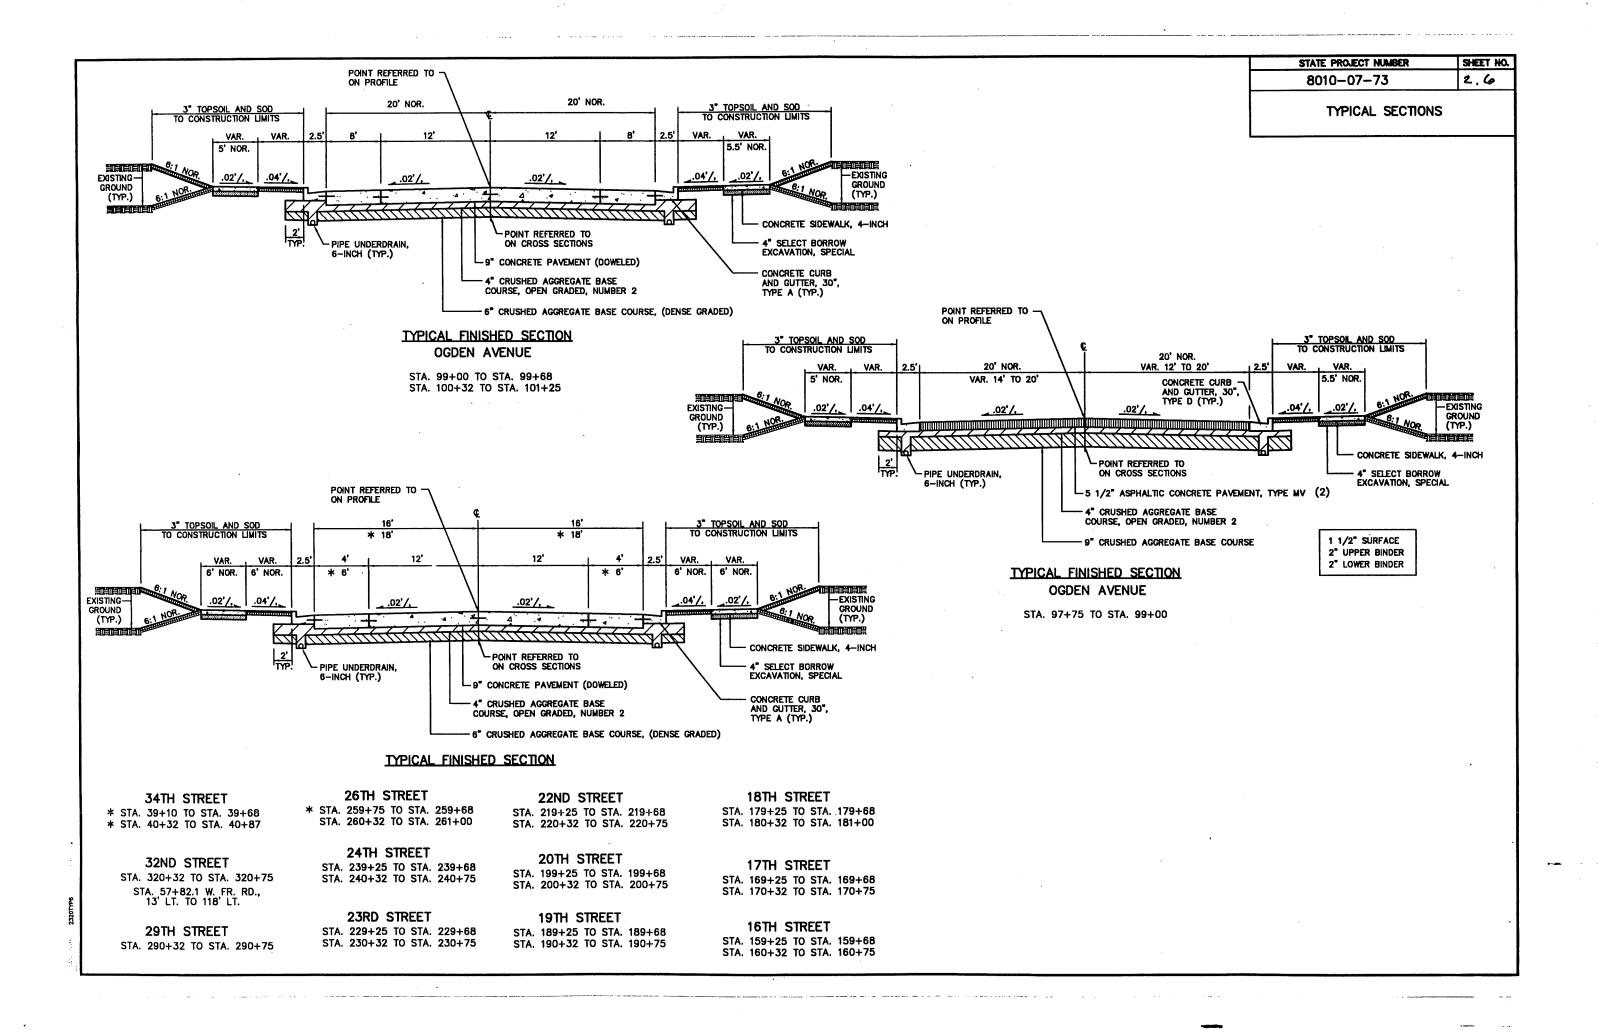

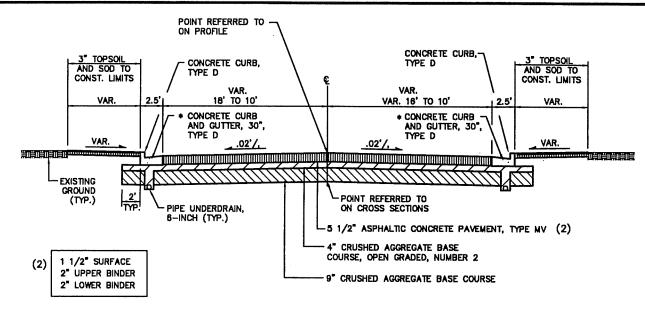

## TYPICAL FINISHED SECTION

29TH STREET

• STA. 290+75 TO STA. 291+25, RT. \* STA. 290+75 TO STA. 291+35, LT.

**26TH STREET** 

STA. 259+00 TO STA. 259+75, RT.

24TH STREET

STA. 240+75 TO STA. 241+00

22ND STREET

STA. 220+75 TO STA. 221+25

**20TH STREET** 

19TH STREET

STA. 188+75 TO STA. 189+25

STA. 190+75 TO STA. 191+00

STA. 200+75 TO STA. 201+00

STA. 170+75 TO STA. 171+00

STA. 159+00 TO STA. 159+25

STA. 628+00, LT.

17TH STREET

STA, 169+00 TO STA, 169+25


**16TH STREET** 

STA. 160+75 TO STA. 161+00

KMART ENTRANCE

**26TH STREET** STA. 259+00 TO STA. 259+75, LT. STATE PROJECT NUMBER SHEET NO. 2.7 8010-07-73

TYPICAL SECTIONS

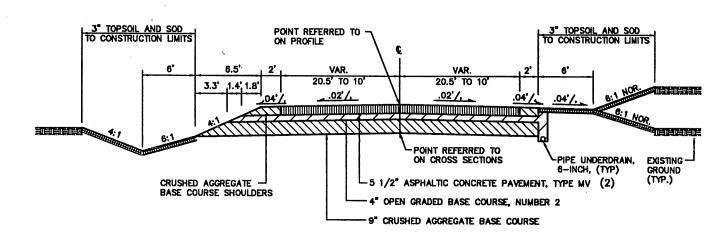

## TYPICAL FINISHED SECTION

**32ND STREET** STA. 320+75 TO STA. 321+00

29TH STREET

24TH STREET

STA. 239+00 TO STA. 239+25

23RD STREET

STA. 291+25 TO STA. 291+50, RT. STA. 228+75 TO STA. 229+25 STA. 291+35 TO STA. 291+50, LT. STA. 230+75 TO STA. 231+00 22ND STREET


STA. 218+75 TO STA. 219+25

**20TH STREET** 

STA. 199+00 TO STA. 199+25


18TH STREET

STA. 179+00 TO STA. 179+25

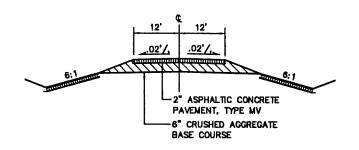


C.E. STA. 51+22 W. FR. RD., LT. 23.5' LT. TO 93' LT.


C.E. STA. 53+57 W. FR. RD., RT. 23.5' LT. TO 82' RT.

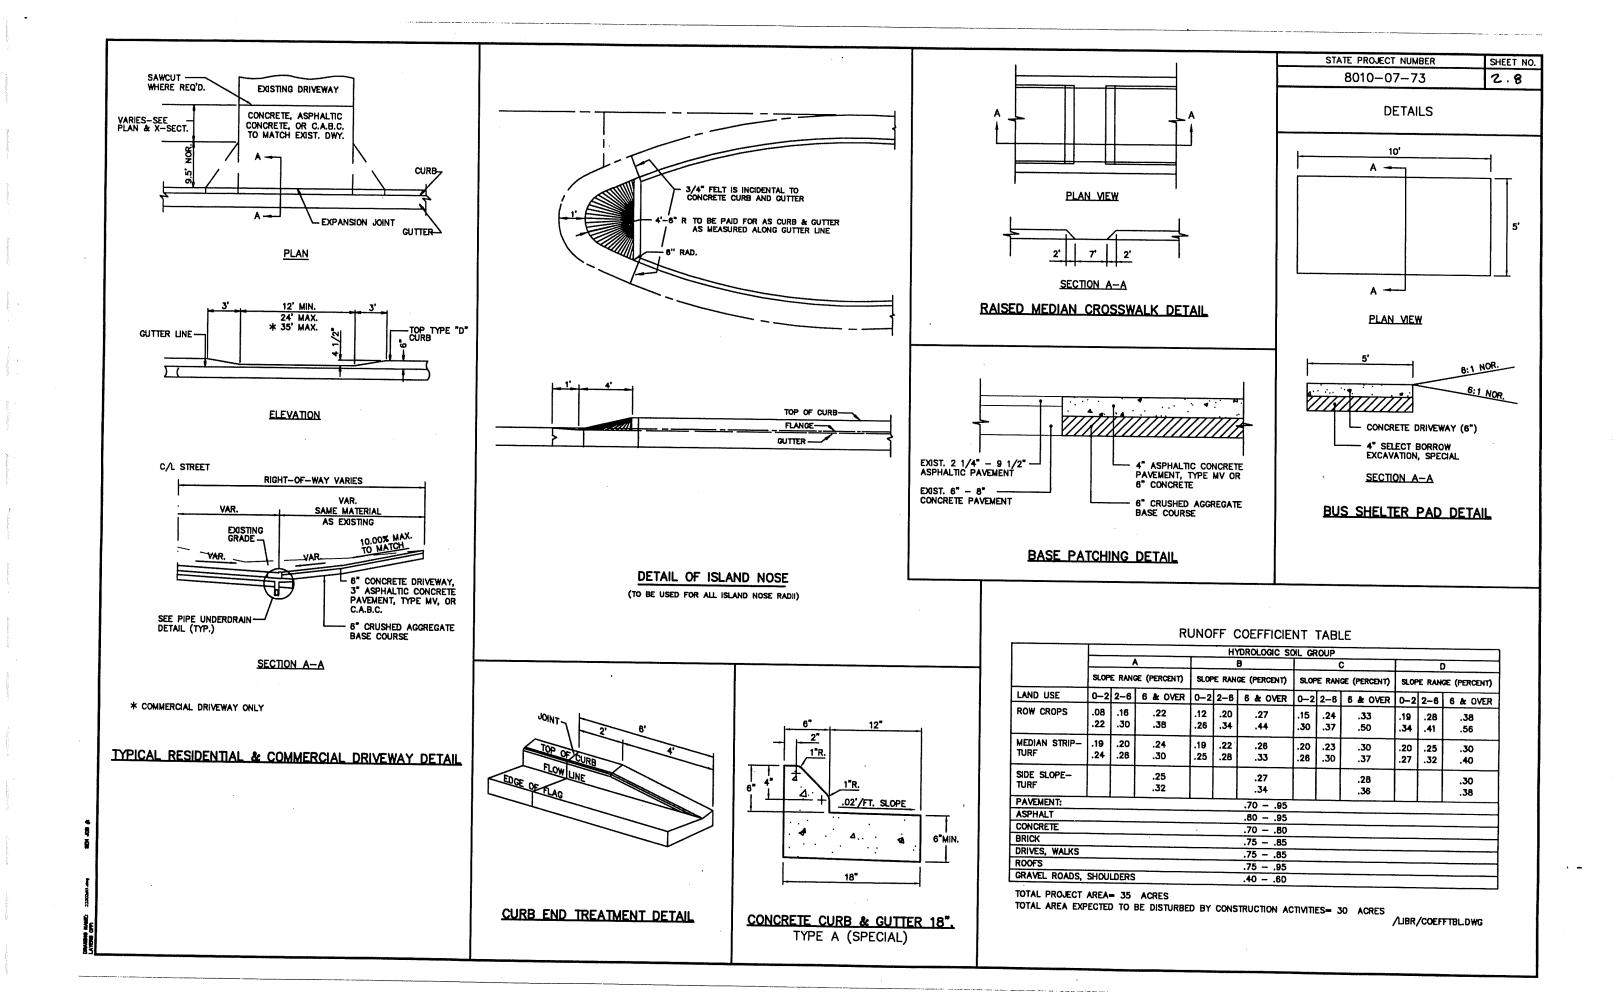



-**-**

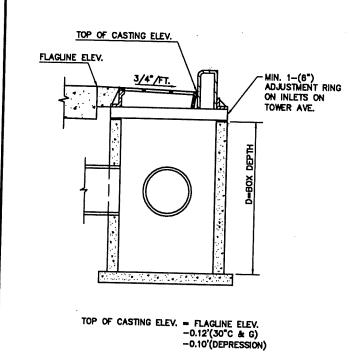



## INLET GRATE DEPRESSION DETAIL

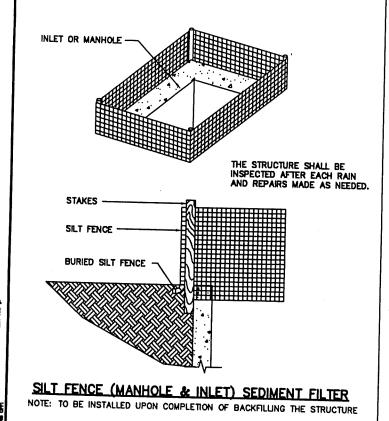


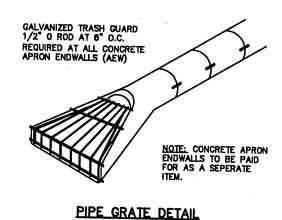

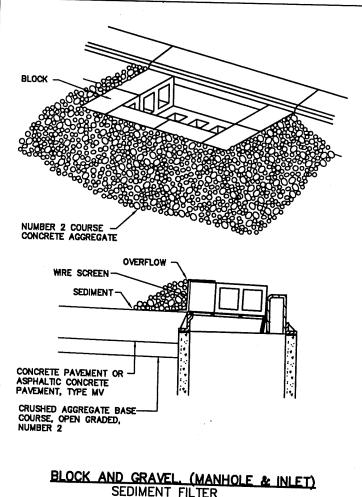


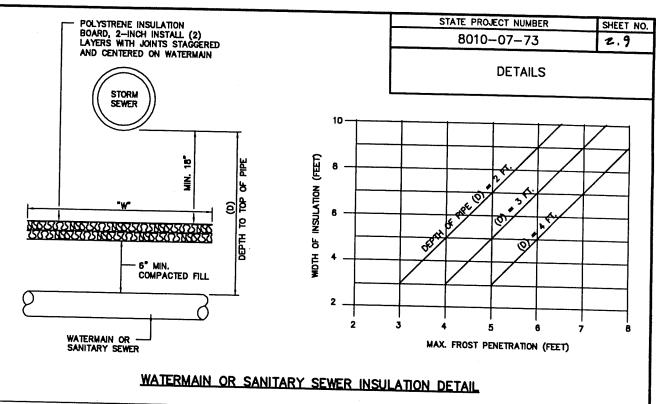

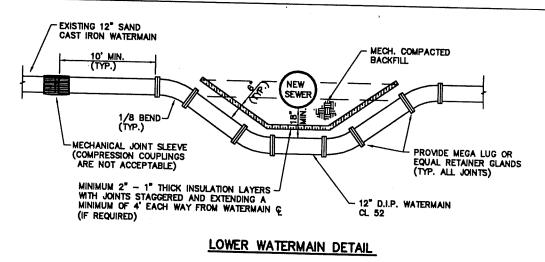

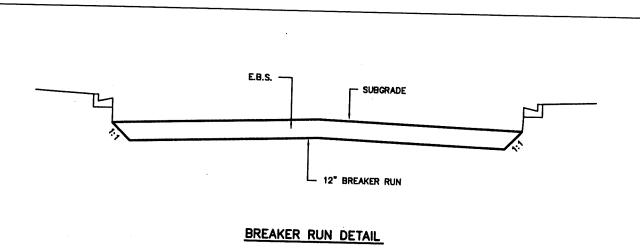



SEDIMENT FILTER

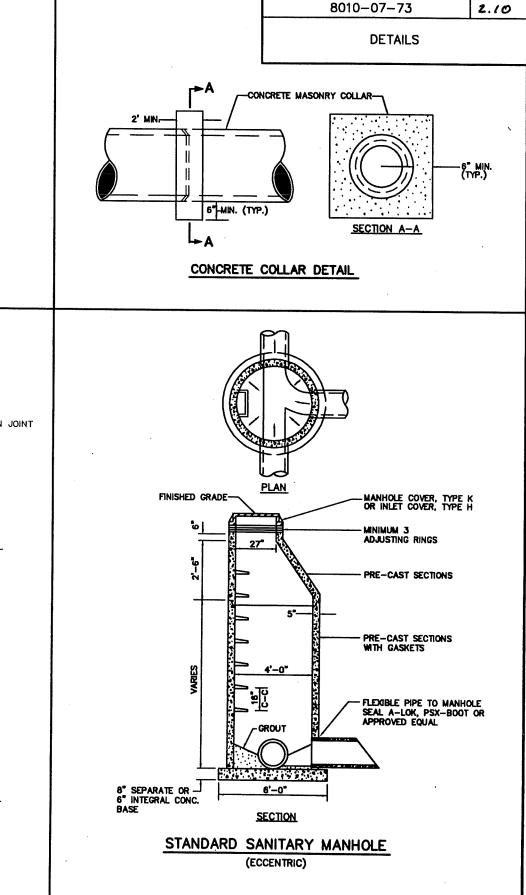



STATE PROJECT NUMBER


SHEET NO.

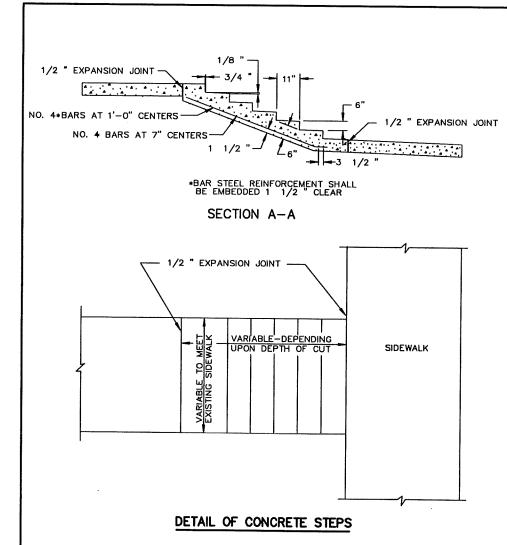


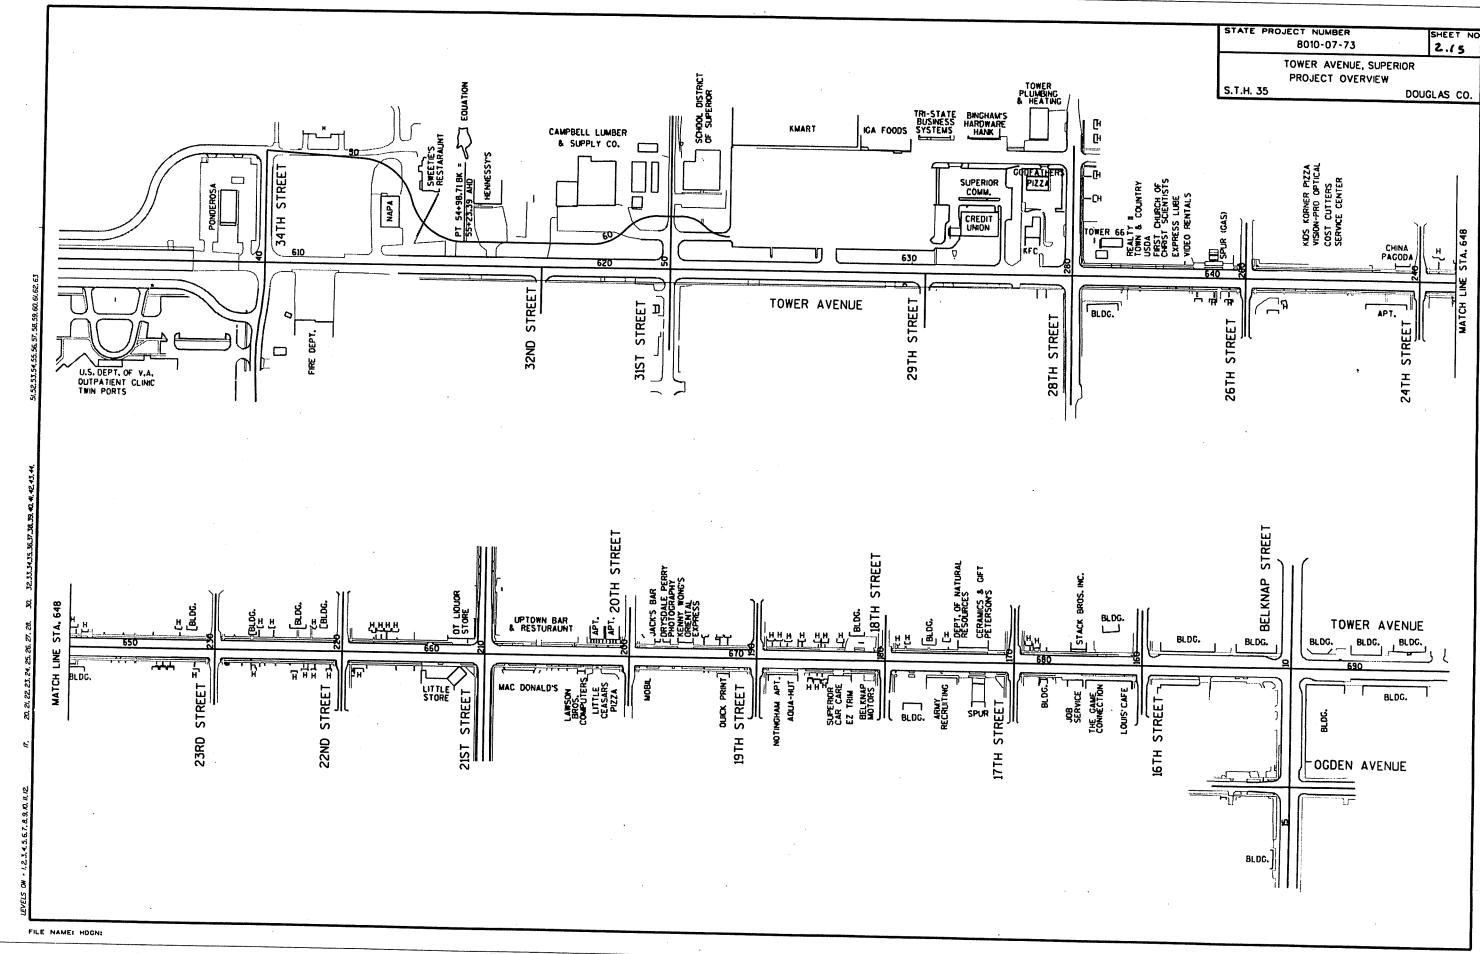


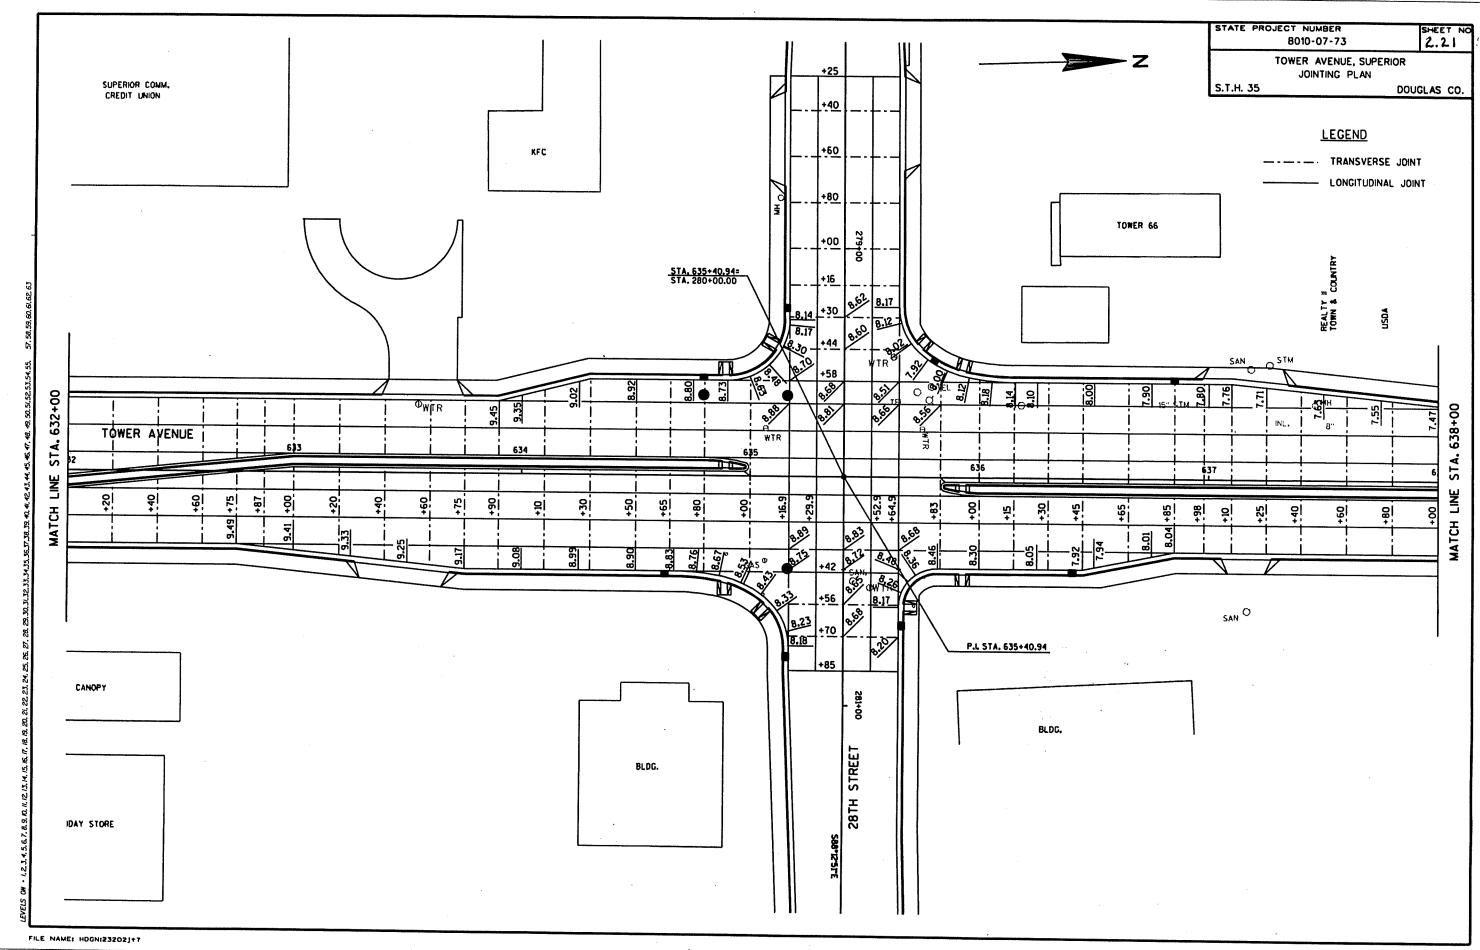


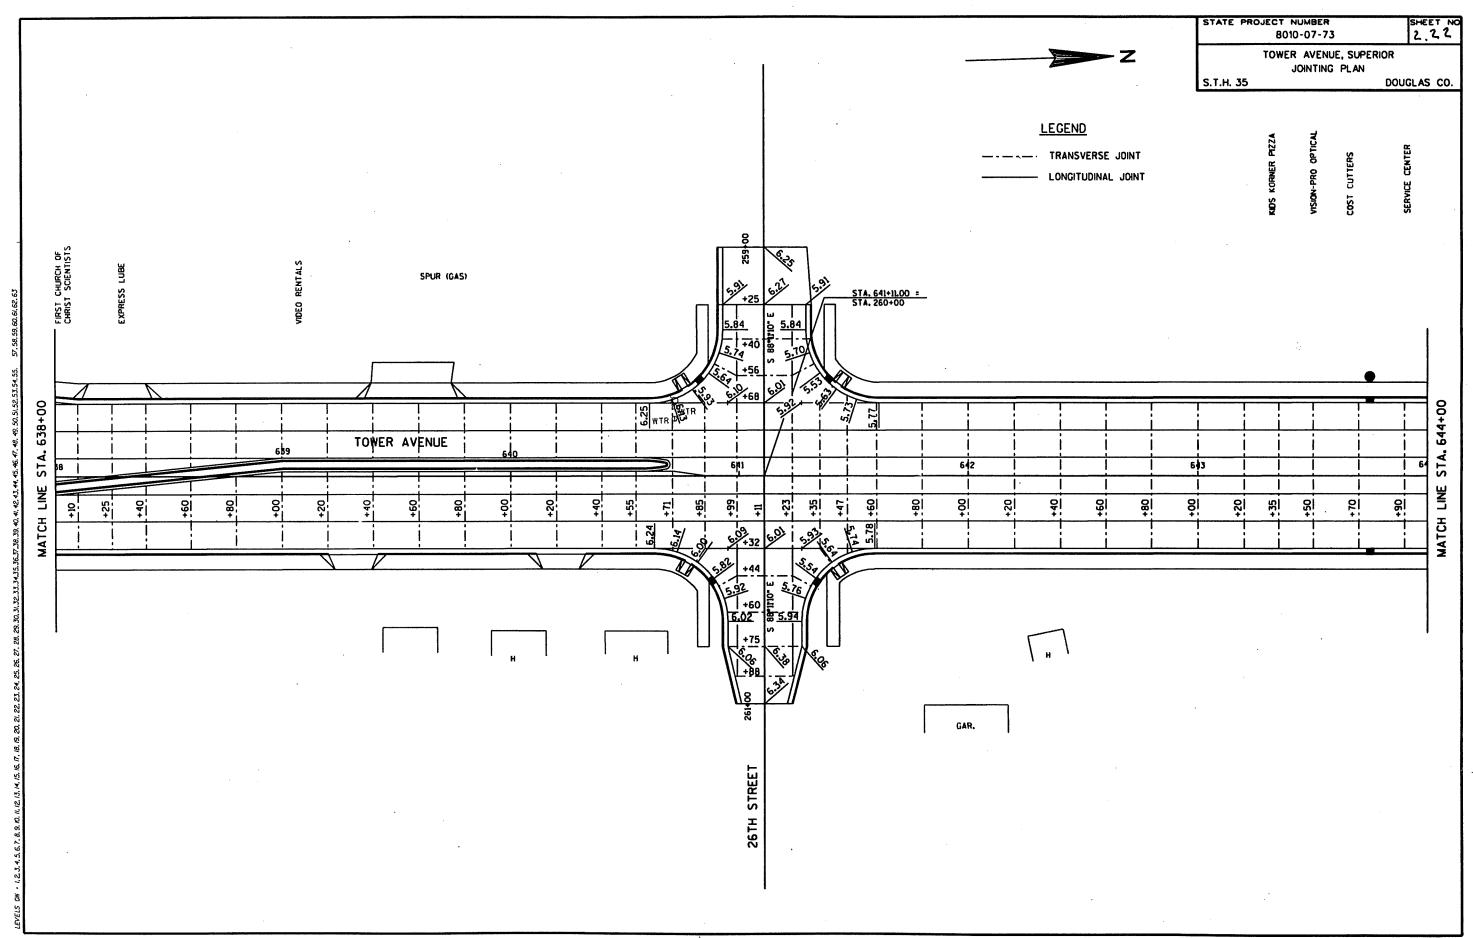


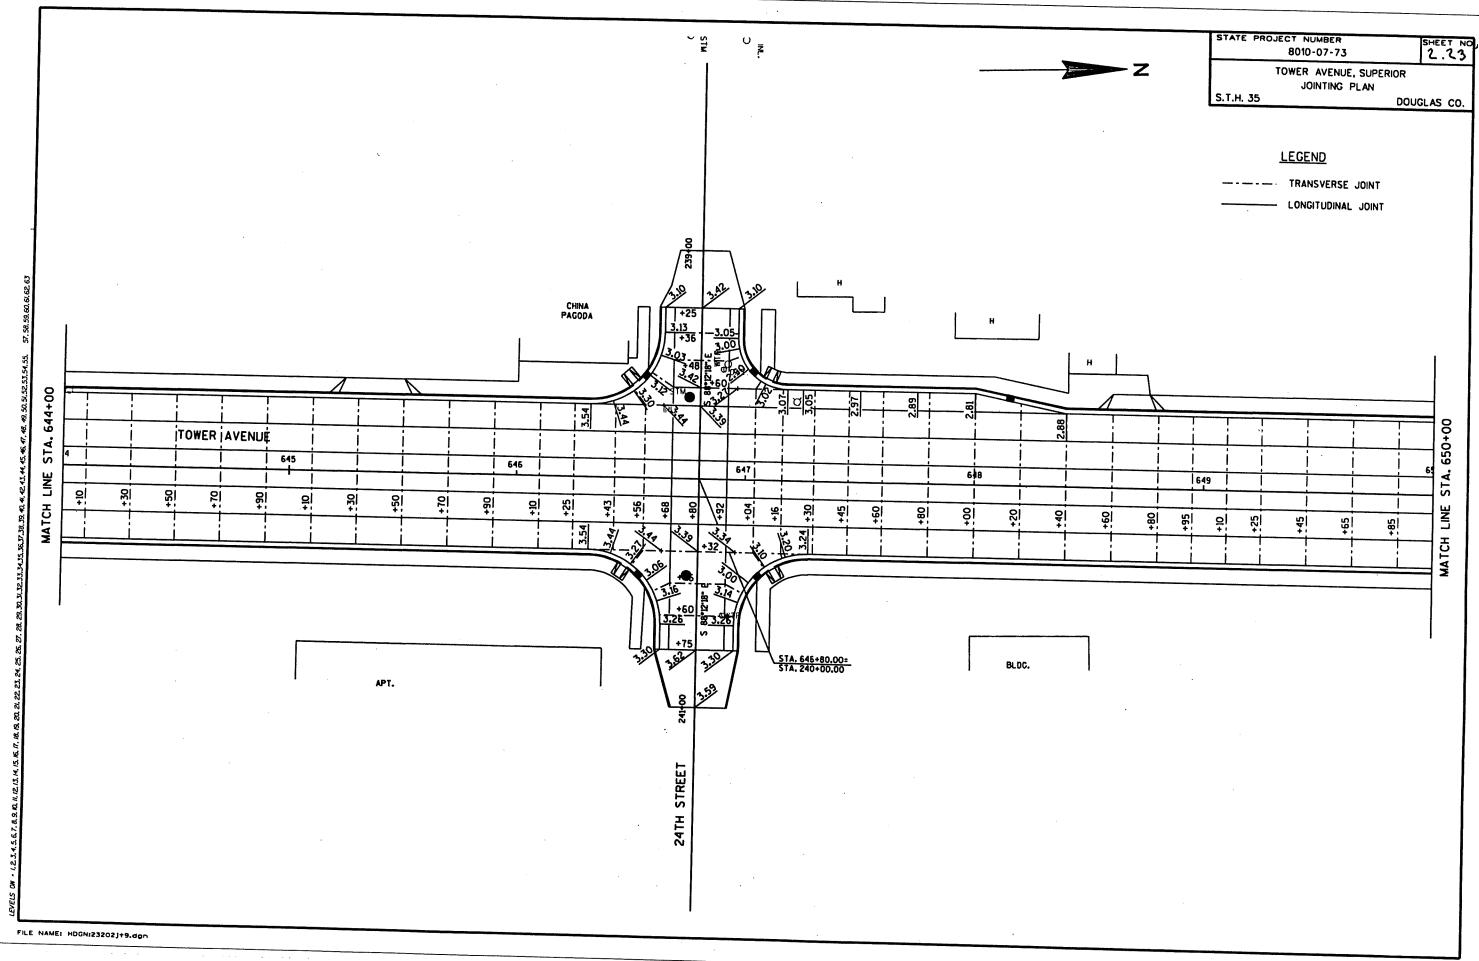


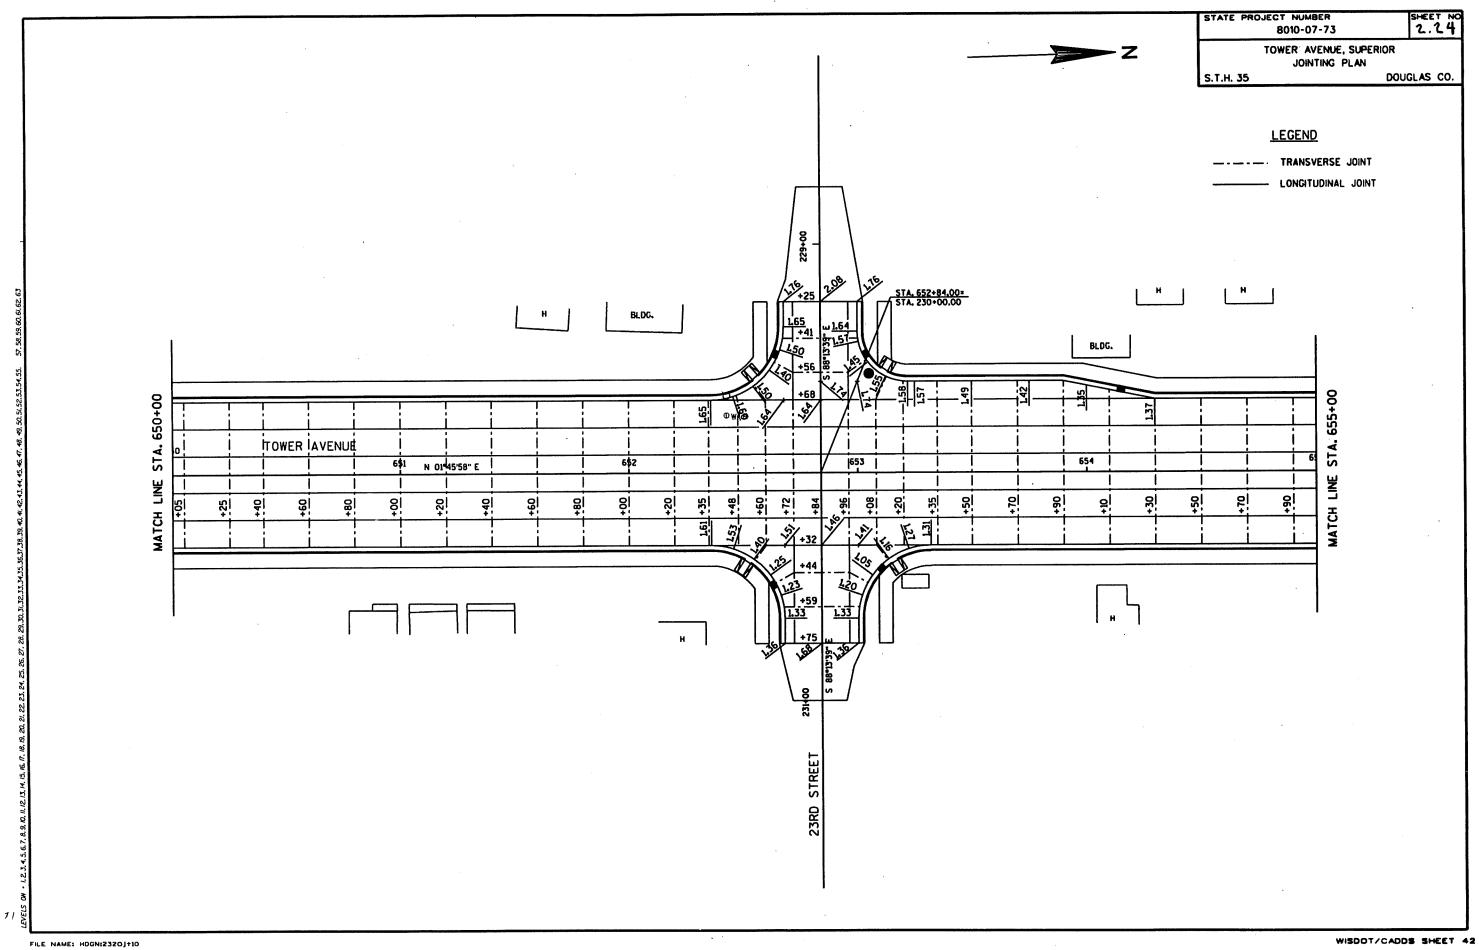


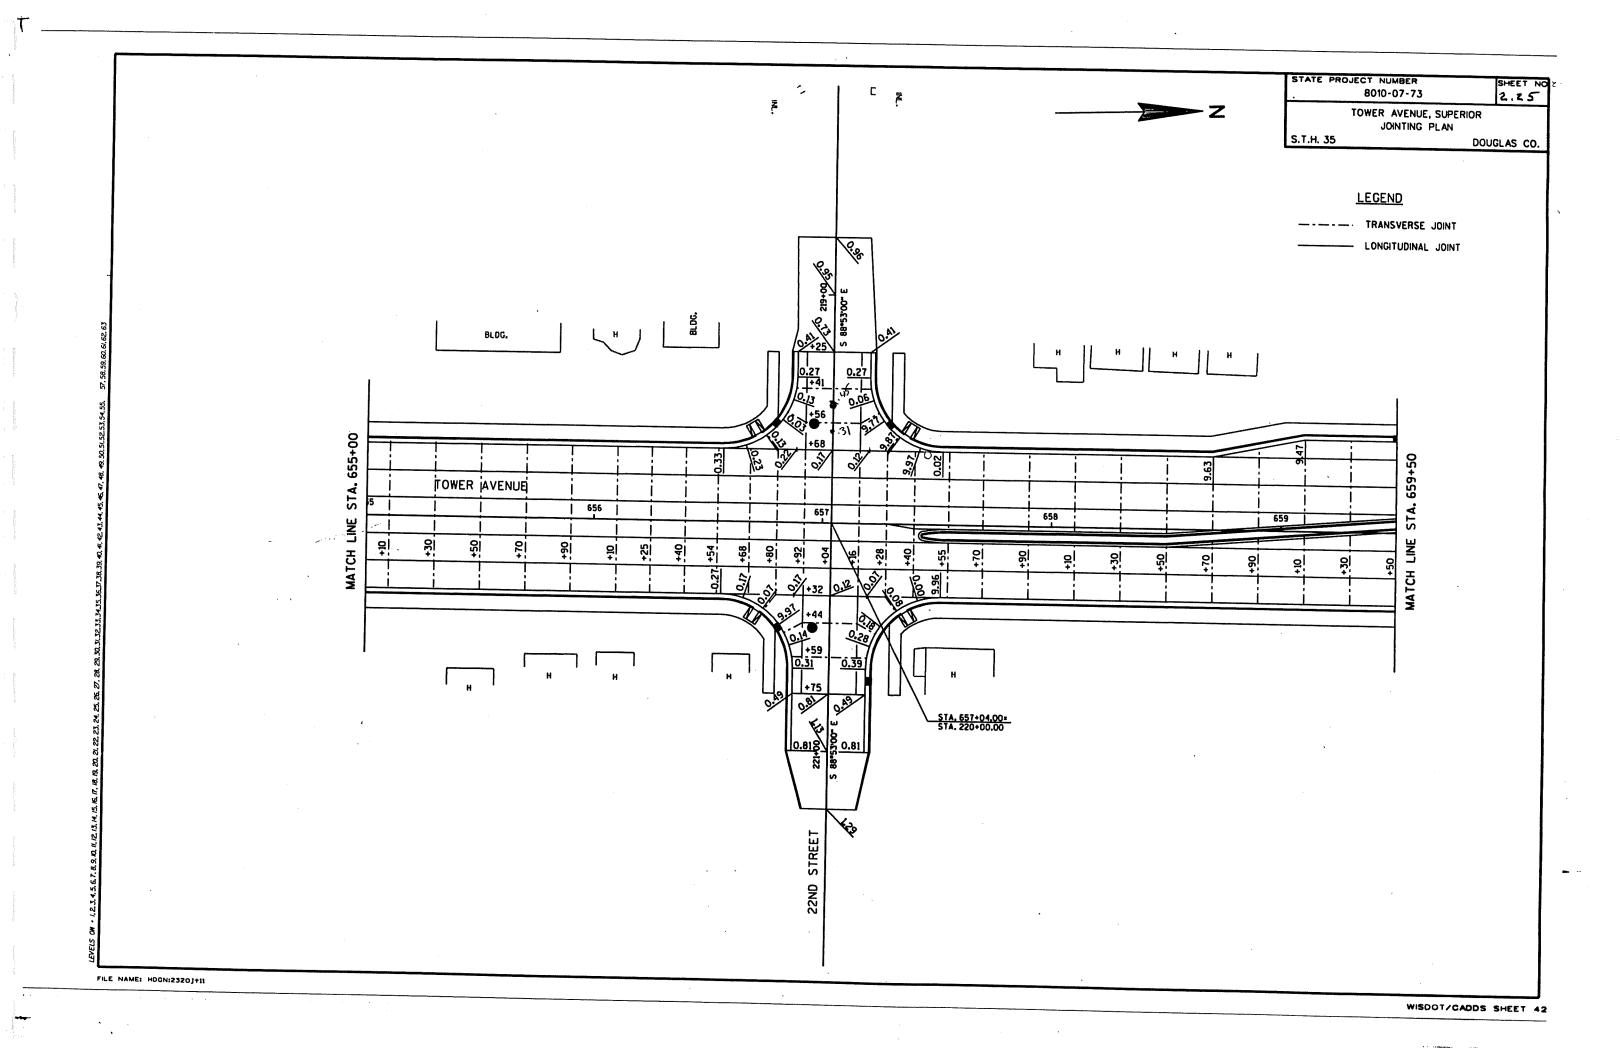


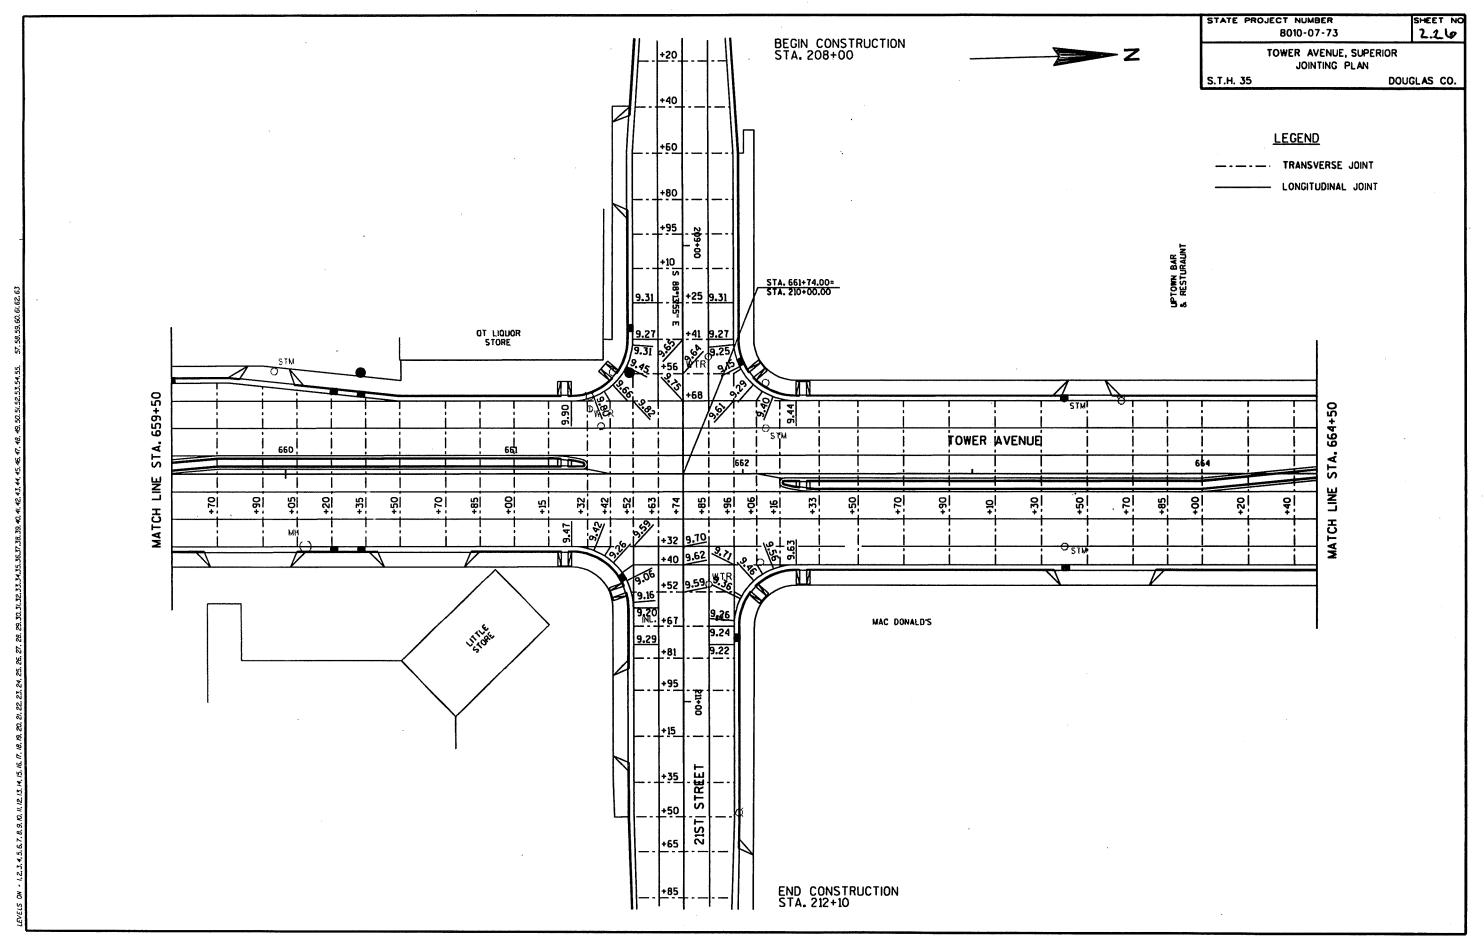


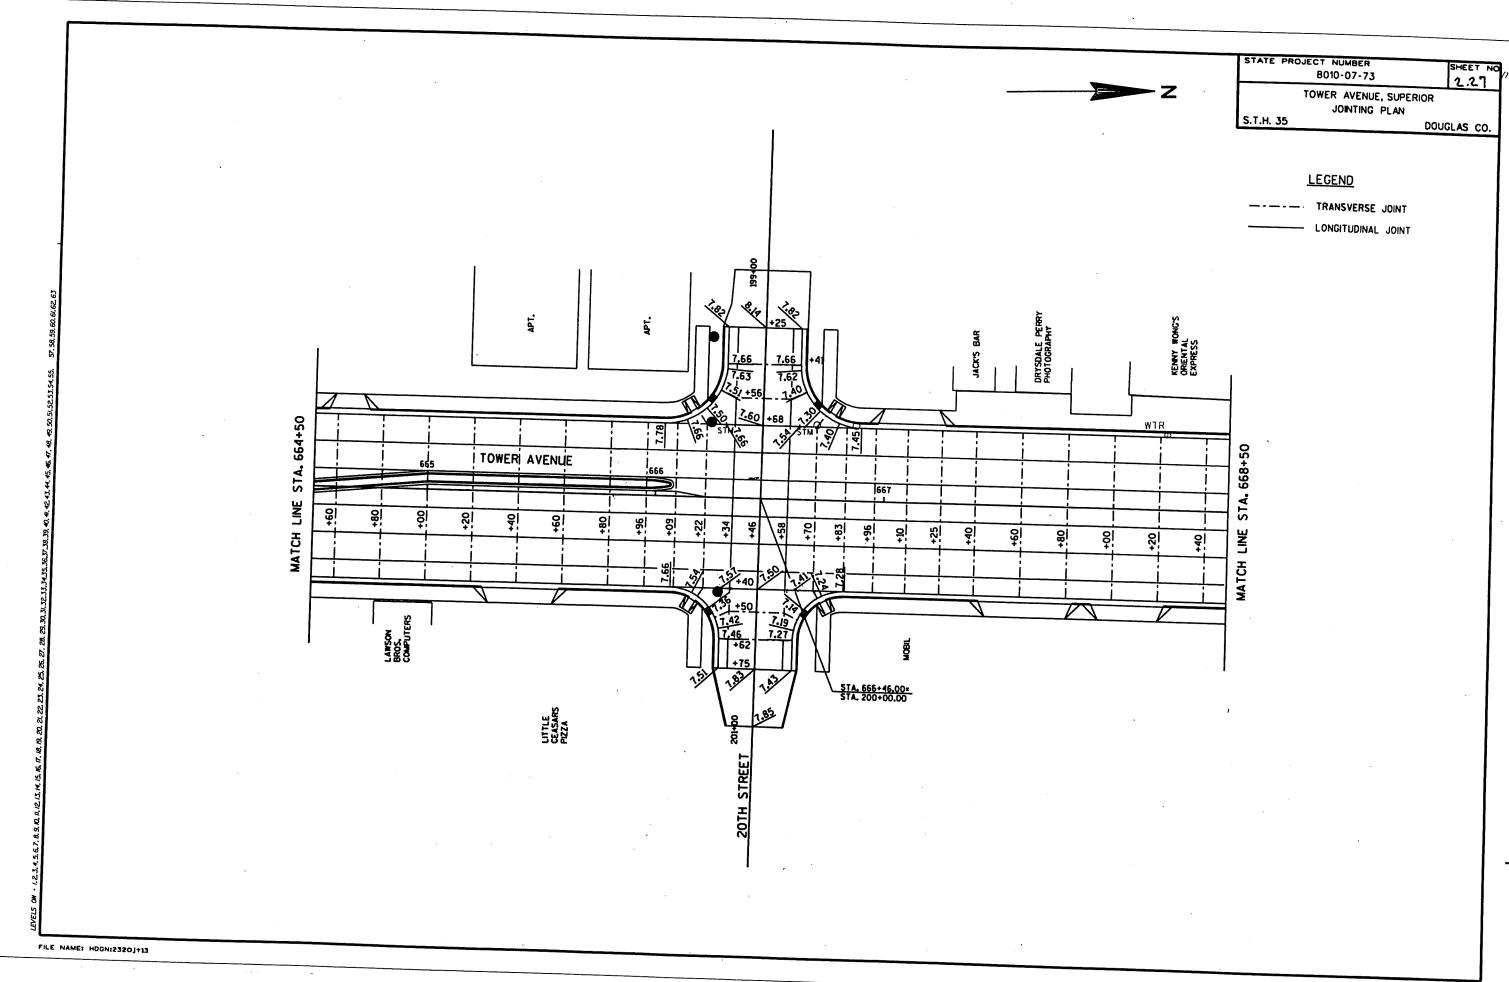


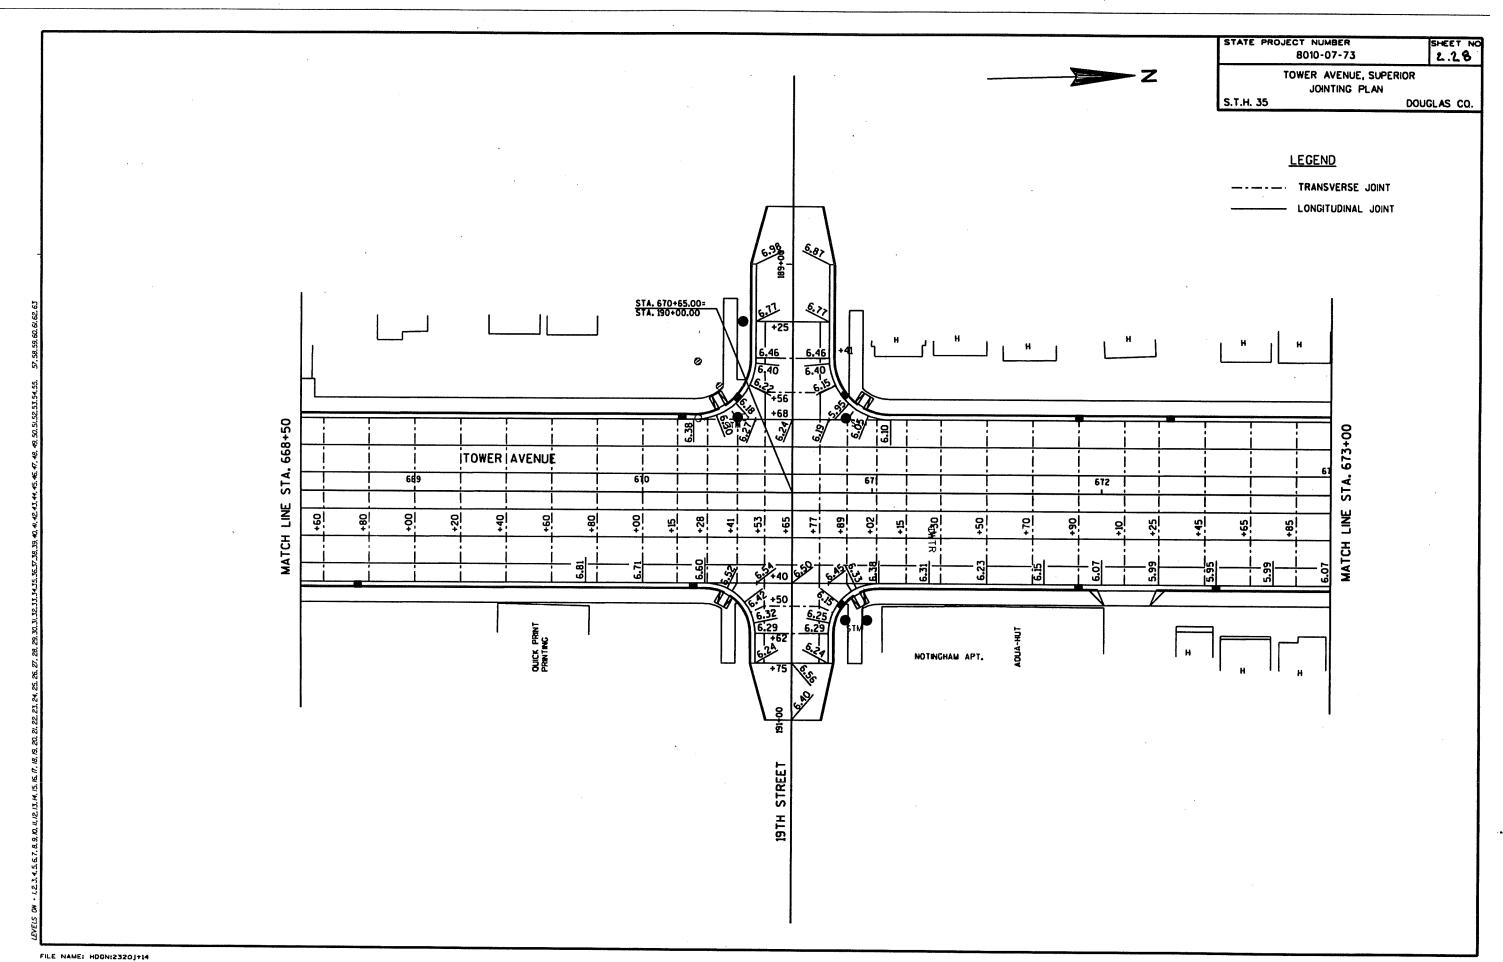


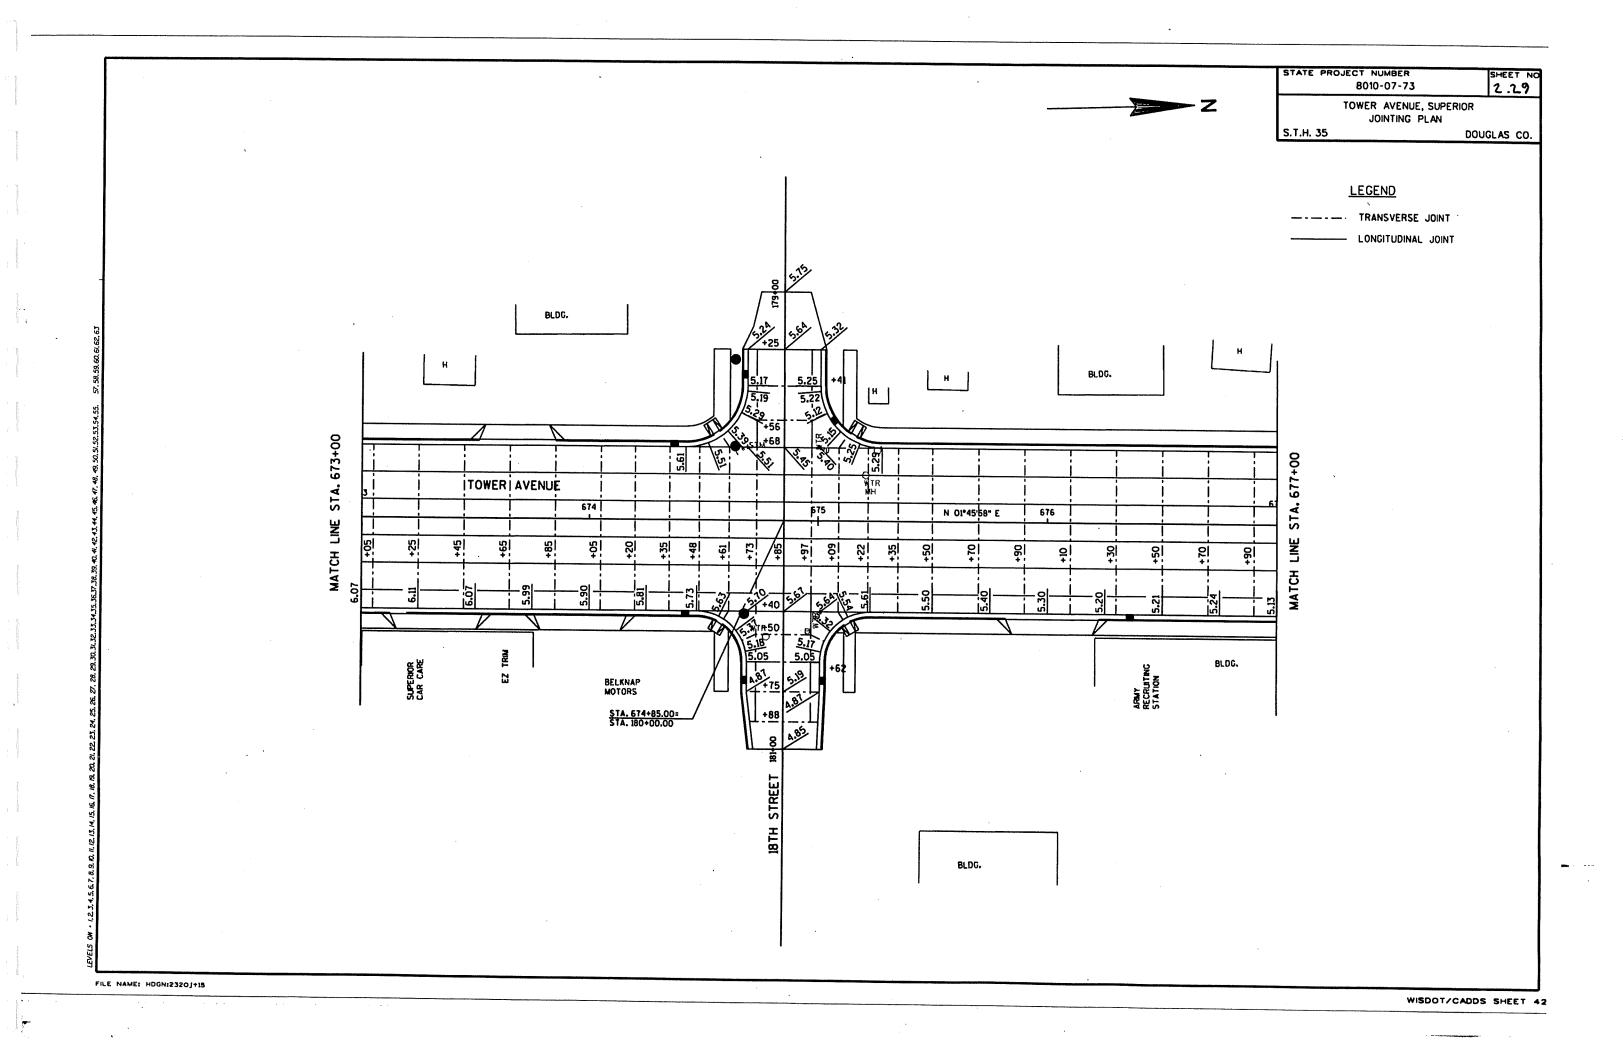


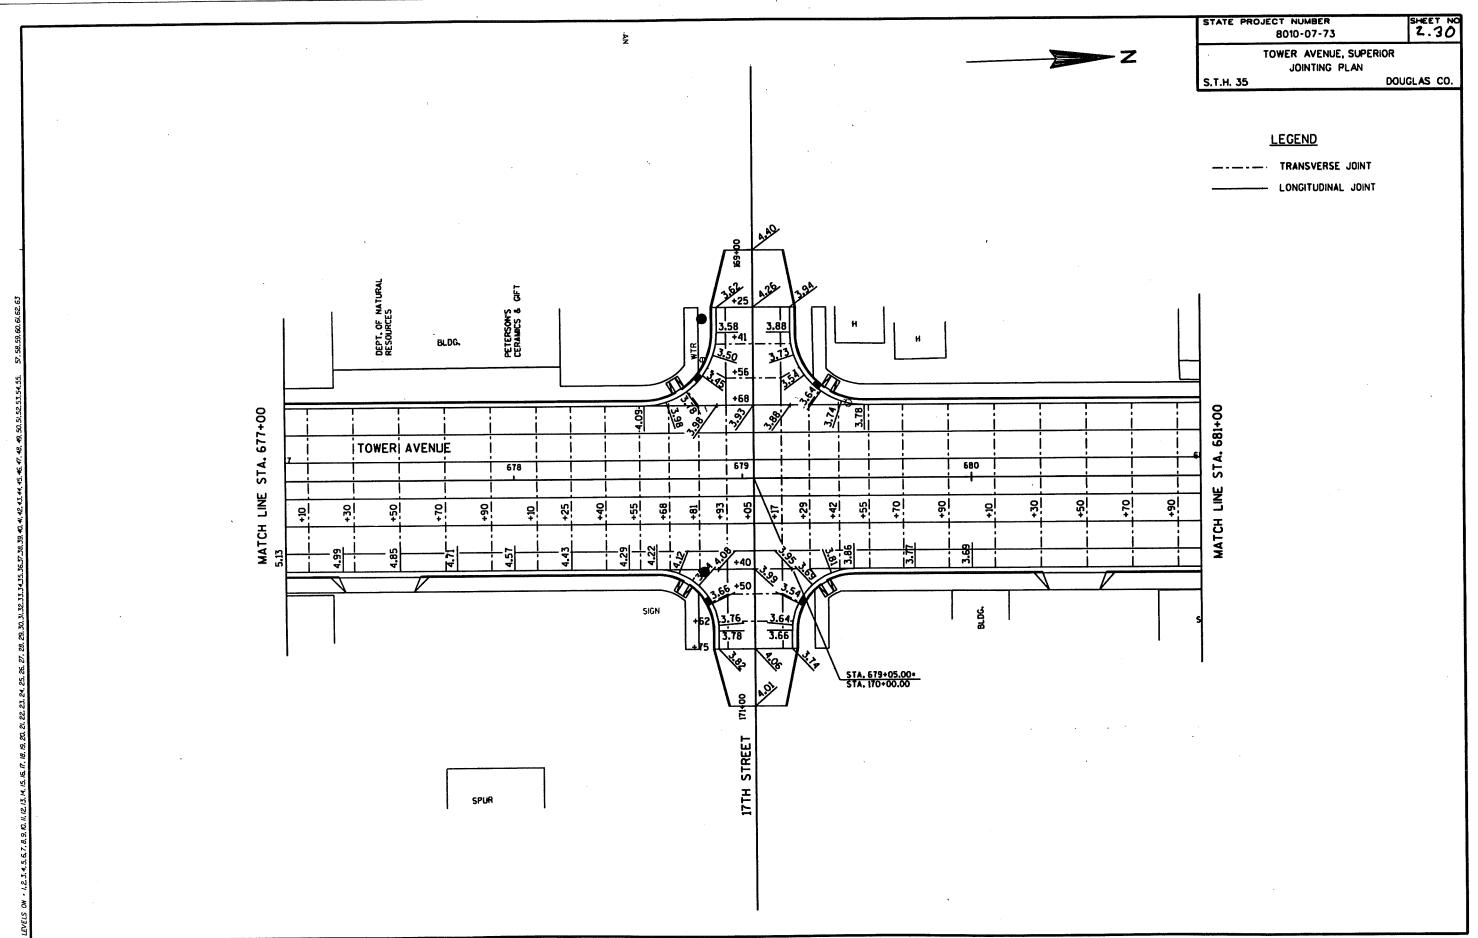


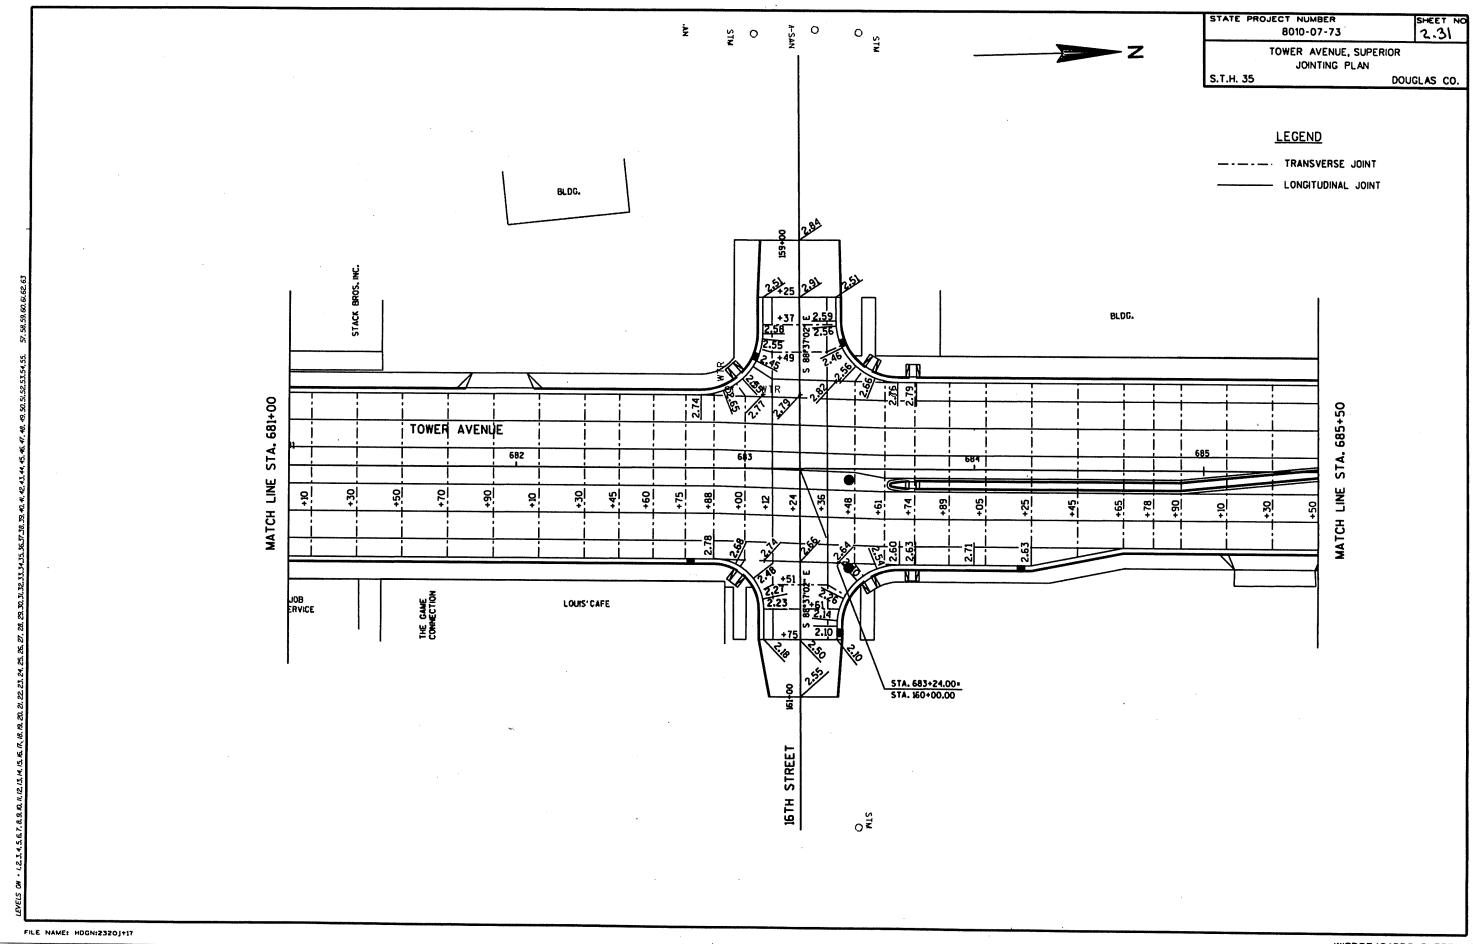


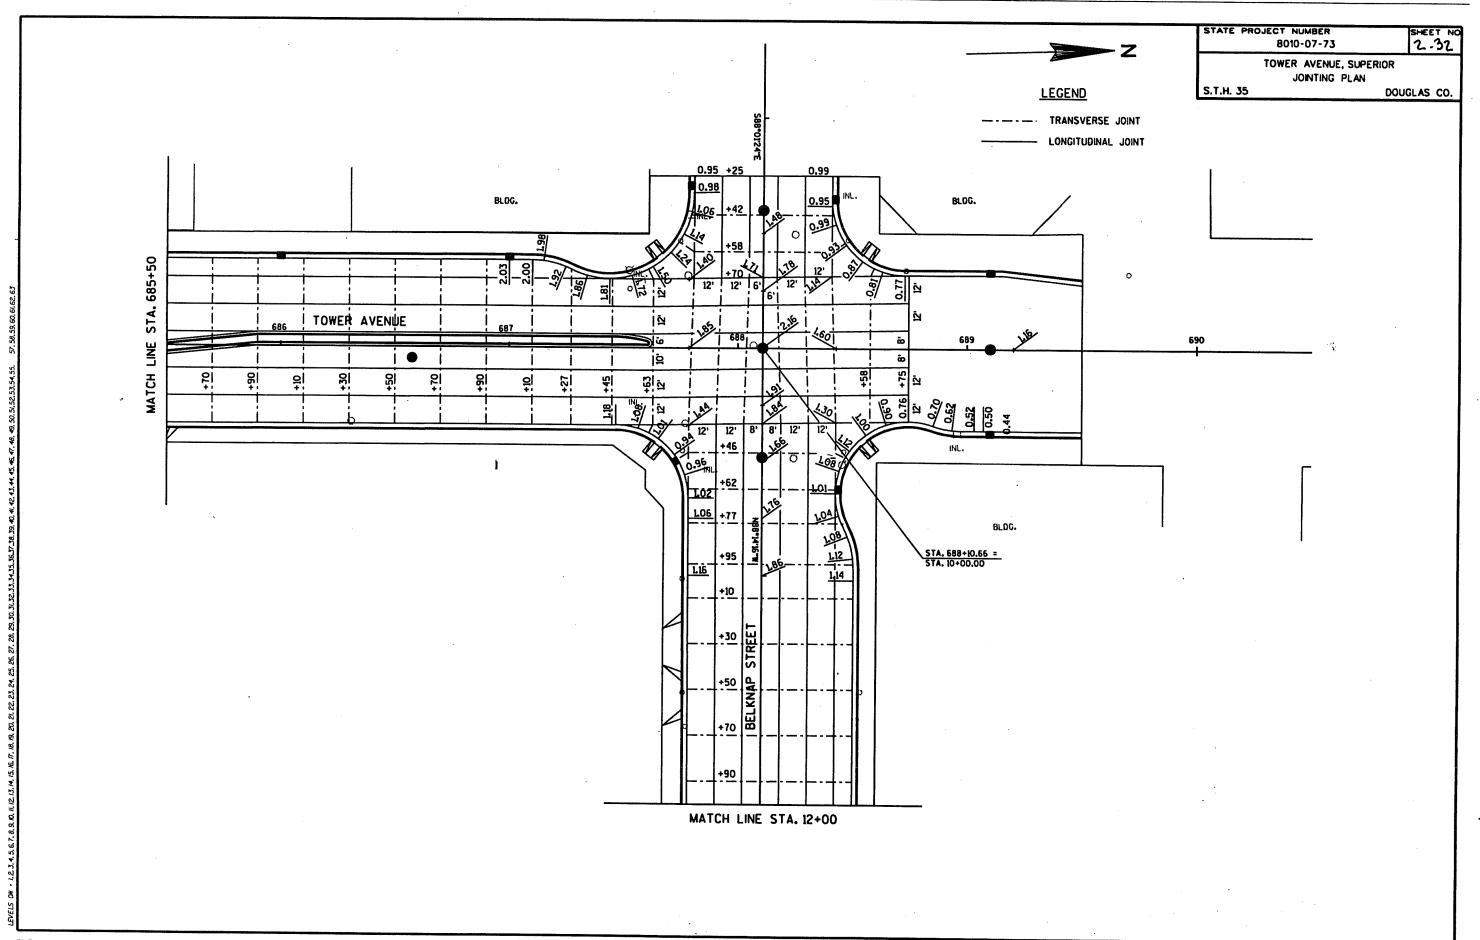


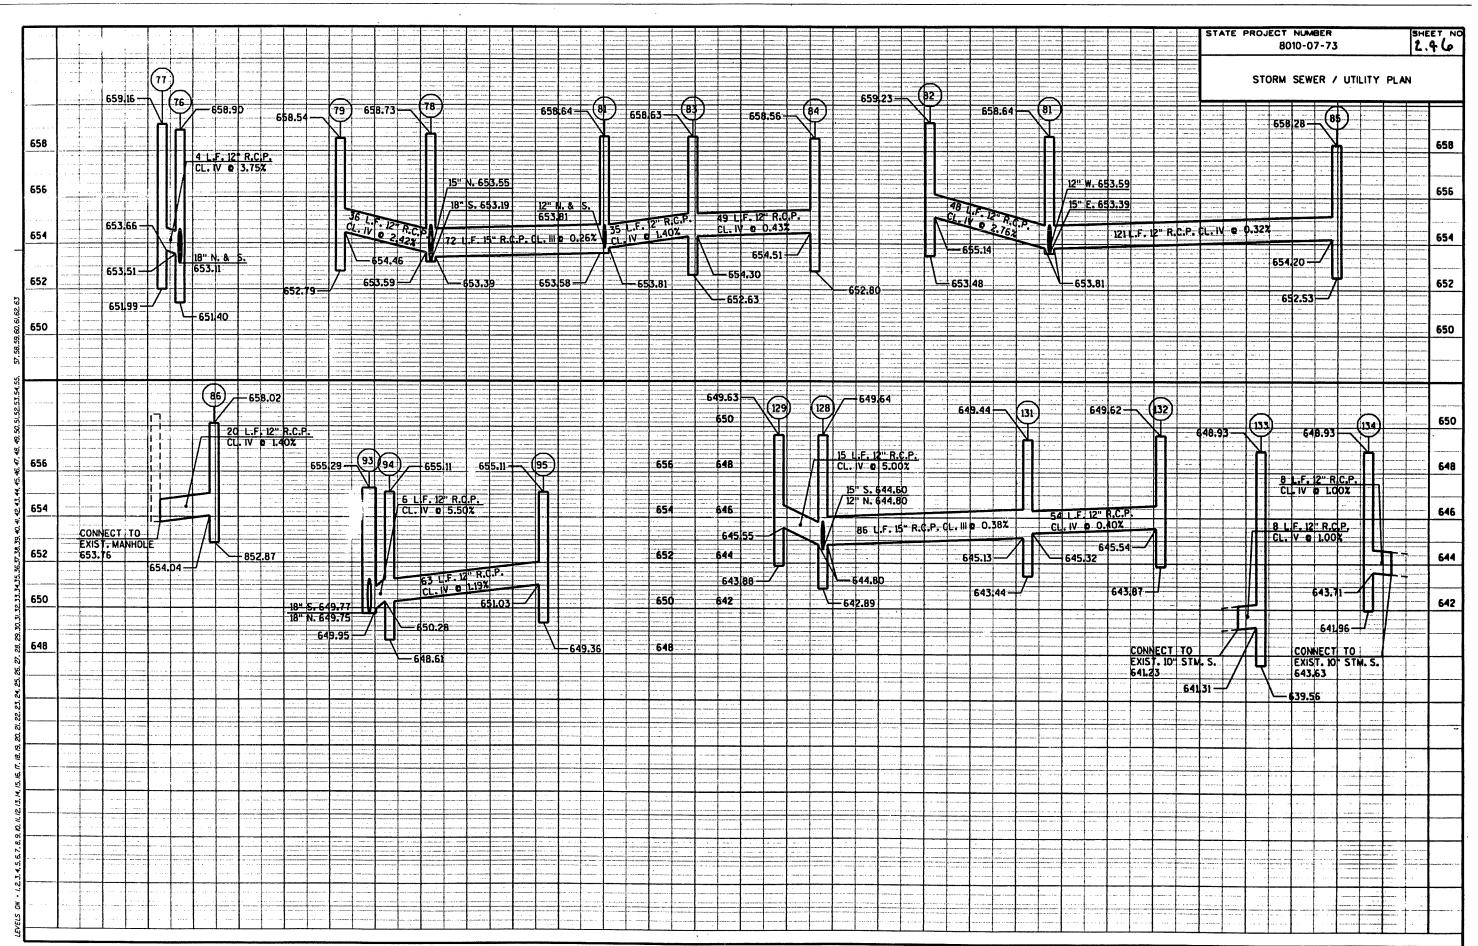


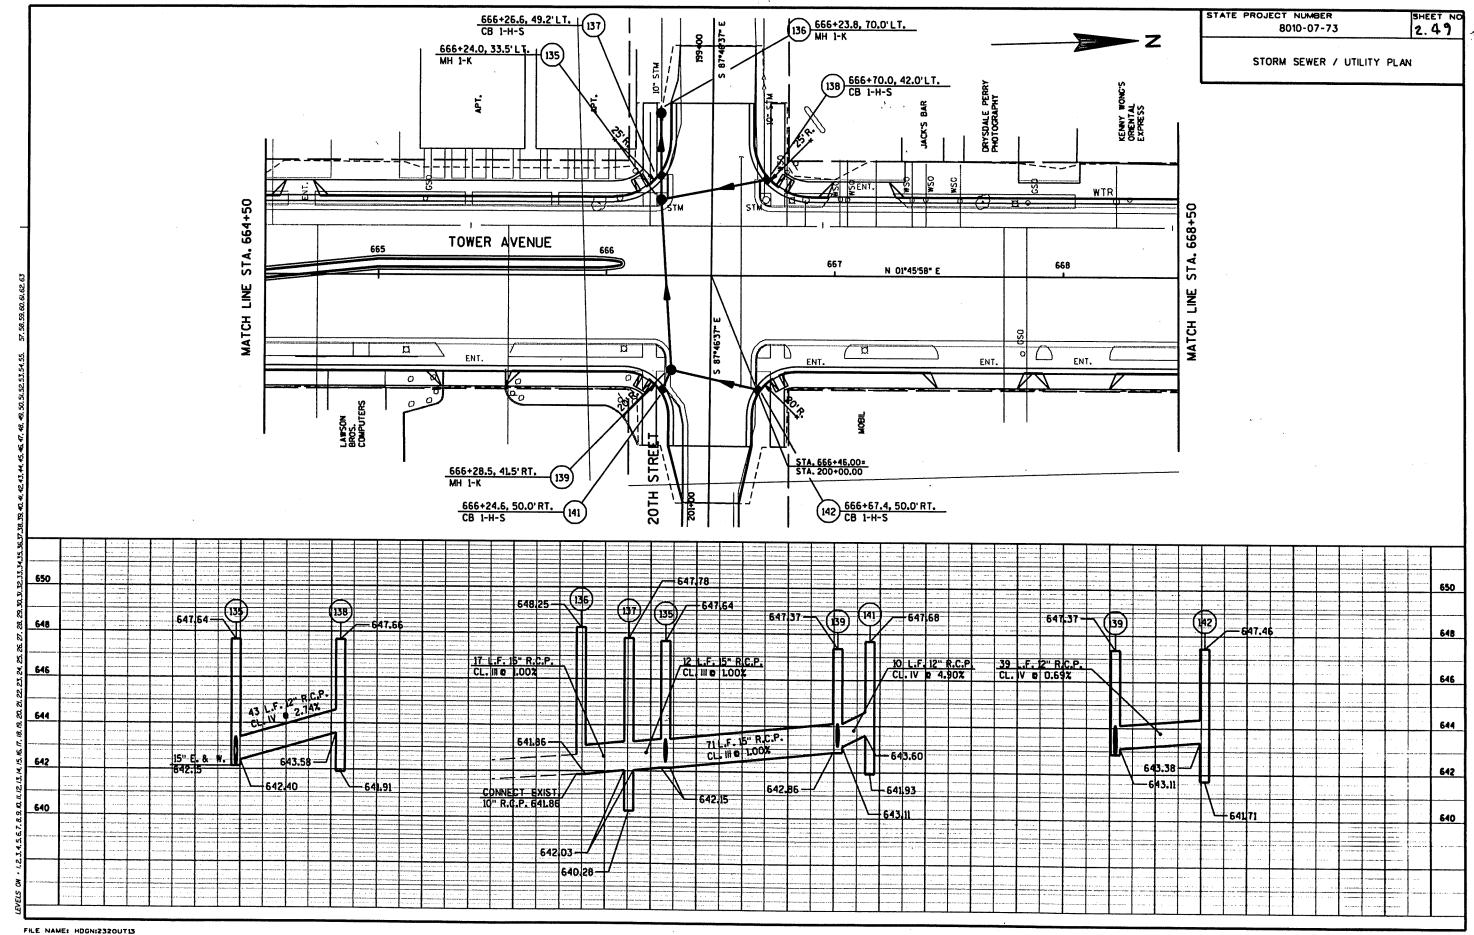


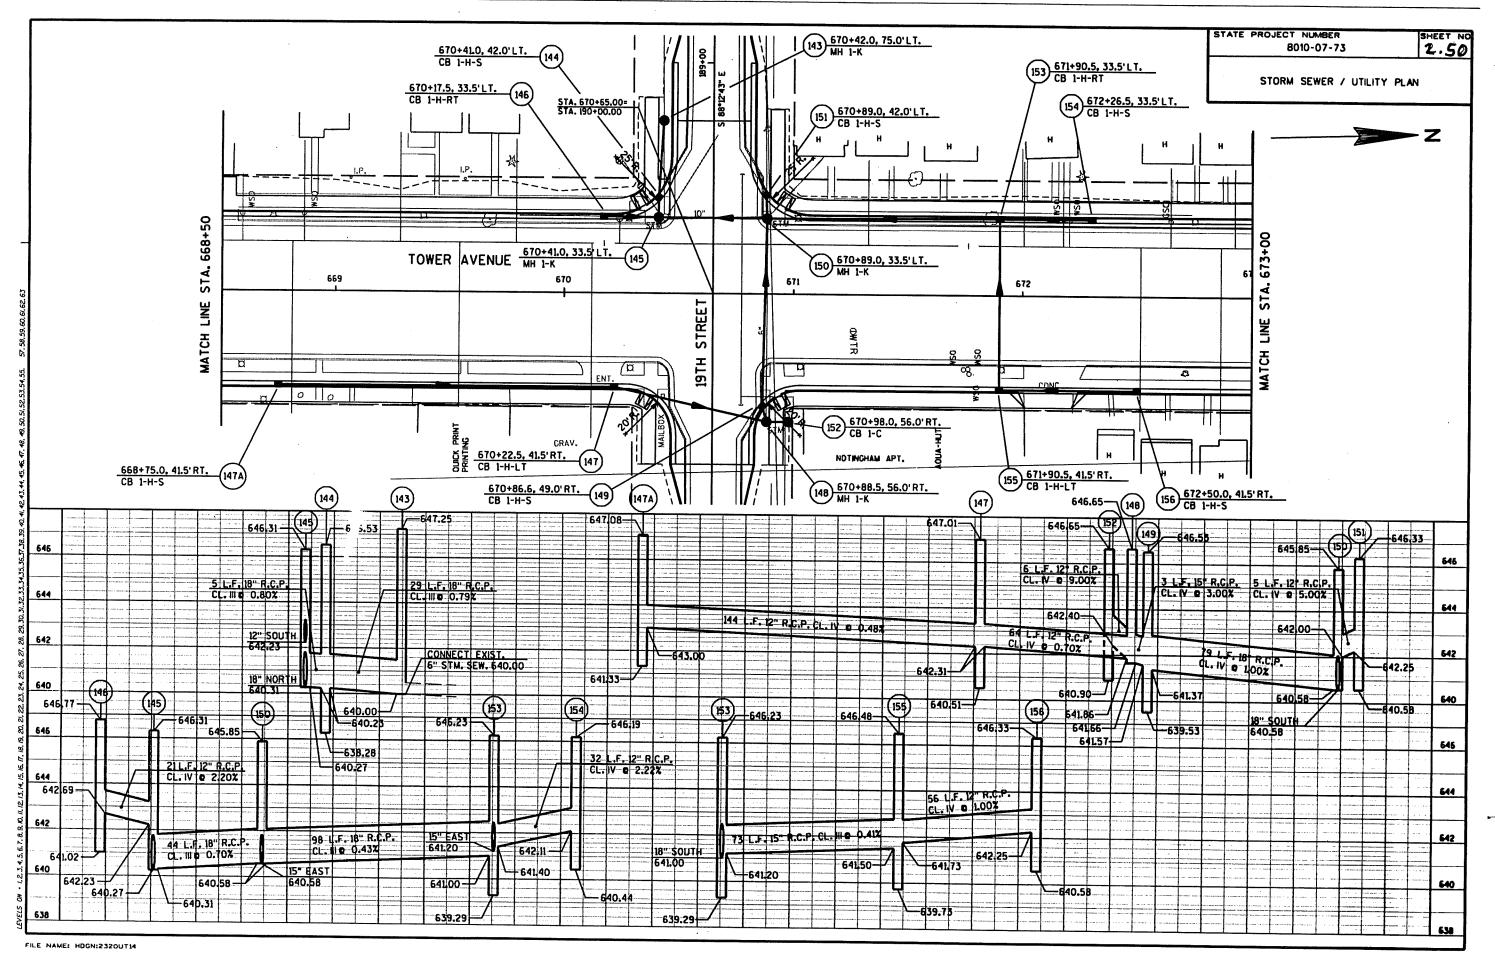


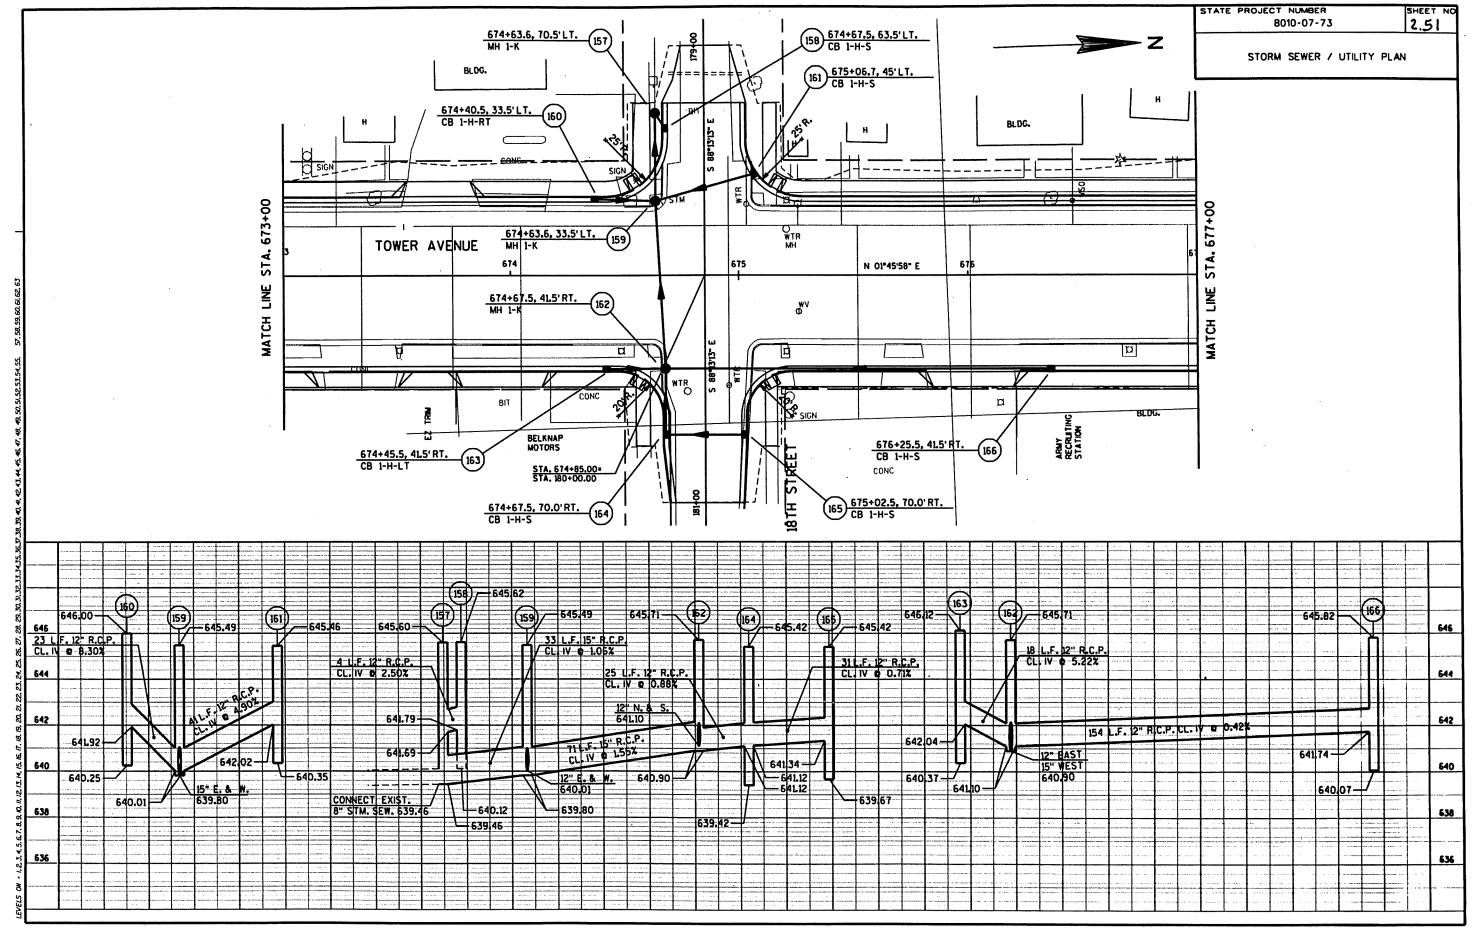


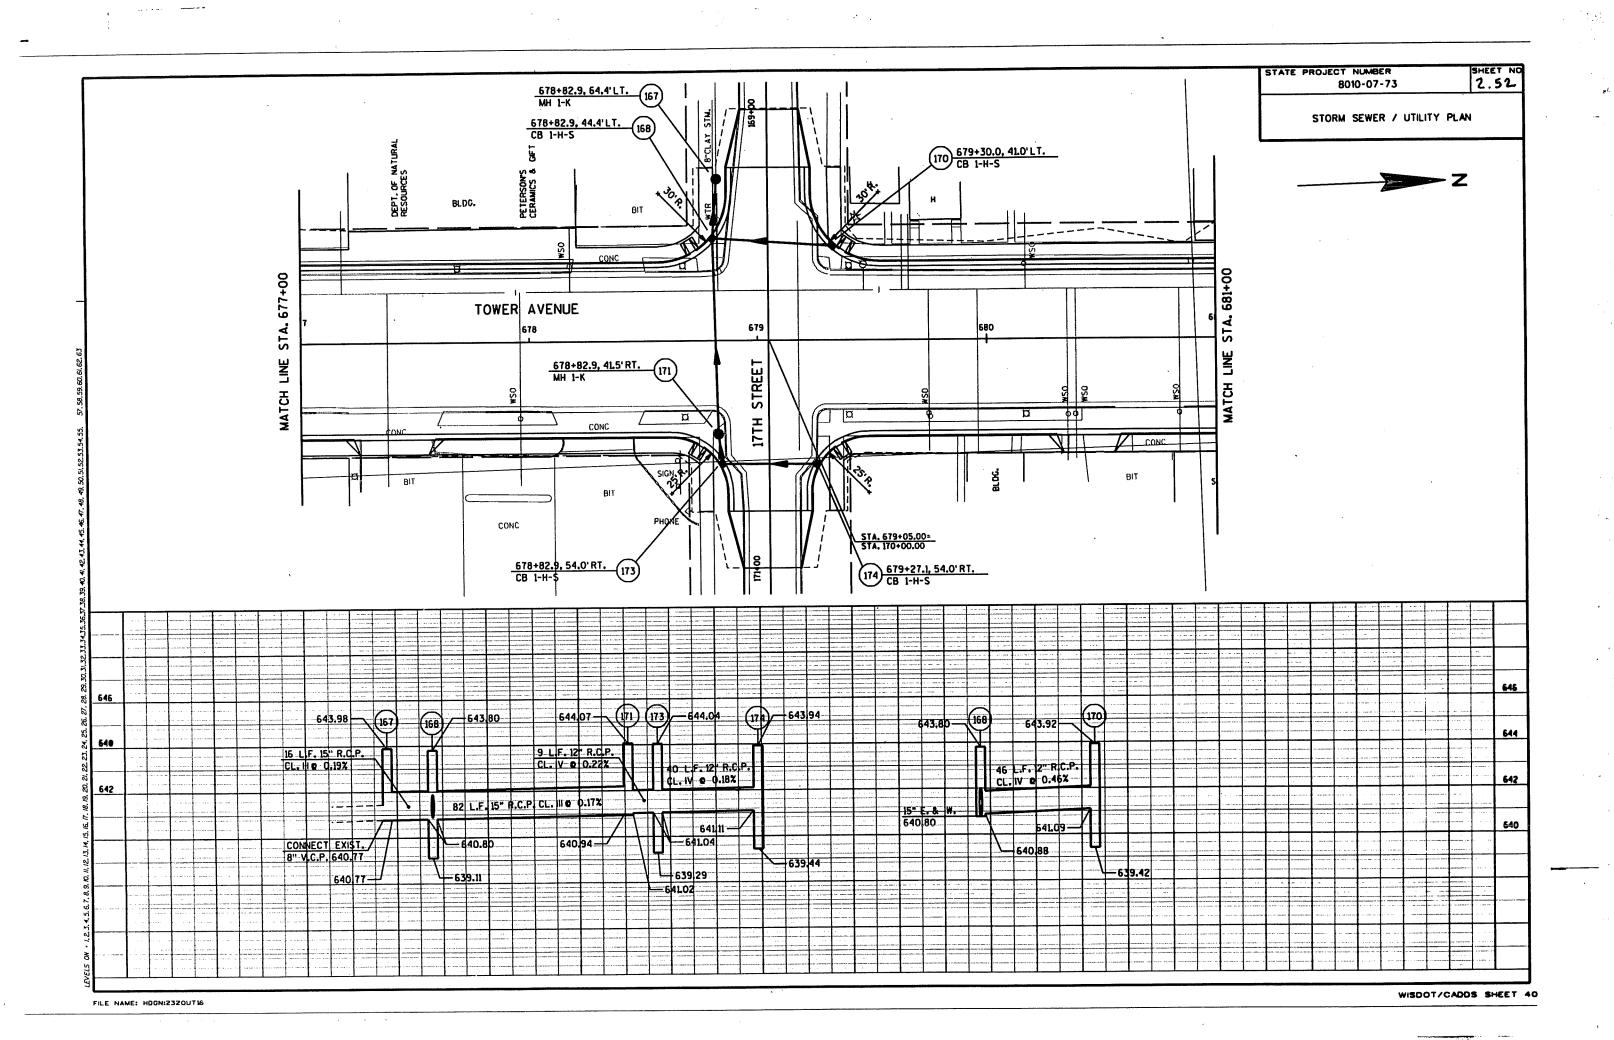


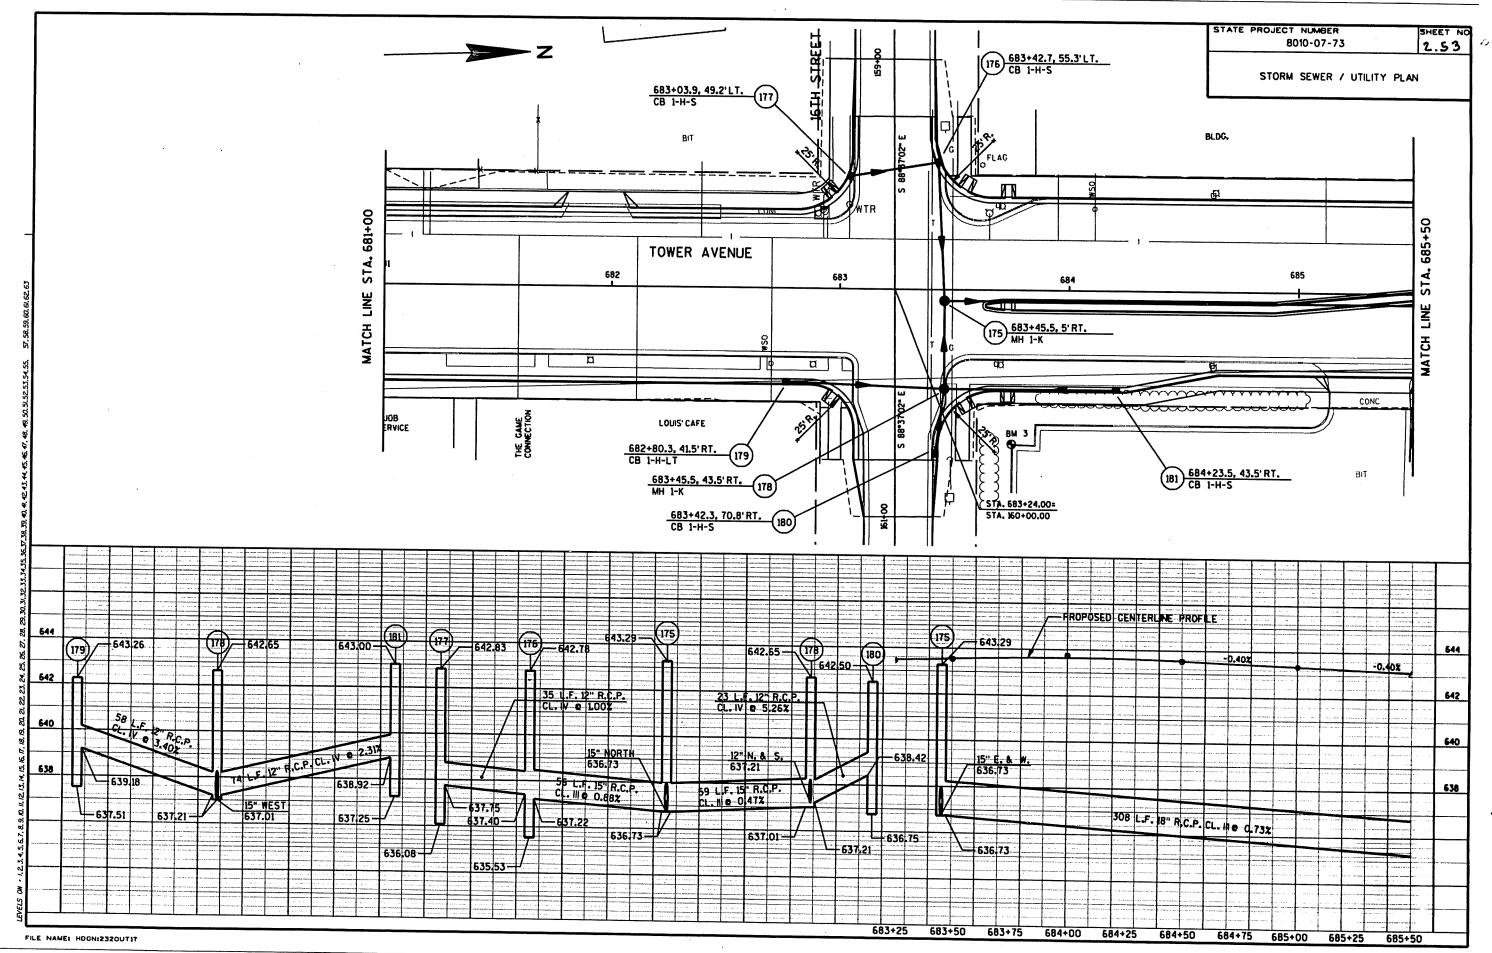


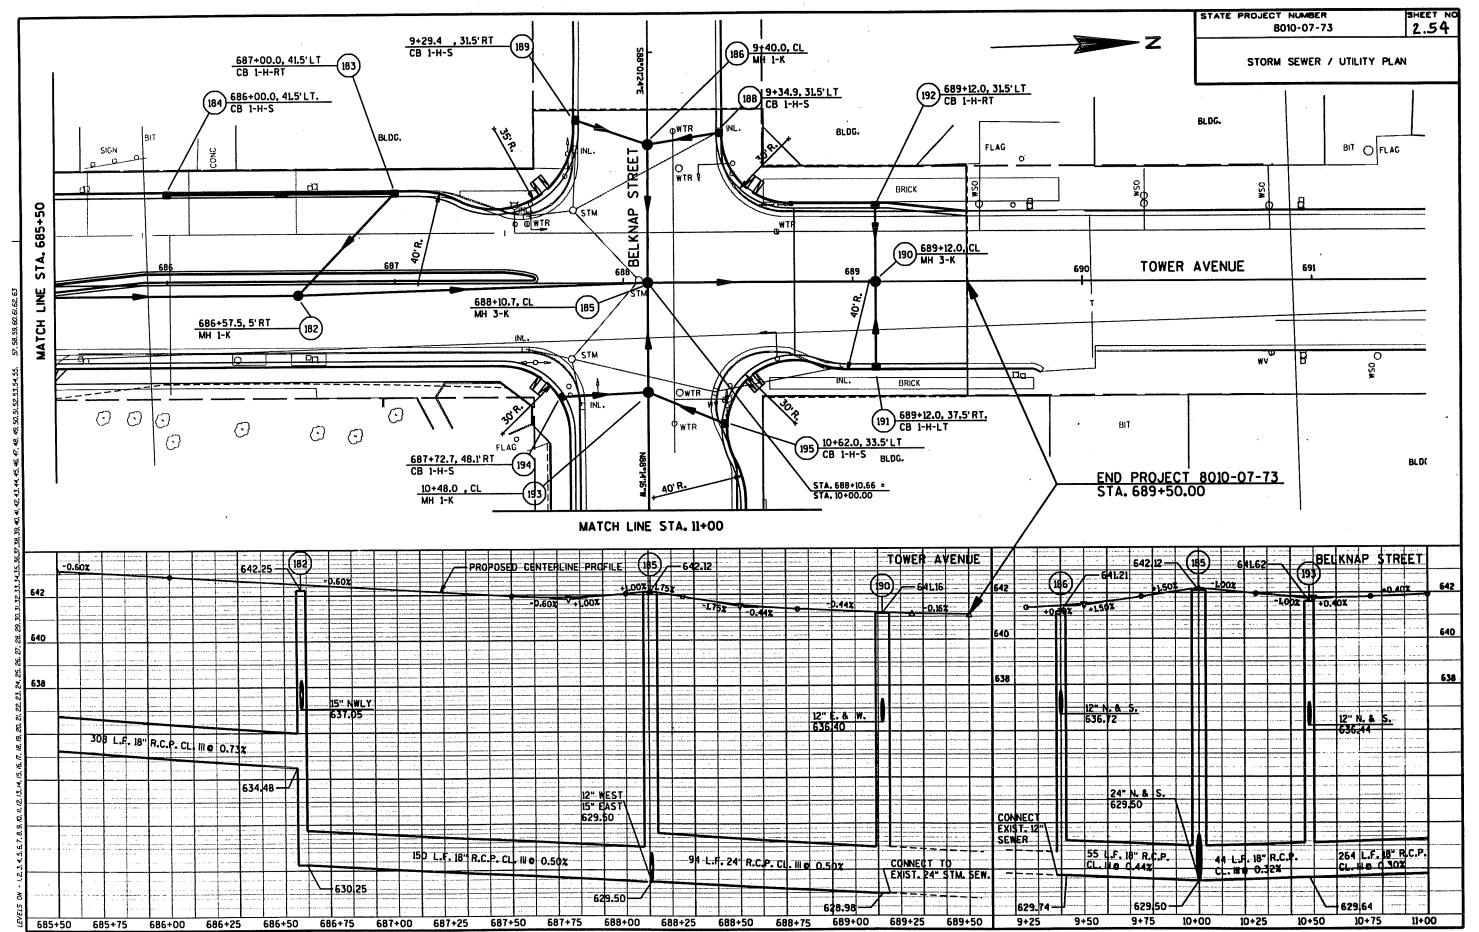


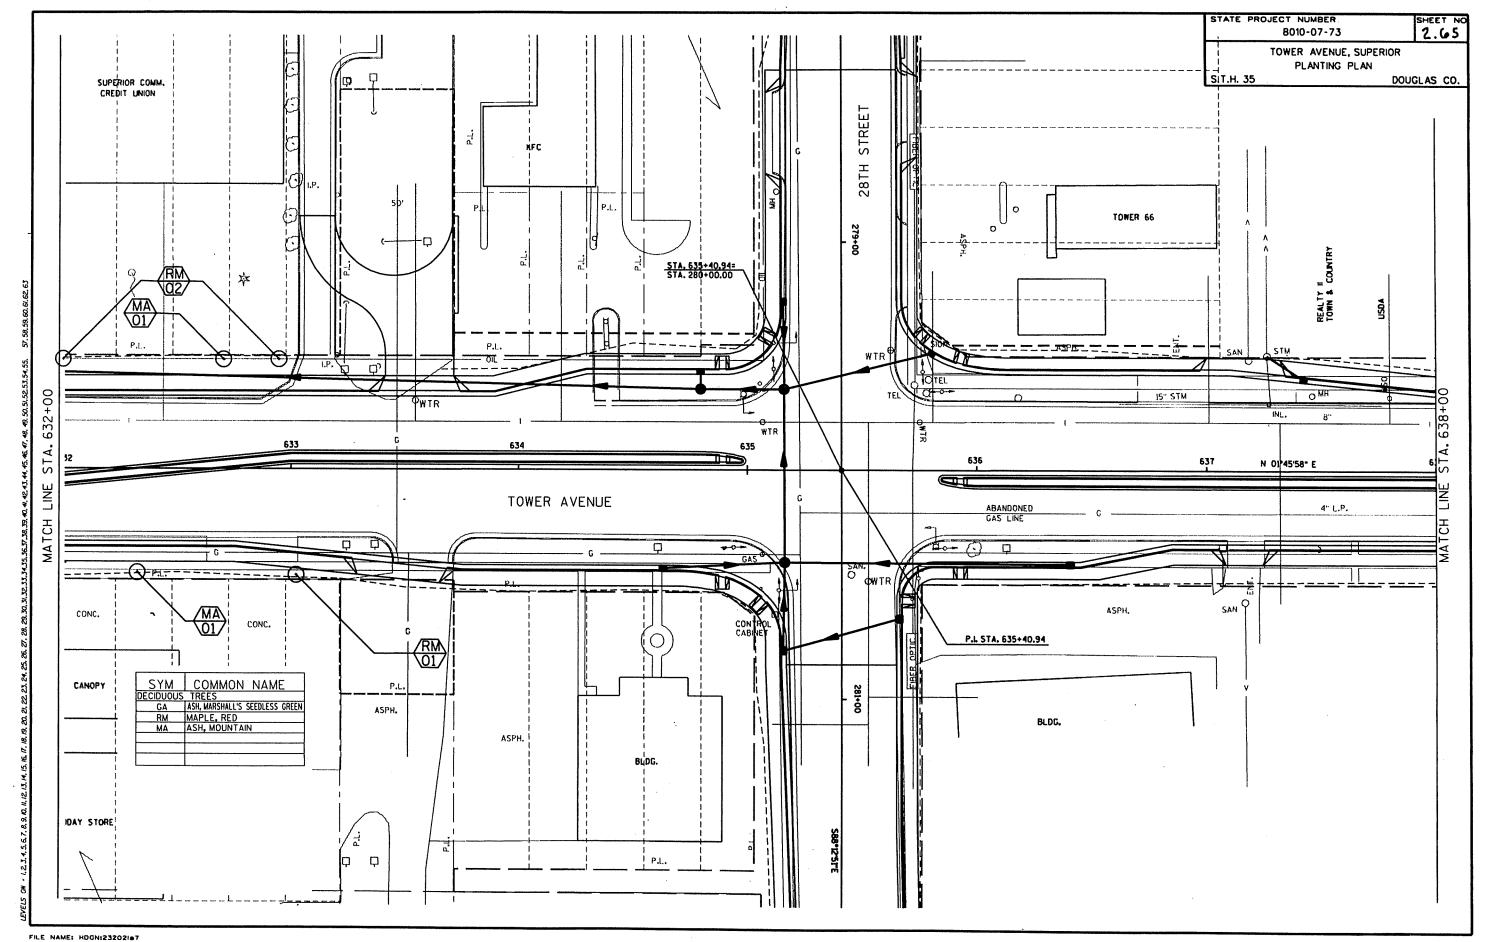


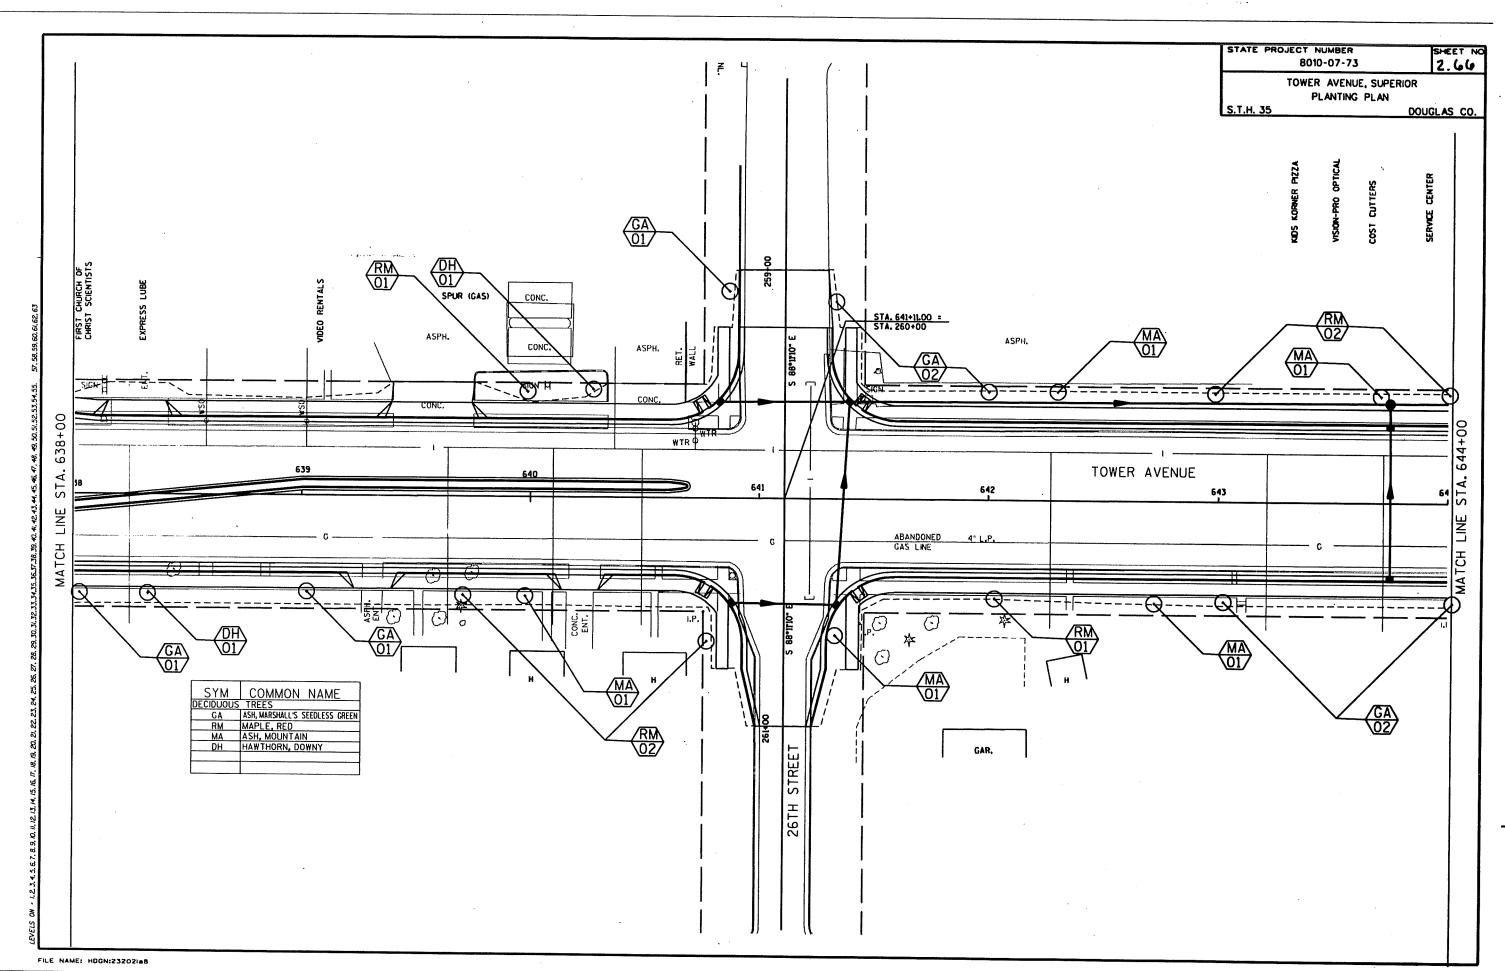


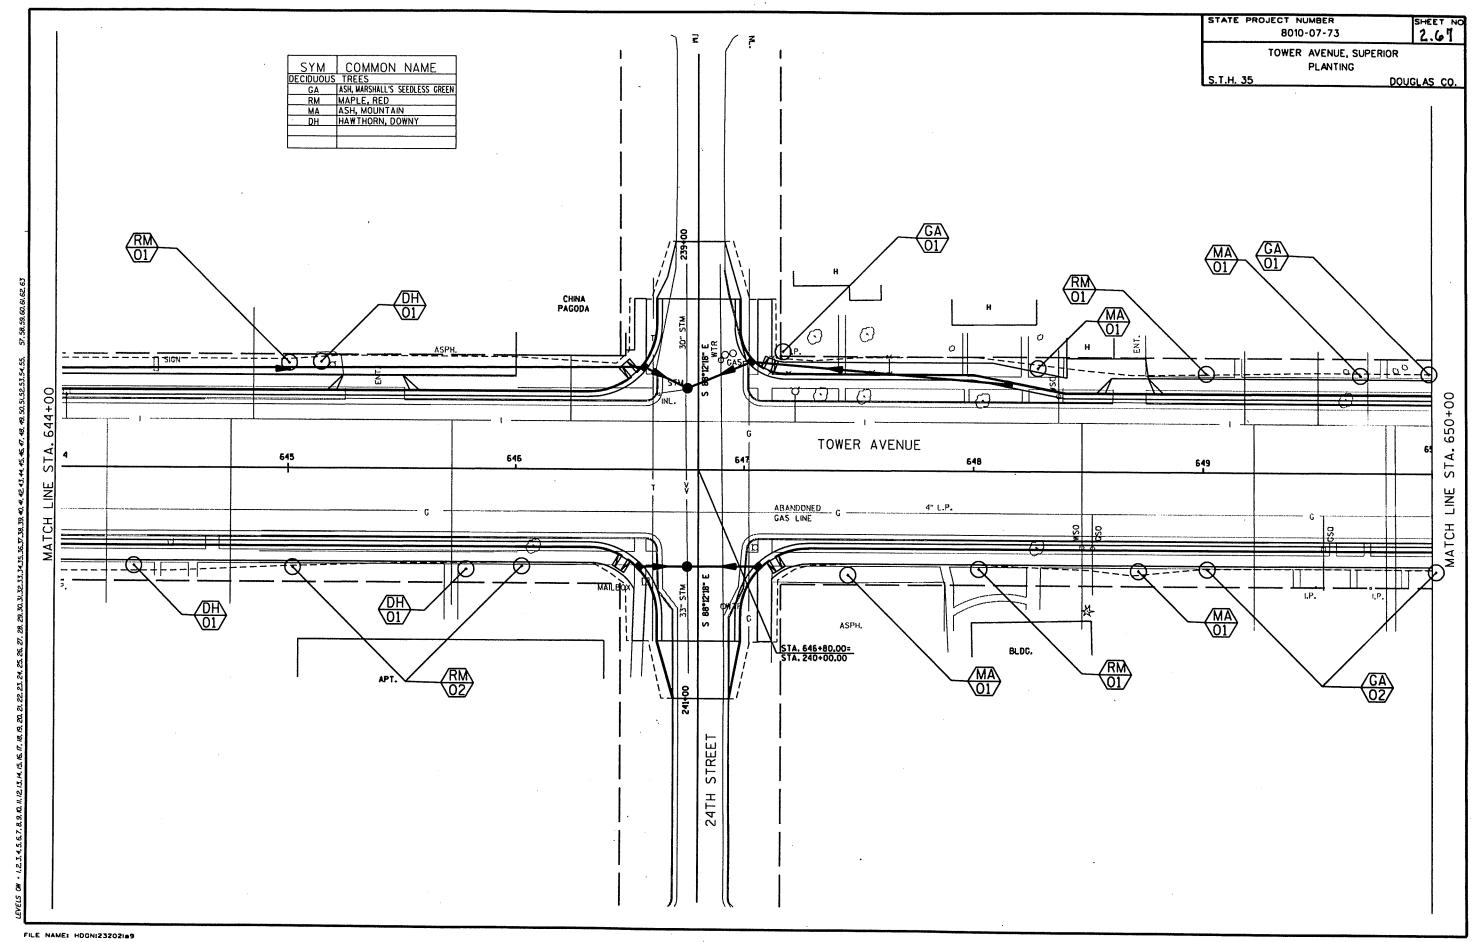


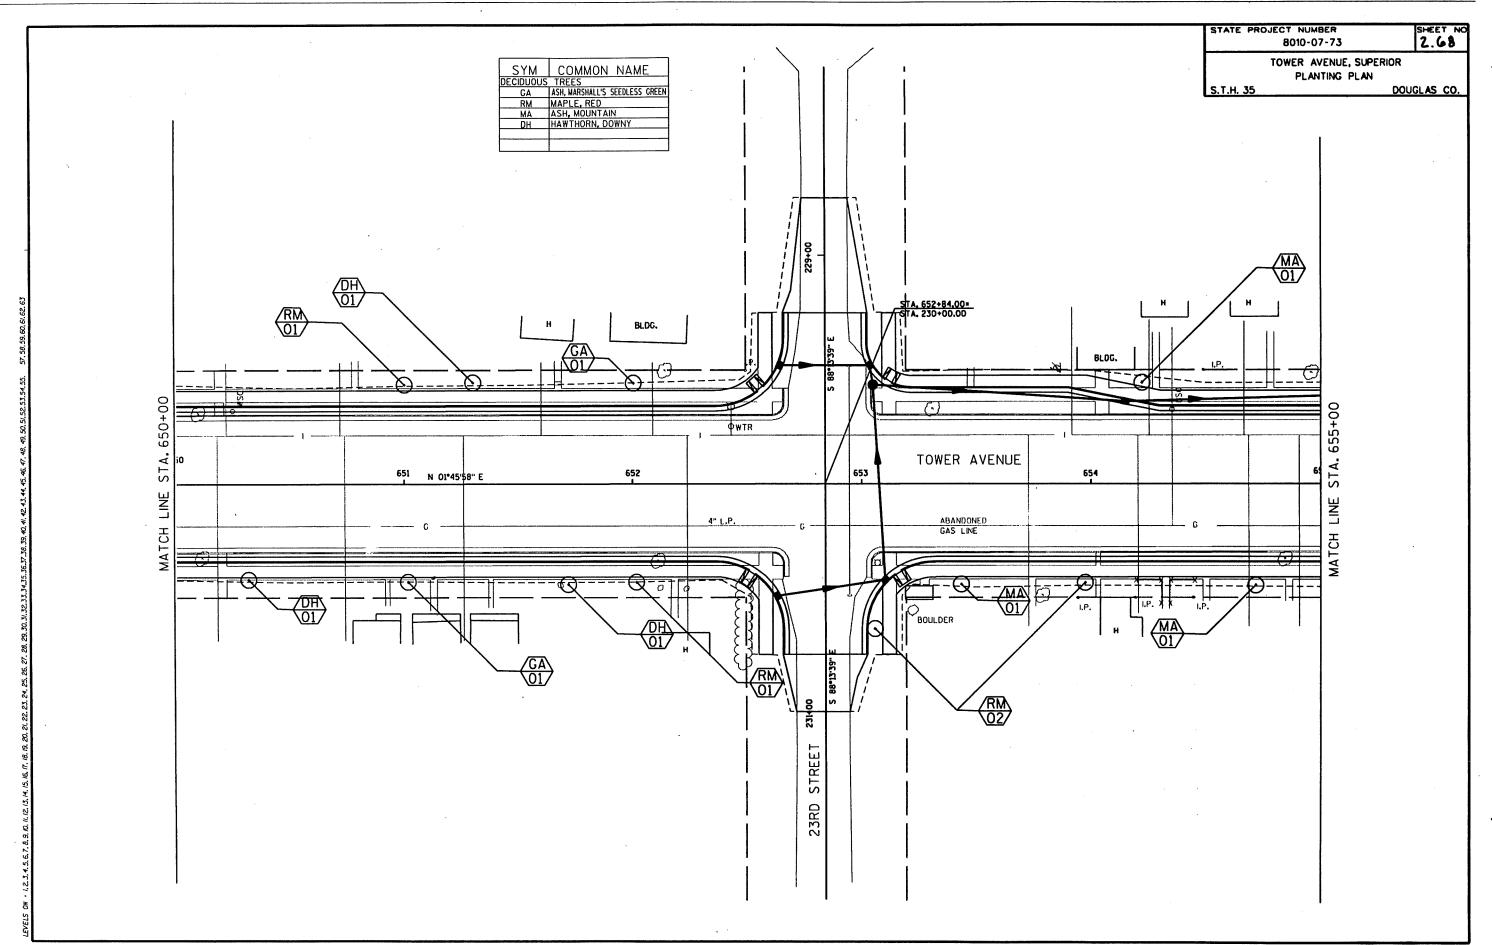


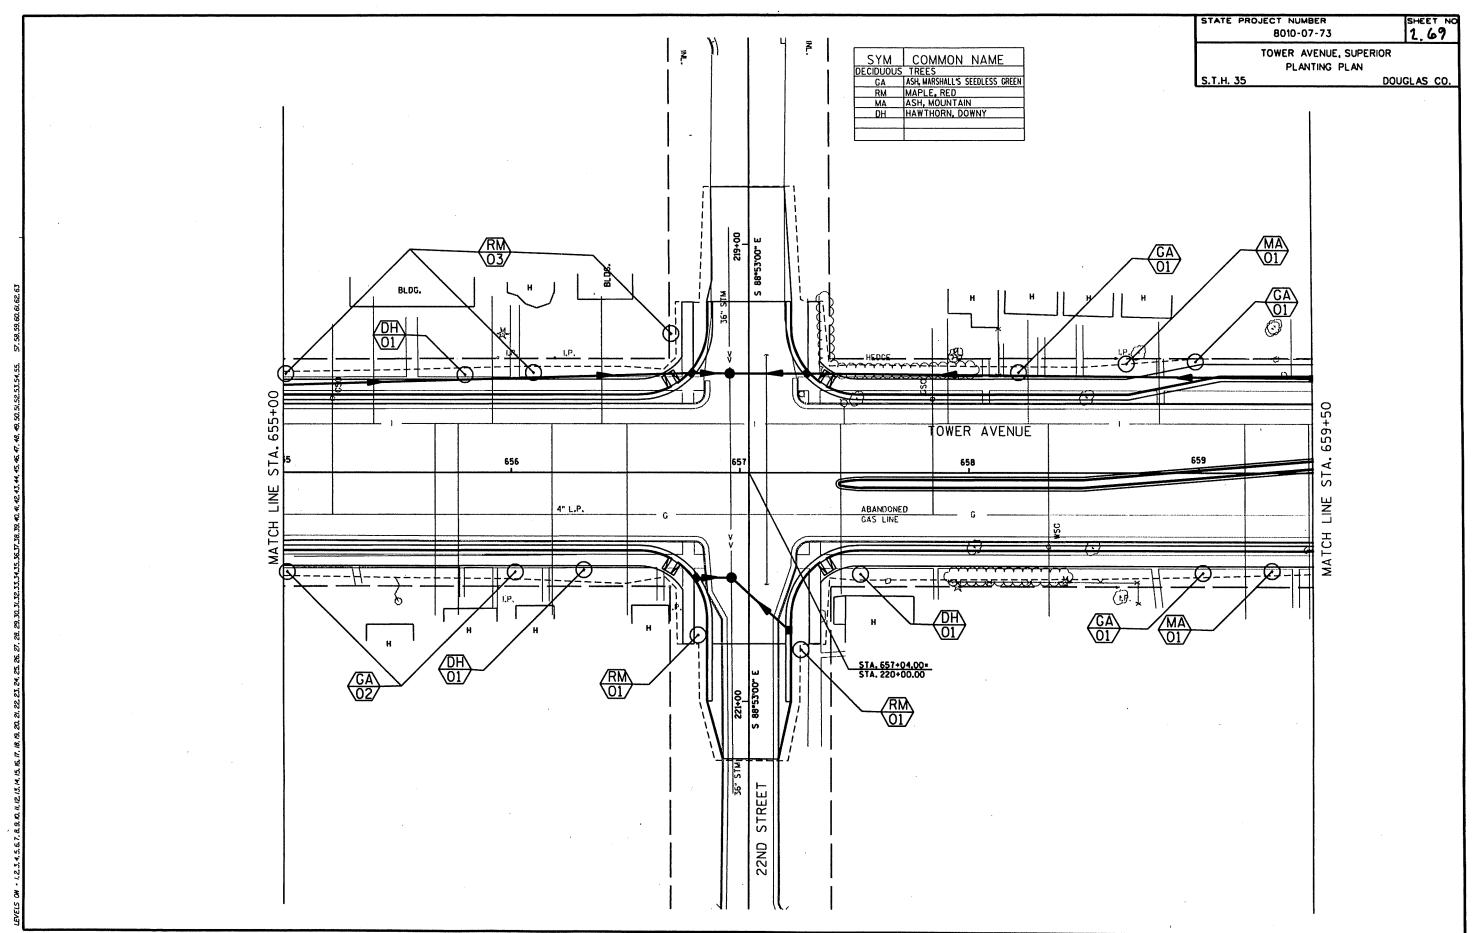


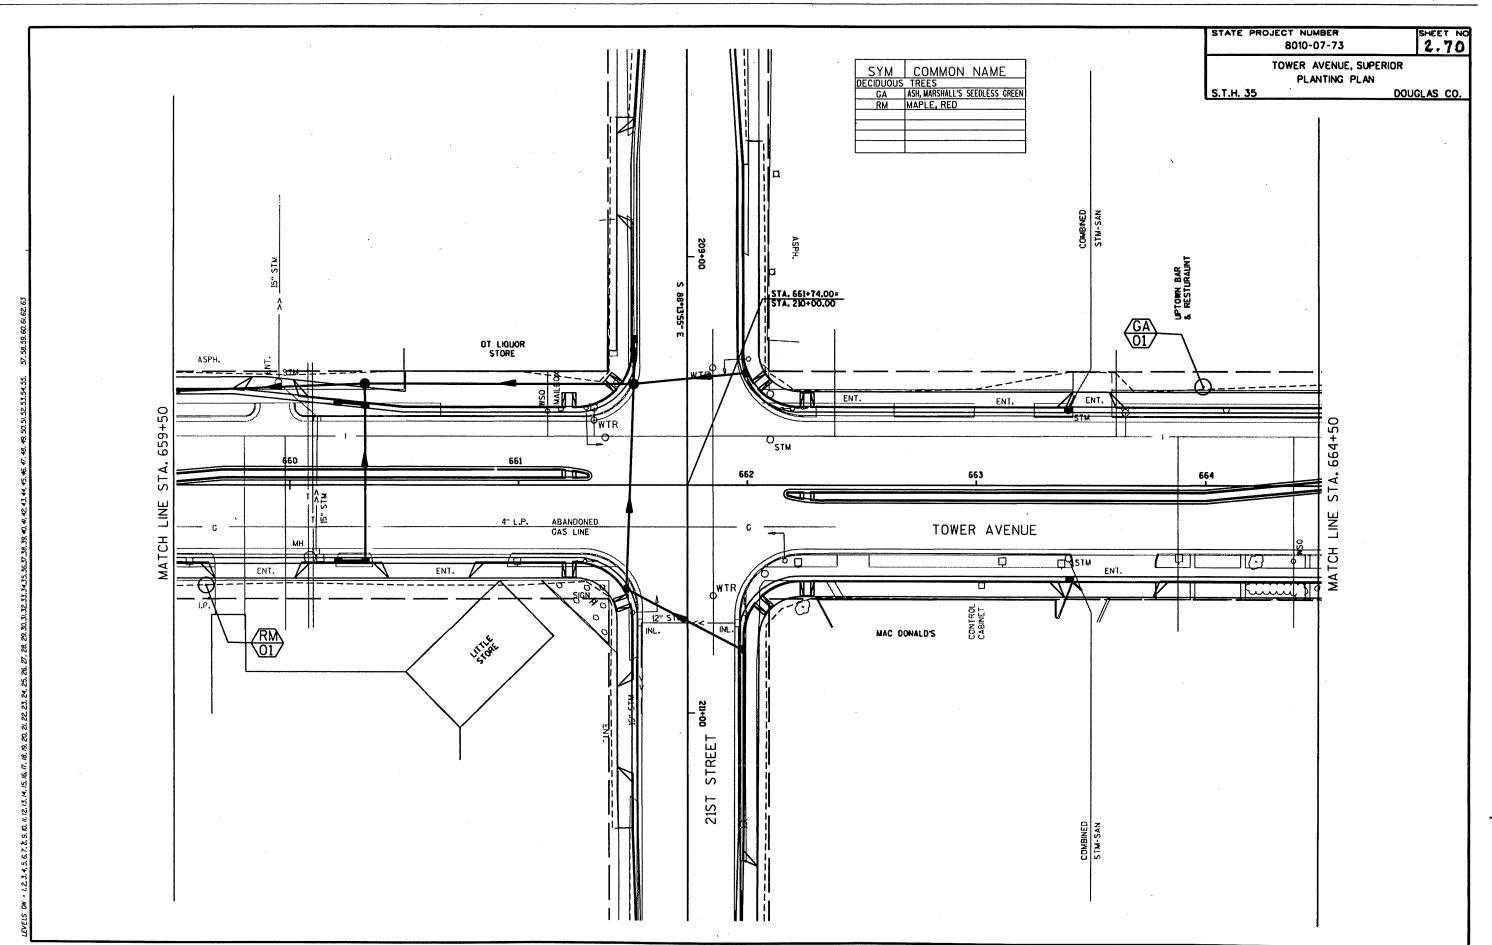


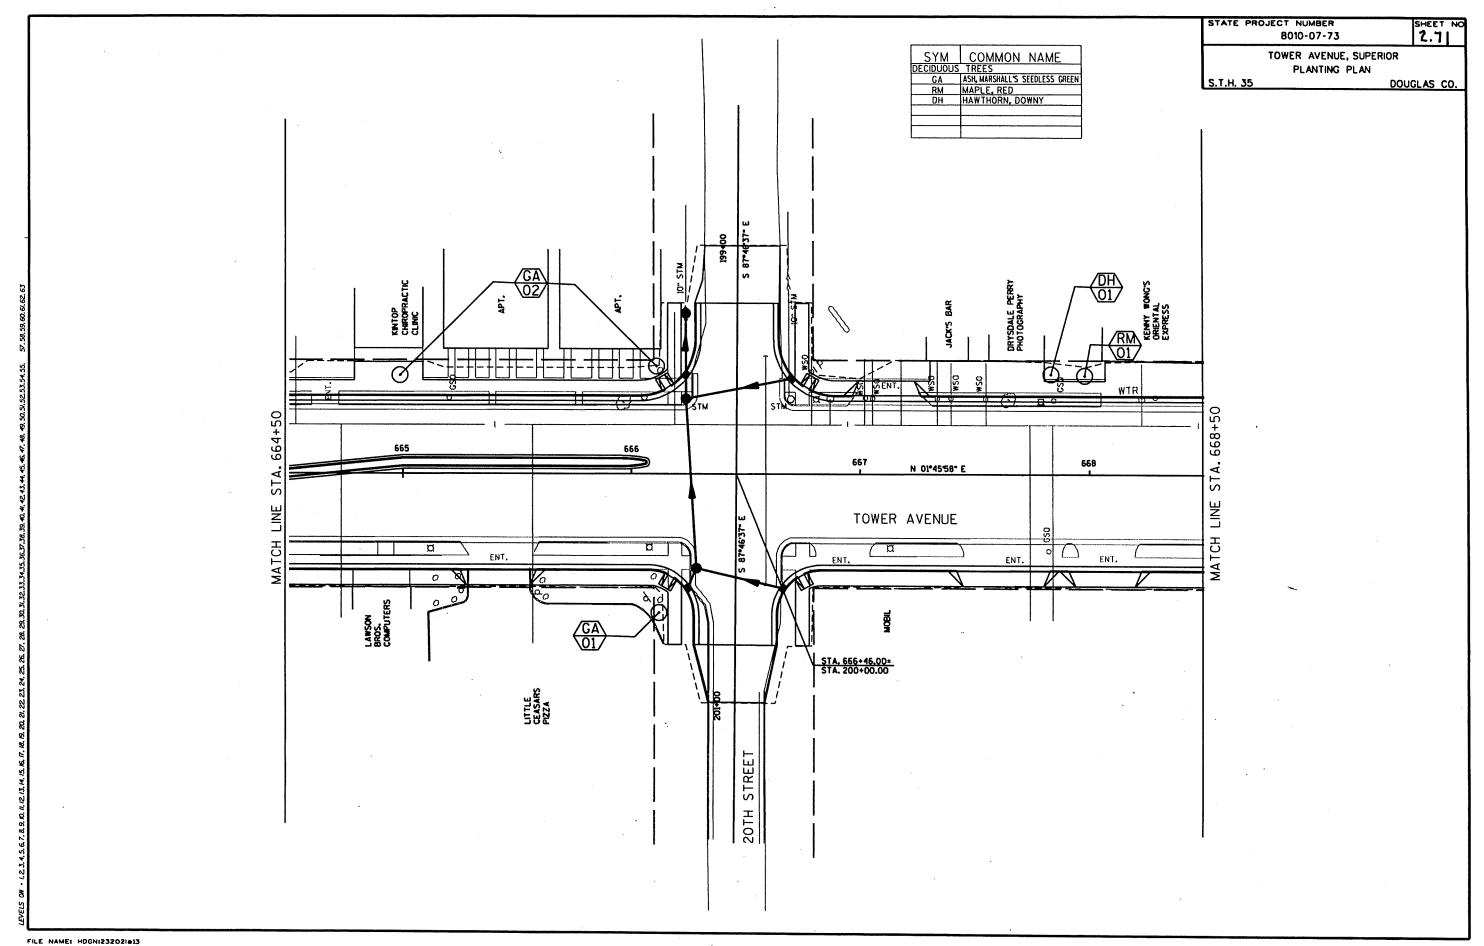


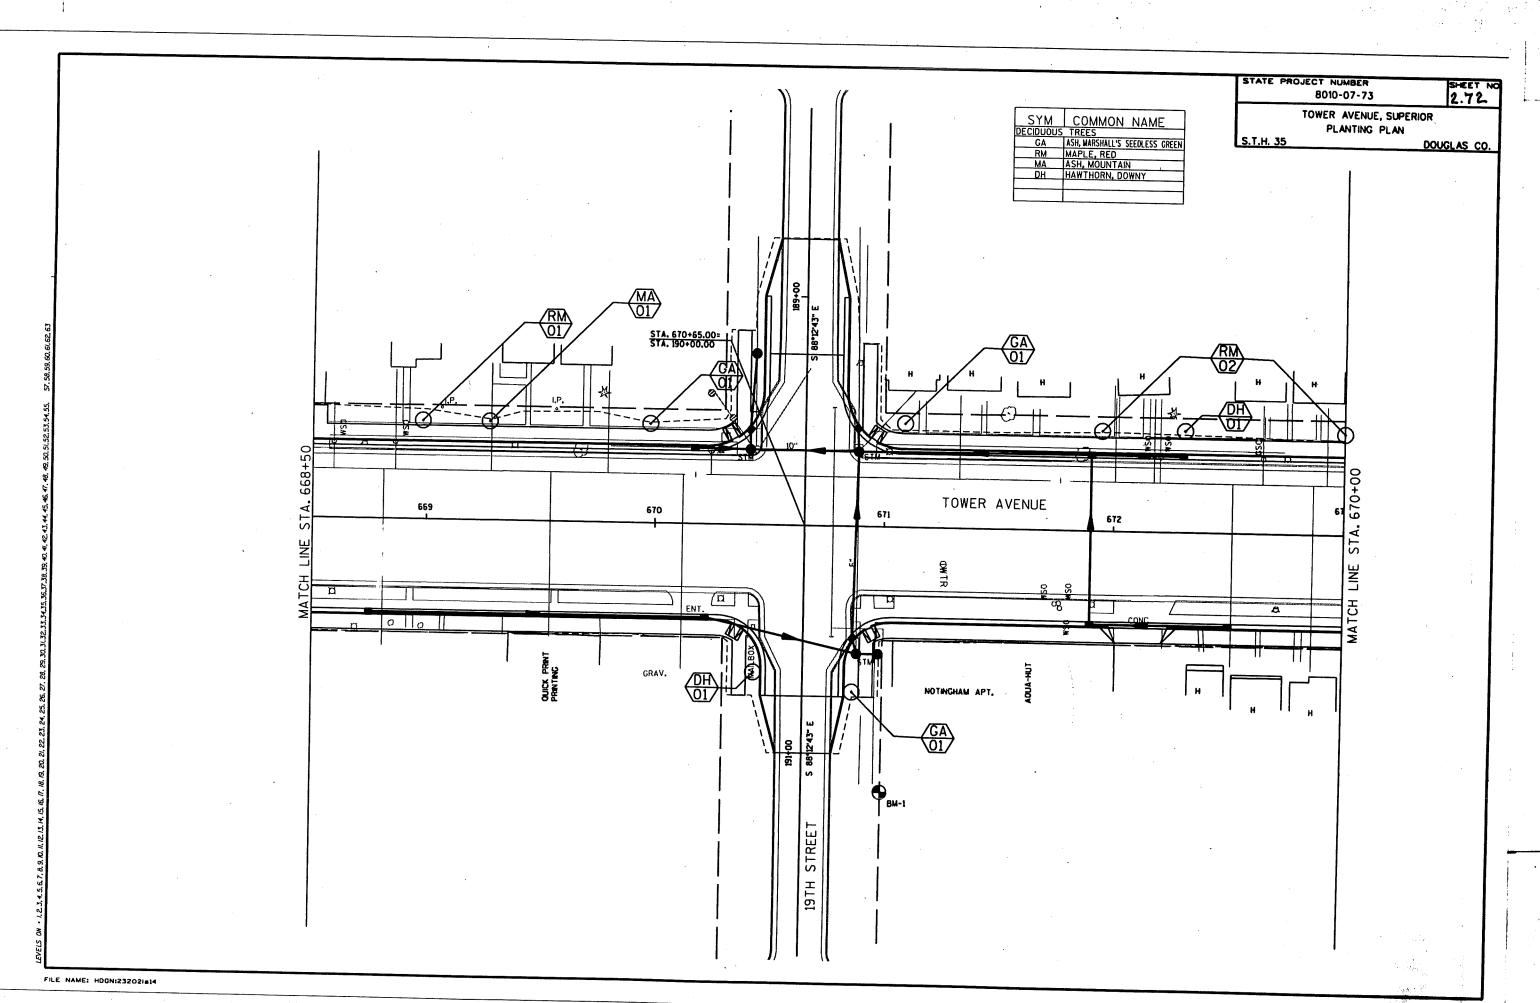

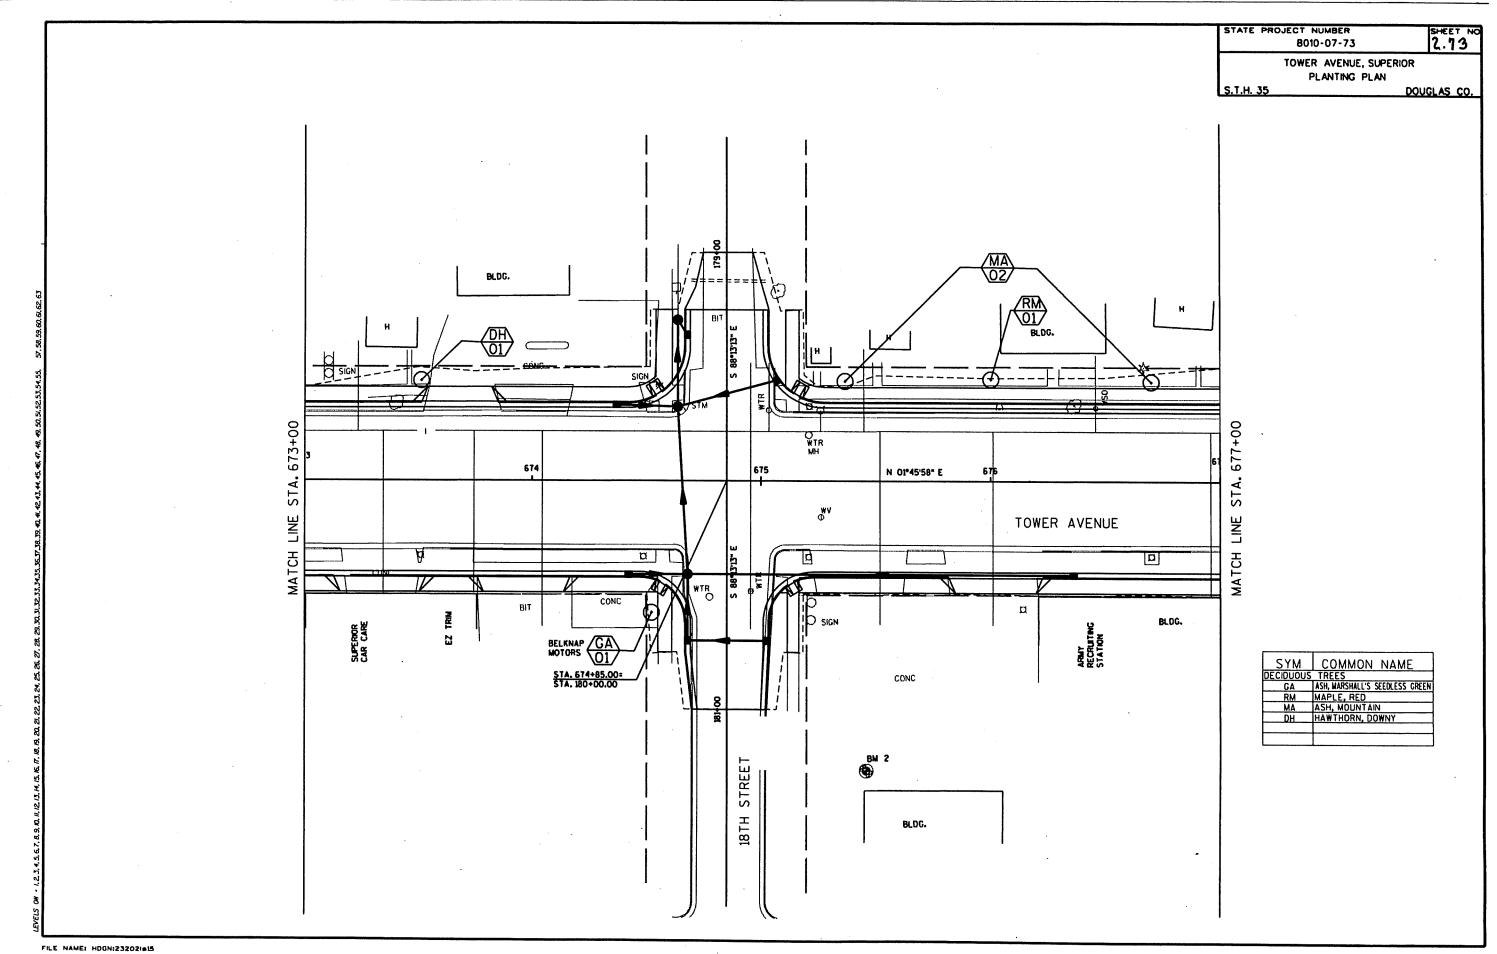


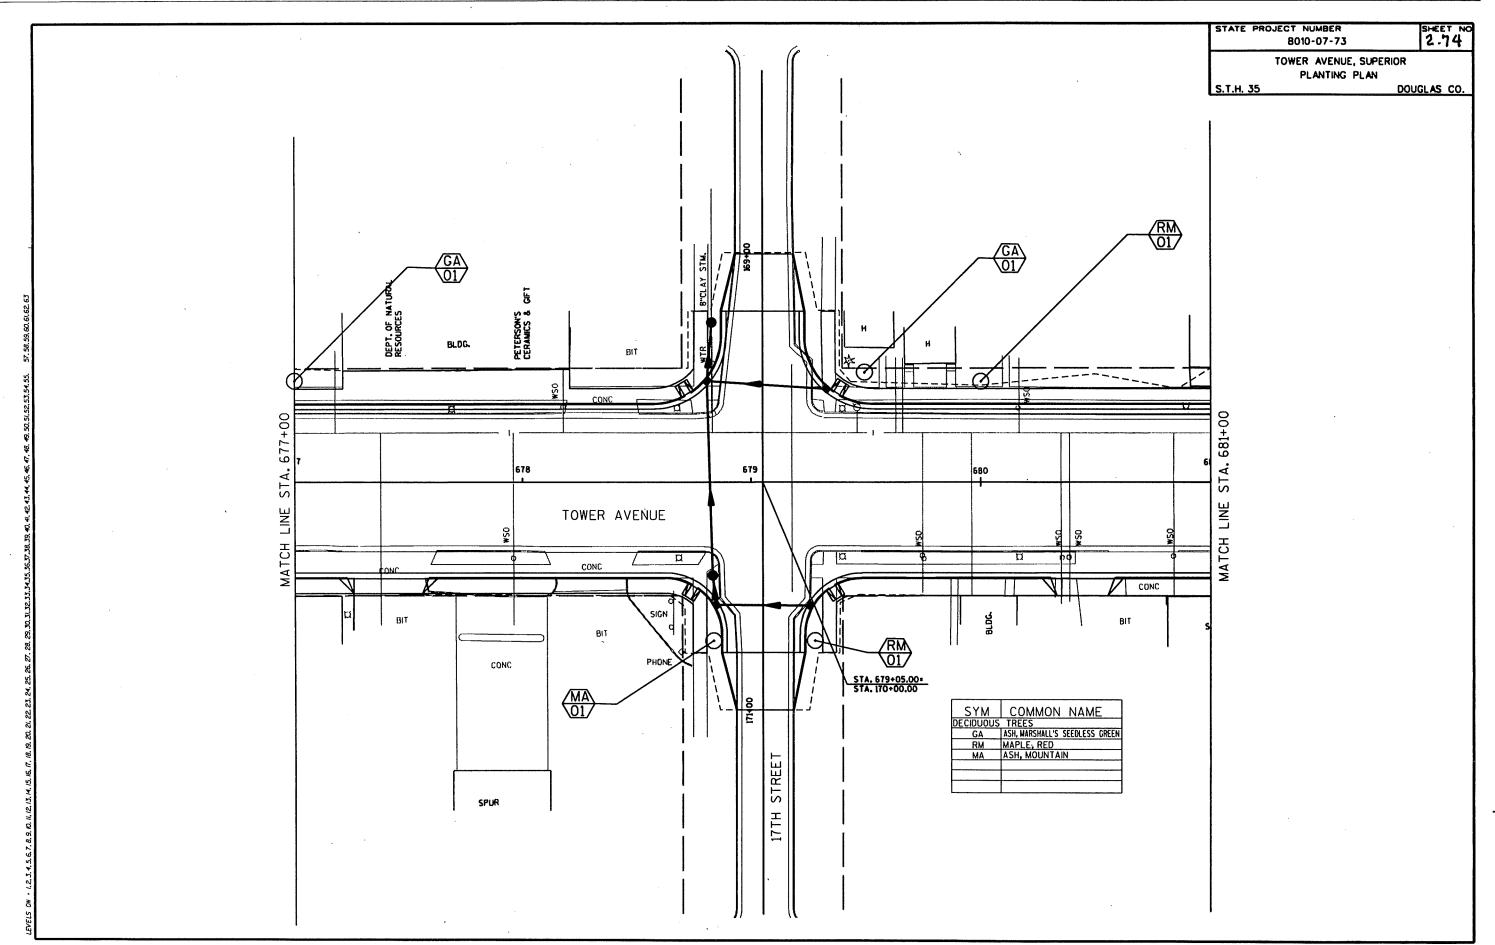

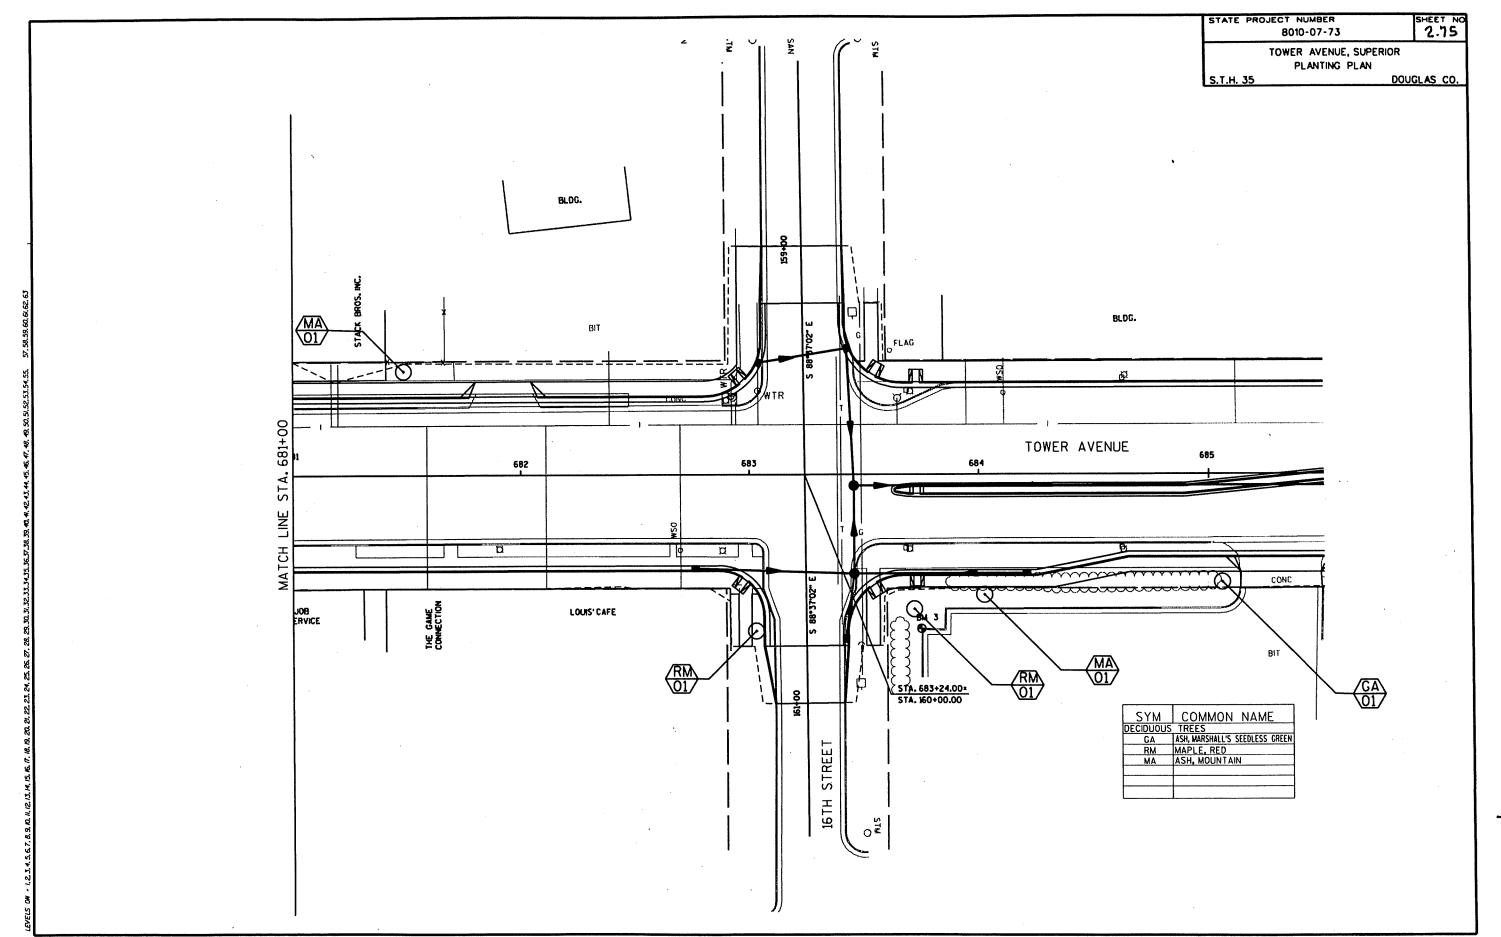

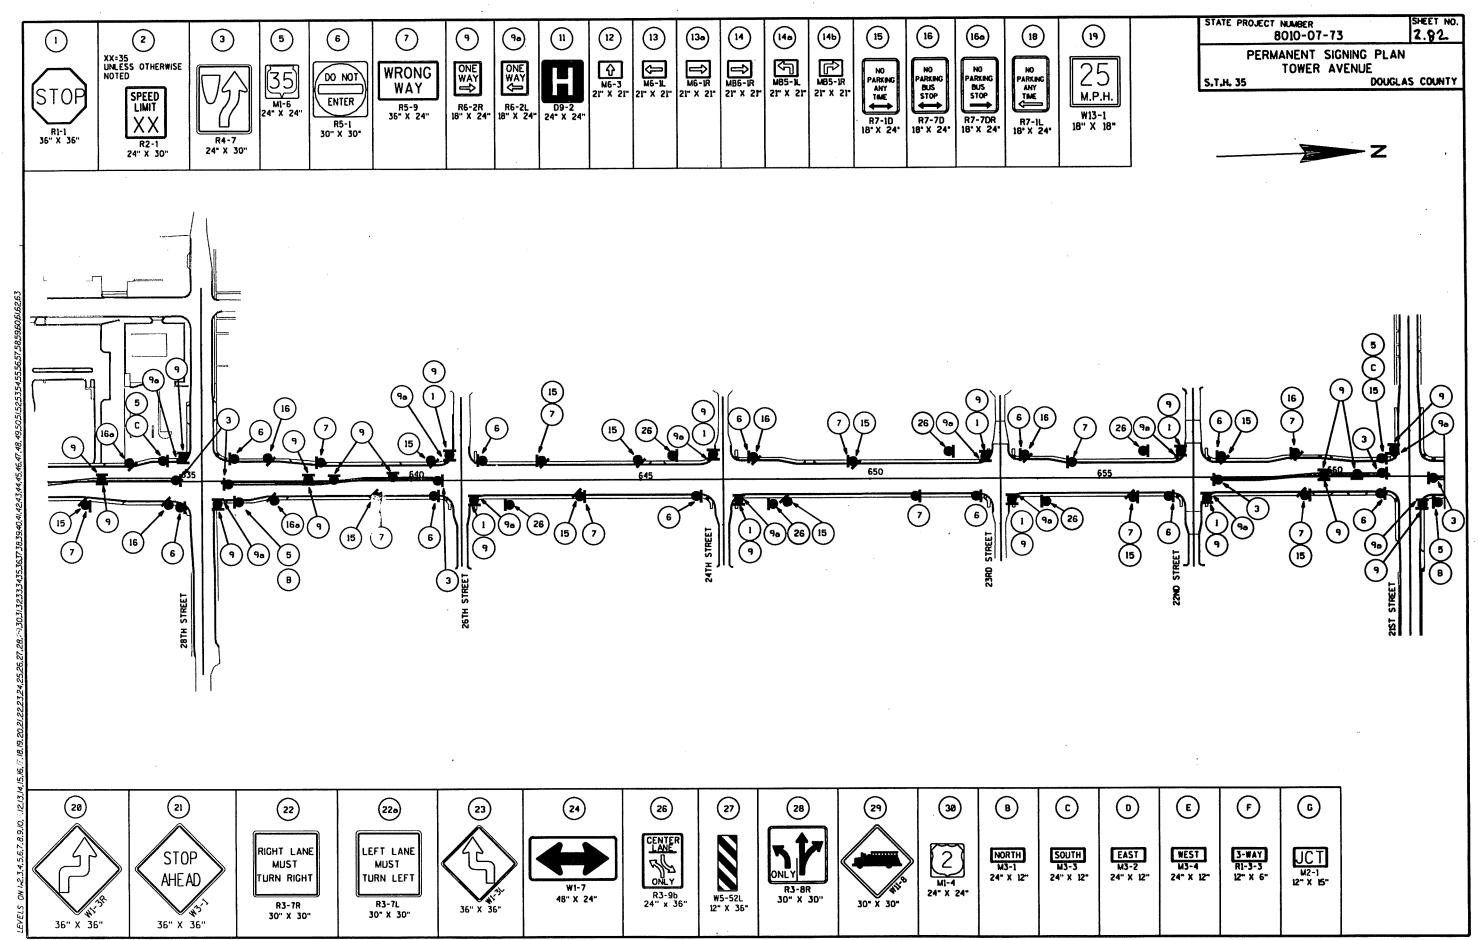

FILE NAME: 23202PS2.DGN

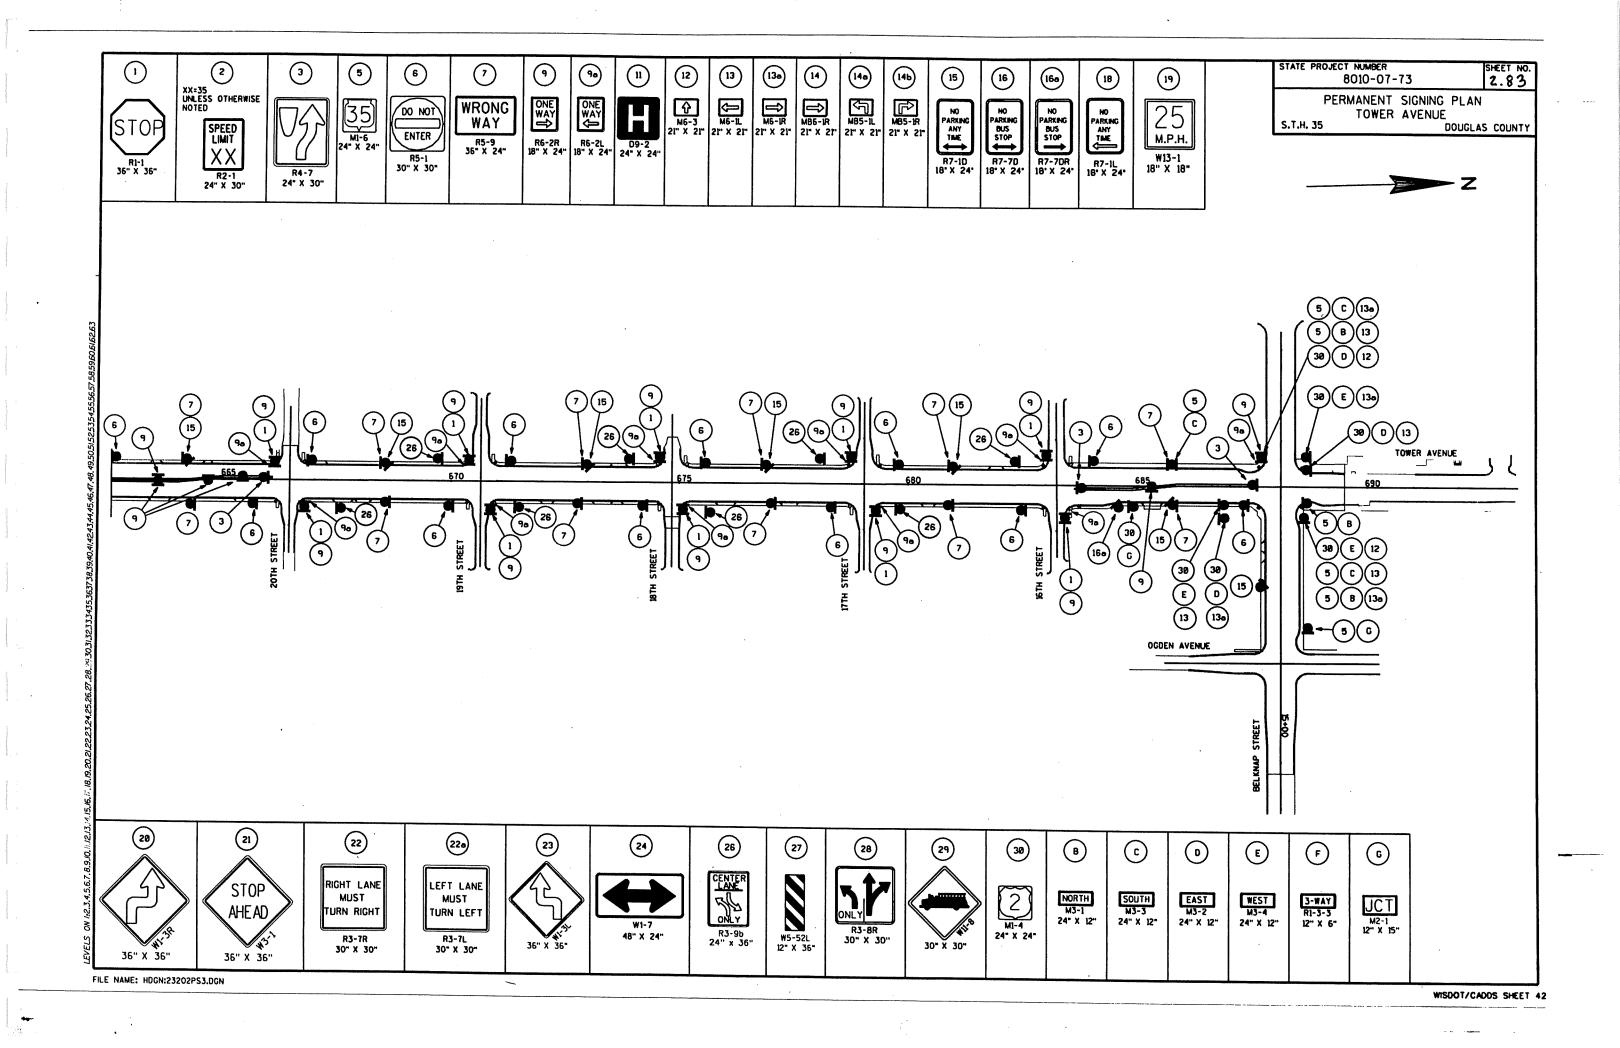

STATE PROJECT NUMBER SHEET NO. 8010-07-73 2.84

ELECTRICAL/LIGHTING DETAILS TOWER AVENUE & FRONTAGE ROADS S.T.H. 35 DOUGLAS COUNTY

12 3/4" BOLT CIRCLE CONDUIT--CONDUIT CONDUIT WITHIN 6" DIA. ANCHOR BOLTS SHALL BE ORIENTED PARALLEL TO THE ROADWAY

FORM DEPTH SHALL BE NO MORE THAN 6" BELOW GRADE ON THE LOWER SIDE OF BASE. FORMING SHALL BE REMOVED AFTER CONCRETE HAS SET CONTRACTOR SHALL VERIFY

**FORMING DETAIL** 

#### GENERAL NOTES

DETAILS OF CONSTRUCTION, MATERIALS AND WORKMANSHIP NOT SHOWN ON THIS DRAWING SHALL CONFORM TO THE PERTINENT REQUIREMENTS OF

BASES SHALL BE EXCAVATED BY THE USE OF A CIRCULAR AUGER.

TOP SURFACES OF CONCRETE BASES SHALL BE TROWEL FINISHED AND

CONDUIT SIZES AND LOCATIONS SHALL BE AS SHOWN ON THE PLANS.

MINIMUM BENDING RADIUS OF CONDUIT = 6 X THE DIAMETER.

CONDUIT HEIGHT ABOVE CONCRETE BASES SHALL BE 1 INCH. ALL METALLIC CONDUIT ENDS SHALL BE REAMED AND THREADED.

ALL METALLIC CONDUITS IN WHICH WIRE OR CABLE IS NOT TO BE INSTALLED SHALL BE CAPPED WITH THREADED PROTECTIVE CAPS, AS APPROVED BY THE ENGINEER.

ALL NONMETALLIC CONDUITS IN WHICH WIRE OR CABLE IS NOT INSTALLED SHALL BE PLUGGED.

ALL CONDUIT ENDS AT THE TOP OF CONCRETE BASES SHALL BE CAPPED IF METALLIC OR PLUGGED IF NONMETALLIC IMMEDIATELY AFTER PLACEMENT AND BEFORE CONCRETE IS POURED, CONDUITS IN WHICH WIRE OR CABLE IS NOT INSTALLED SHALL REMAIN CAPPED OR PLUGGED.

BELL ENDS SHALL BE INSTALLED ON ALL PVC CONDUIT EXPOSED AT THE TOP OF CONCRETE BASES BEFORE INSTALLATION OF CABLE OR WIRE.

ENDS OF CONDUIT INSTALLED BELOW GRADE FOR FUTURE USE SHALL BE CAPPED IF METALLIC OR PLUGGED IF NONMETALLIC.

WHEN REQUIRED TO CONNECT NONMETALLIC CONDUIT TO METALLIC CONDUIT, ONLY ADAPTER FITTINGS, U.L. LISTED FOR ELECTRICAL


IF A BASE REQUIRES A DEEP FORM BECAUSE OF LOOSE DIRT OR FILL. THE FORM SHALL BE REMOVED BEFORE BACKFILLING AROUND THE BASE. BACKFILL SHALL BE TAMPED TIGHT AGAINST THE BARE CONCRETE BASE IN LAYERS OF 1 FOOT OR LESS.

A NO. 6 AWG. STRANDED COPPER GROUNDING WIRE SHALL BE CADWELDED

THE GROUNDING WIRE SHALL BE FURNISHED AND INSTALLED TO ENTER THE BASE THROUGH A 1 INCH CONDUIT INSTALLED FOR GROUNDING PURPOSES, LEAVING A 4 FOOT COIL OF WIRE ABOVE THE CONCRETE BASE. THE GROUNDING WIRE SHALL BE NEATLY COILED AND THE COILS

ANCHOR BOLTS SHALL BE THREADED 8° IN LENGTH ON EACH END OF THE BOLT, AND BE MANUFACTURED IN ACCORDANCE WITH SECTION 840.2.9 OF THE STANDARD SPECIFICATIONS AND ASTM A-449, OR ASTM A-687 (GRADE 105).

WHEN ANCHOR BOLTS USING THE ALTERNATE "L" BEND ARE FURNISHED, THE 4" "L" BEND SHALL BE IN ADDITION TO THE SPECIFIED ANCHOR BOLT BAR LENGTH. THE "L" BEND END SHALL NOT BE THREADED.

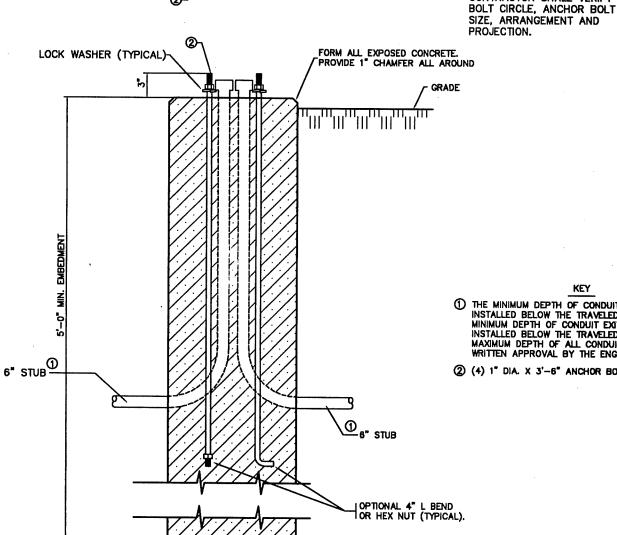


- THE MINIMUM DEPTH OF CONDUIT EXITING THE CONCRETE BASE AND INSTALLED BELOW THE TRAVELED WAY SHALL BE 24 INCHES. THE MINIMUM DEPTH OF CONDUIT EXITING THE CONCRETE BASE THAT IS NOT INSTALLED BELOW THE TRAVELED WAY SHALL BE 18 INCHES. THE MAXIMUM DEPTH OF ALL CONDUIT SHALL BE 36 INCHES EXCEPT WITH WRITTEN APPROVAL BY THE ENGINEER.
- (4) 1" DIA. X 3'-6" ANCHOR BOLTS.

CONCRETE BASE TYPE 1. SPECIAL

STATE PROJECT NUMBER SHEET NO. 8010-07-73 2.85 ELECTRICAL/LIGHTING DETAILS TOWER AVENUE & FRONTAGE ROADS

DOUGLAS COUNTY

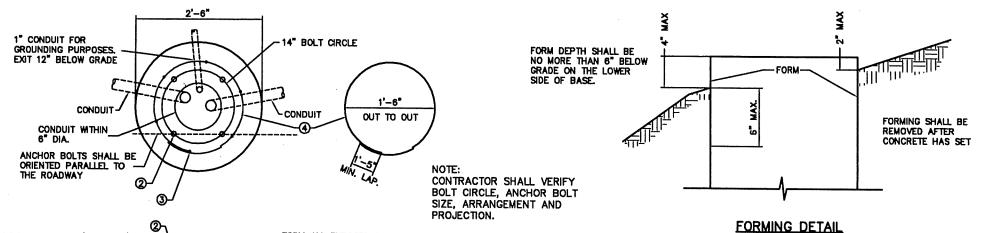

#### **GENERAL NOTES**

S.T.H. 35

DETAILS OF CONSTRUCTION, MATERIALS AND WORKMANSHIP NOT SHOWN ON THIS DRAWING SHALL CONFORM TO THE PERTINENT REQUIREMENTS OF

BASES SHALL BE EXCAVATED BY THE USE OF A CIRCULAR AUGER.

TOP SURFACES OF CONCRETE BASES SHALL BE TROWEL FINISHED AND

CONDUIT SIZES AND LOCATIONS SHALL BE AS SHOWN ON THE PLANS. MINIMUM BENDING RADIUS OF CONDUIT - 6 X THE DIAMETER.

CONDUIT HEIGHT ABOVE CONCRETE BASES SHALL BE 1 INCH. ALL METALLIC CONDUIT ENDS SHALL BE REAMED AND THREADED.

ALL METALLIC CONDUITS IN WHICH WIRE OR CABLE IS NOT TO BE INSTALLED SHALL BE CAPPED WITH THREADED PROTECTIVE CAPS, AS APPROVED BY THE ENGINEER.

ALL NONMETALLIC CONDUITS IN WHICH WIRE OR CABLE IS NOT INSTALLED SHALL BE PLUGGED.

ALL CONDUIT ENDS AT THE TOP OF CONCRETE BASES SHALL BE CAPPED IF METALLIC OR PLUGGED IF NONMETALLIC IMMEDIATELY AFTER PLACEMENT AND BEFORE CONCRETE IS POURED. CONDUITS IN WHICH WIRE OR CABLE IS NOT INSTALLED SHALL REMAIN CAPPED OR PLUGGED.

BELL ENDS SHALL BE INSTALLED ON ALL PVC CONDUIT EXPOSED AT THE TOP OF CONCRETE BASES BEFORE INSTALLATION OF CABLE OR WRE.

ENDS OF CONDUIT INSTALLED BELOW GRADE FOR FUTURE USE SHALL BE CAPPED IF METALLIC OR PLUGGED IF NONMETALLIC.

WHEN REQUIRED TO CONNECT NONMETALLIC CONDUIT TO METALLIC CONDUIT, ONLY ADAPTER FITTINGS, U.L. LISTED FOR ELECTRICAL USE, SHALL BE USED.


IF A BASE REQUIRES A DEEP FORM BECAUSE OF LOOSE DIRT OR FILL, THE FORM SHALL BE REMOVED BEFORE BACKFILLING AROUND THE BASE. BACKFILL SHALL BE TAMPED TIGHT AGAINST THE BARE CONCRETE BASE IN LAYERS OF 1 FOOT OR LESS.

A NO. 6 AWG. STRANDED COPPER GROUNDING WIRE SHALL BE CADWELDED TO THE GROUND ROD.

THE GROUNDING WIRE SHALL BE FURNISHED AND INSTALLED TO ENTER THE BASE THROUGH A 1 INCH CONDUIT INSTALLED FOR GROUNDING PURPOSES, LEAVING A 4 FOOT COIL OF WIRE ABOVE THE CONCRETE BASE. THE GROUNDING WIRE SHALL BE NEATLY COILED AND THE COILS

ANCHOR BOLTS SHALL BE THREADED 8" IN LENGTH ON EACH END OF THE BOLT, AND BE MANUFACTURED IN ACCORDANCE WITH SECTION 640.2.9 OF THE STANDARD SPECIFICATIONS AND ASTM A-449, OR ASTM A-687 (GRADE 105).


WHEN ANCHOR BOLTS USING THE ALTERNATE "L" BEND ARE FURNISHED, THE 4" "L" BEND SHALL BE IN ADDITION TO THE SPECIFIED ANCHOR BOLT BAR LENGTH. THE "L" BEND END SHALL NOT BE THREADED.

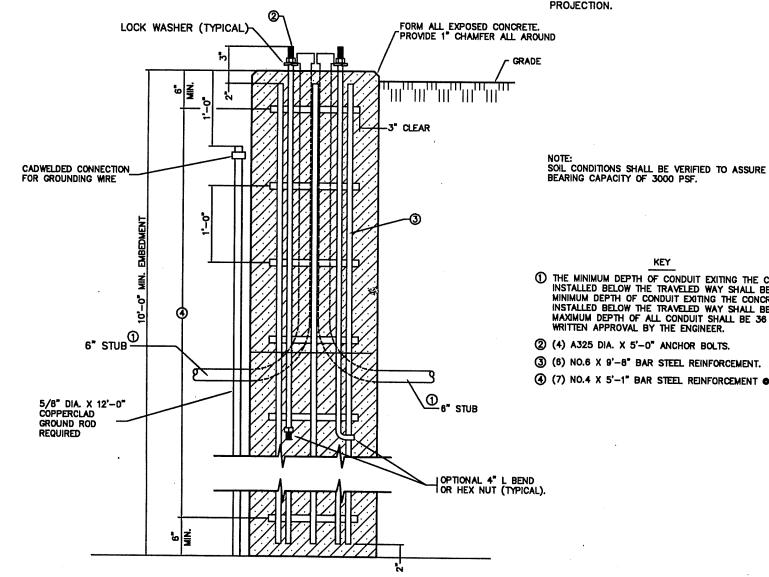

- THE MINIMUM DEPTH OF CONDUIT EXITING THE CONCRETE BASE AND INSTALLED BELOW THE TRAVELED WAY SHALL BE 24 INCHES. THE MINIMUM DEPTH OF CONDUIT EXITING THE CONCRETE BASE THAT IS NOT INSTALLED BELOW THE TRAVELED WAY SHALL BE 18 INCHES. THE MAXIMUM DEPTH OF ALL CONDUIT SHALL BE 36 INCHES EXCEPT WITH WRITTEN APPROVAL BY THE ENGINEER.
- 2 (4) A325 DIA. X 5'-0" ANCHOR BOLTS.
- 3 (6) NO.6 X 9'-8" BAR STEEL REINFORCEMENT.
- (7) NO.4 X 5'-1" BAR STEEL REINFORCEMENT 1'-0" C-C.

CONCRETE BASE TYPE 2. SPECIAL


٦	STATE PROJECT NUMBER	SHEET NO.
	8010-07-73	2.89
	ELECTRICAL/LIGHTING DE	TAILS
	TOWER AVENUE & FRONTAGE	RUADS
	S.T.H. 35 DOUGLAS	COUNTY

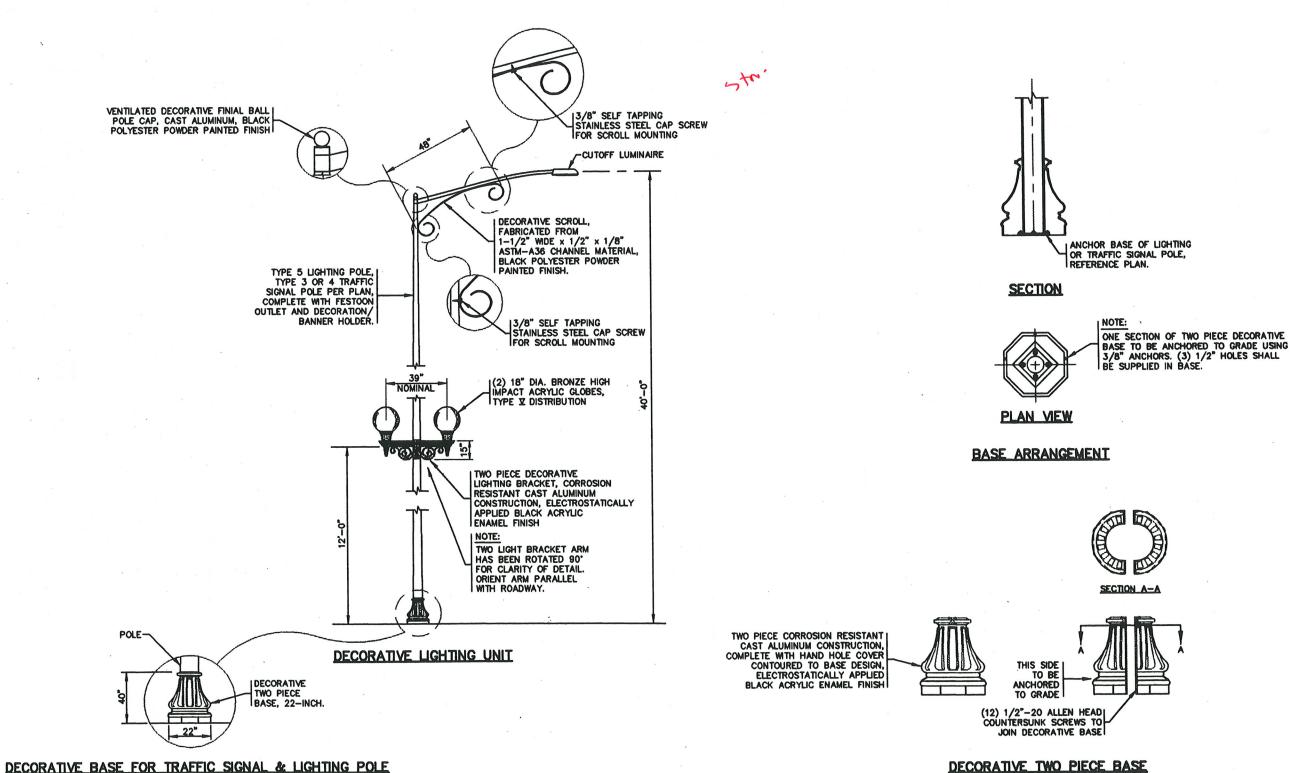

DECORATIVE TWO PIECE BASE

₹ E


### TYPICAL LUMINAIRE/FESTOON RECEPTACLE WIRING DIAGRAM 120/240V, 1#, 3W SERVICE

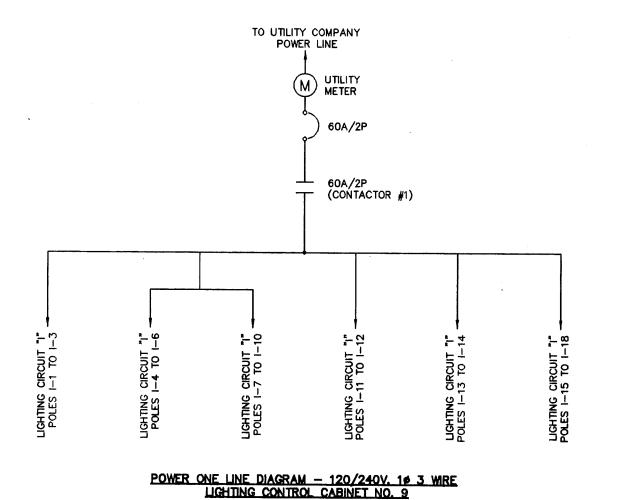


GENERAL NOTES: DETAILS OF CONSTRUCTION MATERIALS AND WORKMANSHIP NOT SHOWN ON THIS DRAWING SHALL CONFORM TO THE PERTINENT REQUIREMENTS OF THE CONTRACT.

SHEET NO. 7 8010-07-73 2.90 ELECTRICAL/LIGHTING DETAILS TOWER AVENUE & FRONTAGE ROADS S.T.H. 35 DOUGLAS COUNTY

STATE PROJECT NUMBER

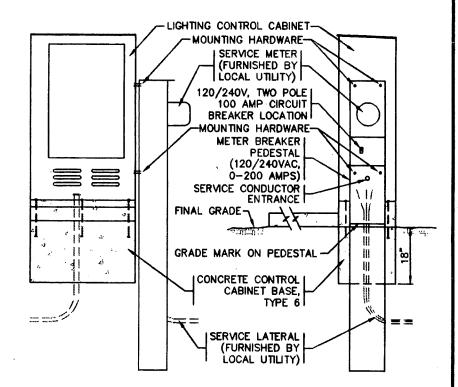


ELECTRICAL SERVICE, LIGHTING, STA,40+75 "34TH ST.", 40.0' LT.

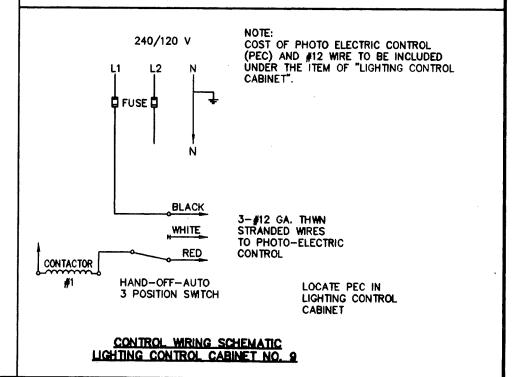


88 ₹5

₹ ₽

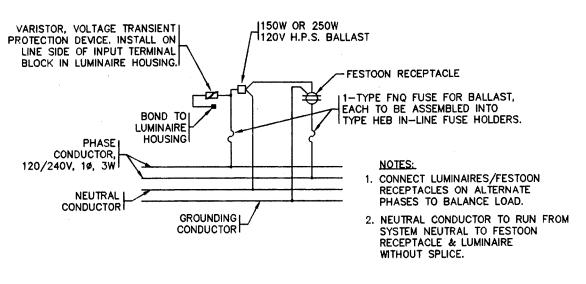

## TYPICAL LUMINAIRE/FESTOON RECEPTACLE WIRING DIAGRAM 120/240V, 16, 3W SERVICE

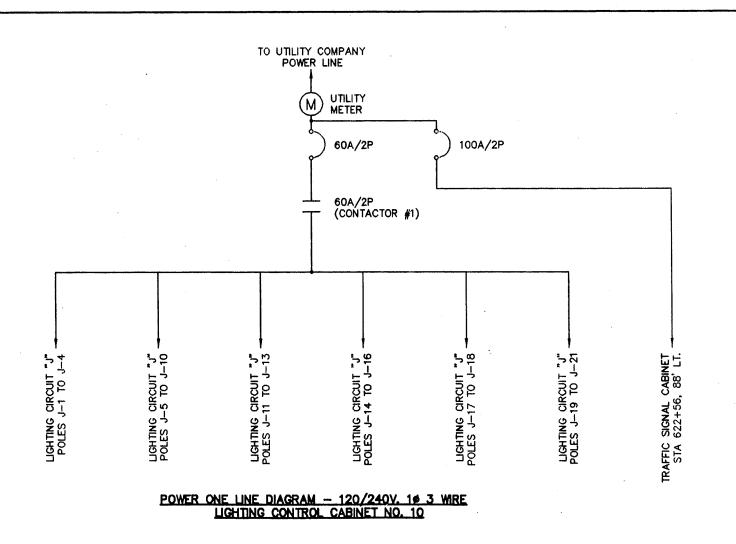

GENERAL NOTES:


DETAILS OF CONSTRUCTION
MATERIALS AND WORKMANSHIP
NOT SHOWN ON THIS DRAWING
SHALL CONFORM TO THE PERTINENT
REQUIREMENTS OF THE CONTRACT.


8010-07-73 2.91

ELECTRICAL/LIGHTING DETAILS
TOWER AVENUE & FRONTAGE ROADS
S.T.H. 35 DOUGLAS COUNTY

SHEET NO.


STATE PROJECT NUMBER

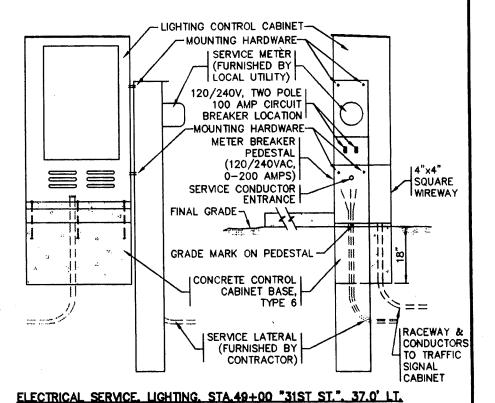

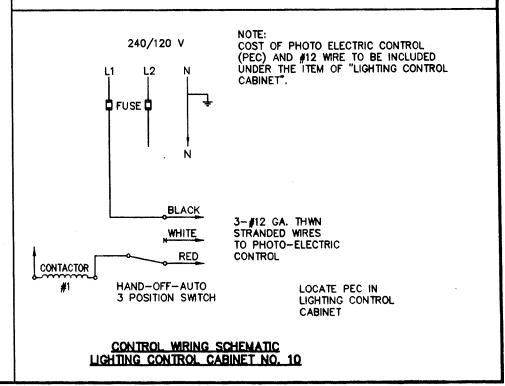



HVP DRAWING #034


HWP JOB #92207

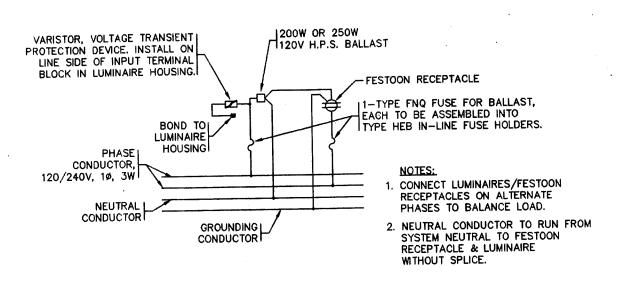


# TYPICAL LUMINAIRE/FESTOON RECEPTACLE WIRING DIAGRAM 120/240V, 10, 3W SERVICE

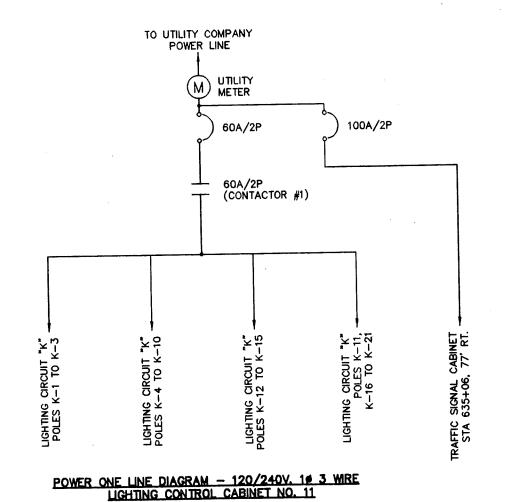

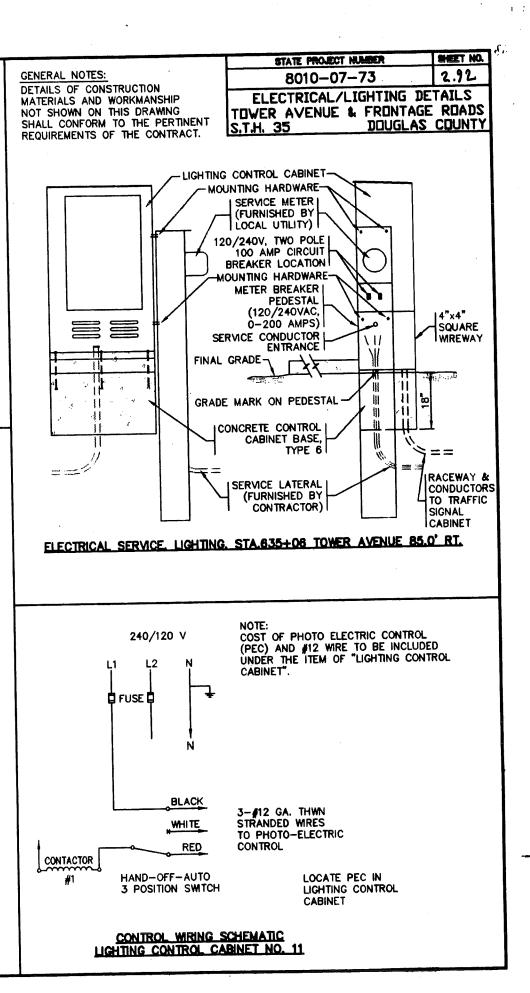

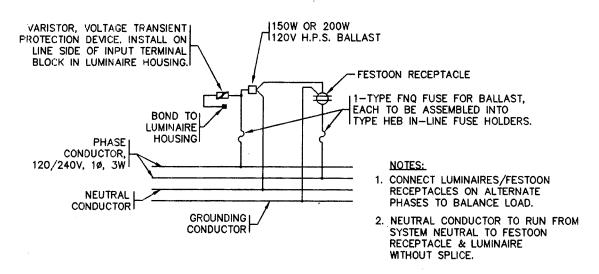

## TYPICAL LUMINAIRE/FESTOON RECEPTACLE WIRING DIAGRAM 120/240V, 16, 3W SERVICE

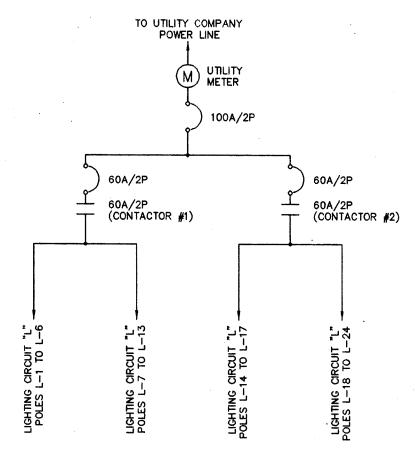


POWER ONE LINE DIAGRAM - 120/240V. 1 € 3 WIRE LIGHTING CONTROL CABINET NO. 12


₽Ð


38


\$ 5

STATE PROJECT NUMBER SHEET NO. **GENERAL NOTES:** 2.93 8010-07-73 DETAILS OF CONSTRUCTION MATERIALS AND WORKMANSHIP ELECTRICAL/LIGHTING DETAILS NOT SHOWN ON THIS DRAWING SHALL CONFORM TO THE PERTINENT TOWER AVENUE & FRONTAGE ROADS DOUGLAS COUNTY S.T.H. 35 REQUIREMENTS OF THE CONTRACT. - LIGHTING CONTROL CABINET--MOUNTING HARDWARE-SERVICE METER! (FURNISHED BY LOCAL UTILITY) 120/240V, TWO POLE |

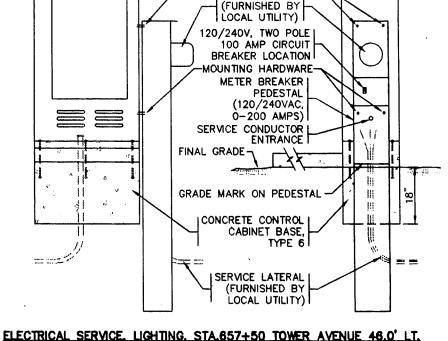

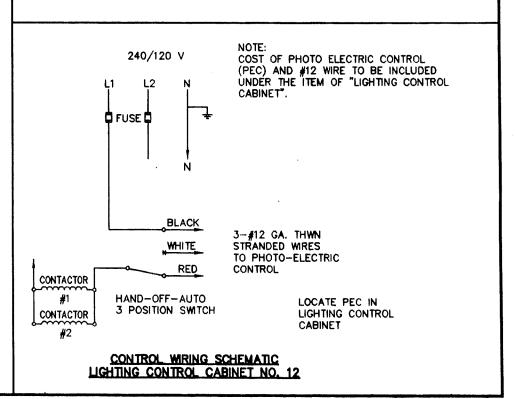

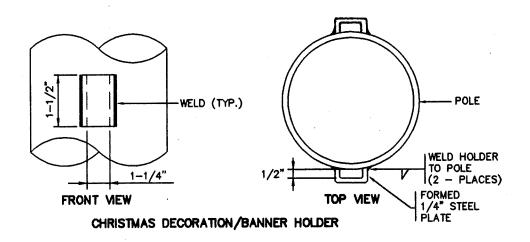

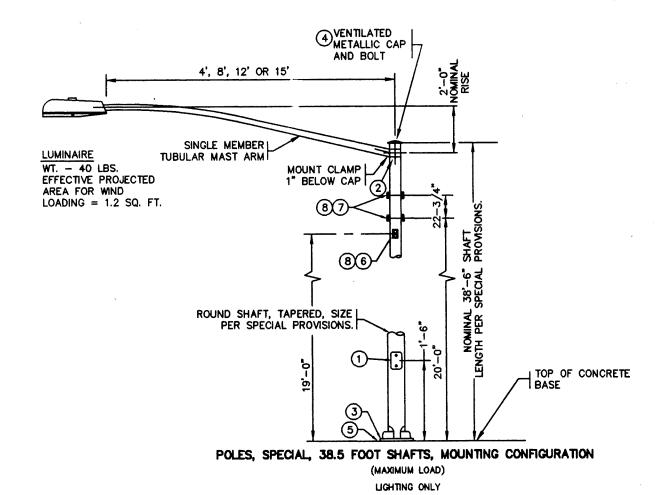


STATE PROJECT NUMBER

8010-07-73

2.98

ELECTRICAL/LIGHTING DETAILS
TOWER AVENUE & FRONTAGE ROADS
S.T.H. 35

DOUGLAS COUNTY

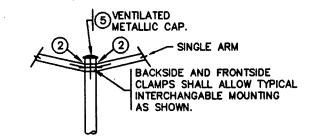

#### INTERCHANGEABLE MOUNTING DETAIL


#### **GENERAL NOTES**


ALL LUMINAIRE POLE MOUNTINGS SHALL BE DESIGNED FOR ARMS AND LUMINAIRES AS SHOWN ON THE PLANS.

THE SLIPFITTER END OF THE MAST ARM SHALL BE A NOMINAL 2-3/8 INCHES IN OUTSIDE DIAMETER. THE STRAIGHT PORTION OF THE SLIPFITTER END OF THE LUMINAIRE ARM SHALL BE A NOMINAL 12 INCHES IN LENGTH.


- 4" X 6" REINFORCED HAND HOLE & COVER ASSEMBLY WITH 2 (TWO) 1/4" X 3/4" 20 TPI HEX HEAD STAINLESS STEEL BOLTS.
- 2 GROMMETS, 1" CHASE NIPPLES OR 1" CLOSE CONDUIT NIPPLES WITH BUSHINGS SHALL BE PROVIDED FOR 1-3/8" HOLE IN POLE SHAFT FOR WIRING.
- (3) POLE BASE.
- FURNISH AND INSTALL VENTILATED CAST METALLIC (ALUMINUM ALLOY) CAPS. FASTEN CAPS WITH 1 (ONE) 1/4"x3/4"-20 TPI STAINLESS STEEL HEX HEAD BOLT.
- 5 SHIMMING, IF NEEDED, SHALL BE LOCATED BETWEEN THE CONCRETE FOUNDATION AND THE POLE BASE.
- 6 FESTOON OUTLET WITH DUPLEX RECEPTACLE & WEATHERPROOF GASKETED COVER, LOCATE 90° CLOCKWISE FROM MAST ARM.
- CHRISTMAS DECORATION/BANNER HOLDER SEE DETAIL THIS SHEET, LOCATE O' FROM MAST ARM.
- (8) VERIFY ALL DIMENSIONS FOR LOCATING & FABRICATING FESTOON OUTLETS & CHRISTMAS DECORATION/BANNER HOLDERS WITH OWNER DURING SHOP DRAWING APPROVAL.
- 9 SEE STANDARD DETAIL DRAWING S.D.D. 9 E 1-10 FOR HARDWARE DETAILS FOR POLE MOUNTINGS.

STATE PROJECT NUMBER	SHEET NO.
8010-07-73	2.89
ELECTRICAL/LIGHTING DE	TAILS
TOWER AVENUE & FRONTAGE	RUADS
S.T.H. 35 DOUGLAS	COUNTY

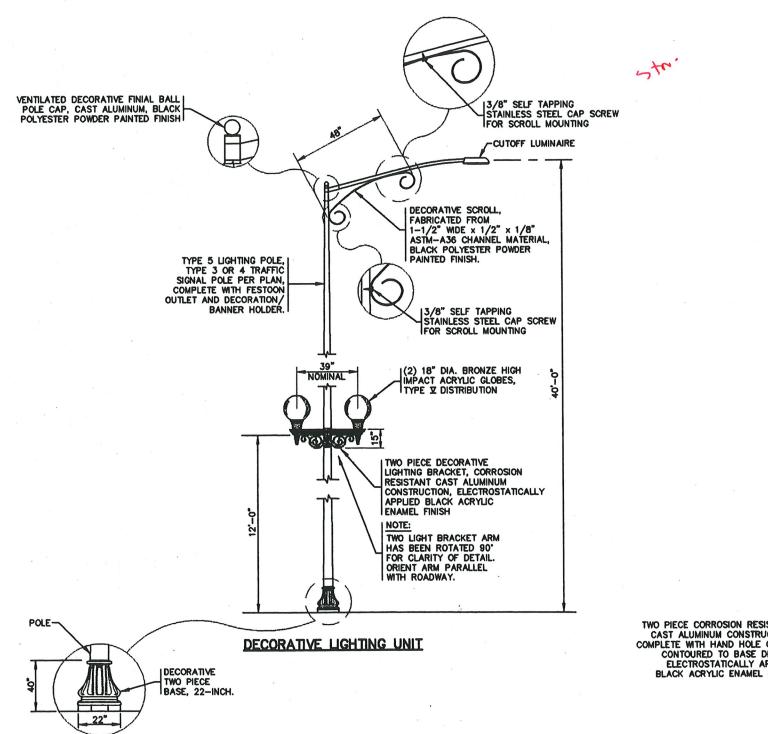

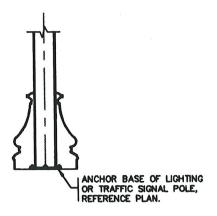

## SECTION

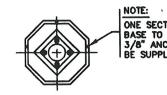


ONE SECTION OF TWO PIECE DECORATIVE
BASE TO BE ANCHORED TO GRADE USING
3/8" ANCHORS. (3) 1/2" HOLES SHALL
BE SUPPLIED IN BASE.


## PLAN VIEW


## BASE ARRANGEMENT



SECTION A-A

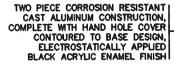

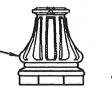

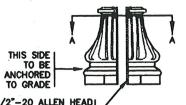

(12) 1/2"-20 ALLEN HEAD COUNTERSUNK SCREWS TO JOIN DECORATIVE BASE


DECORATIVE TWO PIECE BASE

至至

DECORATIVE BASE FOR TRAFFIC SIGNAL & LIGHTING POLE

To the me

## TYPICAL LUMINAIRE/FESTOON RECEPTACLE WIRING DIAGRAM 120/240V, 16, 3W SERVICE

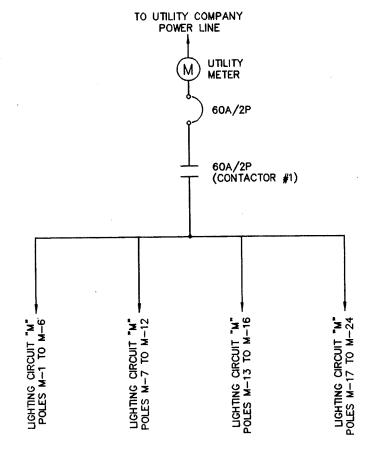

POWER ONE LINE DIAGRAM - 120/240V. 1¢ 3 WIRE LIGHTING CONTROL CABINET NO. 13

GENERAL NOTES:


DETAILS OF CONSTRUCTION
MATERIALS AND WORKMANSHIP
NOT SHOWN ON THIS DRAWING
SHALL CONFORM TO THE PERTINENT
REQUIREMENTS OF THE CONTRACT.

8010-07-73 2.94


ELECTRICAL/LIGHTING DETAILS
TOWER AVENUE & FRONTAGE ROADS
S.T.H. 35 DOUGLAS COUNTY

SHEET NO.

STATE PROJECT NUMBER

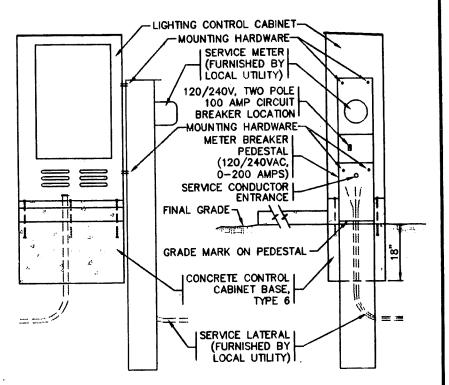


FLECTRICAL SERVICE, LIGHTING, STA.675+07.2 TOWER AVENUE 60.0' LT.

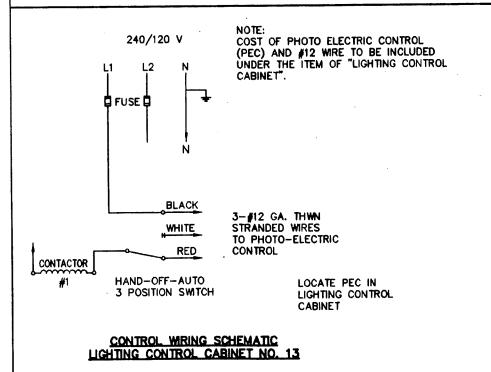

7 HVP DRAWING #037
SEH DRAWING # SCA

HVP JOB #92207 SEH JOB #


E. NOVEMBER 1, 1995

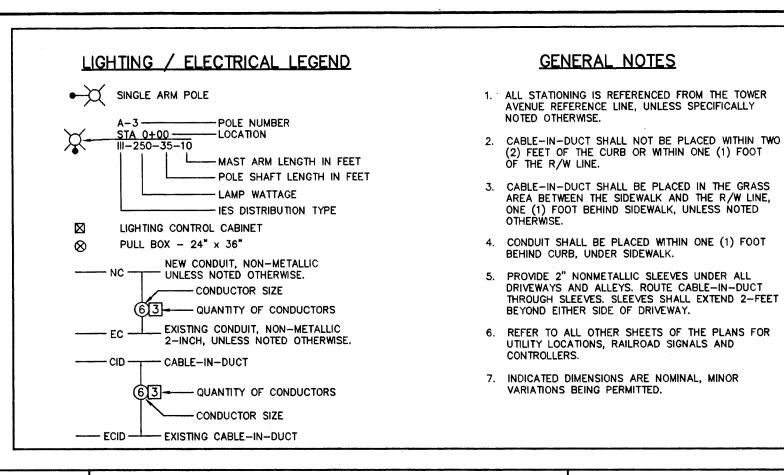



STATE PROJECT NUMBER SHEET NO.


8010-07-73 2.95


ELECTRICAL/LIGHTING DETAILS
TOWER AVENUE & FRONTAGE ROADS
S.T.H. 35 DOUGLAS COUNTY

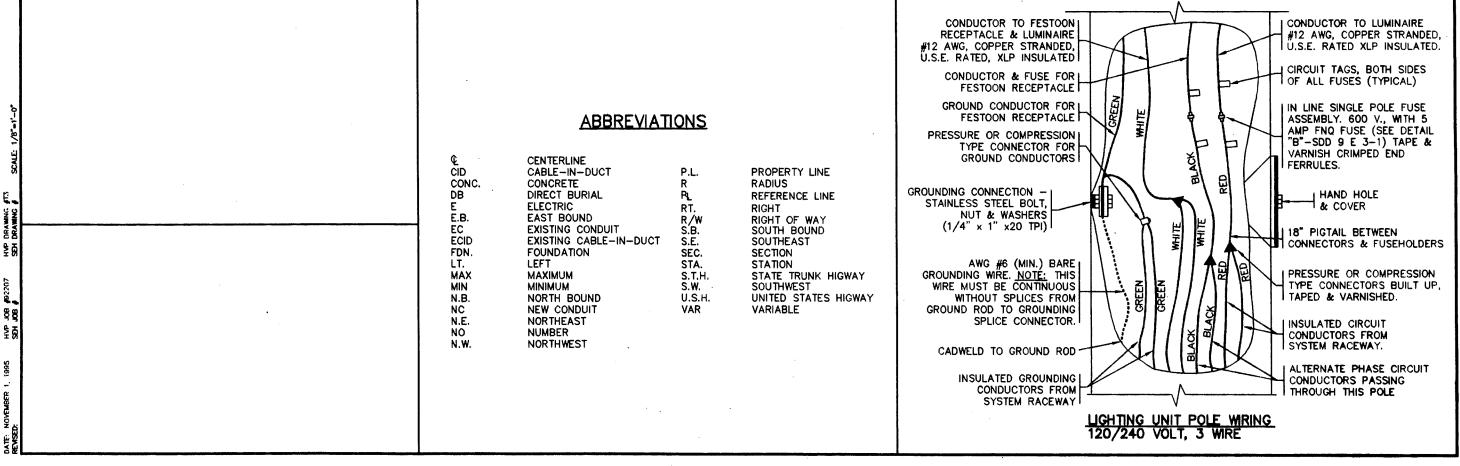


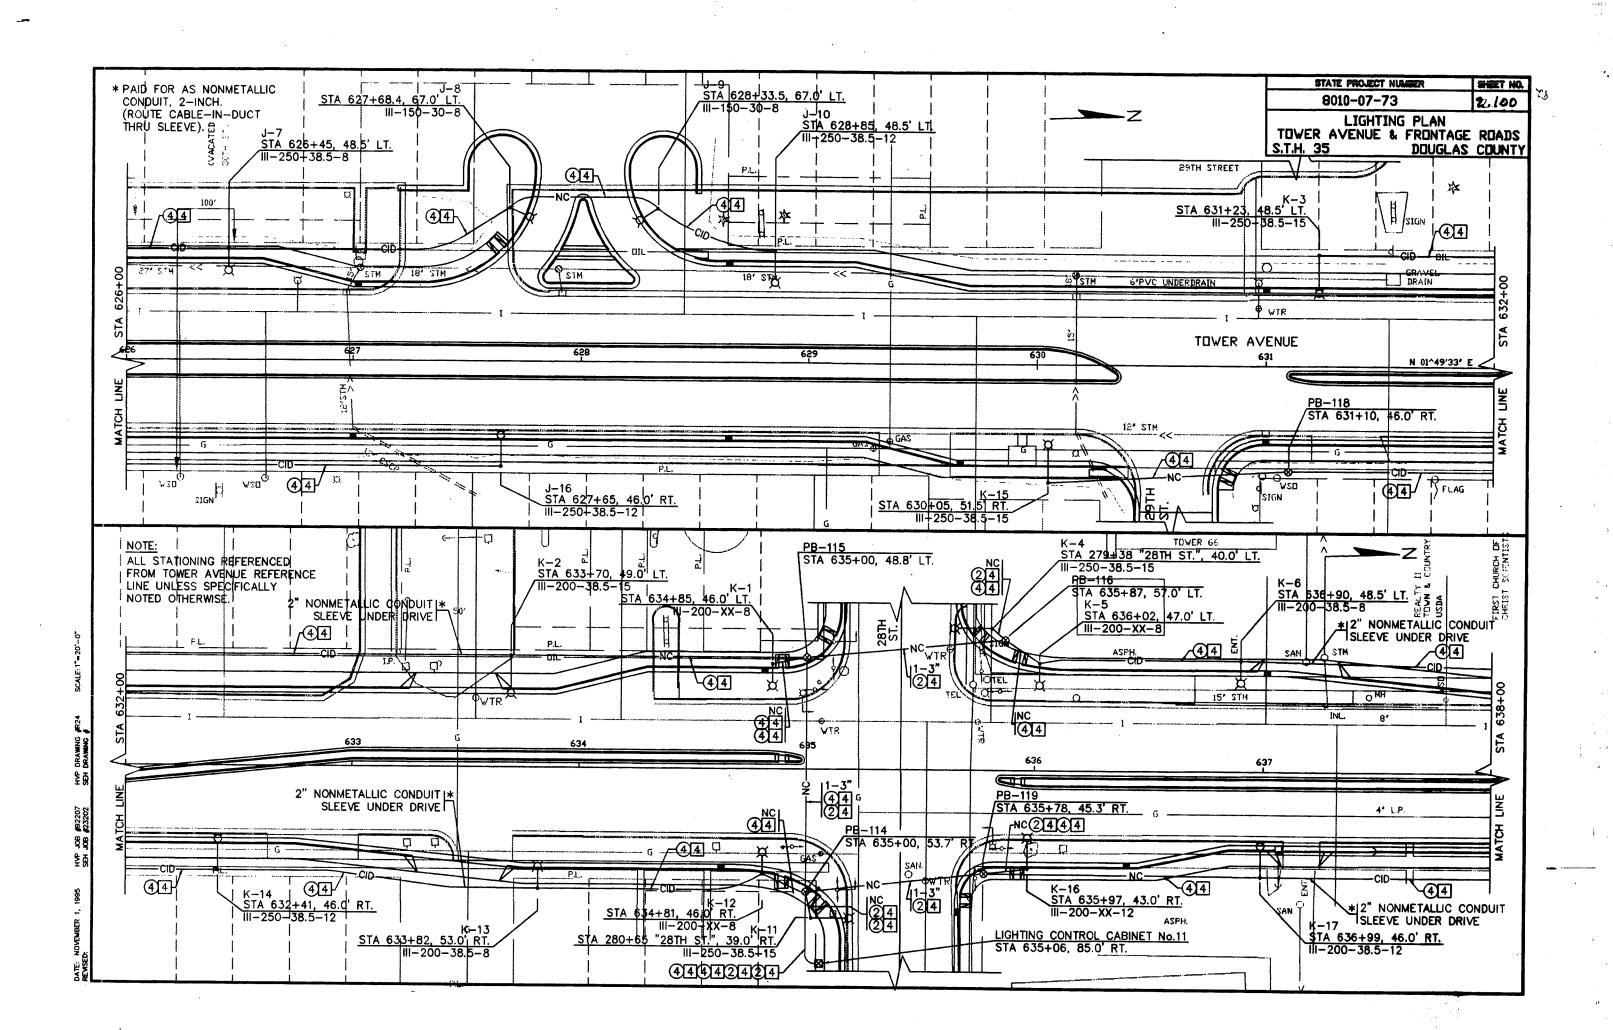


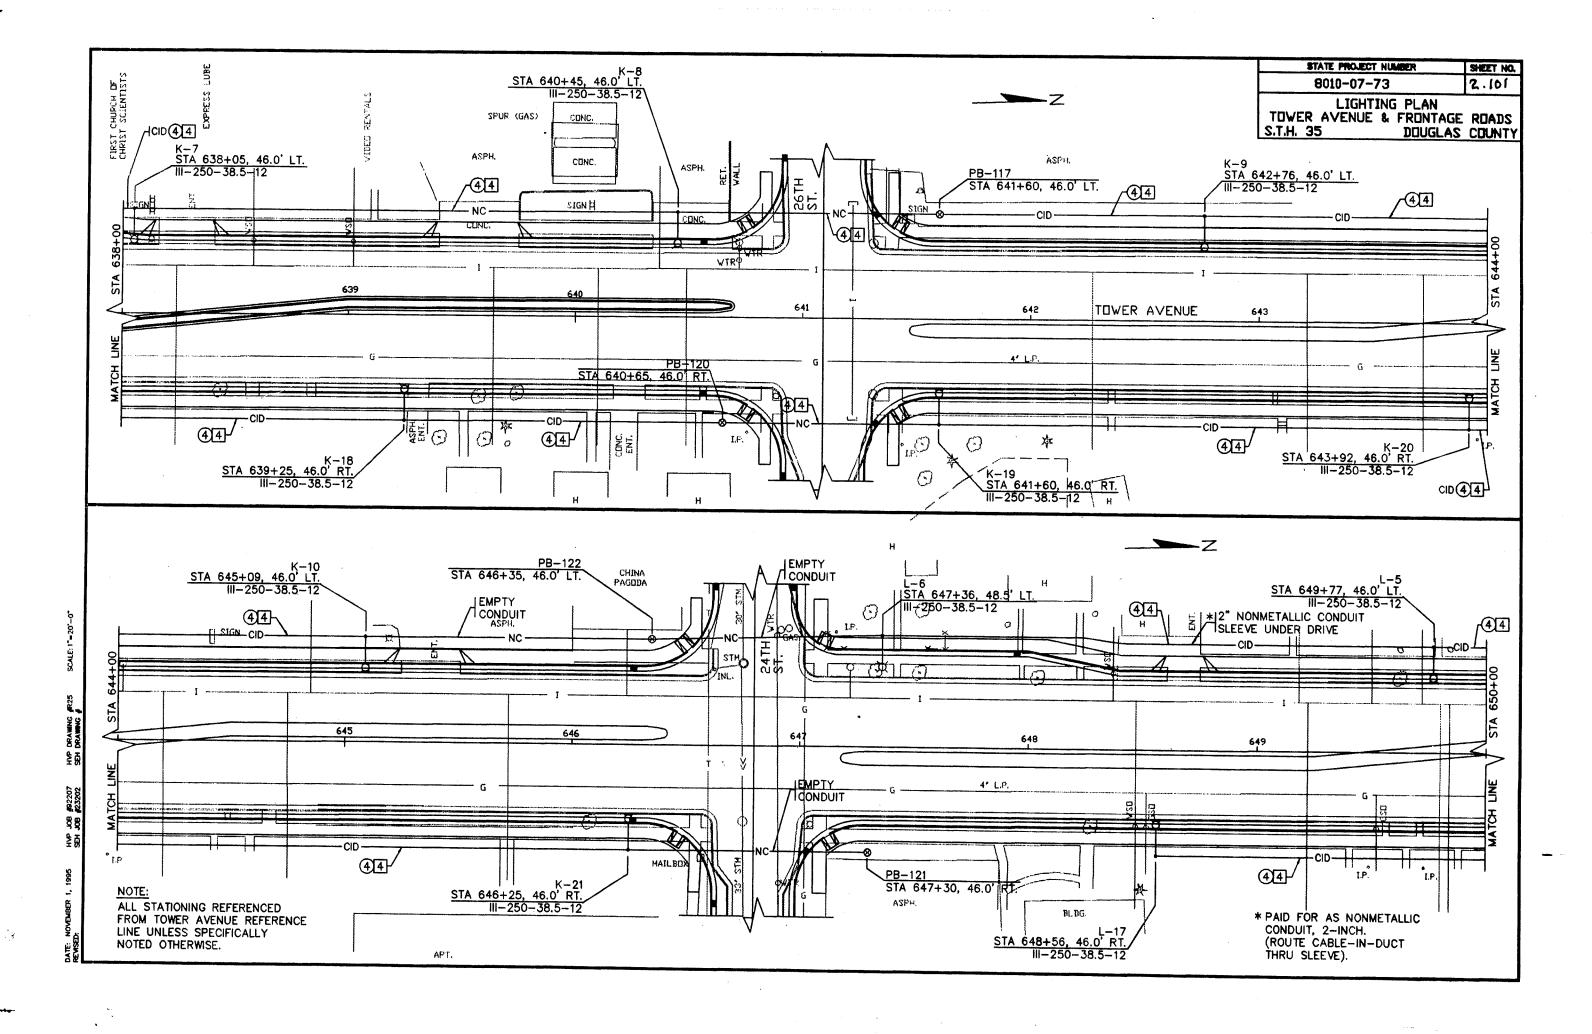

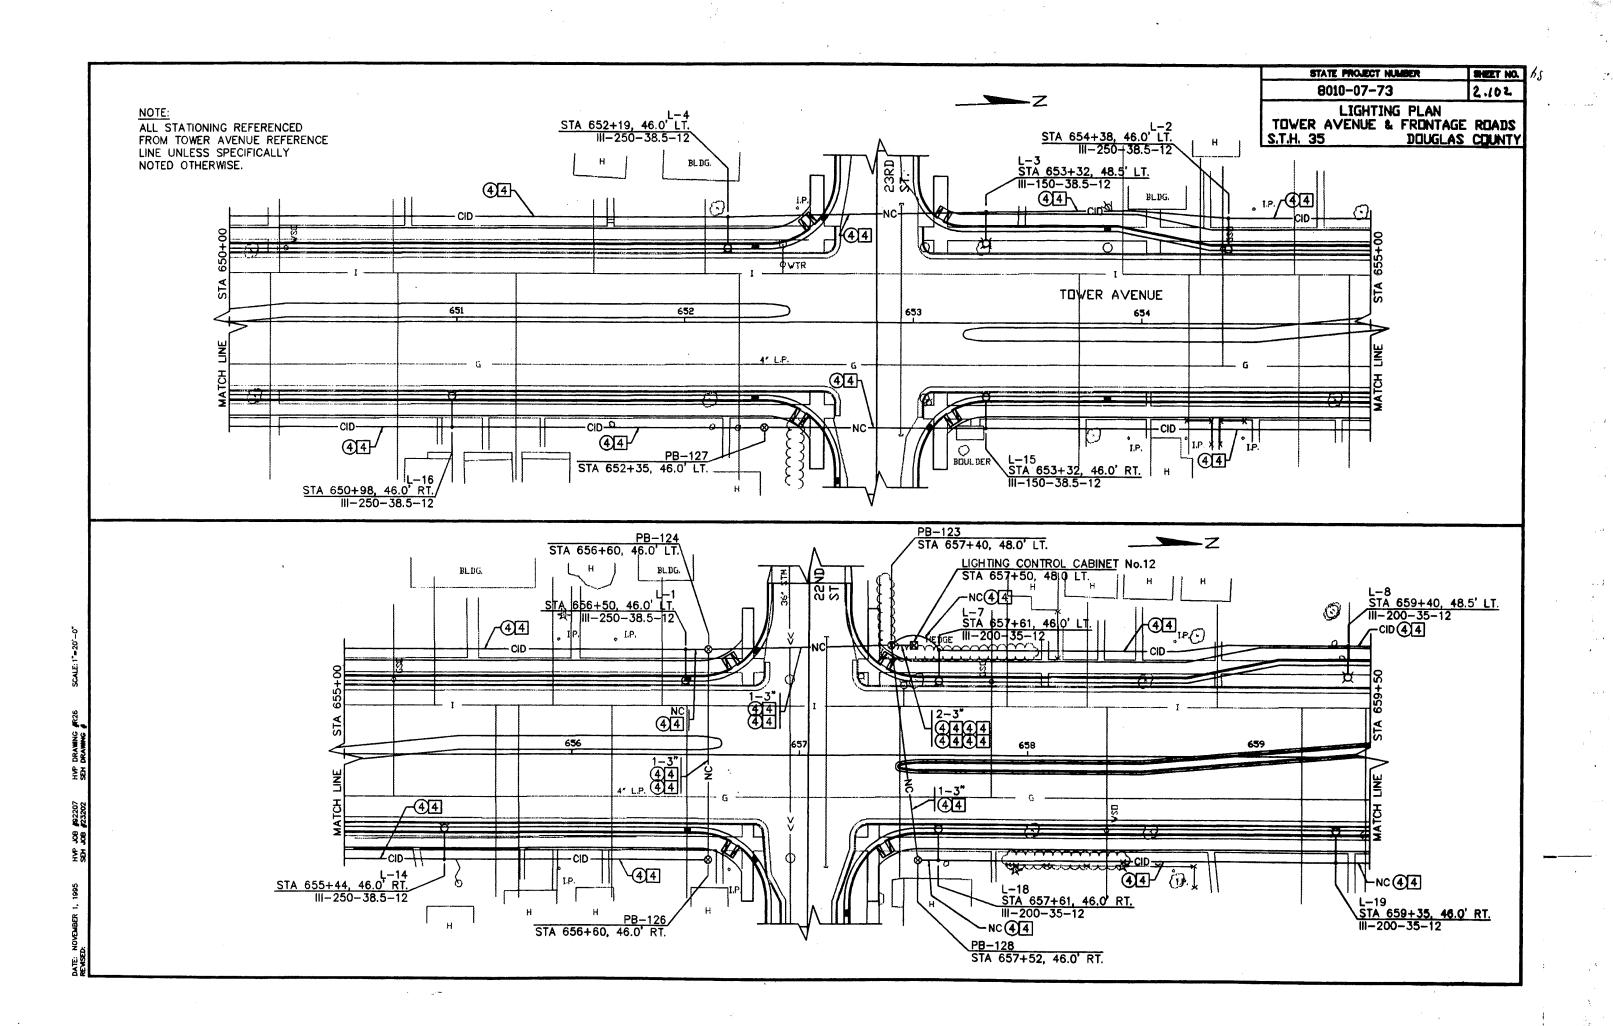


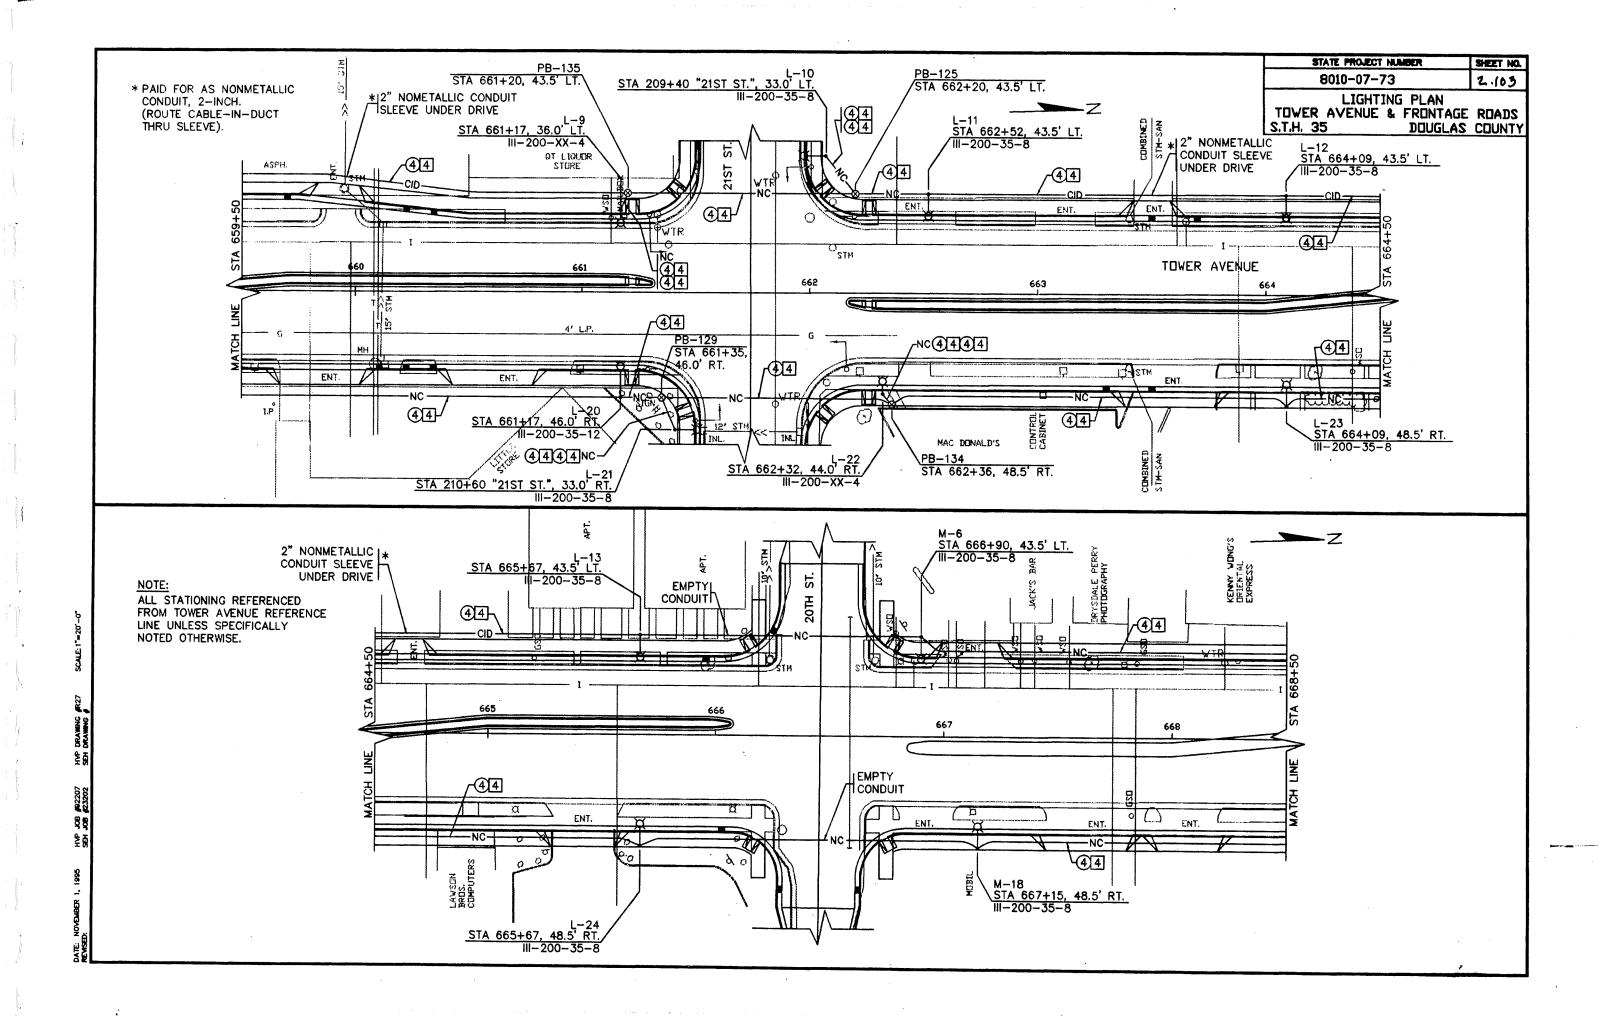

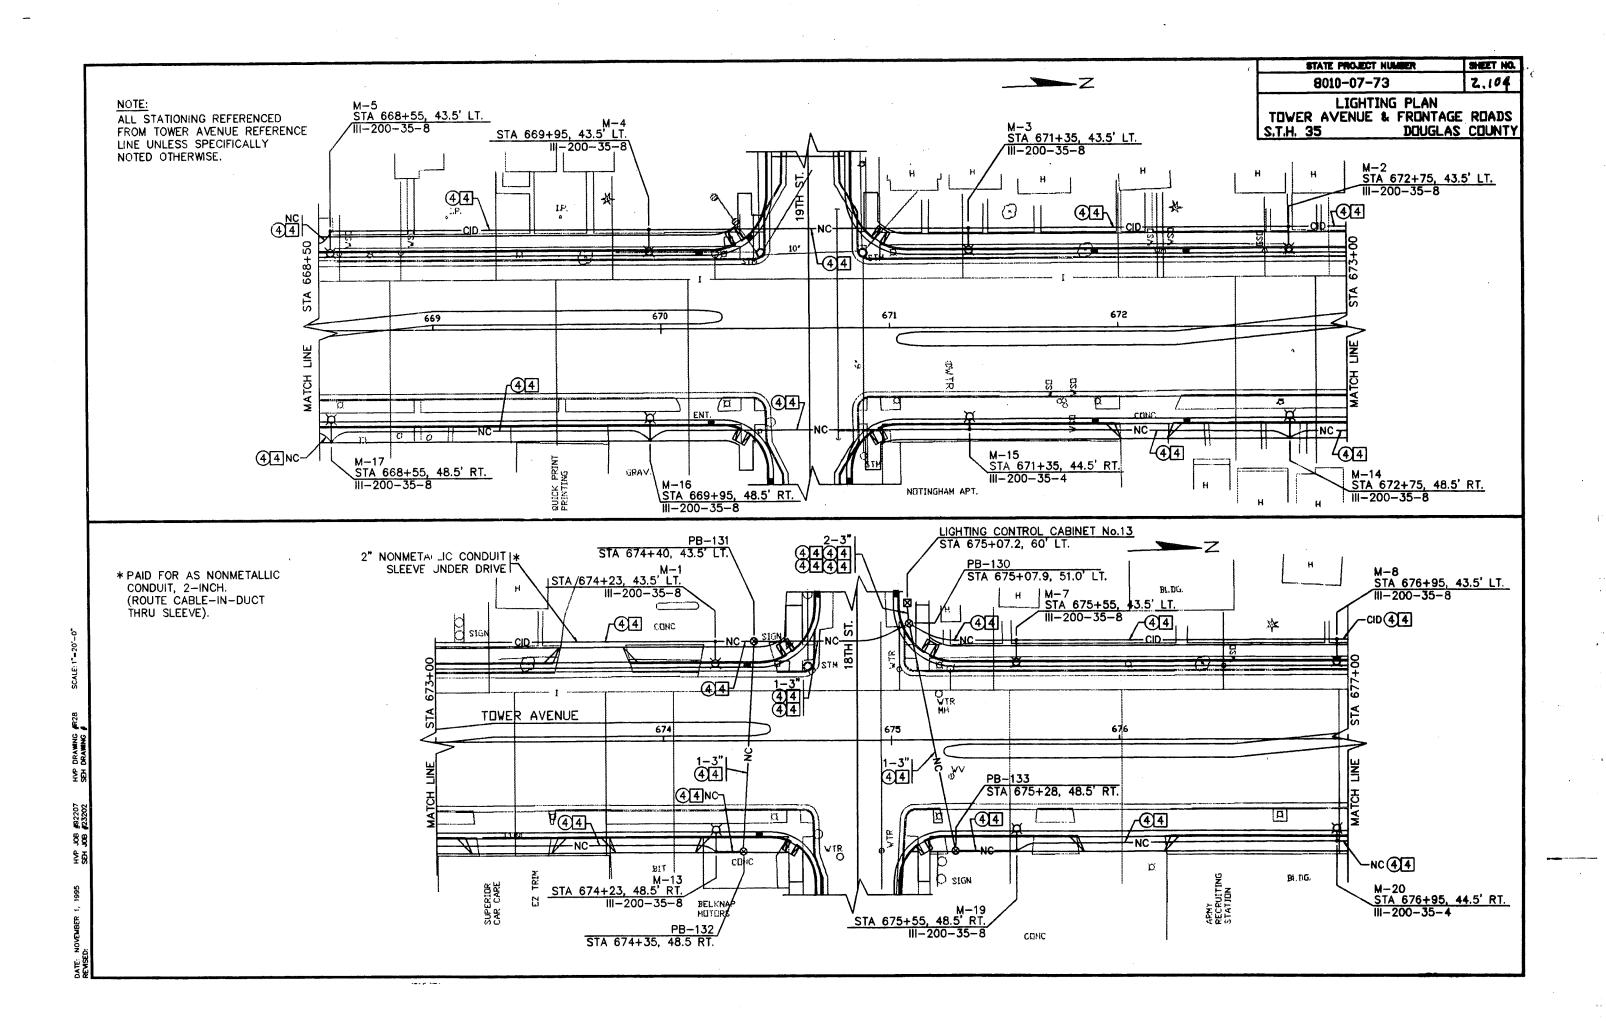

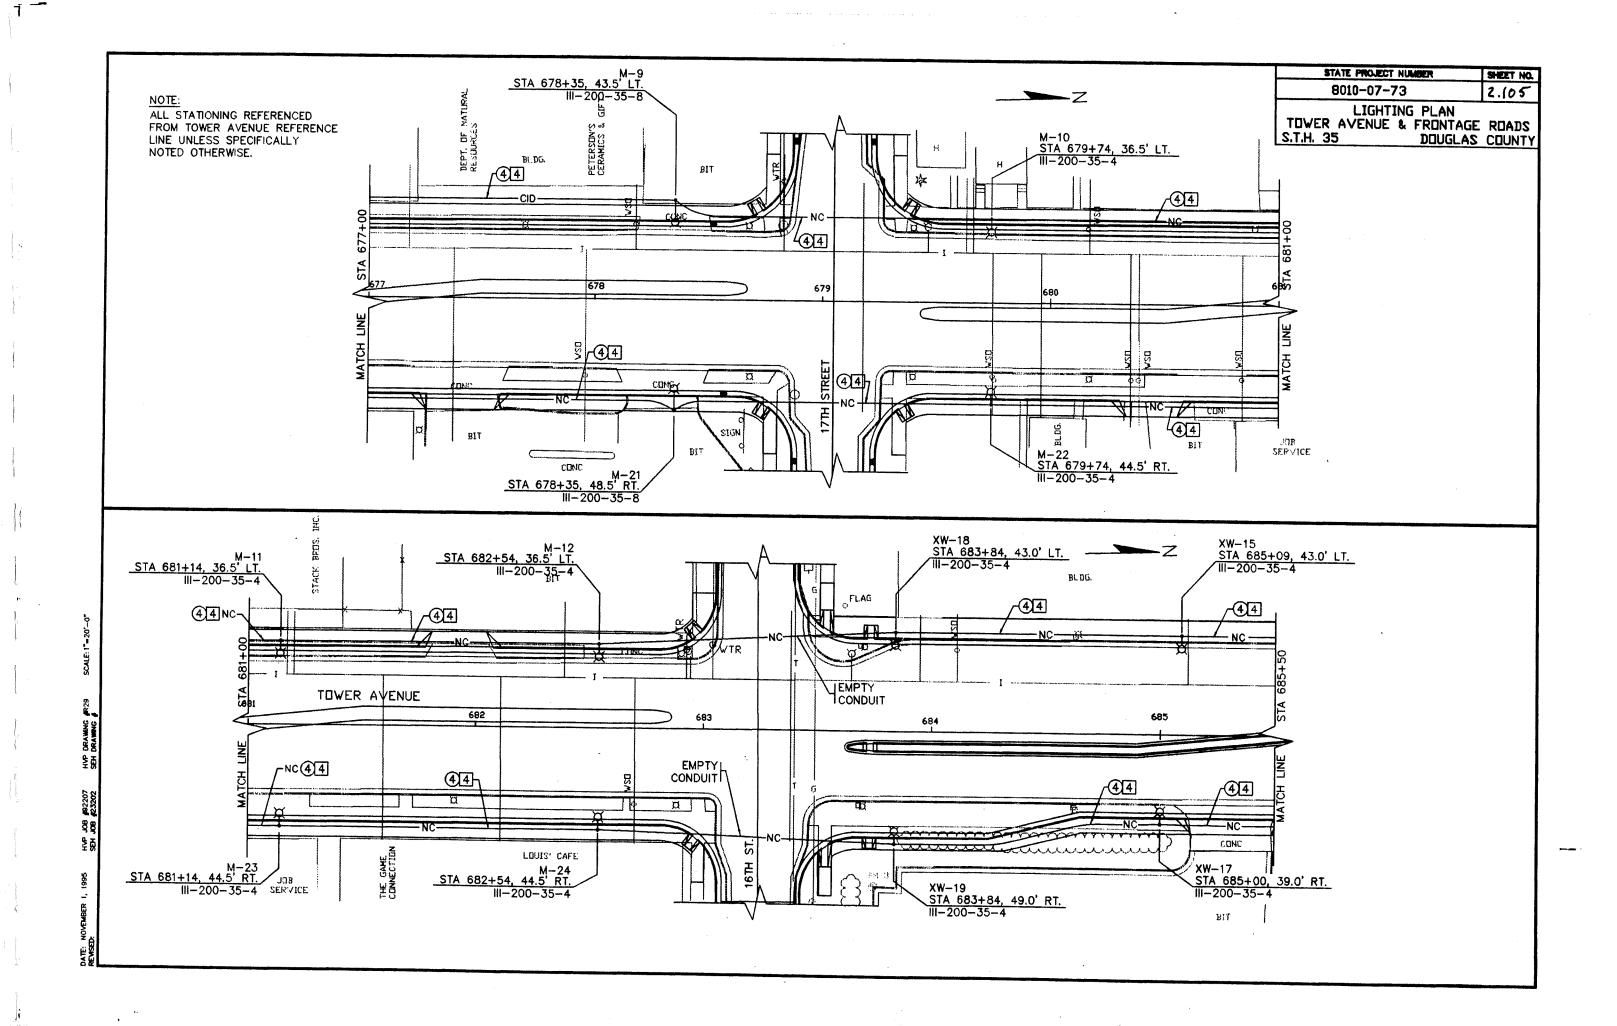

STATE PROJECT NUMBER
SHEET NO. %
8010-07-73
2.108
LIGHTING SERVICE PLAN
TOWER AVENUE, CITY OF SUPERIOR
S.T.H. 35
DOUGLAS COUNTY

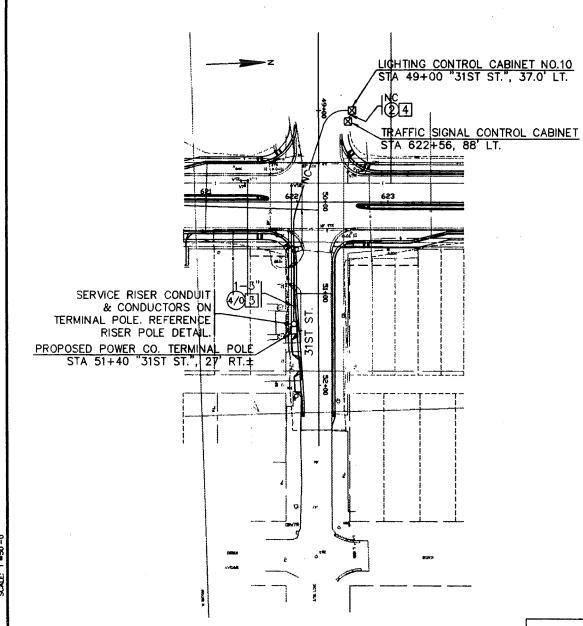

316 STUB CONDUIT 24"
ABOVE GRADE & EMPTY CONDUIT CAP AT STA 637+07, 45' RT. SAWOUT EXISTING
ASPHALTIC ALLEY.
REMOVE 3 MDE
SECTION OF ASPHAL TRAFFIC SIGNAL CONTROL CABINET STA 635+06, 77' RT. & BASE COURSE. LIGHTING CONTROL CABINET NO.11 STA 635+06, 85.0' RT. PATCH ALLEY WITH NEW BASE COURSE & ASPHALTIC CONCRETE STUB CONDUIT 24" | ABOVE GRADE & CAPI LASPHALTIC ALLEY EXISTING POWER CO TERMINAL POLE STA 633+23, 225' RT.H POLE DETAIL.

ELECTRICAL SERVICE PLAN
LIGHTING CONTROL CABINET NO.10
& TRAFFIC SIGNAL CONTROL CABINET


NOTE:
COORDINATE LOCATION OF PULL BOXES & SERVICE CONDUIT WITH LIGHTING CONDUIT. REFERENCE LIGHTING PLANS.

ELECTRICAL SERVICE PLAN
LIGHTING CONTROL CABINET NO.11
& TRAFFIC SIGNAL CONTROL CABINET

A VERIFY EXACT LOCATION WITH ENGINEER AND POWER COMPANY IN THE FIELD.

B REMOVAL & DISPOSAL OF BASE COURSE & ASPHALTIC MATERIAL SHALL BE CONSIDERED INCIDENTAL TO NONMETALLIC CONDUIT, 2-INCH.

ENER 1, 1995 HVP 108 49220

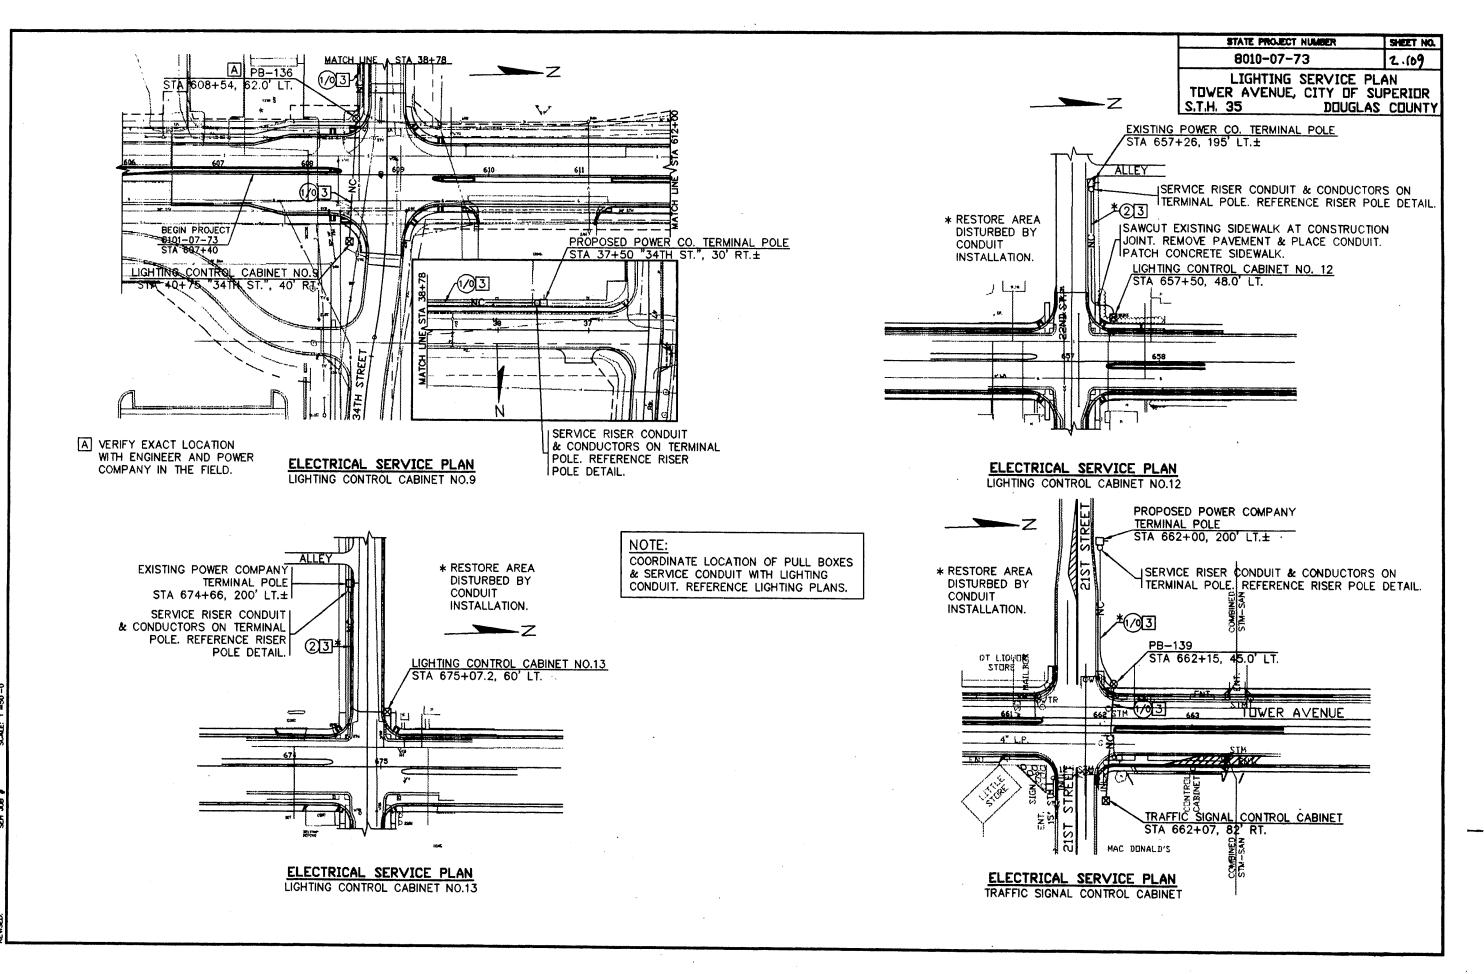


HVP DRAWING FREE SCALE: 1"-50"-0"

HVP JOB #97207

OVEMBER 1, 1995

DATE: NOVEMBER !

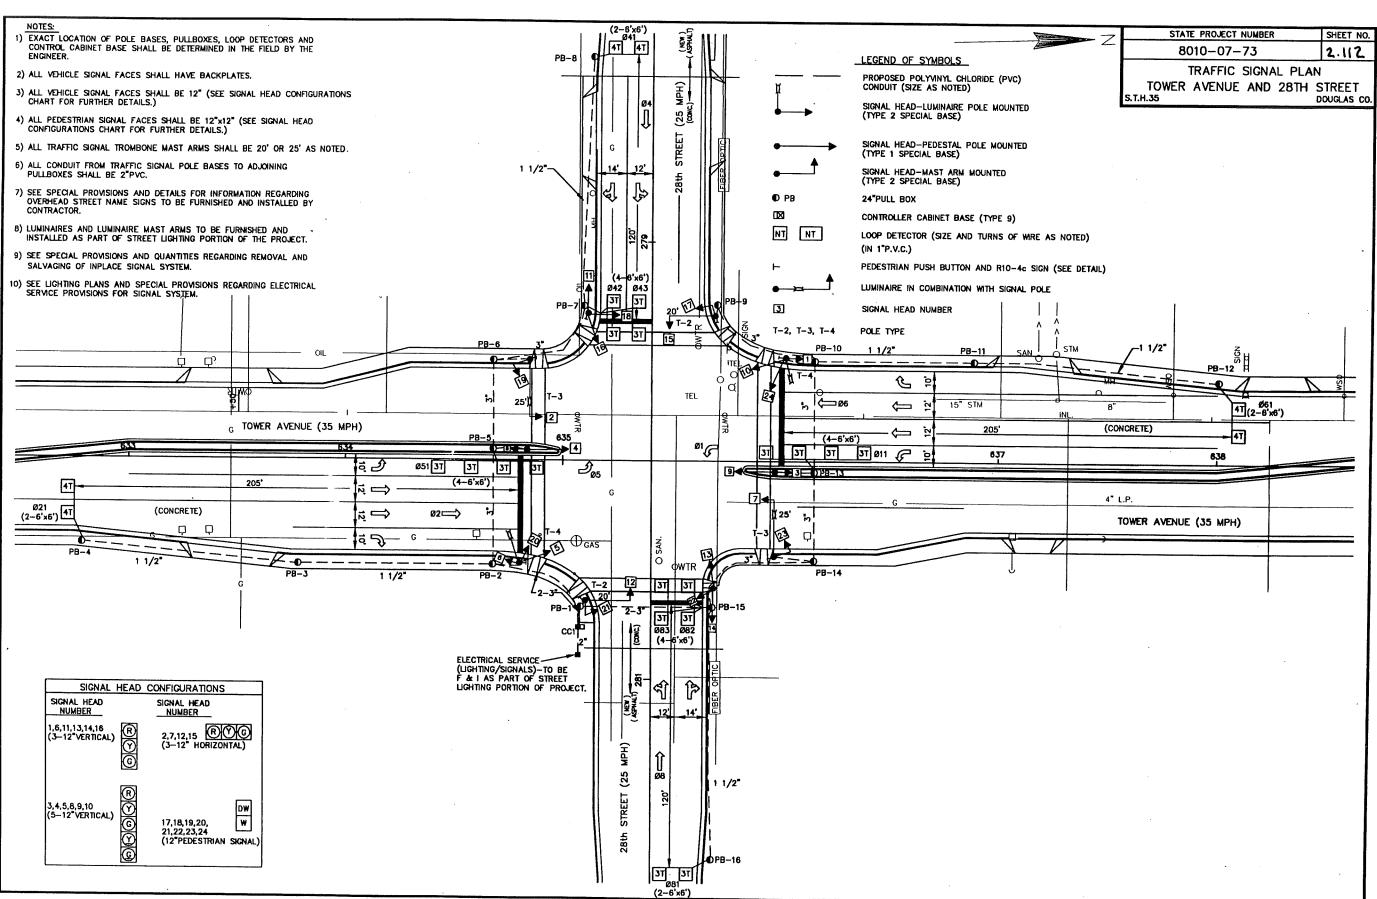

• •	=	WHEN	CALLED,	TIMES	STEADY	WALK,	THEN	FLASHING	DON'T	WALK,	THEN	STEADY	DON'T	WALK.

<ul> <li>RED INDICATION IS ASSOCIATED WITH CORRESPONDING THROUGH PHAS</li> </ul>		= RED	INDICATION	IS	ASSOCIATED	WITH	CORRESPONDING	THROUGH	PHASE
--	--	-------	------------	----	------------	------	---------------	---------	-------

	CHART 1	
PHASE ON	NON-CONFLICTING PHASE ALLOWED TO TIME CONCURRENTLY	PHASES IN CONFLICT WITH PHASE ON
Ø1	5or6	2-4-8
Ø2	5or6	1-4-8
Ø3	_	_
Ø4	8	1-2-5-6
Ø5	1or2	468
Ø6	1or2	4-5-8
Ø7	_	_
Ø8	4	1-2-5-6





78" x 18" , 3"R. 1.0"B ' LINE 1 65.6: 8"-6"E MOD.




60" x 18" , 3"R. 1.0"B. LINE 1 47.9: 8"-6"E MOD.

#### SIGN NOTES:

- 1) COLOR WHITE ON GREEN BACKGROUND.
- 2) TYPE "H" REFLECTIVE SHEETING ON ALUMINUM SHEETING SHALL BE USED.
- 3) SIGNS TO BE FURNISHED AND INSTALLED ON TRAFFIC SIGNAL MAST ARMS AT 5' FROM RIGHT END OF MAST ARM.



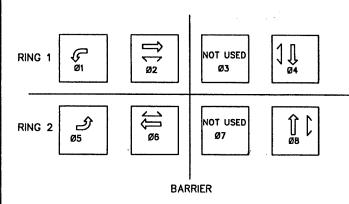

#### NOTES:

- 1) ANY ACTUATED PHASE FOR WHICH THERE IS NO CALL SHALL BE SKIPPED.
- 2) WHEN ONE PHASE IS ON ALONE, ANY NON-CONFLICTING PHASE MAY START TIMING CONCURRENTLY, WITHOUT A CLEARANCE INTERVAL (SEE CHART 1 AT LEFT).
- 3) IF ANY OPPOSING THROUGH PHASES ARE TIMING CONCURRENTLY, THEY SHALL TERMINATE TOGETHER DUE TO PERMISSIVE LEFT TURN CONFLICT.

O.L.	"A"	-	NONE
0.L.	"B"	-	NONE
0.L.	"C"	_	NONE

O.L. "D" - NONE

OVERLAPS

	CONTROL	LER LOGIC	)
PHASE NUMBER	PHASE LOCKING	PHASE RECALL	DUAL ENTRY
Ø1	N	N	N
Ø2	Y	MIN.	N
Ø3	N	N	N
Ø4	N	N	Ø8
Ø5	N	N	N
Ø6	Y	MIN.	N
Ø7	N	N	N
Ø8	N	. N	Ø4

8010-07-73	2.113
TRAFFIC SIGNAL PLAN C	CHARTS
TOWER AVENUE AND 28TH	STREET

SHEET NO.

TOWER AVENUE AND 28TH STREET S.T.H.35 DOUGLAS CO.

STATE PROJECT NUMBER

				DETEC	TOR OPER	ATION						
DETECTOR NUMBER	SIZE (FT.)	DISTANCE FROM STOP BAR	AMPLIFIER CHANNEL	CALLS & EXTENDS	CALLS ONLY	EXTENDS ONLY	PHASE CALLED	PHASE EXTENDED	CALLING DELAY	DETECTOR DISCONNECT		MOTOR CYCLE SENSITIVITY
Ø11	4-6x6	5',20',35'	1	Х			Ø1	Ø1				
Ø21	2-6x6	205'	2	Х			Ø2	Ø2			X	
Ø41	2-6x6	120'	3			Х	-	Ø4				
Ø42	2-6x6	5'	4	X			Ø4	04	Х			
Ø43	2-6x6	5'	5	Х			Ø4	Ø4				
Ø51	4-6x6	5',20',35'	6	Х			Ø5	Ø5				
Ø61	2-6x6	205'	7	X			Ø6	Ø6			X	
Ø81	2-6x6	120'	8			Х	-	Ø8				
Ø82	2-6x6	5'	9	X			Ø8	Ø8	X			
Ø83	2-6x6	5'	10 -	Х			Ø8	Ø8				
l.												


DETECTOR LOGIC

PEDESTRIAN PUSH BUTTON SIGN 9"x12"

BLACK LEGEND, BORDER, AND ARROW ON WHITE NON-REFLECTORIZED BACKGROUND






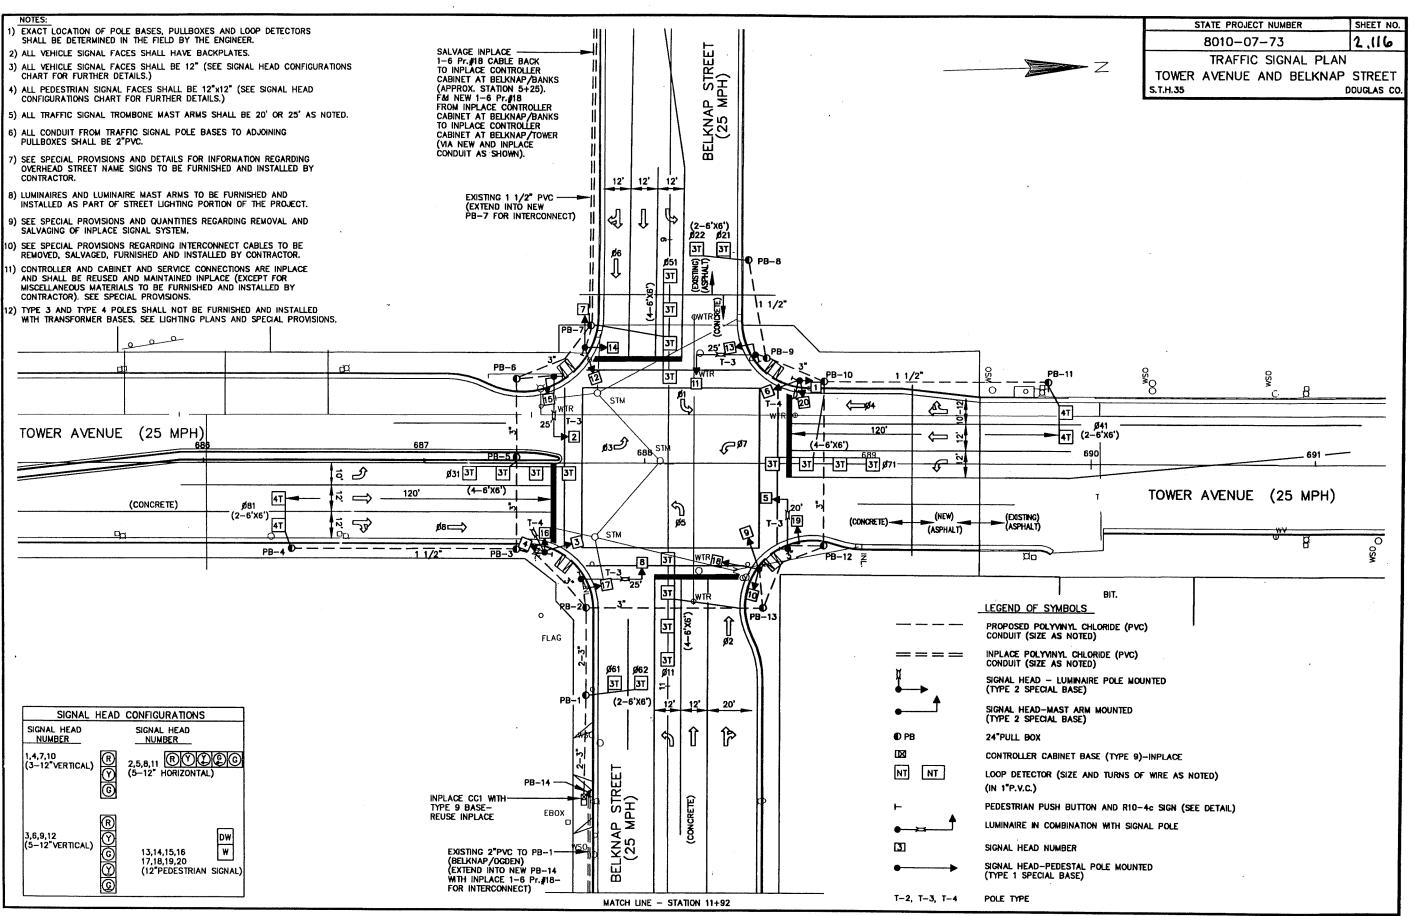

										S	EQUI	ENC	E 0	FOP	ER/	ATIC	N									
	HEAD	1 '	<u></u>				,	l	<u>∌</u> ø3			 Ø4		1	<u>)</u> Ø5		(	] [] Ø6	,	Ø			l	⇒ øs′		FLASH
	NUMBER	R/W	a,	EAR 10	R/W	CL	EAR TO	R/W	CI.	EAR TO	R/W	a	EAR TO	R/W	CLI	EAR O	R/W	CLI	EAR O	R/W	α. I	EAR O	R/W	CL	EAR TO	FLASE
Ø١	8,9	G	Y	•	R	R	R	R	R	R	R	R	R	R	R	R	R	R	R	R	R	R	R	R	R	
Ø2	10,11,12	R	R	R	G	Υ	R	R	R	R	R	R	R	R	R	R	R	R	R	R	R	R	R	R	R	Y
Ø3	5,6	R	R	R	R	R	R	ပ	Y	*	R	R	R	R	R	R	R	R	R	R	R	R	R	R	R	_
Ø4	1,2,3	R	R	R	R	R	R	R	R	R	G	Y	R	R	R	R	R	R	R	R	R	R	R	R	R	R
<b>Ø</b> 5	11,12	R	R	R	R	R	R	R	R	R	R	R	R	G	Y	٠	R	R	R	R	R	R	R	R	R	_
Ø6	7,8,9	R	R	R	R	R	R	R	R	R	R	R	R	R	R	R	G	Y	R	R	R	R	R	R	R	Y
Ø7	2,3	R	R	R	R	R	R	R	R	R	R	R	R	R	R	R	R	R	R	G	Y	•	R	R	R	_
Ø8	4,5,6	R	R	R	R	R	R	R	R	R	R	R	R	R	R	R	R	R	R	R	R	R	G	Y	R	R
ΈD	19,20	DW	DW	DW	**	DW	DW	DW	DW	DW	DW	DW	DW	DW	DW	DW	DW	DW	DW	DW	DW	DW	DW	DW	DW	
ED	13,14	DW	D₩	DW	DW	DW	DW		DW			DW		DW			DW		DW		DW	DW	DW		DW	
	15,16	DW	DW	DW	DW	DW	DW	DW	DW	DW	DW	DW	DW	DW	DW	DW	**	DW	DW	DW	DW	DW	DW	DW	DW	
	17,18	DW	DW	DW	DW	DW	DW	DW	DW	DW	DW	DW	DW	DW	DW	DW	DW	DW	DW	DW	DW	DW	**	DW	DW	

- \*\* WHEN CALLED, TIMES STEADY WALK, THEN FLASHING DON'T WALK, THEN STEADY DON'T WALK.
- \* = RED INDICATION IS ASSOCIATED WITH CORRESPONDING THROUGH PHASE.


	CHART 1	
PHASE ON	NON-CONFLICTING PHASE ALLOWED TO TIME CONCURRENTLY	PHASES IN CONFLICT
Ø1	5or6	2-3-4-7-8
Ø2	5or6	1-3-4-7-8
Ø3	7or8	1-2-4-5-6
Ø4	7or8	1-2-3-5-6
Ø5	1or2 ,	3-4-6-7-8
Ø6	1or2	3-4-5-7-8
Ø7	3or4	1-2-5-6-8
Ø8	3or4	1-2-5-6-7

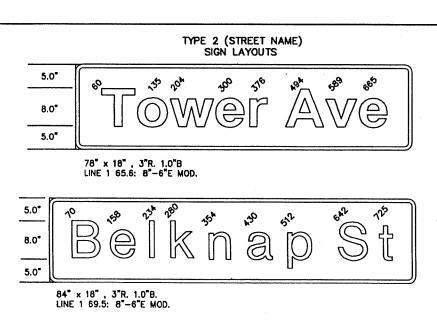

### SIGN NOTES:

- 1) COLOR WHITE ON GREEN BACKGROUND.
- 2) TYPE "H" REFLECTIVE SHEETING ON ALUMINUM SHEETING SHALL BE USED.
- 3) SIGNS TO BE FURNISHED AND INSTALLED ON TRAFFIC SIGNAL MAST ARMS AT 5' FROM RIGHT END OF MAST ARM.



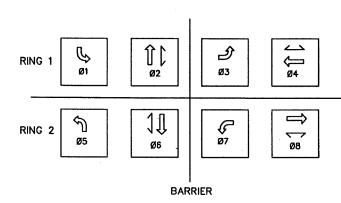

### NOTES:

- 1) ANY ACTUATED PHASE FOR WHICH THERE IS NO CALL SHALL BE SKIPPED.
- 2) WHEN ONE PHASE IS ON ALONE, ANY NON-CONFLICTING PHASE MAY START TIMING CONCURRENTLY, WITHOUT A CLEARANCE INTERVAL (SEE CHART 1 AT LEFT).
- 3) IF ANY OPPOSING THROUGH PHASES ARE TIMING CONCURRENTLY, THEY SHALL TERMINATE TOGETHER DUE TO PERMISSIVE LEFT TURN CONFLICT.

O.L. "A" = NONE  O.L. "B" = NONE  O.L. "C" = NONE	OVERLAPS	
O.L. "C" = NONE	O.L. "A" = NONE	
	O.L. "B" = NONE	
O.L. "D" - NONE	O.L. "C" = NONE	
0.2 0 - 110112	O.L. "D" = NONE	

CONTROLLER LOGIC								
PHASE NUMBER	PHASE LOCKING	PHASE RECALL	DUAL ENTRY					
Ø1	N	- N	N					
Ø2	N	N	N					
Ø3	N	N	N					
Ø4	Y	N	N					
Ø5	N	N	N					
Ø6	N	N	N					
Ø7	N	N	N					
Ø8	Y	N	N					

8010-07-73 **2.117**TRAFFIC SIGNAL PLAN CHARTS
TOWER AVENUE AND BELKNAP STREET
5.T.H.35 DOUGLAS CO.

SHEET NO.

STATE PROJECT NUMBER


DETECTOR LOGIC												
DETECTOR NUMBER	SIZE (FT.)	DISTANCE FROM STOP BAR	AMPLIFIER CHANNEL	DETEC	CALLS ONLY	EXTENDS ONLY	PHASE CALLED	PHASE EXTENDED	CALLING DELAY	DETECTOR DISCONNECT	EXTENSION STRETCH	MOTOR CYCLE SENSITIVITY
Ø11	4-6x6	5',20',35'	1	X			Ø1	Ø1				
Ø21	6x6	45'	2	X			Ø2	Ø2				
Ø22	6x6	45'	2	X			Ø2	Ø2				
Ø31	4-8x6	5',20',35'	3	Χ			Ø3	Ø3				
Ø41	2-6x6	120'	4	Х			Ø4	04				
Ø51	4-6x6	5',20',35'	5	X			Ø5	Ø5				
Ø61	6x6	45'	6	X			Ø6	Ø6				
Ø62	6x6	45'	6	Х			Ø6	Ø6				
Ø71	4-6x6	5',20',35'	7	Χ			Ø7	Ø7				
Ø81	2-6x6	120'	8	X			Ø8	Ø8				

PEDESTRIAN PUSH BUTTON SIGN 9"x12"

BLACK LEGEND, BORDER, AND ARROW ON WHITE NON-REFLECTORIZED BACKGROUND SIGN NO.R10-4c (R, L or DH)







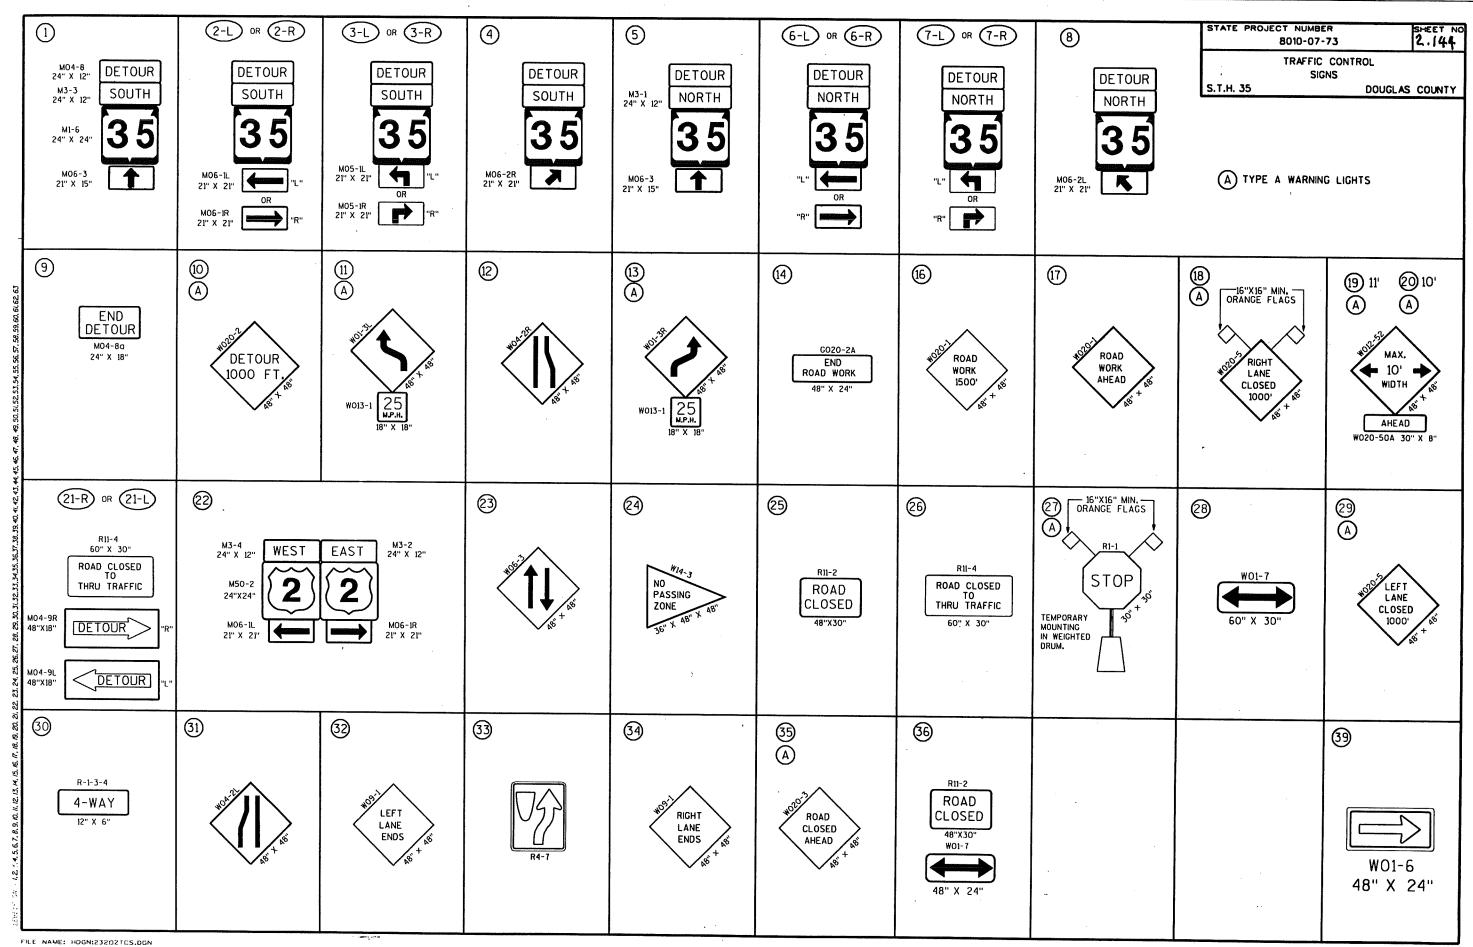



M04-8 24" X 12"  M3-4 24" X 12"  WEST  M1-4 24"X24"  M06-1L 21" X 21"  OR  M06-1R 21" X 21"  "R"	STOP AHEAD 36" X 36"	(2) (42) (42) (42) (42) (43) (43) (43) (43) (43) (43) (43) (43	M1-4 24"X24" <b>2</b>	MO5-1L 21" X 21" OR 44-R MO5-1L 21" X 21" OR "L"	DETOUR WEST  21" X 15"	M4-5 24" X 12"  M3-2 24" X 12"  EAST  2	TO EAST OR QR QR	STATE PROJECT NUMBER 8010-07-7 TRAFFIC ( SIGN S.T.H. 35	CONTROL S DOUGLAS COUNTY
48-L) OR 48-R) TO EAST OR  OR  I I I I I I I I I I I I I I I I	(49) (A) DE TOUR AHE AD ABE	M1-6 24" X 24" 35	·	(52)  R6-2R 24" X 30"  WAY	R3-1 36" X 36"	€4 EAST <b>2</b>			
22, 23, 24, 25, 56, 27, 28, 29, 30, 31, 32, 33, 34, 35, 55, 75, 39, 39, 40, 41, 42, 43, 4									
57 12 14 5 6 7 8 9 10 11 12 13, 4 15 16 17 18 18 20 20.									


FILE NAME: HDGN:2320201.don

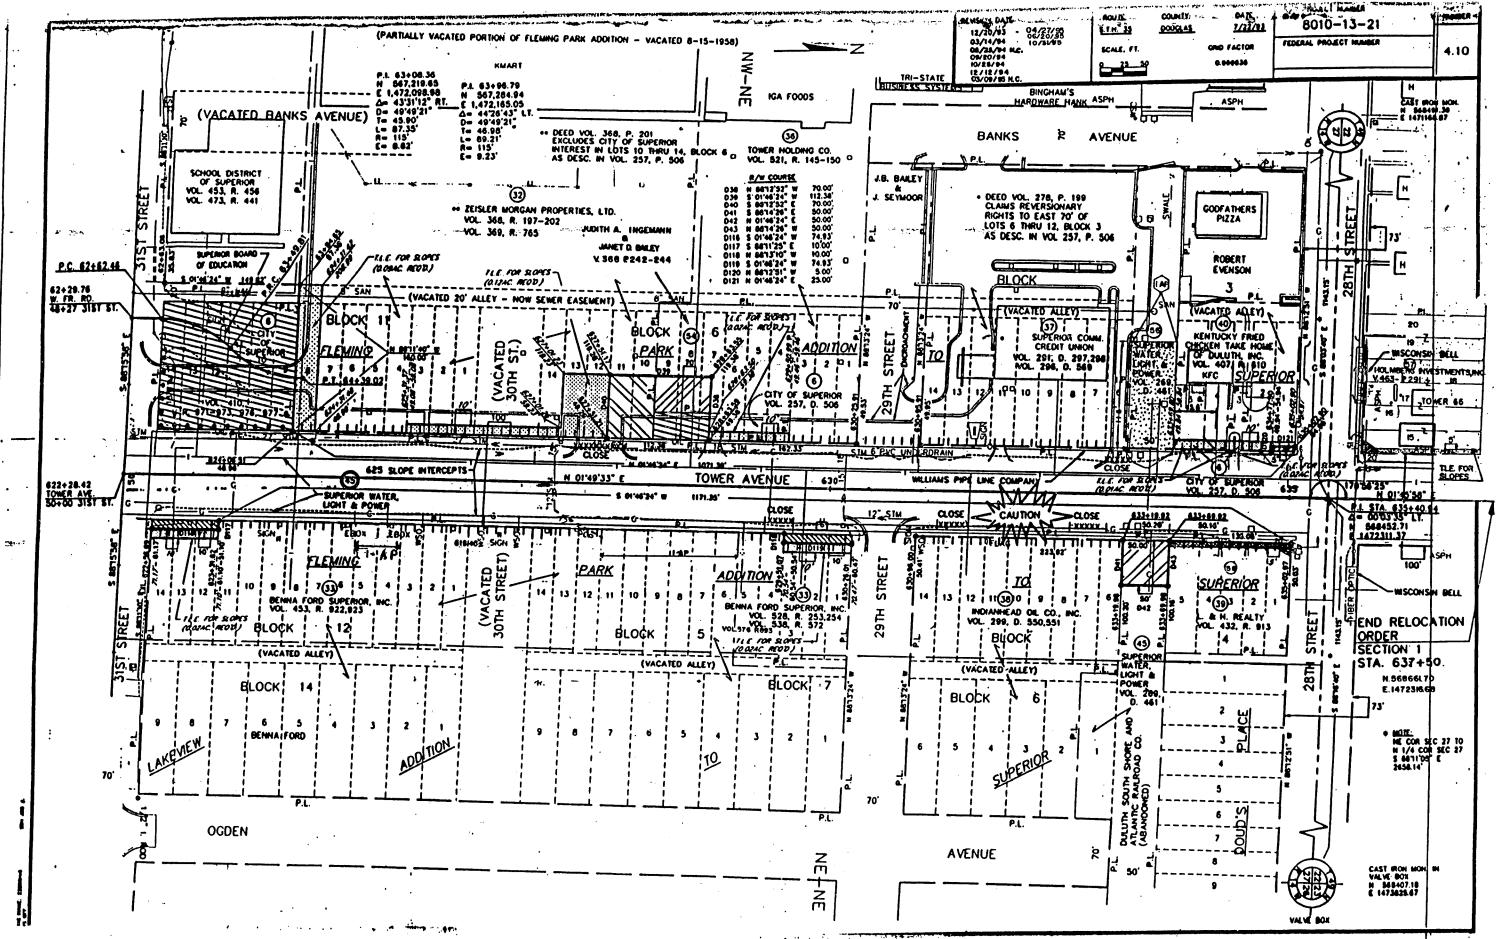


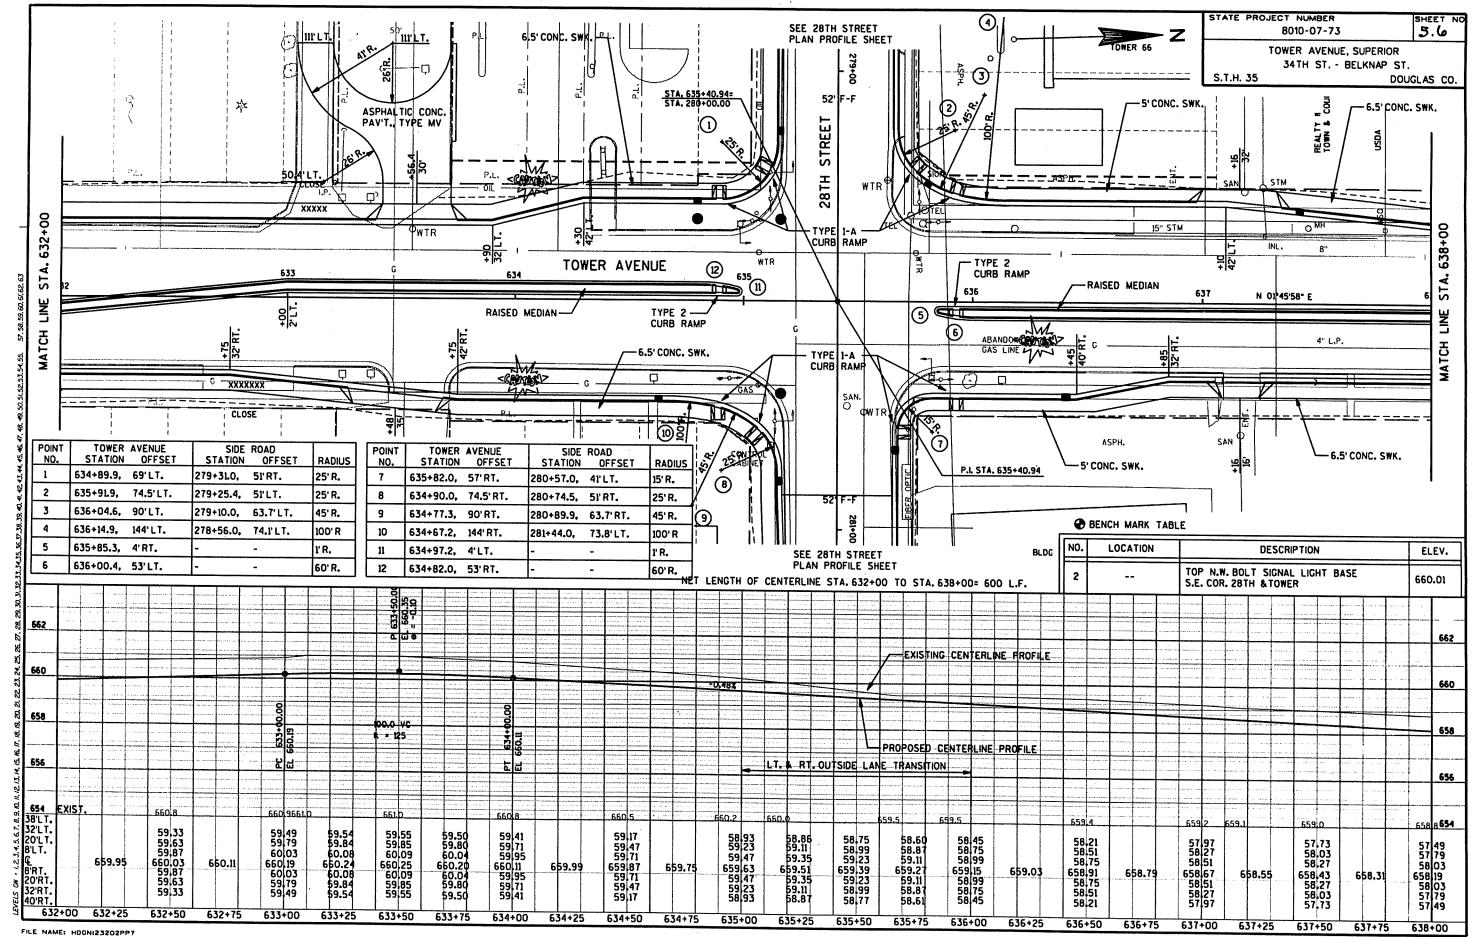


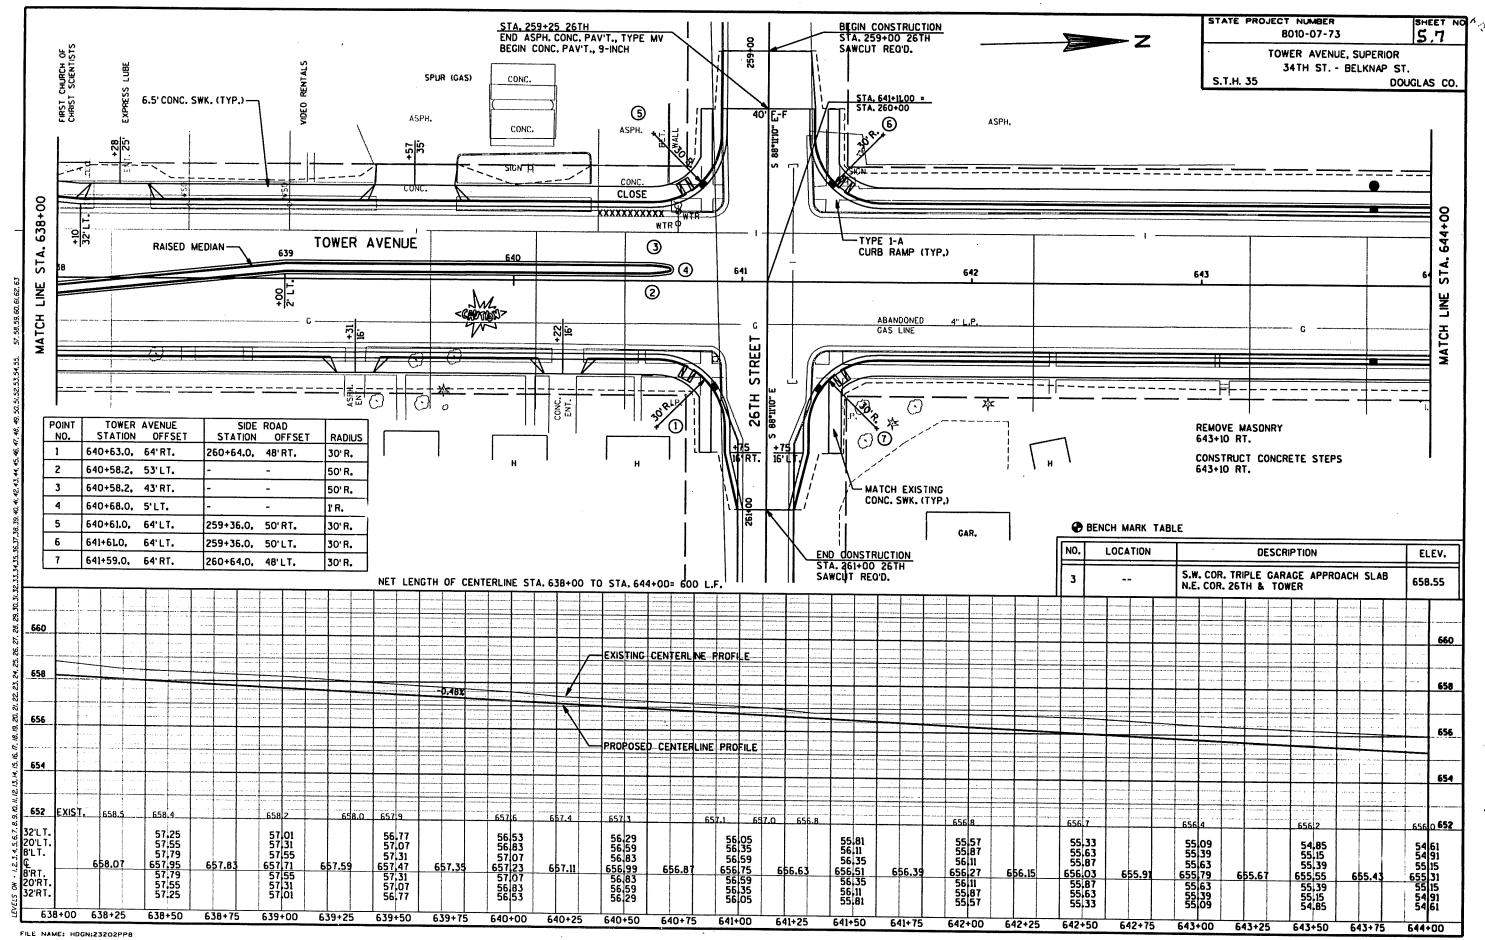


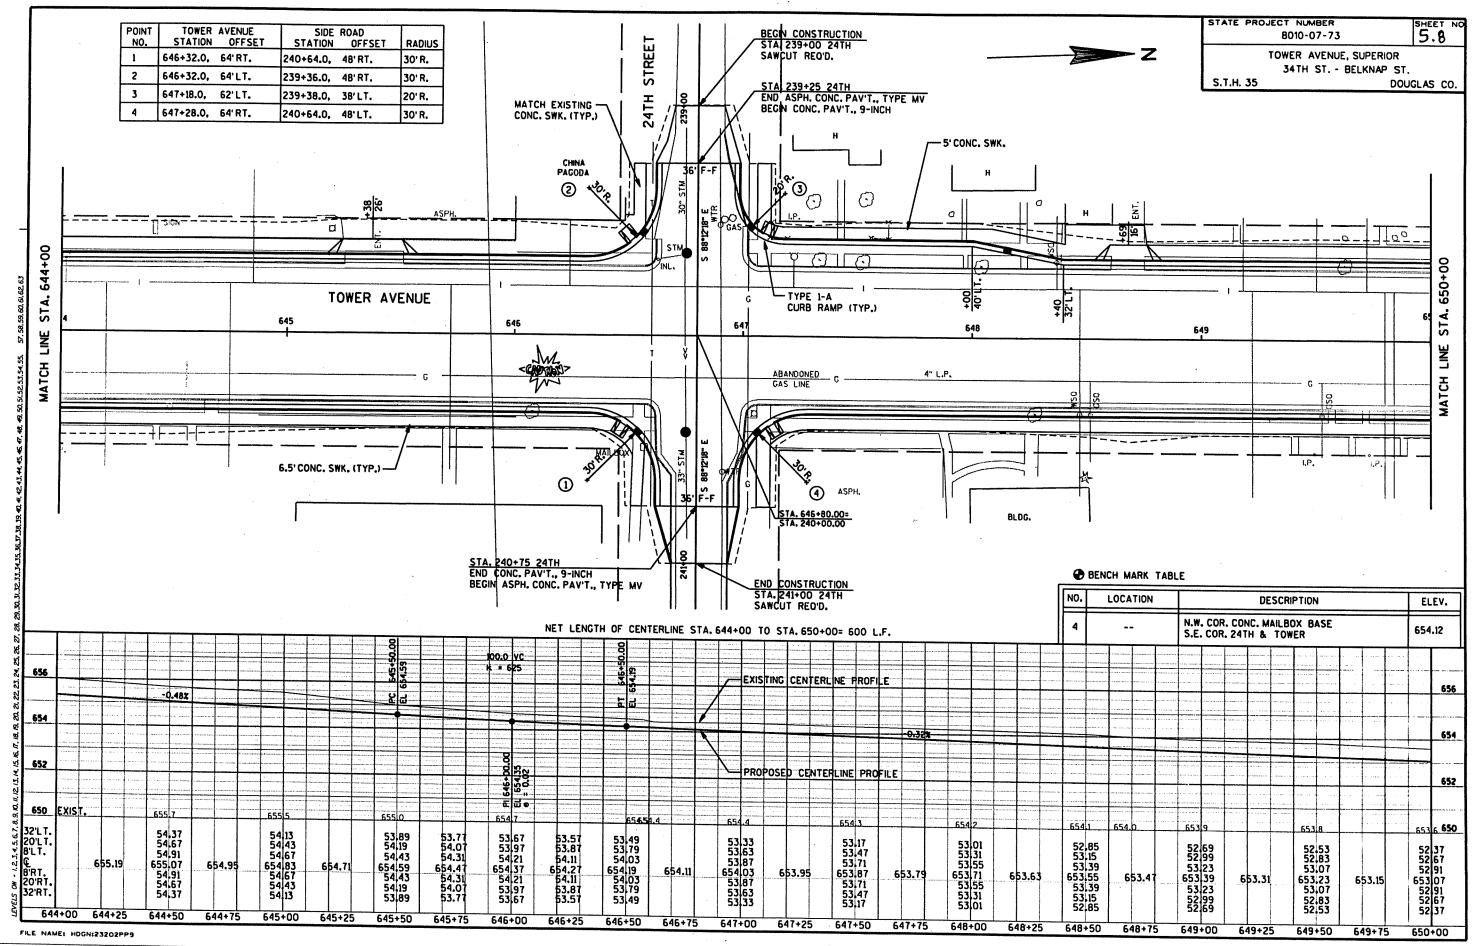


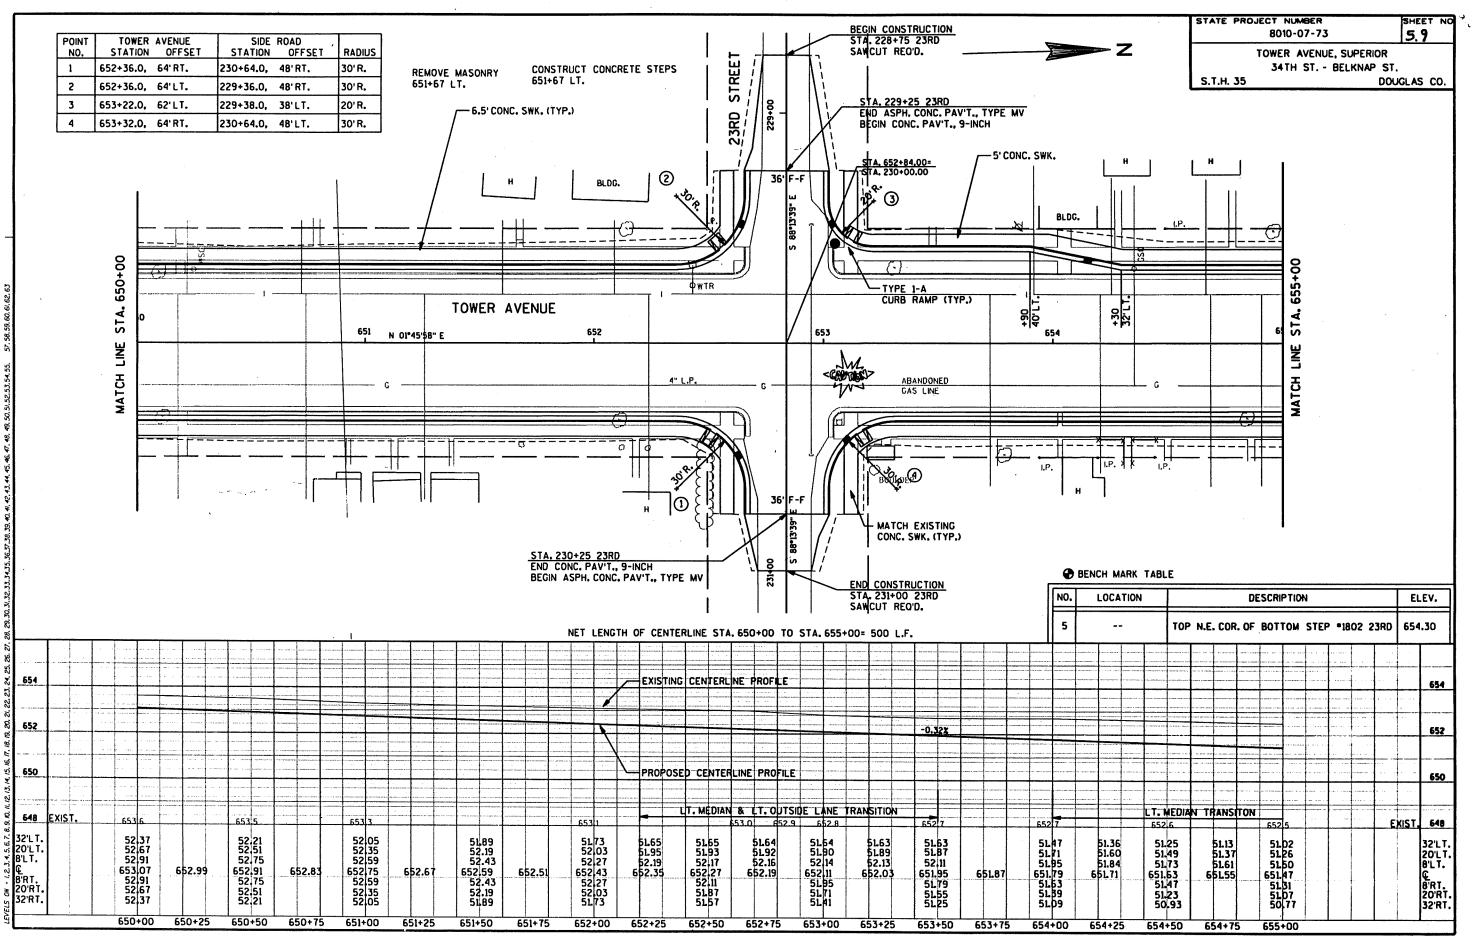


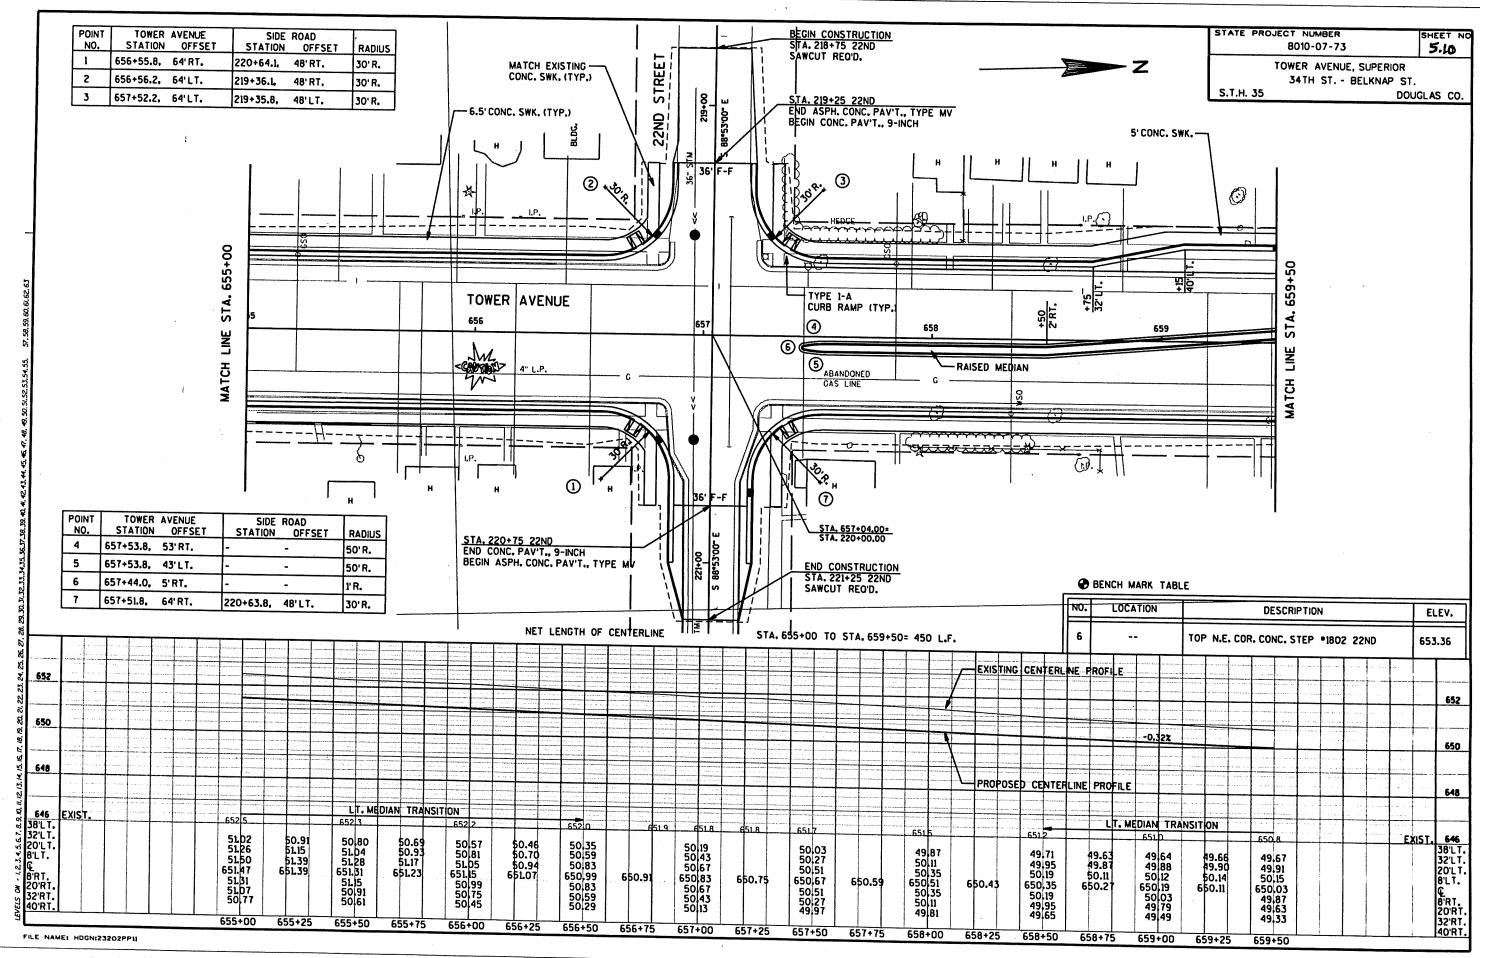


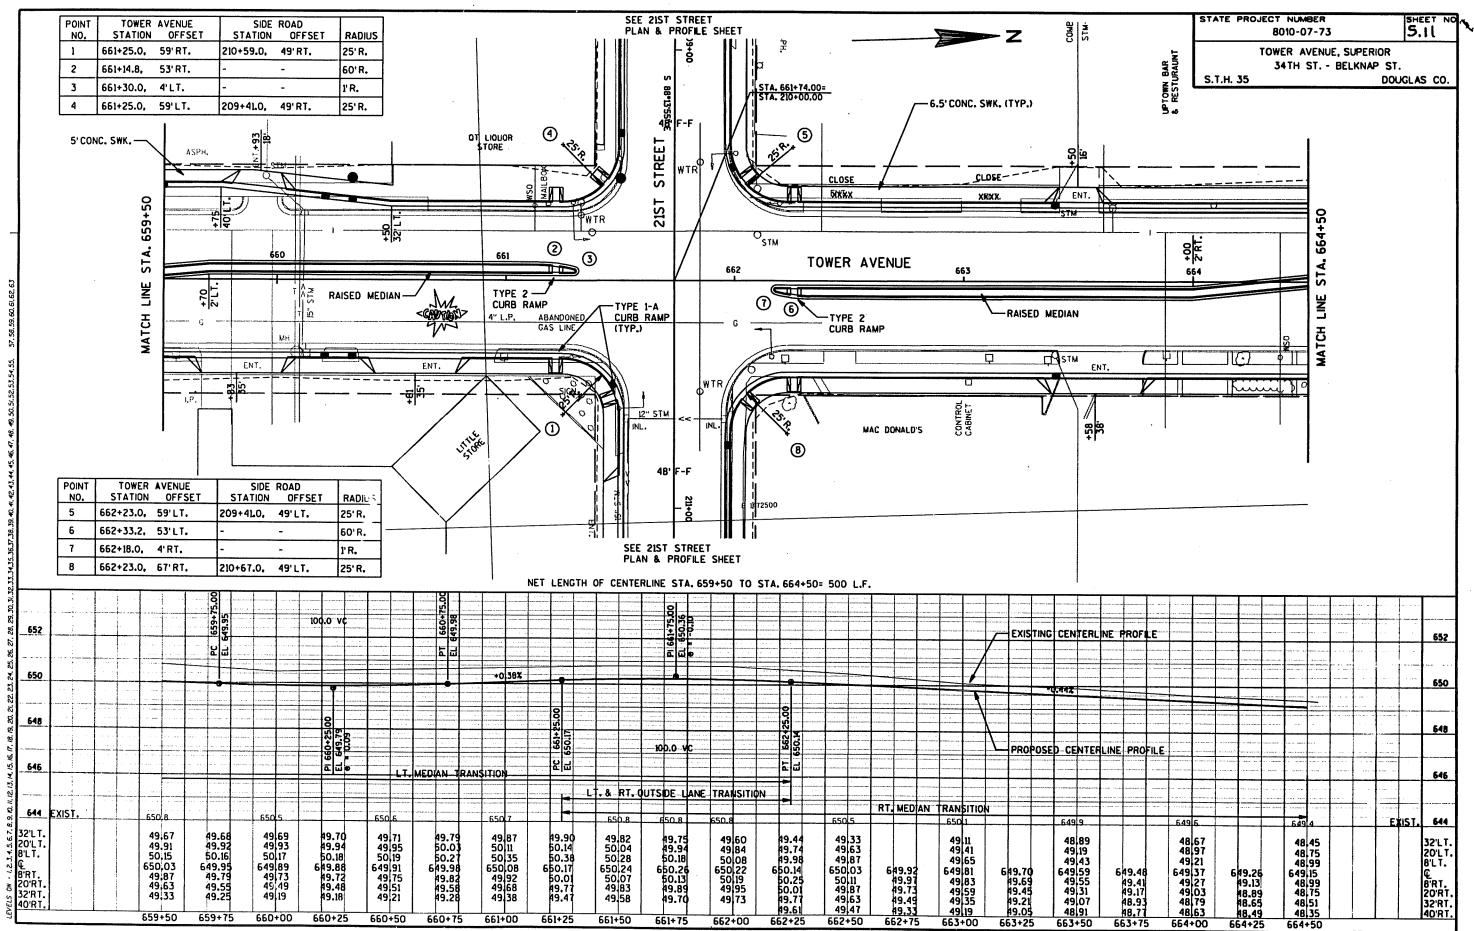


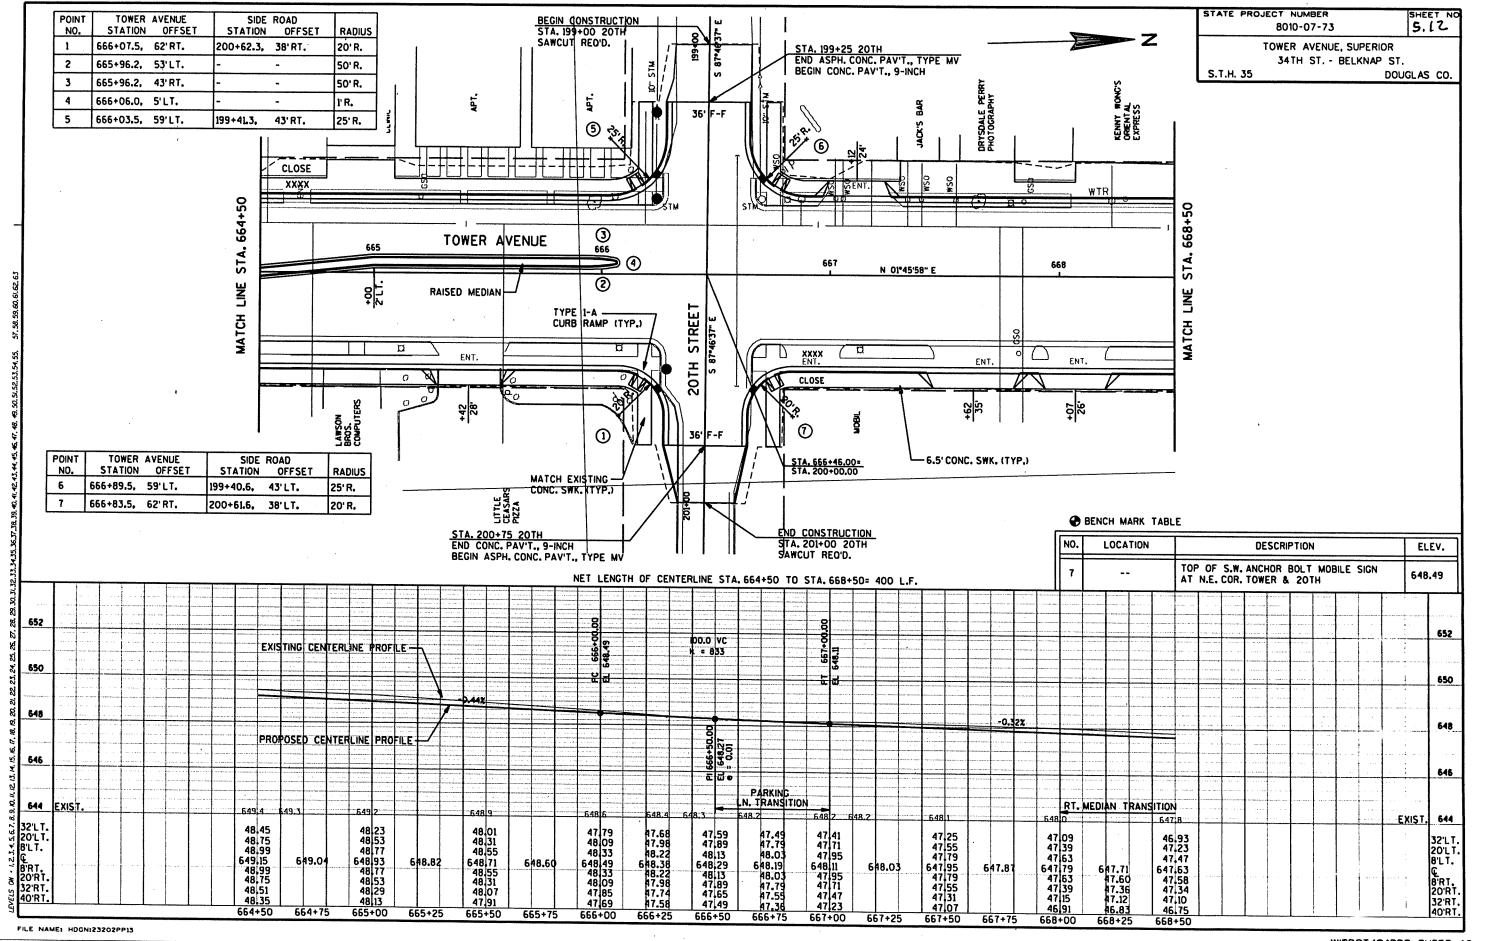


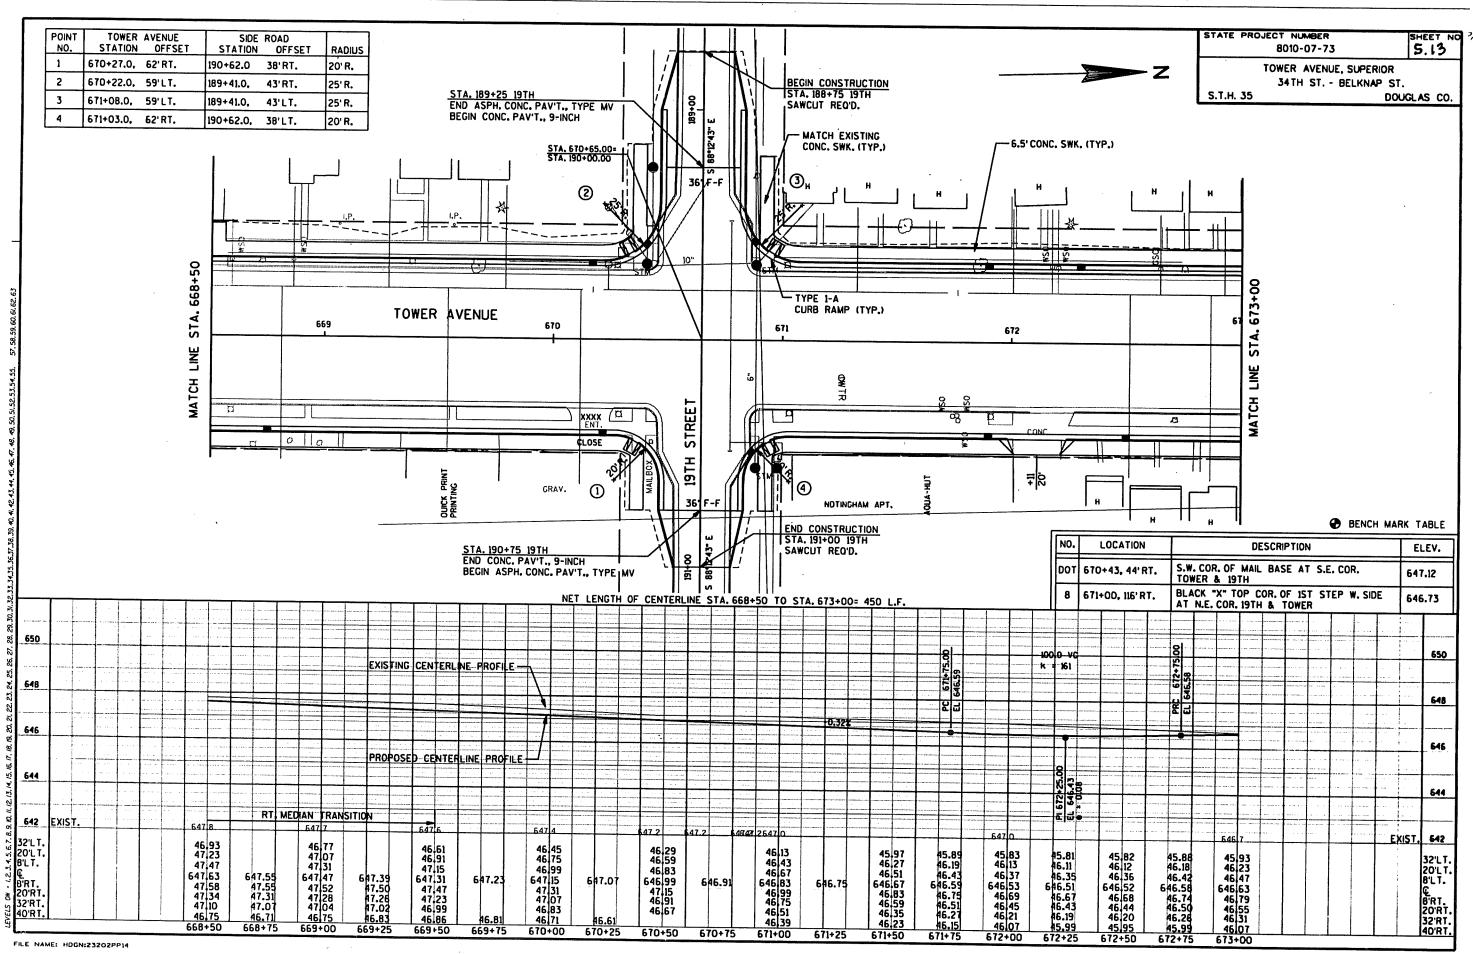


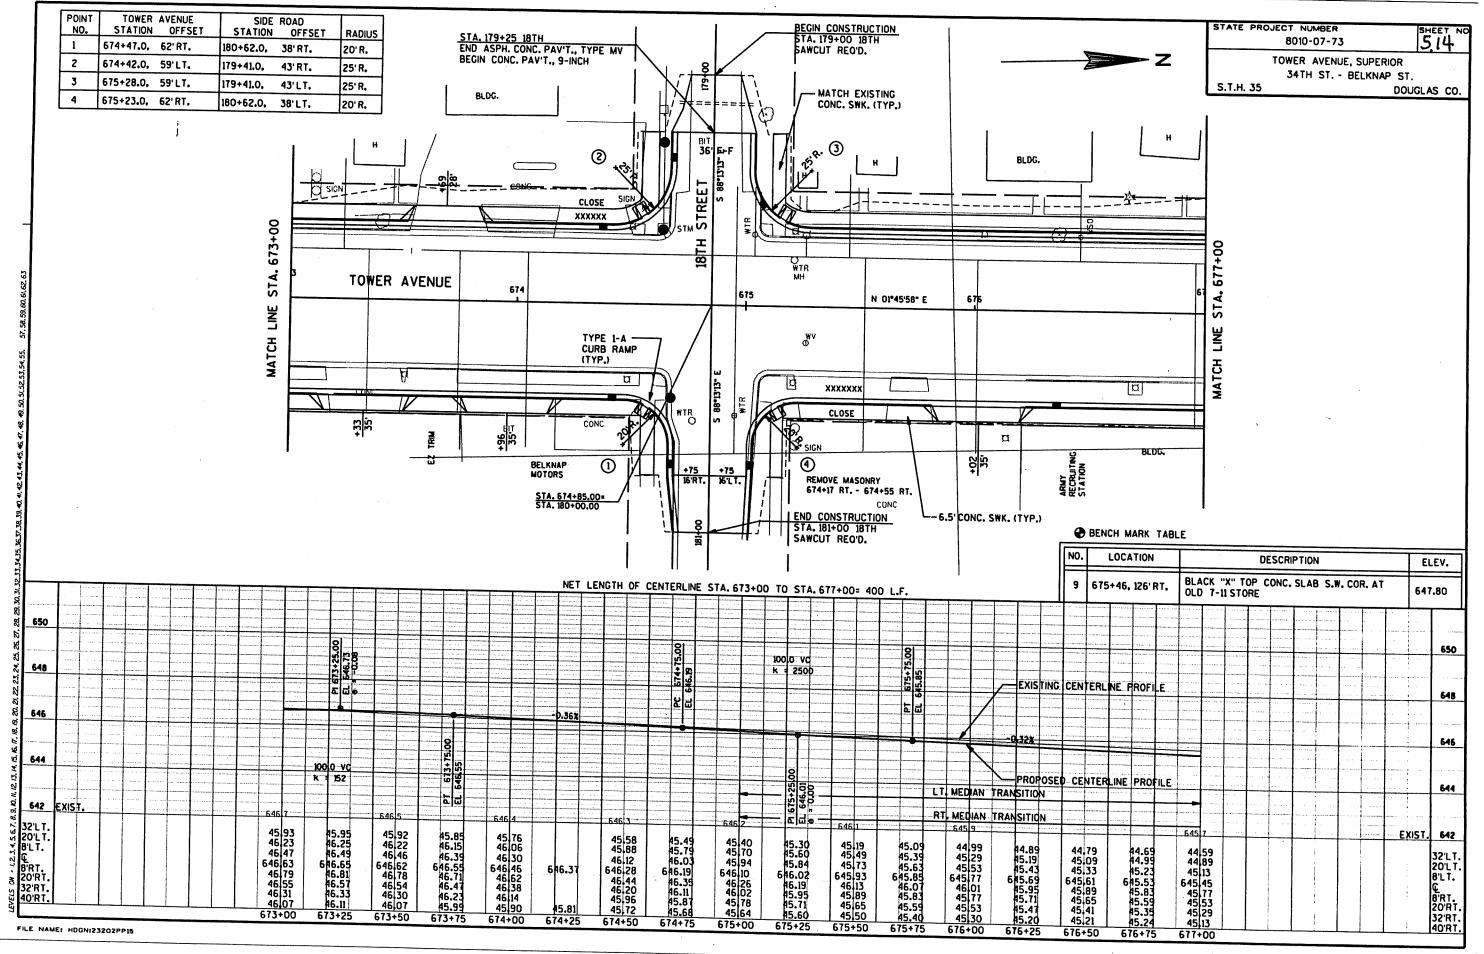


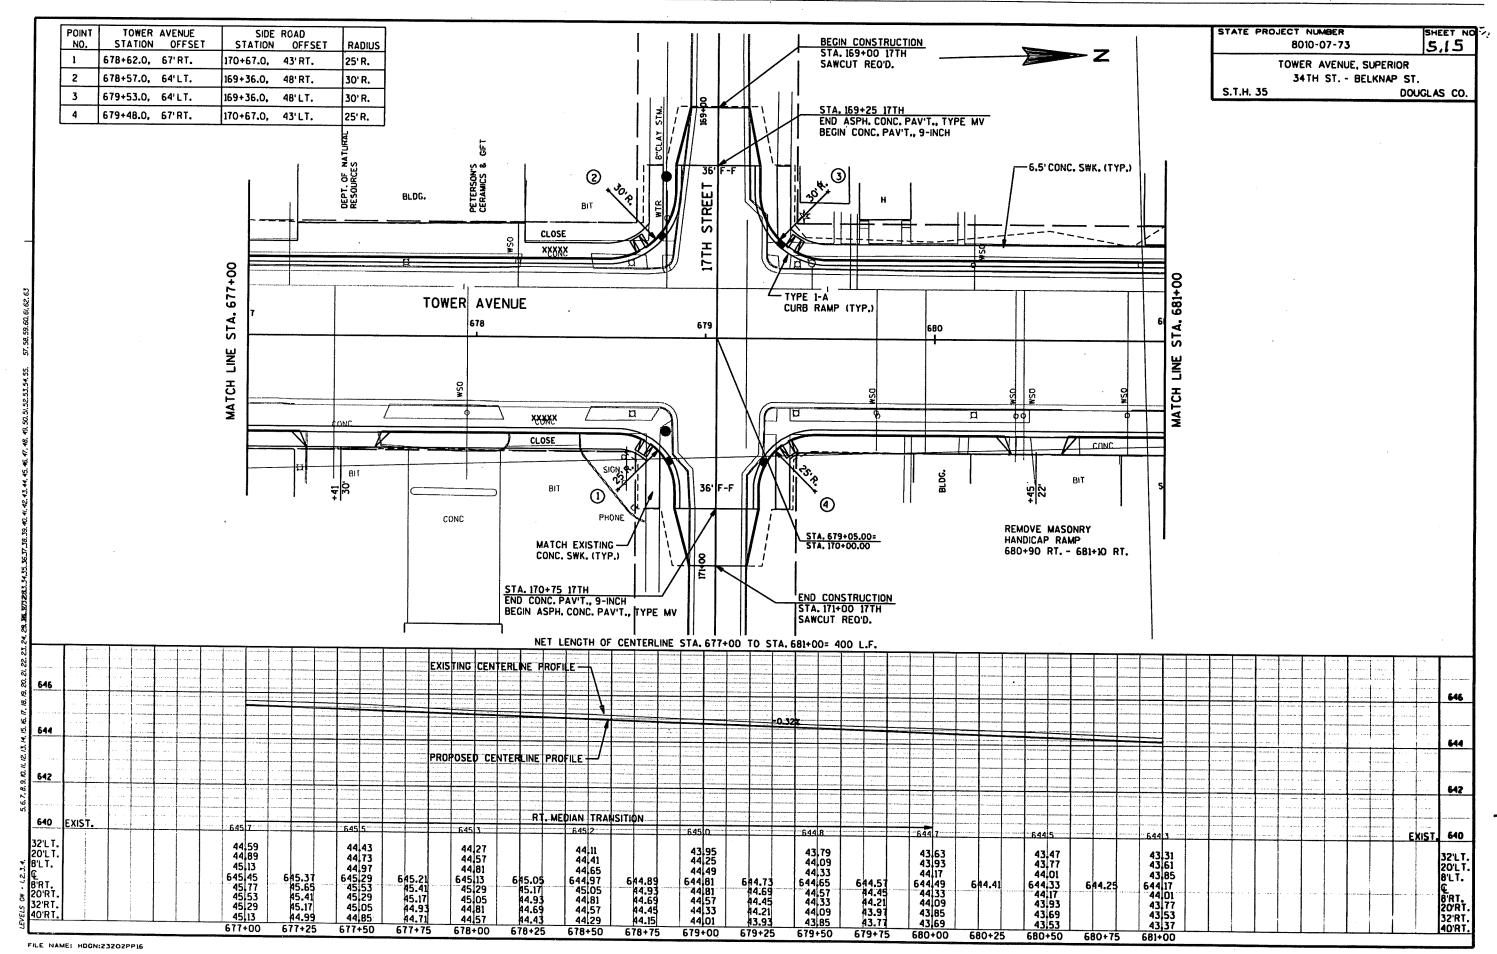


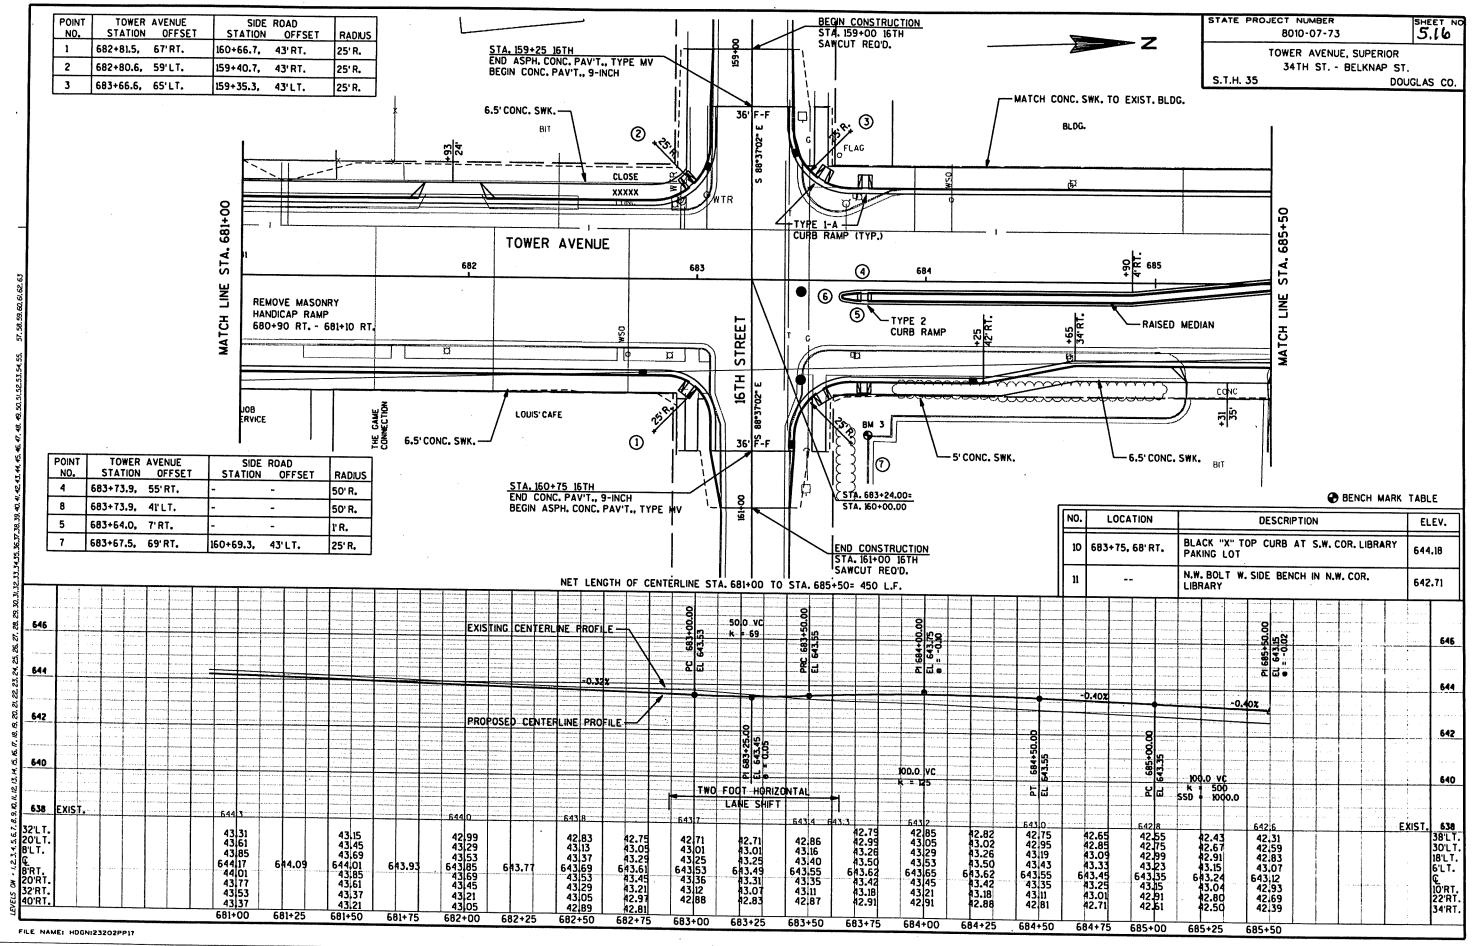


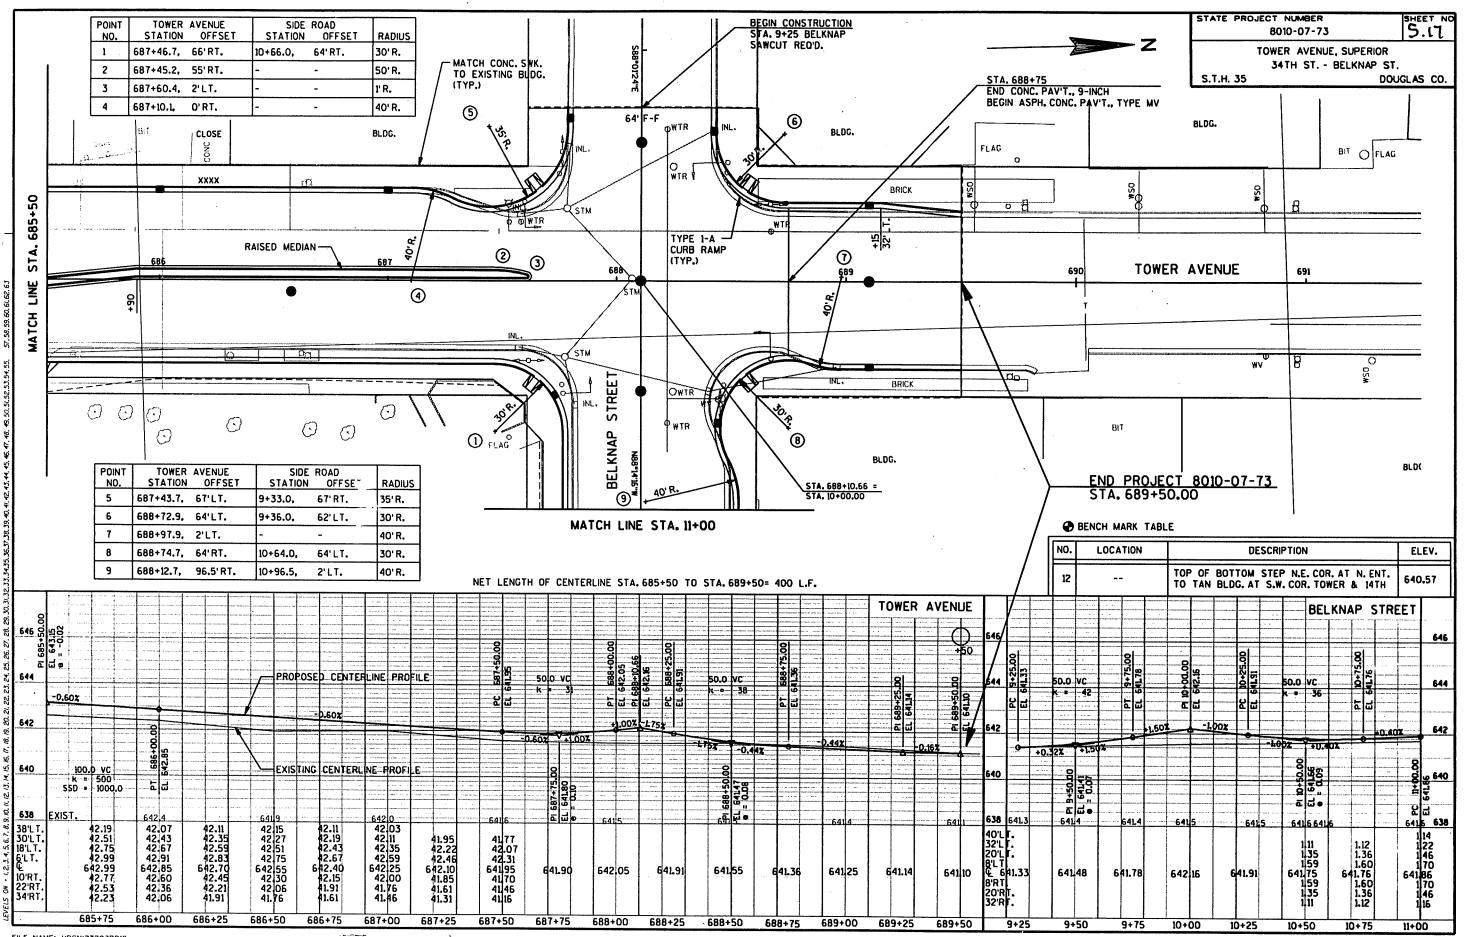


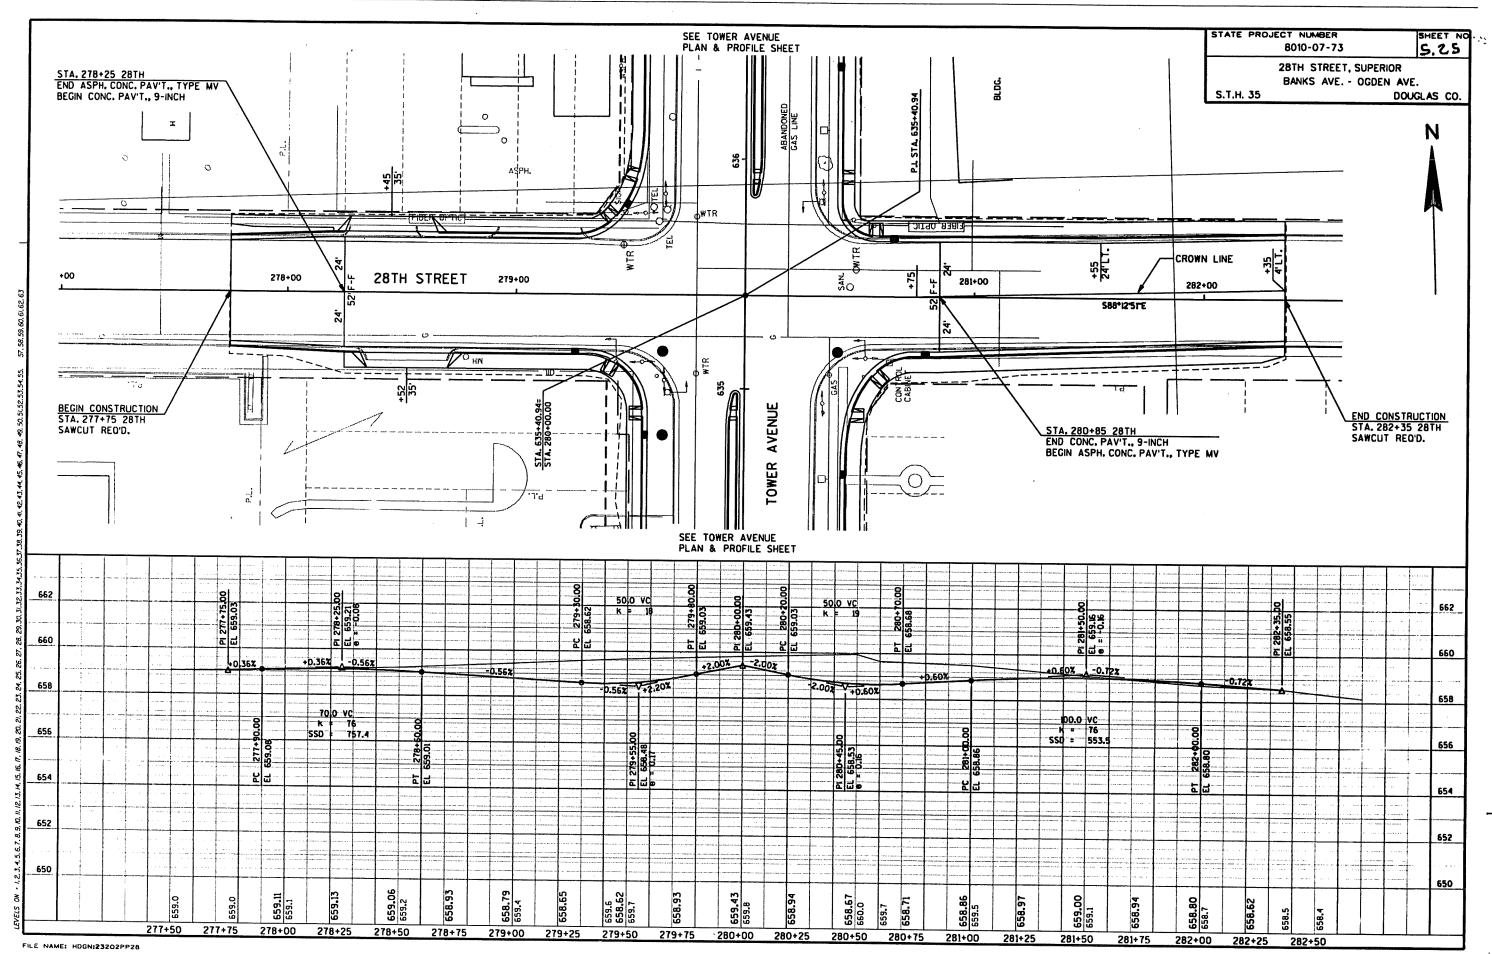


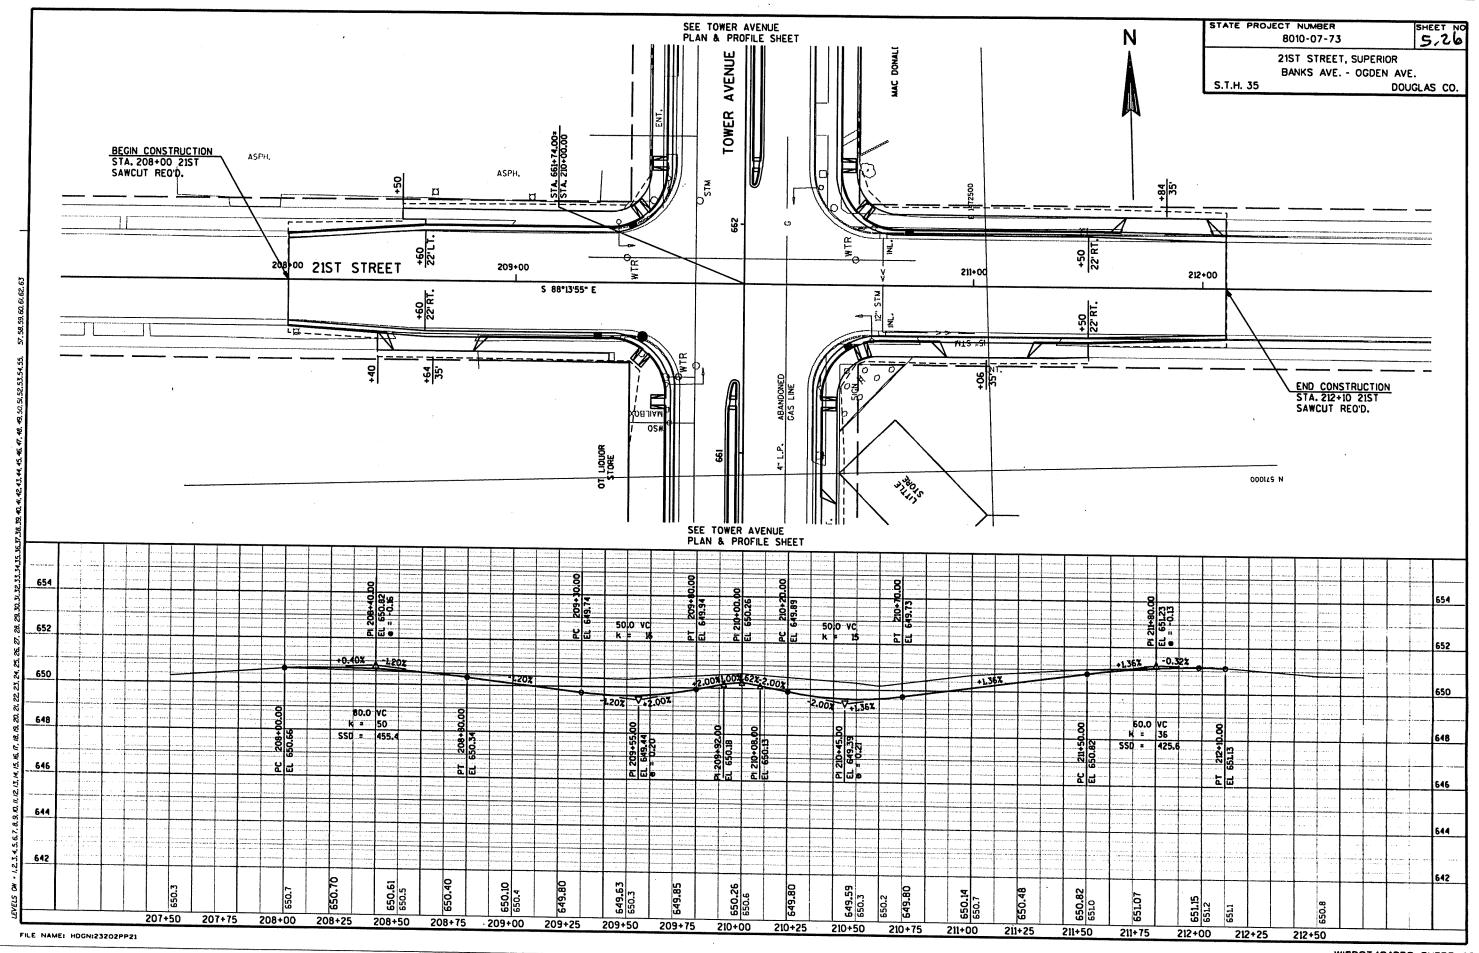

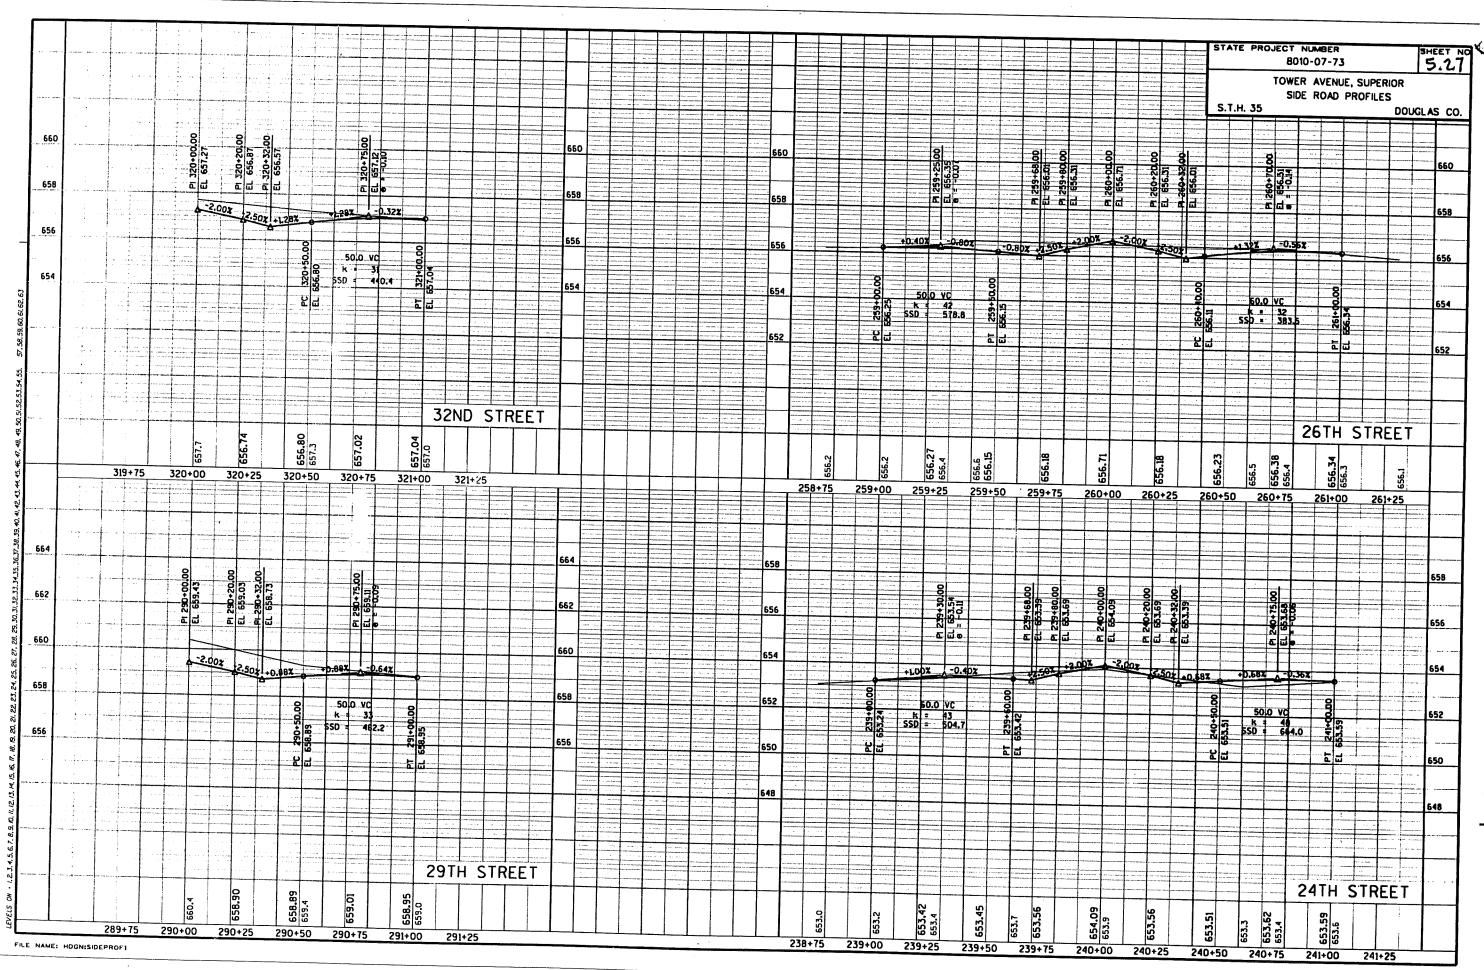

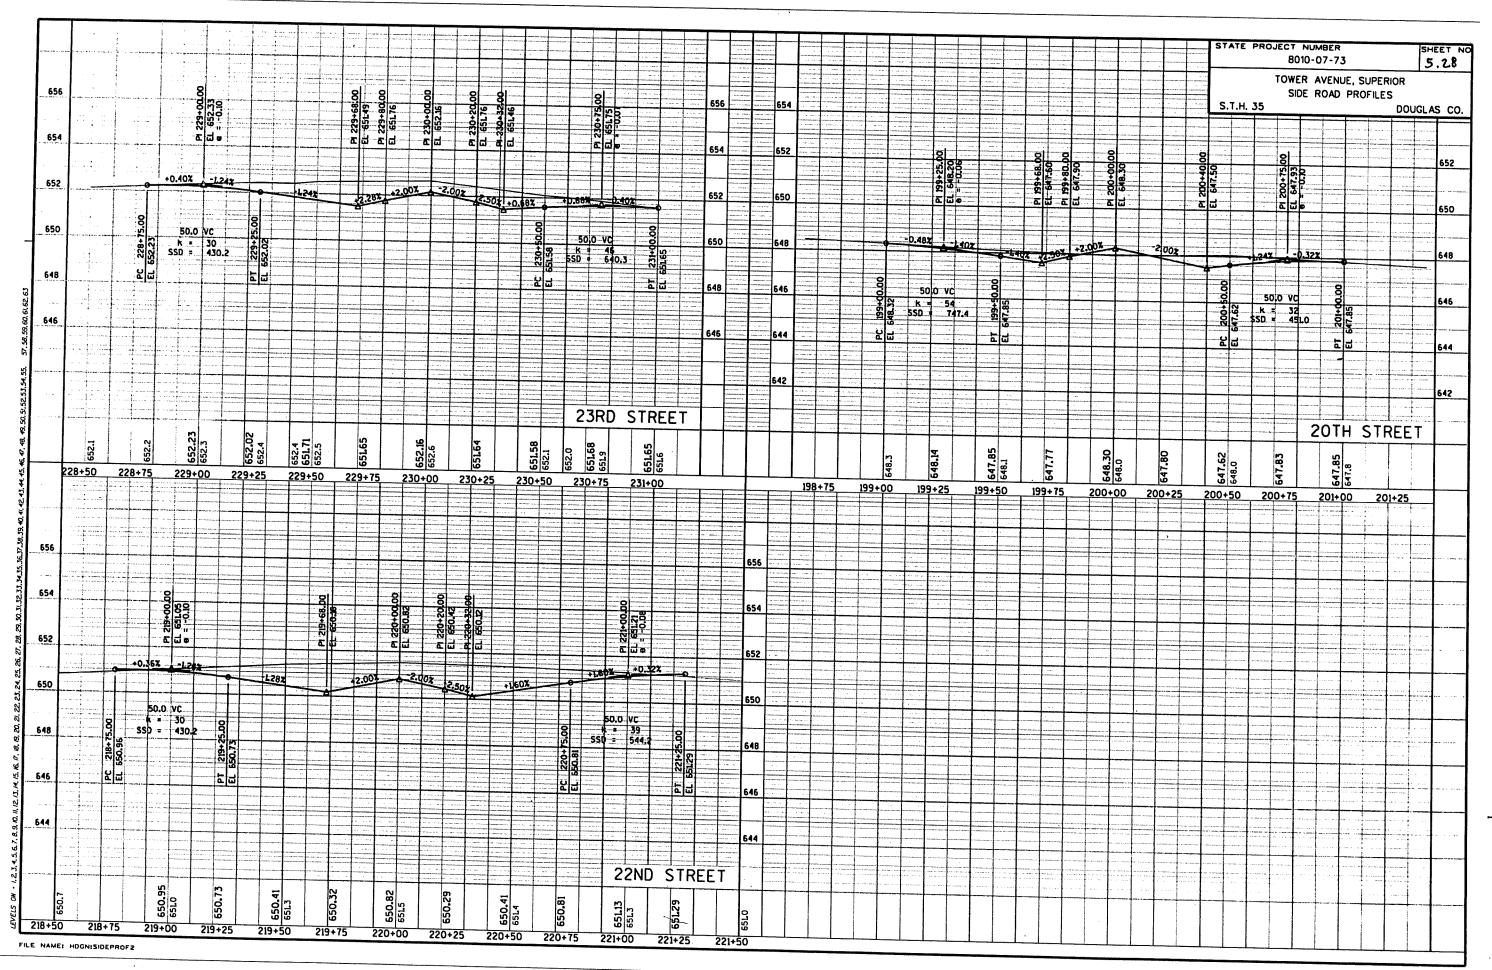

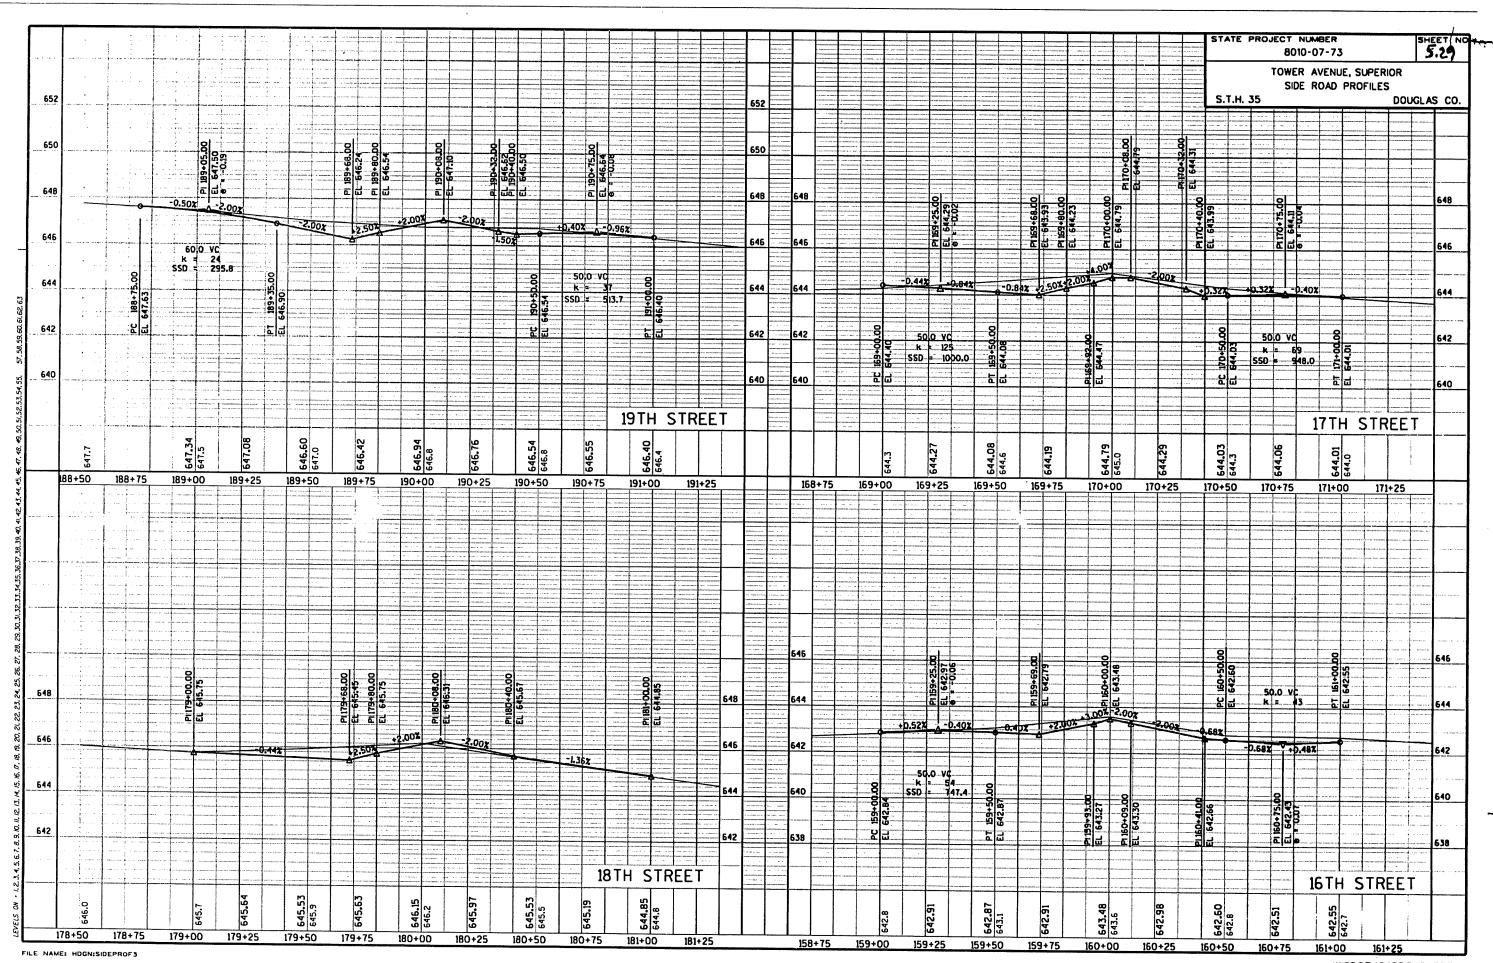

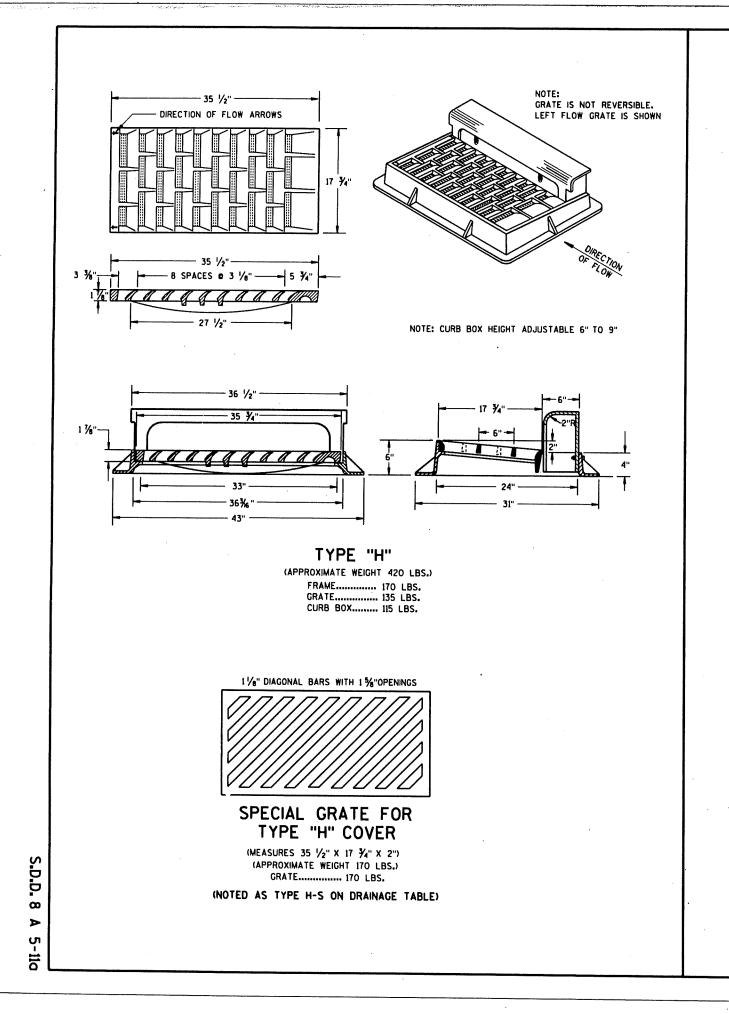


# GENERAL NOTES

DETAILS OF CONSTRUCTION, MATERIALS AND WORKMANSHIP NOT SHOWN ON THIS DRAWING SHALL CONFORM TO THE PERTINENT REQUIREMENTS OF THE STANDARD SPECIFICATIONS AND THE APPLICABLE SPECIAL PROVISIONS.

DETAIL DRAWINGS FOR PROPOSED ALTERNATE DESIGNS FOR CATCH BASIN, MANHOLE AND INLET COVERS SHALL BE SUBMITTED TO THE ENGINEER FOR APPROVAL PROVIDING THAT SUCH ALTERNATE DESIGNS MAKE PROVISION FOR EQUIVALENT CAPACITY AND STRENGTH.

ROUND FRAMES AND COVERS SHALL HAVE CONTINUOUSLY MACHINED BEARING SURFACES TO PREVENT ROCKING AND RATTLING.

THE ACTUAL WEIGHT OF COVERS MAY VARY WITHIN 5 PERCENT, PLUS OR MINUS, OF THE APPROXIMATE WEIGHT.

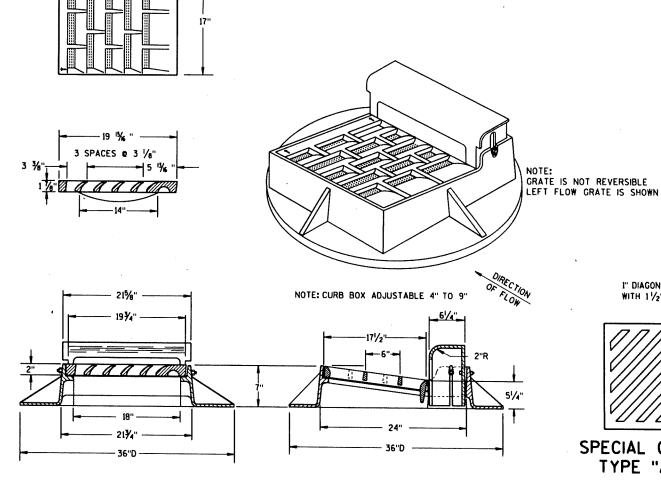


- DIRECTION OF FLOW ARROWS

TYPE "A"

(APPROXIMATE WEIGHT 355 LBS.)

FRAME..... 185 LBS. GRATE...... 85 LBS. CURB BOX..... 85 LBS.

1" DIAGONAL BARS WITH 1 1/2" OPENINGS

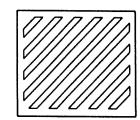

SPECIAL GRATE FOR TYPE "A" COVER

(MEASURES 19 1/4" X 11/4" X 1 1/4"

GRATE..... 85 LBS.


(NOTED AS TYPE A-S ON DRAINAGE TABLE)


INLET COVERS

STATE OF WISCONSIN DEPARTMENT OF TRANSPORTATION

APPROVED

Rous A. Thursday DESIGN ENGINEER 08/07/95 DATE

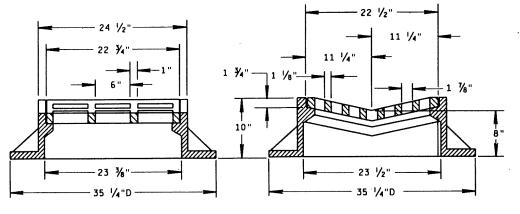


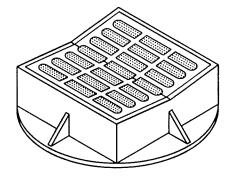

# TYPE "B"

(APPROXIMATE WEIGHT 395 LBS.)


FRAME..... 285 LBS. GRATE..... 110 LBS.

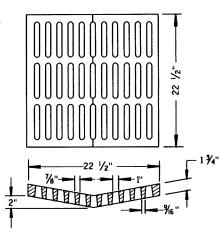


# ALTERNATIVE GRATE FOR FOR TYPE "B" COVER

(APPROXIMATE GRATE WEIGHT 125 LBS.) GRATE.....125 LBS. USE WHERE PEDESTRIAN OR BICYCLE TRAFFIC IS POSSIBLE.

NOTED AS TYPE B-A ON THE DRAINAGE TABLE

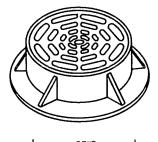

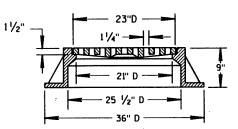


# TYPE "C"

(APPROXIMATE WEIGHT 340 LBS.)

FRAME..... 235 LBS. GRATE..... 105 LBS.


# 1" DIAGONAL BARS WITH

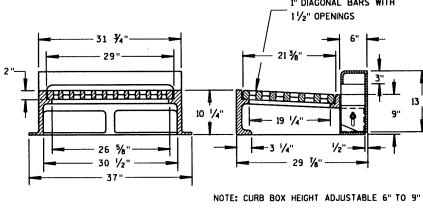

(APPROXIMATE WEIGHT 670 LBS.)

FRAME...... 360 LBS. GRATE..... 160 LBS. CURB BOX..... 150 LBS.



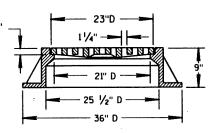

# ALTERNATIVE TYPE "MS"

(APPROXIMATE GRATE WEIGHT 365 LBS.)

GRATE......365 LBS.

USE WHERE PEDESTRIAN OR BICYCLE TRAFFIC IS PERMITTED NOTED AS TYPE MS-A ON THE DRAINAGE TABLE


# GENERAL NOTES

DETAILS OF CONSTRUCTION, MATERIALS AND WORKMANSHIP NOT SHOWN ON THIS DRAWING SHALL CONFORM TO THE PERTINENT REQUIREMENTS OF THE STANDARD SPECIFICATIONS AND THE APPLICABLE SPECIAL PROVISIONS.

DETAIL DRAWINGS FOR PROPOSED ALTERNATE DESIGNS FOR CATCH BASIN, MANHOLE AND INLET COVERS SHALL BE SUBMITTED TO THE ENGINEER FOR APPROVAL PROVIDING THAT SUCH ALTERNATE DESIGNS MAKE PROVISION FOR EQUIVALENT CAPACITY AND STRENGTH.

ROUND FRAMES AND COVERS SHALL HAVE CONTINUOUSLY MACHINED BEARING SURFACES TO PREVENT ROCKING AND RATTLING.


THE ACTUAL WEIGHT OF COVERS MAY VARY WITHIN 5 PERCENT, PLUS OR MINUS, OF THE APPROXIMATE WEIGHT.

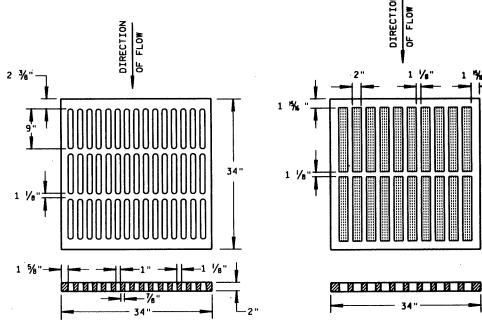


# TYPE "MS"

(APPROXIMATE GRATE WEIGHT 270 LBS.) GRATE.....270 LBS.

USE ON FREEWAYS AND EXPRESSWAYS NOTED AS TYPE MS ON DRAWAGE TABLE

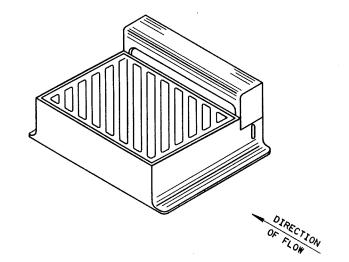

DIAGONAL SLOTS, SHALL BE ORIENTED TO THE DIRECTION OF FLOW AS ILLUSTRATED. GRATES ARE MANUFACTURED TO BE REVERSIBLE.

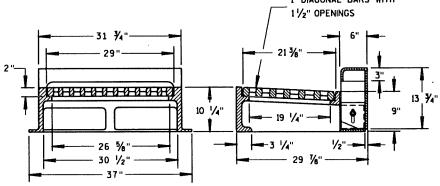


#### TYPE "WM"

INLET COVERS


STATE OF WISCONSIN DEPARTMENT OF TRANSPORTATION


S.D.D. 8 A 5-11b

S.D.D.  $\infty$ 5-115

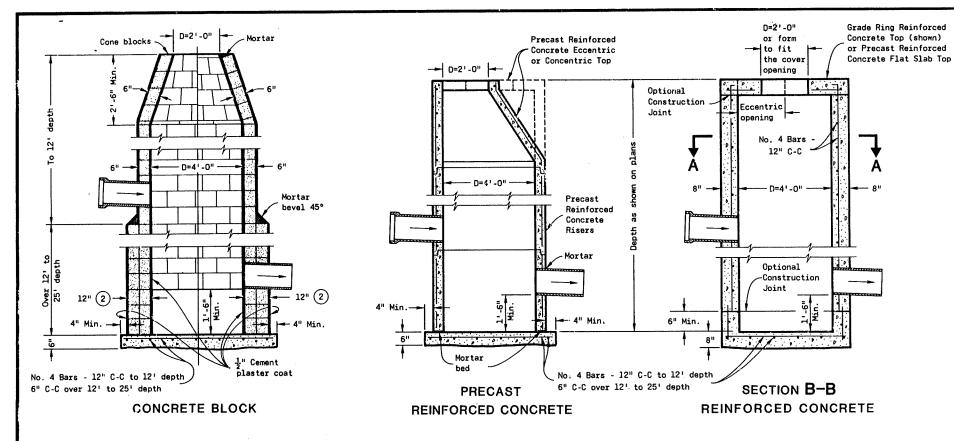

#### **CATCH BASINS TYPE 1**

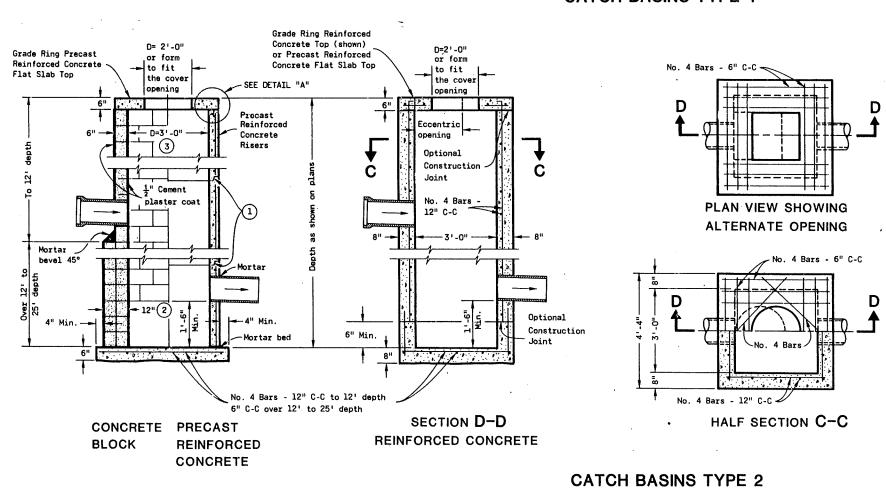

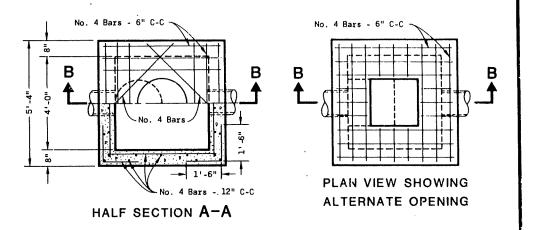

## **GENERAL NOTES**

Details of construction, materials and workmanship not shown on this drawing shall conform to the pertinent requirements of the Standard Specifications and the applicable Special Provisions.

Detailed drawings for proposed alternate designs for underground drainage structures shall be submitted to the Engineer for approval providing that such alternate designs make provision for equivalent capacity and strength.

All drainage structures are designated on the plans as "Manholes 1-C", "Catch Basins 1-D", "Inlets 3-H", etc. The first digit designates the masonry portion of the structure, and the following letter designates the type of cover to be used to comprise the complete unit.

Precast Reinforced Bases shall be placed on a bed of material at least 6 inches in depth, which meets the requirements of Granular Backfill. This bedding shall be compacted and provide uniform support for the entire area of the base.

Precast Reinforced Concrete Cone Tops (Eccentric or Concentric) or Precast Reinforced Concrete flat Slab Tops may be used on concrete block structures. The Cone Tops shall be installed on a bed of mortar.


Eccentric Cone Tops may be used on all structures, and Concentric Cone Tops shall be used only on structures 5 feet or less in depth, unless otherwise directed by the Engineer.

Steps meeting the following requirements shall be installed in all structures over 5 feet in depth: 16 inch C-C maximum spacing; project a minimum clear distance of 4 inches from the wall at the point of embedment; minimum length of 10 inches, minimum wall embedment of 3 inches; and be capable of supporting a concentrated load of 300 lbs. Ferrous metal steps not painted or treated to resist corrosion shall have a minimum cross sectional dimension of 1 inch.

Solid Aluminum steps shall have a minimum cross sectional dimension of 0.75 inch. Aluminum surfaces to be embedded in concrete shall be given one coat of suitable quality paint, such as zinc chromate primer conforming to federal specification TT-P-645 or equivalent. Steps of approved Polypropylene plastic coated reinforcement bar are acceptable.

All bar steel reinforcement shall be embedded 2 inches clear unless otherwise shown or noted.

- All Precast Inlet Units shall conform to the pertinent requirements of AASHTO Designation M 199.
- 1 Precast Reinforced Concrete Risers shall be placed with the tongue down when grade rings are used for the slab top.
- 2 courses 6" block.
- When the connecting pipes are 24" or larger the Precast Catch Basin may be increased to 42" dia.

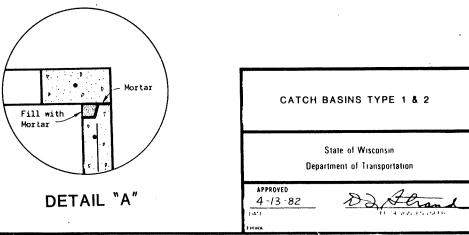


S.D.D. 8 A 6-3

Ö


D.

 $\infty$ 


 $\triangleright$ 

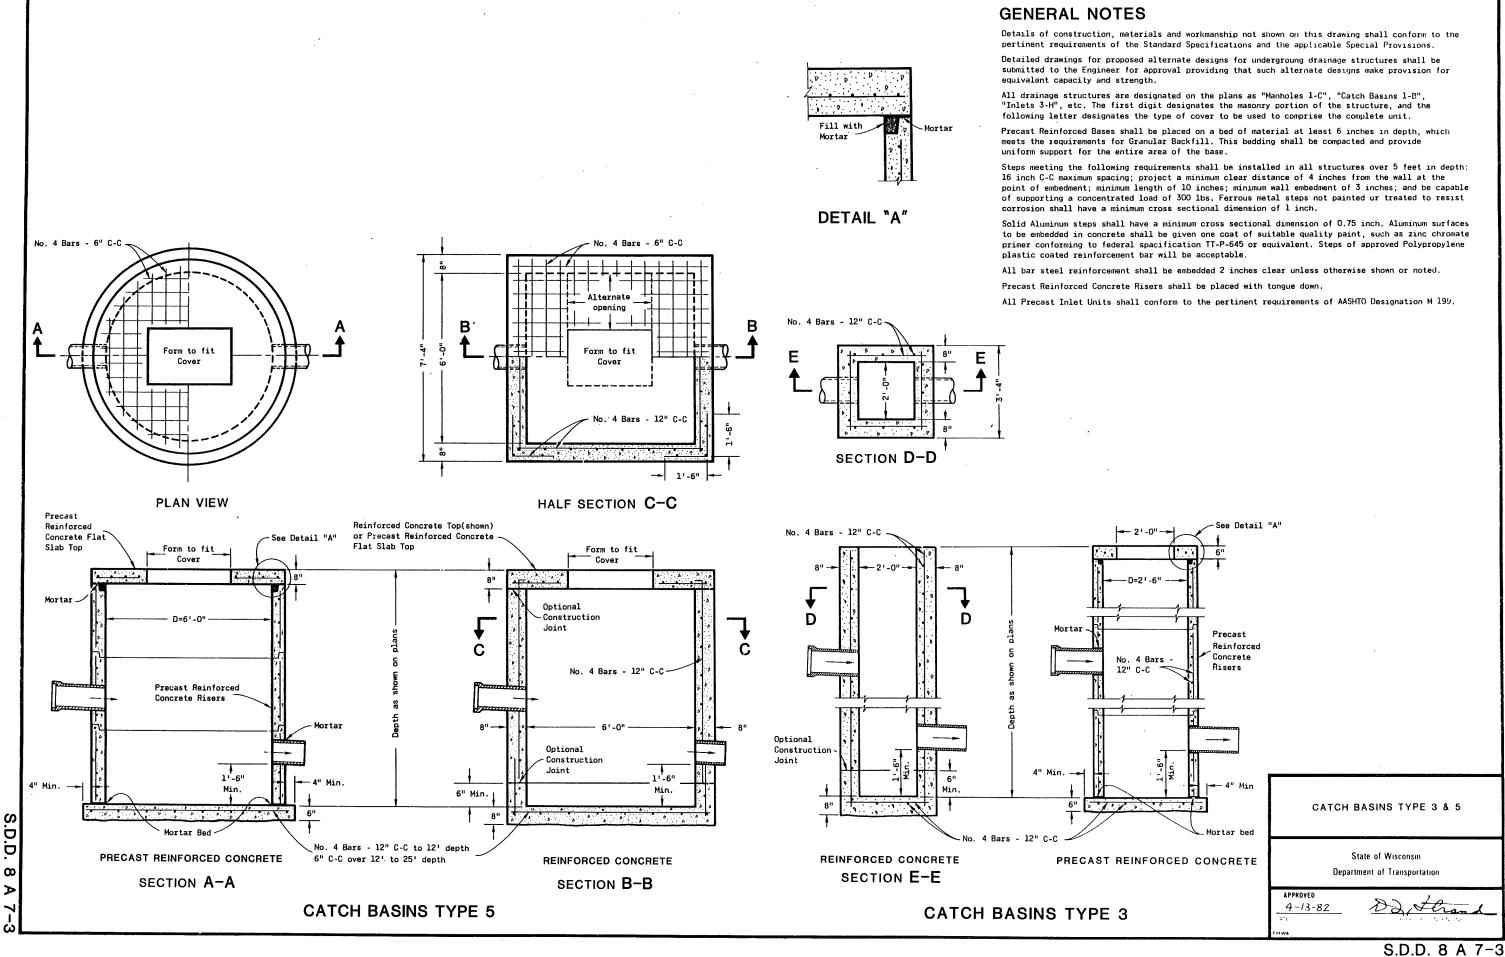


### HALF SECTION A-A

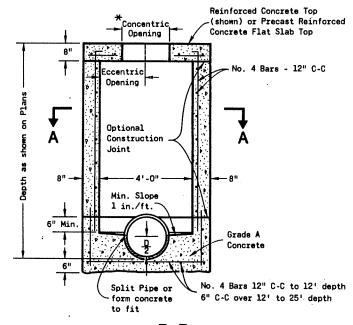

SECTION B-B
REINFORCED CONCRETE

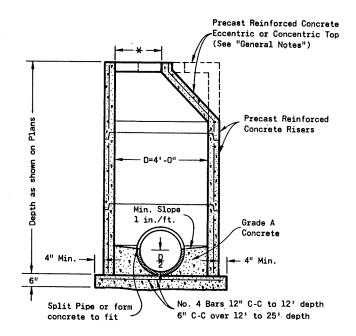

#### PRECAST REINFORCED CONCRETE

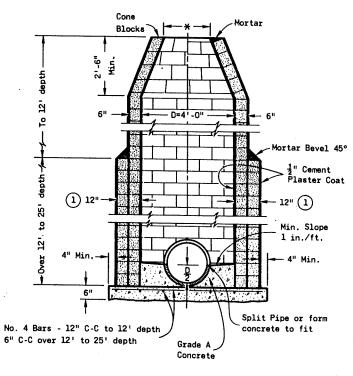

**CONCRETE BLOCK** 

MANHOLES TYPE 1

# **GENERAL NOTES**

Details of construction, materials and workmanship not shown on this drawing shall conform to the pertinent requirements of the Standard Specifications and the applicable Special Provisions.

Detailed drawings for proposed alternate designs for underground drainage structures shall be submitted to the Engineer for approval providing that such alternate designs make provision for equivalent capacity and strength,

All drainage structures are designated on the plans as "Manholes 1-C", "Catch Basins 1-B", "Inlets 3-H", etc. The first digit designates the masonry portion of the structure, and the following letter designates the type of cover to be used to comprise the complete unit,

Precast Reinforced Bases shall be placed on a bed of material at least 6 inches in depth, which meets the requirements for Granular Backfill. This bedding shall be compacted and provide uniform support for the entire area of the base.

Precast Reinforced Concrete Cone Tops (Eccentric or Concentric) may be used on concrete block structures. The Cone Tops shall be installed on a bed of mortar.

Eccentric Cone Tops may be used on all structures, and Concentric Cone Tops shall be used only on structures 5 feet or less in depth, unless otherwise directed by the Engineer.

Steps meeting the following requirements shall be installed in all structures over 5 feet in depth: 16 inch C-C maximum spacing; project a minimum clear distance of 4 inches from the wall at the point of embedment; minimum length of 10 inches; minimum wall embedment of 3 inches; and be capable of supporting a concentrated load of 300 lbs. Ferrous metal steps not painted or treated to resist corrosion shall have a minimum cross sectional dimension of 1 inch.

Solid Aluminum steps shall have a minimum cross sectional dimension of 0.75 inch. Aluminum surfaces to be embedded in concrete shall be given one coat of suitable quality paint, such as zinc chromate primer conforming to Federal Specification TT-P-645 or equivalent. Steps of approved Polyproplene plastic coated reinforcement bar will be acceptable.

All bar steel reinforcement shall be embedded 2 inches clear unless otherwise shown or noted.

Precast Reinforced Concrete Risers may be placed with tongue up or down.

All Precast Inlet Units shall conform to the pertinent requirements of AASHTO Designation M 199.

- \* Use 2'-0" diameter opening with Type "C", "L" and "J" covers, or 3'-0" diameter with Type "K" and "M" covers.
- 1) 2 courses 6" block.


MANHOLES TYPE 1

State of Wisconsin
Department of Transportation

4-13-82

Da Flrand

DETAIL "A"

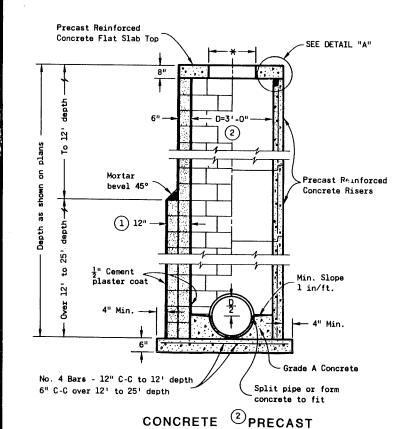


**BLOCK** 


REINFORCED

CONCRETE

MANHOLES TYPE 2

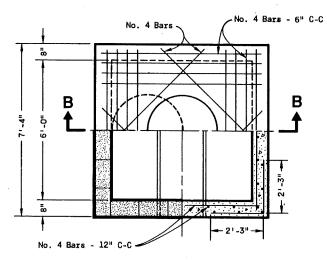

HALF SECTION A-A

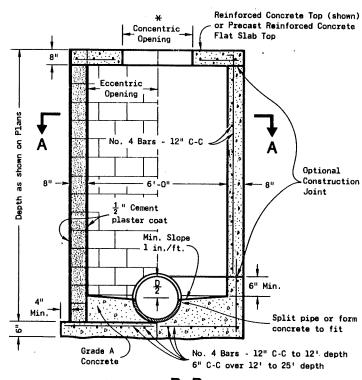

SECTION B-B

CONCRETE REINFORCED
BLOCK CONCRETE

**GENERAL NOTES** 

Details of construction, materials and workmanship not shown on this drawing shall conform to the pertinent requirements of the Standard Specifications and the applicable Special Provisions.

Detailed drawings for proposed alternate designs for underground drainage structures shall be submitted to the Engineer for approval providing that such alternate designs make provision for equivalent capacity and strength

All drainage structures are designated on the plans as "Manholes 1-C", "Catch Basins 1-B", "Inlets 3-H", etc. The first digit designates the masonry portion of the structure, and the following letter designates the type of cover to be used to comprise the complete unit.

Precast Reinforced Bases shall be placed on a bed of material at least 6" in depth, which meets the requirements for Granular Backfill. This bedding shall be compacted and provide uniform support for the entire area of the base.

Steps meeting the following requirements shall be installed in all structures over 5 feet in depth: 16 inch C-C maximum spacing; project a minimum clear distance of 4 inches from the wall at the point of embedment; minimum length of 10 inches; minimum wall embedment of 3 inches; and capable of supporting a concentrated load of 300 lbs. Ferrous metal steps not painted or treated to resist corrosion shall have a minimum cross sectional dimension of 1 inch.


Solid Aluminum steps shall have a minimum cross sectional dimension of 0.75 inch. Aluminum surfaces to be embedded in concrete shall be given one coat of suitable quality paint, such as zinc chromate primer conforming to federal specification TT-P-645 or equivalent. Steps of approved Polypropylene plastic coated reinforcement bar are acceptable.

All bar steel reinforcement shall be embedded 2 inches clear unless otherwise shown or noted.

Precast Reinforced Concrete Risers shall be placed with tongue down.

All precast inlet units shall conform to the pertinent requirements of AASHTO Designation M 199.

- \* Use 2'-0" diameter opening with type "C", "L", and "J" covers, or 3'-0" diameter with type "K" and "M" covers.
- 1) 2 courses 6" block.
- (2) When connecting pipes are 24" or larger the Precast Manholes may be increased to 42" diameter.

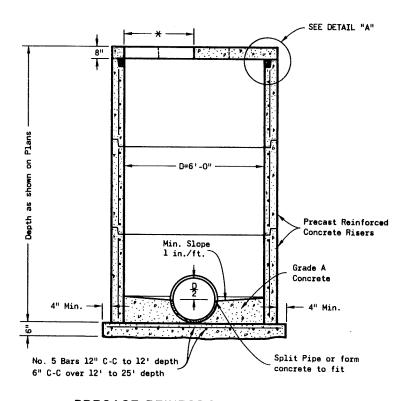

PRECAST REINFORCED CONCRETE


State of Wisconsin
Department of Transportation


MANHOLES TYPE 2 & 3


4-13-82


CHIEF DESIGN ENGINEER

MANHOLES TYPE 3

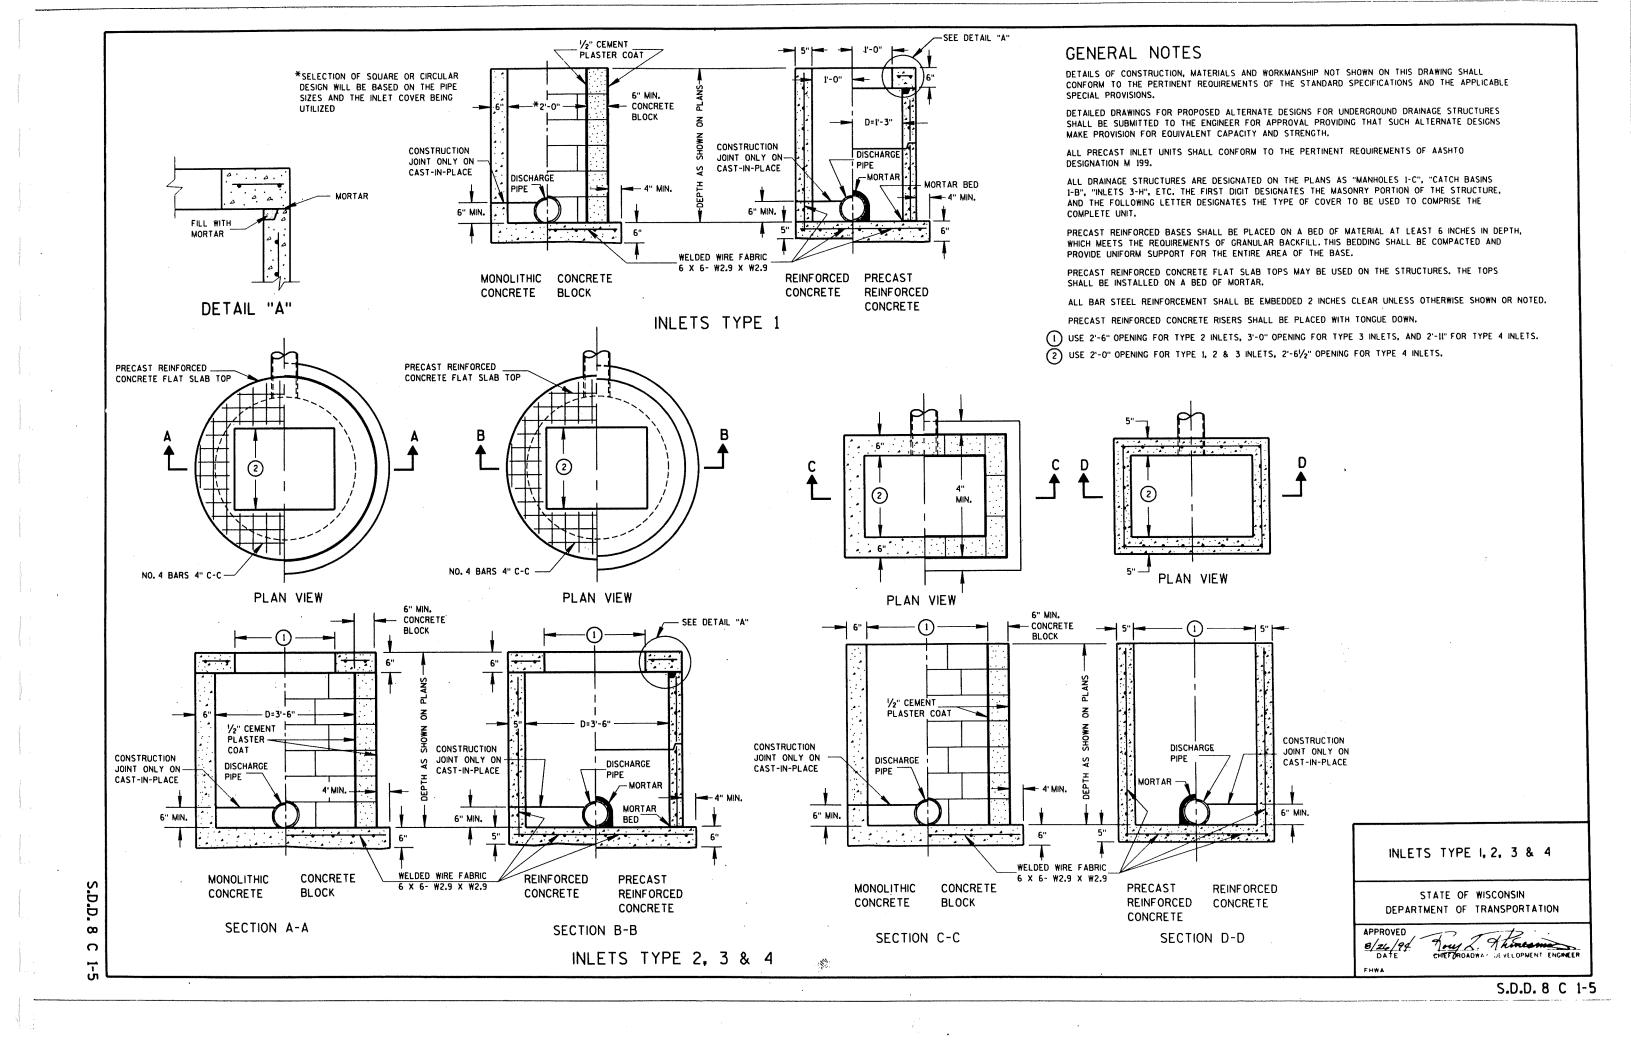

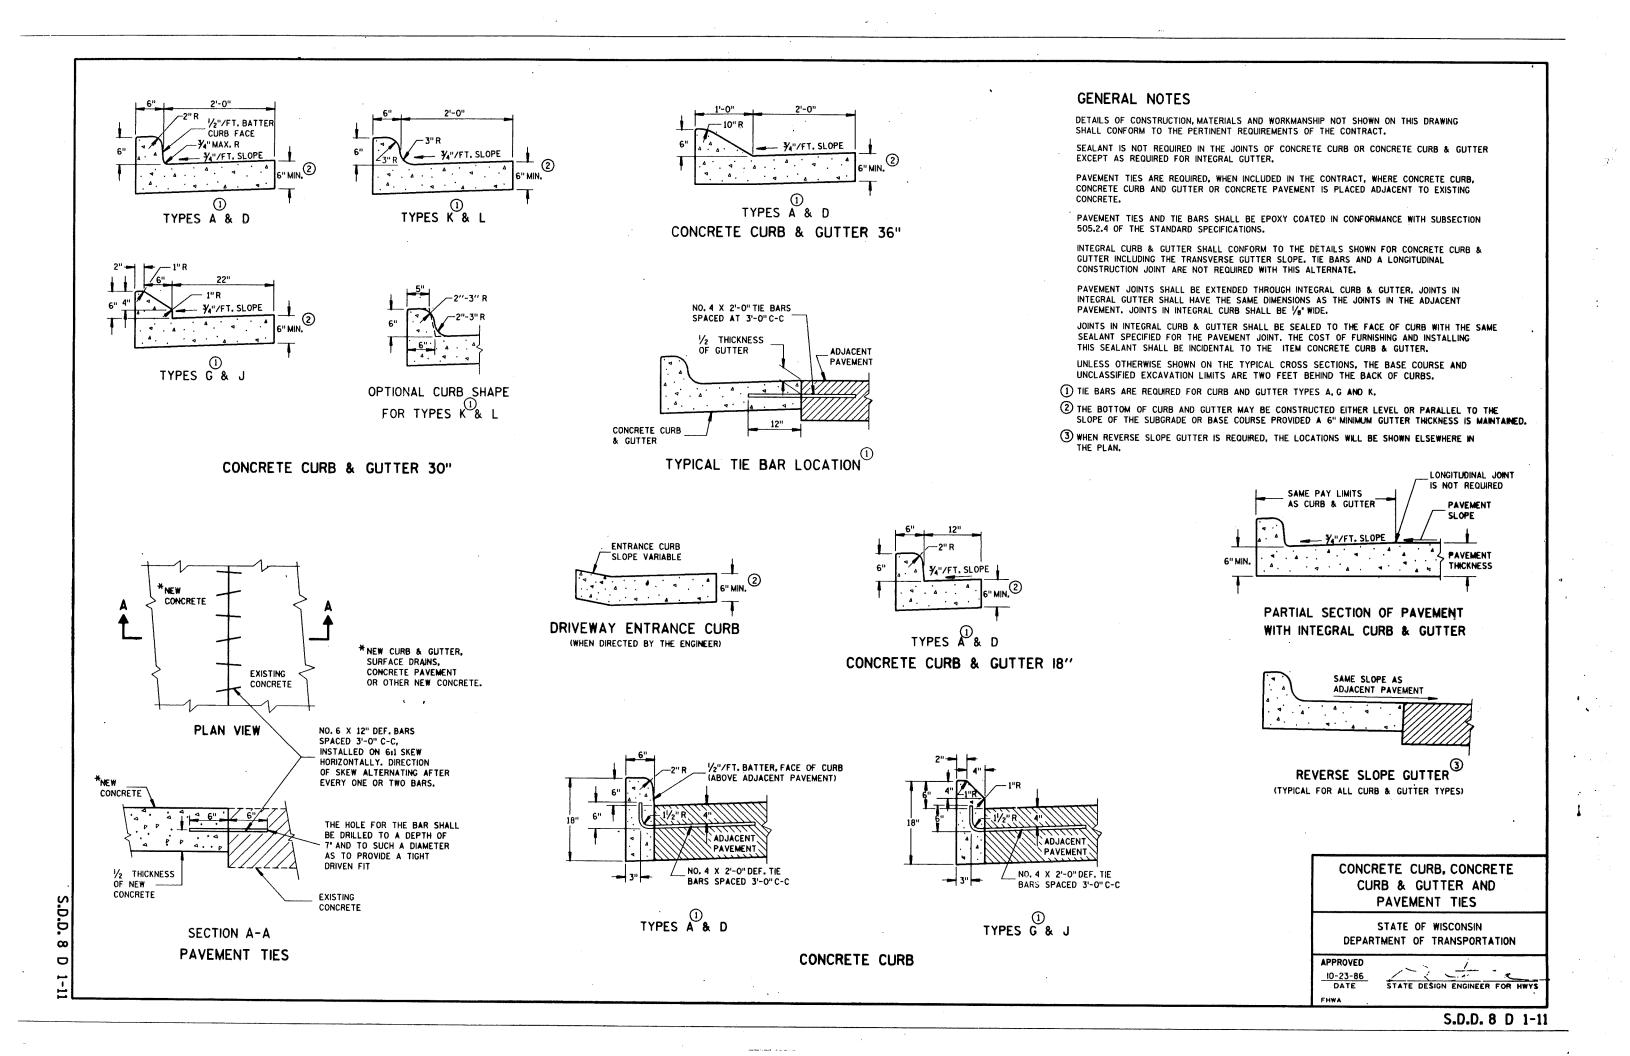

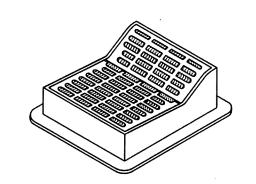

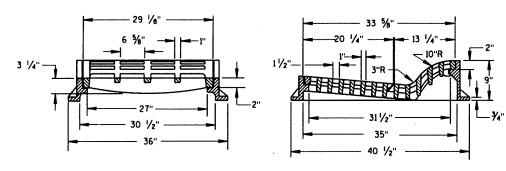



# TYPE "F"

(APPROXIMATE WEIGHT 645 LBS.)

FRAME..... ....300 LBS. GRATE...... 180 LBS.

USE WITH CONCRETE CURB & GUTTER, 36 INCH.

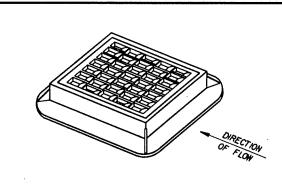


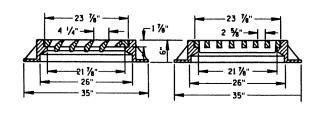

# TYPE "S"

(APPROXIMATE WEIGHT 400 LBS.)

FRAME...... 245 LBS. GRATE..... 155 LBS.

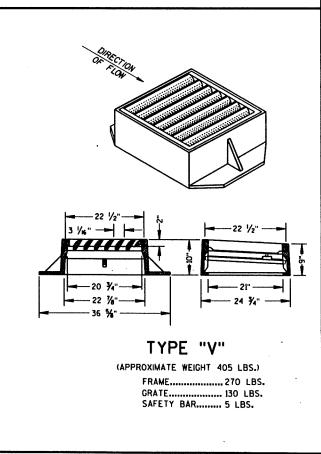


# GENERAL NOTES

DETAILS OF CONSTRUCTION, MATERIALS AND WORKMANSHIP NOT SHOWN ON THIS DRAWING SHALL CONFORM TO THE PERTINENT REQUIREMENTS OF THE STANDARD SPECIFICATIONS AND THE APPLICABLE SPECIAL PROVISIONS.

DETAIL DRAWINGS FOR PROPOSED ALTERNATE DESIGNS FOR INLET COVERS SHALL BE SUBMITTED TO THE ENGINEER FOR APPROVAL PROVIDING THAT SUCH ALTERNATE DESIGNS MAKE PROVISION FOR EQUIVALENT CAPACITY AND STRENGTH.


THE ACTUAL WEIGHT OF COVERS MAY VARY WITHIN 5 PERCENT, PLUS OR MINUS, OF THE APPROXIMATE WEIGHT.

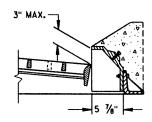

# ALTERNATIVE CURB BOX FOR TYPE "HM" COVER

(APPROXIMATE WEIGHT 60 LBS.) CURB BOX......60 LBS.

USE WITH TYPES G & J CONCRETE CURB & GUTTER, 30 INCH NOTED AS TYPE HM-GJ ON DRAINAGE TABLE

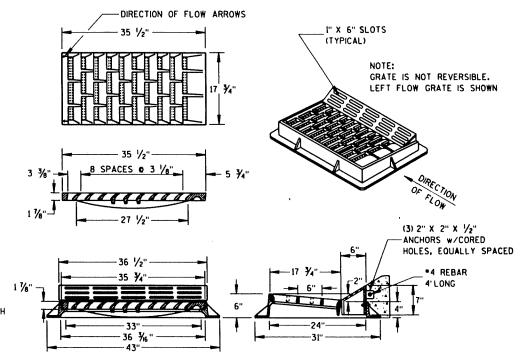

# TYPE "HM"

(APPROXIMATE WEIGHT 395 LBS.) FRAME......170 LBS. GRATE...... 135 LBS. CURB BOX..... 90 LBS.

SPECIAL GRATE FOR THE TYPE "H" COVER MAY ALSO BE USED FOR THE TYPE "HM" COVER NOTED AS TYPE HM-S ON DRAINAGE TABLE

USE WITH CONCRETE CURB & GUTTER, 36 INCH.

INLET COVERS

STATE OF WISCONSIN DEPARTMENT OF TRANSPORTATION


APPROVED


OB/O7/95

Tony 2. Thursday

DATE

CHIEF ROADWAY DESIGN ENGINEER

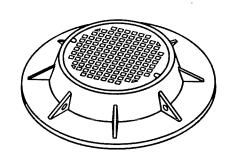


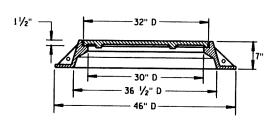

#### TYPE "K"

(APPROXIMATE WEIGHT 535 LBS.)


FRAME......330 LBS. LID......205 LBS.

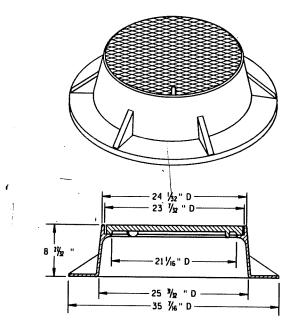

TYPE "J"

(APPROXIMATE WEIGHT 255 LBS.)
FRAME.......140 LBS.
LID......115 LBS.




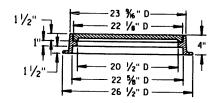


# TYPE "L"

(APPROXIMATE WEIGHT 145 LBS.)

FRAME......75\* LID.....70\*

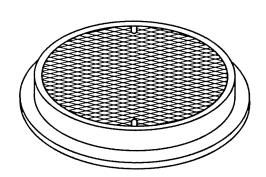

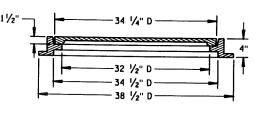

#### TYPE "M"

(APPROXIMATE WEIGHT 385 LBS.)

FRAME...... 125\* LID...... 260\*


#### GENERAL NOTES

DETAILS OF CONSTRUCTION, MATERIALS AND WORKMANSHIP NOT SHOWN ON THIS DRAWING SHALL CONFORM TO THE PERTINENT REQUIREMENTS OF THE STANDARD SPECIFICATIONS AND THE APPLICABLE SPECIAL PROVISIONS.


DETAIL DRAWINGS FOR PROPOSED ALTERNATE DESIGNS FOR MANHOLE COVERS SHALL BE SUBMITTED TO THE ENGINEER FOR APPROVAL PROVIDING THAT SUCH ALTERNATE DESIGNS MAKE PROVISION FOR EQUIVALENT CAPACITY AND STRENGTH.


ROUND FRAMES AND COVERS SHALL HAVE CONTINUOUSLY MACHINED BEARING SURFACES TO PREVENT ROCKING AND RATTLING.

THE ACTUAL WEIGHT OF COVERS MAY VARY WITHIN 5 PERCENT, PLUS OR MINUS, OF THE APPROXIMATE WEIGHT.

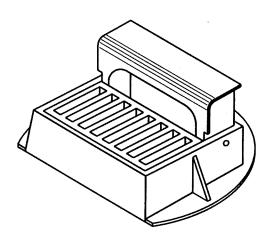

CURB BOX ADJUSTABLE 4" TO 10"

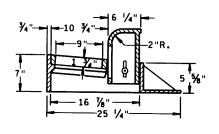

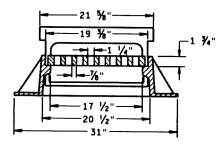

# INLET COVER TYPE "Z"

(APPROXIMATE WEIGHT 280 LBS.)


INLET AND MANHOLE COVERS


STATE OF WISCONSIN
DEPARTMENT OF TRANSPORTATION


APPROVED

DATE CHIEF ROADWAY DESIGN ENGIN


FHWA

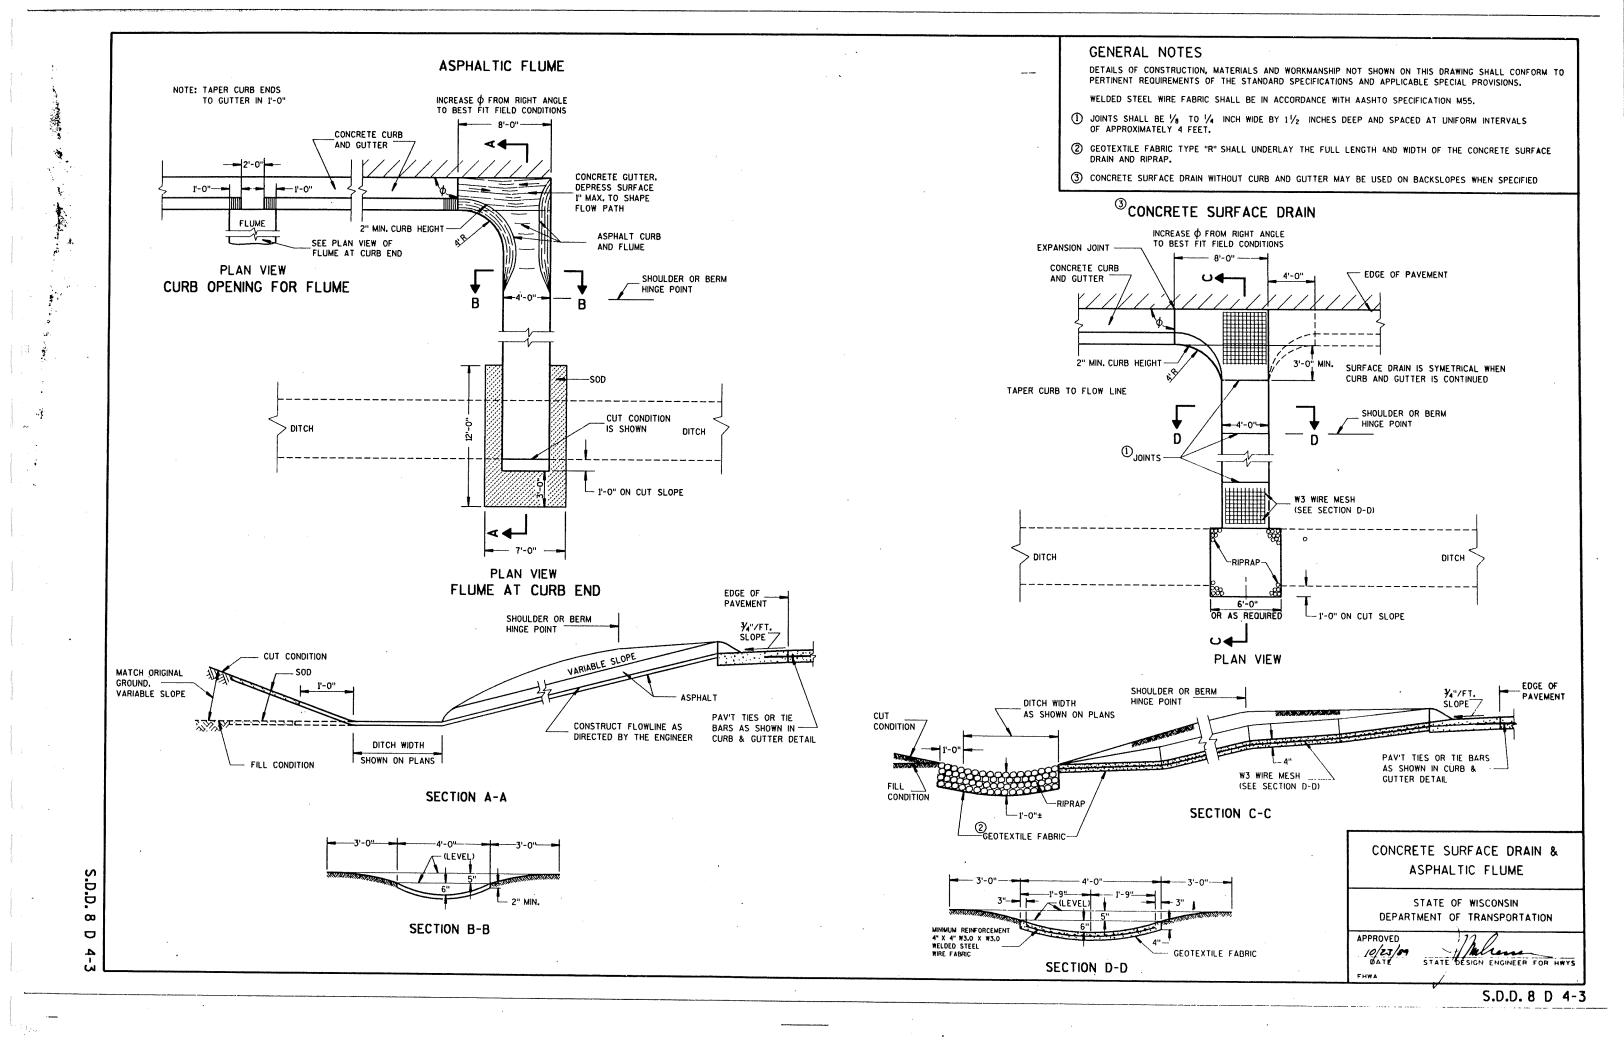

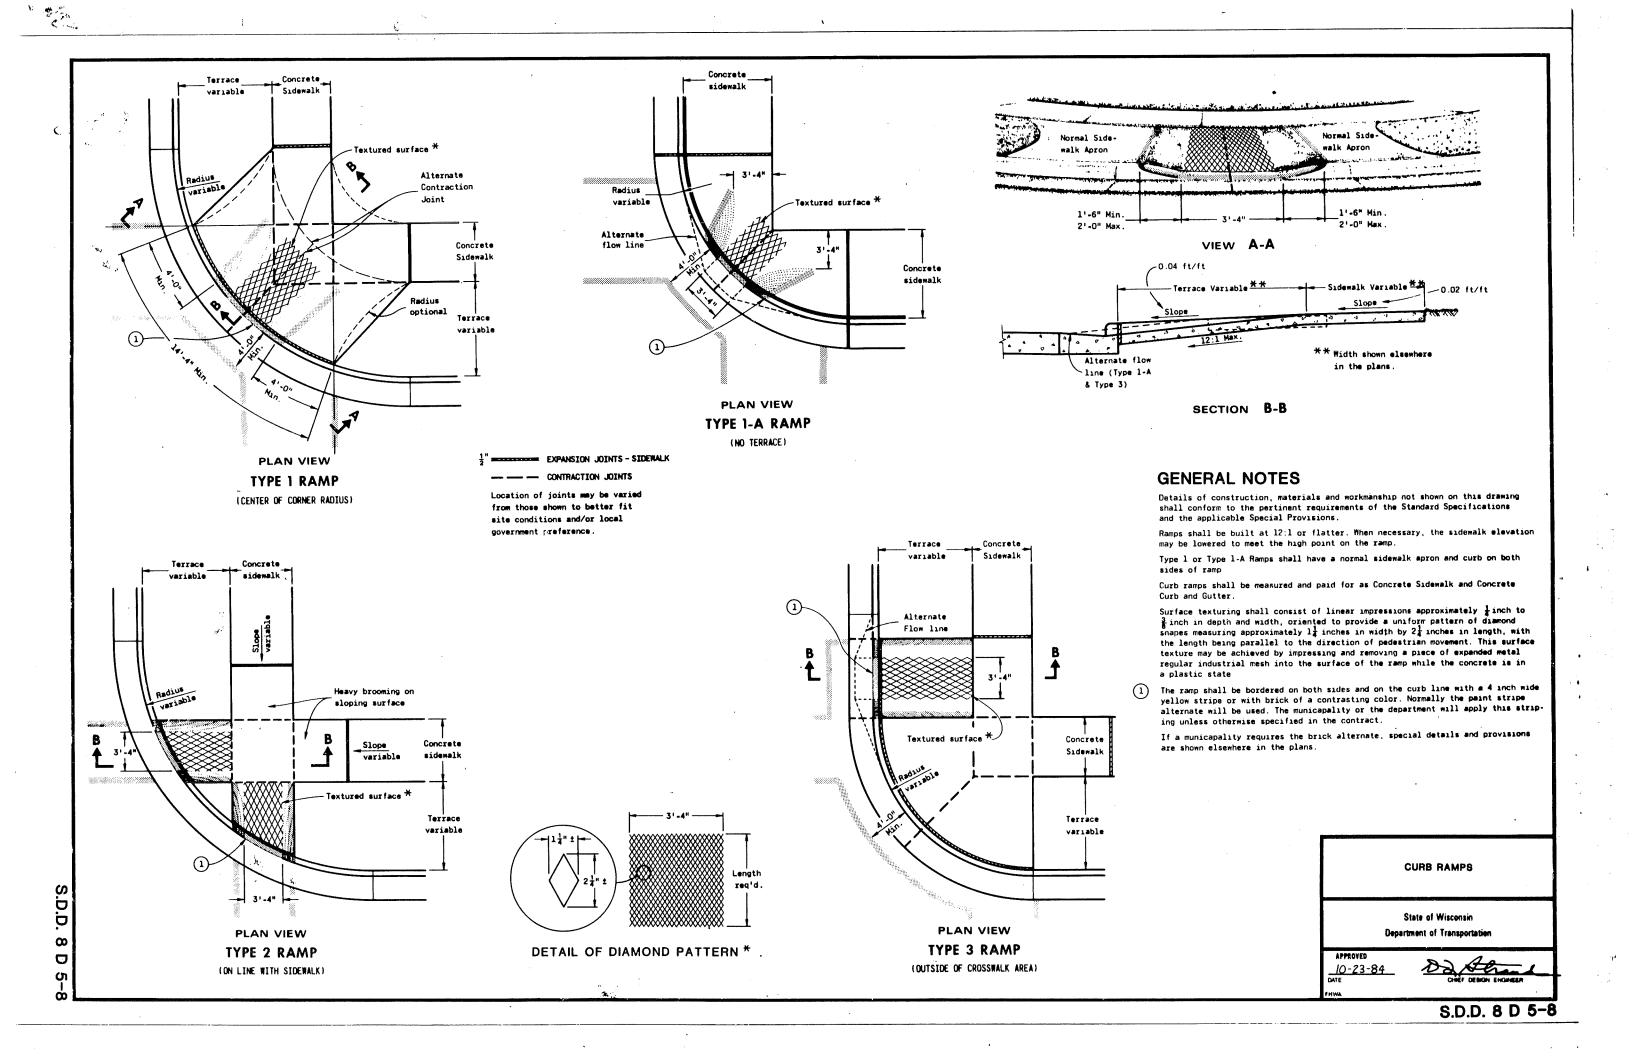

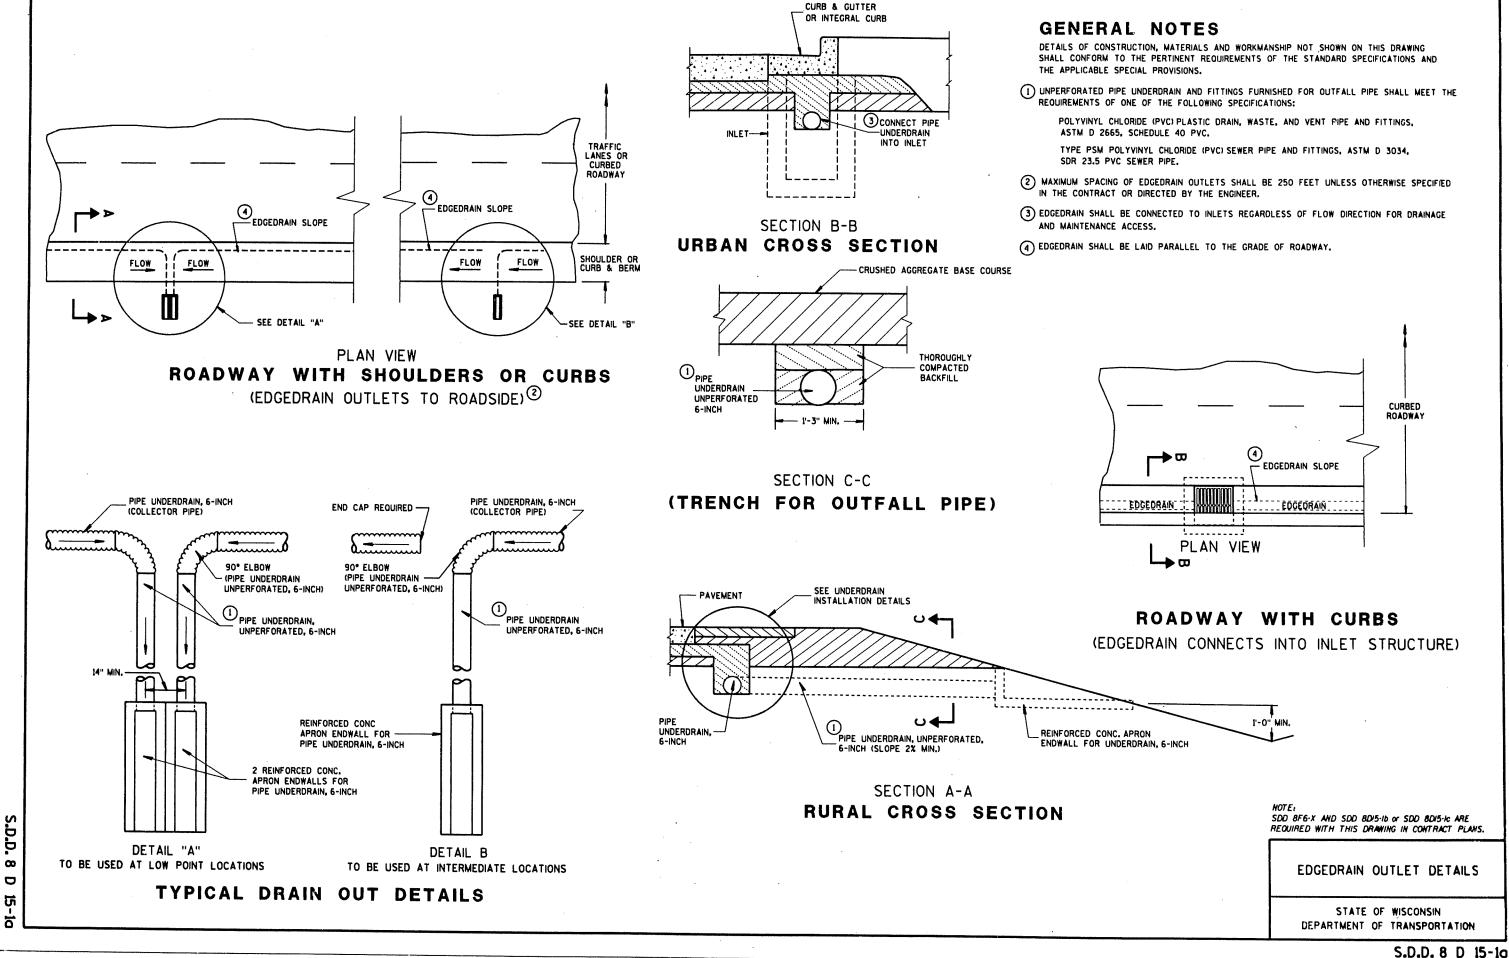

ᅜ

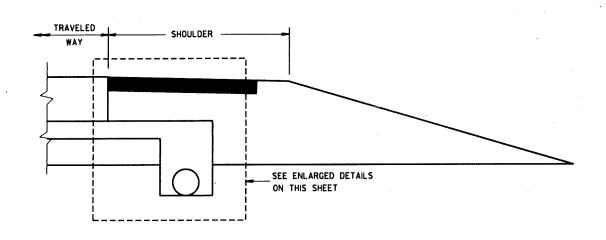

**RURAL CROSS SECTION** 

S.D.D. 8

D

15-1b


#### NOTES

....


THE DIMENSIONS SHOWN ON THE TYPICAL CROSS SECTIONS WILL GOVERN IN THE EVENT THERE IS A CONFLICT WITH THE DETAILS SHOWN ON THIS DRAWING.

PIPE UNDERDRAIN SHALL BE LAID PARALLEL TO THE GRADE OF THE ROADWAY.

- ① THE GRADATION OF THE OPEN GRADED BASE COURSE SHALL BE EITHER NO. 1 OR NO. 2 AS SPECIFIED ELSEWHERE IN THE CONTRACT.
- 2 TRENCH BACKFILL WILL BE PAID FOR AS CRUSHED AGGREGATE BASE COURSE, OPEN GRADED NO. 1 OR NO. 2 AS SPECIFIED.

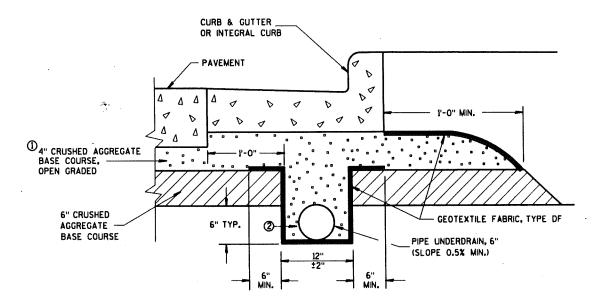

# **EDGEDRAIN IN URBAN ROADWAY**

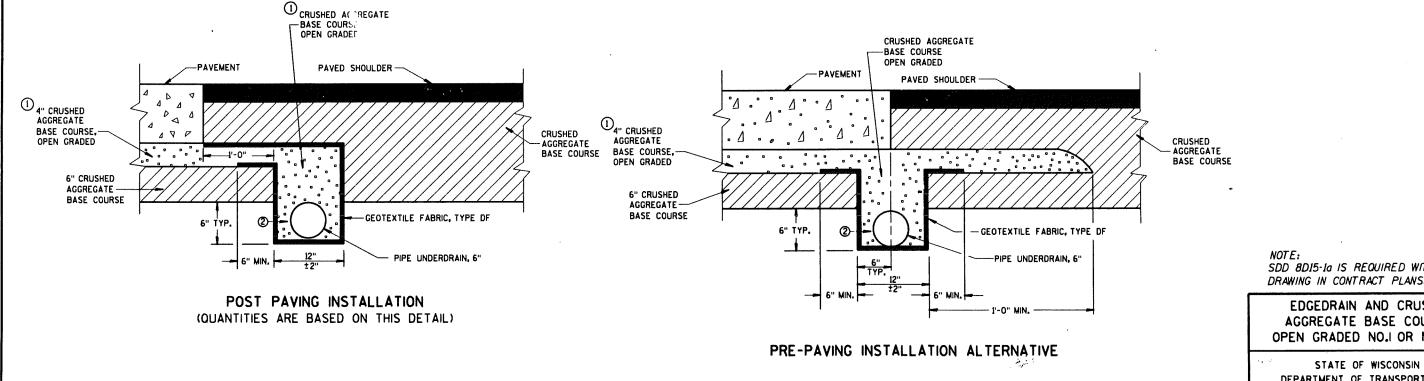

**EDGEDRAIN IN RURAL ROADWAY** 

SDD 8D15-10 IS REQUIRED WITH THIS DRAWING IN CONTRACT PLANS.

EDGEDRAIN AND CRUSHED AGGREGATE BASE COURSE, OPEN GRADED NO.1 OR NO. 2


DEPARTMENT OF TRANSPORTATION


APPROVED

12/1/93 Tory A. Thurstone

DATE CHEEN METHODS DEVELOPMENT ENGINEER


S.D.D. 8 D 15-1b

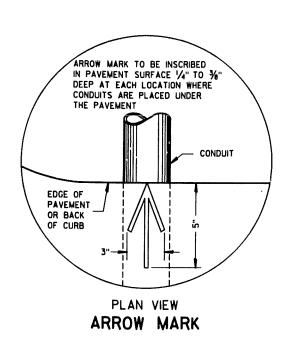

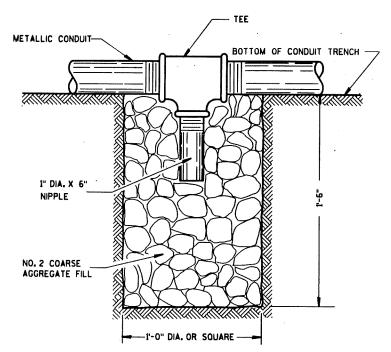

NOTE: INSTALL AT LOCATIONS WHERE METALLIC CONDUITS CANNOT BE PITCHED TO DRAIN INTO A PULL BOX.

# DRAIN SUMP FOR CONDUIT

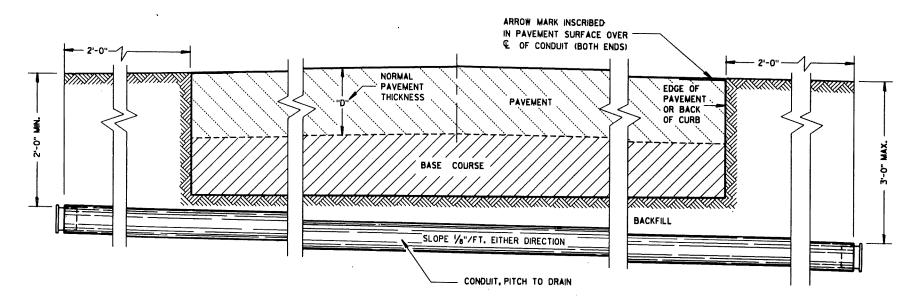

SIDE ELEVATION

DETAIL FOR CONDUIT UNDER PAVED HIGHWAYS

# GENERAL NOTES

DETAILS OF CONSTRUCTION, MATERIALS AND WORKMANSHIP NOT SHOWN ON THIS DRAWING SHALL CONFORM TO THE PERTINENT REQUIREMENTS OF THE CONTRACT.

METALLIC (STANDARD SPECIFICATION 613.2.2) OR NONMETALLIC (STANDARD SPECIFICATION 613.2.3) CONDUIT SHALL BE FURNISHED AND PLACED AS SHOWN.

DEPTH OF CONDUIT INSTALLED BELOW THE TRAVELED WAY SHALL BE 24 INCHES MINIMUM AND 36 INCHES MAXIMUM.

DEPTH OF CONDUIT INSTALLED THAT IS NOT BELOW THE TRAVELED WAY SHALL BE 18 INCHES MINIMUM AND 36 INCHES MAXIMUM.

ANY EXCEPTION TO THE MAXIMUM DEPTH SHALL BE ONLY WITH THE WRITTEN APPROVAL OF THE ENGINEER.

THE TRENCH SHALL NOT BE BACKFILLED PRIOR TO INSPECTION OF THE CONDUIT.

ALL METALLIC CONDUIT RACEWAY ENDS SHALL BE REAMED AND THREADED.

ALL METALLIC CONDUIT IN WHICH WIRE OR CABLE IS TO BE INSTALLED SHALL BE BUSHED WITH APPROVED THREADED BUSHINGS BEFORE INSTALLATION OF THE WIRE OR CABLE.

ALL METALLIC CONDUITS IN WHICH WIRE OR CABLE IS NOT TO BE INSTALLED SHALL BE CAPPED WITH THREADED PROTECTIVE CAPS, AS APPROVED BY THE ENGINEER.

ALL NONMETALLIC CONDUIT SHALL BE CAPPED OR PLUGGED IMMEDIATELY AFTER INSTALLATION.

NONMETALLIC CONDUITS IN WHICH WIRE OR CABLE IS NOT BEING INSTALLED SHALL REMAIN CAPPED OR PLUGGED.

WHEN REQUIRED TO CONNECT NONMETALLIC CONDUIT TO METALLIC CONDUIT, ONLY U.L.LISTED ADAPTER FITTINGS SHALL BE USED.

PRIOR TO CONDUIT ACCEPTANCE, CONDUIT CAPS OR PLUGS SHALL BE REMOVED, AND THE CAPS, PLUGS AND CONDUIT ENDS SHALL BE THOROUGHLY CLEANED AND THEN THE CAPS OR PLUGS REMSTALLED TO ENSURE THAT THE CAPS OR PLUGS CAN BE EASILY REMOVED IN THE FUTURE.

ALL CONDUIT BEING FURNISHED AND INSTALLED SHALL HAVE THE U.L. LABEL FIRMLY ATTACHED.

CONDUIT RUNS SHALL BE THE SAME SIZE PIPE FROM ONE END TO THE OTHER (FROM PULL BOX TO PULL BOX-OR-JUNCTION BOX TO JUNCTION BOX).

A \*12 GAUGE, GALVANIZED PULL WIRE SHALL BE INSTALLED IN EACH RUN OF CONDUIT THAT DOES NOT RECEIVE CABLE OR WIRE UNDER THIS CONTRACT. THE PULL WIRE SHALL BE DOUBLED BACK 2 FEET AT EACH END CAP OF THE CONDUIT RUN.

BENDING OF PYC SHALL BE ACCOMPLISHED BY USING A BLANKET OR EMERSION TYPE TANK DESIGNED FOR THE PURPOSE OF BENDING PYC ELECTRICAL CONDUIT.

ALL CONDUIT RUNS SHALL BE STRAIGHT (WITHOUT BENDS) FROM PULL BOX TO PULL BOX, PULL BOX TO BASE AND BASE TO BASE AS SHOWN ON THE PLANS UNLESS OTHERWISE APPROVED BY THE PROJECT ENGINEER.

ALL CUT ENDS SHALL BE TRIMMED INSIDE AND OUTSIDE TO REMOVE ALL ROUGH EDGES ON NONMETALLIC CONDUIT. (SEE NEC 347.5)

CONDUIT

STATE OF WISCONSIN
DEPARTMENT OF TRANSPORTATION

PPROVED

DATE 9/15/92 DATE STATE ELECTRICAL ENGR FOR HE

S.D.D. 9 B 2-5

TABLE OF NOMINAL DIMENSIONS AND WEIGHTS

DIMENSION IN INCHES		TYPE OF PIPE						
		CORRUGATED STEEL						POLYETHYLENE SDR 32.5
PIPE DIAMETER (INSIDE)	A	12	12	18	18	24	24	12
PIPE LENGTH **	В	24	36	24	36	24	36	24
WALL THICKNESS	С	0.064	0.064	0.064	0.064	0.064	0.064	0.4
COVER	D	10 1/4	10 1/4	16 1/4	16 1/4	22 1/4	22 1/4	10 1/4
FRAME	E	14 1/2	14 1/2	20 1/2	20 ½	26 1/2	26 1/2	14 1/2
FRAME	F	8 1/2	8 1/2	14 1/2	14 1/2	20 1/2	20 1/2	8 ½
FRAME	G	11 1/2	11 1/2	17 1/2	17 1/2	23 1/2	23 1/2	11 1/2
			WEIG	HT IN	POUN	)s *		*****
FRAME AND COVER		60	60	110	110	155	155	60

- \* THE ACTUAL WEIGHT OF THE MANHOLE FRAME AND COVER MAY VARY WITHIN 5 PERCENT PLUS OR MINUS OF THE WEIGHTS SHOWN.
- NORMALLY USED LENGTHS. THE PROJECT ENGINEER SHALL DETERMINE IF PIPE LENGTHS, OTHER THAN THOSE SPECIFIED, SHALL BE USED, TO A MAXIMUM OF 48" (CONTINUOUS LENGTH, NON-SPLICED)

#### GENERAL NOTES

DETAILS OF CONSTRUCTION, MATERIALS AND WORKMANSHIP NOT SHOWN ON THIS DRAWING SHALL CONFORM TO THE PERTIMENT REQUIREMENTS OF THE CONTRACT.

ALL FRAMES AND COVERS SHALL BE HEAVY DUTY TYPE, SUITABLE FOR VEHICULAR TRAFFIC LOADS.

POLYETHYLENE PULL BOXES SHALL NOT BE INSTALLED IN CONCRETE OR ASPHALTIC PAVEMENT. PULL BOXES LOCATED IN THE ROADWAY SHALL HAVE LOCKING COVERS.

ENTRANCE HOLES INTO PULL BOXES SHALL BE CUT WITH A CIRCULAR HOLE SAW OR HYDRAULIC CONDUIT PUNCH, HOLE SIZE SHALL BE THE OUTSIDE DIAMETER OF THE CONDUIT THAT IS TO FIT IN THE OPENING PLUS NO MORE THAN 1/4".

THE CONTRACTOR SHALL NOT INSTALL WIRE IN ANY PULL BOX UNTIL ITS INSTALLATION HAS BEEN INSPECTED AND ACCEPTED BY THE ENGINEER.


CROUNDING LUGS (MECHANICAL CONNECTORS) SHALL BE U.L. LISTED AND APPROVED FOR USE WITH COPPER WIRE. THE MECHANICAL CONNECTION (INSIDE AND OUTSIDE) TO THE PULL BOX, SHALL BE TOTALLY AND PERMANENTLY SEALED WITH A SILICONE OR RUBBERIZED CAULKING COMPOUND AS APPROVED BY THE ENGINEER.

GROUNDING LUGS ARE NOT REQUIRED IN PULL BOXES WHEN VOLTAGES OF LESS THAN 50 VOLTS AC ARE THE ONLY VOLTAGES ENCOUNTERED IN THE BOXES.


DRAIN DUCT SHALL BE MEASURED AND PAID FOR SEPARATELY.

RODENT SCREEN SHALL BE 1/8" GALVANIZED STEEL MESH AND BE INSTALLED WITH A STAINLESS STEEL HOSE CLAMP OF SUFFICIENT SIZE.

ALL METALLIC CONDUIT IN WHICH WIRE AND/OR CABLE IS TO BE INSTALLED. SHALL BE BUSHED BEFORE INSTALLATION OF THE WIRE AND/OR CABLE.

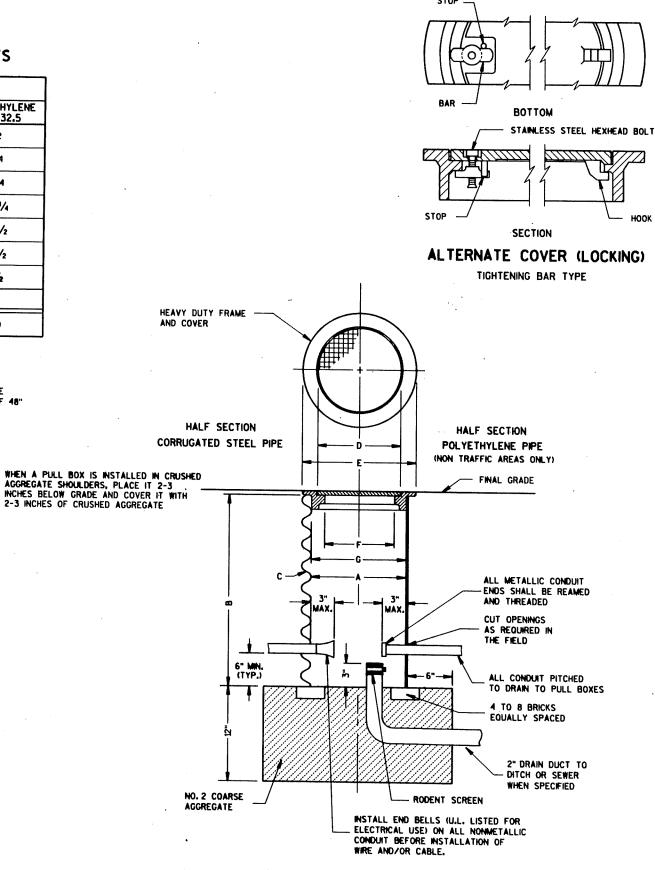

**PULL BOX** 

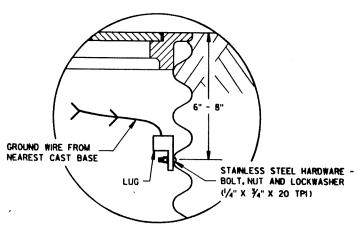

GROUNDING LUG AND LOCATION IN STEEL PULL BOXES

PULL BOX

STATE OF WISCONSIN DEPARTMENT OF TRANSPORTATION

S.D.D. 9 B 4-1



DETAILS OF CONSTRUCTION, MATERIALS AND WORKMANSHIP NOT SHOWN ON THIS DRAWING SHALL CONFORM TO THE PERTINENT REQUIREMENTS OF THE CONTRACT.

FOUR (4) BOLTS TO BE FURNISHED WITH EACH TRANSFORMER BASE, BOLTS SHALL BE 1" DIAMETER, 4" IN LENGTH, WITH WASHERS, LOCK WASHERS AND NUTS. BOLTS, NUTS AND WASHERS SHALL BE MANUFACTURED IN ACCORDANCE WITH ASTM A-449, AND BE GALVANIZED IN ACCORDANCE WITH ASTM A-153, CLASS C.

4" BOLTS SHALL BE IN ACCORDANCE WITH SECTION 640.2.9 OF THE STANDARD SPECIFICATIONS, ASTM A-449 OR ASTM A-687 (GRADE 105).

LEVELING SHIMS, IF NEEDED, SHALL BE DESIGNED FOR THE PURPOSE AND USED UNDER CAST BASES WHEN PLUMBING POLES OR STANDARDS DURING INSTALLATION. THE USE OF WASHERS IN LIEU OF PROPER LEVELING SHIMS IS NOT ACCEPTABLE.

SHIM LENGTH SHALL BE LONG ENOUGH TO COMPLETELY COVER THE AREA UNDER THE LENGTH AND WIDTH OF THE BASE MOUNTING FLANGE.


DOUBLE NUTTING IS NOT ACCEPTABLE FOR LEVELING OR MOUNTING PURPOSES.


A NEMA APPROVED AND U.L. LISTED MECHANICAL CONNECTOR (LUG) AL/CU RATED AND SIZED TO ACCEPT \*10 AWG STRANDED WIRE, SHALL BE FURNISHED AND INSTALLED IN THE PEDESTAL AND TRANSFORMER BASES.


THE MECHANICAL CONNECTOR SHALL BE INSTALLED USING A  $\frac{1}{4}$ " - 20 (TPI) STAINLESS STEEL HEX HEAD BOLT OF SUFFICIENT LENGTH TO FIRMLY ATTACH THE LUG TO THE BASE.

SHOULD THE MANNER OF ATTACHMENT OF THE LUG REQUIRE WASHERS, HEX NUTS, LOCK WASHER - THEY SHALL BE STAINLESS STEEL AS IS THE BOLT. THE MANNER OF ATTACHMENT SHALL NOT BLOCK ACCESSIBILITY TO WIRE PLACEMENT IN THE CONNECTOR.

TEST REPORTS FROM AN FHWA APPROVED INDEPENDENT LABORATORY SHALL BE PROVIDED CERTIFYING THAT THE BASE HAS BEEN TESTED AND MEETS OR EXCEEDS ALL OF THE APPLICABLE 1985 AASHTO BREAKAWAY REQUIREMENTS. A STATEMENT OF CERTIFICATION FROM FHWA ATTESTING THAT SUCH TESTS HAVE BEEN ACCEPTED AND APPROVED SHALL BE SUPPLIED ALONG WITH THE BID.

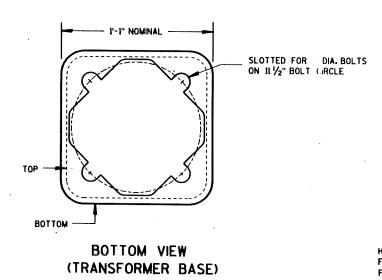

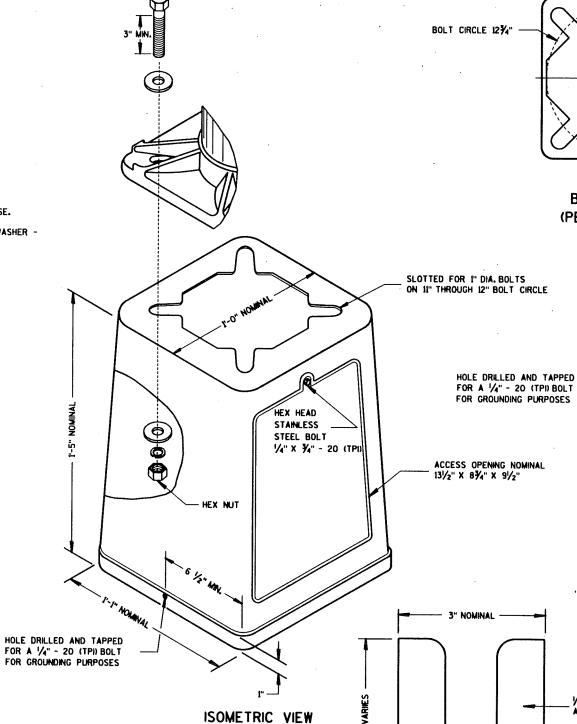

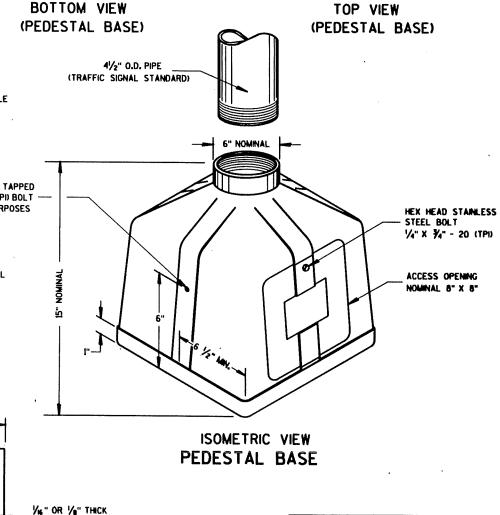

-11" NOMINAL

- I'-I" NOMINAL

AS NEEDED

LEVELING SHIM

TRANSFORMER BASE


INTENDED FOR USE WITH TYPE 2, 3, 4 & 5 POLES

CAST BASES

STATE OF WISCONSIN
DEPARTMENT OF TRANSPORTATION

Feter Rusch

APPROVED

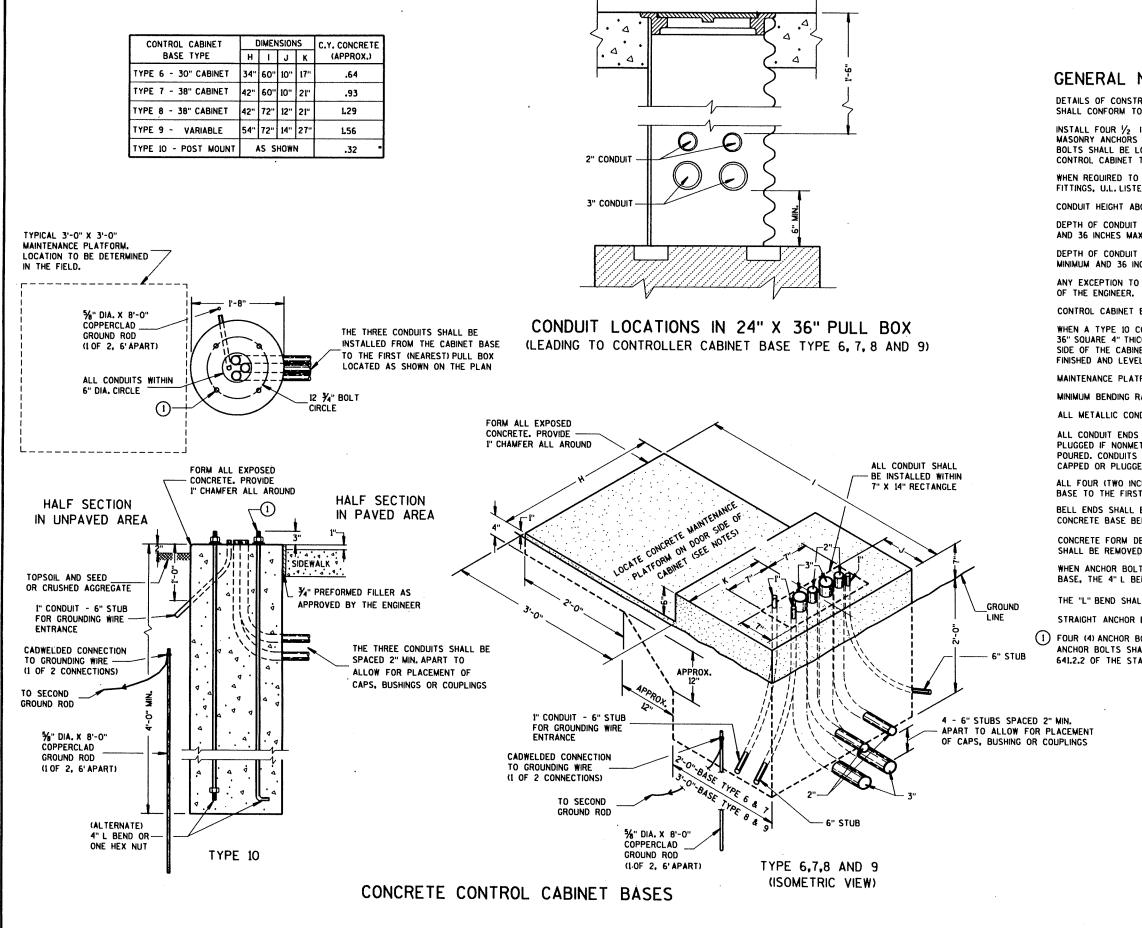

D.D.

9

C

# GENERAL NOTES

DETAILS OF CONSTRUCTION, MATERIALS AND WORKMANSHIP NOT SHOWN ON THIS DRAWING SHALL CONFORM TO THE PERTINENT REQUIREMENTS OF THE CONTRACT.

INSTALL FOUR  $\frac{1}{2}$  INCH MINIMUM DIAMETER X 4 INCH MINIMUM LENGTH APPROVED CONCRETE MASONRY ANCHORS TO ANCHOR THE CABINET TO TYPE 6, 7, 8, AND 9 BASES. THE ANCHOR BOLTS SHALL BE LOCATED AS DIRECTED BY THE ENGINEER TO PROPERLY ANCHOR THE

WHEN REQUIRED TO CONNECT NONMETALLIC CONDUIT TO METALLIC CONDUIT, ONLY ADAPTER FITTINGS, U.L. LISTED FOR ELECTRICAL USE, SHALL BE USED.

CONDUIT HEIGHT ABOVE THE CONCRETE BASE SHALL BE LINCH.

DEPTH OF CONDUIT INSTALLED BELOW THE TRAVELED WAY SHALL BE 24 INCHES MINIMUM AND 36 INCHES MAXIMUM.

DEPTH OF CONDUIT INSTALLED THAT IS NOT BELOW THE TRAVELED WAY SHALL BE 18 INCHES MINIMUM AND 36 INCHES MAXIMUM.

ANY EXCEPTION TO THE MAXIMUM DEPTH SHALL BE ONLY WITH THE WRITTEN APPROVAL

CONTROL CABINET BASE TOP SURFACES SHALL BE TROWEL FINISHED AND LEVEL.

WHEN A TYPE 10 CONTROL CABINET BASE IS USED TO POST MOUNT A CONTROL CABINET. A 36" SQUARE 4" THICK CONCRETE MAINTENANCE PLATFORM SHALL BE REQUIRED ON THE DOOR SIDE OF THE CABINET. THE TOP LINCH SHALL BE ABOVE FINISHED GRADE AND BE BROOM

MAINTENANCE PLATFORMS ARE NOT REQUIRED WHEN THE SURROUNDING AREA IS PAVED.

MINIMUM BENDING RADIUS OF CONDUIT = 6 X THE DIAMETER.

ALL METALLIC CONDUIT ENDS SHALL BE REAMED AND THREADED.

ALL CONDUIT ENDS AT THE TOP OF CONCRETE BASES SHALL BE CAPPED IF METALLIC OR PLUGGED IF NONMETALLIC IMMEDIATELY AFTER PLACEMENT AND BEFORE CONCRETE IS POURED. CONDUITS IN WHICH WIRE OR CABLE IS NOT BEING INSTALLED SHALL REMAIN

ALL FOUR (TWO INCH AND THREE INCH) CONDUIT SHALL BE INSTALLED FROM THE CABINET BASE TO THE FIRST (NEAREST PULL BOX LOCATED AS SHOWN ON THE PLANS.

BELL ENDS SHALL BE INSTALLED ON ALL PVC CONDUIT EXPOSED AT THE TOP OF THE CONCRETE BASE BEFORE INSTALLATION OF CABLE OR WIRE.

CONCRETE FORM DEPTH BELOW FINISHED GRADE SHALL BE 6" MAXIMUM, CONCRETE FORMS SHALL BE REMOVED AFTER CONCRETE HAS SET.

WHEN ANCHOR BOLTS USING THE ALTERNATE L BEND ARE FURNISHED FOR THE TYPE 10 BASE, THE 4" L BEND SHALL BE IN ADDITION TO THE SPECIFIED ANCHOR BOLT BAR LENGTH.

THE "L" BEND SHALL NOT BE THREADED.

STRAIGHT ANCHOR BOLTS SHALL BE THREADED 8" IN LENGTH ON EACH END OF THE BOLT.


(1) FOUR (4) ANCHOR BOLTS, 1" DIA. X 3'-6" ANCHOR BOLTS SHALL BE MANUFACTURED IN ACCORDANCE WITH SECTION 640.2.9 AND 641.2.2 OF THE STANDARD SPECIFICATIONS AND IN ACCORDANCE WITH A-449.

> CONCRETE CONTROL CABINET BASES

STATE OF WISCONSIN DEPARTMENT OF TRANSPORTATION

APPROVED

STATE ELECTRICAL ENGR FOR HWYS 4/21/93 DATE sau Surch

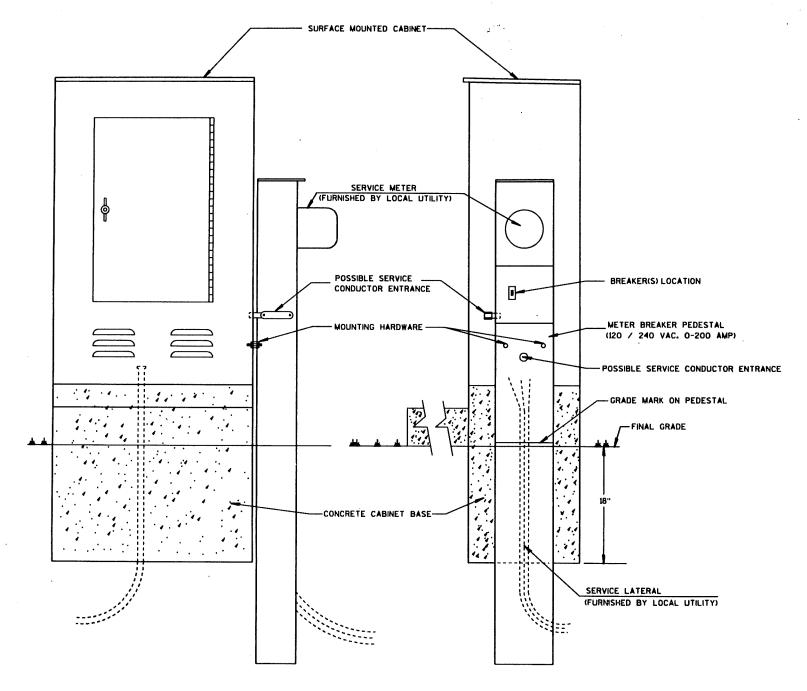

TYPICAL CABINET SERVICE INSTALLATION

# GENERAL NOTES

DETAILS OF CONSTRUCTION, MATERIALS AND WORKMANSHIP NOT SHOWN ON THIS DRAWING SHALL CONFORM TO THE PERTINENT REQUIREMENTS OF THE CONTRACT.

THE EXACT LOCATION OF THE METER BREAKER PEDESTAL SHALL BE DETERMINED BY THE ENGINEER IN THE FIELD.

THE TYPE OF CONCRETE CABINET BASE TO BE INSTALLED SHALL BE AS CALLED FOR IN THE PLANS.

SERVICE CONDUCTOR ENTRANCES SHALL BE RIGID CONDUIT, NIPPLES AND/OR CONDULETS AS REQUIRED.

SERVICE CONDUCTOR ENTRANCES SHALL BE SIZED AS REQUIRED AND IN ACCORDANCE WITH APPROPRIATE ARTICLES OF THE LATEST ACCEPTED NATIONAL ELECTRICAL CODE.

CABINET SERVICE INSTALLATION

STATE OF WISCONSIN
DEPARTMENT OF TRANSPORTATION


APPROYED

4/2//63

4/2//93


DATE

STATE SLECTHEAN ENGR FOR HE STATE TRAFFIC ENGINEER FOR HE

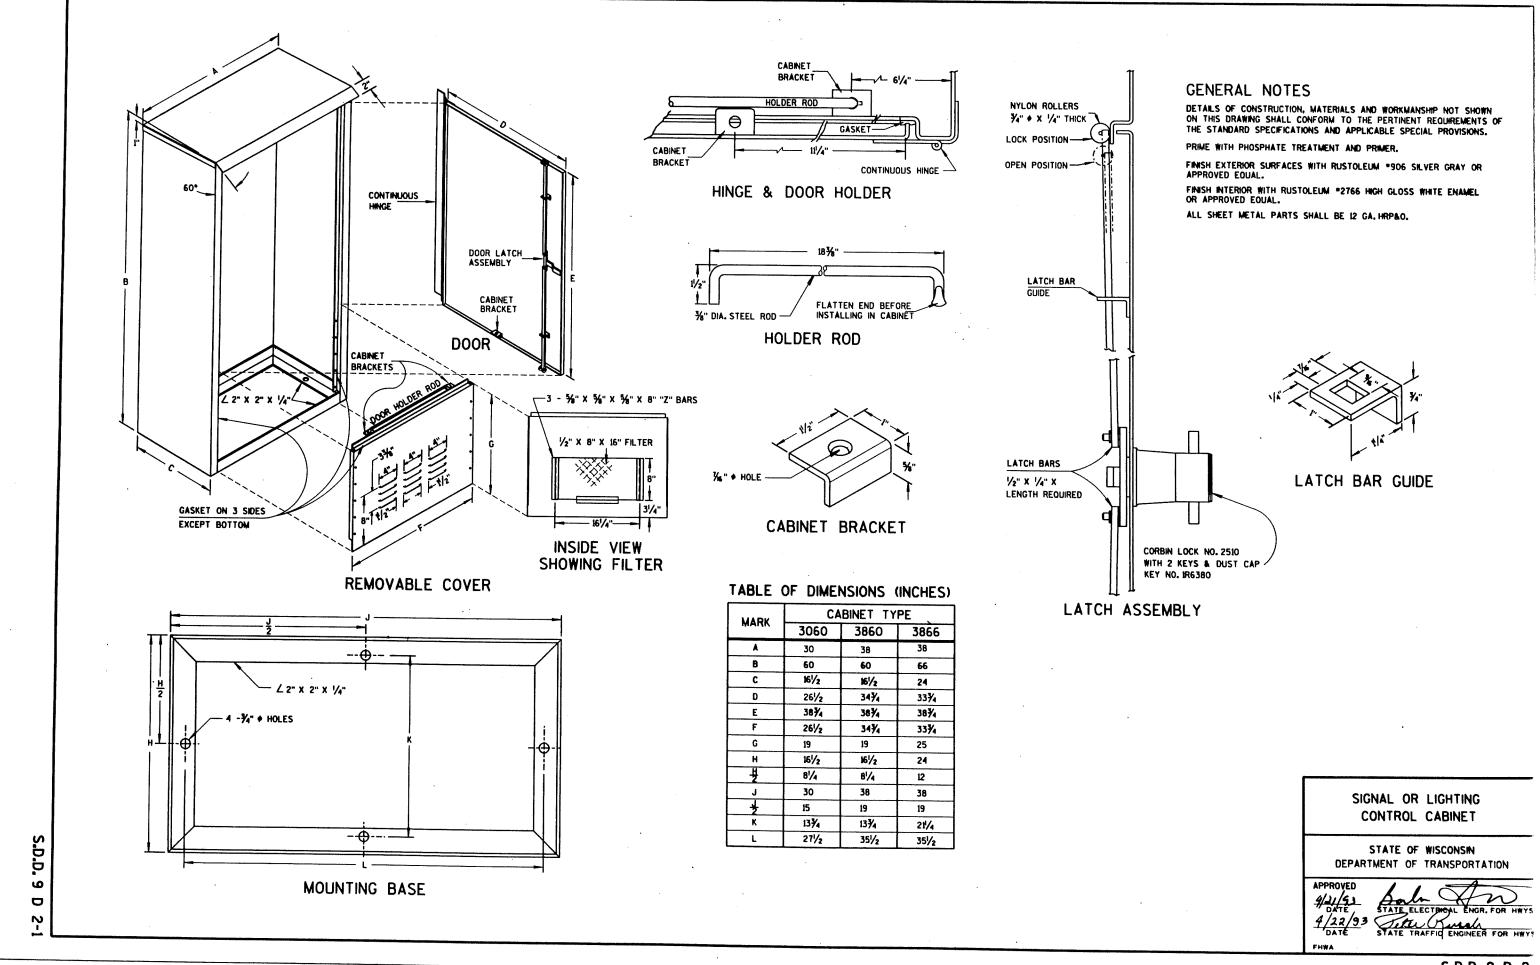

S.D.D. 9 D 2

SIGNAL FACE MOUNTING DETAIL

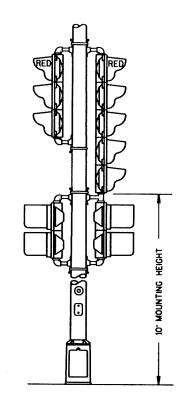

VENTILATED

METALLIC CAP

AND BOLT

POLE SPLICE

WHEN STEEL
POLE IS TO BE
FURNISHED

ROUND SHAFT 8" O.D. -(POLE BUTT) X 65%" O.D. LOWER 15' TAPERED

SIDEWALK, OR IF NONE,

PAVEMENT CENTERLINE


TYPICAL MOUNTING OF BACK TO BACK 3 AND 5 SECTION SIGNAL FACES

TYPE 2 POLE MOUNTING CONFIGURATION

#### GENERAL NOTES


- 4" X 6" REINFORCED HANDHOLE & COVER ASSEMBLY WITH 2 (TWO) 1/4" X 3/4" 20 TPI HEX HEAD STAINLESS STEEL BOLTS.
- (SEE SPECIAL PROVISIONS).
- GROMMETS, I" CHASE NIPPLES OR I" CLOSE CONDUIT NIPPLES WITH BUSHINGS SHALL BE PROVIDED FOR 1%" HOLE IN POLE SHAFT FOR WIRING.
- (4) BACKBOARDS ARE REQUIRED AT ALL TIMES ON TROMBONE MAST ARM MOUNTED SIGNAL FACES. VERTICAL MOUNTED SIGNAL FACES WITH BACKBOARDS REQUIRED ARE LOCATED AS SHOWN ON THE PLANS. BACKBOARDS ARE REQUIRED TO SURROUND SIGNAL FACES. BACKBOARDS SHALL EXTEND 5" BEYOND EXTREMITIES OF THE SIGNAL FACE.
- (5) POLE MOUNTED SIGNAL FACES SHALL REQUIRE 1 OR MORE MOUNTING SPACERS UNDER THE TOP MOUNTING BRACKET(S) AS REQUIRED, TO PLUMB THE SIGNAL FACES.
- 6.) CAST ALUMINUM TRANSFORMER BASE, WHEN REQUIRED.
- 1 1/2" PIPE THREAD ON THE MOUNTING BRACKET NIPPLES FOR THE SIGNAL FACE. NIPPLE SHALL BE 1 1/2" X 2".
- (8) VERTICAL STRUT (ADJUSTABLE). ONE (1) SET SCREW (1/4" X 1/4" LONG-20 TPI, STAINLESS STEEL, HEX HEAD) INTO EACH ARM MEMBER IF STRUT IS THE SLIDING TYPE.
- 9. FURNISH AND INSTALL VENTILATED, CAST, METALLIC (ALUMINUM ALLOY) CAPS.

  FASTEN CAPS WITH ONE (D'/" x ¾" 20 TPI STAINLESS STEEL, HEX HEAD BOLT.
- (i) SHIMMING, IF NEEDED, SHALL BE LOCATED BETWEEN THE CONCRETE FOUNDATION AND THE TRANSFORMER BASE.
- \*MOUNTING HEIGHT LIMITATION DIMENSIONS OF THE TROMBONE MAST ARM WILL BE DEPENDENT UPON THE USE/NON-USE OF A TRANSFORMER BASE.

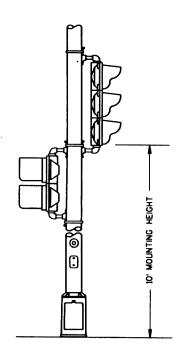

TYPICAL MOUNTING OF 3 SECTION SIGNAL FACE

WELD TO BE 100% R.T. OR U.T. TESTED AS PER THE REQUIREMENTS OF AWS D 1.5-88. RECORDS OF CERTIFICATION OF COMPLIANCE OF SUCH TESTING SHALL BE FURNISHED TO THE PROJECT ENGINEER FOR APPROVAL PRIOR TO SHIPMENT OF THE POLES, VERFICATION AND APPROVAL OF THE TESTING CERTIFICATION FROM THE MANUFACTURER SHALL BE COMPLETED BY THE CENTRAL OFFICE BRIDGE SECTION.

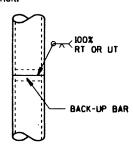

HOT

SHEET SDD 9 E 1-16 IS REQUIRED WHEN THIS DRAWING IS CALLED FOR IN THE PLANS.

POLE MOUNTINGS FOR TRAFFIC SIGNALS TYPE 2

STATE OF WISCONSIN
DEPARTMENT OF TRANSPORTATION

CURVED END

VARIABLE

ROADWAY

PAVEMENT


25'-0" LENGTH FOR DESIGN CALCULATION

PEDESTRIAN PUSH BUTTON

(MAXIMUM LOAD)

REQUIRED

THIS DETAIL IS APPLICABLE WHEN SIGNALS ARE MOUNTED ON A TROMBONE ARM. DO NOT USE FOR LIGHTING.

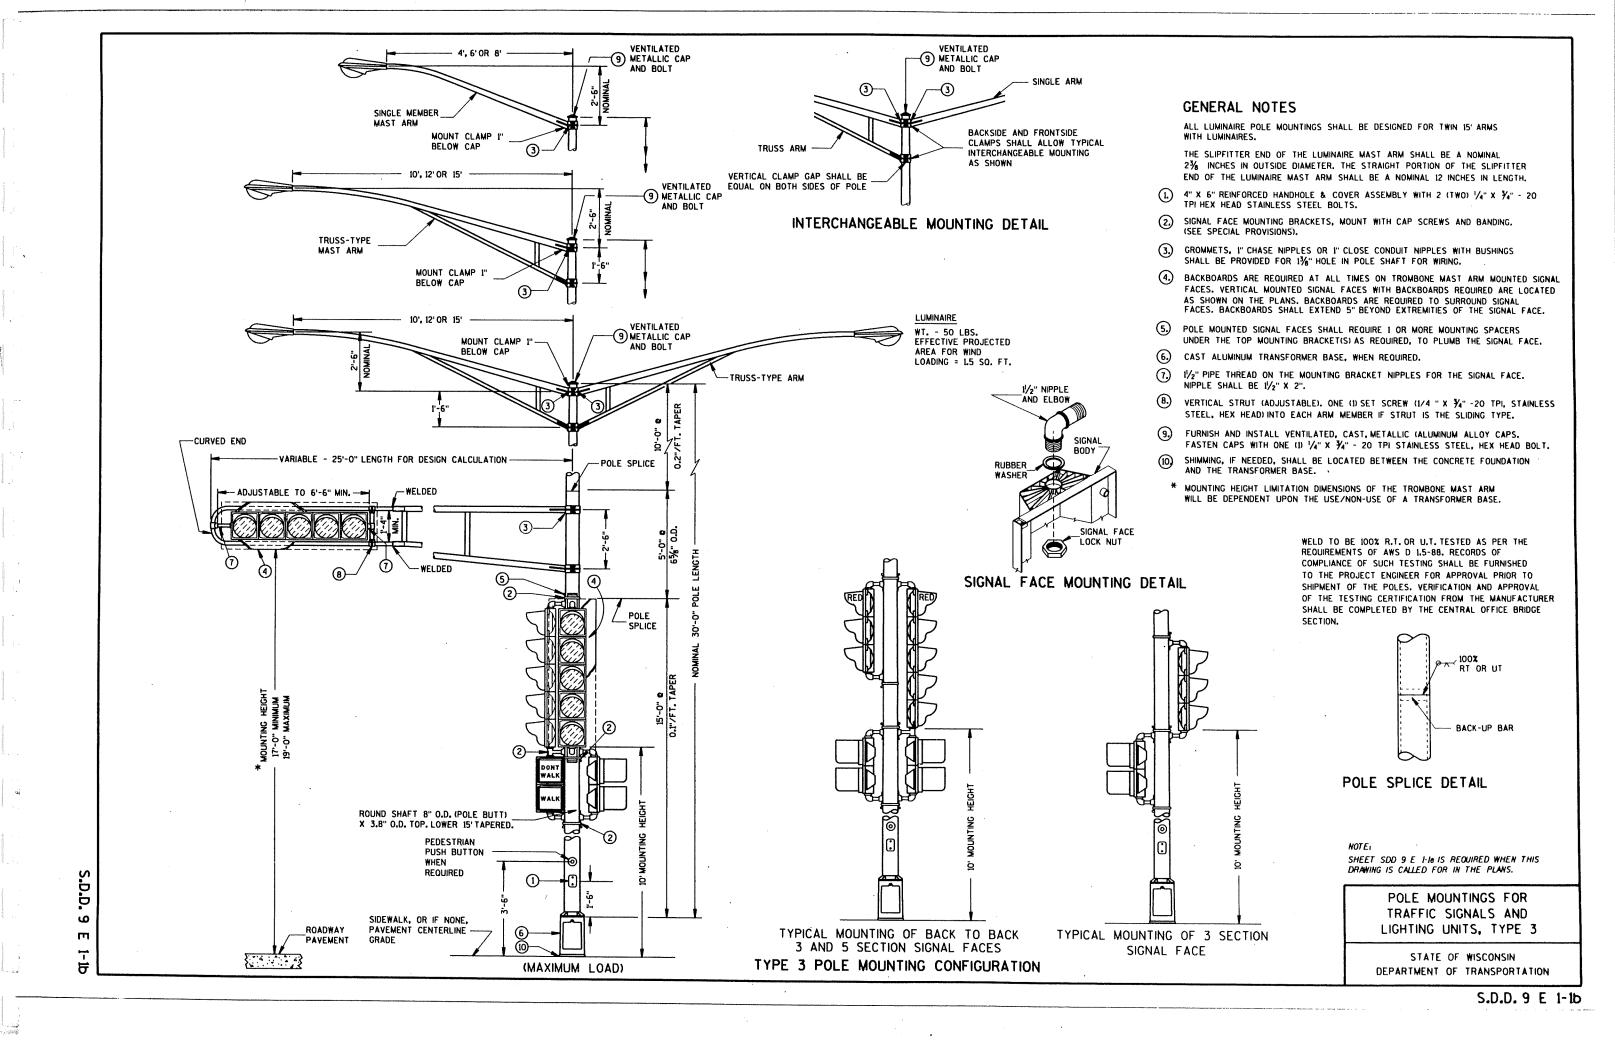

MOUNT CLAMP I

ROUND SHAFT 8" O.D. (POLE BUTT) X 3.8"-

PEDESTRIAN PUSH BUTTON

REQUIRED

O.D. TOP

10'- 12' OR 15'

TRUSS-TYPE ARM

PAVEMENT CENTERLINE GRADE.

VENTILATED


-POLE SPLICE

POLE


(MAXIMUM LOAD)

METALLIC CAP AND BOLT


WELD TO BE 100% R.T. OR U.T. TESTED AS PER THE REQUIREMENTS OF AWS D L5-88. RECORDS OF CERTIFICATION OF COMPLIANCE OF SUCH TESTING SHALL BE FURNISHED TO THE PROJECT ENGINEER FOR APPROVAL PRIOR TO THE SHIPMENT OF THE POLES. VERIFICATION AND APPROVAL OF THE TESTING CERTIFICATION FROM THE MANUFACTURER SHALL BE COMPLETED BY THE CENTRAL OFFICE BRIDGE SECTION.

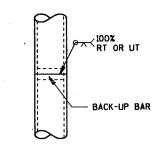

POLE SPLICE DETAIL

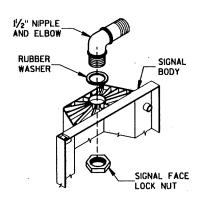

SIGNAL FACE MOUNTING DETAIL

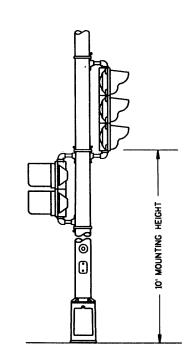

TYPICAL MOUNTING OF 3 SECTION SIGNAL FACE

TYPE 4 POLE MOUNTING CONFIGURATION


#### GENERAL NOTES

THE POLE USED IN THE TYPE 4 MOUNTING CONFIGURATION SHALL BE INTERCHANGEABLE WITH, AND MEET THE LOADING REQUIREMENTS OF A TYPE 3 POLE.

ALL LUMINAIRE POLE MOUNTINGS SHALL BE DESIGNED FOR TWIN 15' ARMS WITH LUMINAIRES.

THE SLIPFITTER END OF THE LUMINAIRE MAST ARM SHALL BE A NOMINAL 2% INCHES IN OUTSIDE DIAMETER. THE STRAIGHT PORTION OF THE SLIPFITTER END OF THE LUMINAIRE MAST ARM SHALL BE A NOMINAL 12 INCHES IN LENGTH.

- 4" X 6" REINFORCED HANDHOLE & COVER ASSEMBLY WITH 2 (TWO)  $\frac{1}{4}$ " X  $\frac{3}{4}$ " 20 TPI HEX HEAD STAINLESS STEEL BOLTS.
- 2) SIGNAL FACE MOUNTING BRACKETS, MOUNT WITH CAP SCREWS AND BANDING.
- (3.) GROMMETS, I" CHASE NIPPLES OR I" CLOSE CONDUIT NIPPLES WITH BUSHINGS SHALL BE PROVIDED FOR 1%" HOLE IN POLE SHAFT FOR WIRING.
- VERTICAL MOUNTED SIGNAL FACES WITH BACKBOARDS REQUIRED ARE LOCATED AS SHOWN ON THE PLANS. BACKBOARDS ARE REQUIRED TO SURROUND SIGNAL FACES. BACKBOARDS SHALL EXTEND 5" BEYOND EXTREMITIES OF SIGNAL FACE.
- (5.) POLE MOUNTED SIGNAL FACES SHALL REQUIRE 1 OR MORE MOUNTING SPACERS UNDER THE TOP MOUNTING BRACKET(S) AS REQUIRED, TO PLUMB THE SIGNAL FACE.
- (6.) CAST ALUMINUM TRANSFORMER BASE, WHEN REQUIRED.
- FURNISH AND INSTALL VENTILATED, CAST, METALLIC (ALUMINUM ALLOY CAPS. FASTEN CAPS WITH ONE (1) 1/4" X 1/4" - 20 TPI STAINLESS STEEL, HEX HEAD BOLT.
- (8) SHIMMING, IF NEEDED, SHALL BE LOCATED BETWEEN THE CONCRETE FOUNDATION AND THE TRANSFORMER BASE.

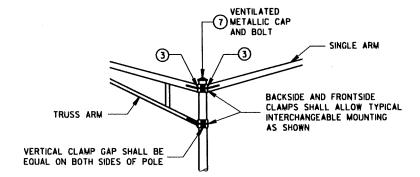

INTERCHANGEABLE MOUNTING DETAIL

SHEET SDD 9 EI-10 IS REQUIRED WHEN THIS DRAWING IS CALLED FOR IN THE PLANS.

POLE MOUNTINGS FOR TRAFFIC SIGNALS AND LIGHTING UNITS, TYPE 4

STATE OF WISCONSIN DEPARTMENT OF TRANSPORTATION

D.D. 9 Ш

ក

TYPICAL MOUNTING OF BACK TO BACK


3 AND 5 SECTION SIGNAL FACES


LUMINAIRE

AREA FOR WIND


WT. - 50 LBS. EFFECTIVE PROJECTED

LOADING = 15 SQ. FT.

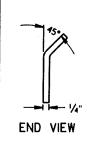


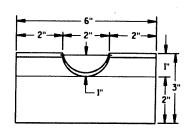


FRONT VIEW
RECTANGULAR CLAMP SHIM
(4 TO A SET)

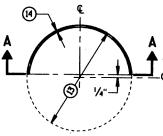


PLAN VIEW

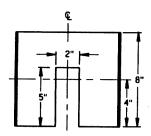

SECTION A-A
CIRCULAR CLAMP SHIM
(2 TO A SET)

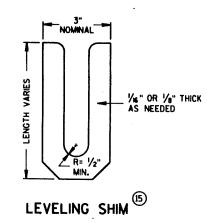

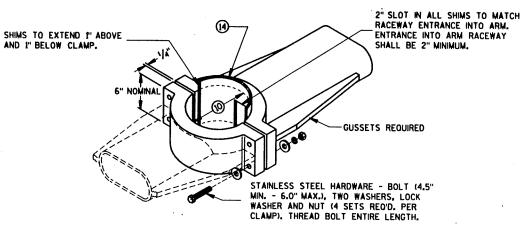

## TYPICAL TROMBONE MAST ARM AND LUMINAIRE MAST ARM MOUNTING CLAMP

#### **GENERAL NOTES**

- (0) 4.5" LD. FOR LUMINAIRE MAST ARM CLAMP. 6.625" LD. FOR TROMBONE MAST ARM CLAMP.
- (IL) INDIVIDUAL BASE PLATE ANCHOR BOLT COVERS. (4 REQUIRED)
- (2) BASE PLATE SLOTTED TO ACCEPT 11" THROUGH 12" BOLT CIRCLE USING 1" DIAMETER ANCHOR BOLTS.
- (3.) OUTSIDE SHIM DIAMETER (4.5" O.D. FOR LUMINAIRE MAST ARM)
  (6.625" O.D. FOR TROMBONE MAST ARM)
- (4) VARIABLE SHIM THICKNESS (0.10", 0.25", 0.35", 0.53" OR 0.70")

  SHIM THICKNESS FOR TROMBONE MAST ARMS MAY BE TYPICALLY 0.35", 0.53" OR 0.70".

SHMM THICKNESS FOR LUMMNAIRE MAST ARMS MAY BE TYPICALLY 0.10", 0.25" OR 0.35".


SHM MATERIAL SHALL BE ALUMNUM ALLOY.

SHIM THICKNESS SHALL BE IMPRESSED INTO EACH SHIM, NUMERALS SHALL BE  $\frac{1}{4}$ " HIGH AND LEGIBLE.


THE CONTRACTOR SHALL SUBMIT TWO COPIES OF ALL SHIM SHOP DRAWINGS TO THE ENGINEER FOR APPROVAL.


(5) LEVELING SHIMS, DESIGNED FOR THE PURPOSE, SHALL BE USED WHEN PLUMBING POLES. THE USE OF WASHERS IN LIEU OF PROPER LEVELING SHIMS IS NOT ACCEPTABLE. LEVELING SHIMS SHALL BE USED ONLY BETWEEN THE TOP OF THE CONCRETE BASE AND A METALLIC BASE PLATE.

SHIM LENGTH SHALL BE LONG ENOUGH TO COMPLETELY COVER THE AREA UNDER THE LENGTH AND WIDTH OF THE BASE MOUNTING FLANGE.

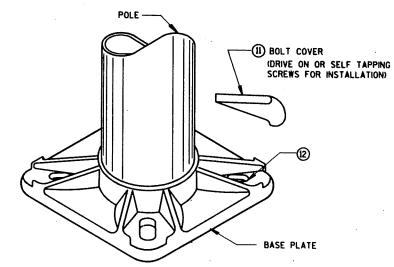



BASE PLATE

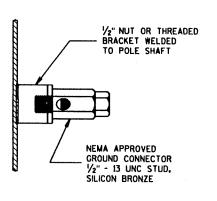

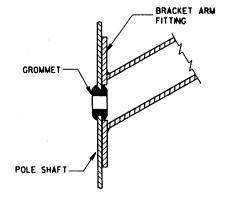

TYPICAL APPLICATION OF GROMMET IN POLE SHAFT

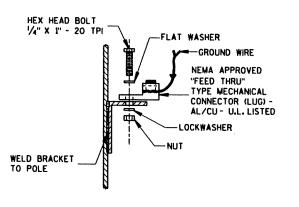


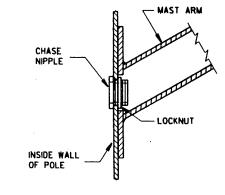

TYPICAL GROUNDING CONNECTIONS

NUT, BOLT AND WASHERS SHALL BE STAINLESS STEEL

TYPICAL APPLICATION OF CHASE NIPPLE IN POLE SHAFT

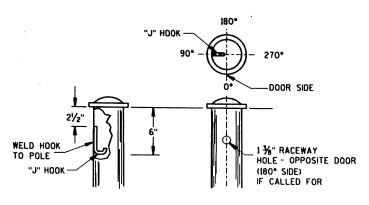

TYPICAL "J" HOOK LOCATION

THIS DRAWING IS REQUIRED WHEN DRAWINGS SDD 9 E 1-to.b.c. OR & IS CALLED FOR IN THE PLANS.

HARDWARE DETAILS FOR POLE MOUNTINGS

STATE OF WISCONSIN
DEPARTMENT OF TRANSPORTATION

APPROVED

9/A1/G 9

DATE

STATE ELECTRICAL ENGR FOR HWYS

4/21/93


DATE

STATE TRAFFIC ENGRICER FOR HWYS

FHWA

S.D.D. 9 E 1-1e

S.D.D. 9 E 1

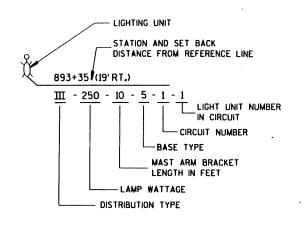


LIGHTING UNIT CODE


S.D.D.

Q


Ш

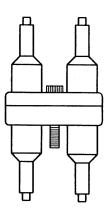

DETAIL "A"
DOUBLE POLE

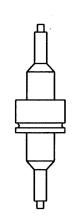

DETAIL "B"
SINGLE POLE

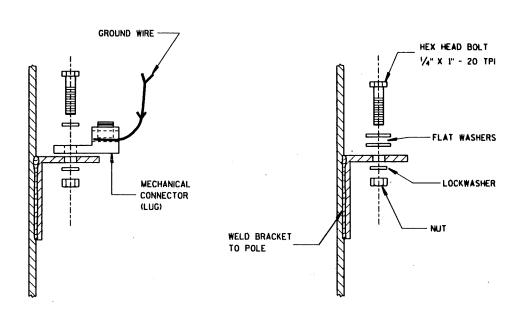


#### TYPICAL GROUNDING CONNECTIONS


NUT, BOLT AND WASHERS SHALL BE STAINLESS STEEL

#### GENERAL NOTES


DETAILS OF CONSTRUCTION, MATERIALS AND WORKMANSHIP NOT SHOWN ON THIS DRAWING SHALL CONFORM TO THE PERTINENT REQUIREMENTS OF THE CONTRACT.

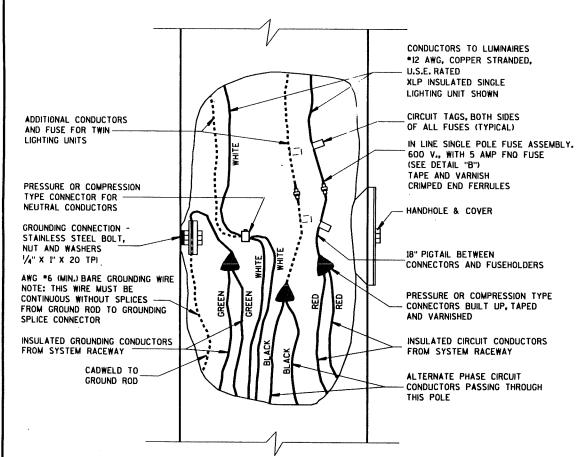

3 WIRE - 120, 240 OR 480 VOLTS TO GROUND 2 WIRE - 120 VOLTS TO GROUND

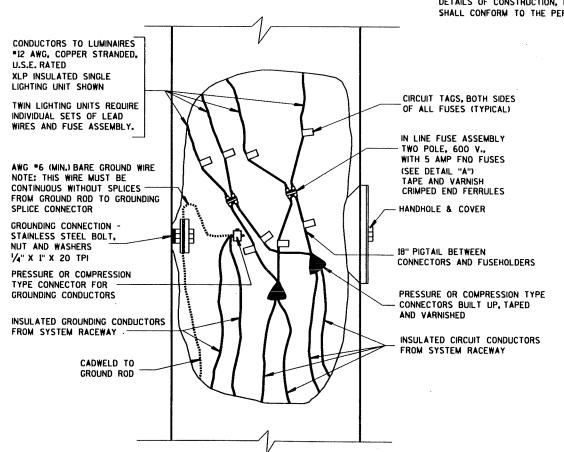

2 WIRE - 240 OR 480 VOLTS (UNGROUNDED)

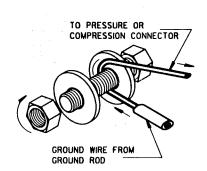

GROUND WIRE INSTALLATION
BETWEEN TWO WASHERS

NON-FREEWAY LIGHTING UNIT POLE WIRING

STATE OF WISCONSIN
DEPARTMENT OF TRANSPORTATION


4/21/93
DATE
4/21/93
DATE

STATE ELECTRICATION FOR HWYS

STATE TRAFFIC ENGINEER FOR HWYS

FUWA

S.D.D. 9 E 3-1

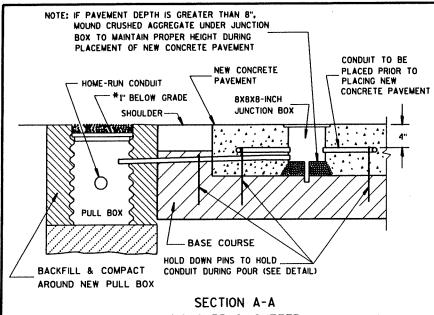

# SECTION A-A NO CURB & GUTTER LOOP DETECTOR INSTALLATION DETAIL

\*RECESS PULL BOX SO THAT THE COVER IS 3" BELOW GRADE IN SHOULDER AREAS OF CRUSHED AGGREGATE, BACKFILL OVER COVER WITH THE CRUSHED AGGREGATE TO BRING THE AREA TO GRADE LEVEL.

#### GENERAL NOTES

DETAILS OF CONSTRUCTION, MATERIALS AND WORKMANSHIP NOT SHOWN ON THIS DRAWING SHALL CONFORM TO THE PERTINENT REQUIREMENTS OF THE CONTRACT.

LOOP SIZE, LOCATION, NUMBER OF TURNS OF WIRE AND ASSOCIATED SIGNAL PHASE SHALL BE AS SHOWN ON THE PLANS.

PITCH LEAD OUT CONDUIT TO DRAIN TO ROADSIDE PULL BOX.

SPLICES SHALL BE INSTALLED BY USING CAST IN PLACE SPLICE KITS SUCH AS 3M TYPE 82A1 OR APPROVED EQUAL. NON-INSULATED BUTT SPLICES TO FIT \*12 AWG STRANDED WIRE SHALL BE USED. SPLICES SHALL BE SOLDERED AND INSULATED FROM EACH OTHER AS PER INSTRUCTIONS INCLUDED IN THE SPLICE KIT.

THE GROUND RESISTANCE READING OF THE LOOP SHALL READ "INFINITY" TO GROUND ON AN OHMMETER USING A MULTIPLIER SCALE OF I MEGOHM AND AN INPUT RESISTANCE OF II MEGOHMS MINIMUM BEFORE SPLICING THE LOOP TO THE LEAD-IN CABLE.

AFTER SPLICING THE LOOP WIRE TO THE LOOP LEAD-IN CABLE, THE CONTRACTOR SHALL MEASURE INDUCTANCE, GROUND RESISTANCE AND WIRE RESISTANCE AT THE CABINET END OF THE LEAD-IN CABLE AND FURNISH A COPY OF THE READINGS TO THE PROJECT ENGINEER FOR EVALUATION.

ANTI-SIEZE LUBRICATING MATERIAL SHALL BE USED ON ALL THREADS OF THREADED ASSEMBLIES BEFORE INSTALLATION.

LOOP DETECTOR LEADS SHALL BE IDENTIFIED WITH THEIR ASSOCIATED LOOP BY USE OF WATERPROOF TAGS AT BOTH ENDS OF THE CABLE. A LISTING OF THE CABLE IDENTIFICATION PER INDIVIDUAL LOOP LEAD-IN SHALL BE PLACED IN THE CABINET.


ANY PVC LEADOUT CONDUIT CONTAINING MORE THAN ONE TWISTED PAIR OF LOOP LEAD WIRE SHALL BE 2".


THE \*12 AWG LOOP WIRE FROM THE LOOP TO THE ROADSIDE PULL BOX, SHALL BE HAND TWISTED AT LEAST 3 TURNS PER FOOT BEFORE INSTALLATION.

SPLICES OF LOOP WIRE TO LEAD-IN CABLE SHALL BE MADE ONLY IN PULL BOXES AT THE SIDE OF THE ROAD.

THE "12 AWG LOOP WIRE SHALL BE INSTALLED FROM THE ROAD SIDE PULL BOX, THROUGH THE JUNCTION BOX, THROUGH THE LOOP CONDUIT, BACK TO THE ROADSIDE PULL BOX, AND BE INSTALLED IN ONE, NON-SPLICED CONTINUOUS LENGTH.

PROTECTION OF THE JUNCTION BOX AND RELATED CONDUITS SHALL BE REQUIRED AFTER INSTALLATION AND BEFORE NEW CONCRETE PAVEMENT IS POURED.

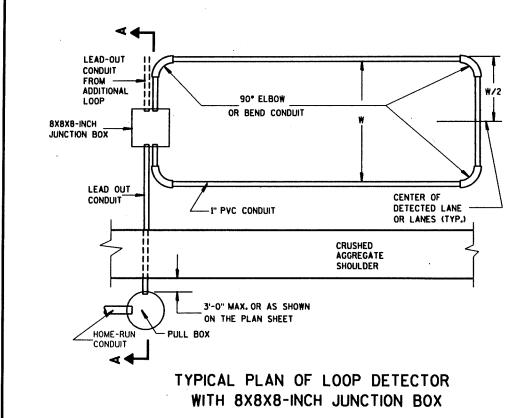

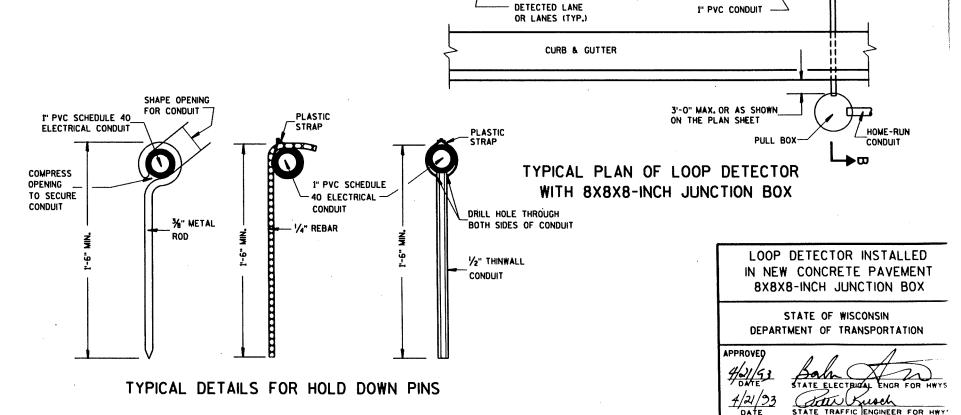

CONDUIT TO BE PLACED

NEW CONCRETE PAVEMENT

HOLD DOWN PINS TO HOLD

CENTER OF

CONDUIT DURING POUR (SEE DETAIL)

PRIOR TO PLACING

NOTE: IF PAVEMENT DEPTH IS GREATER THAN 8".

NEW CONCRETE

BASE COURSE-

SECTION B-B

**CURB & GUTTER** 

DETECTOR LOOP INSTALLATION DETAIL

90° ELBOW

OR BEND CONDUIT

**PAVEMENT** 

8X8X8-INCH

MOUND CRUSHED AGGREGATE UNDER JUNCTION

BACKFILL & COMPACT

**PULL BOX** 

INSTALL CONDUIT WITH

COUPLING INTO CURB AT

TIME OF CURB INSTALLATION

LEAD-OUT

ADDITIONAL

LEAD-OUT

8X8X8-INCH

JUNCTION BOX

CONDUIT

L00P


AROUND NEW PULL BOX

GRADE LEVEL

CONDUIT

BOX TO MAINTAIN PROPER HEIGHT DURING

PLACEMENT OF NEW CONCRETE PAVEMENT

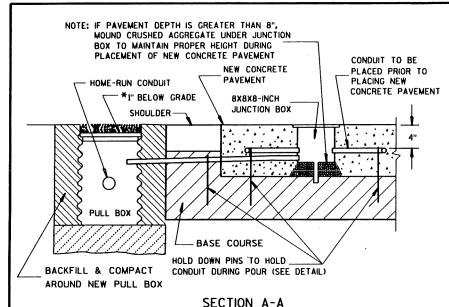

# NO CURB & GUTTER LOOP DETECTOR INSTALLATION DETAIL

\*RECESS PULL BOX SO THAT THE COVER IS 3"
BELOW GRADE IN SHOULDER AREAS OF CRUSHED
AGGREGATE, BACKFILL OVER COVER WITH THE
CRUSHED AGGREGATE TO BRING THE AREA TO
GRADE LEVEL.

#### GENERAL NOTES

DETAILS OF CONSTRUCTION, MATERIALS AND WORKMANSHIP NOT SHOWN ON THIS DRAWING SHALL CONFORM TO THE PERTINENT REQUIREMENTS OF THE CONTRACT.

LOOP SIZE, LOCATION, NUMBER OF TURNS OF WIRE AND ASSOCIATED SIGNAL PHASE SHALL BE AS SHOWN ON THE PLANS.

PITCH LEAD OUT CONDUIT TO DRAIN TO ROADSIDE PULL BOX.

SPLICES SHALL BE INSTALLED BY USING CAST IN PLACE SPLICE KITS SUCH AS 3M TYPE 82A1 OR APPROVED EQUAL. NON-INSULATED BUTT SPLICES TO FIT \*12 AWG STRANDED WIRE SHALL BE USED. SPLICES SHALL BE SOLDERED AND INSULATED FROM EACH OTHER AS PER INSTRUCTIONS INCLUDED IN THE SPLICE KIT.

THE GROUND RESISTANCE READING OF THE LOOP SHALL READ "INFINITY" TO GROUND ON AN OHMMETER USING A MULTIPLIER SCALE OF 1 MEGOHM AND AN INPUT RESISTANCE OF 11 MEGOHMS MINIMUM BEFORE SPLICING THE LOOP TO THE LEAD-IN CABLE.

AFTER SPLICING THE LOOP WIRE TO THE LOOP LEAD-IN CABLE, THE CONTRACTOR SHALL MEASURE INDUCTANCE, GROUND RESISTANCE AND WIRE RESISTANCE AT THE CABINET END OF THE LEAD-IN CABLE AND FURNISH A COPY OF THE READINGS TO THE PROJECT ENGINEER FOR EVALUATION.

ANTI-SIEZE LUBRICATING MATERIAL SHALL BE USED ON ALL THREADS OF THREADED ASSEMBLIES BEFORE INSTALLATION.


LOOP DETECTOR LEADS SHALL BE IDENTIFIED WITH THEIR ASSOCIATED LOOP BY USE OF WATERPROOF TAGS AT BOTH ENDS OF THE CABLE. A LISTING OF THE CABLE IDENTIFICATION PER INDIVIDUAL LOOP LEAD-IN SHALL BE PLACED IN THE CABINET.

THE \*12 AWG LOOP WIRE FROM THE LOOP TO THE ROADSIDE PULL BOX, SHALL BE HAND TWISTED AT LEAST 3 TURNS PER FOOT BEFORE INSTALLATION.


SPLICES OF LOOP WIRE TO LEAD-IN CABLE SHALL BE MADE ONLY IN PULL BOXES AT THE SIDE OF THE ROAD.

THE \*12 AWG LOOP WIRE SHALL BE INSTALLED FROM THE ROAD SIDE PULL BOX, THROUGH THE JUNCTION BOX, THROUGH THE LOOP CONDUIT, BACK TO THE ROADSIDE PULL BOX, AND BE INSTALLED IN ONE, NON-SPLICED CONTINUOUS LENGTH.

PROTECTION OF THE JUNCTION BOX AND RELATED CONDUITS SHALL BE REQUIRED AFTER INSTALLATION AND BEFORE NEW CONCRETE PAVEMENT IS POURED.

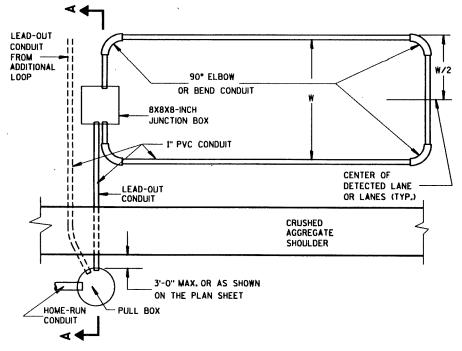

TYPICAL PLAN OF LOOP DETECTOR WITH 8X8X8-INCH JUNCTION BOX

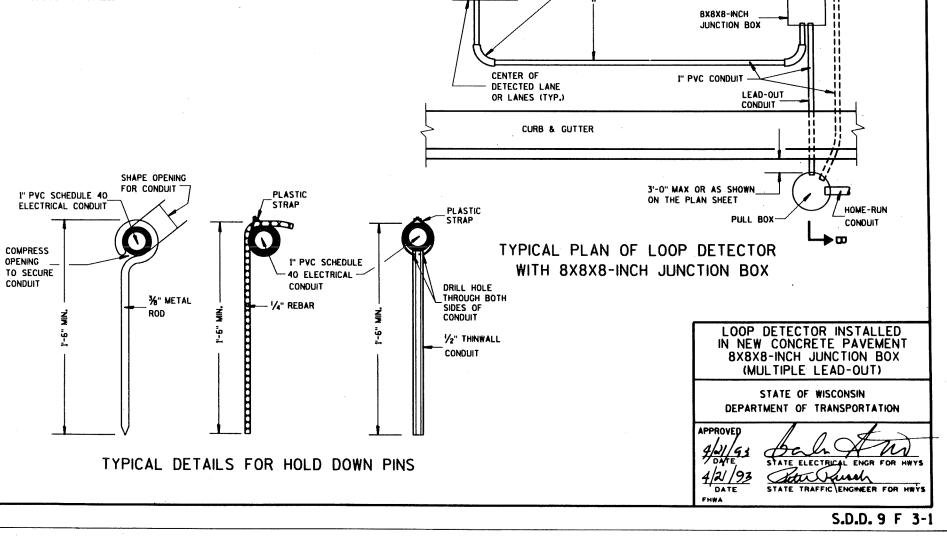

CONDUIT TO BE PLACED

HOLD DOWN PINS TO HOLD

CONDUIT DURING POUR (SEE DETAIL)

NEW CONCRETE PAVEMENT

PRIOR TO PLACING

NOTE: IF PAVEMENT DEPTH IS GREATER THAN 8".

NEW CONCRETE PAVEMENT

BASE COURSE-

SECTION B-B

**CURB & GUTTER** 

LOOP DETECTOR INSTALLATION DETAIL

90° ELBOW

OR BEND CONDUIT

8X8X8-INCH

JUNCTION BOX

MOUND CRUSHED AGGREGATE UNDER JUNCTION

BACKFILL & COMPACT

INSTALL CONDUIT WITH

COUPLING INTO CURB AT

TIME OF CURB INSTALLATION

AROUND NEW PULL BOX

GRADE LEVEL

HOME-RUN

CONDUIT

LEAD-OUT


CONDUIT

FROM ADDITIONAL

LOOP

BOX TO MAINTAIN PROPER HEIGHT DURING


PLACEMENT OF NEW CONCRETE PAVEMENT

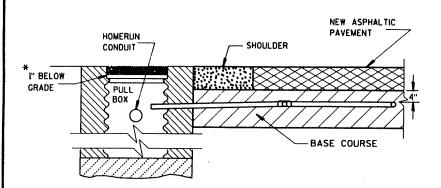

### SECTION A-A NO CURB & GUTTER

#### DETECTOR LOOP INSTALLATION DETAIL

\*RECESS PULL BOX SO THAT THE COVER IS 3"
BELOW GRADE IN SHOULDER AREAS OF CRUSHED
AGGREGATE. BACKFILL OVER COVER WITH THE
CRUSHED AGGREGATE TO BRING THE AREA TO
GRADE LEVEL.

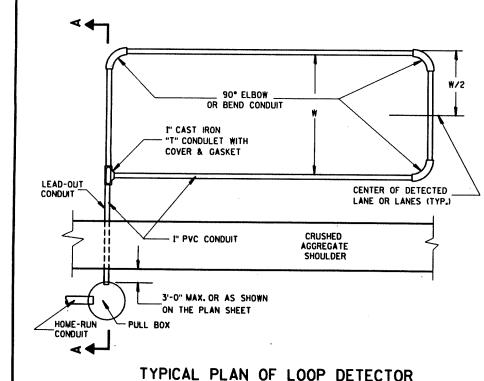

#### GENERAL NOTES

DETAILS OF CONSTRUCTION, MATERIALS AND WORKMANSHIP NOT SHOWN ON THIS DRAWING SHALL CONFORM TO THE PERTINENT REQUIREMENTS OF THE CONTRACT.

LOOP SIZE, LOCATION, NUMBER OF TURNS OF WIRE AND ASSOCIATED SIGNAL PHASE SHALL BE AS SHOWN ON THE PLANS.

PITCH LEAD-OUT CONDUIT TO DRAIN TO ROADSIDE PULL BOX.

SPLICES SHALL BE INSTALLED BY USING CAST IN PLACE SPLICE KITS SUCH AS 3M TYPE 82AI OR APPROVED EQUAL. NON-INSULATED BUTT SPLICES TO FIT \*12 AWG STRANDED WIRE SHALL BE USED. SPLICES SHALL BE SOLDERED AND INSULATED FROM EACH OTHER AS PER INSTRUCTIONS INCLUDED IN THE SPLICE KIT.

THE GROUND RESISTANCE READING OF THE LOOP SHALL READ "INFINITY" TO GROUND ON AN OHMMETER USING A MULTIPLIER SCALE OF I MEGOHM AND AN INPUT RESISTANCE OF 11 MEGOHMS MINIMUM BEFORE SPLICING THE LOOP TO THE LEAD-IN CARLE.

AFTER SPLICING THE LOOP WIRE TO THE LOOP LEAD-IN CABLE, THE CONTRACTOR SHALL MEASURE INDUCTANCE, GROUND RESISTANCE AND WIRE RESISTANCE AT THE CABINET END OF THE LEAD-IN CABLE AND FURNISH A COPY OF THE READINGS TO THE PROJECT ENGINEER FOR EVALUATION.

ANTI-SIEZE LUBRICATING MATERIAL SHALL BE USED ON ALL THREADS OF THREADED ASSEMBLIES BEFORE INSTALLATION.

LOOP DETECTOR LEADS SHALL BE IDENTIFIED WITH THEIR ASSOCIATED LOOP BY USE OF WATERPROOF TAGS AT BOTH ENDS OF THE CABLE. A LISTING OF THE CABLE IDENTIFICATION PER INDIVIDUAL LOOP LEAD-IN SHALL BE PLACED IN THE CABINET.

THE \*12 AWG LOOP WIRE FROM THE LOOP TO THE ROADSIDE PULL BOX, SHALL BE HAND TWISTED AT LEAST 3 TURNS PER FOOT BEFORE INSTALLATION.

SPLICES OF LOOP WIRE TO LEAD-IN CABLE SHALL BE MADE ONLY IN PULL BOXES AT THE SIDE OF THE ROAD.


THE \*12 AWG LOOP WIRE SHALL BE INSTALLED FROM THE ROADSIDE PULL BOX, THROUGH THE LOOP DUCT, BACK TO THE ROADSIDE PULL BOX, AND BE INSTALLED IN ONE, NON-SPLICED, CONTINUOUS LENGTH.

PROTECTION OF THE CONDUIT AND CONDULET SHALL BE REQUIRED AFTER INSTALLATION AND BEFORE THE ASPHALTIC PAVEMENT IS PLACED.

WHEN MULTIPLE LAYERS OF ASPHALTIC PAVEMENT ARE TO BE PLACED, LOOPS MAY BE INSTALLED BY SAWING A TWO INCH WIDE SLOT IN THE FIRST LAYER, DIG OUT THE ASPHALTIC MATERIAL AND BASE COURSE, PLACE THE LOOP, FILL THE SLOT WITH BASE COURSE MATERIAL AND NEW ASPHALTIC MATERIAL AND TAMP THE ASPHALTIC MATERIAL IN PLACE.


SHOULD TRAFFIC BE ALLOWED TO USE THE AREA OF ROADWAY WITH THE NEWLY INSTALLED LOOP BEFORE THE PLACEMENT OF THE NEXT LAYER OF ASPHALTIC PAVEMENT, THE SLOT SHALL BE SEALED AS STATED IN THE SPECIAL PROVISIONS.

DRIVE A 11/2" MAX. PK NAIL INTO THE NEW ASPHALTIC PAVEMENT AND DIRECTLY ABOVE THE CONDULET AFTER THE FINAL LAYER OF NEW ASPHALTIC PAVEMENT IS COMPLETELY INSTALLED, IF REQUIRED BY THE DISTRICT TRAFFIC SECTION.

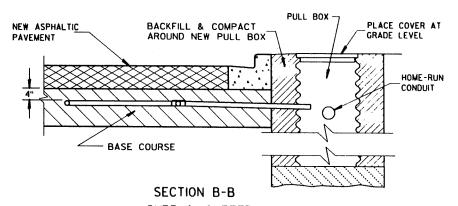

CURB & GUTTER

LOOP DETECTOR INSTALLATION DETAIL

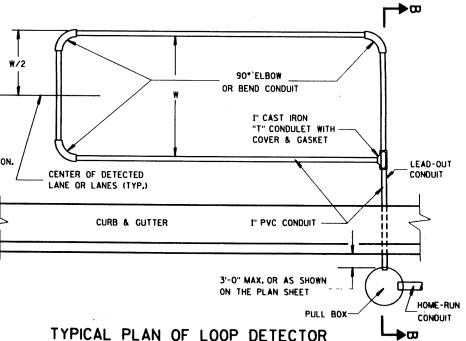

LOOP DETECTOR PLACED
IN CRUSHED AGGREGATE BASE
(NEW ASPHALTIC PAVEMENT)

STATE OF WISCONSIN
DEPARTMENT OF TRANSPORTATION

APPROVED

ALALAS


ALALAS

STATE ELECTRICAL ENGR FOR HWYS

STATE TRAFFIC ENGINEER FOR HWY

21/93 g

S.D.D. 9 F 8-1

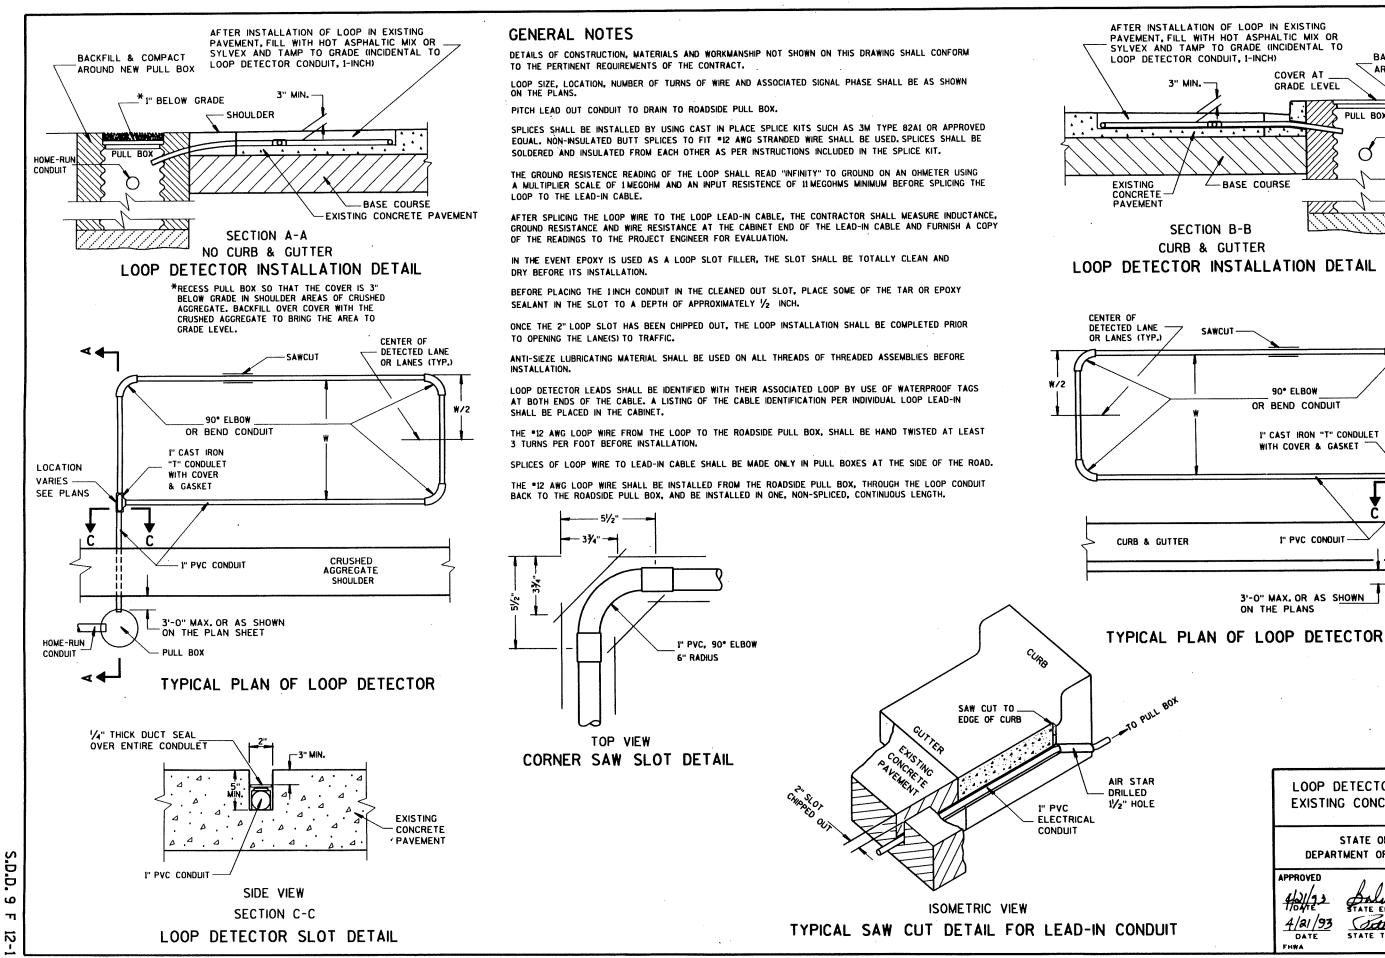

BACKFILL & COMPACT

AROUND NEW PULL BOX

HOME-RUN

LOCATION

SEE PLANS

-VARIES

CONDUIT

LOOP DETECTOR INSTALLED IN

EXISTING CONCRETE PAVEMENT

STATE OF WISCONSIN

DEPARTMENT OF TRANSPORTATION

STATE ELECTRICAL ENGR FOR HWYS

Sotta Surch

-PULL BOX

CONDUIT

COVER AT


90° ELBOW


1" PVC CONDUIT

**APPROVED** 

GRADE LEVEL

**PULL BOX** 

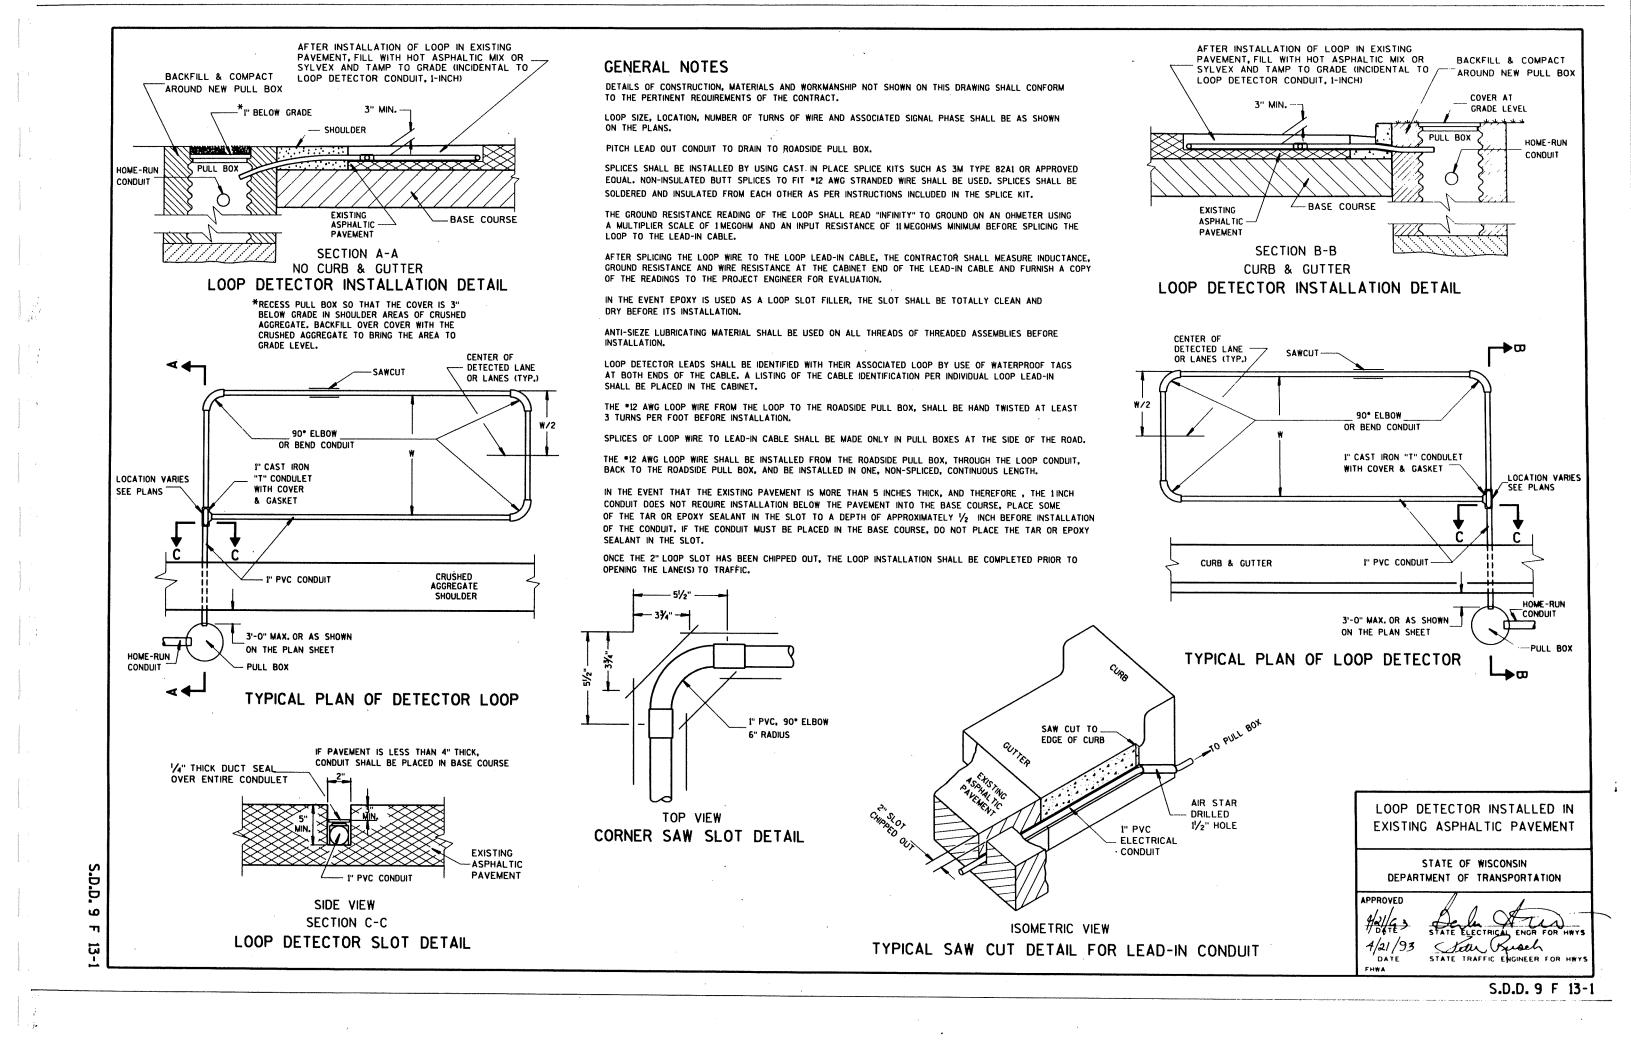


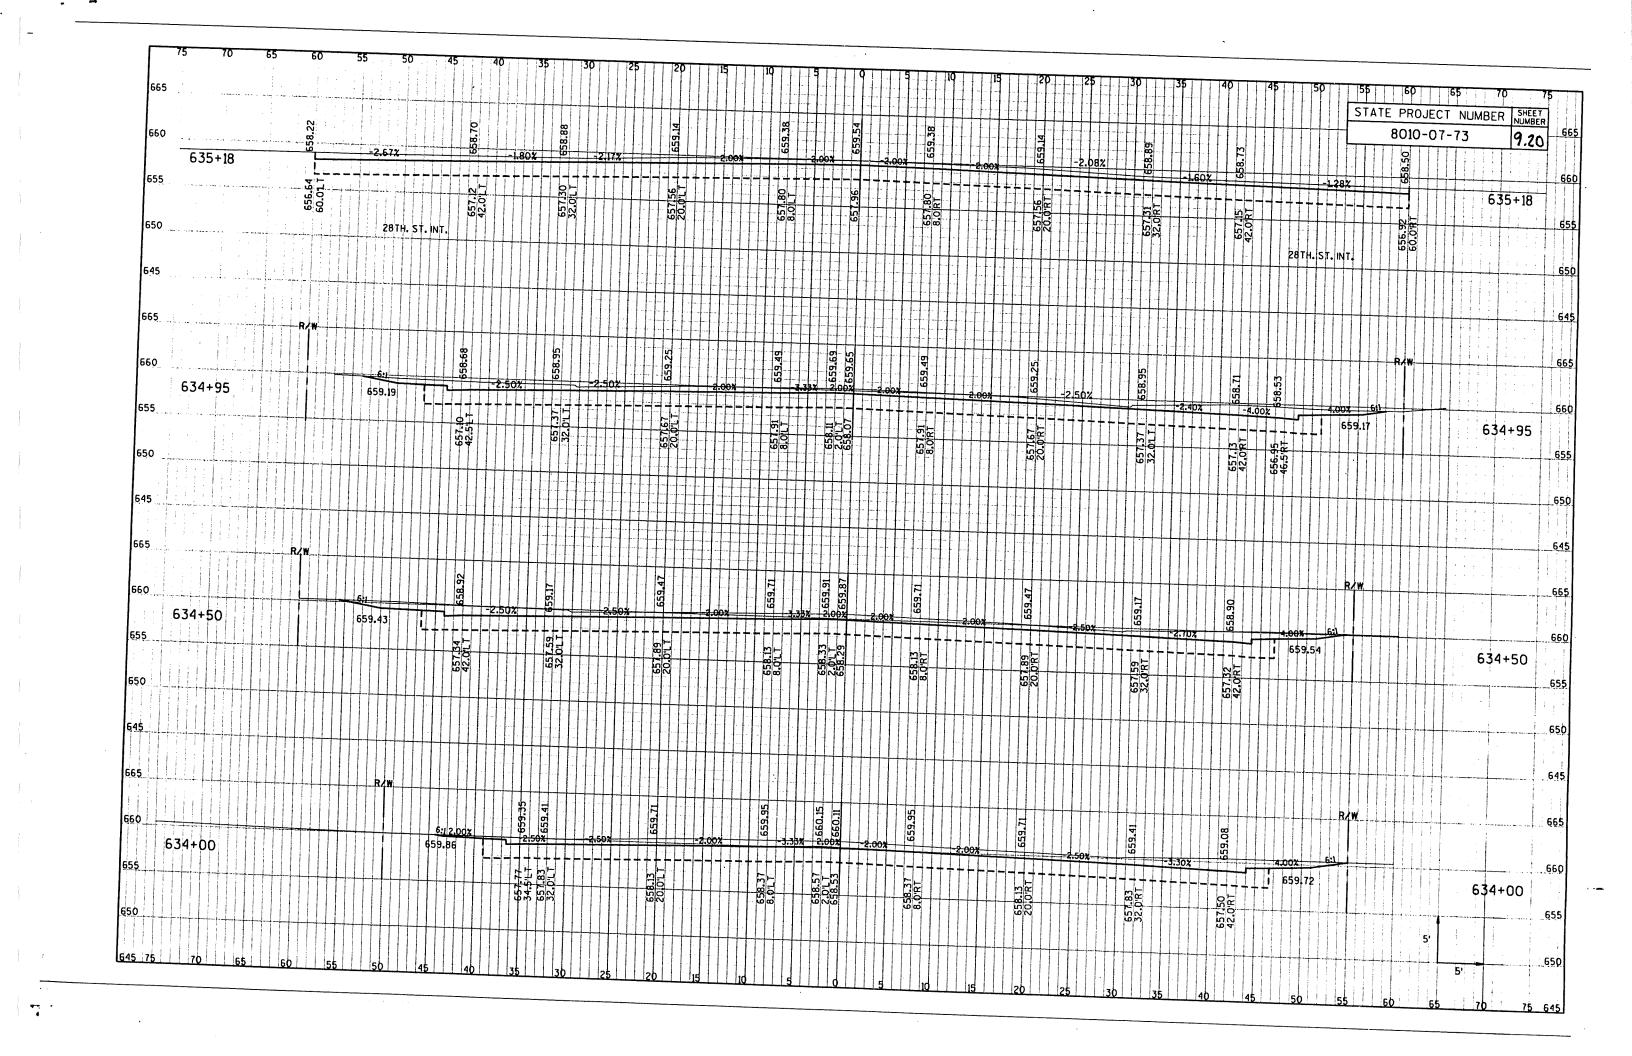



STATE PROJECT NUMBER SHEET NUMBER 8010-07-73 9,21 655 637±17\_\_ 655 637+00 636±50 636+50 655 655 635+93 635+93 655 657.57 8.0° T \_635±66 28TH. ST. INT. 28TH. ST. INT.


STATE PROJECT NUMBER SHEET NUMBER 8010-07-73 9.22 657.52 655 639±00 639+00 655 655 638+50 638+50 655 655 638+28 657.87 638+28 655 660 655 638+00 658.00 656.45 8.0'RT 638+00 655 650 655 637+50 658.24 656.45 I 20.0'RT I 656.15 | 32.0°RT | 637+50 655 650 5, 650

1131

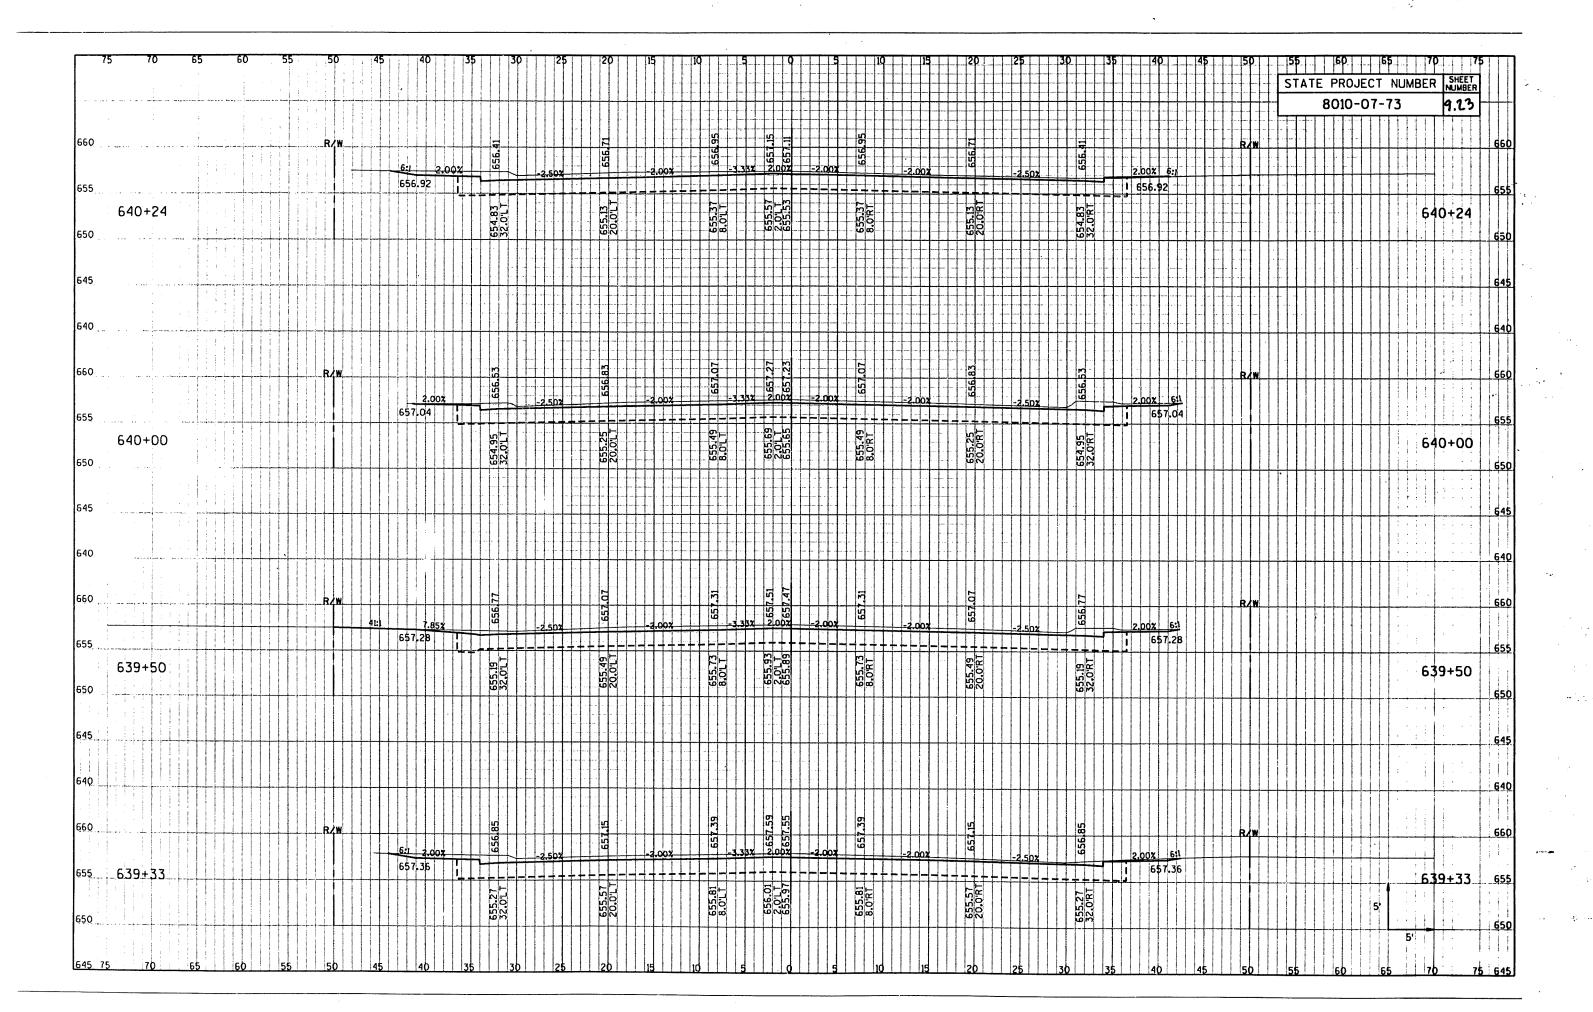


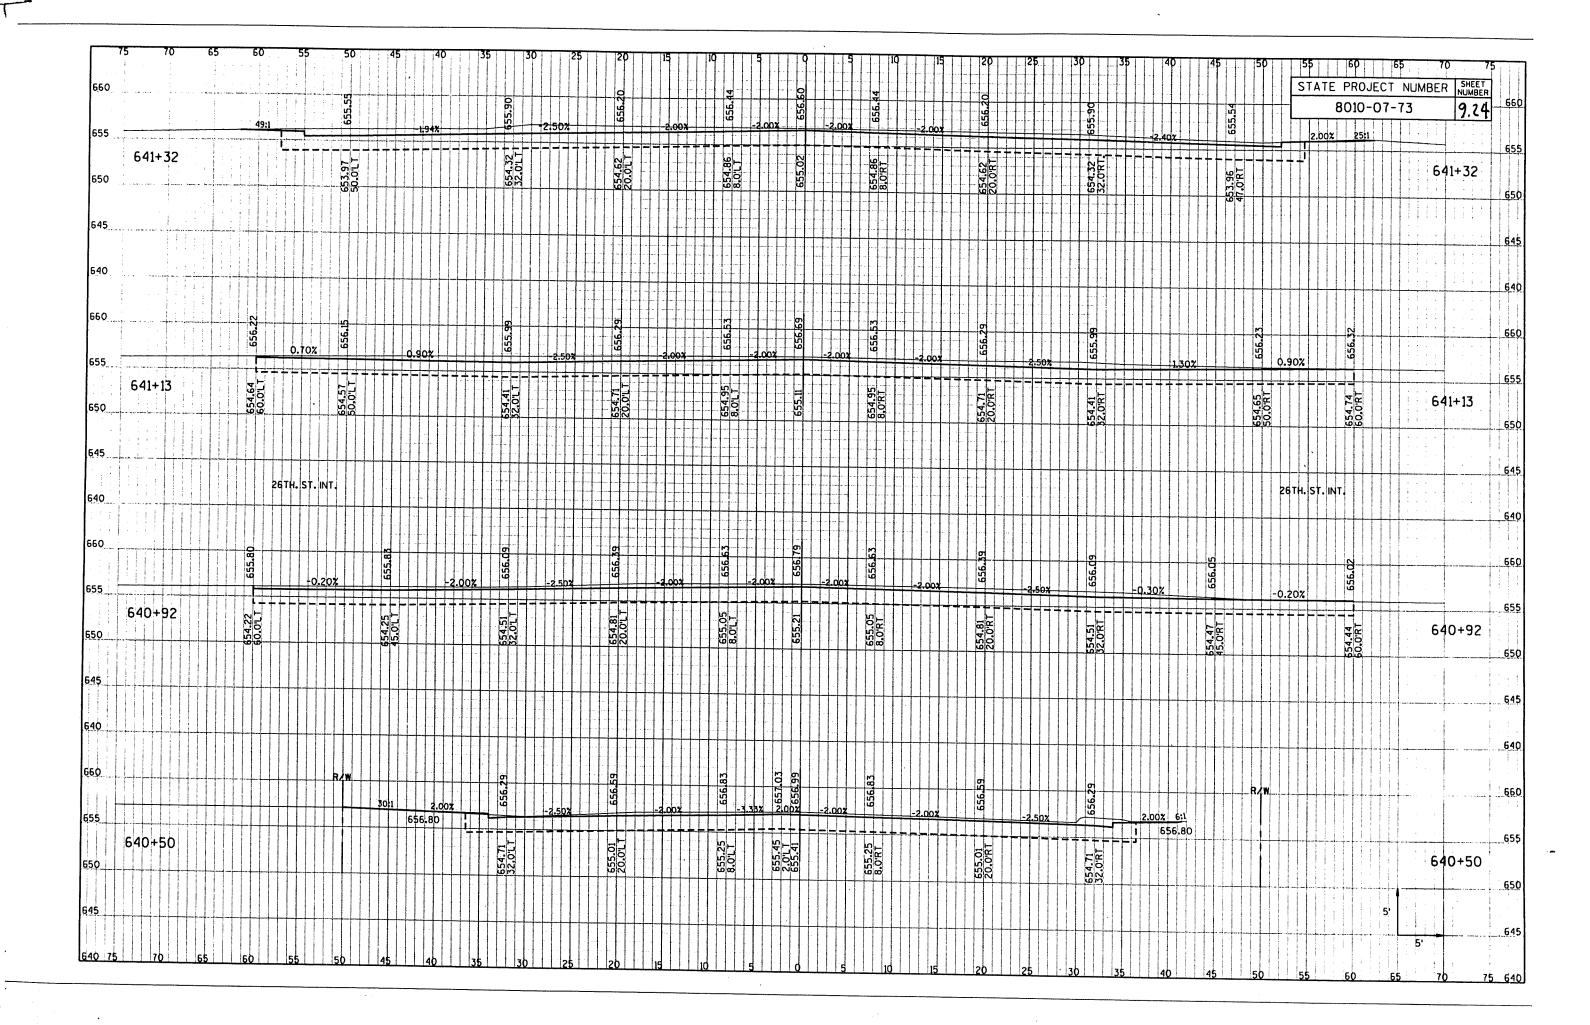

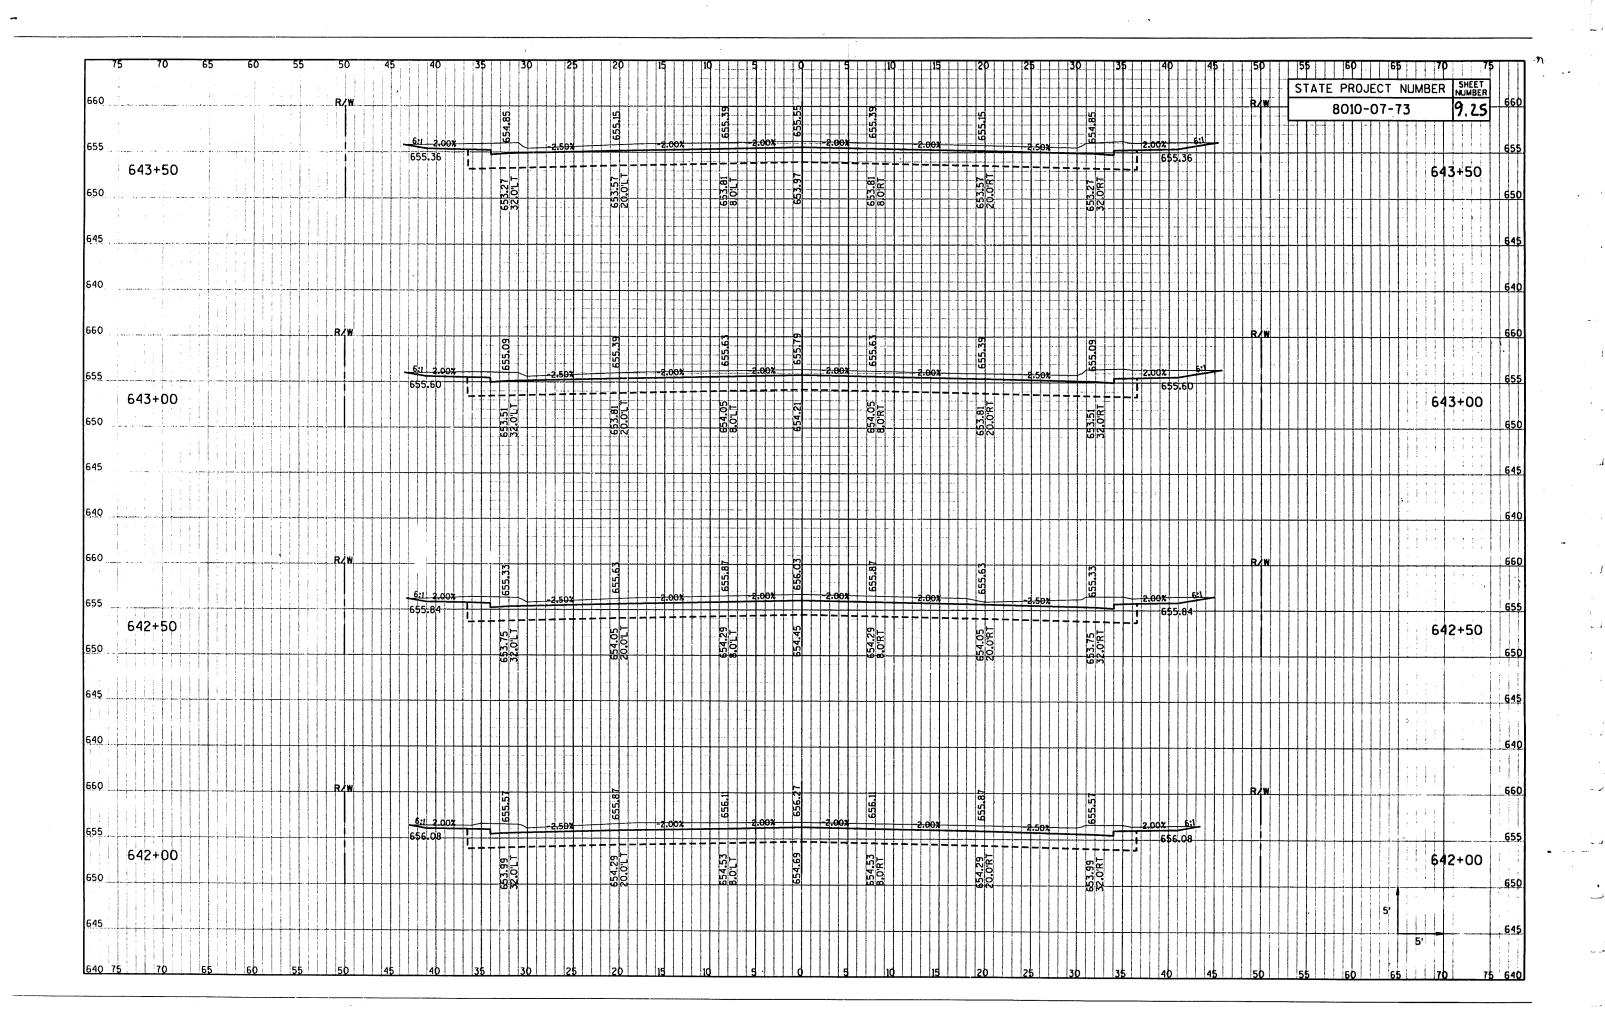

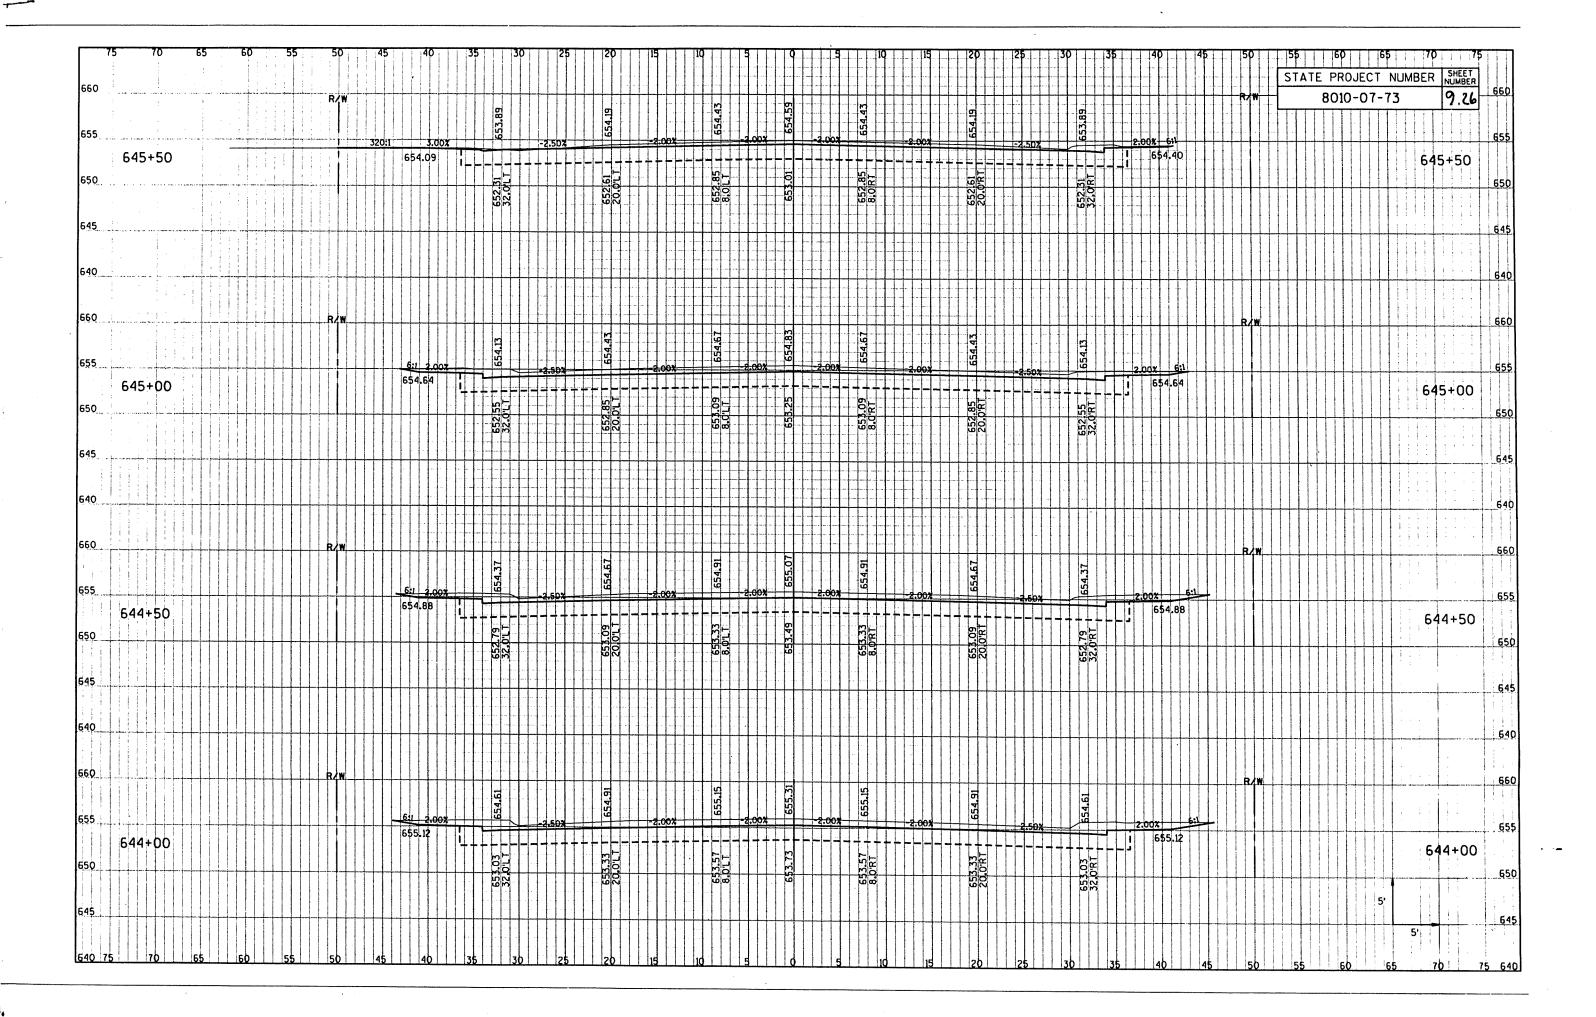



STATE PROJECT NUMBER NUMBER 8010-07-73 9.27 653.45 647+50 650 650 647+50 651.39 40.0°L 647+01 647+01 24TH-ST-INT-24TH. ST. INT. 646+62 650 646+62 646+57 650 650 646±57 646+00 | 650 650 646+00

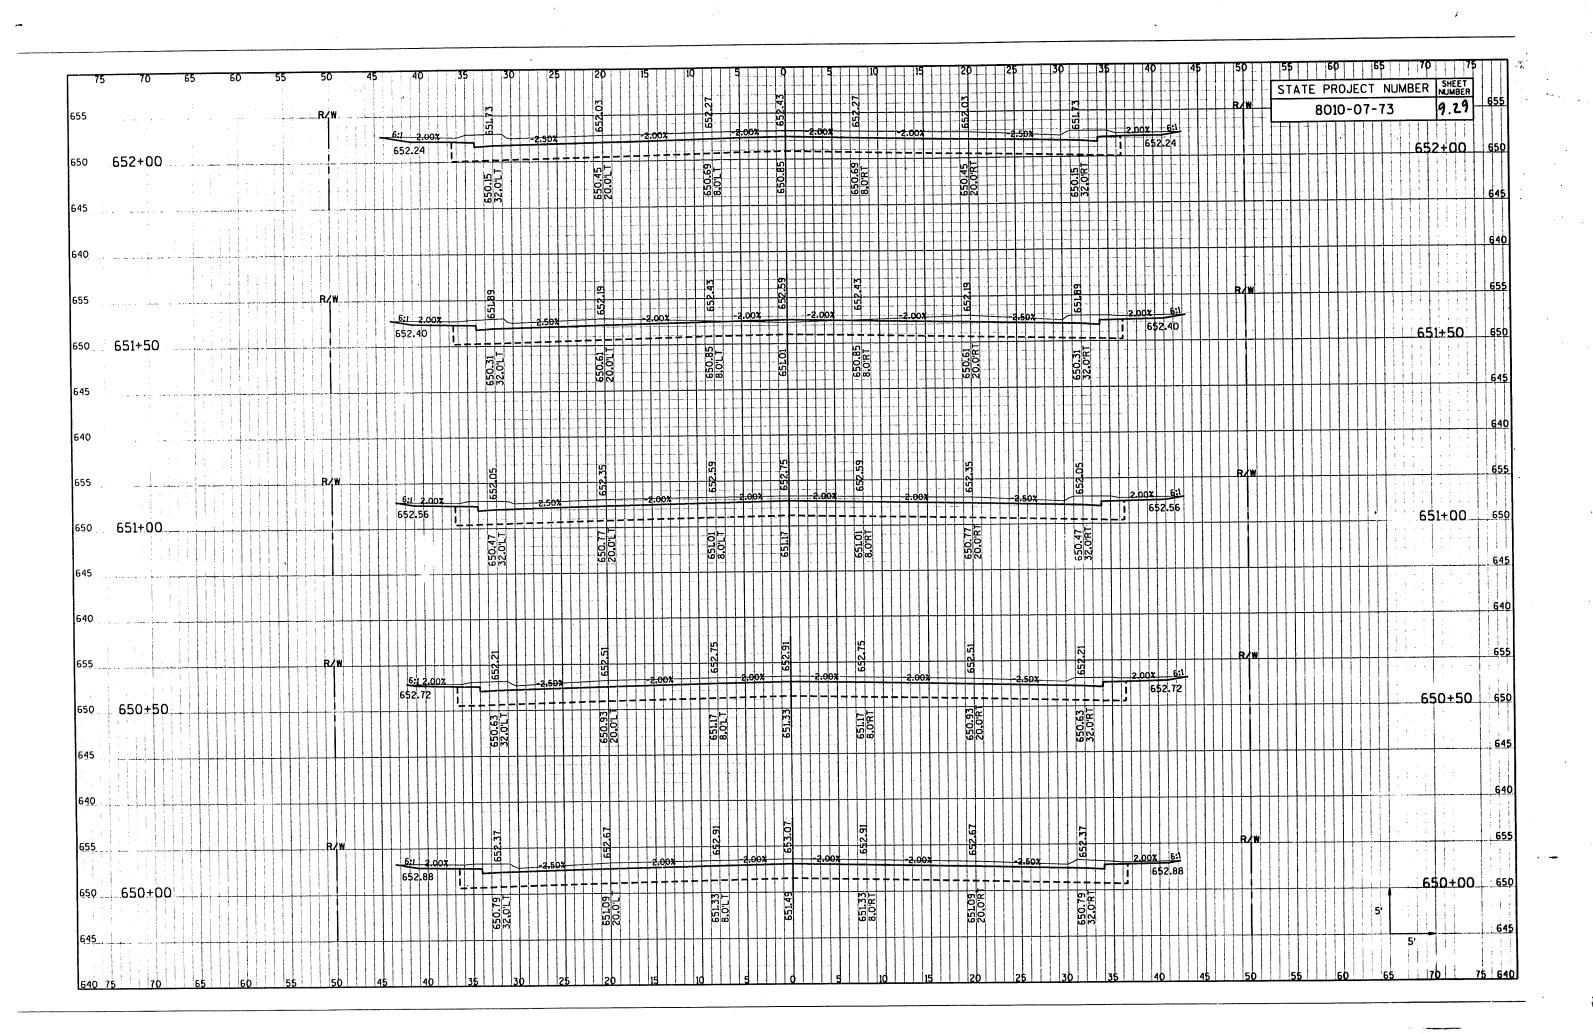


STATE PROJECT NUMBER SHEET NUMBER 8010-07-73 9.30 652.09 653+50 653+50 651.93 649.87 49.0'L T 653+04 653+04 645 652+85 652+85 23RD, ST, INT. 650.08 58.51. T 650.01 44.0'L T 650.58 8.0"L.T 652+66 649.94 32.0'RT 652+66

· \_\_

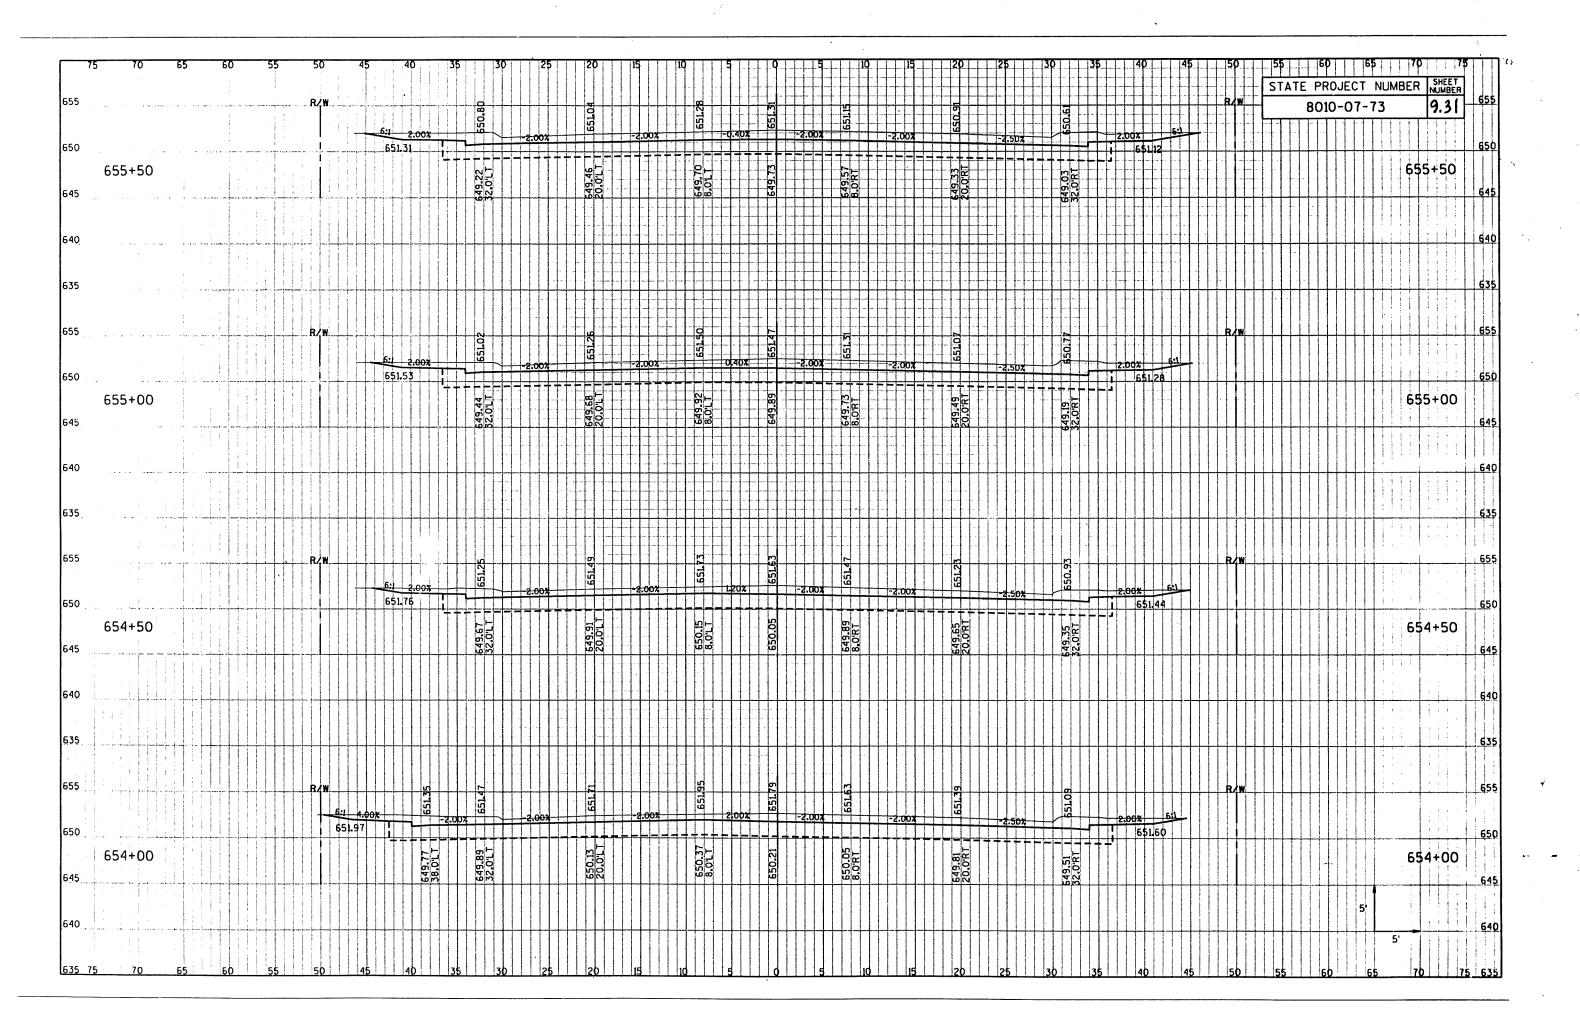


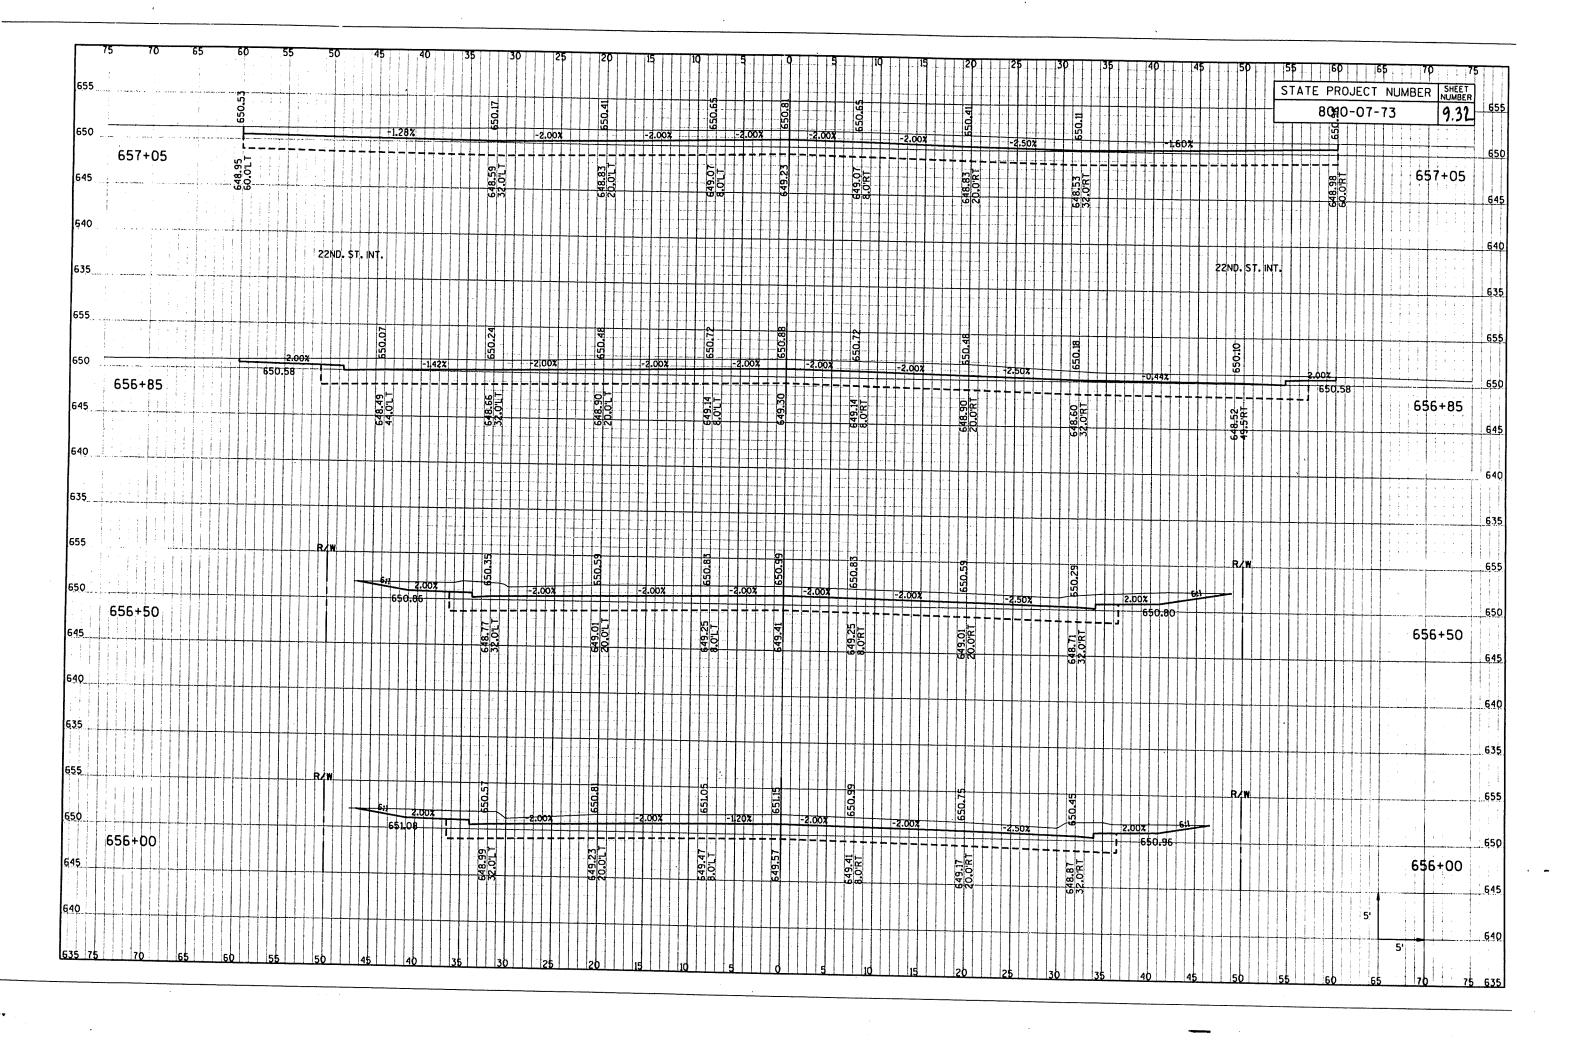


٠,

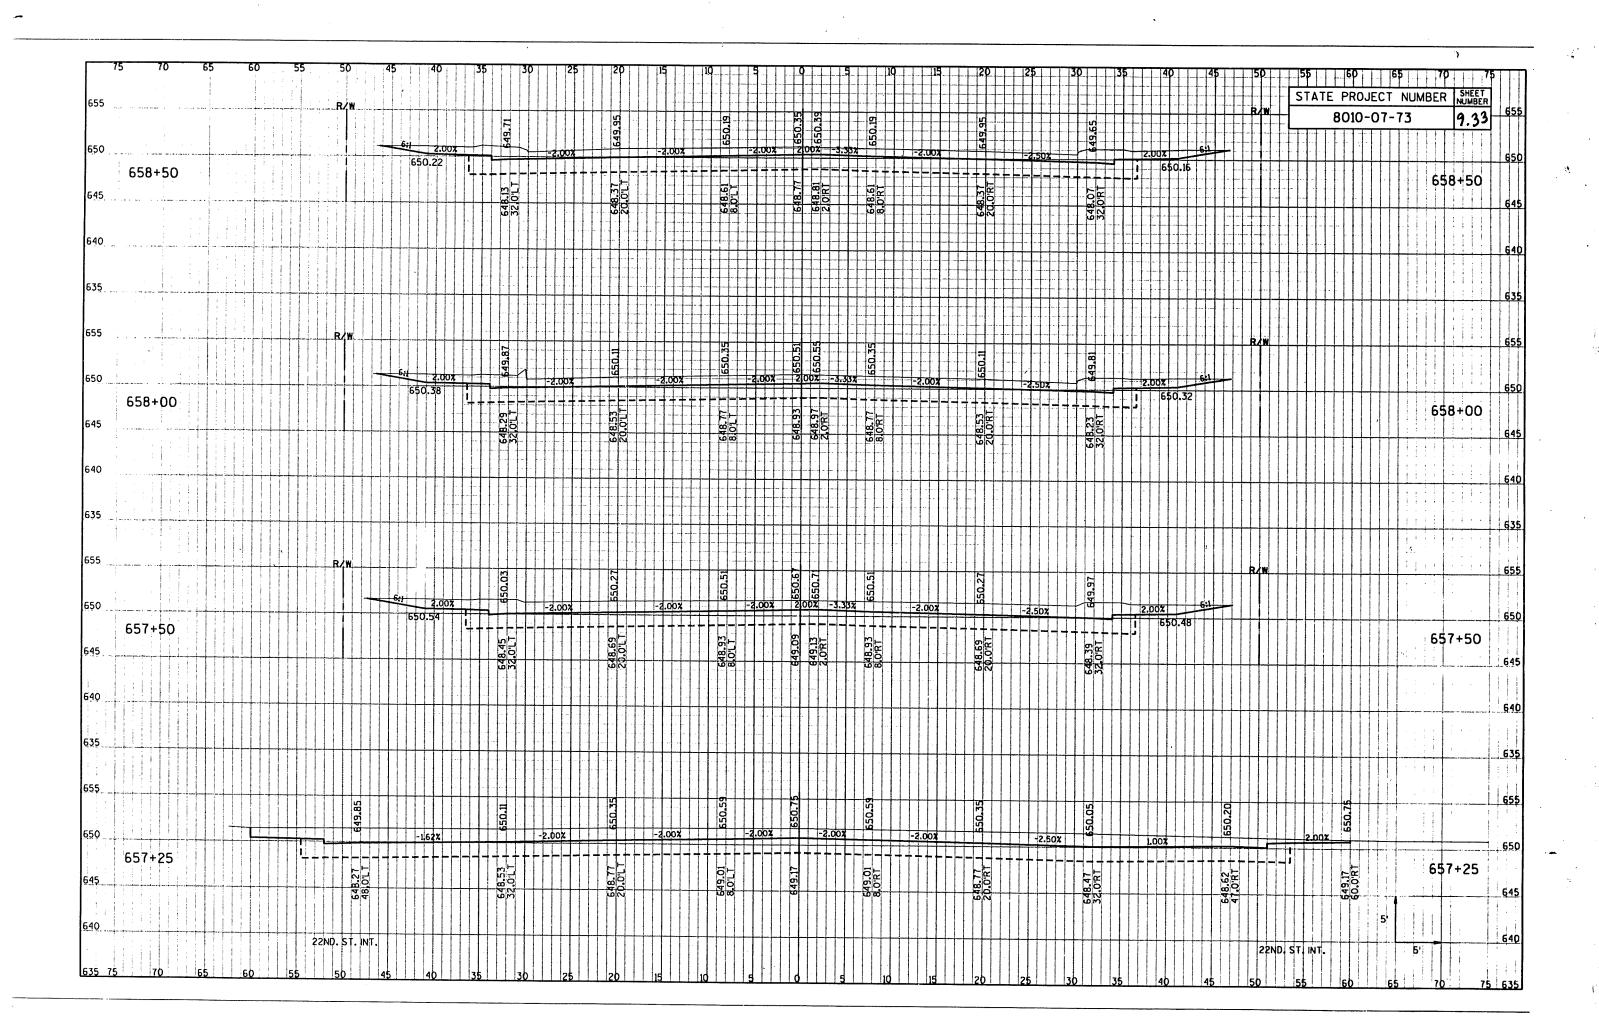



STATE PROJECT NUMBER SHEET NUMBER 8010-07-73 9.34 650.35 660+50 660+50 635 660+00 660+00 635 640 635 655 659+50 659+50 659+00 650.00 650 647.91 32.0'RT 659+00 640

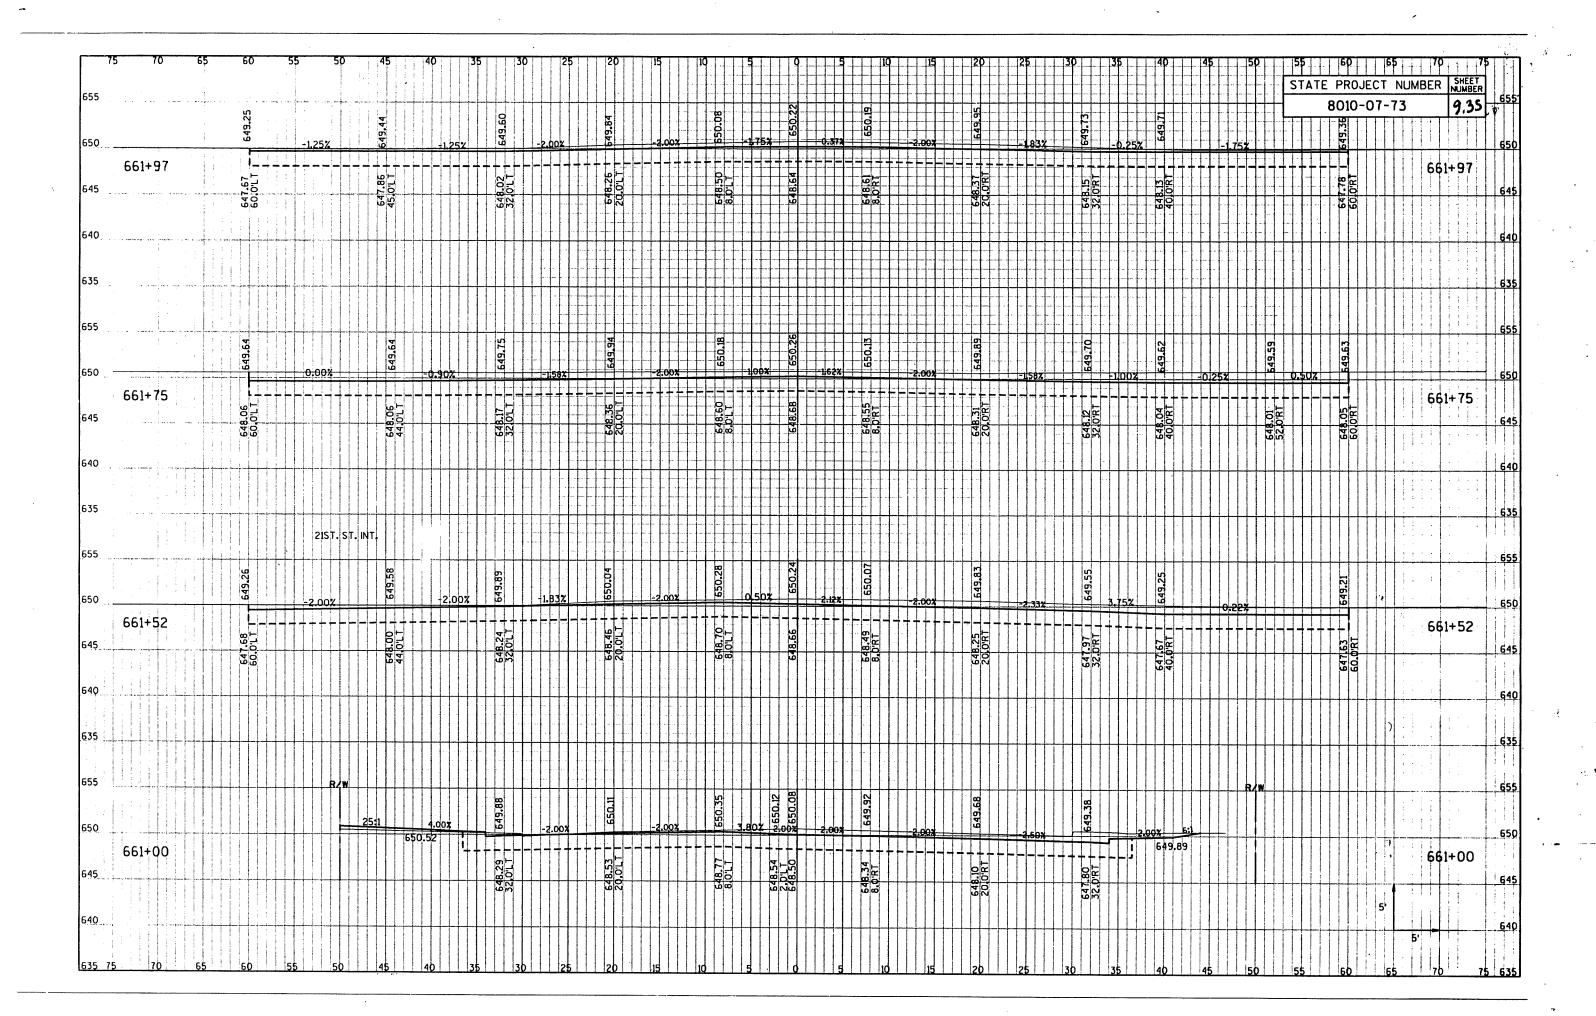

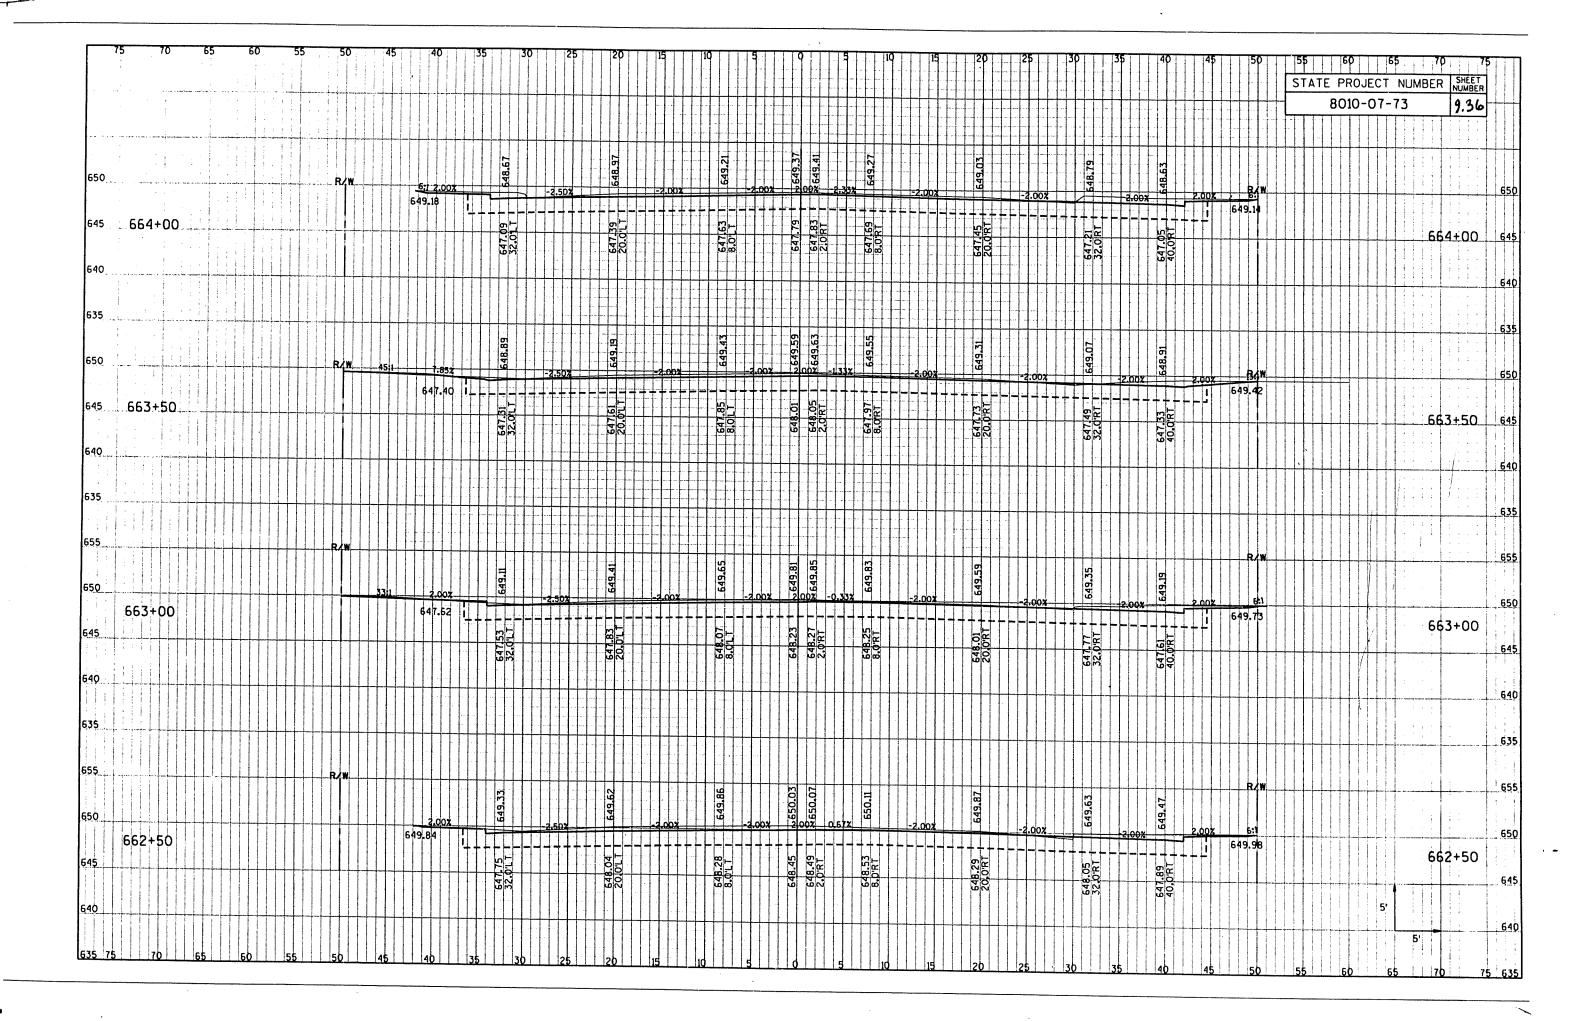

STATE PROJECT NUMBER SHEET NUMBER 8010-07-73 645 665+00 645 665+50 .... 665+00 645 664+66 664+66 645 645 664+50 664+50

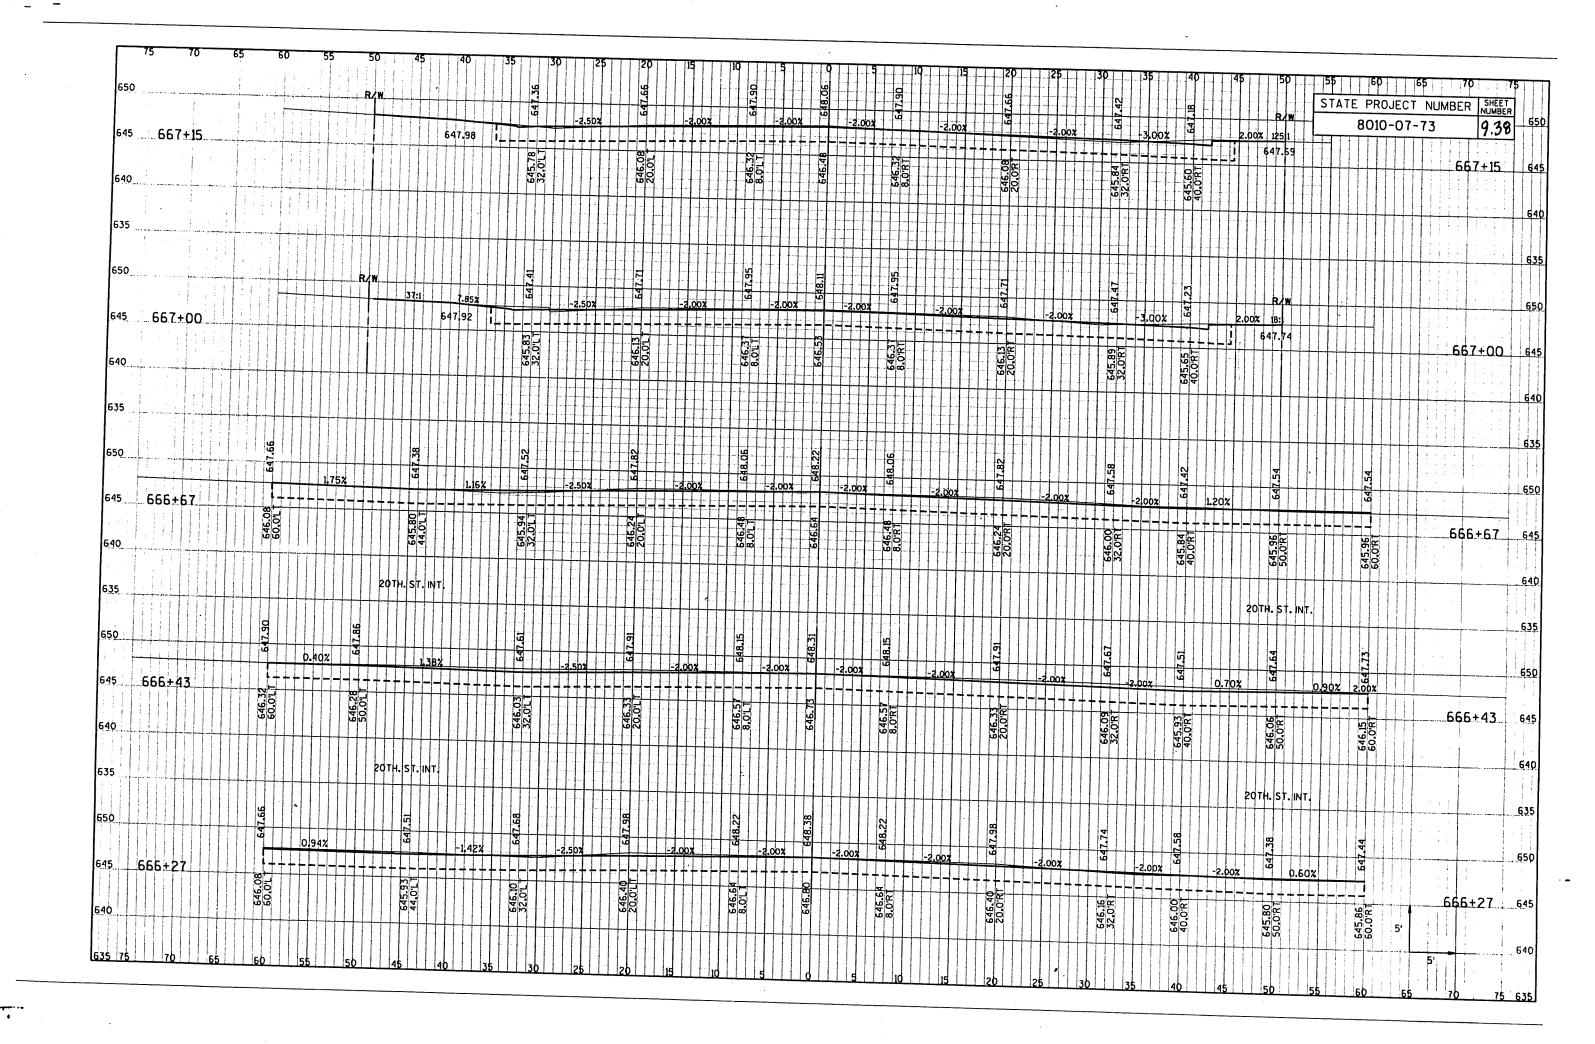


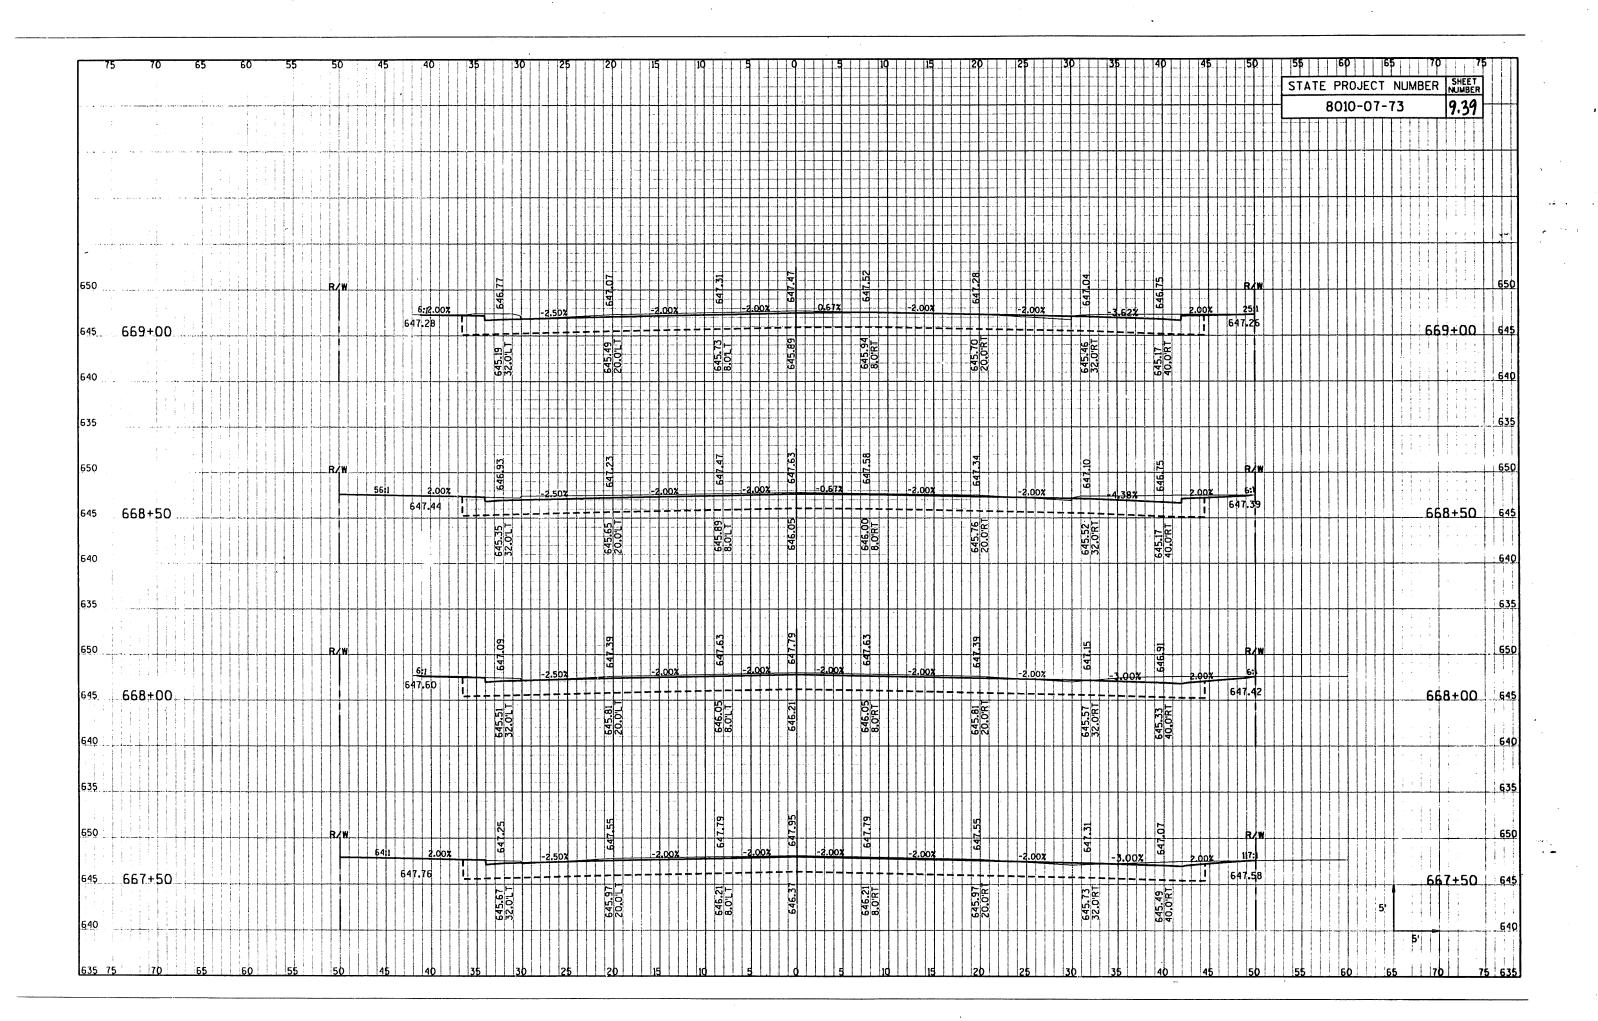

75 70 650	65 60 25	5 50 45 84.54		30 25 20 70 90	0   15   10	646,78	01779	15 20 25 89 99	30 35	40 45	STATE PROJ	65   70   75    ECT NUMBER   SHEET NUMBER   650
645		2.00%	2,00%	-2.50x	-2.00X	-2.002	2002	-2.00x	-1.	50% 0.40%	0.30%	
670+66 <sub>640</sub>	645.22 60.0'LT	644.90 44.01	44.0'LT	644.96		645.20 8.0" T	645.52 8.0°RT	645.28 20.08TT	645.04 32.01RT	644.92 40.0'RT	50.0'RT 50.0'RT 644.99	670+66
635												635
630		19TH. S.T. INT.									19TH. ST. INT.	630
650	646.46	46.20	646.30	46.60		645,84	41.16	25		3.56	29	650
645		1.62%	-0.84%	-2,50%	-2.00%	-2.00%	2,00% -2	00% -2.00%	646.	50% -1.90%	646. 646.	
670+46 640	644.88 60.0L T	644.62 44.01.T	644.72 32.0°LT	645.02		645.26 8.01.T	645.58 8.0RT	645.34 20.0RT	645.10 32.0RT	644.98 40.0RT	50.08T	670+46 640
635												635
650 650		3/W				σ						630
645		125:1	2.00x 44 9 9 9 9	-2.50X -2.5-	-2.002	-2.00x 6	2,00%	00x -2.00x -2.00x C C	-1.		R/W 15:	650
670+00			644.87 32.0'LT	645.17		645.41 8.01 T	645.73 8.0RT	645.49 20.087	645.25 32.0'RT	645.13 40.0'RT	647.22	670+00 640
635												640
630												630
650		R/W 80;1	3.00% 59 64 16	-2.50%	-2,002	647.15 8 9 647.31	2,00% -2.1	647.23	646.99	46,86	R/W	650
645			647.12						<del>                                     </del>		<u>B:1</u> 7.50	
669+50			645.03 32.0\text{T}	645.33 20.0°		645.57 8.0'L T	645.89 8.0'RT	645.65 20.0RT	645.41 32.0'RT	645.28   40.0°RT   4		669+50
635												5' 635
630 75 70 6	5 60 55	50 45	40   35   36	25 20	15 10	5 0	5 10	15 20 25	30 35	40 45	50 55 60	55 70 75 630

:

)		65		ьи	5	•	50		45		40		35	30	)	25		20		15		10		5	Q	+	5		10	1		20		25		30	3	<b>12</b>	40		4P		- 0		STAT	TE F	ROJE	ECT N	NUMB	ER N	SHEET UMBER	
				· ·	:		R/Y	<i>i</i>	<u></u>	<u>-</u>	ļļ			6	444	444	4	27			111	1	<b>3</b>	-   -	19	#		5.83		##	##	15	###	<del>       </del>		<u> </u>		##	17	111			R/W	$\bot$	•			07-7		5	9.41	Н
		ì		1	: 1		1			10.4				645.				646				6.45	6		7.2		007	64			]	548	111			646	$\Box$	1-1-1-	F46	++1	2.00%	37.		-   -	11-1-	111	-111	1 1 1	1	T		ĺ
			····•				$\dashv$			10:1		+++	+∟	-	-2,	50%	++	++-	H	-2.00	X :		Ħ	-2,002	訷	+ 4	UUA	Ħ		-2.00	##	##	##	-2.00	) <b>X</b>			1150	*++	++	1	1416			111	1-1-1	111	+++			H	
67	1+50					1 1						1	1	39 - 1⊤ 1				644.69 T				203	8.0'L.T		0.03			5.25 9.RT				- 100	۲ ک			Į,	O'RT.		344,65			646	74					-		671+	50	
	a soletina and a			-		******								644.39 32.0'L T		$\frac{1}{1}$		20.		-		- 79	8		64	#		64				64	3			644	32.		644	40,						_		+++				L
	1		, .				Hamilton Communications.				- 1											#				#																										
	e de la merca de la merca de la merca de la merca de la merca de la merca de la merca de la merca de la merca d La merca de la merca della									-				TOTAL PROPERTY OF THE PARTY OF														<u>†</u> † † † † † † † † † † † † † † † † † †																								
•							_B/¥							ri,				6.43				7	o o		6.83			46.99				6.75				15.5			6.39				R/W							<u> </u>		
							-		15;	646	.64			646	-2.	502		64		-2,00	*	77		2.002	9	2	00%	ů.		-2.00	*	29		-2.00	2	7	-   -   -   -   -   -   -   -   -   -	-1.50	0X 8		2.00%	546	.90									
67	1+00													2.0'LT T		<b>†</b> † †		44.85 P				45.09	10°		645.25			645.41 8.0'RT				645.17	N.O.			644.93	52,0'RT		344.81	0.0'RT									of colors to colors	671+	00	L
														u m				W.Q																		3			·	7												
•	# 10 mm	***																																																		
	The state of the s						***************************************				the state of the s																																									
							R/Y		00%		645.95			646.15				646.46		-3.00	الد	CAE 70	77 aba	-2.002	646,86	2	OOZ	647.0		-2.00	x	646,78		-2.00	02	545. 54	-	50%	646.42	3.50	646.28				***************************************							
								46.46		<del> </del>	<b>1</b> +						##-								  8			44				0									++	<del>-</del>	<u>.</u>			64	16.82			$\pm$		and the same of the same of
67	0+90							TATALOGRAPHICAL PROPERTY OF THE PARTY OF THE			644.37	J 0.66		644.58 32.0'L T	-			644.88 20.0'L				645 8	8.0'L		645.2			645.44 8.0'RT				645.20	70°07			644.9	32.0'RT		644.8	40.0'RT	644.70 44.0'RT									670-	+90	-
																																		-																		-
			The second of the second		***************************************		***************************************										- 1					-				***************************************		***************************************							***************************************		***************************************								***************************************						a de la companya de l	
																																																		The state of the s		
				646.46				***************************************	646.12					646.17				645.47				EAC 71	04b,//	<del>                                      </del>	646,87		002	647.03		-2.00		646.79				646 55			646,43	T			646.23				546.29					4
					4	2.1	3%	111	##			142%	#		-2. 	5D2	#			-2.00	#			-2.002					##	4.00				-2.00	JZ			.50%		<b>.</b>	-2.0	00%	#-	0.6	0%							***************************************
67	70+86			60.0'LT					544.54	44,0'L T				644.59 32.0'L T				644.89 20.0'L T				51 583	8.0'LT	***************************************	645.29	171.6.6.6.6.6.6.6.6.6.6.6.6.6.6.6.6.6.6.		645.45 8 0'RT	<b>X</b>			645.21	70 <b>,</b> 07			644.97	32,0'RT		644.85	40,0'RT			644.65 50.0'RT			***************************************	644.71 60.0'RT			670-	+86	!
																	***************************************		concentration of the contract							***************************************		***************************************							***************************************					***************************************						***************************************		5'	de company consequent	1.000000000		
5	70	65	Andrew Park					19	гн. s	T. INT														***************************************																		19ТН.	ST. IN	IT.					5'		76	

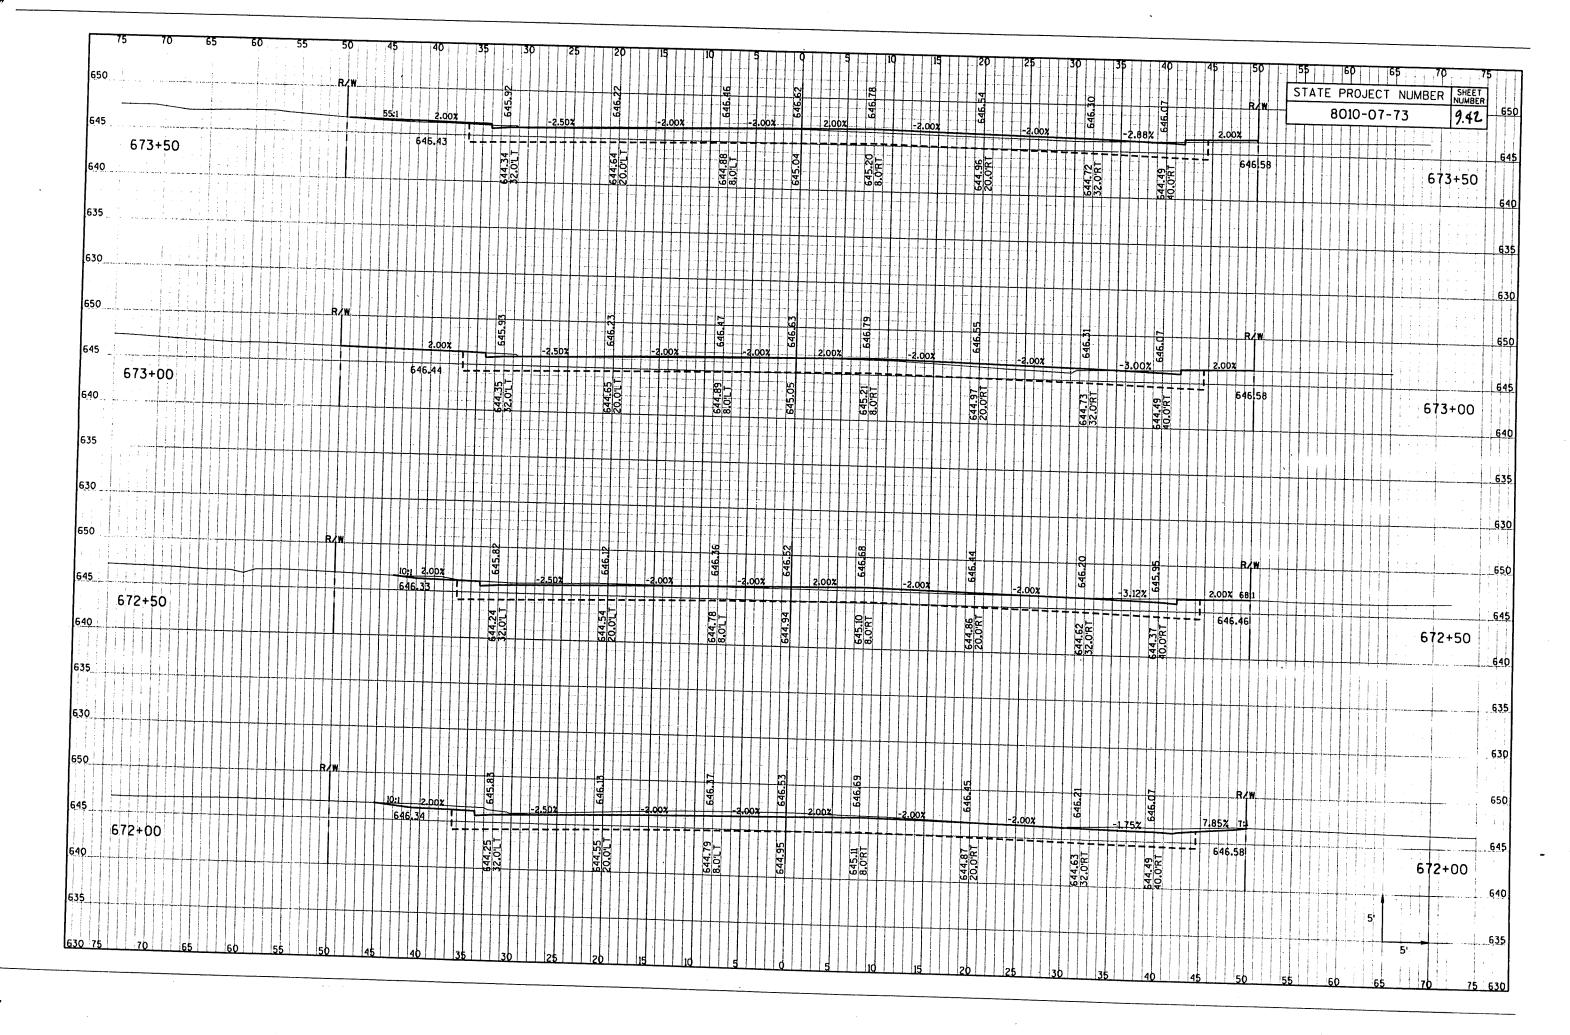


STATE PROJECT NUMBER SHEET NUMBER 8010-07-73 675+50 3.61 .0'L T 675+00 44.20 2.0'RT 675+00 674+50 674+50 645.04 8.0'RT 674+00 674+00


13 TO RE 28


5 70 65	60	55	50 R/N	45	40	3	5	30	25		20	1	â	110		5	6		5	10	15		20	25		30	35	40		45	50 R/1	S	TATE	PROJE	ECT NL	JMBER	SHEET UMBER
							644.4		-2.50%		644.7		.00%		644,9	4.00%	645.2	3.00	645.		-2.00x		645.2	-2.0	0%	645.05	-2.50	× 644.85							71-13		). 44 65 64
677+50					ь44.94						643.15 20.01.T			<del></del>			643.71		643.95	a or			643.71 20.0'RT			543.47 52.0'RT		43.27	200		645.17					677-	
										-																		9					0111 (1111) (1111) (1111) (1111) (1111) (1111) (1111) (1111) (1111) (1111) (1111) (1111) (1111) (1111) (1111)				63
																																					63
			3/W				4.59				14.89				15.13		45.45		45.77				15.53			5.29		5.13			R/I			***************************************			65
677+00						*	1 64		2.50%		1 64	<u></u>	.002		ς 	4.002	9 1 2	4.00%	4+	+++	-2.00x		RT 6.	-2.0	ox 	####	- - -	444		1	645.1					677+	-OO
											643.3 20.01				8.0'L		643.		644.				20.0			643.7 32.0'R		643.55	( ) ( )								64
																					-																63
		R	<b>W</b>																6																THE THE THE THE THE THE THE THE THE THE		63
				10:1	15.30		644.79	-	2.50%		645.09	-2.	.00%		645.33	3.50%	645.61	3,50%	645.8		2.00%		645.65	-2.0	0%	645.41	-2.50%	645.21		3.00%							65
676+50							m				643.51 1 20.0'LT 1			3.4	8.0.7		644.03		644.31				644.07 20.0'RT			843.83 82.0'RT	-   -   -	43.63		64	15.79					676+	-50 -64
																										0		9									63
																																					63
		R	<b>/W</b>				4.99				15.29				ccc		45.77		46.01				15.77			5.53		.30			R/¥						65
676+00				25:1 64!					.50%		ğ     	-2.	002			00%	já	3,00%	13 6		2.002		24 H	-2.00	x 	645		<b>-</b>	III.	852 i	9: 645.81						64
							643.41 32.0'L				20.01			9 8 8 9	8,0'.		644.1		644.4			64.40	20.0'F			643.95 32.0'R]		643.72 40.0'RT								6 (6+	-00 64
					111			111		111	$+ \downarrow \downarrow$	-																				-			5'		63
Comparisonment of the contract	676+50	676+50	677+00 676+50	677+00 676+50	677+50  R/W  3th  575+50  R/W  25th	677+50	677+50	677+50  R/W  Baye  644.94  R/W  Baye  675+50  R/W  Baye  645.10  R/W  Baye  675+50  R/W  Baye   677+50  -2.00X  -3.00X   677+50  -2.00x  644.94  -2.50x   677+50  677+50  677+50  677+50  677+50  677+50  677+50  677+50  677+50  677+50  677+50  677+50	677+50  -2.00x  -3.50x  -2.50x  -3.50x   677+50  684,94  867  878  878  878  878  878  878  87	677+50  684.94  1. 1. 1. 1. 1. 1. 1. 1. 1. 1. 1. 1. 1. 1	677+50  -2.00x  -3.00x   677+50  644.94  87  87  87  87  87  87  87  87  87  8	677+50  644.94  330 2.003  677+00  646.50  1.00  675+50  675+50  675+50  675+50	677+50  -2.00x  -3.00x   -2.00x	677+50  -2.00x  -3.00x   677+50    1	2.00x	677+50  -2.00x   577+50	577+50  -2.000	577+50  -2.000  -3.000	677+50    1	677+50    Control   Contro	677+50    1	677-50    1	677+50    2,001   9	677+50	677-50  676-60  676-60  676-60	677-50 \$ 1 1 1 1 1 1 1 1 1 1 1 1 1 1 1 1 1 1	677-50	677+00 (46.9) (4	676-00   100								

-

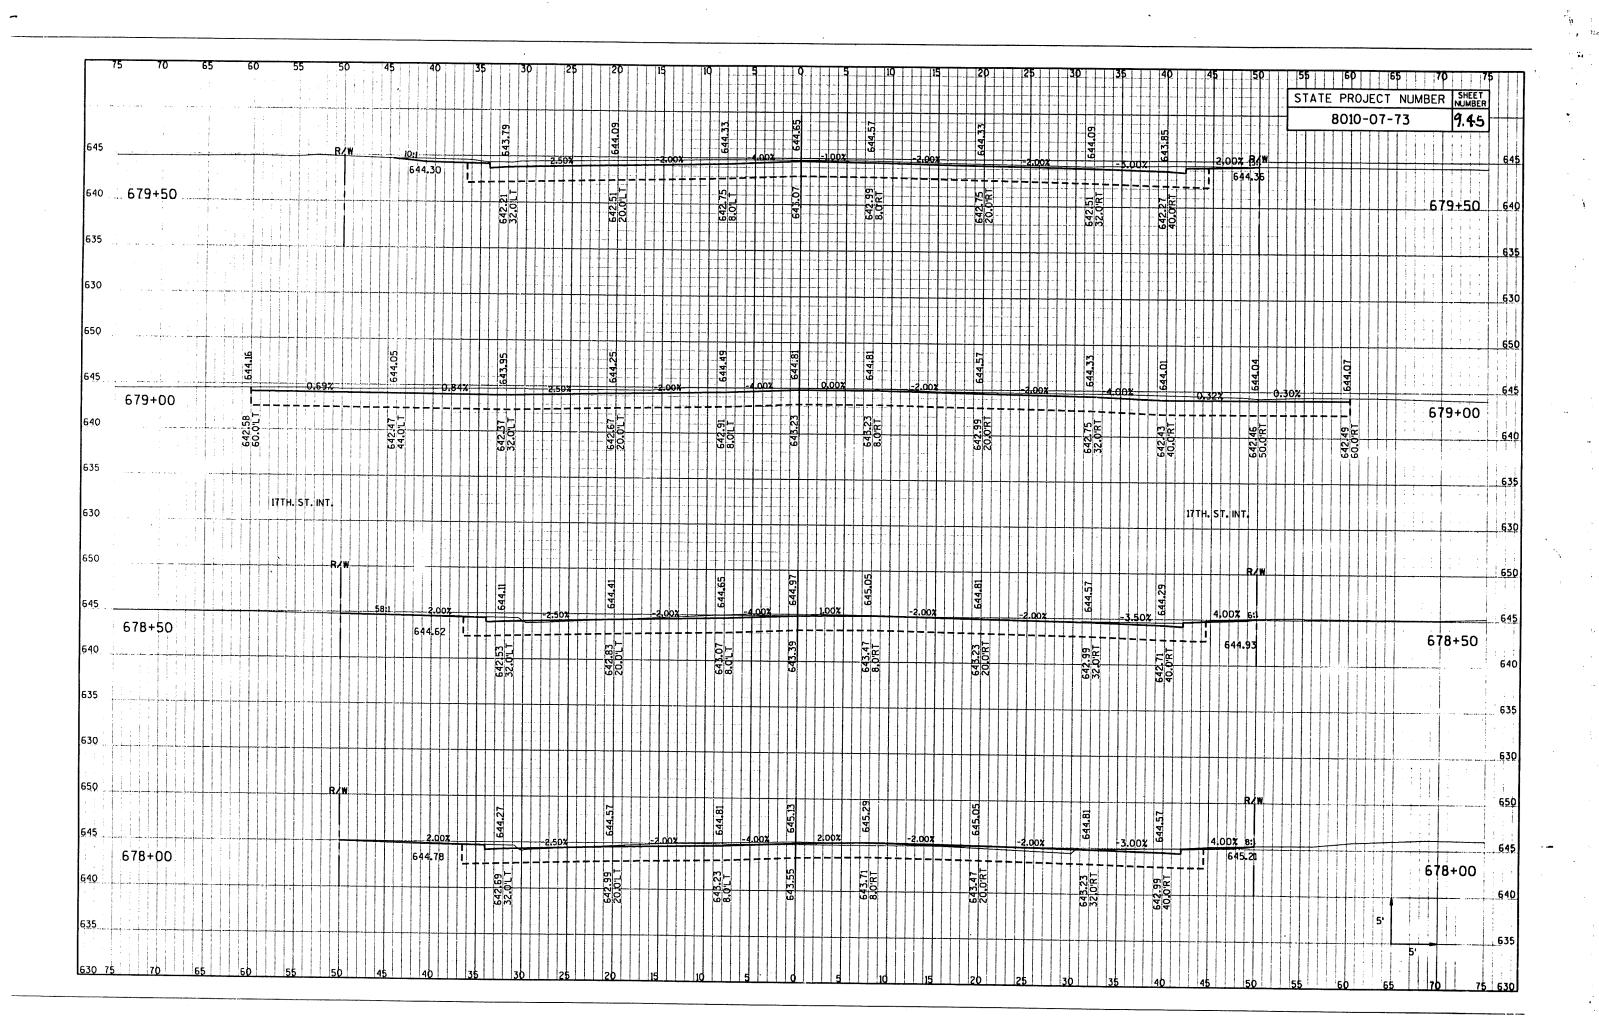

STATE PROJECT NUMBER SHEET NUMBER 8010-07-73 640 682+00 \_\_\_ 640 681+50 681+50 640 645 640 681+00 680+50 640 645 640 680+00 680+00 640

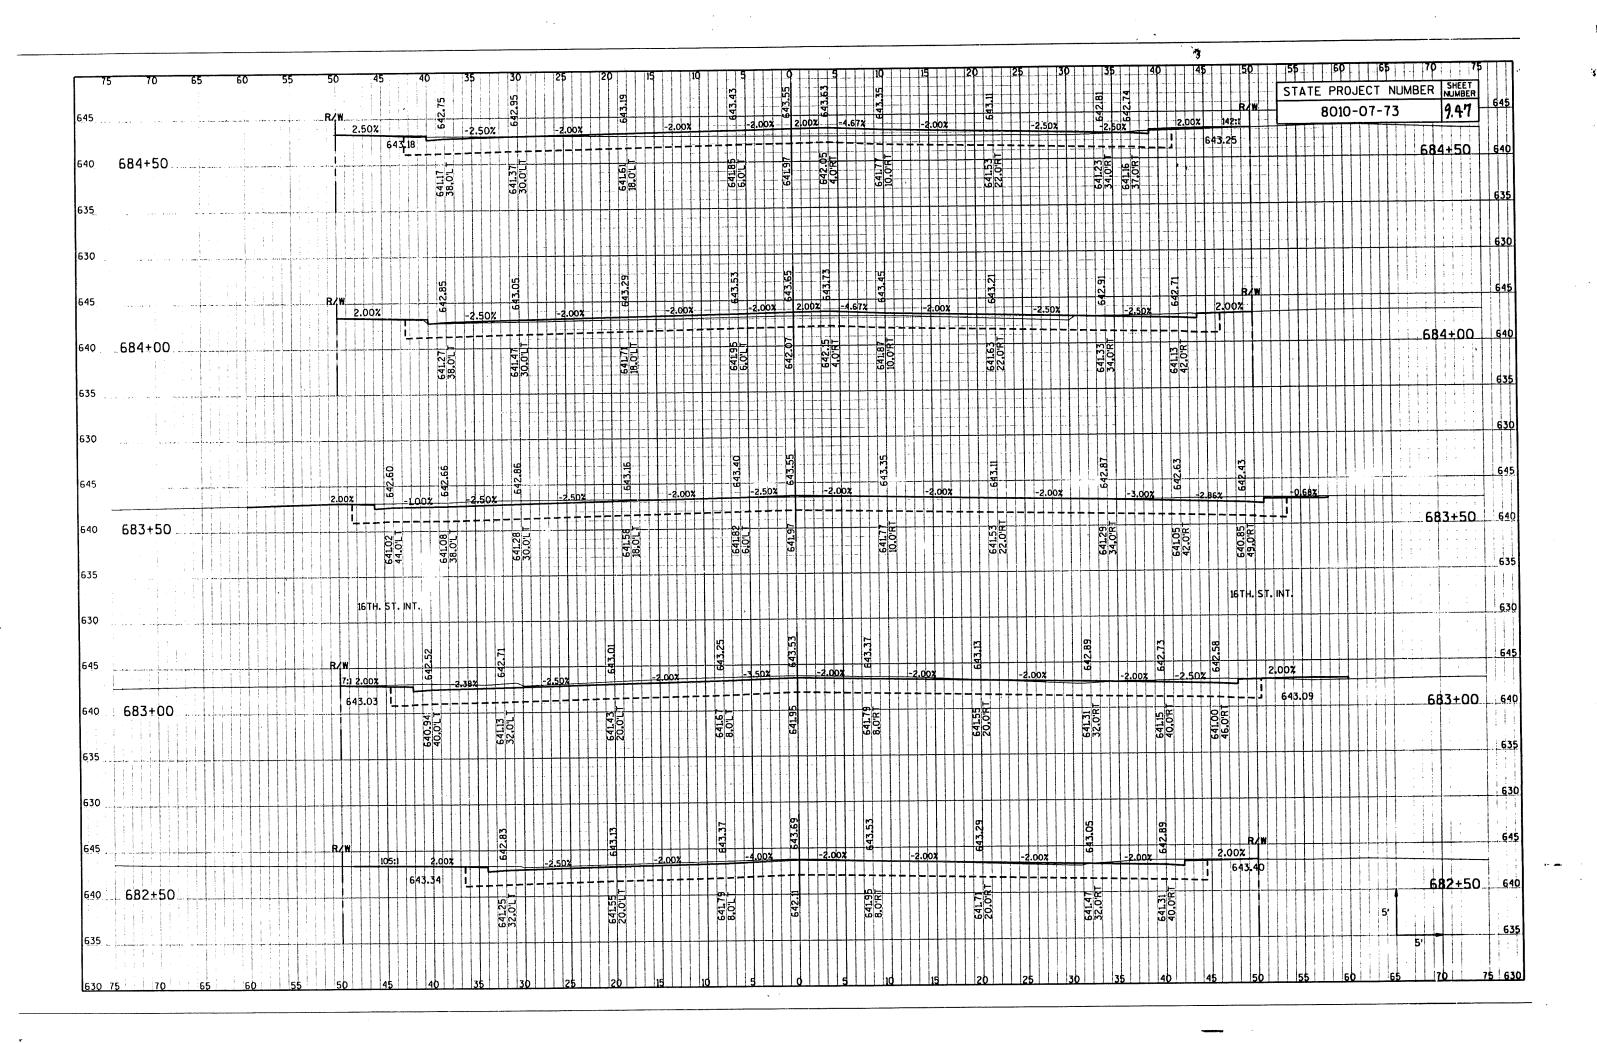


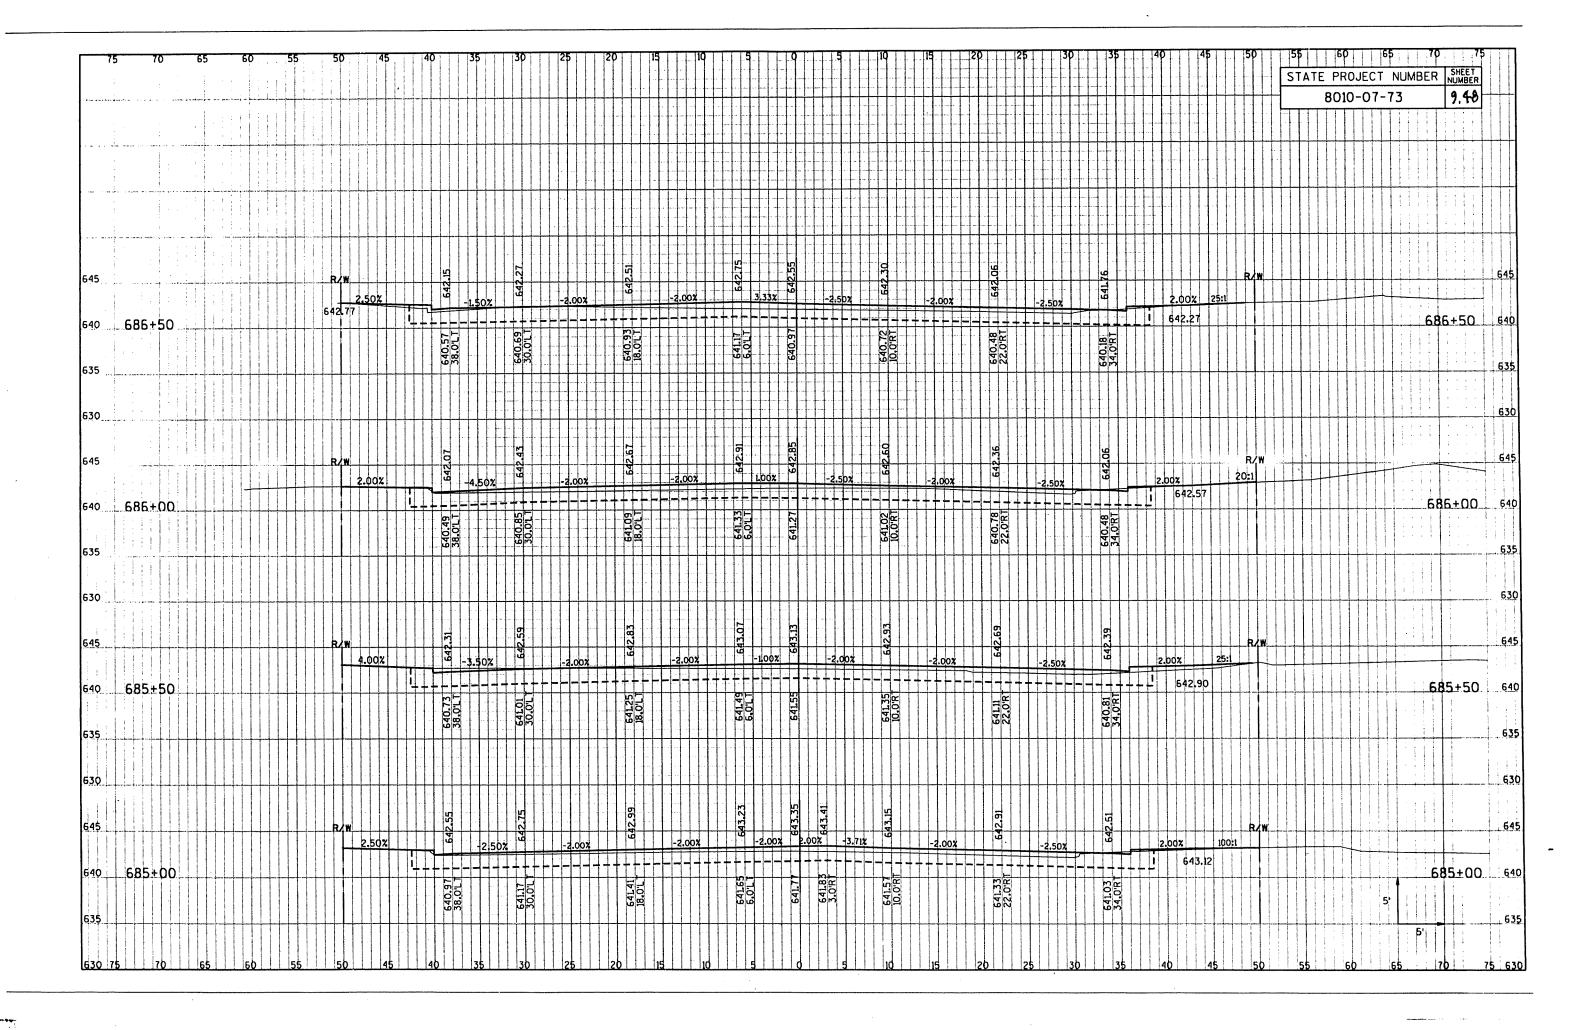


STATE PROJECT NUMBER SHEET NUMBER 9.49 8010-07-73 640.49 18.0'L T 640.12 10.0'RT 39.58 34.0'RT 639.88 22.0'RT 687+50 687+50 630 625 639.88 34,0'RT 640.42 10,0'RT 640.18 22.0'RT 687+00 687+00 1


i:


645	1					+	4		1 1											-	111		5	H	1-1-	15		20	2	<b>*</b>	30	777	35		40		45	1 150	511	155		***			
640					44		-					540.58			40 7g	4Ur.	#	#	10.98				##	8	#			9				###		1-1-1-				R/V	w	STAT	∐∐ <sup>t</sup> TE P	ROJE	65 CT N	IUMBER	0 15
	689+50				1	##	H	6.4	41.21	井	掛		z.	.00x	4	#	-2.00	*	9	-150x	1 29	-2.	202	640		xoo.		540.7				640.46	40.38	1				$\prod$	+	· · · ·	80	10-0	7-73	אוסבר	9.
635	the same and a second	1		44						***************************************	*	639.00 28.01. T			639.20			111	8		123	##	盽		++	#	耕	##	##	002			640	#		00% 641,0	01	##							
630			The state of the s								115	38	##	#	633	9			639.40 8.01.T		539.52	##	1	639.36 8.0'RT	111		10	0.0RT	##		+++	38.88 2.0'RT	88.80 F		9				***************************************					68	9+5
				+++	+	#	+++		##	++-	111.	11		1-1-1					111	11				[]]					#	#	11	3	638 36.		H	##	+++				H				
625																							#	##	##			#	+++	##	##	##													
645	The case of the ca								1	#	#			#	 	++-	##	##	##	1111				111	##																##				3 1 1 3 1 1
0,13				+++	++-	++-	++-													###	##	###		$\prod$							##		+++	+++	+			+++	+++	#					
640										640.5			$\prod$	540.BC	#		#	64104	#	##	計	###	e	1	Ш	111	19										***************************************		***************************************	***************************************		***************************************			
	689+20				##	##	6412	22	群	##	井	2.00	X	#	#	-z.o	OX	H 9	曲	50x	13	-2.00	64		-2.00	23	640.				640.52	THE STATE OF THE S	40.44			111			++		#				- : :
635					1	+-				39.00				39.22 0.01 T	3	$\prod$		539.46			9.58		1 2	計	##	开	##	##				-2.002		###	4.00%	2 641,07									
530		The second secon								ME	F	111		130	#	H	##	1 1 2	*	##	639		639.42	8.0'R	1 1 - 1 -		539.18 20.0'RT	2.0			8.94	32.0'RT	38.86 6.0'RT							***************************************				689	+2(
			***************************************	++++		++-	##	++	#	#	#	###																			138	*	35.		#	$\prod$		++		+++	+				
i25					1				##		#	H	#				$\mathbb{H}$	H	#	###	##	111	##	##			HH				+++									Marie Control		William			•
45								1		#	卌	H	#	##		#	##		4	###	#									***************************************	***************************************	***************************************		***************************************			***************************************				$\prod$	+++	+		, ;
				++++	+++	+++	4	<u>-                                    </u>	##	#	##				##			1+++			11							###	1	H	HH	##	+++	+++		+	++-								
10					##	44			40.1	4     1				640.8				641.13	#	41.28	##		641.09		+++	+++	+44+		111				***************************************												
	89+00					641	41.28	H	39.07	井	-2.0 	007	##	#	#	2.00x	##	#	-150	X G	-2	x00.5		] ] ] [	-2.002		640.		2.002		640.61	640.53	- T								H				
5	+ + + + + + + + + + + + + + + + + + + +	+++++		+		<del>           </del>	411	1111	39.07	2,01.				639.31 20.01. T				639.55 8.0'. T	$\prod$	1 193			111		+	777.	+++		-H-	##	. ‡‡‡	.00%		3.5	.30% 641	1.12	+			***************************************			-		
2														<b>6</b> ×		$\parallel \parallel$	#	8,	H	639.	+	+++	639.51 8.0'RT	111	111		639.27 20.0'RT				639.03 32.0°RT	38.95	O'RT				***************************************	***************************************						689+	00
					++++	1		##	+++		$\coprod$	4	+++	11																	TO PY	134	8	1	+	<del>                                      </del>	+++				+		-		
											111										111		H			+++	+++		HH	++	++	#					THE ATTENDED					Today day day			
				R/W					FIT'	#	111	#	$\parallel \parallel$	H	#	+++	H		+++		+++																	***************************************			1	+++		-	*** *****
The second secon				<del>                                      </del>	++++	, <del>    </del>	+++	##	19	+			C																111	+				++-	H	+++	HH	+++	++-						
				-	+++	641,39	<u> </u>		640.	H	-2.00x		641.0					641.24		341.36	$\parallel \parallel \parallel$		11.24		+++	1 8	<u>-</u>	##	##		<u> </u>					***************************************	R/W		***	***************************************		***************************************			-
688	+75	174477444444444444444444444444444444444			, <del>         </del>	ECT PO		1	开						- a.0	00x +++	#		150x	##	-150	x	641	<u>-2.</u>	002	541		-2.0	002		640.7						+							+	
						111	+++		39.18 2.0'L1		111		639.42	J.0.C			G KK	3.01.T		639.78			31.	T	1	1	計	FF	#	茾	##	#	##		#		+1					The second second	:		-
													100				16	8	H	63	+++	230	8.0'RT	111		639.42	20.07			81.95	32.0'RT	***************************************						TOTAL MANAGEMENT					6	88+75	5
The second secon					1	#	,+++	. +++-'	##	+++	#	4	#														***************************************			9					+	-	++-	+++	11:		+				
5	70 65	60 5	<u> 5</u>	b	45	40	3	36		.[]]											##		+		+++		+++	+	+++		$\parallel \parallel \parallel$	44						The state of the s				5'			1
							<del></del>	3011		411	25	444	20		15	111	10						ıd		-														++-	+++-	+++	-	5'		

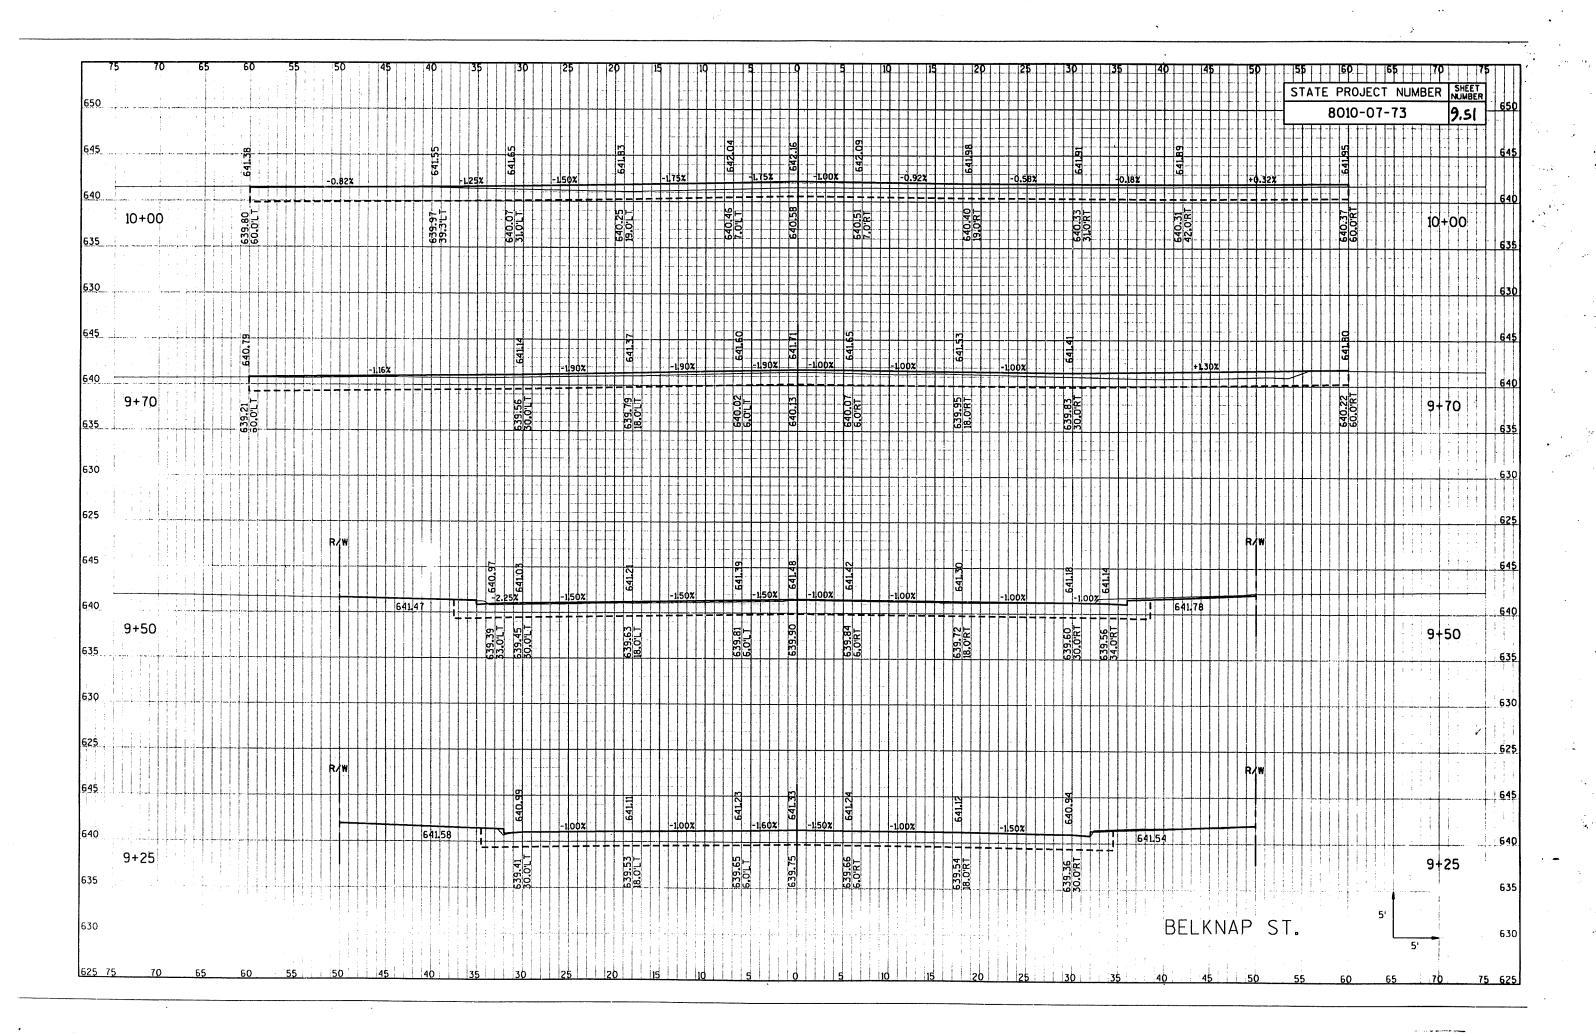



جليد

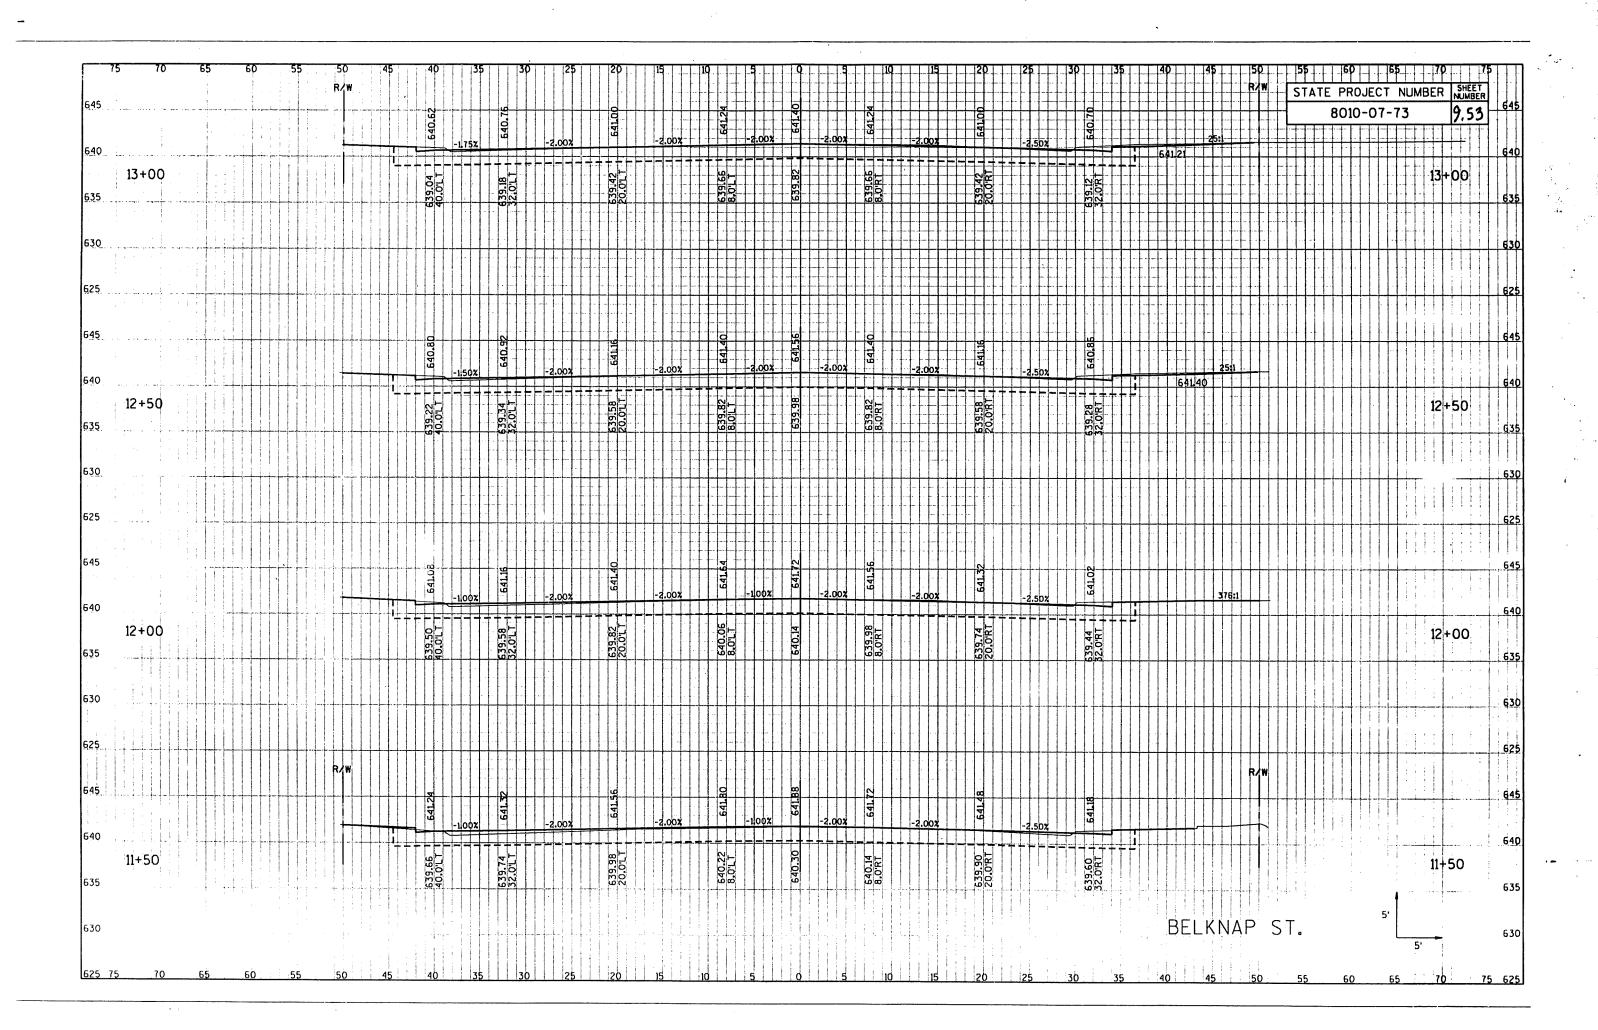


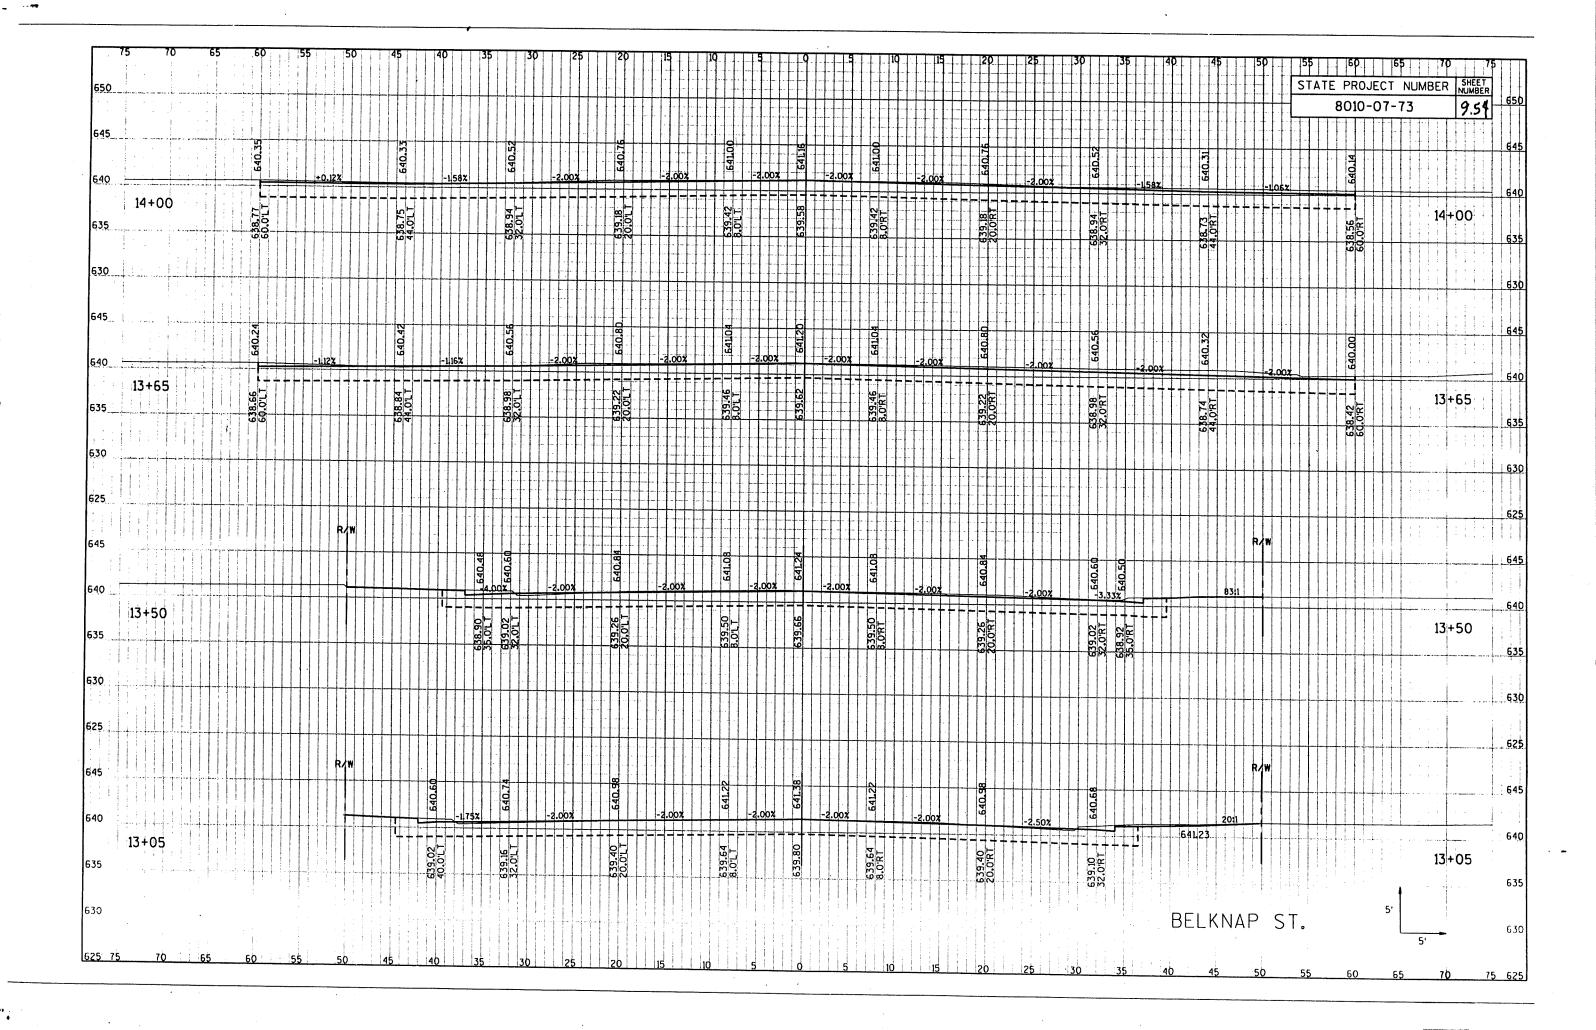


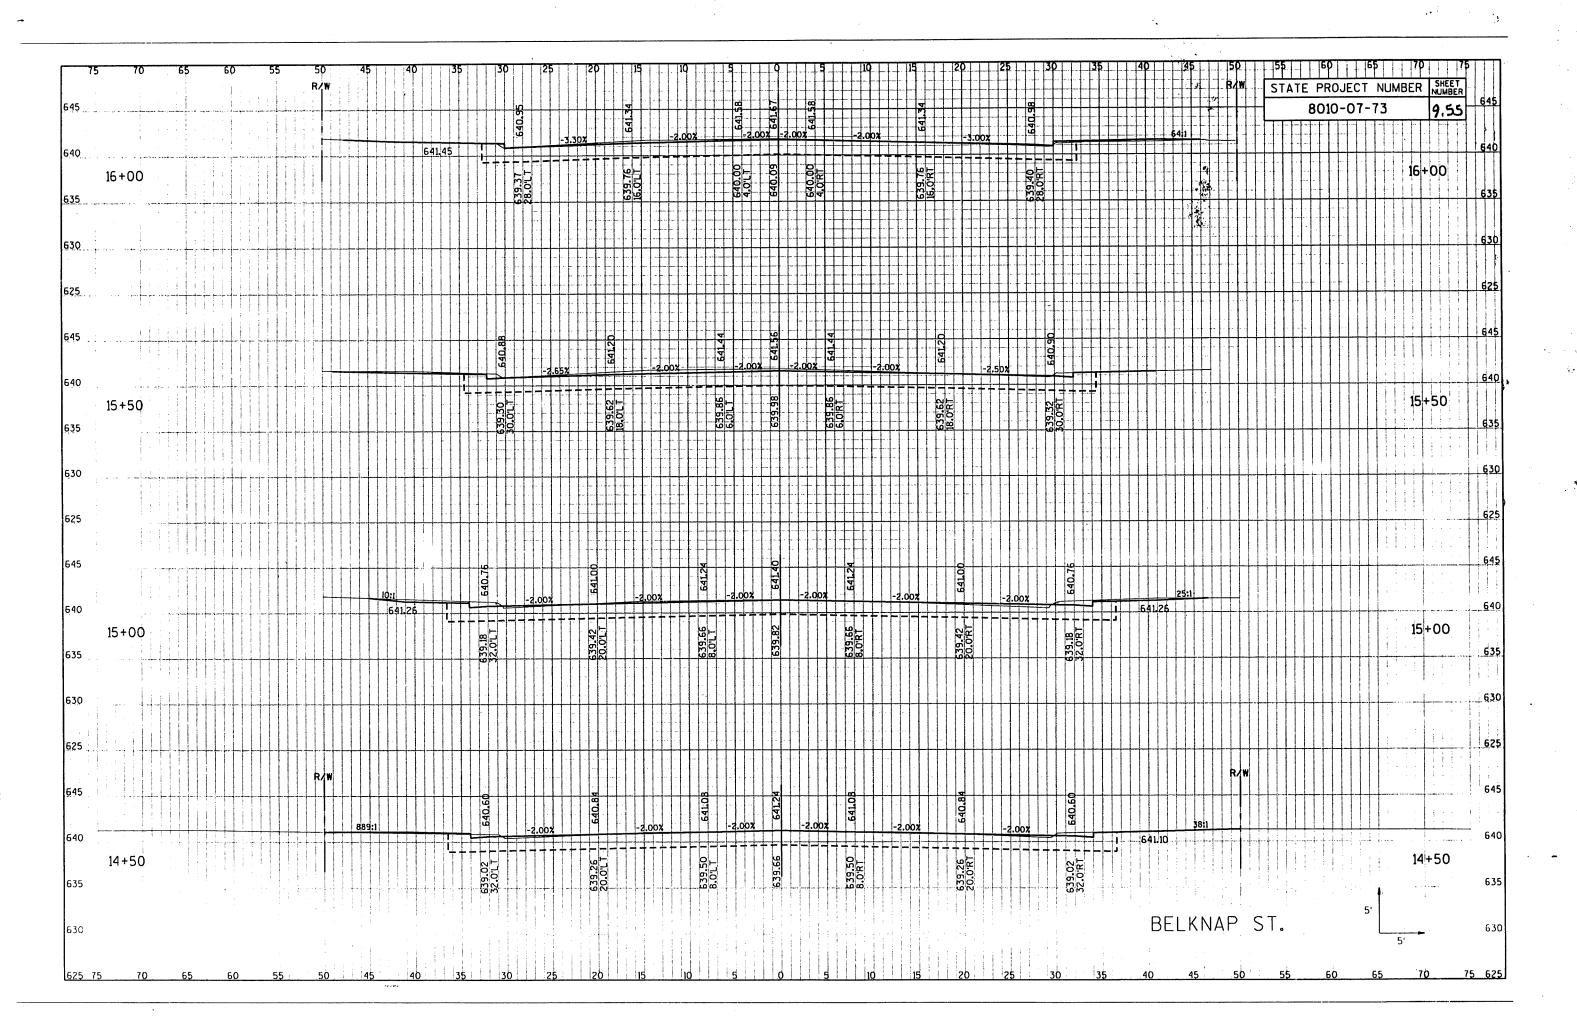


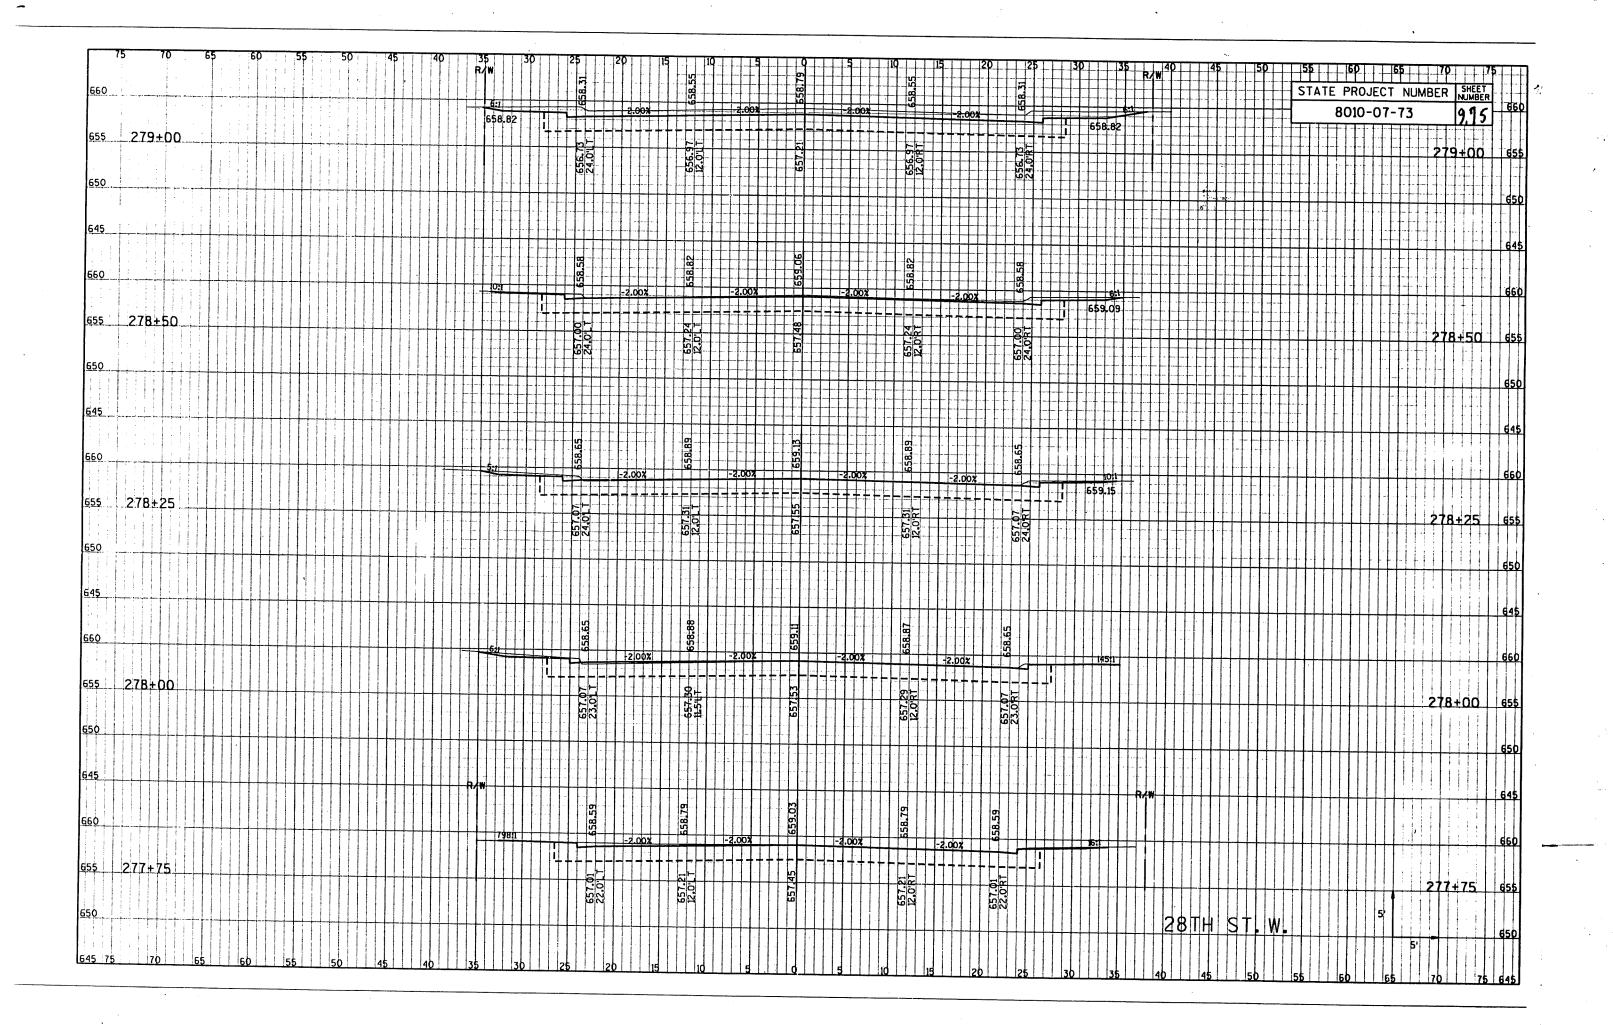


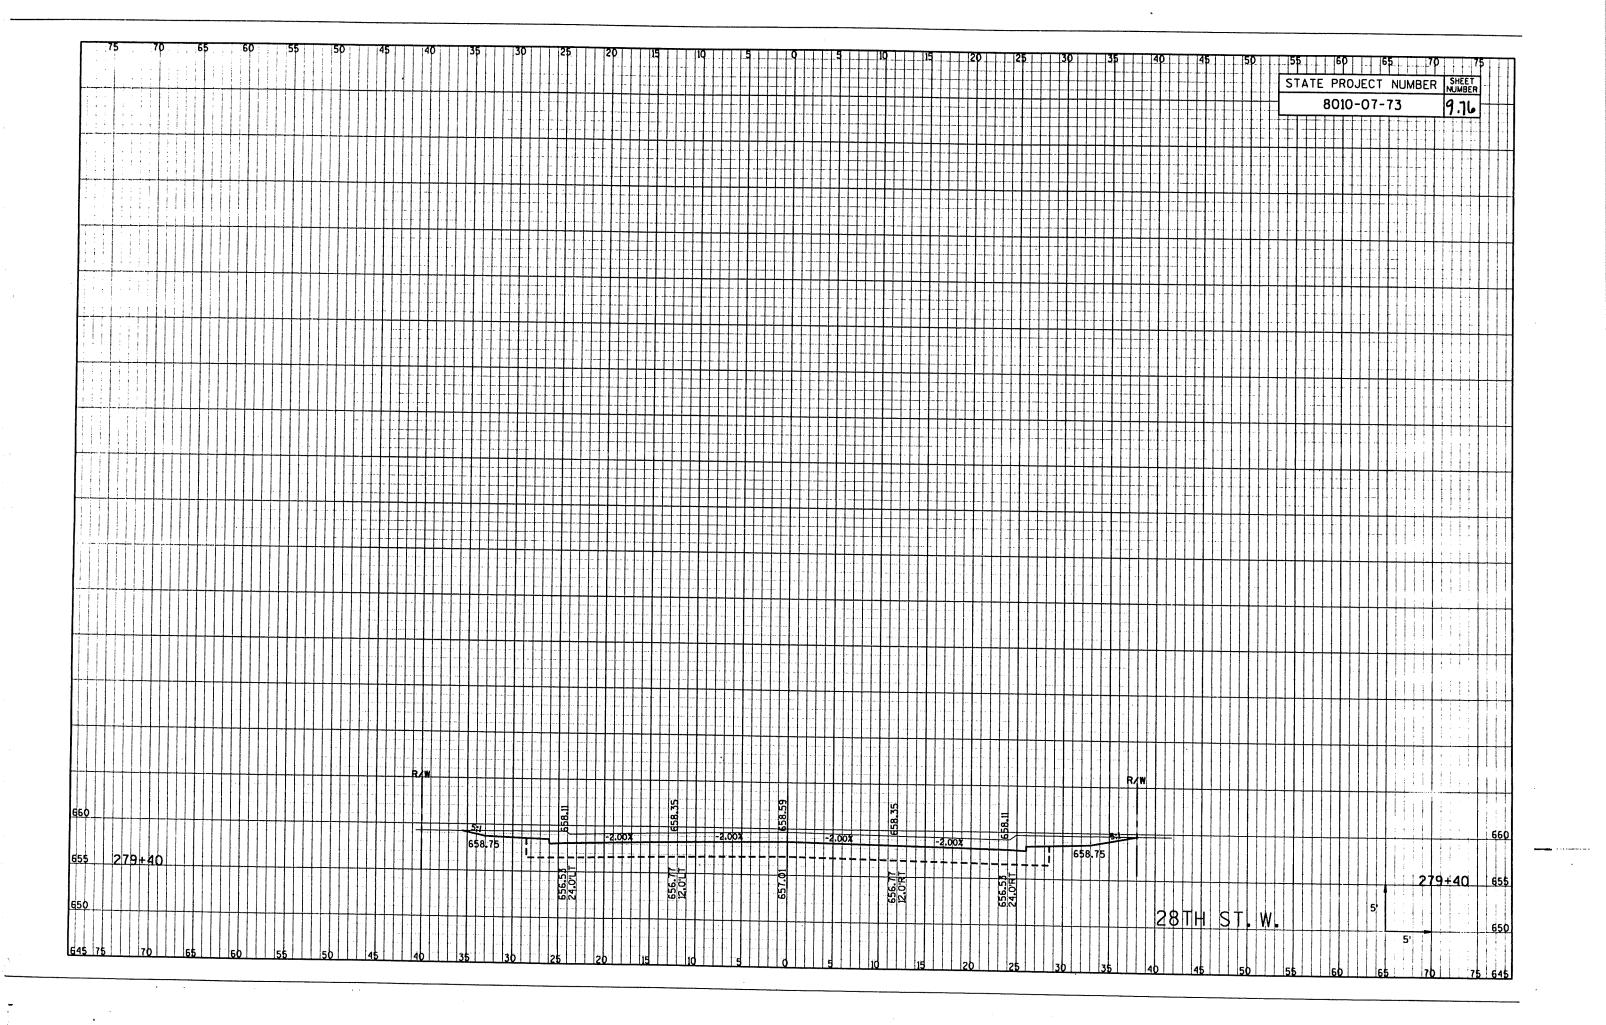


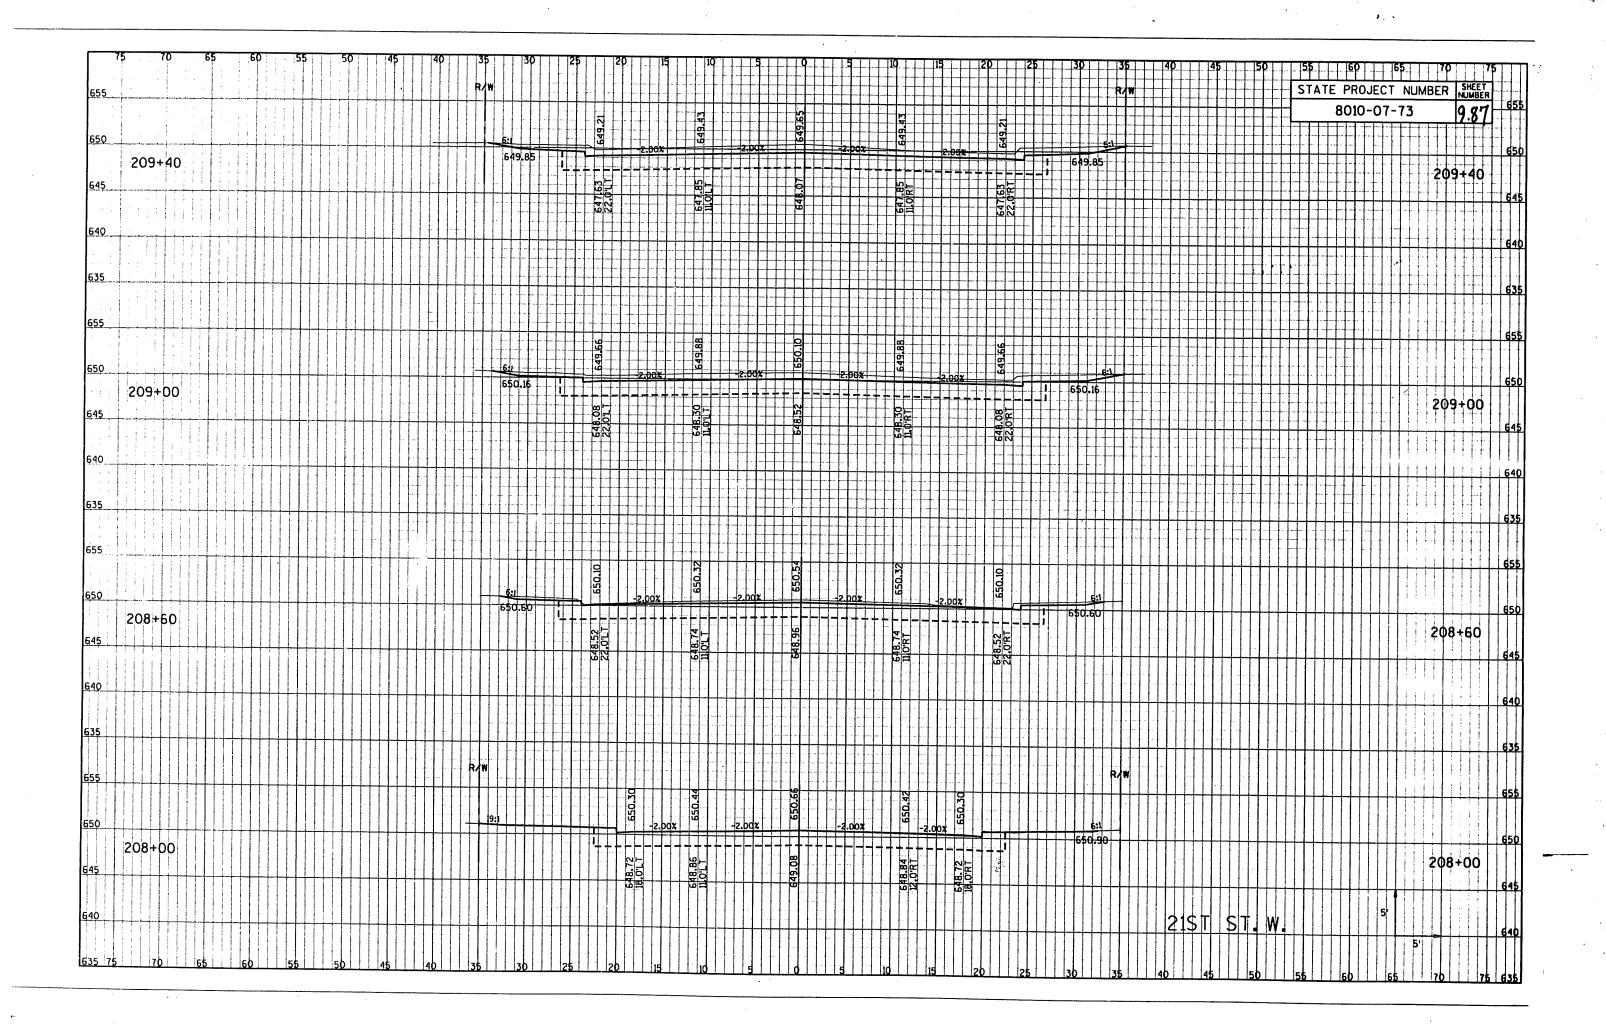


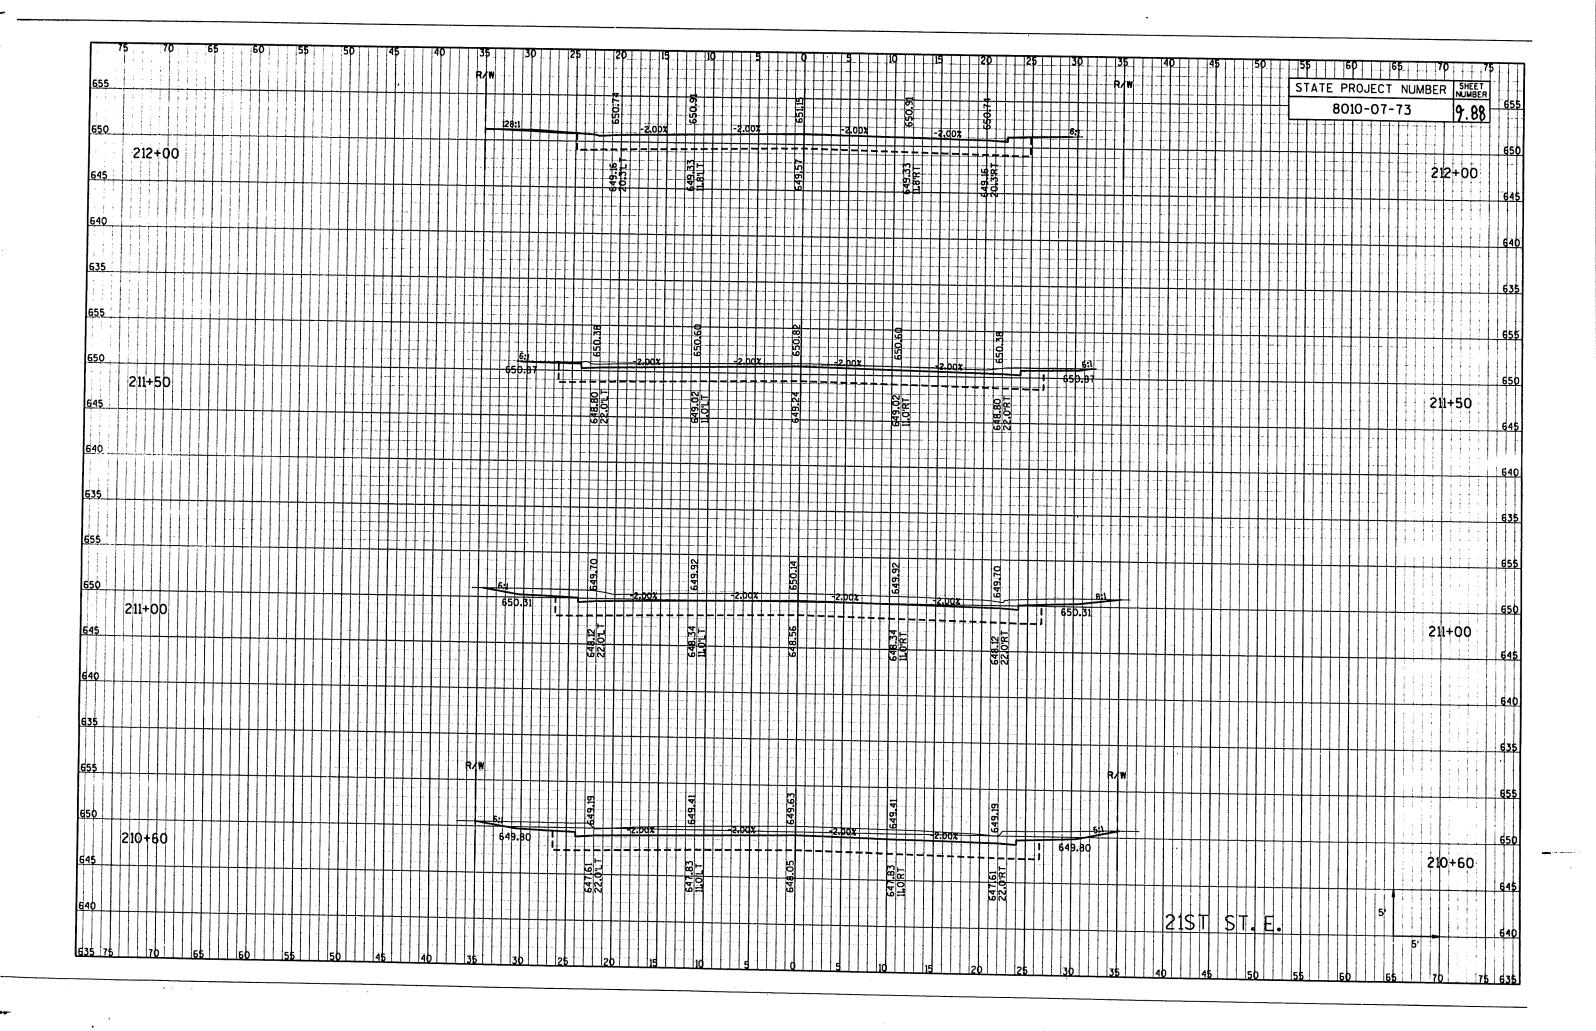


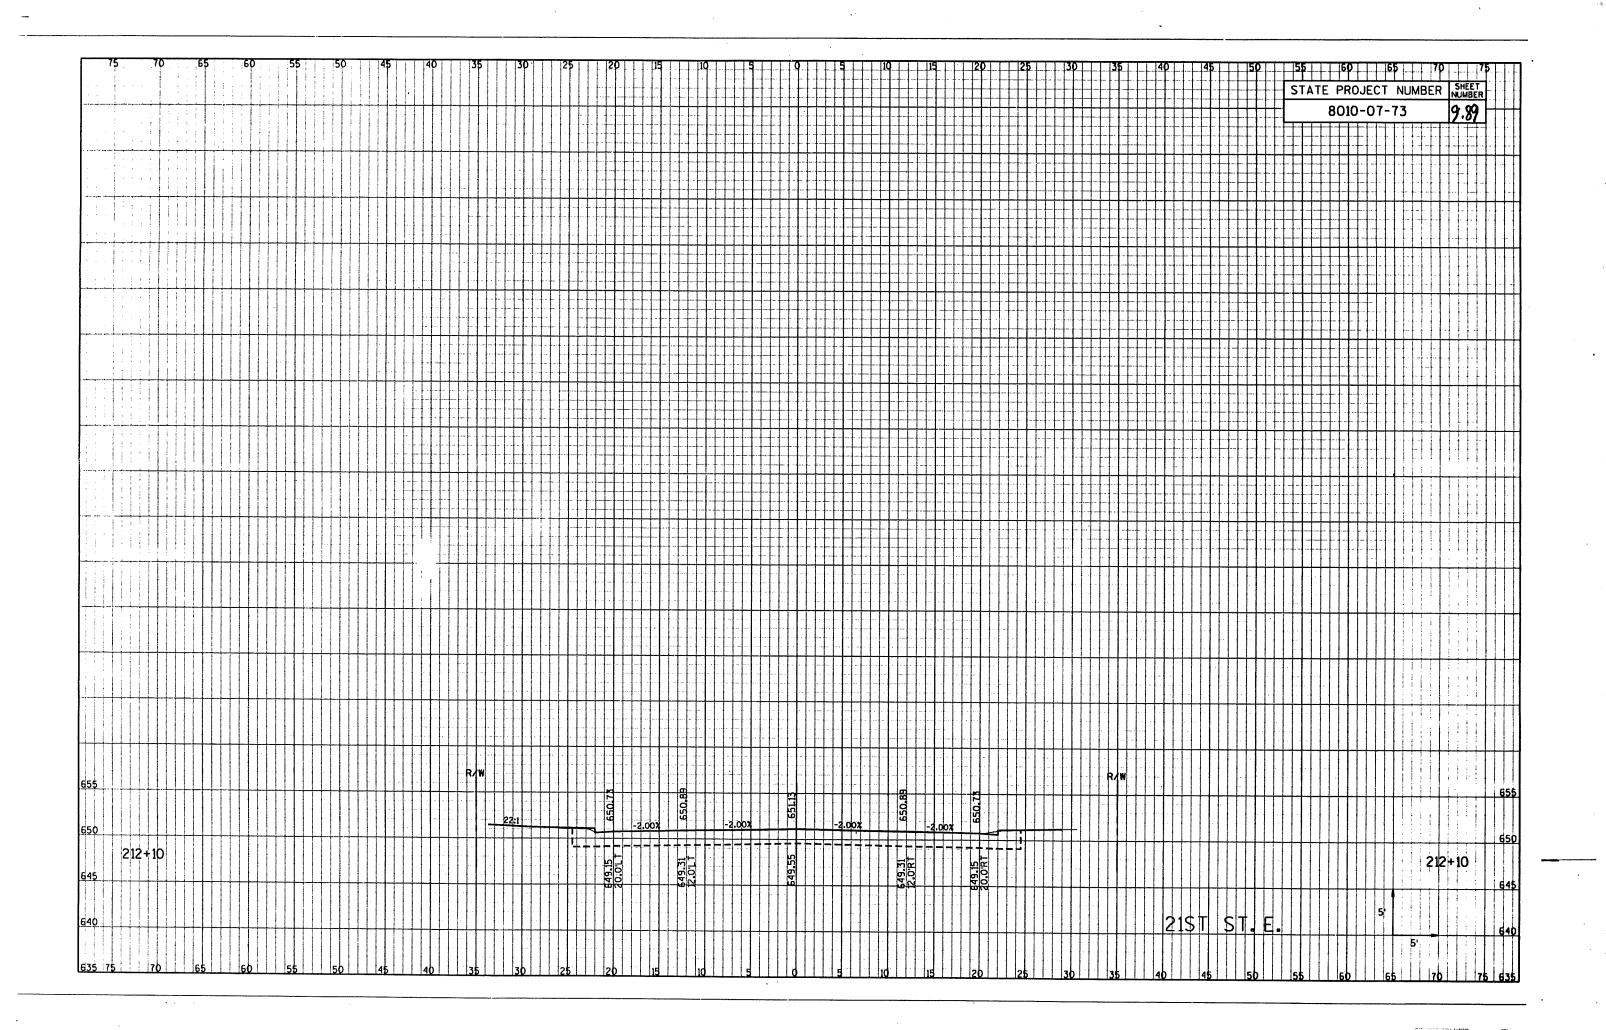


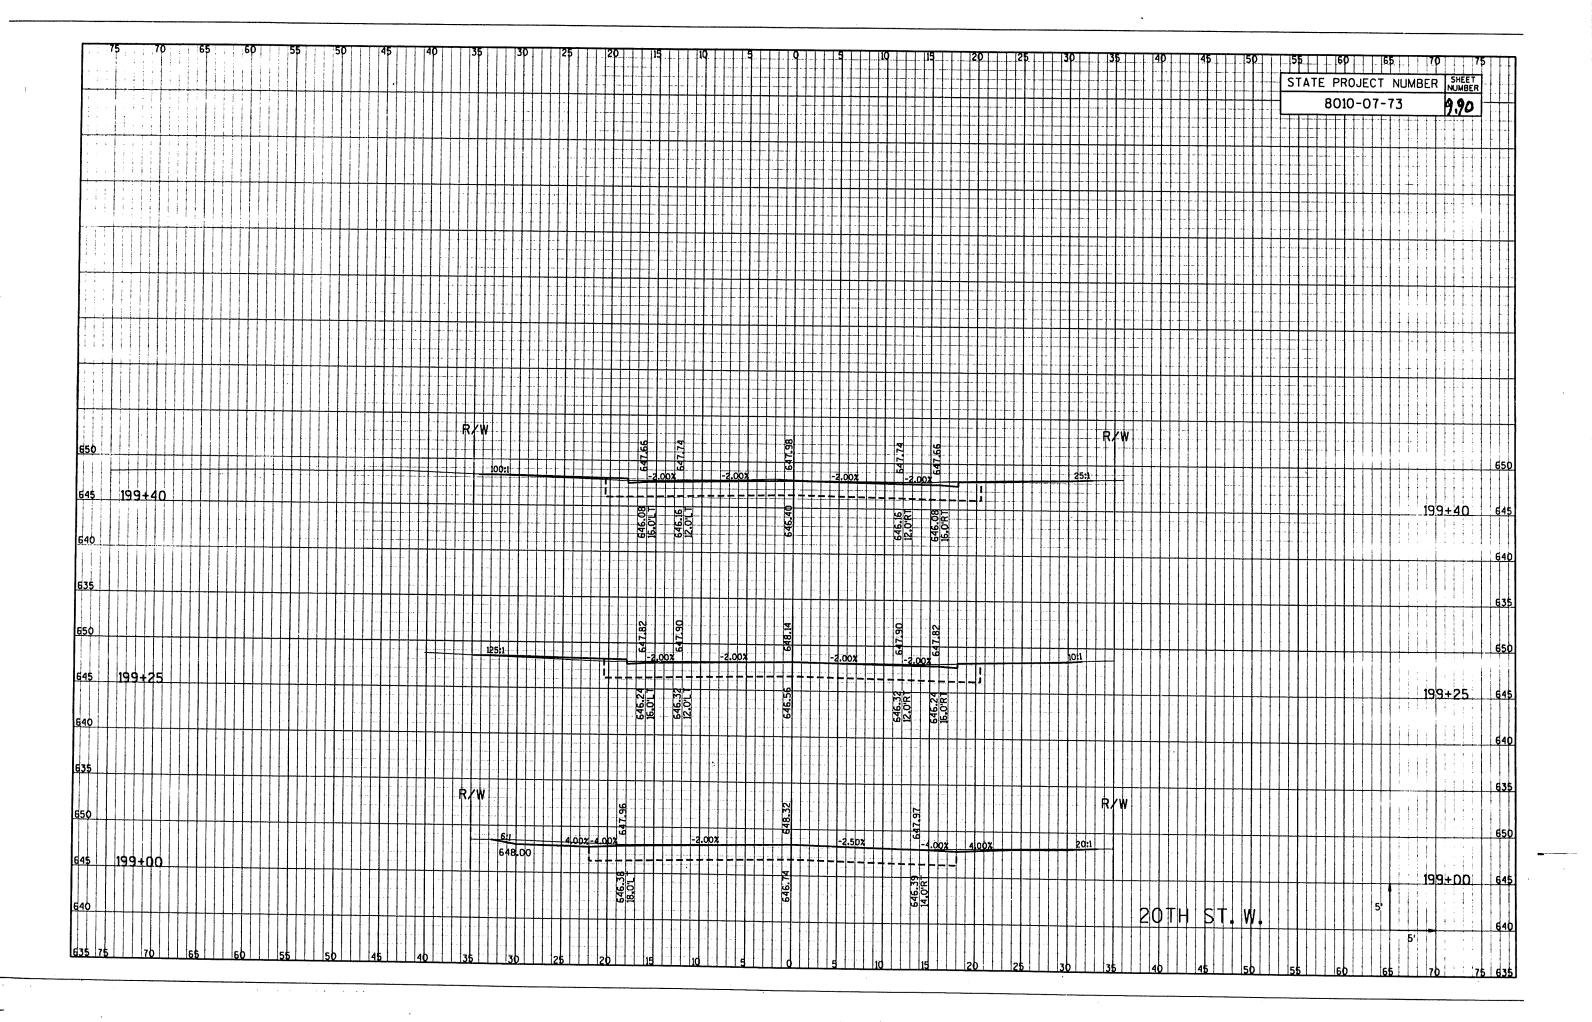

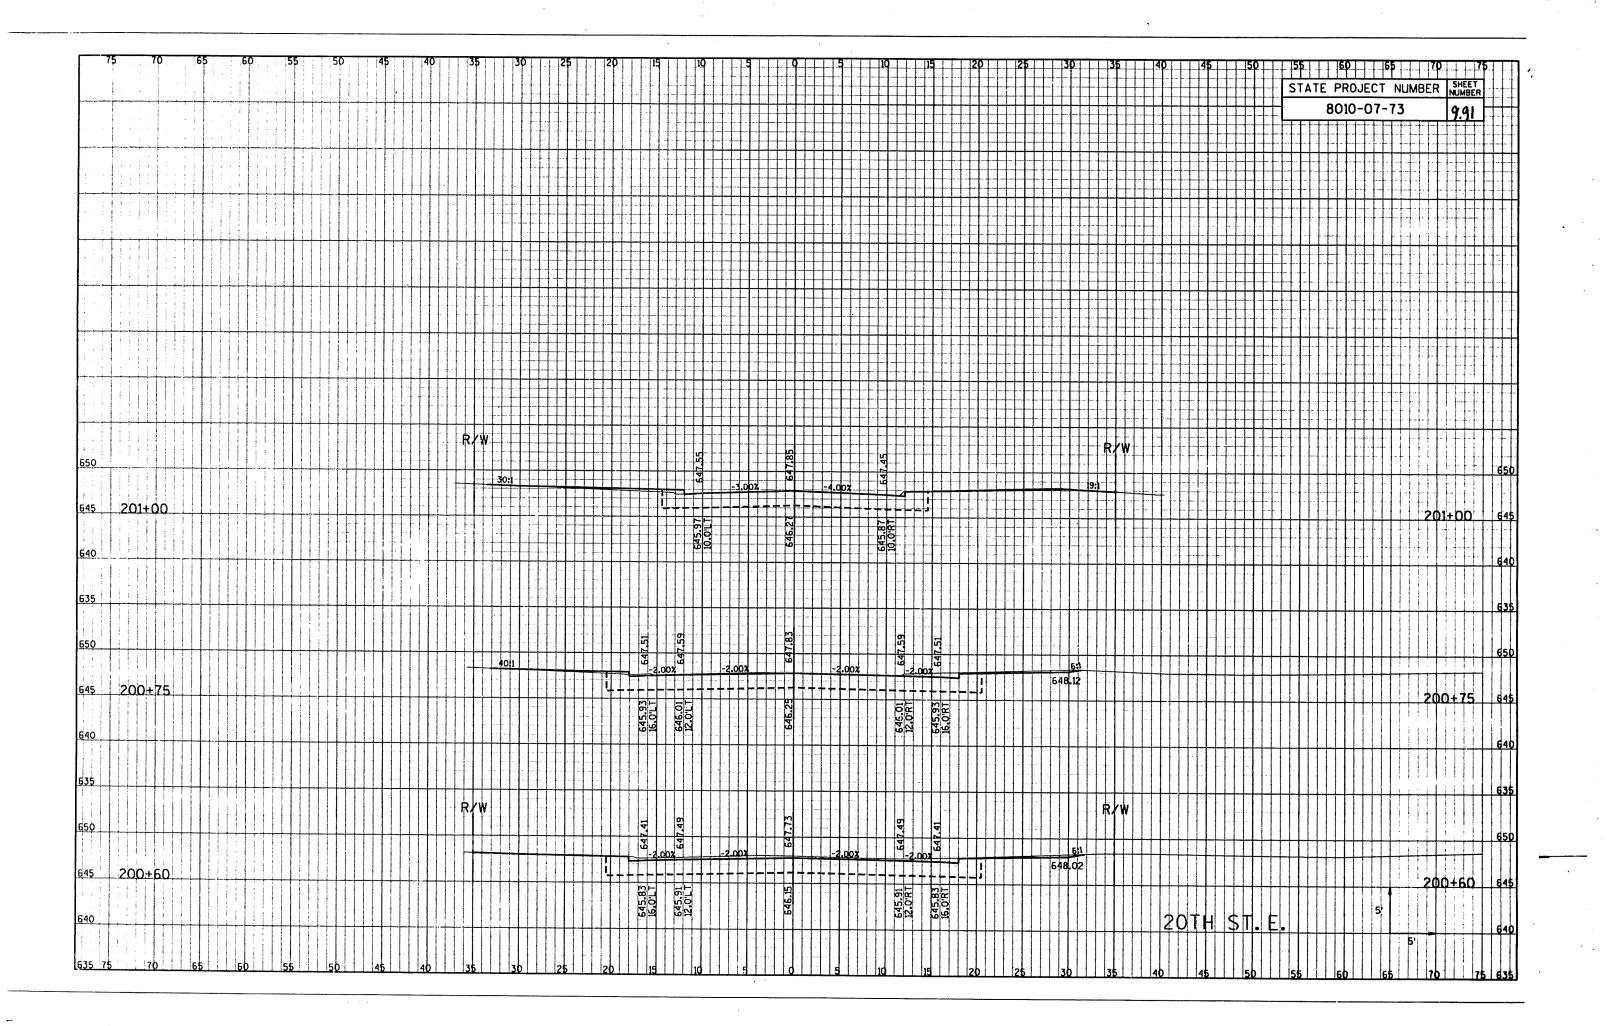


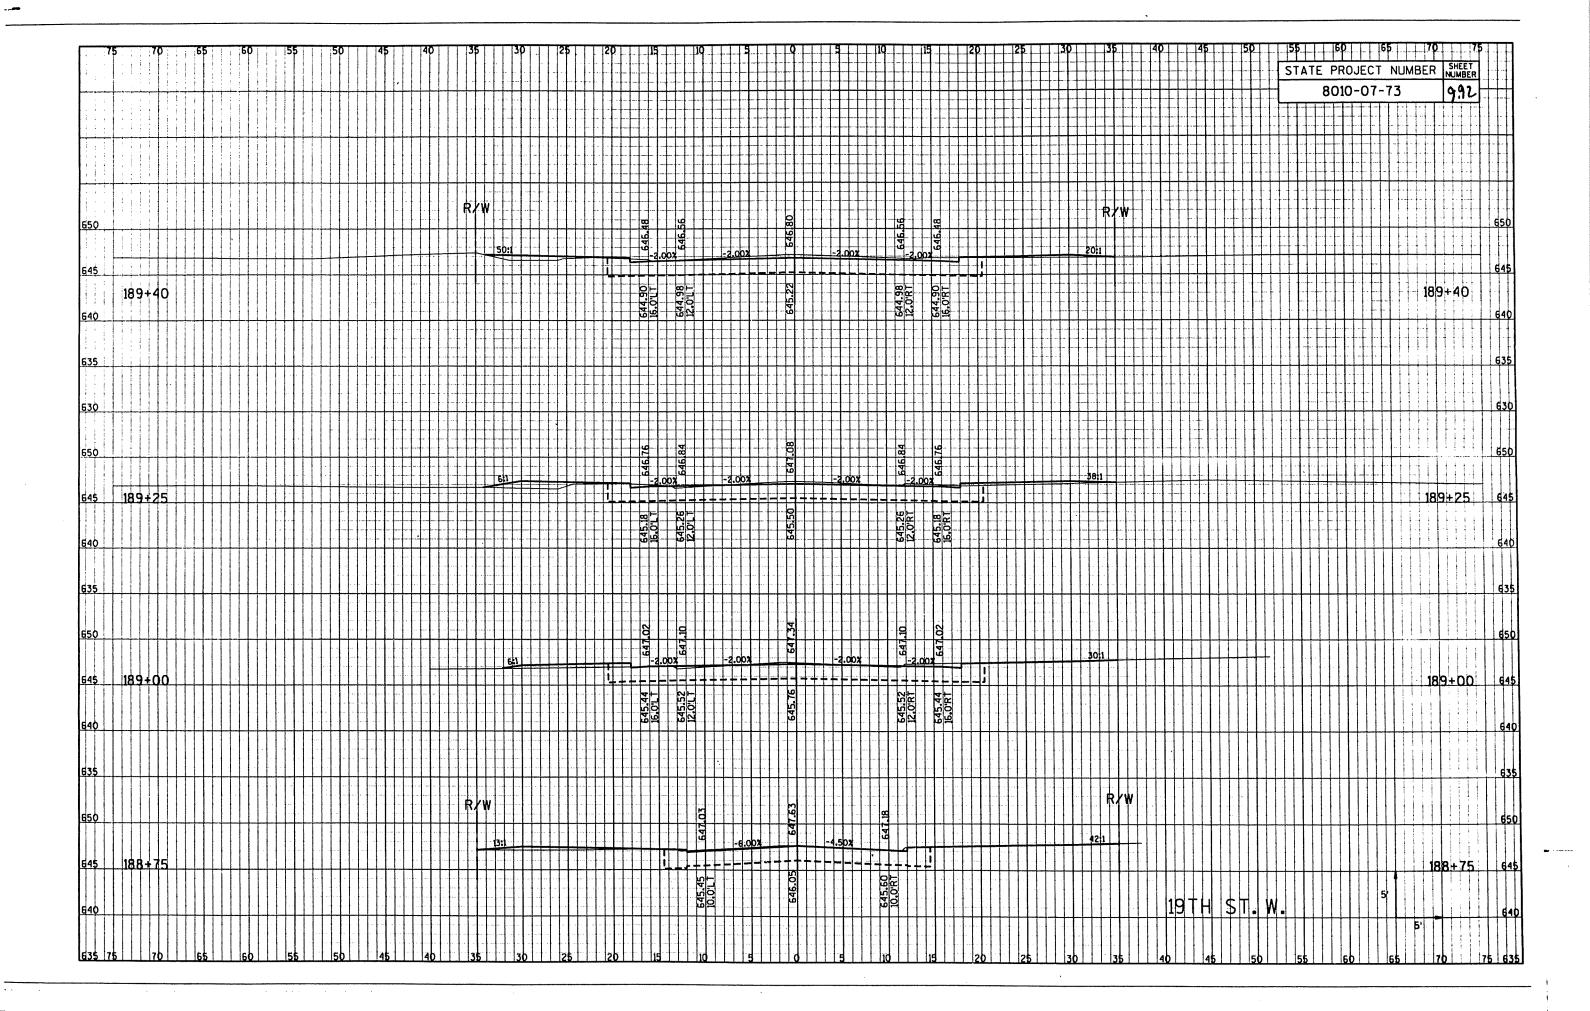


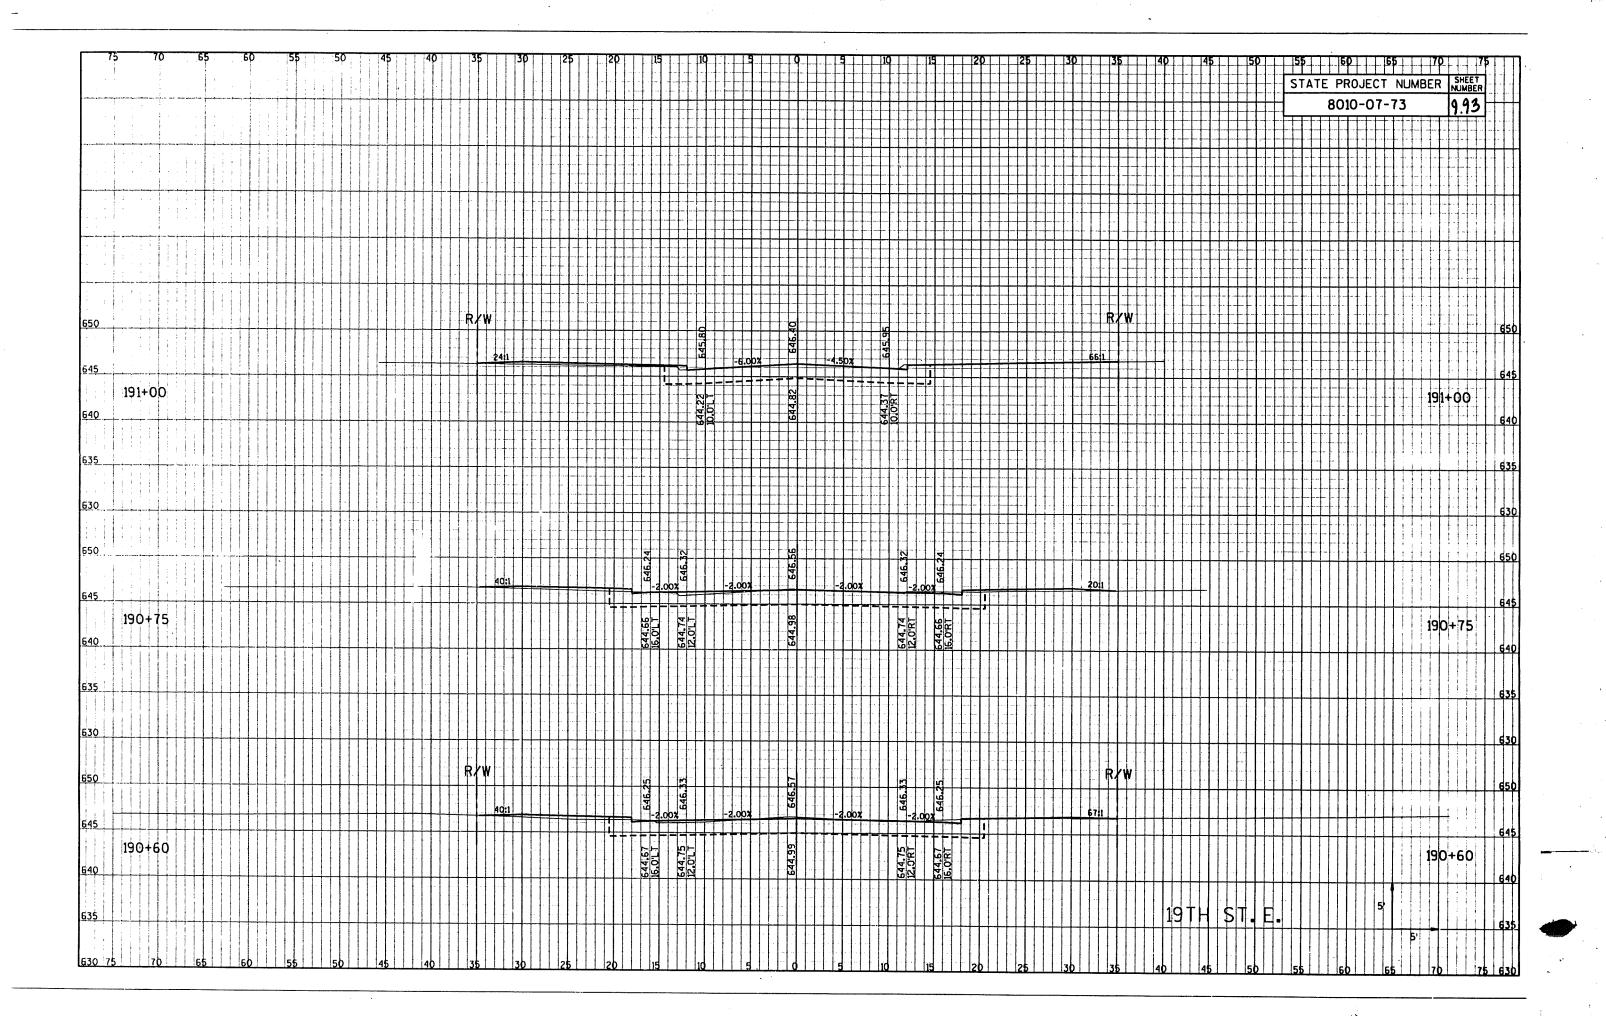

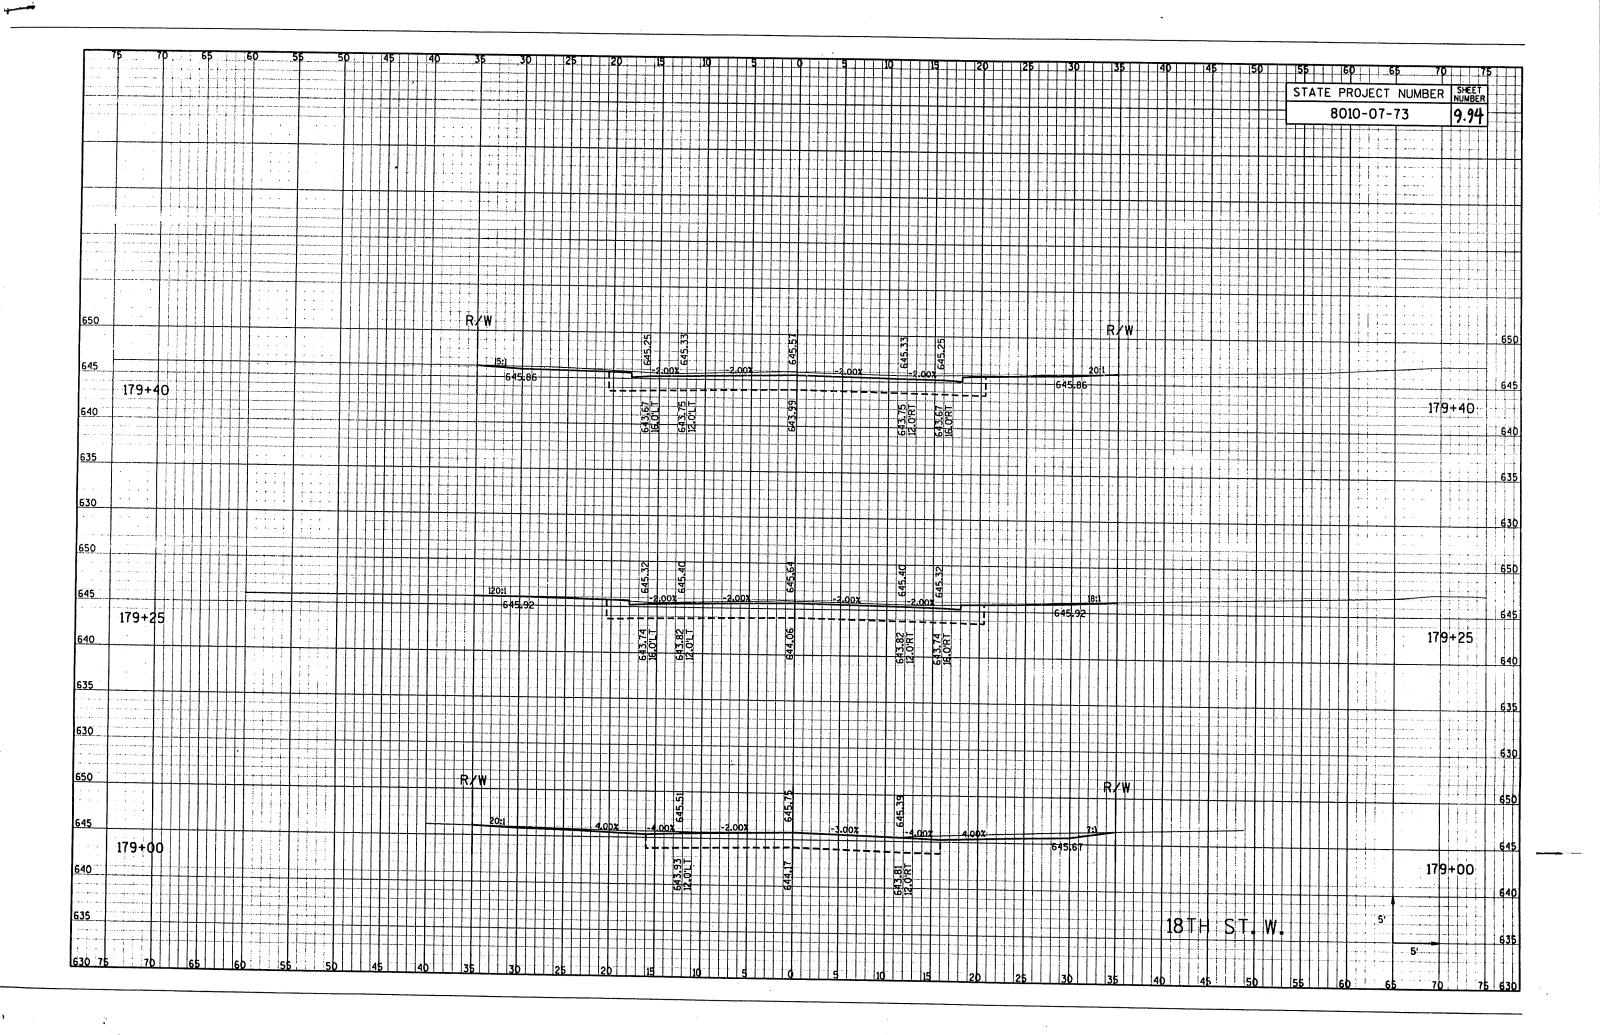

Sillator.

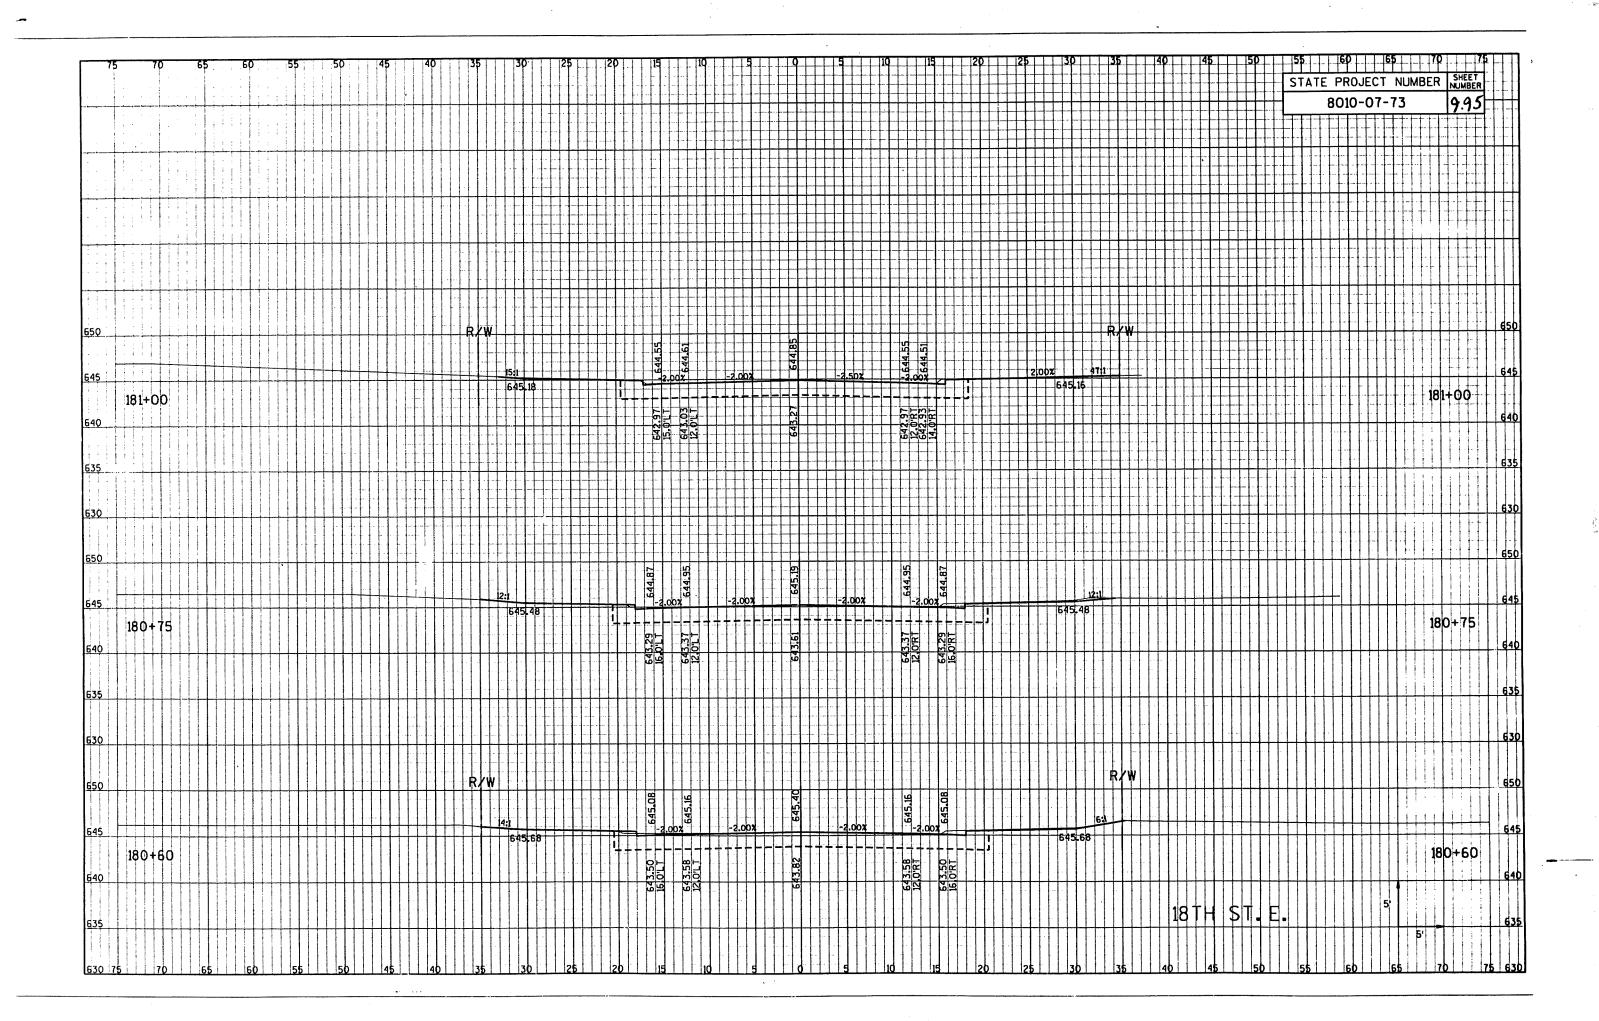

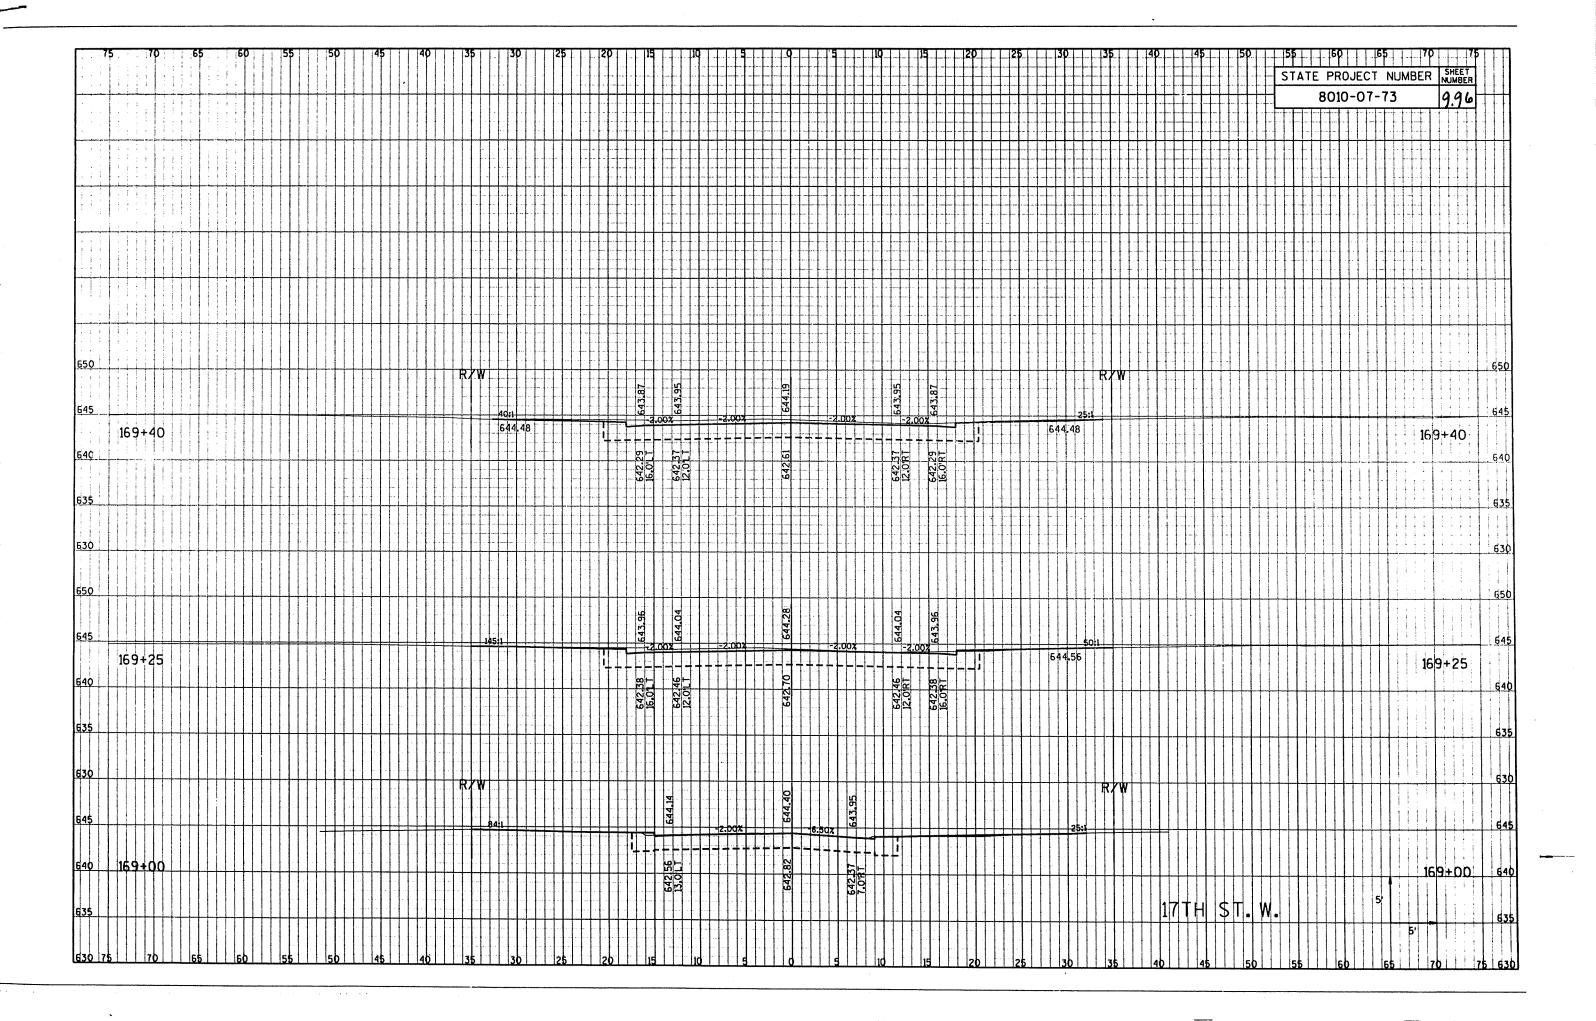

75		70		-7	5		60	. :	55		. 5	0		45		4	0		35		30		2	5		20		1	5	-	10		-	5		0		$\blacksquare$	5 		10					20		<b>2</b>	#		<b>V</b>	#			$\frac{1}{1}$		#	$\ $			$\prod$	#	 51							UMB	3ER				+!
						. :																																$\blacksquare$	#	##		井	H							#											$\blacksquare$	$rac{\pi}{4}$	_		80	010	-0	7-	73			9	2.9'	1	$\pm$
		<del>}-</del> . !			+						<del></del>												hand hand		1		++	-   -				-	-   -		-   -			#	#		<del> </del>	#	Ħ				$\blacksquare$		++	_	+											#		H	<del>   </del>       				-						
																	<u> </u>						1	1			-   -	-   -	1	-	-	上		-   -				井	$\pm$	##			#				$\parallel$	$\prod$		$\blacksquare$											盐	#	且	苴	H					#			1	$\prod$	Æ
																						.									-	╂╂	++-		扯	-											#																	崖	Œ				-		Ш		1	4	H
			· 	· .	-		+		_	++		- -		-			-		-							#	+	-    -   -	-	+			<del>     </del>					+	+	+	+															F							#	<del>     </del>		#		1-1-		-			+		
	:																			-					-									#	${\mathbb H}$	H		H					+	+		+															目	囯	F	F	H	Ŧ	$ar{\parallel}$	#				+	1-1		+
	-	1		+	+					+	+	+		+	+		H	$\parallel$	+	$\vdash$				+				+			1:1				#							#	$\prod$	$\prod$	$\blacksquare$									#								田	Ħ	#	<u> </u>					- -	-				
																									-				-		++		#		#			曲			$\parallel$			H									#	井						<del>      -</del>	H		井	井	井	#	#		-   -	H	+	+	$\dashv \uparrow$	H	H
	:						+					$\dagger$			+	$\parallel$					-				-					-	+	+	+	+	$\coprod$							#										#		Ħ			$\ddagger$	+	+		<u> </u>	肚	扗	#	#	- -					+ + +	-			
	:																		1-1	-											$\prod$		+		++	+									+								⊢R	W			H			+	井	#	$\ddagger$	士	#	#	+				$\prod$	1	$\sqcap$		
				-											-				R/	W									-	#	$\parallel$		3.8	$\prod$	$\prod$	0		#				3,65				#							#	1	#	$\parallel$	#		1	#	H	Ŧ	#	17	#			+			1				
					ļ									-			11									#							2	-2.	5D%			井	-3.0	0%_		54		#	+							+ 61 				甘				Ħ	Ħ	拝	打	Ħ	Ħ	$\prod$					1	71+	+00	<u>.</u> د	
17	71+	+0	0														-	.  -		11		-	11								<b>i</b> + +	+					+	井	Ħ		=-	1			+	+	+		E	#					11		#			#	耳	丰	#	1	4	4			$\prod$	$\frac{1}{1}$	4	$\dashv$	<u> </u>	+	4
)		-			-			-						+			+	+		++				$\vdash$						++			642.2 8.0.11		$\pm \pm$		2	蓒				642.0	ō	-	11					#	+			$\pm$					-	11		#													
														- 1-			.   .				1	$\prod$	11-					#	++						++			井		#					#			H		#		$\prod$	$\frac{1}{1}$	+	+	+		+	-	+	#	#	$\dashv$		#	H	.  -	+		#	+	+	+	#	+
					+																		11.					$\prod$		-   -					- -	- -		井												-   -   -	11	-   -		11	11		-   -		-			4	·       -							.					.
																		.										11		4								#	+	+	-						-   -   -	1-1-					#				-   -	+	+	+	+	#	H		H	H	-		+	+			Ħ	1	+
2			++	Ħ																						<del> </del>		#									#	#	H		H		<del>  -</del>   -							- -	-	-   -			-1-1	-:	-         -	-					[-  -		.   _  										
0										<u> </u>		<del>                                     </del>	<del>                                     </del>				_	-		-	-		+		+	+	+	+	+		 						#	+	+		+							+	$\dagger \dagger$	+	+												$\prod$	П	П						: 1			-	
						***************************************																							13. (4		13.82		-				44.0		$\prod$			A 2 B	70.6	47.74									7-1								Ш	Ш	$\coprod$	₩'	₩	$\coprod$		1	4	H		otag	$\stackrel{\downarrow}{+}$	$\dashv$	$ \downarrow $
5			#	$\frac{1}{1}$			-		4	$\parallel$		#	$\frac{1}{1}$		H	#		H		- 5	58:1	$\frac{1}{1}$	$\frac{1}{1}$	+		$\frac{1}{1}$	1	+	q - 2	.002	ů.	#	-	.00			9		-2.	00%	+	Ħ	-2.0	202			!				644	.35			-																1	170	0+7	75	
111	70	+(	75													1											<b>'</b>	++	• <del> </del>  -		74	]]	††				48						12.0'RT		2											-			-		igoplus	$\mathbb{H}$	igapha	igapha	$oldsymbol{+}$	╫	H	+	$\dashv$	H	+	+	+	+	
0					$\parallel$	+				+	$\dag$				$\dagger \dagger$												$\parallel$		642.16 16.0'LT		642.	2					642					683	12.0	642	16.0'RT								i																				11		
5																												-							-			Н	- -		+	+		$\coprod$	11	1			-			$\parallel$		H	$\frac{\parallel}{\parallel}$	H	+	<del>                                     </del>	-		H	<del>                                      </del>	+	H	H	H	$\dagger \dagger$	+				$\dagger$	$\exists \dagger$	<del></del>	$\uparrow$
,5																															1												-   -   -																																
30												$\perp \downarrow$	4	$\prod_{i=1}^{n}$	$\coprod$	$\prod$			1	-	-											$\parallel$						H	4			+						-   -		H			$\parallel \parallel$	$\dagger$	$\dagger \dagger$		T		$\parallel$		$\parallel$	$\parallel$	$\prod$	$\prod$		$\prod$		$\top$							
																								-  -																																																		1	
50				-			+	$\frac{\parallel}{\parallel}$			-	+		+	+	+	+	+	→ R	/w	+				+					${\dagger}$	+	+	+	+	$\dagger \dagger$	$\dagger \dagger$	2							11,	4									R∤	W																				
																													43.73		543.81						644.0						643.81		643.73								9:1	╝	1	4	$\downarrow \downarrow$	$\coprod$	$\frac{\parallel}{\parallel}$	#	+	otag	$\downarrow \downarrow$	$ \downarrow \downarrow $	#	$\dashv$	+		-	#	<u> </u>	$\dashv$	H	<u> </u>	4
45		_	4		-	H	+	${}^{\dag}$	₩	+	+	+	+	+	+	$\frac{1}{1}$	#	+	+	H	#5:1 6	44.	34			+		+		2.00	× "	+	$\dashv$	2.00	22		开	#		.002			<u>-2</u>	,00%				Ħ	Ħ		64	4.34																			: !	17	0+	60	)
	17	O٠	160	)																									<u>5</u>		13						44	#					642.23 12.0'RT		642.15 16.0'RT	$\prod$	+	-	-	+		+	+	+	+	$\parallel$	+	+	+	+	+	+	+	+	++	$\mathbb{H}$	$\parallel$		H	+	-	$\dashv$	#	H	+
40	$\parallel$	Ť	$\parallel$			$\parallel$																$\prod$							642.15	70	642.23	12.0					642						25.5		16.0									-		,,,,,,,,,,,,,,,,,,,,,,,,,,,,,,,,,,,,,,,	1	<b>∤</b>		<	ST	JE							5						-
35					-															11	$\downarrow \downarrow$		11		$\prod$	-	$\coprod$	11	1	4		_			-	$\dashv$	#	#	<del>                                     </del>	1+				$\dashv$	+	+	+		H	+	++	╁	-	+	+	+	╫	1 1	#	++	++	#	#	H	+	$\dashv$		H	$\dagger \dagger$		5'	+	$\dagger$		$\dashv$
																																															-										40		45			50		55						65	-	7	70		7

VINV

