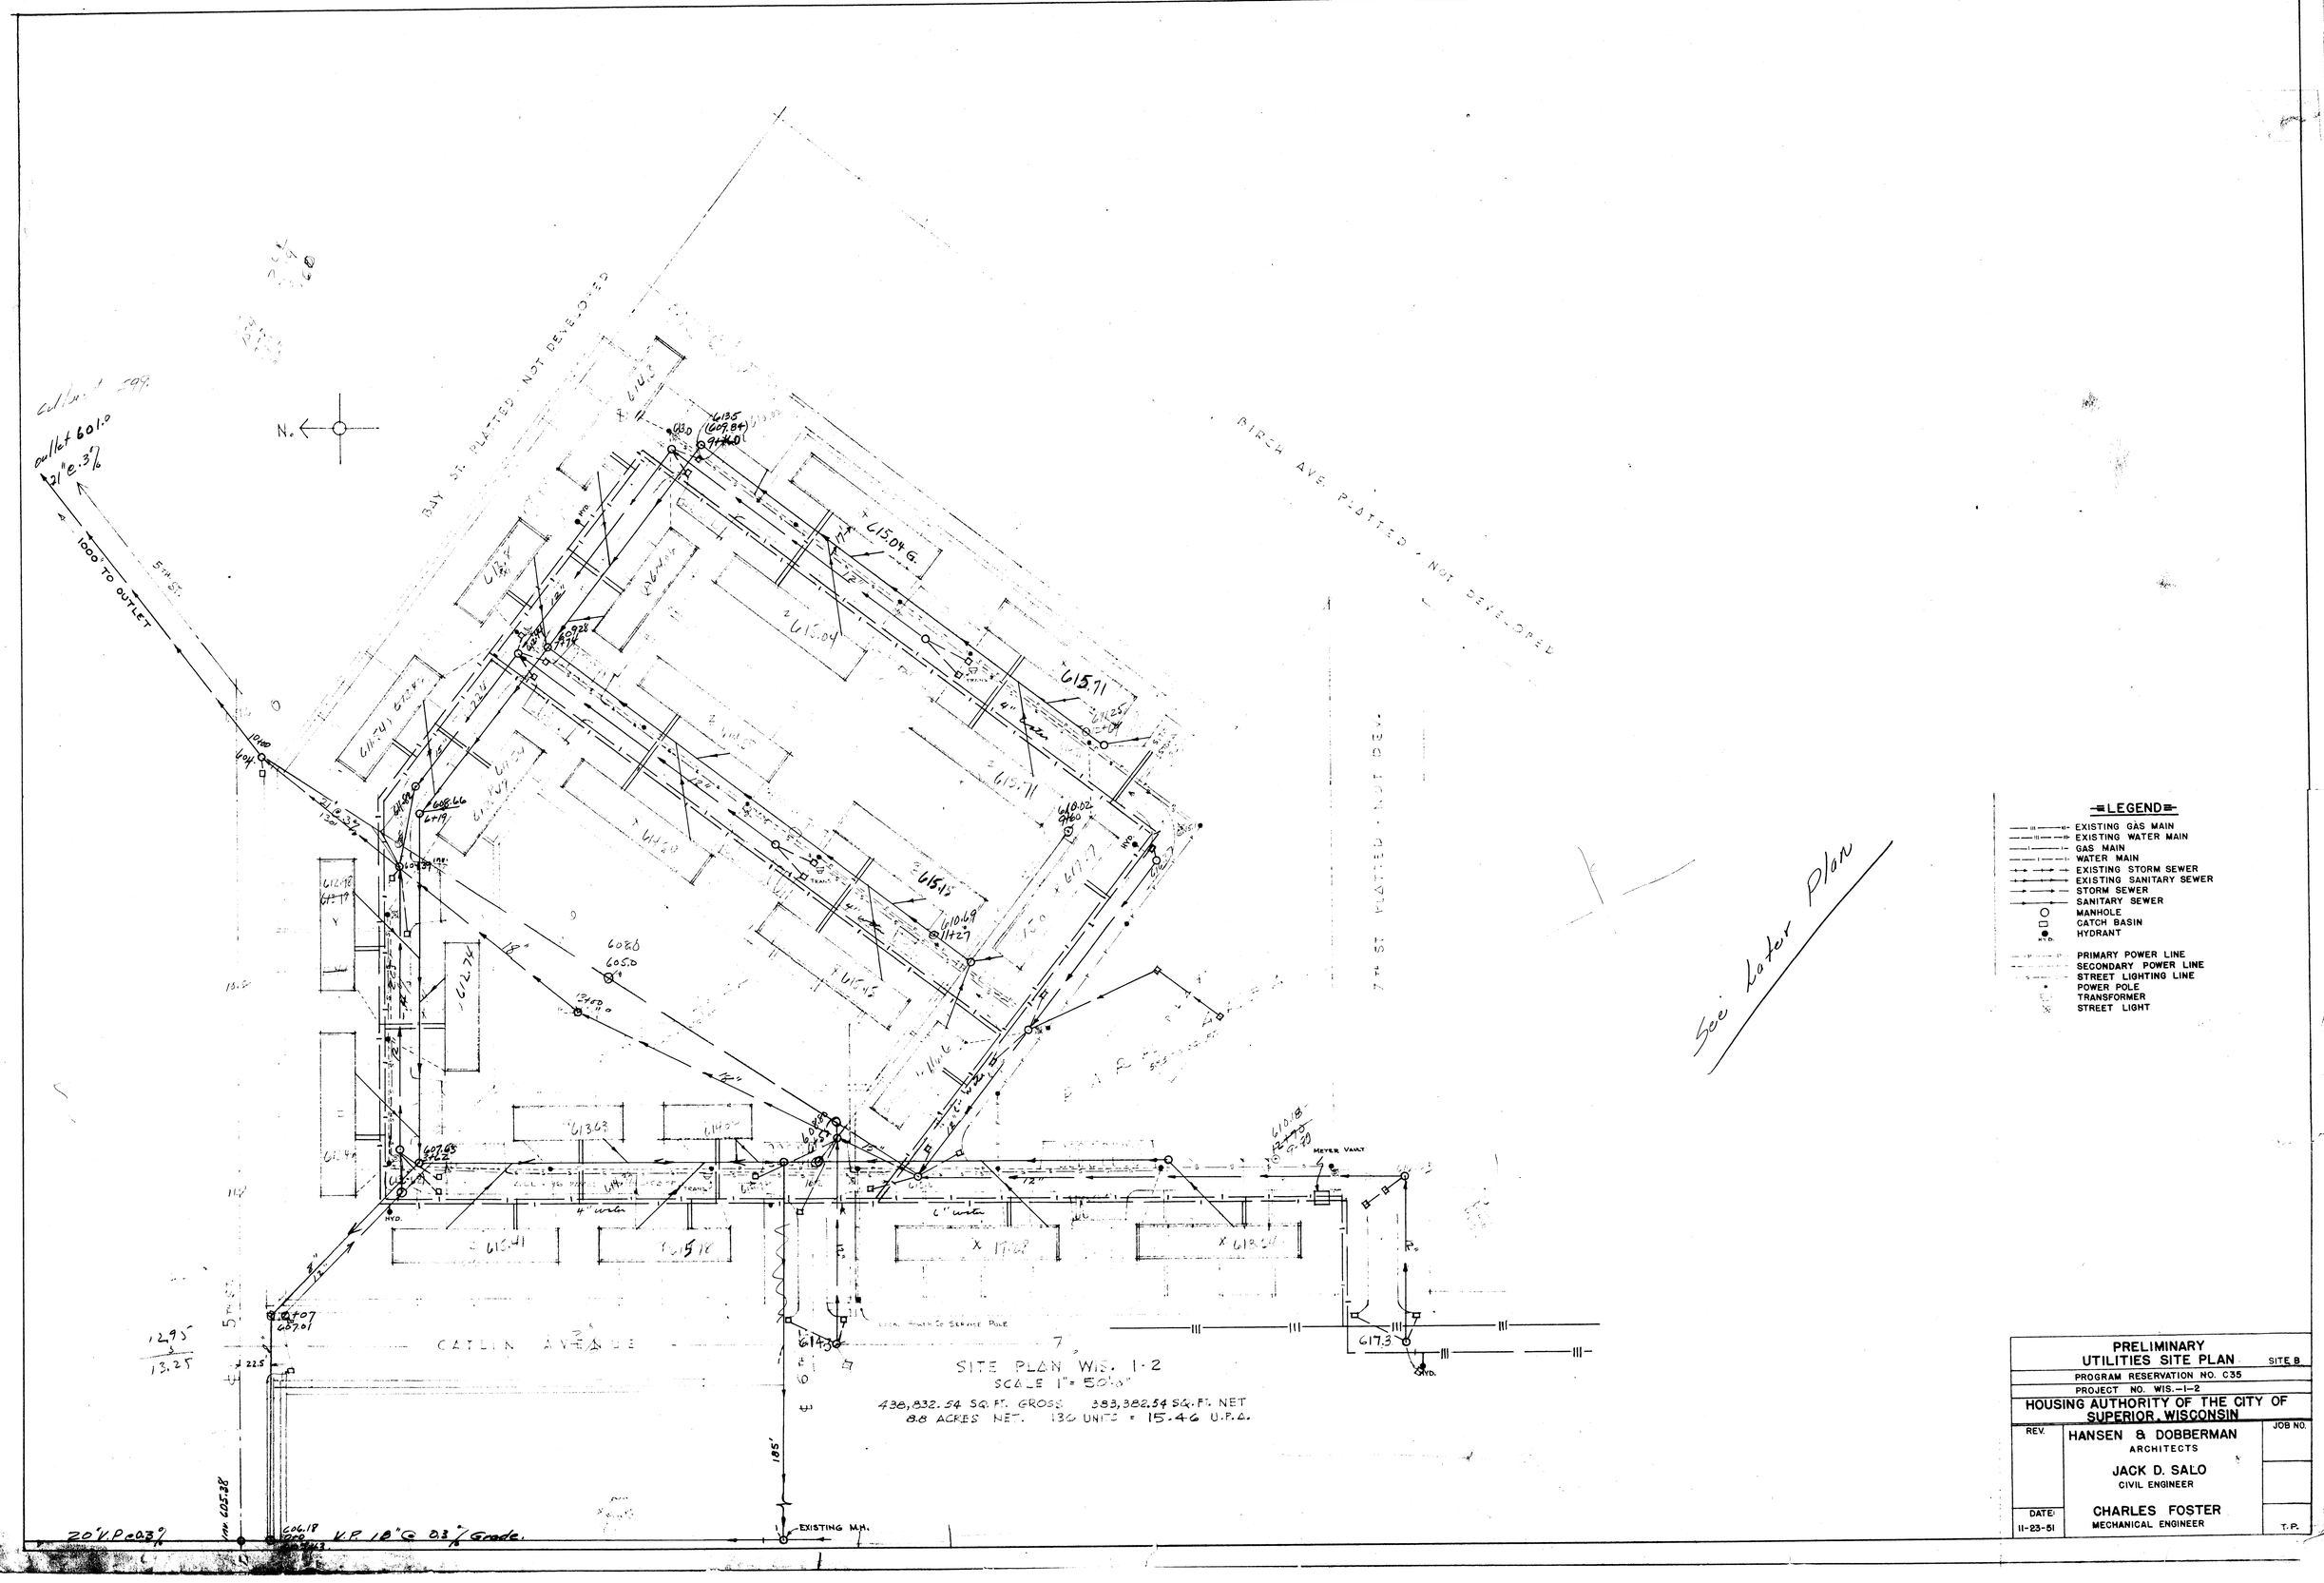

PRELIMINARY
UTILITIES SITE PLAN SITE B

PROGRAM RESERVATION NO. C35

PROJECT NO. WIS.-1-2

HOUSING AUTHORITY OF THE CITY OF SUPERIOR, WISCONSIN

REV.	HANSEN & DOBBERMAN ARCHITECTS	JOB NO.
	JACK D. SALO CIVIL ENGINEER	
DATE: 11-23-51	CHARLES FOSTER MECHANICAL ENGINEER	T.P.