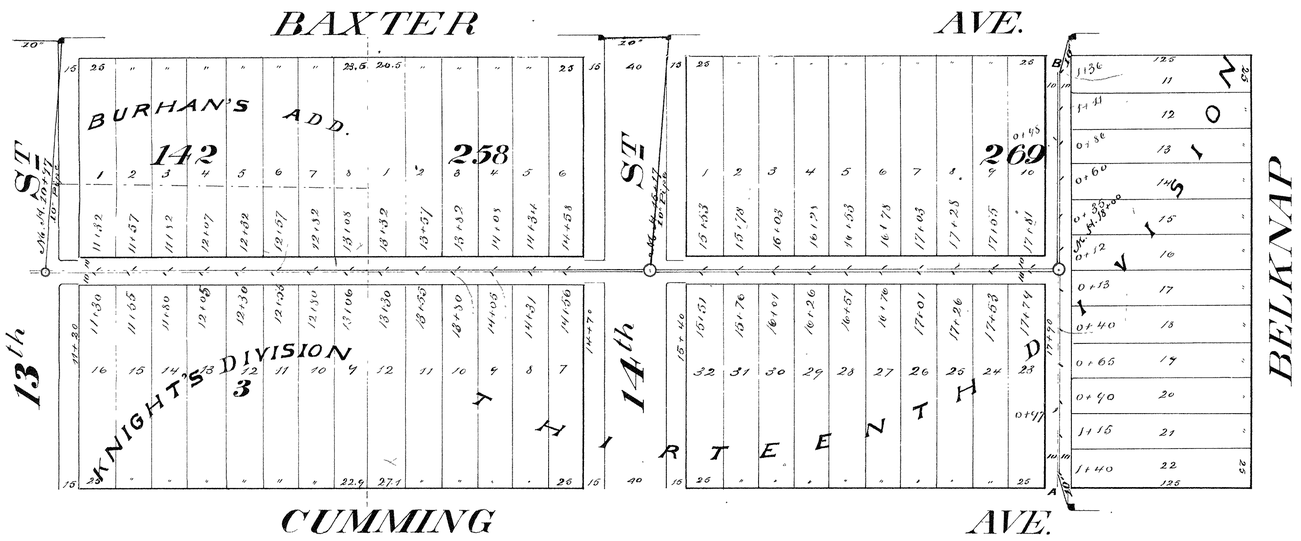

CITY OF SUPERIOR

SEWER PLAN

Contract let April 3, 1891
completed Aug. 20, 1891
Joseph Wolf Contractor.
P. J. McHugh, Inspector
E. B. Banks, City Engineer

Scale: { Horizontal 1 inch = 60 ft.
Vertical 1 inch = 4 "
Section 1 inch = 2 "

Section of 18 inch pipe

Section of 12 inch pipe

Section of 10 inch pipe

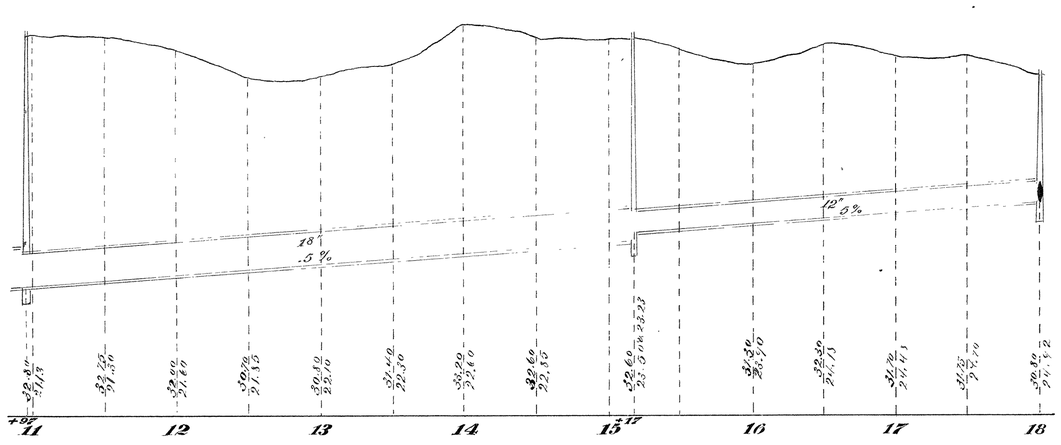

Profile of Sewer in Alley betw. Cumming & Baxter Ave's. from 13th St. So.

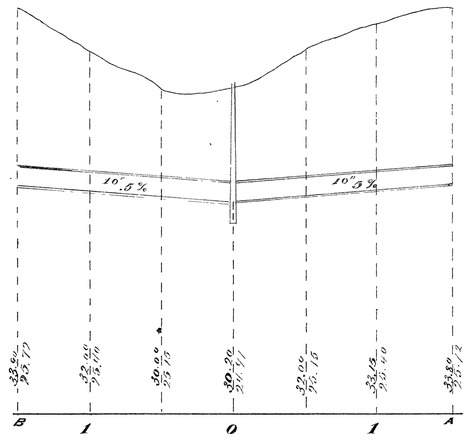

Section of Sewer from A to B

Base line 15' above City datum

2A-41