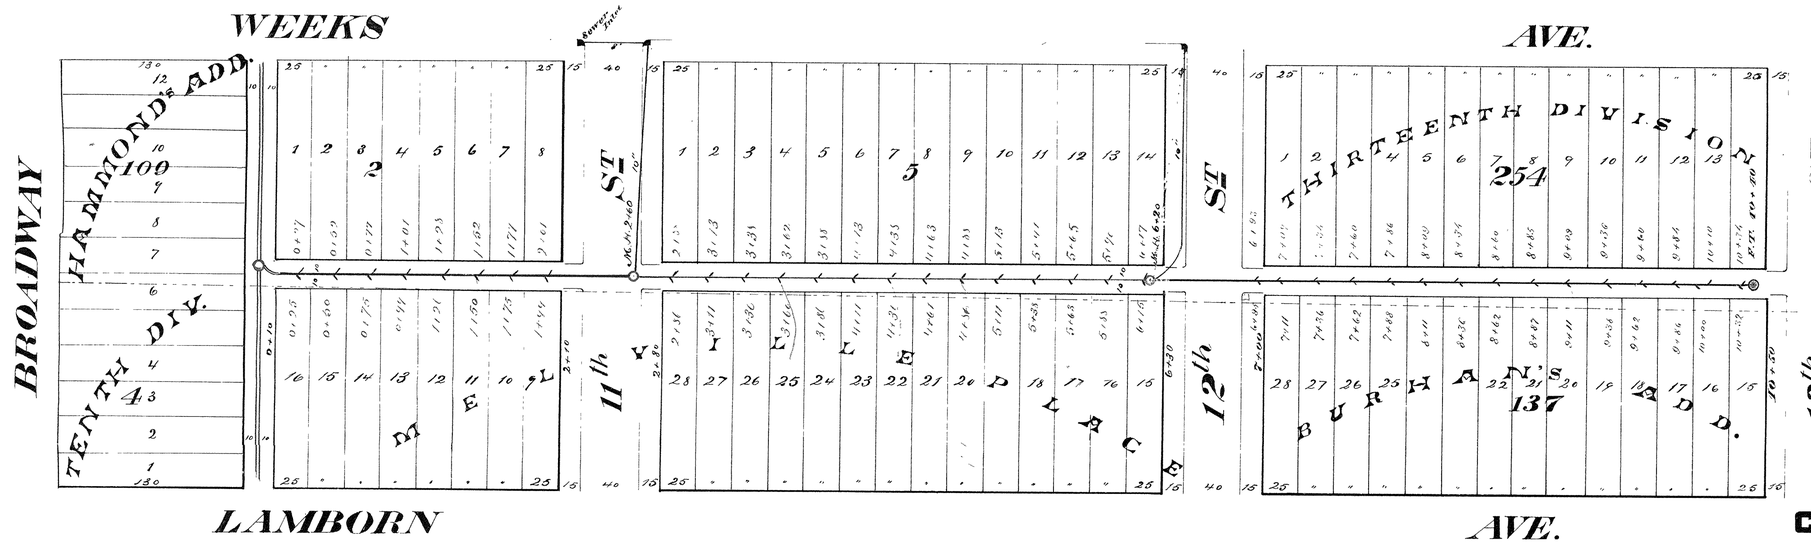

CITY OF SUPERIOR

SEWER PLAN

Contract - Bdwy. to 12th St. - let May 25, 1891
" completed June 27, 1891
Wolf & King, Contractor
Beale, Inspector
E. B. Banks, City Engineer
Contract - 12th to 13th St let Aug. 12, 1893
" completed Sept. 29, 1893
Monks Bros. Contractor
Frank Schwalback, Inspector
A. T. Thomas, City Engineer

Section of 12" Pipe

Section of 10" Pipe

Scale { Horizontal 1 inch = 60 ft.
Vertical 1 " = 40 "
Sectional 1 " = 2 "

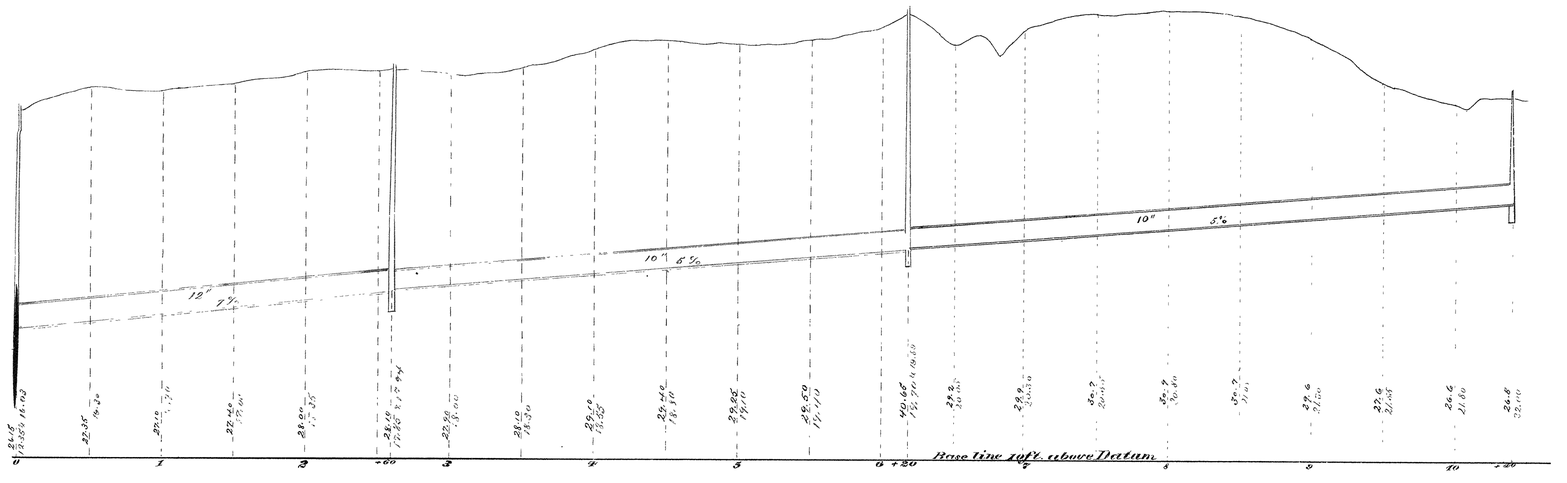

Plan & Profile of Sewer in Alley betw. Lamborn & Weeks Ave's Broadway South

2B-49