SECTION OF SEWER

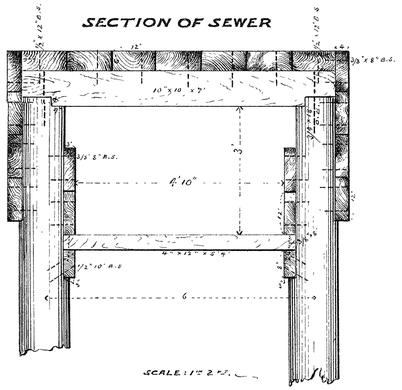

PLAN OF SEWER

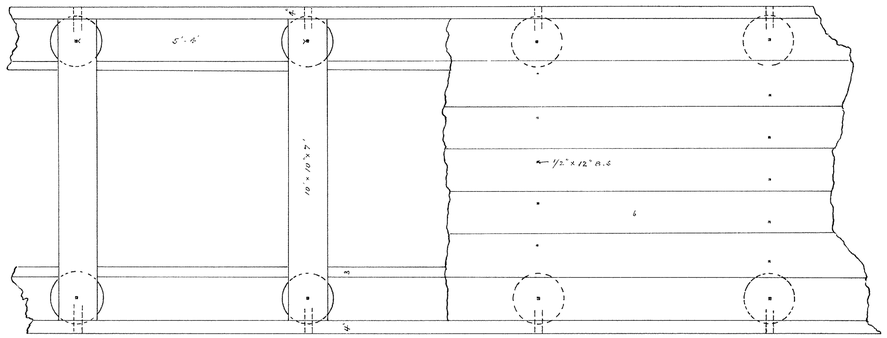

1903

CITY OF SUPERIOR

Map showing temporary outlet to the WINTER ST. SEWER

CONTRACT LET APRIL 8TH 1902

COMPLETED MAY 15TH 1902

CONT. # 668 G.W. PETERSON CONTR

JOHN McGRATH INSPECTOR

HOWARD THOMAS CITY ENGR

SCALE: 1" = 100 FT.

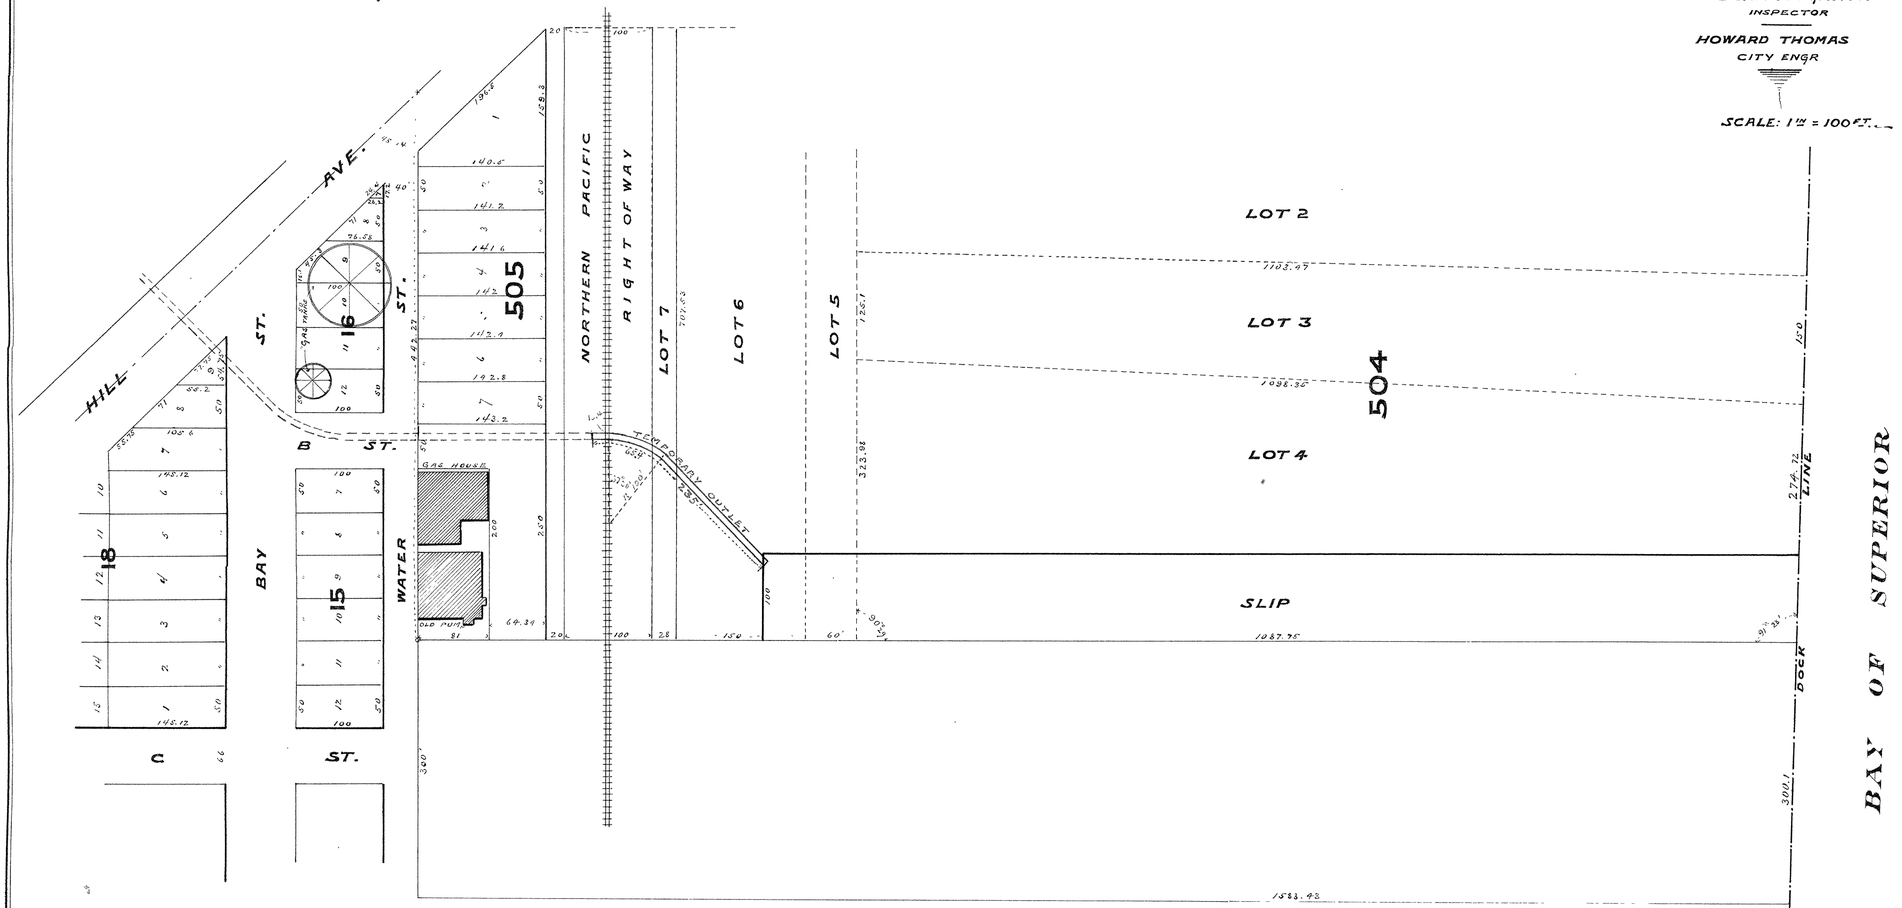

2B-60½

J.A. MURRAY DRAUGHTSMAN