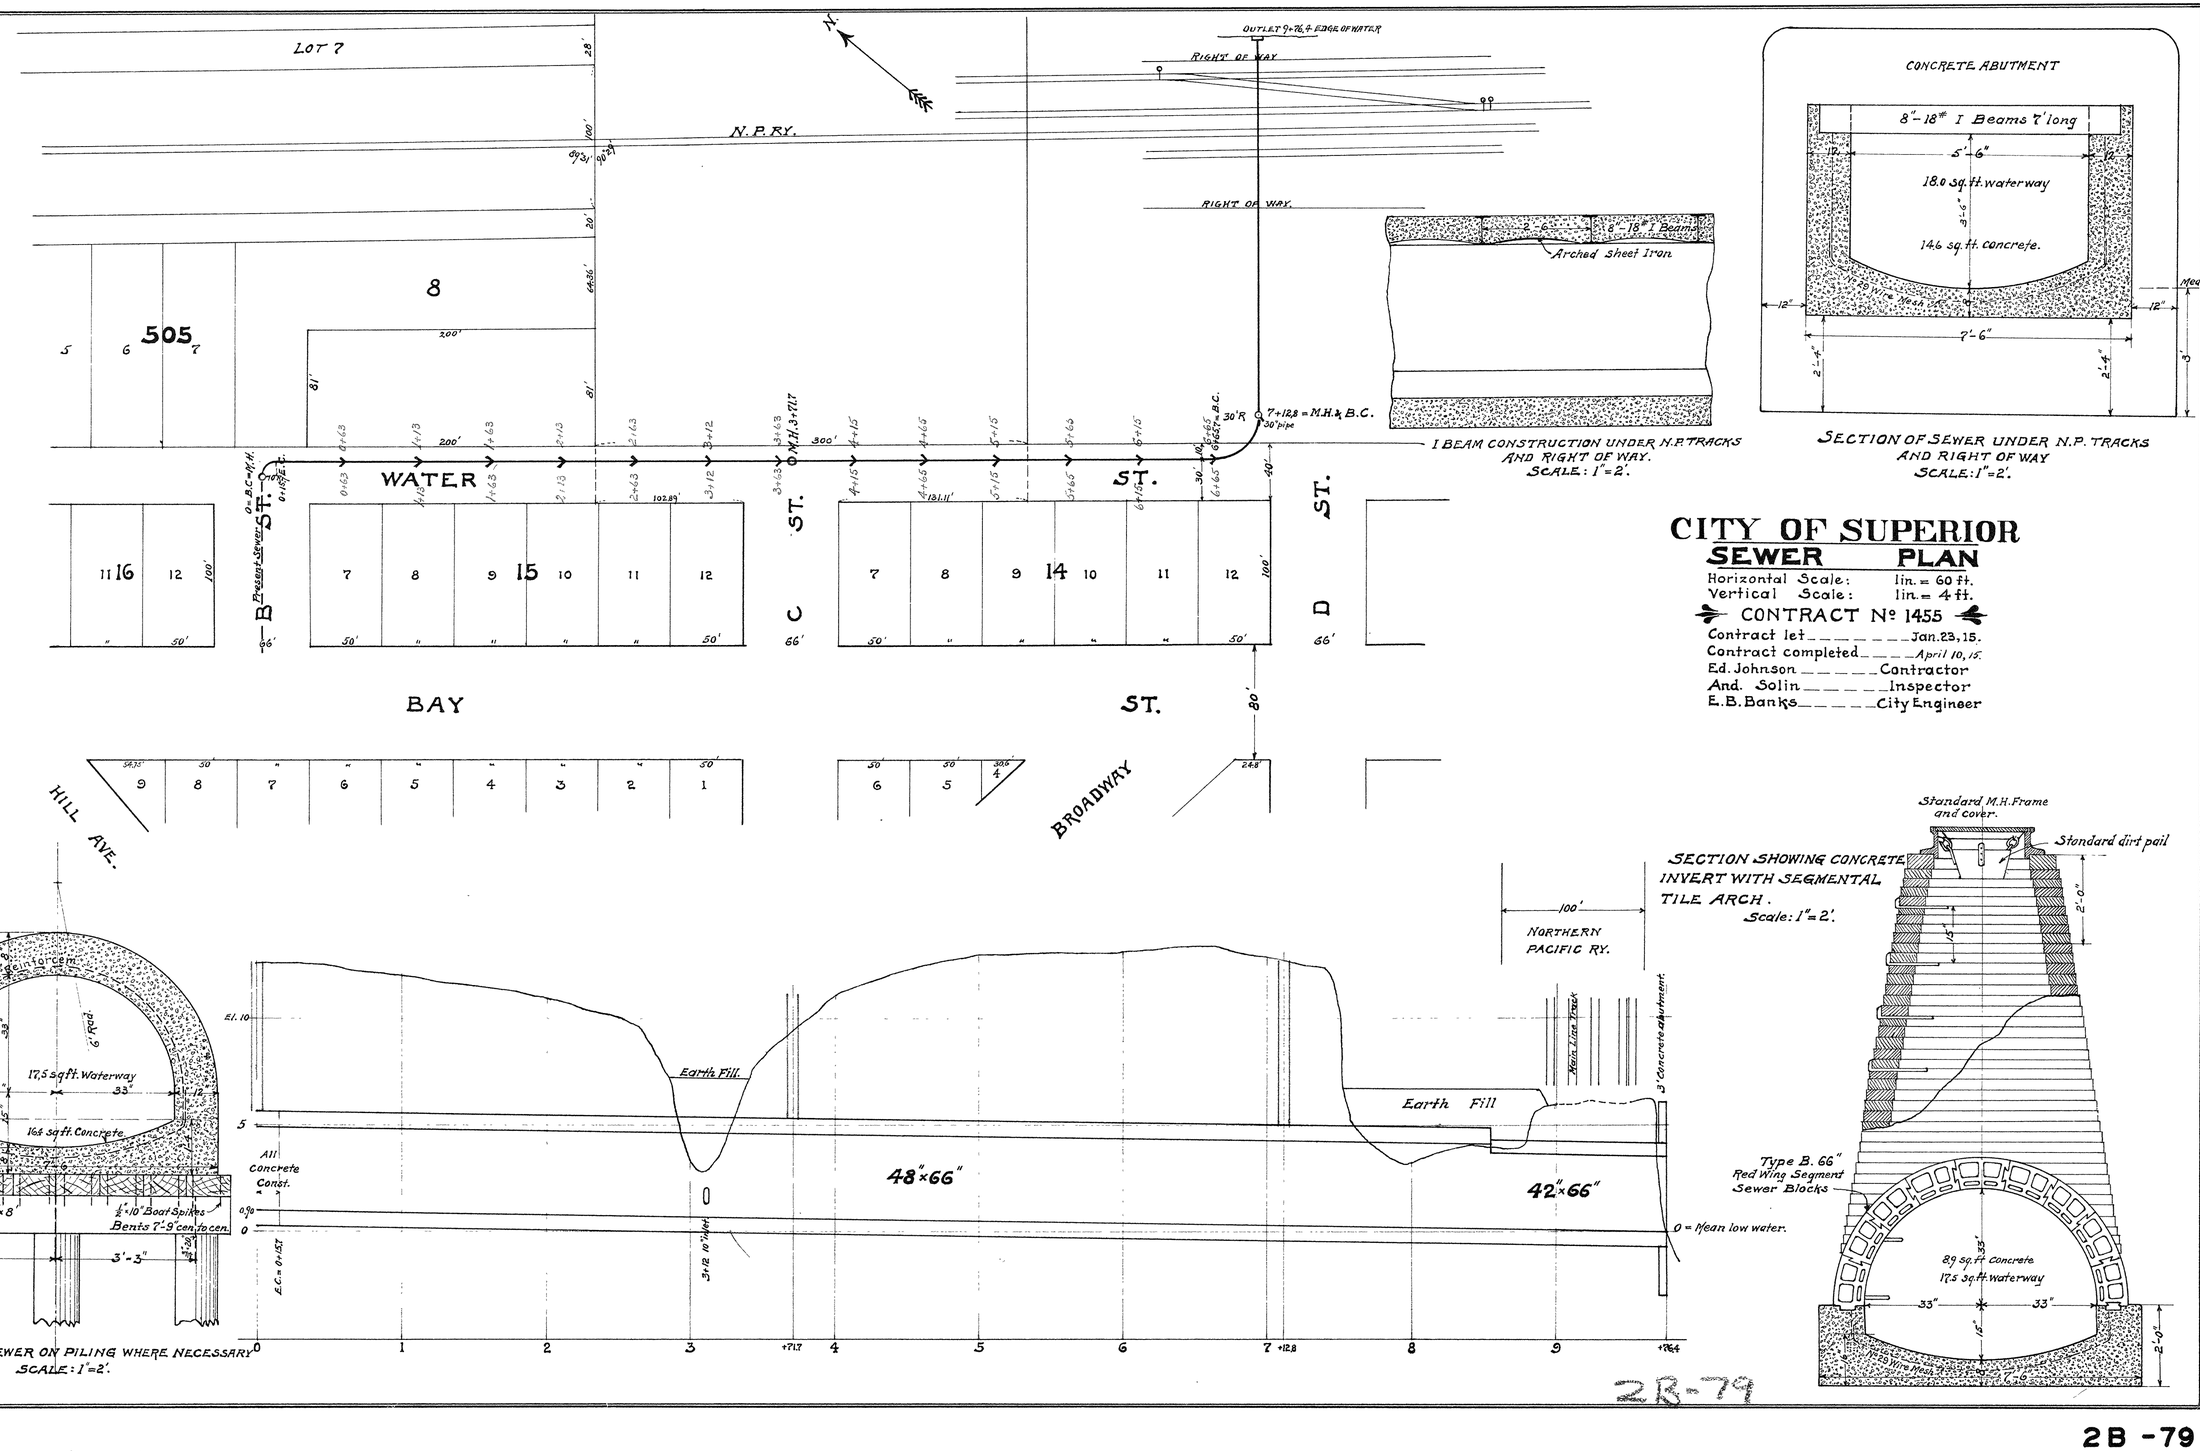

CITY OF SUPERIOR

SEWER PLAN

Horizontal Scale: 1in. = 60 ft.
Vertical Scale: 1in. = 4 ft.

CONTRACT Nº 1455

Contract let _____ Jan. 23, 15.
Contract completed _____ April 10, 15.
Ed. Johnson _____ Contractor
And. Solin _____ Inspector
E.B. Banks _____ City Engineer

2B-79