CITY OF SUPERIOR WISC.

MAP AND PROFILE SHOWING SEWER IN D ST. FROM ALLEY BET. W. 2ND AND W. 3RD STS. TO ALLEY BET. W. 3RD AND W. 4TH STS. AND IN ALLEY BET. W. 3RD AND W. 4TH STS. FROM D ST. TO F ST. AND IN F ST. FROM THE ALLEY BET. W. 3RD AND W. 4TH STS. TO THE ALLEY BET. W. 4TH AND W. 5TH STS. AND IN THE ALLEY BET. W. 4TH AND W. 5TH STS. FROM F ST. TO H ST.

HORIZONTAL SCALE: 1 IN = 100 FT.
VERTICAL SCALE: 1 IN = 40 FT.
CONTRACT No. 1648
CONTRACT LET JAN. 3RD 1922
CONTRACT COMPLETED MAR. 15TH 1922
CITY OF SUPERIOR CONTRACTOR
SID RITCHES INSPECTOR
E.B. BANKS CITY ENGINEER

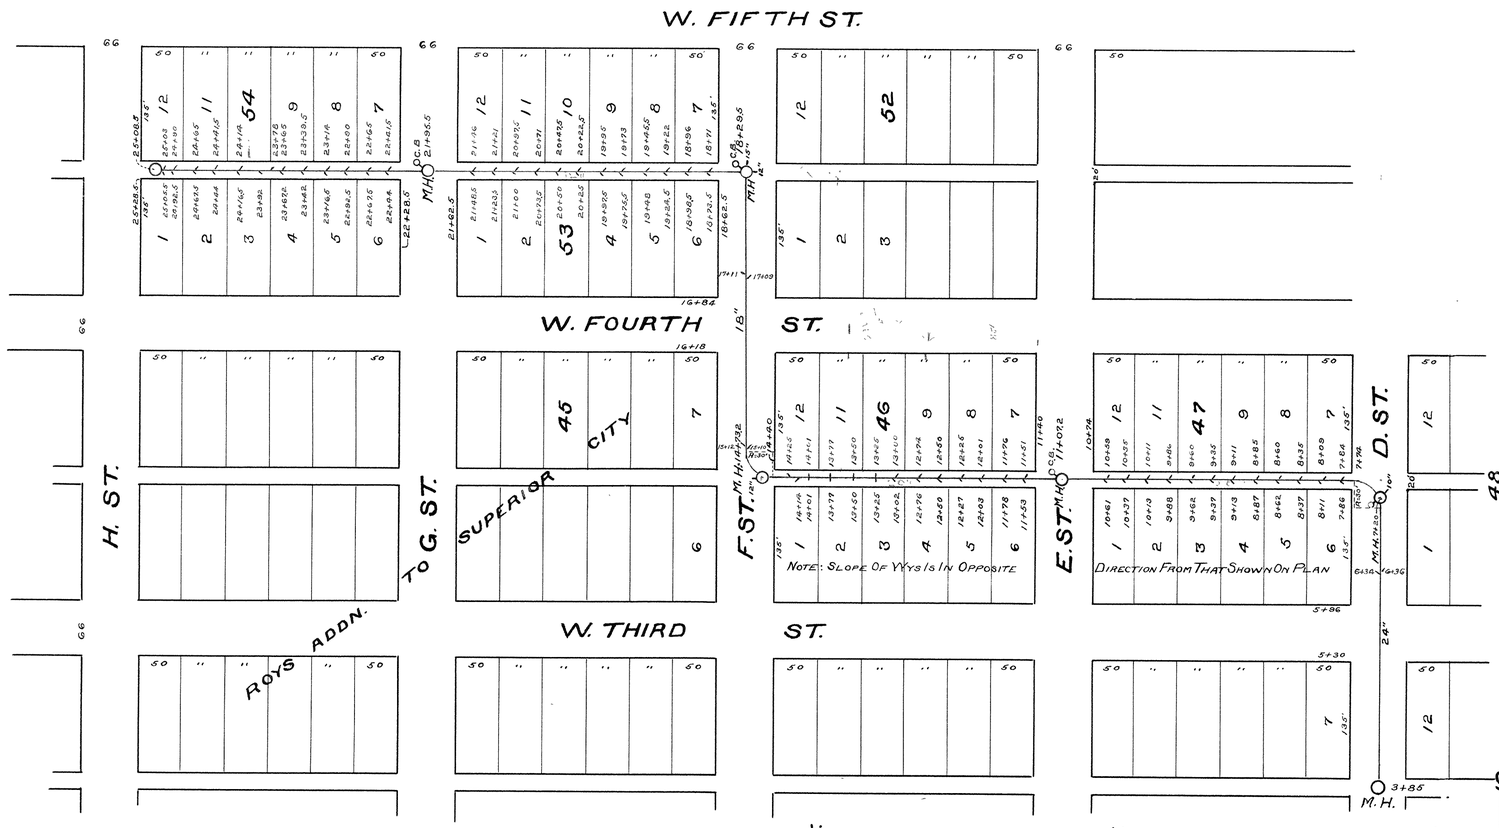

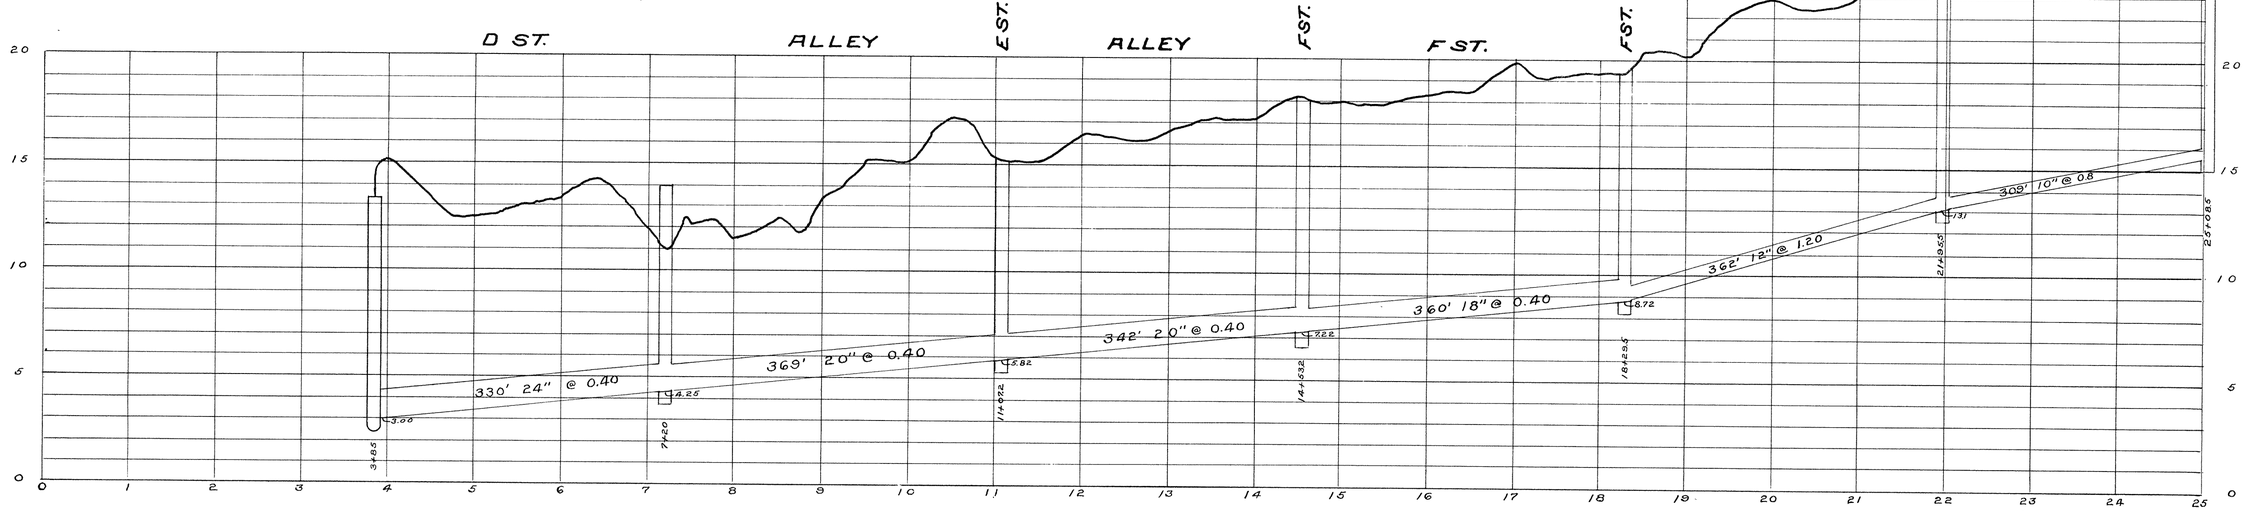

2B-81

2B-81