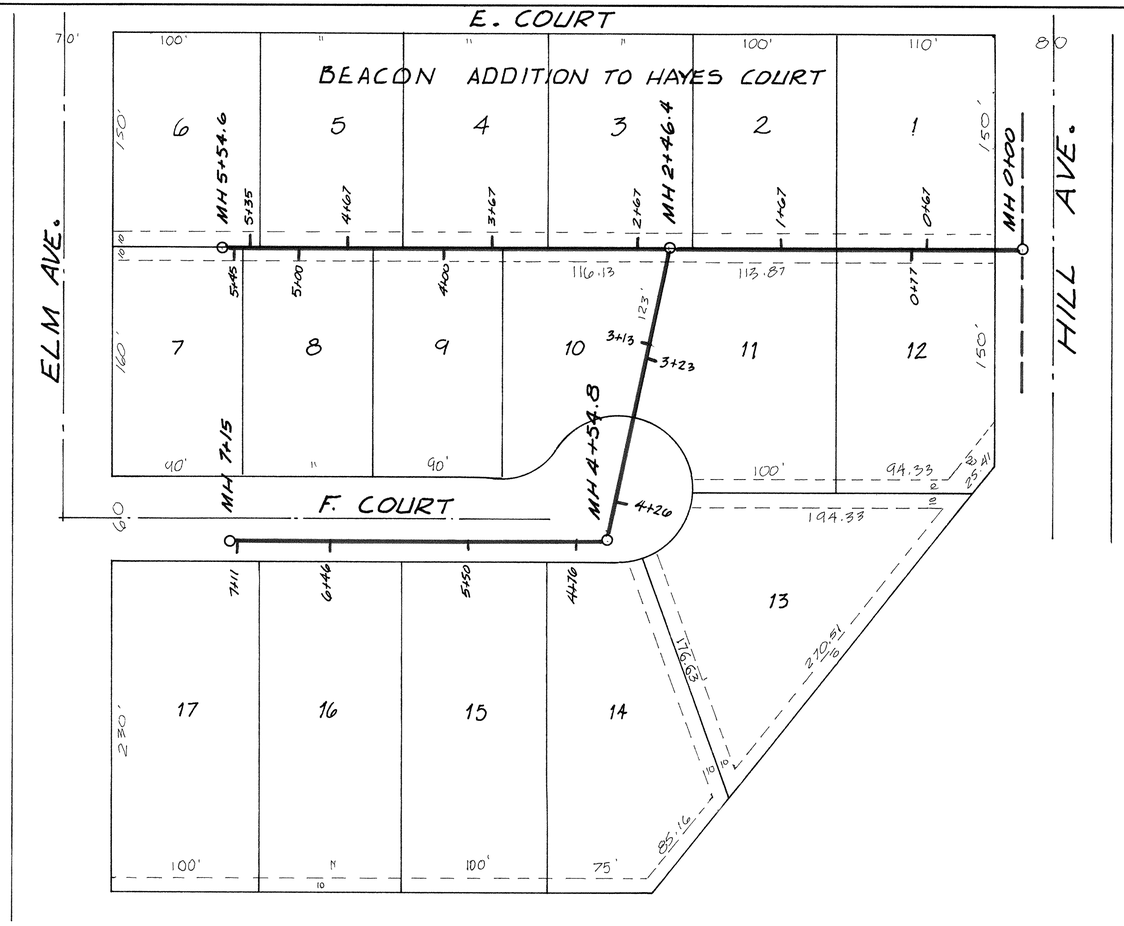

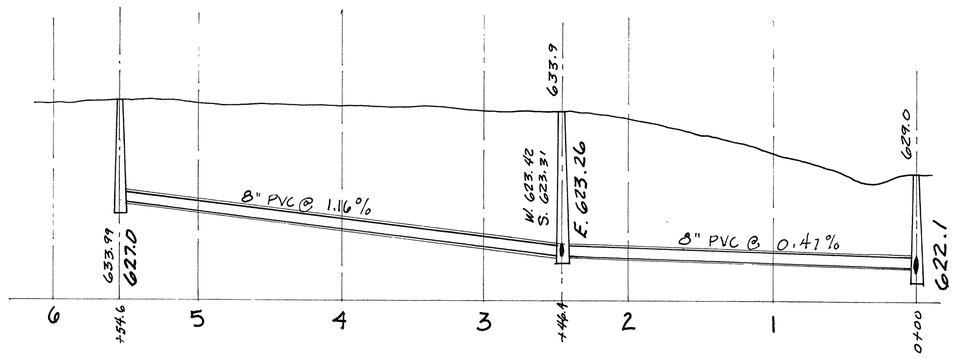

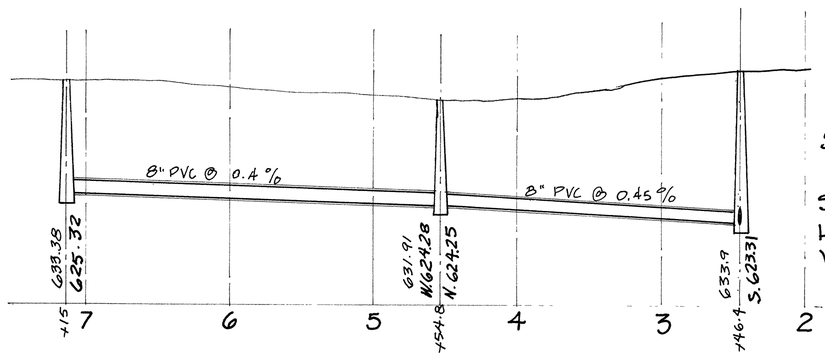

CITY OF SUPERIOR
SANITARY SEWER EXT.
1979
SEWER DISTRICT # 2B
HORIZONTAL SCALE 1"=60'
VERTICAL SCALE 1"=6'

2B-82 B