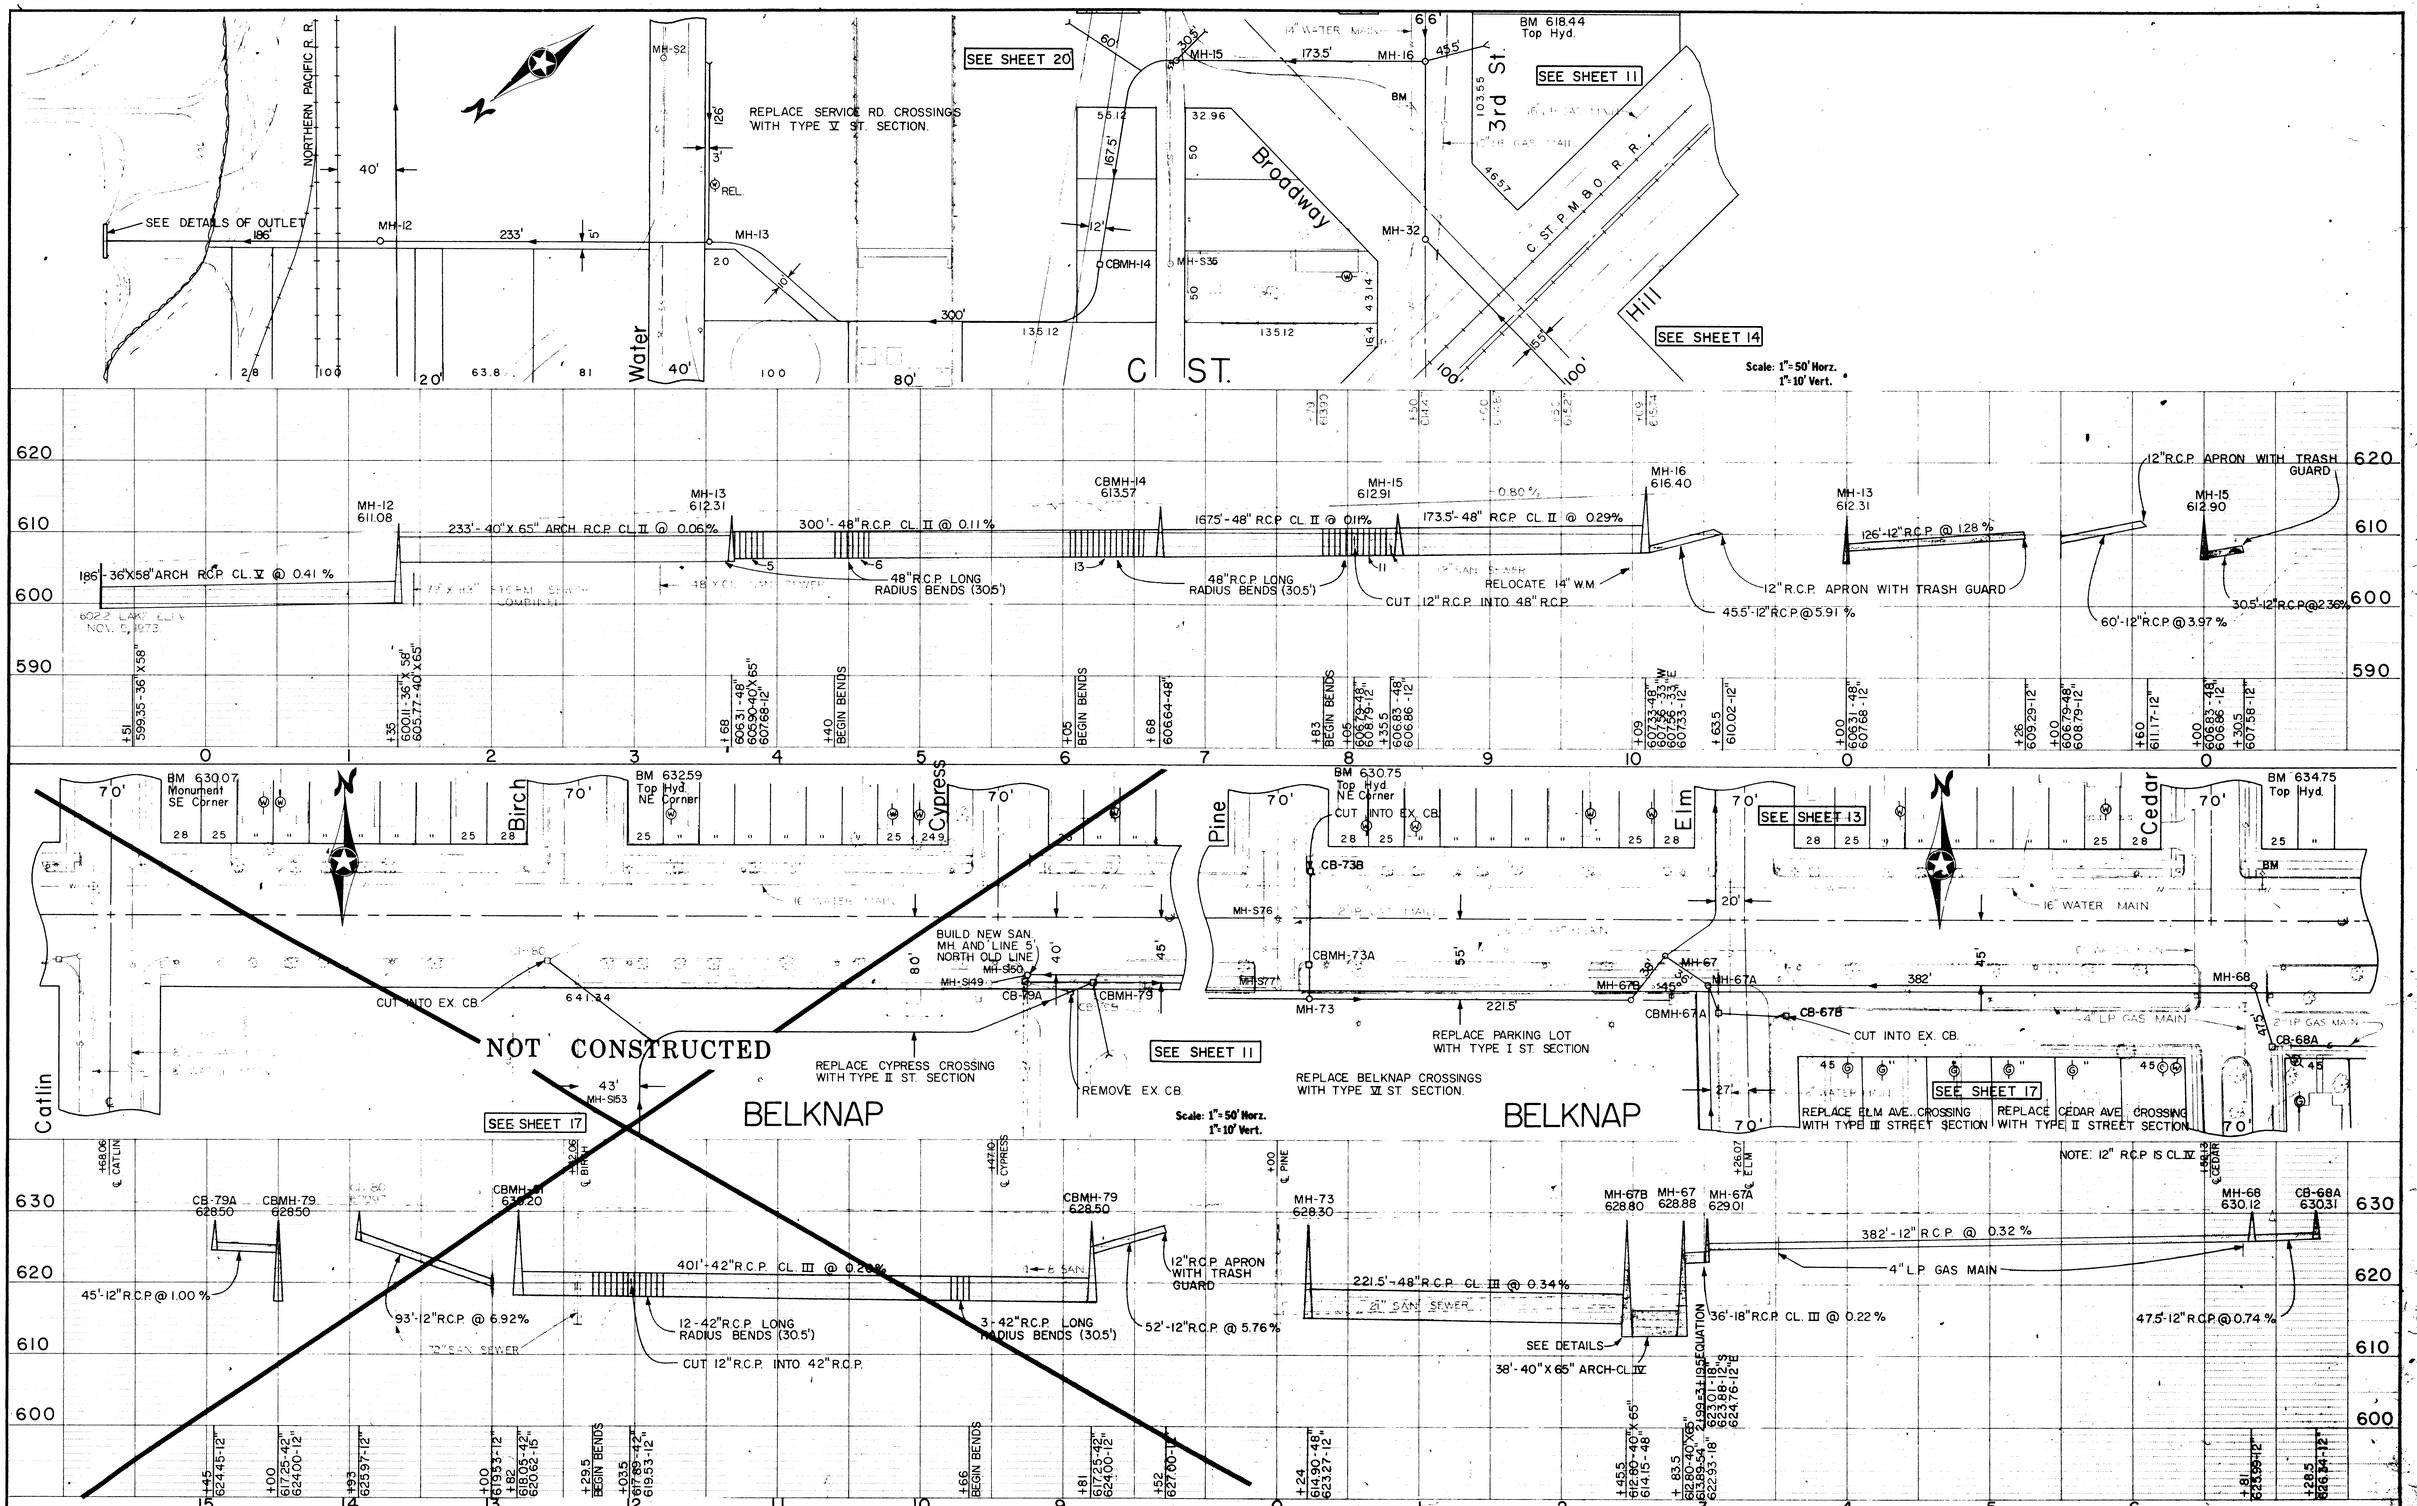

SURVEY	DCB	REVISIONS	
DRAWN	DCB	RECORD PLAN	
DESIGN	DCB	1/16/79 HBR	
APPROV'D	GRC		

I HEREBY CERTIFY THAT THIS PLAN WAS PREPARED BY ME OR UNDER MY DIRECT SUPERVISION AND THAT I AM A DULY REGISTERED PROFESSIONAL ENGINEER UNDER THE LAWS OF THE STATE OF WISCONSIN

DATE AUG. 19, 1974 REG. NO. E06599

BONESTROO, ROSENE, ANDERLIK & ASSOC., INC.
ST. PAUL, MINNESOTA

SUPERIOR, WISCONSIN

DATE: JUNE 14, 1974 COMM. 6888 H

DISTRICT 2 - CENTRAL BUSINESS STORM SEWER SEPARATION

C ST. & BELKNAP ST.

SHEET 10 / 20