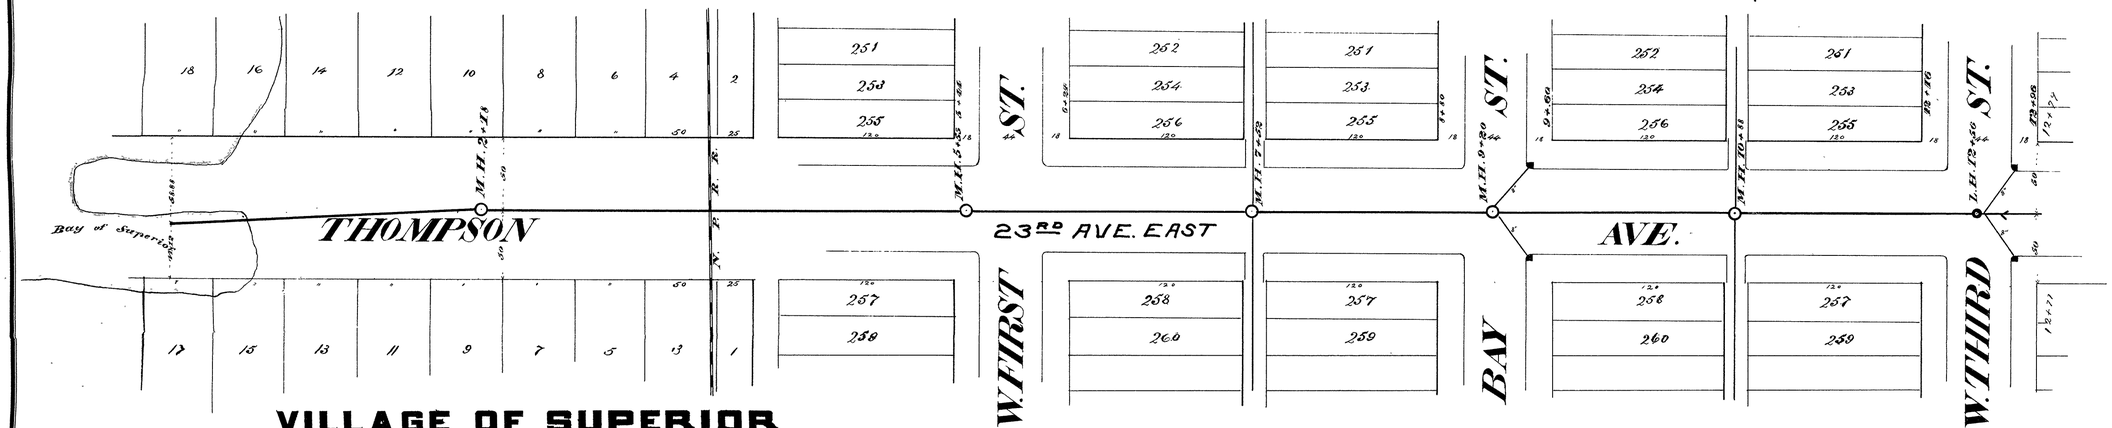

VILLAGE OF SUPERIOR

SEWER PLAN

Contract let July 17, 1888 (1st st. to 3d)
completed
Youngreen & Gleason, Contractor
Frank Grace, Inspector
E. B. Banks, Village Engr.
Extension (Outlet) built by Dole
betw. June 17 to Aug. 10, 1891

1893

Longitudinal Section of Sewer Outlet

Section of 24" Sewer on Piles

Scale: Horizontal 1" = 60'
Vertical 1" = 4'
Section 1" = 2'

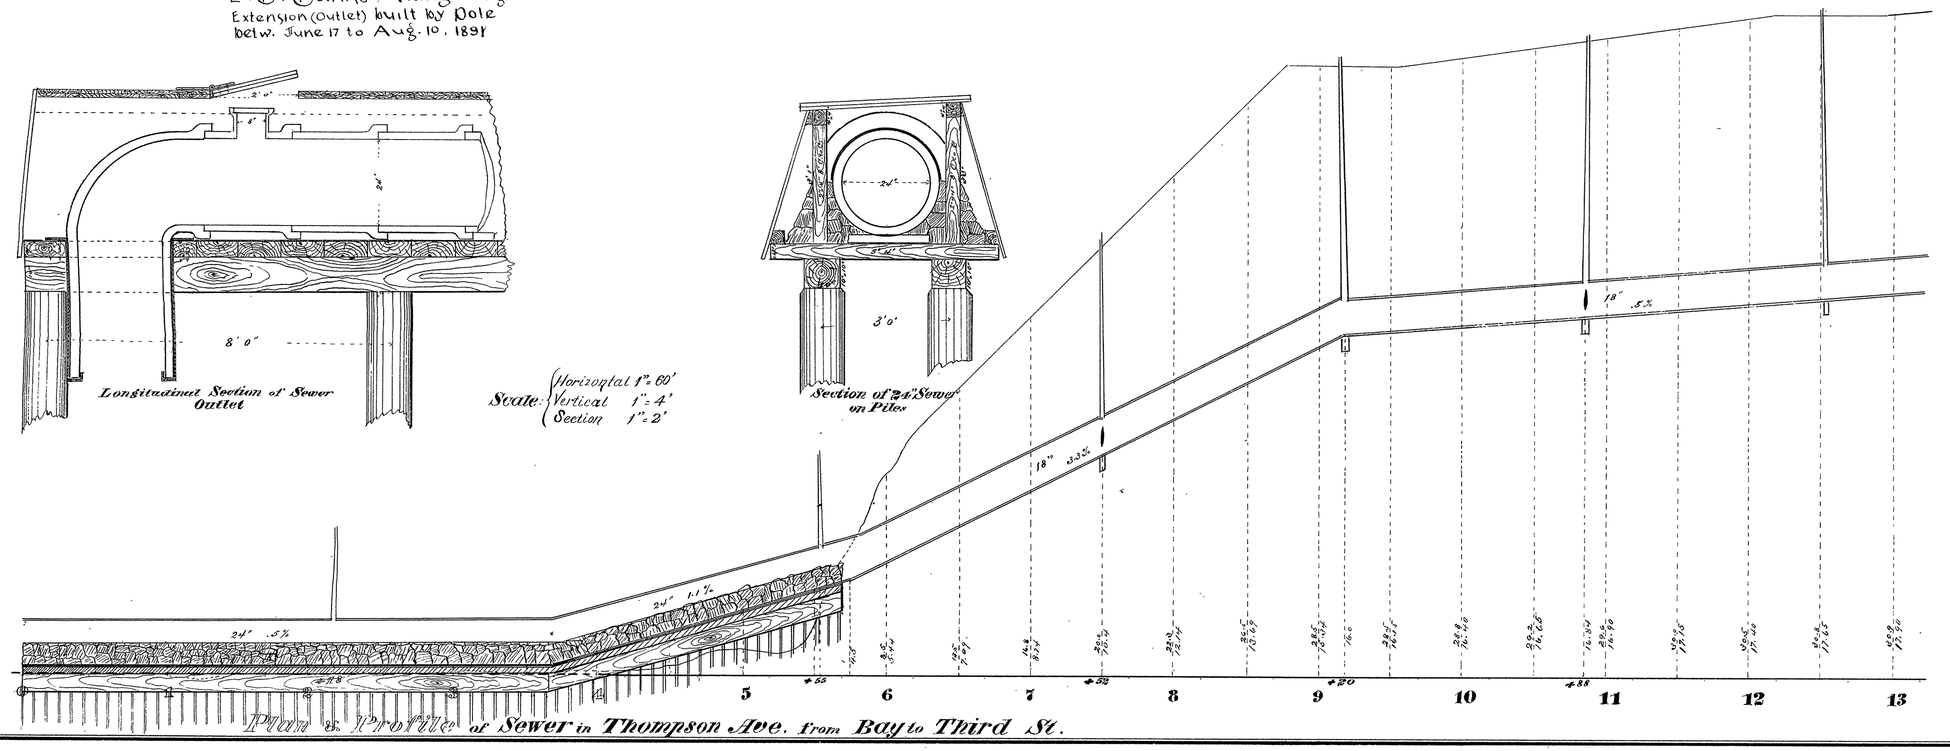

Plan & Profile of Sewer in Thompson Ave. from Bay to Third St.

4-20