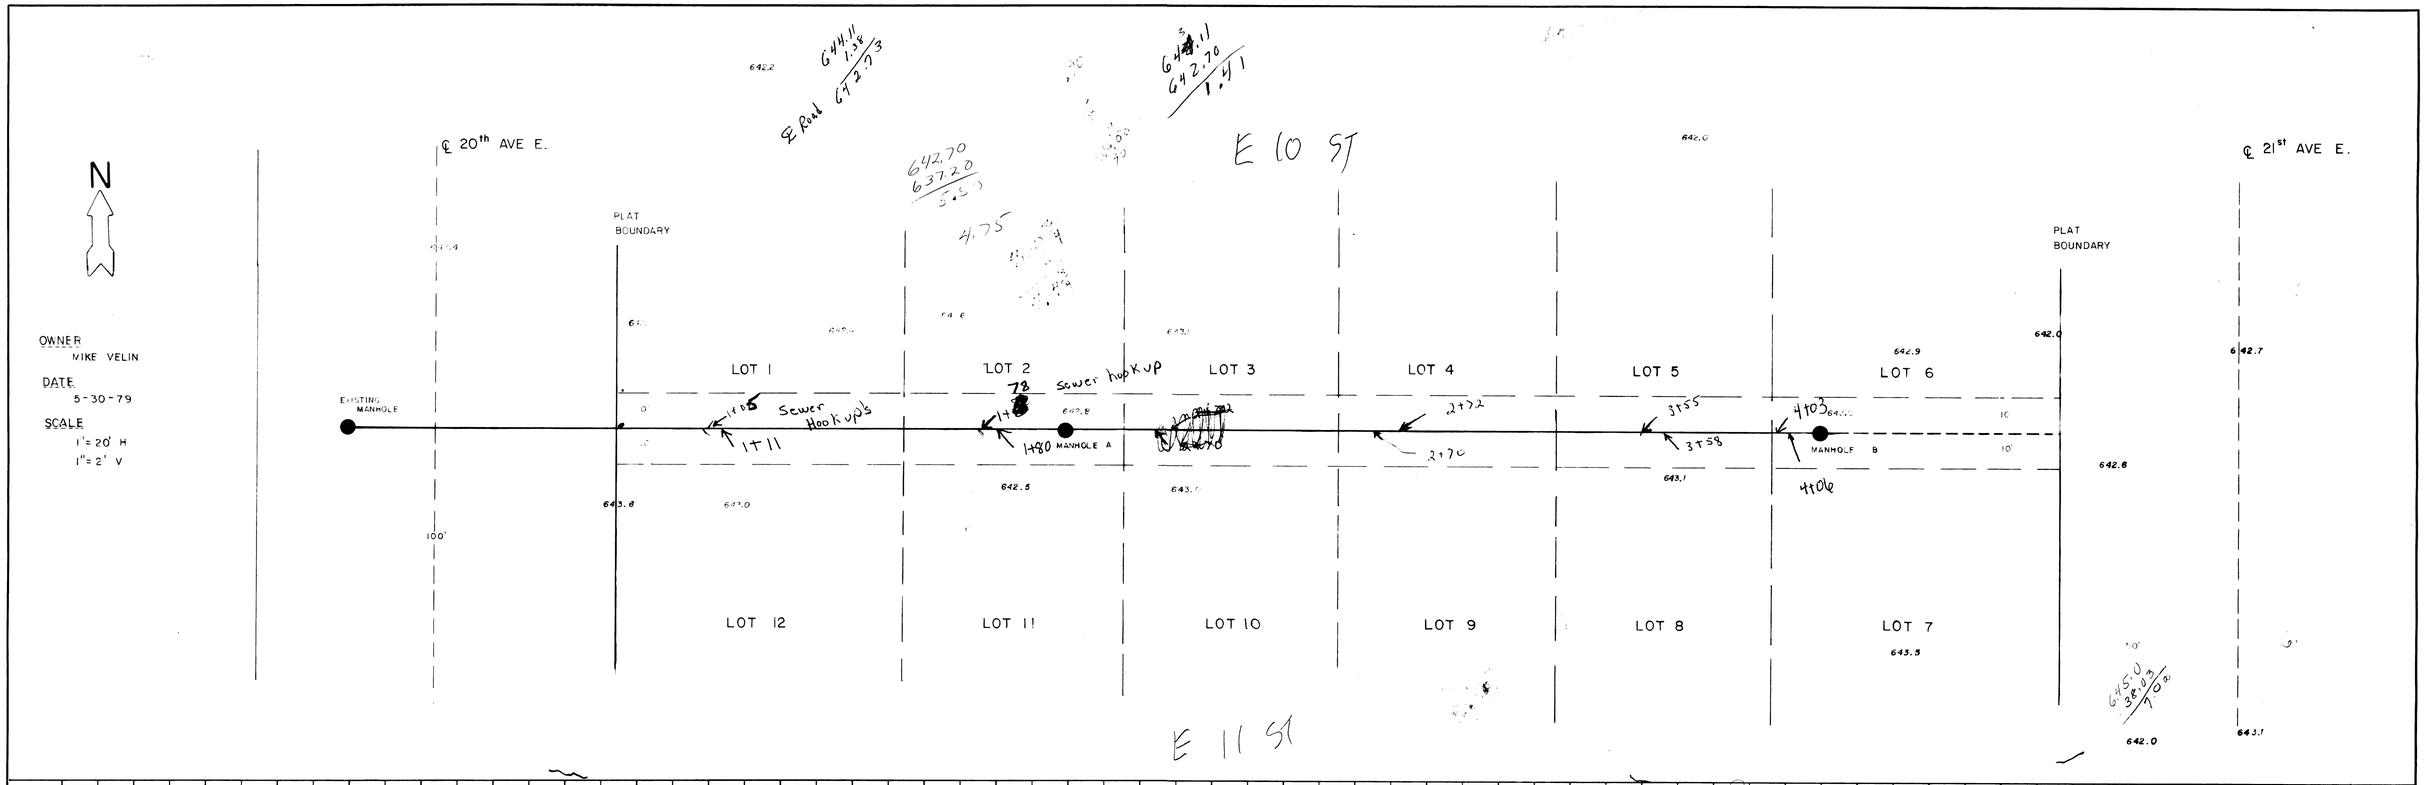

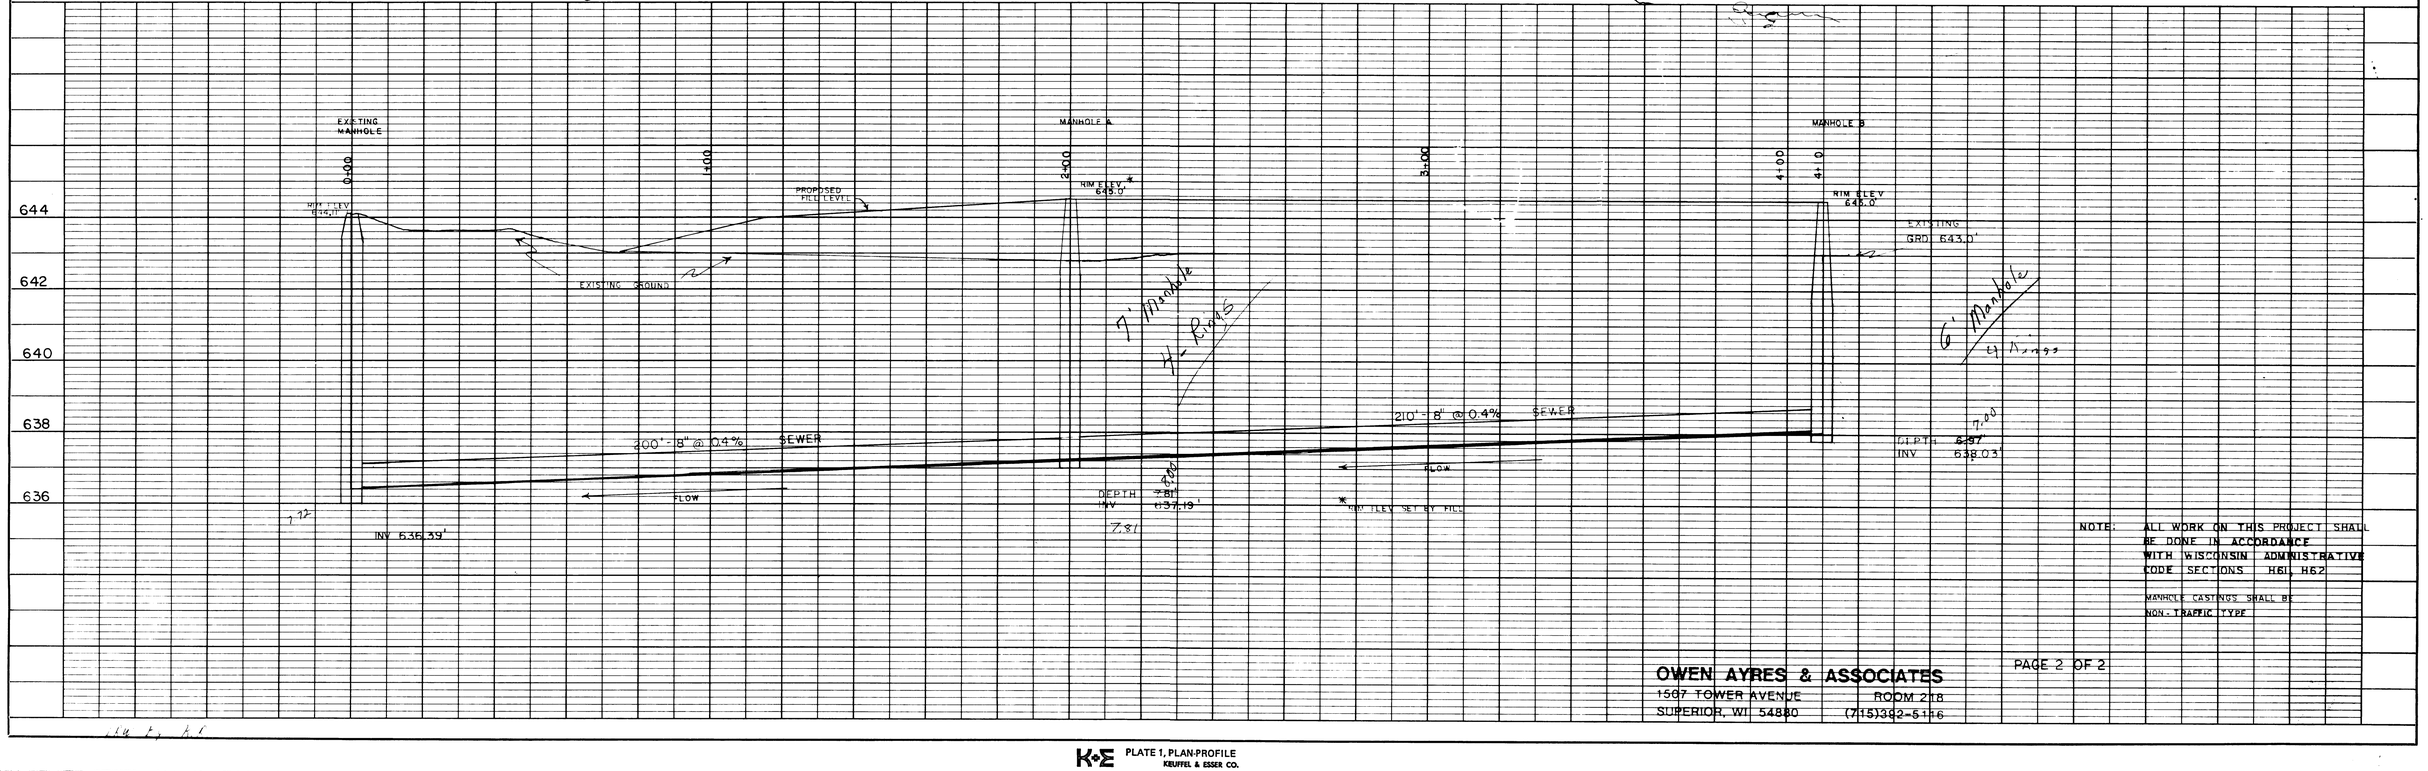

NOTE: ALL WORK ON THIS PROJECT SHALL BE DONE IN ACCORDANCE WITH WISCONSIN ADMINISTRATIVE CODE SECTIONS H61, H62

MANHOLE CASTINGS SHALL BE NON-TRAFFIC TYPE

PAGE 2 OF 2

OWEN AYRES & ASSOCIATES
1507 TOWER AVENUE ROOM 218
SUPERIOR, WI 54880 (715)392-5116

PLAN NOTE BOOK No. SURVEYED. PLOTTED. ALIGNMENT CHECKED. RT. OF WAY CHECKED. BY DATE

PROFILE NOTE BOOK No. SURVEYED. PLOTTED. GRADES CHECKED. B. M.'s NOTED. STRUCTURE NOTATIONS CHECKED. BY DATE

K+E PLATE 1, PLAN-PROFILE KEUFFEL & ESSER CO.
48 7020 MADE IN U.S.A.