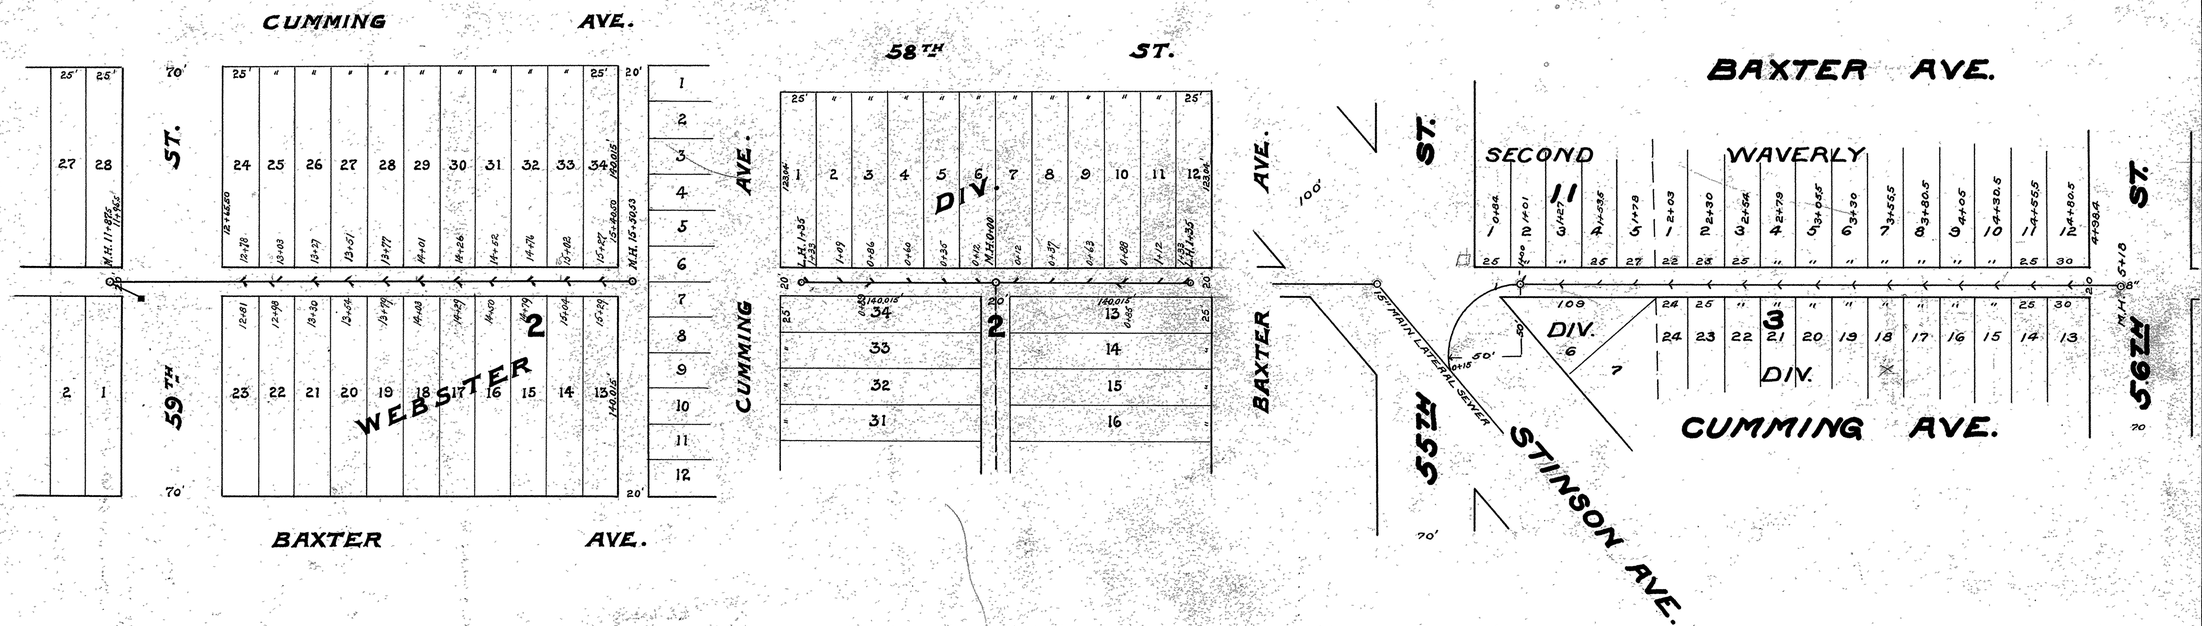

CITY OF SUPERIOR

SEWER PLAN

Horizontal Scale: 1in.= 60 ft.
Vertical Scale: 1in.= 4 ft.

CONTRACT Nº 1461

Contract let _____ March 8-1915
Contract completed _____ April 15-1915.
E. G. Moe _____ Contractor
Martin Nelson _____ Inspector
E. B. Banks _____ City Engineer

SEWER IN ALLEY BETWEEN CUMMING AND BAXTER AVE'S.
FROM 55TH ST. TO 56TH ST.

CONTRACT Nº 1662 CONTRACT COMPLETED JAN. 6TH 1923
MAGNUS PETERSON — CONTRACTOR
E. M. STEFFENSON — INSPECTOR
E. B. BANKS — CITY ENGINEER

HORIZONTAL SCALE: 1 IN.=60 FT. VERTICAL SCALE: 1 IN.=4 FT.

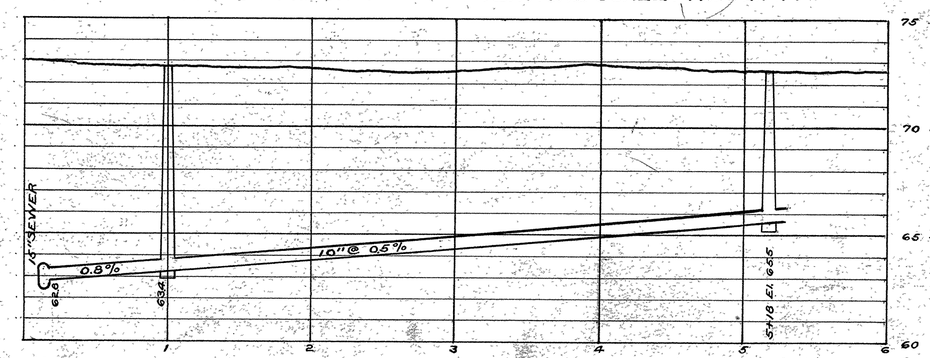

5-37