

PLAN
 NORTH
 1" = 40'

PROFILE
 VERTICAL
 1" = 4'

B.M. 47.54 TEL POLE RT. 88+25

B.M. 50.69 BOLT IN P. POLE 94+50
 B.M. 51.44 WOOD HUB 91+15 LT

(3) B.M. 50.70 - NAIL IN P. POLE S.W. CORNER HILL & 28TH ST.

(2) T.P. 51.98 1 P. 350' SO. 28TH ST. 25' E. STA 98+08 ± SEWER
 (3) T.P. 52.60 1 P. 700' SO. 28TH ST 23' E ± HILL AVE.

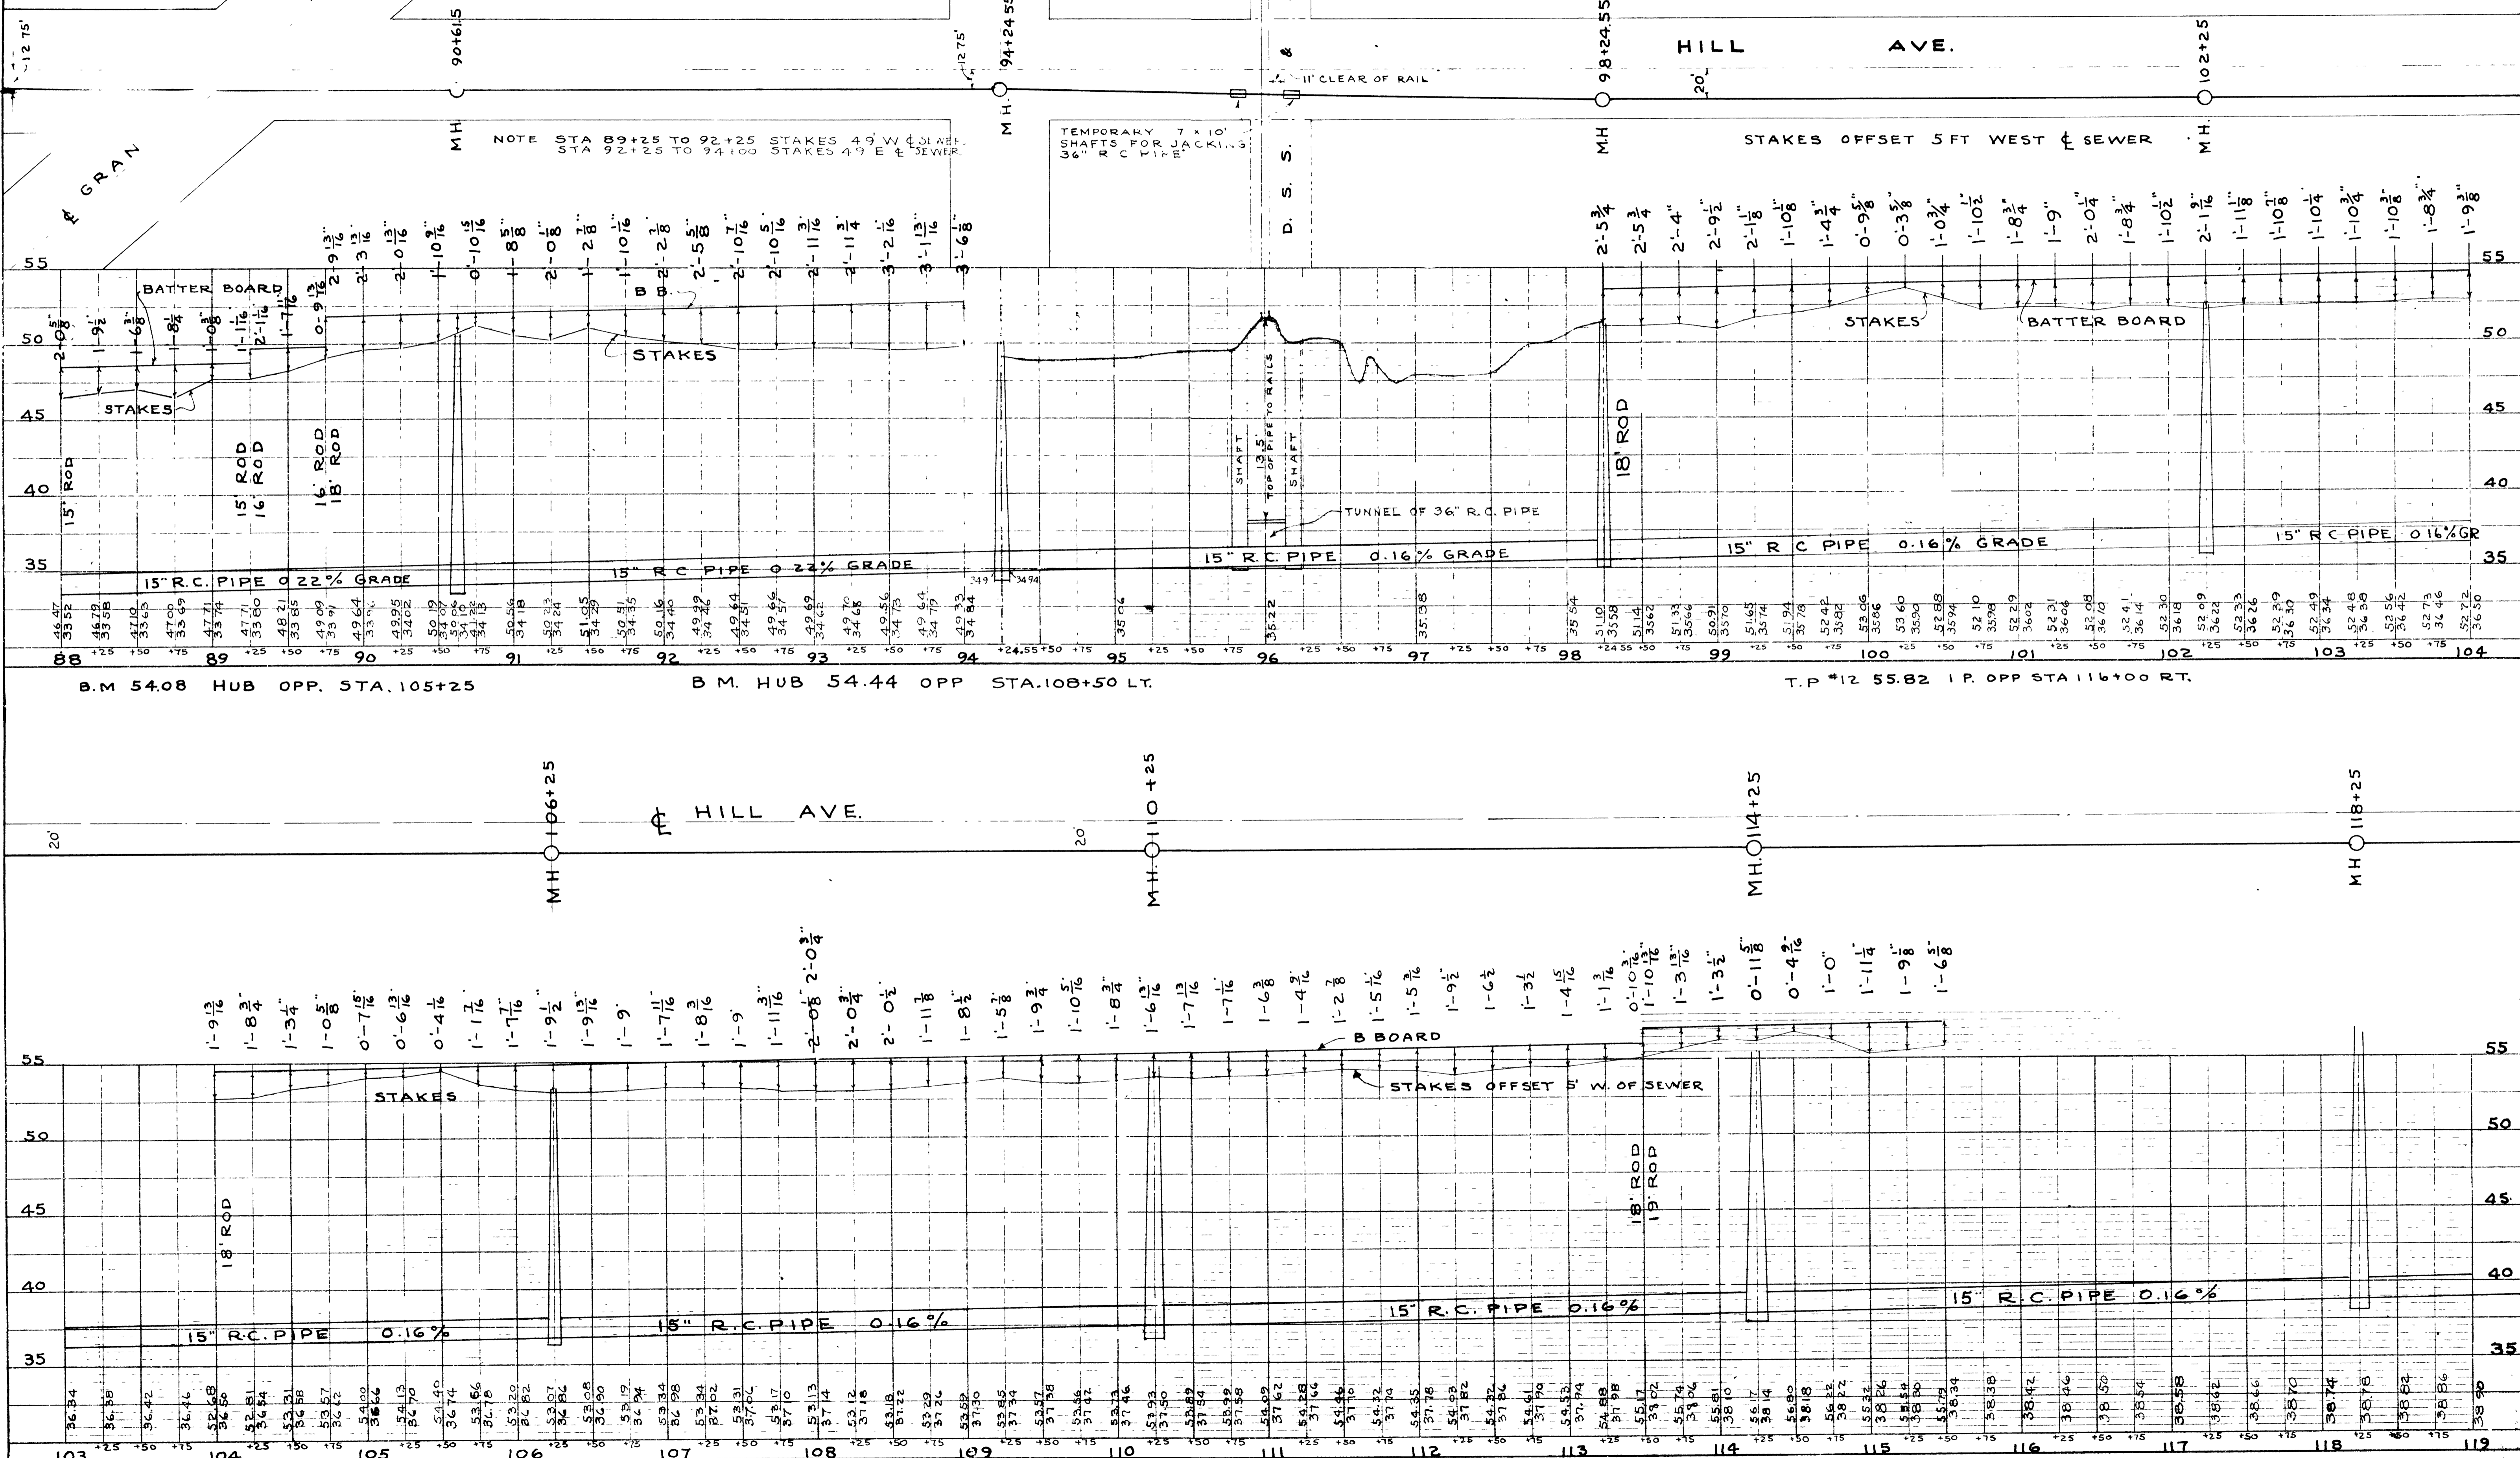


PLATE 2 - PLAN PROFILE 1" = 40' & 1" = 4'