



BEGIN PROJECT EXIST. M.H.
Has Not Been
accepted by the City
END PROJECT M.H.#1

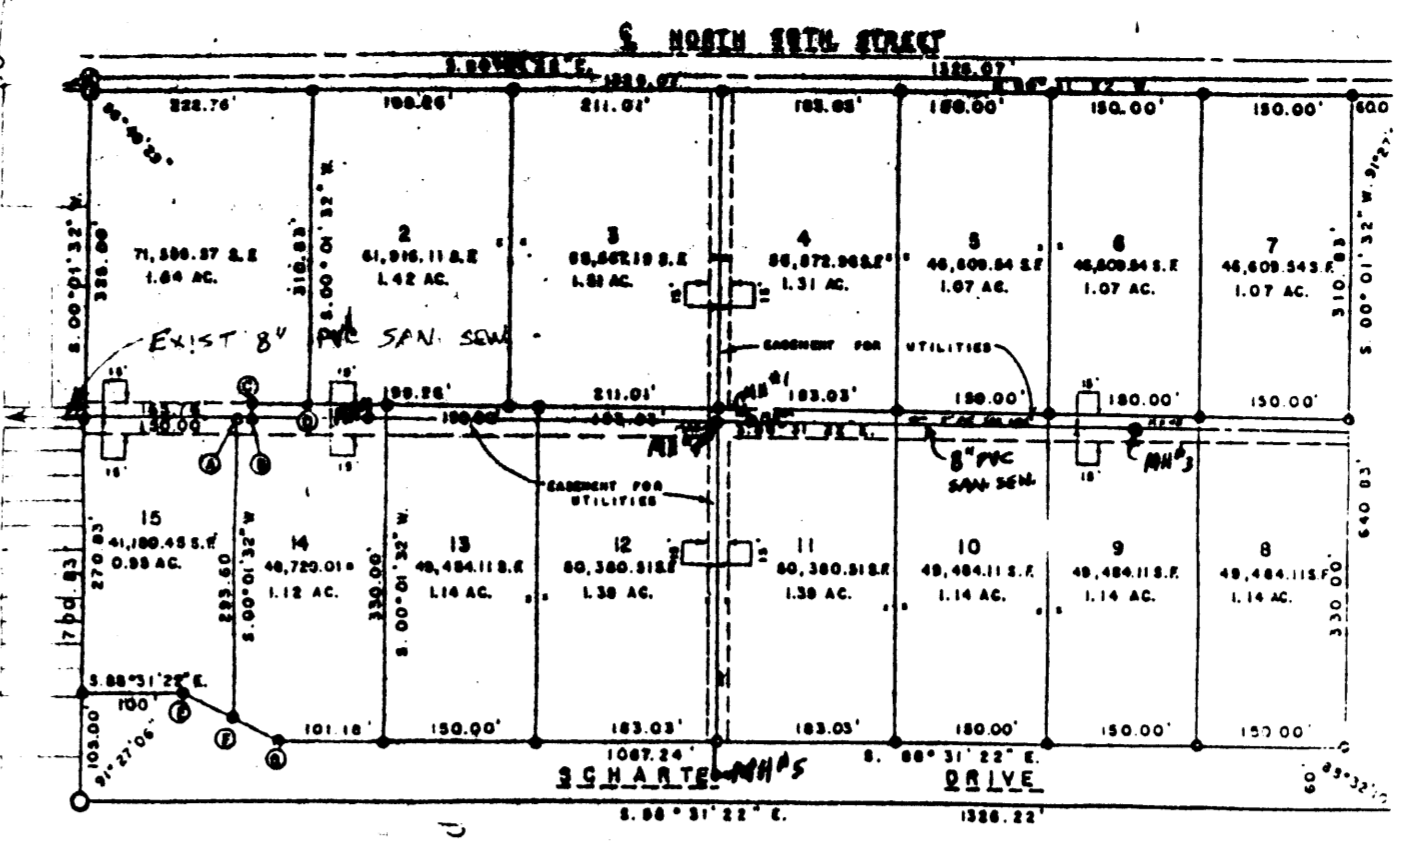


LOCATION PLAN
SCALE 1" = 200'

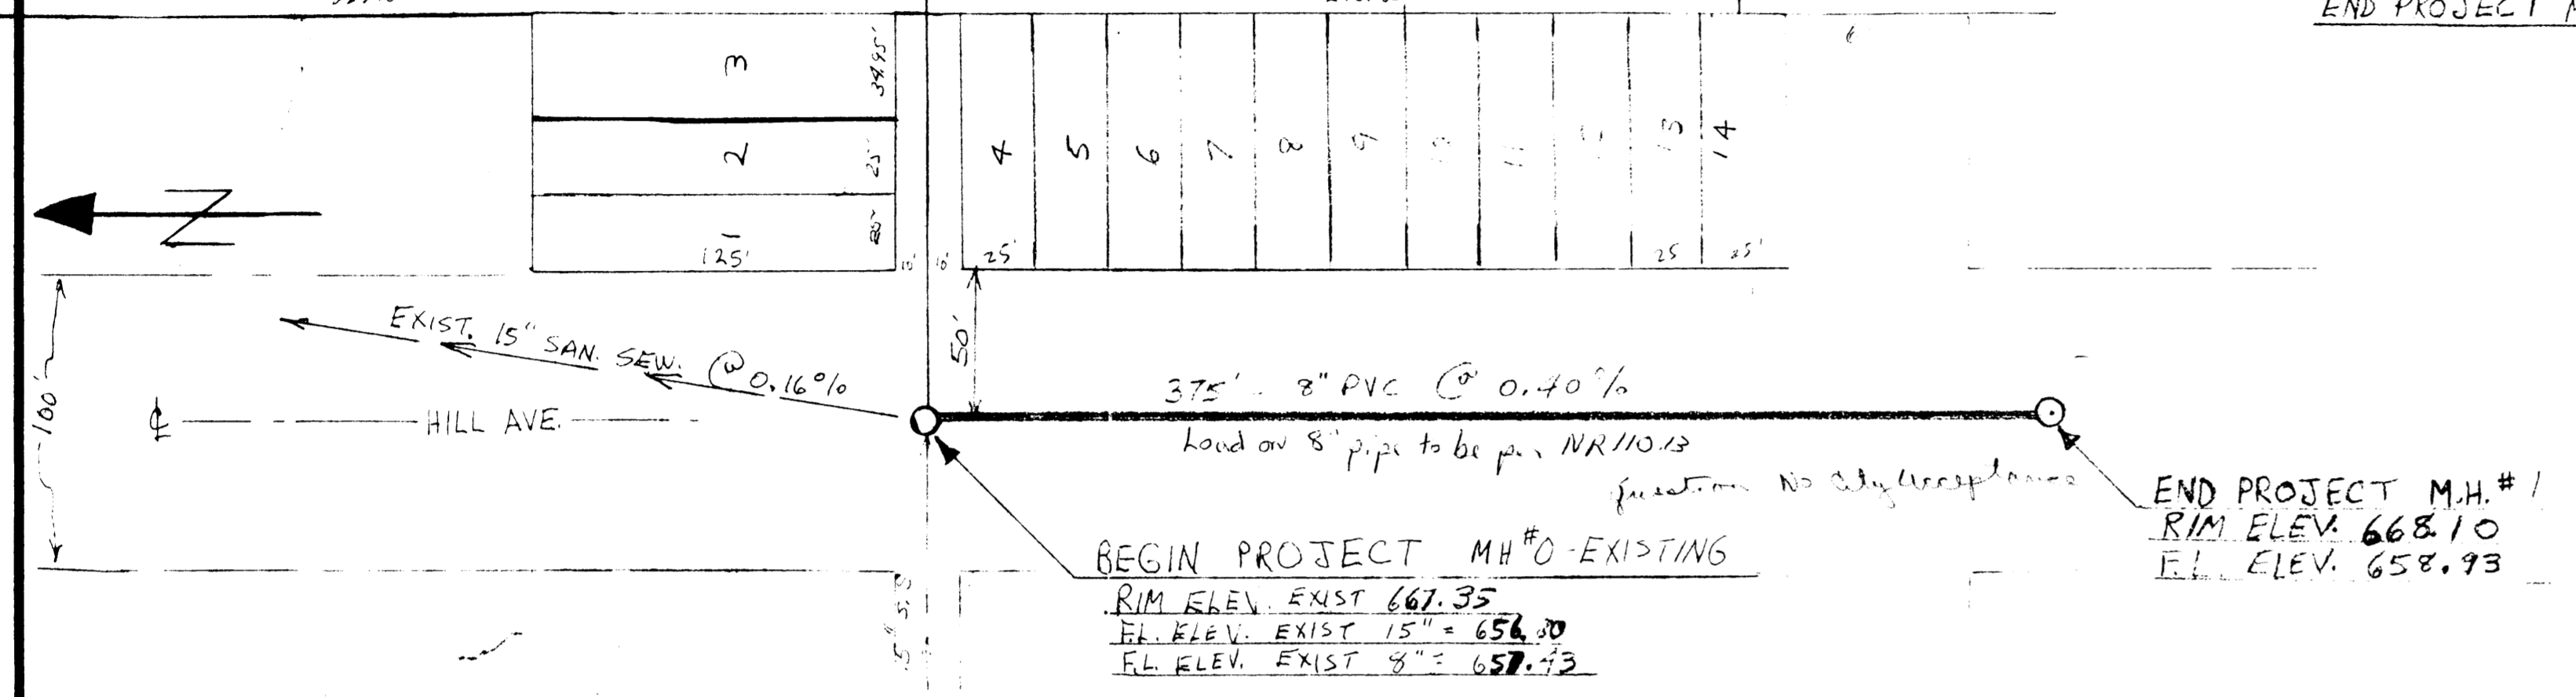


SCALE: 1" = 50' HORIZ.
1" = 2' VERT.

PLAN

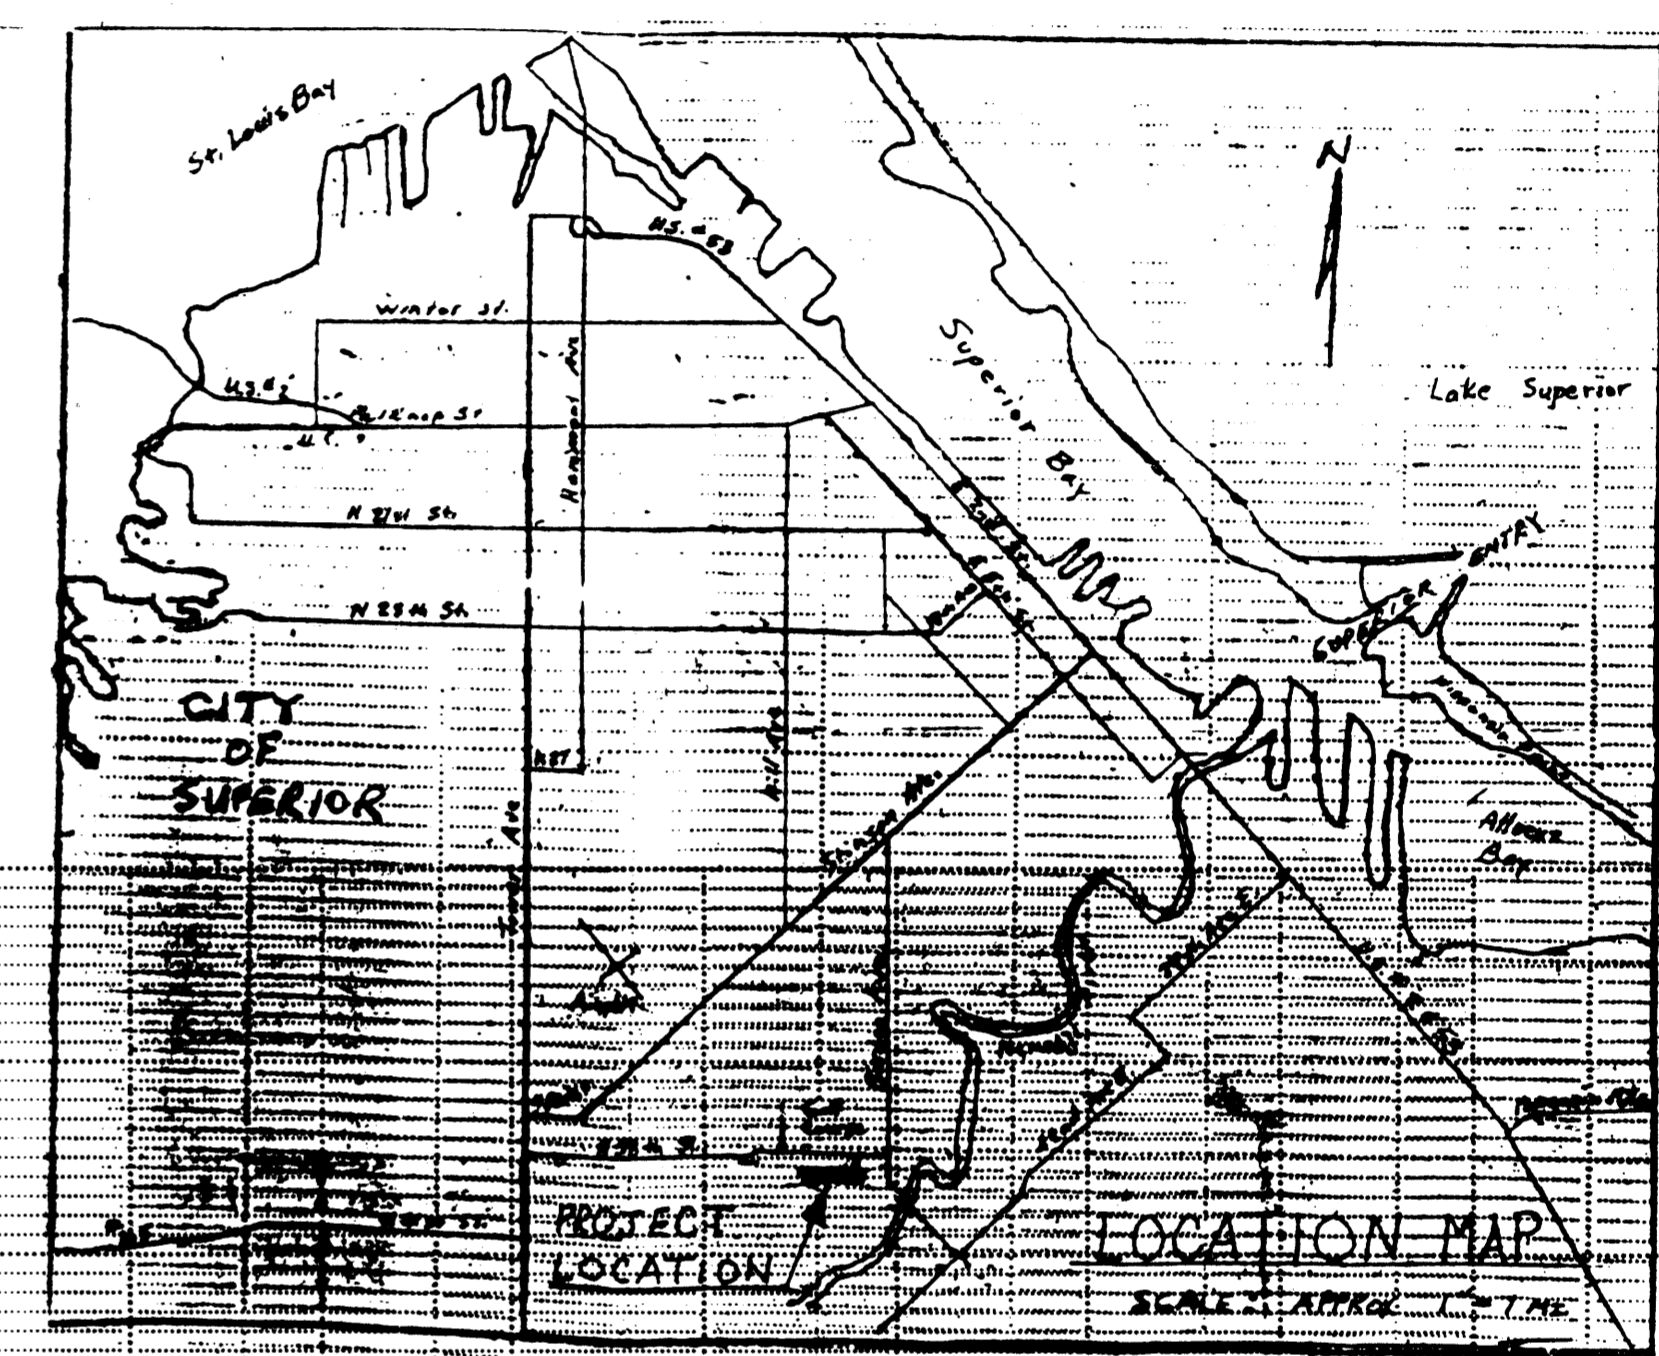


LOCATION MAP

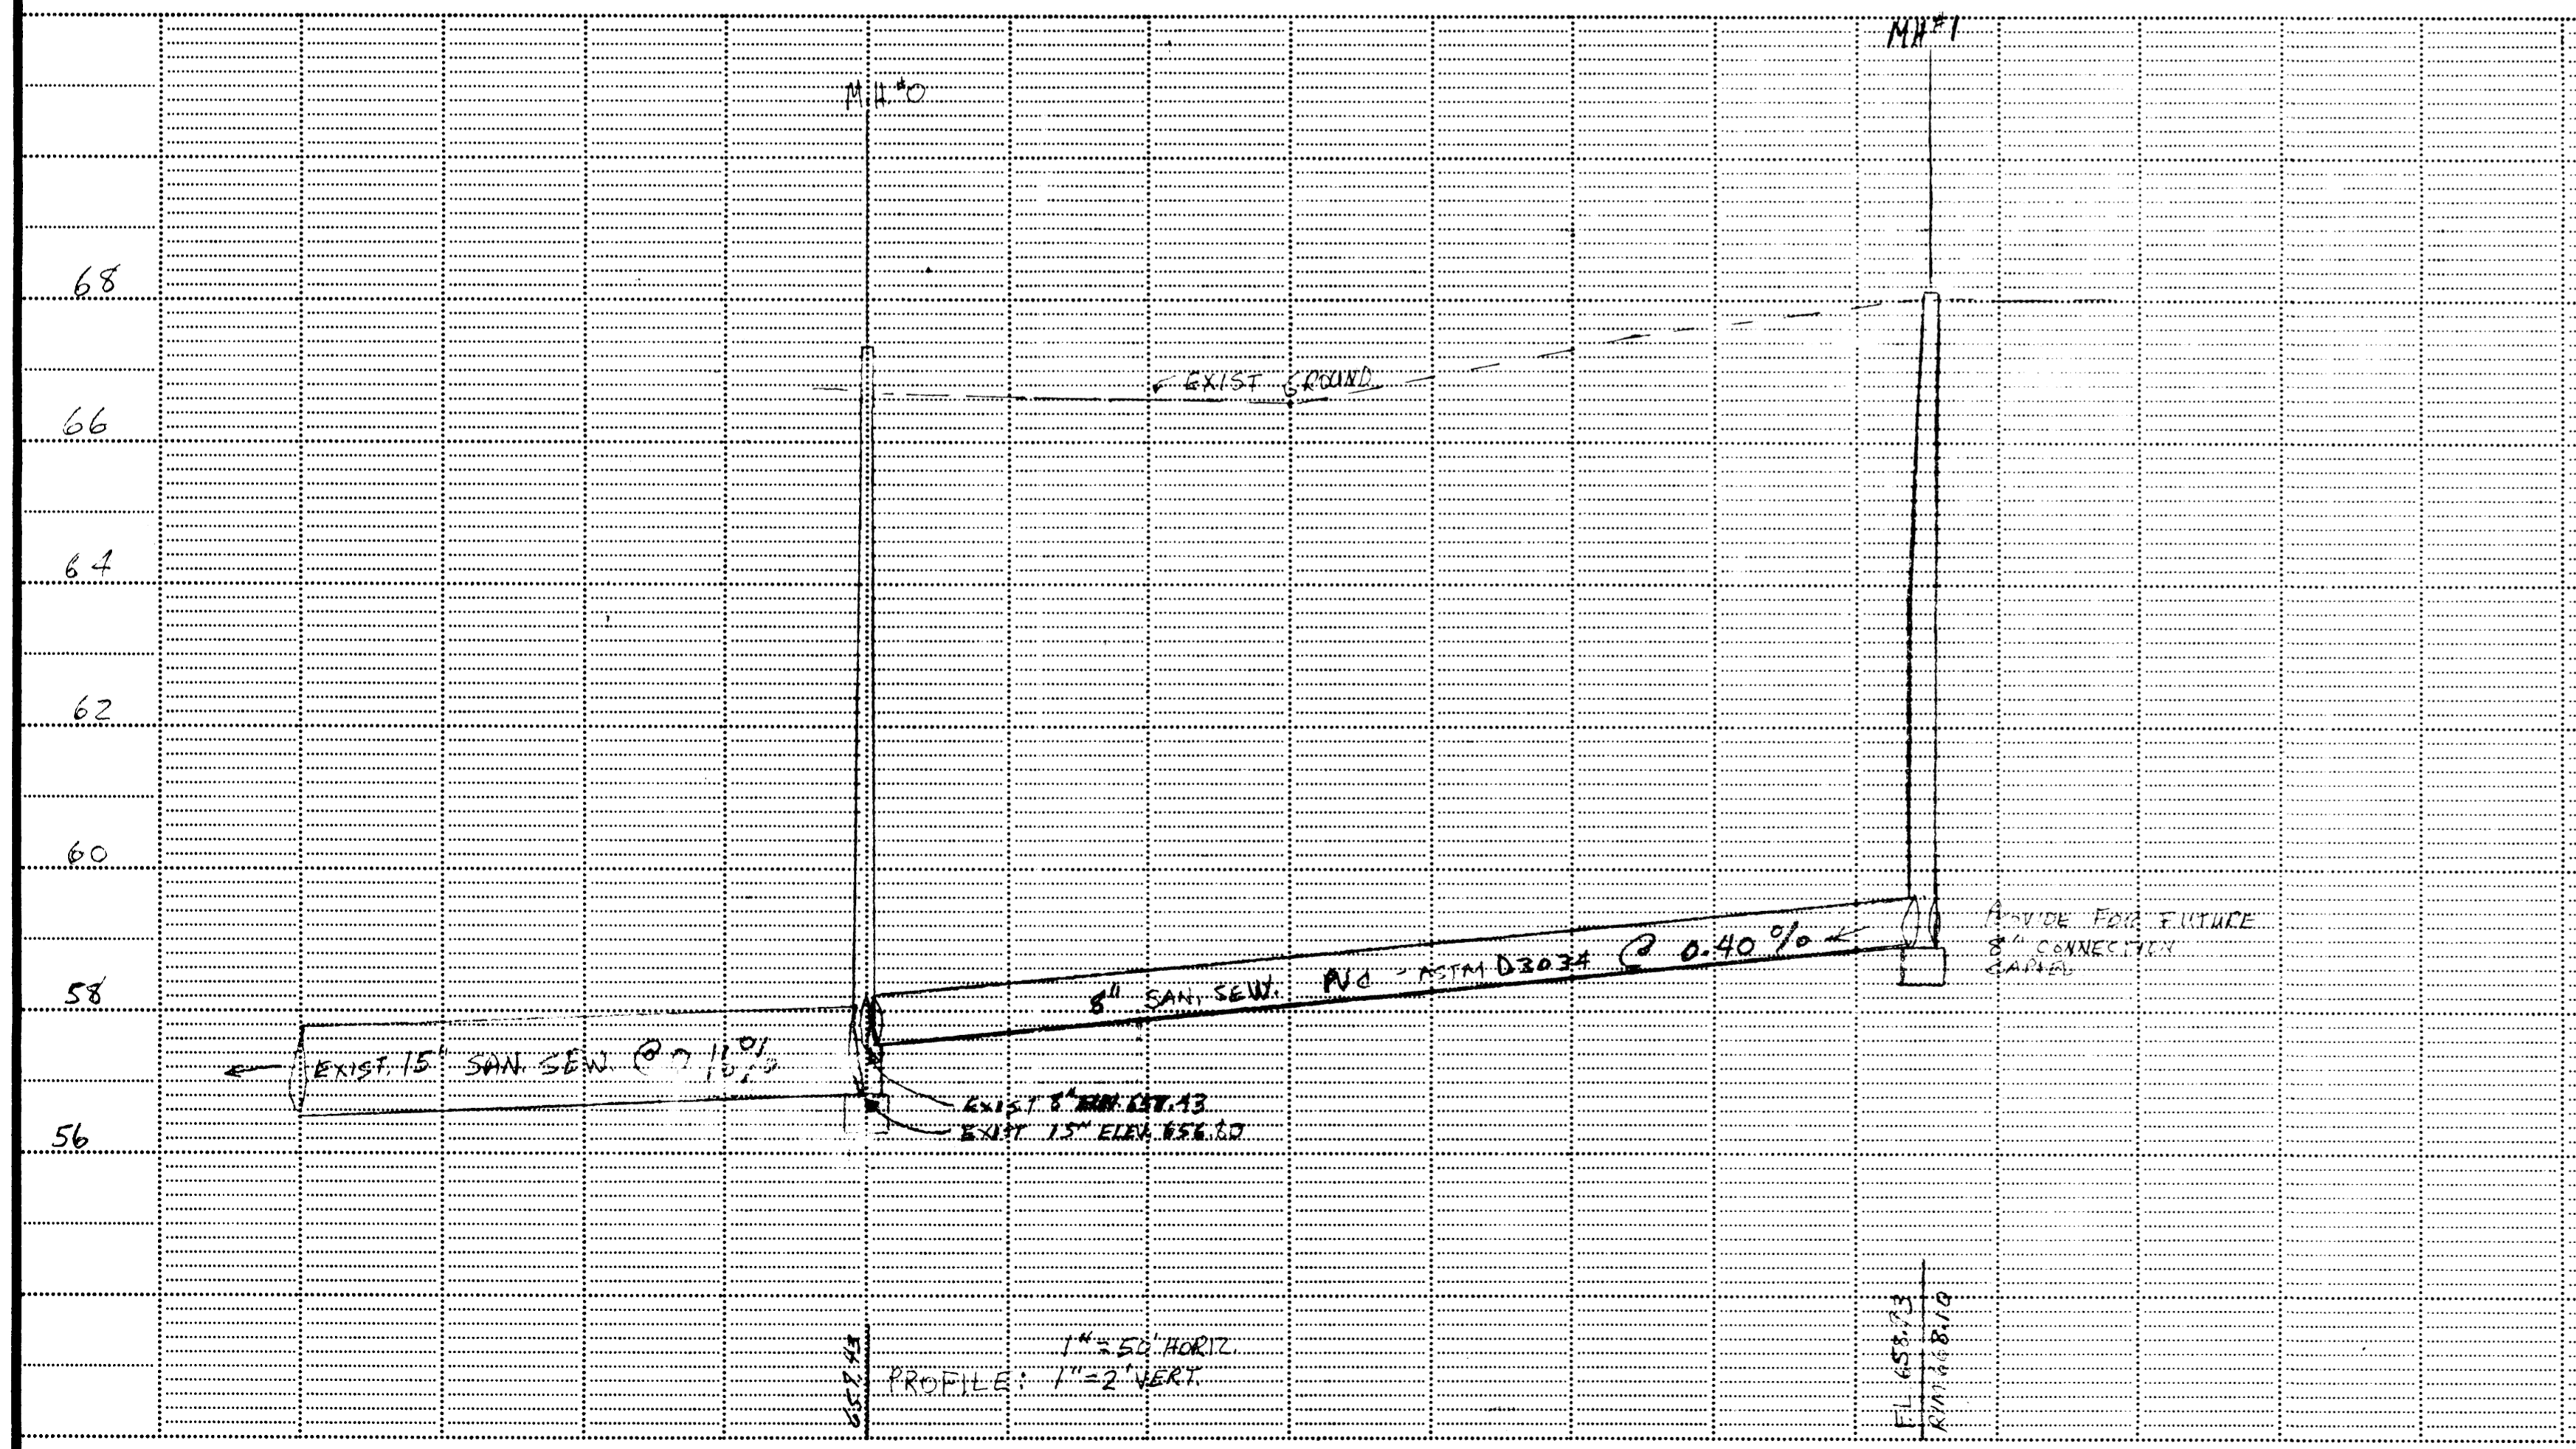

1" = 50' HORIZ.
1" = 2' VERT.

PROFILE

PLUMBING
Conditionally APPROVED
BY THE CITY ENGINEER
DATE: 10/15/13
CITY OF SUPERIOR

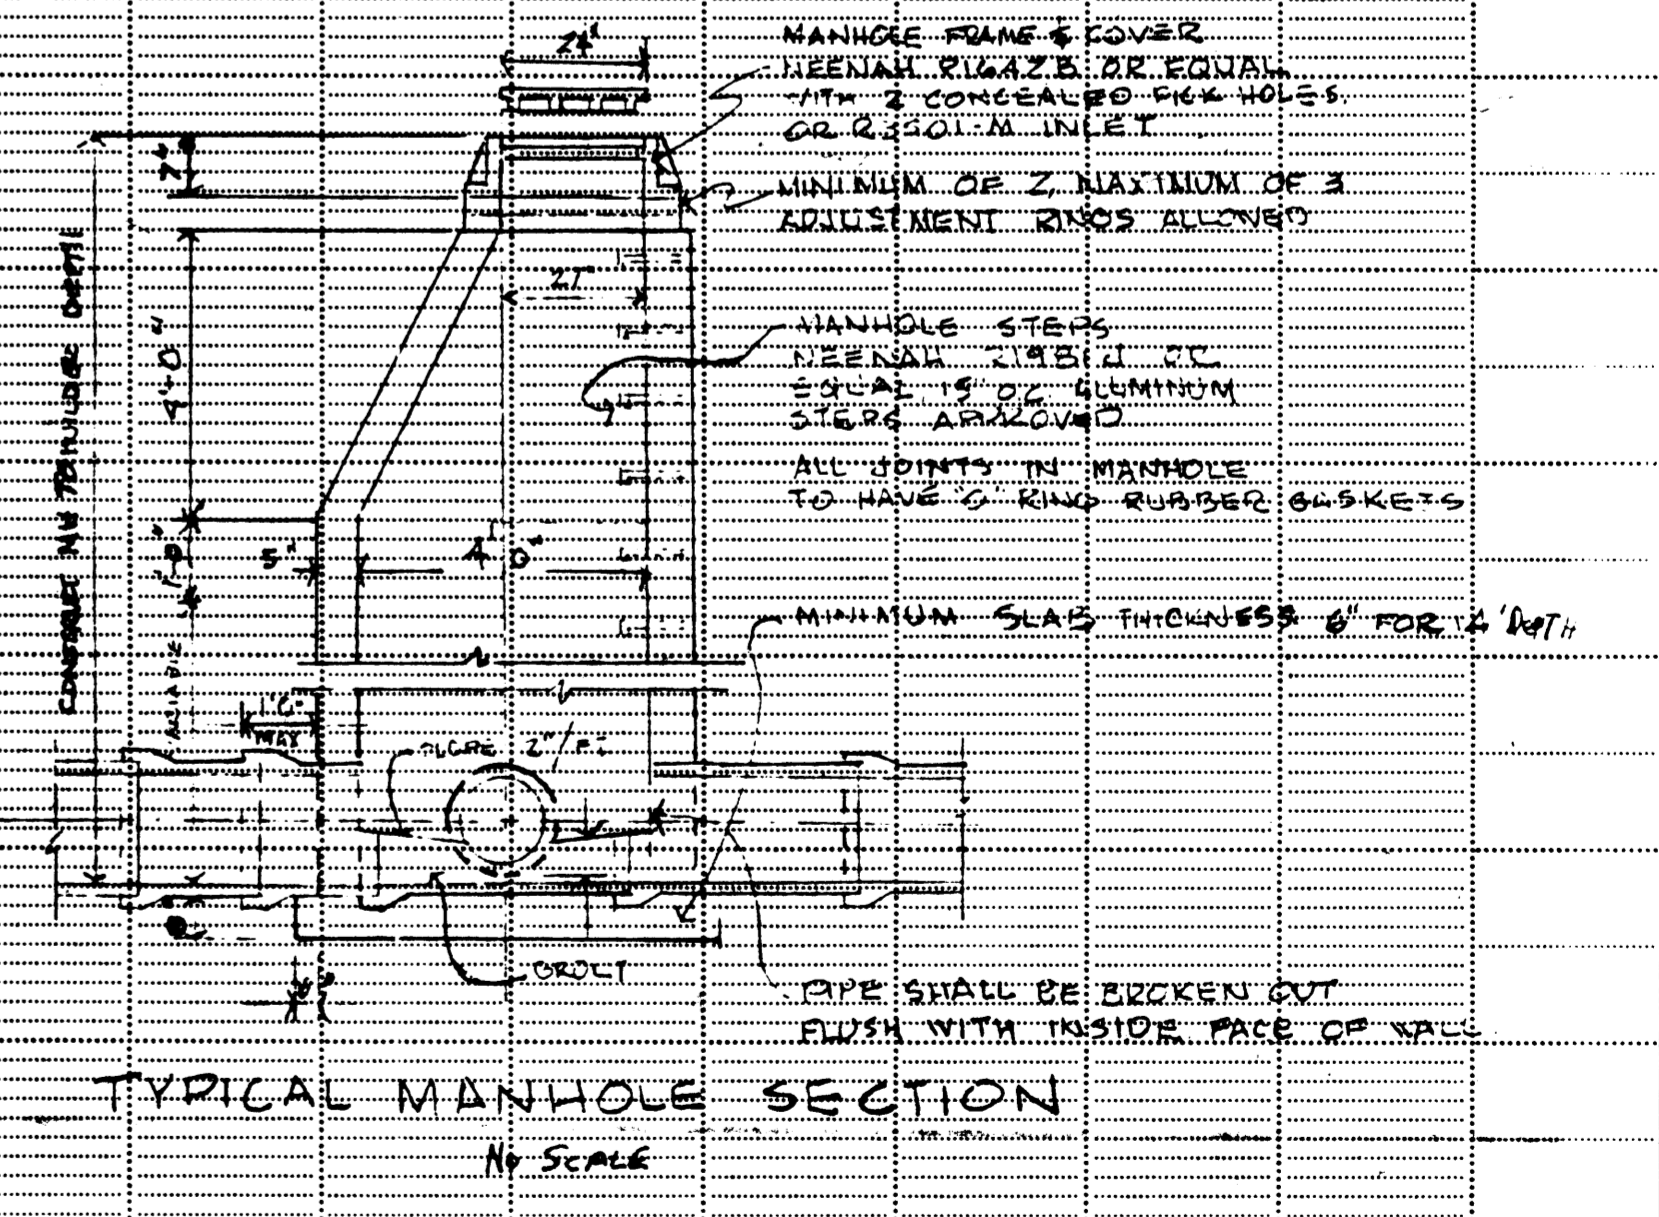

TYPICAL MANHOLE SECTION
NO SCALE

SINGLE PLAN - DOTTED
N. A. ROSE CO., MINNEAPOLIS - ST. PAUL

69220222