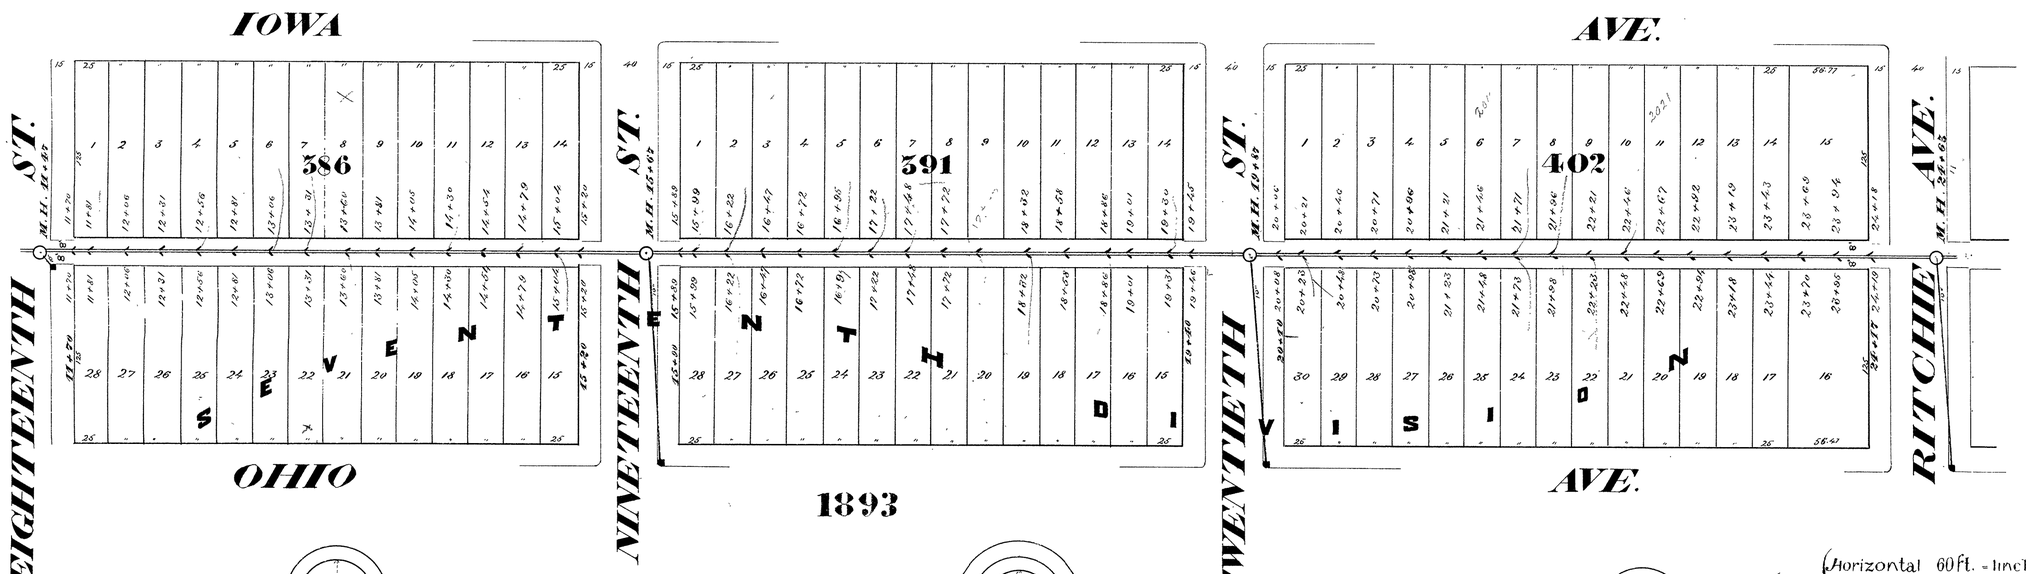

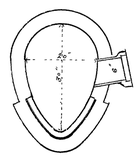

Section of 20"x30" Sewer

CITY OF SUPERIOR
SEWER PLAN

Contract let August 31, 1892
completed Nov. 16, 1892
Moore & Son. Contractor
H. E. Brooks & H. A. Carlson, Inspectors
A. S. Cooper, City Engineer

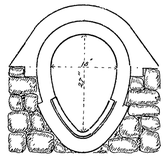

Section of 18"x27" Sewer in Masonry

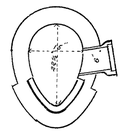

Section of 15"x22½ Sewer

Scale { Horizontal 60 ft. = Inch
Vertical 4 ft. = Inch
Section 2 ft. = Inch

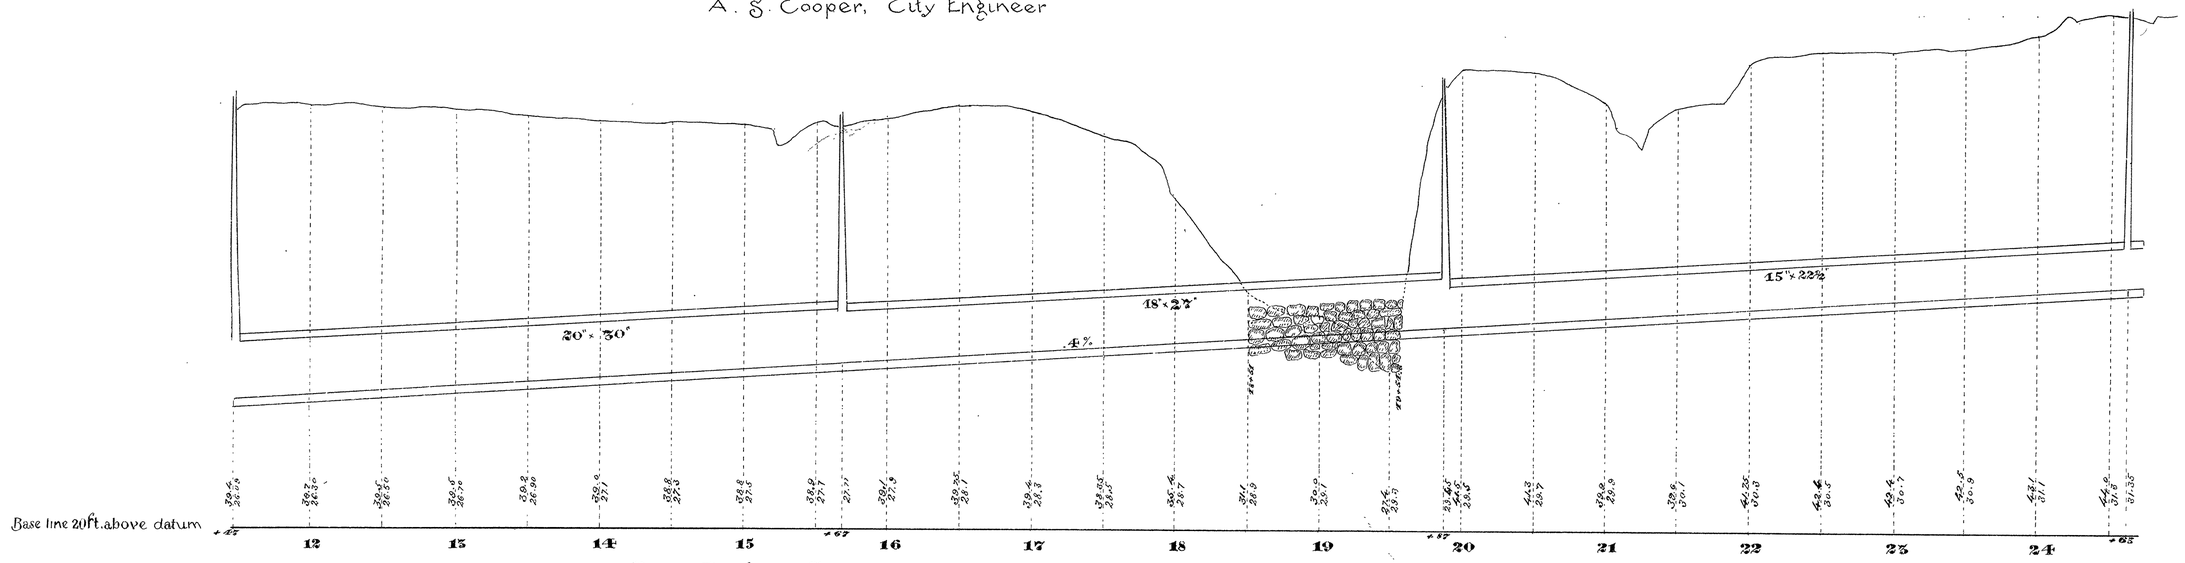

Plan & Profile of Sewer in Alley betw. Iowa & Ohio Aves. from Eighteenth Str to Ritchie Ave.

6-14