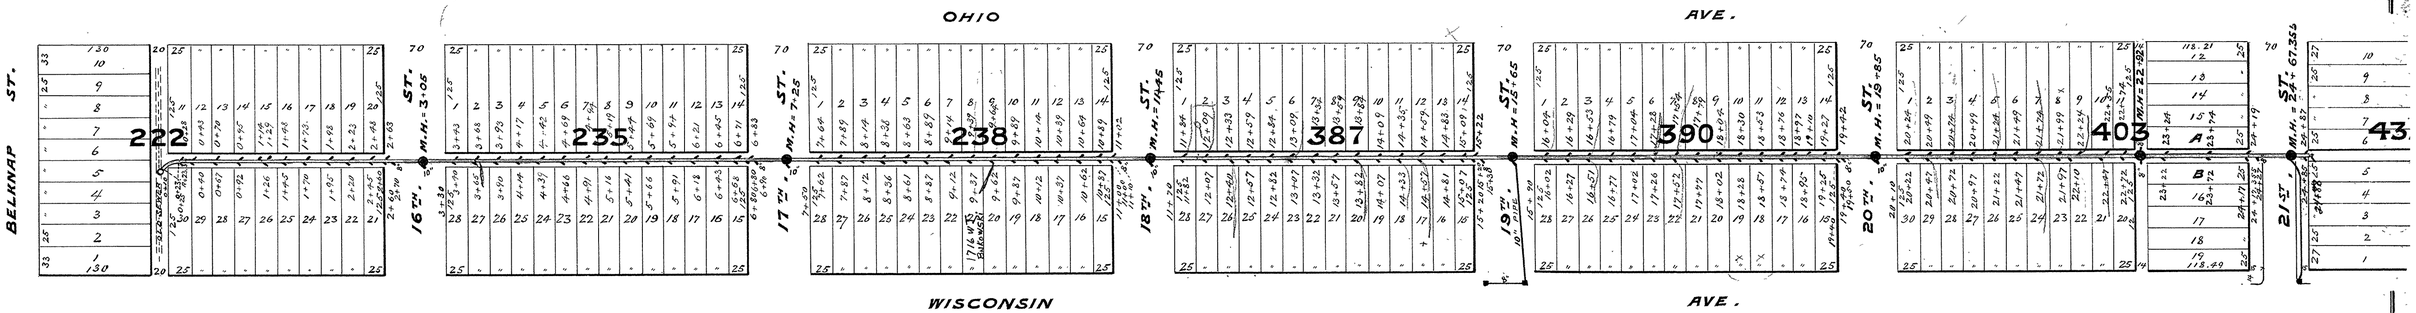

PLAN OF
CONNECTION TO MAIN SEWER
SCALE: 1" = 5 FT.

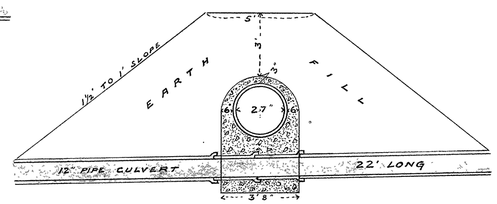

SECTION AT STA. 1 + 13
SCALE: 1" = 4 FT.

1907
CITY OF SUPERIOR

SEWER PLAN

CONTRACT LET JULY 18TH 1907
COMPLETED DEC. 7TH 1907
CONT # 1031 PETERSON & HOLM CONTRACTORS.

A. SOLIN
INSPECTOR

E. B. BANKS
CITY ENGR

SCALE: { HORIZONTAL ..... 1" = 100 FT.
VERTICAL ..... 1" = 4 FT.

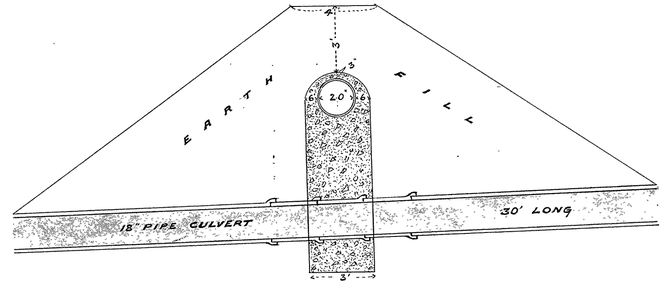

SECTION AT STA. 19 + 04
SCALE: 1" = 4 FT.

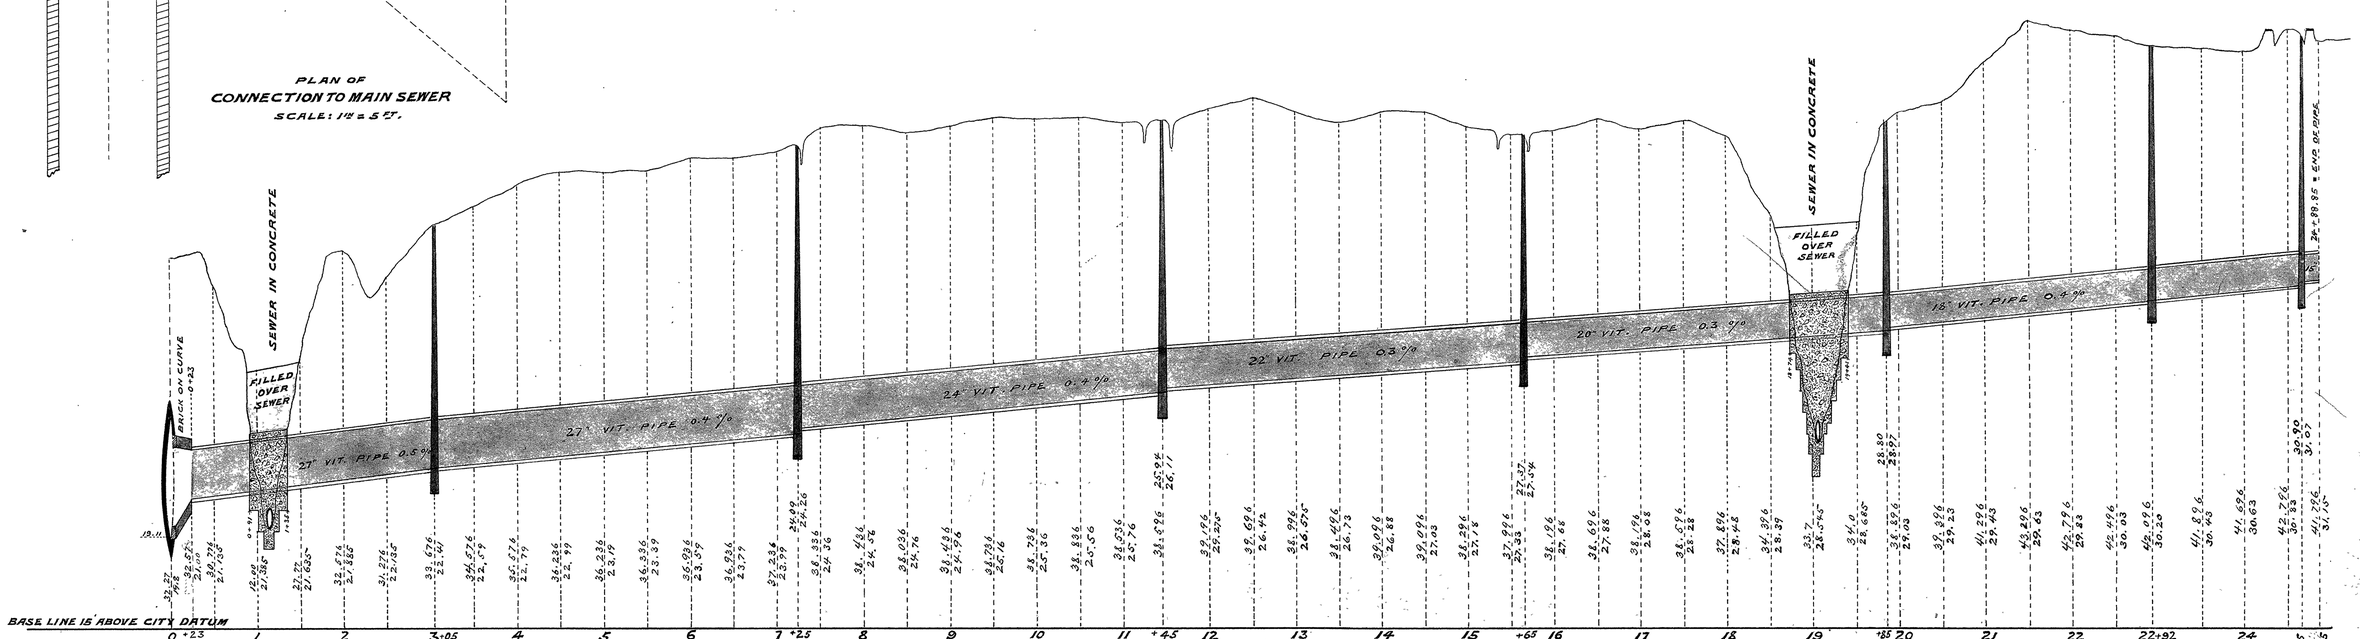

6-18