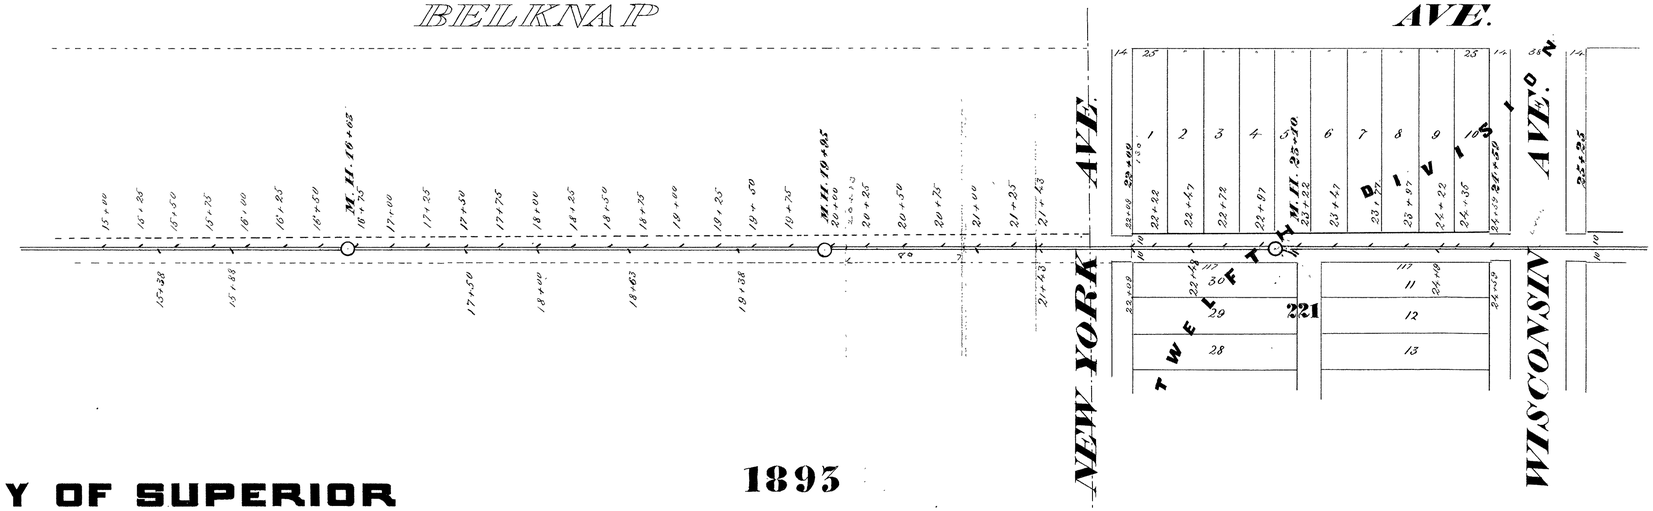

CITY OF SUPERIOR

SEWER PLAN

1893

Contract let June 9, 1892
" completed Nov. 18, 1892
Kirkland & Starkey, Contractor
Jos. P. Duff, Inspector
A. S. Cooper, City Engineer

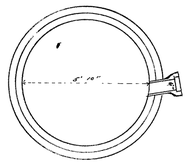

Section of 5'10" Sewer

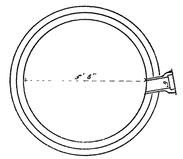

Section of 5'8" Sewer

Scale: Horizontal 60 ft. = 1 inch
Vertical 4 ft. = 1 inch
Section 4 ft. = 1 inch

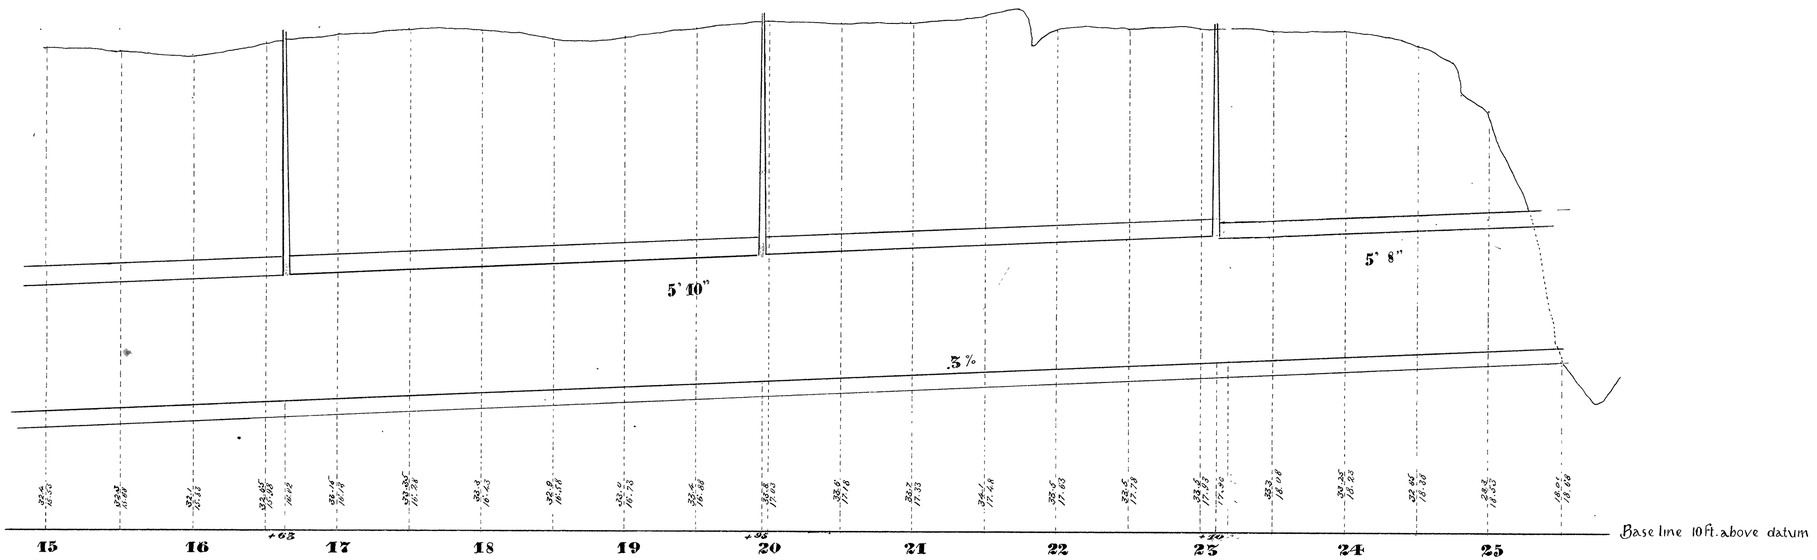

Plan & Profile of Sewer in Alley South of Belknap St. from Wisconsin Ave. West

6-2