


43.8 ACRES ±

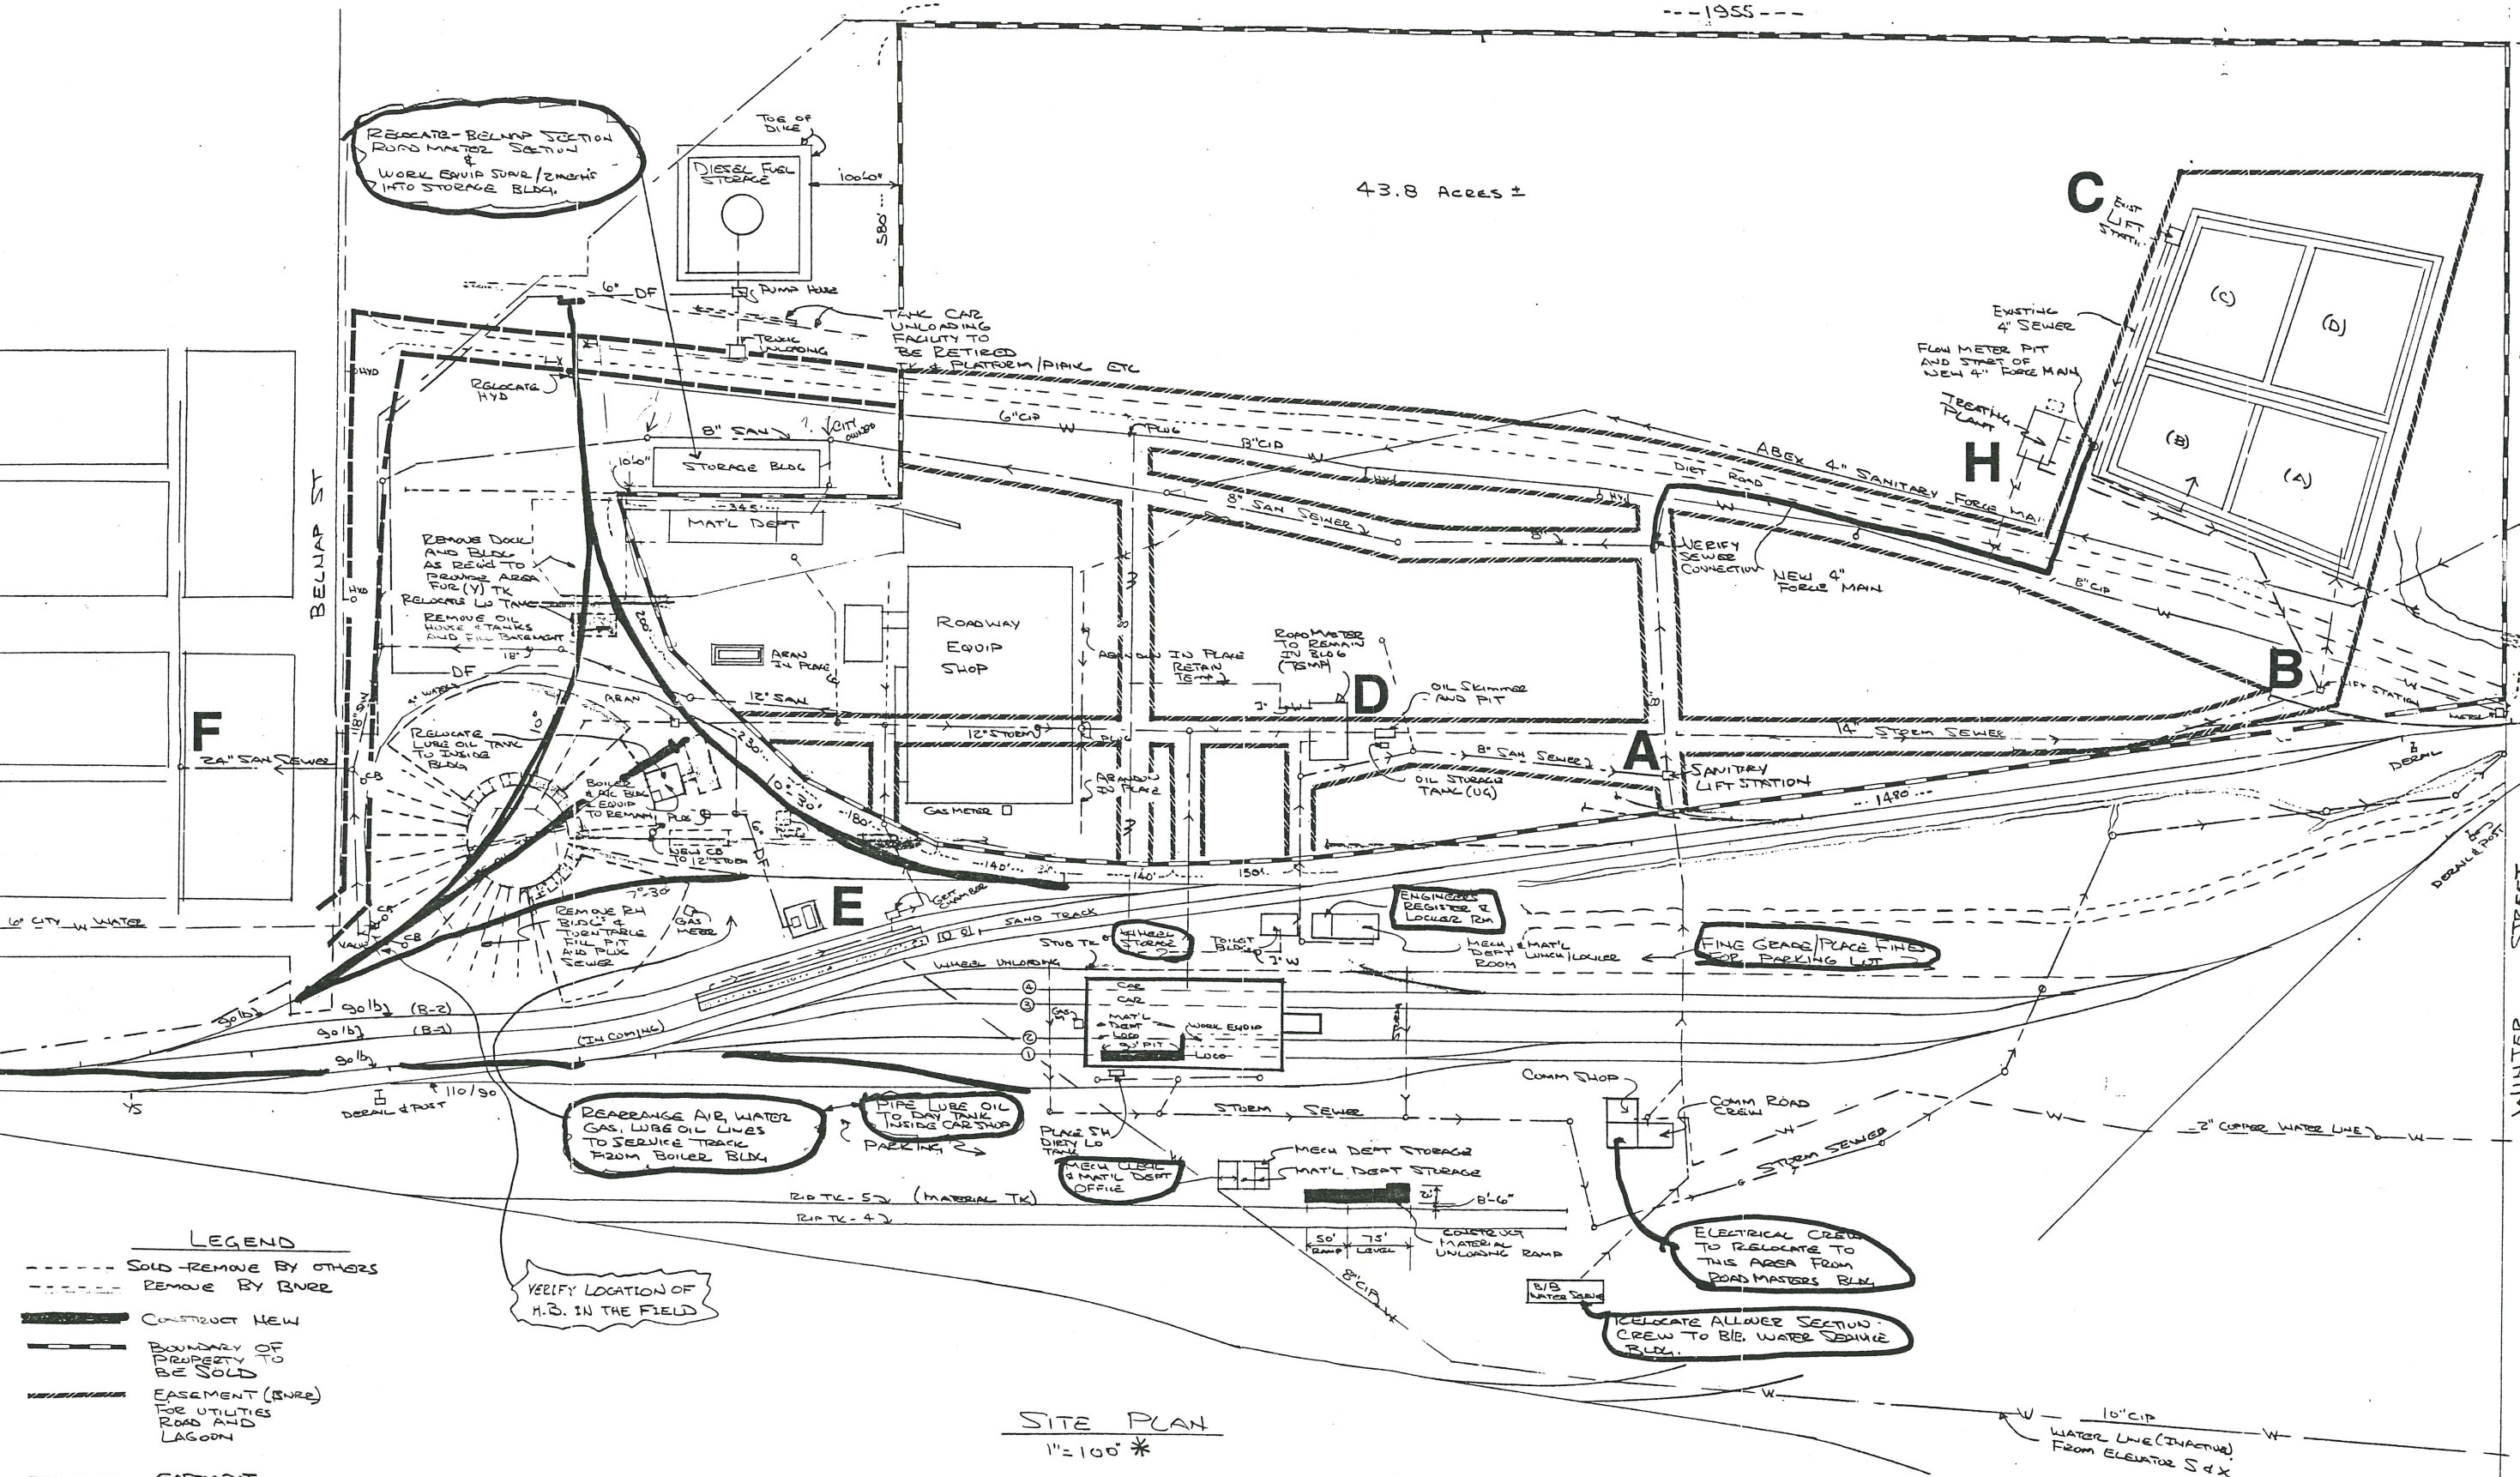

- LEGEND**
- SOLD - REMOVE BY OTHERS
 - - - - REMOVE BY BNRR
 - CONSTRUCT NEW
 - BOUNDARY OF PROPERTY TO BE SOLD
 - EASEMENT (BNRR) FOR UTILITIES ROAD AND LAGOON
 - EASEMENT ROADWAY USE. (RRS, INC)

SITE PLAN
1" = 100' *

* NOTE: This drawing reduced to approx. 50% of original size.

REVISION	DES. SDA	DRW. SDA	CHK.
4-8-86 SDA	REVIEWED	DATE 3-25-86	AUTH.
4-10-86 SDA			
5-5-86 SDA	RECOMMENDED:	APPROVED:	
5-8-86 SDA			
6-10-86 SDA			
6-11-86 SDA			
6-11-86 SDA			

BURLINGTON NORTHERN RAILROAD COMPANY
SUPERIOR, WISCONSIN
"SHOP CONSOLIDATION"

PLAN NO. _____ SHEET _____

JAN 08 1993