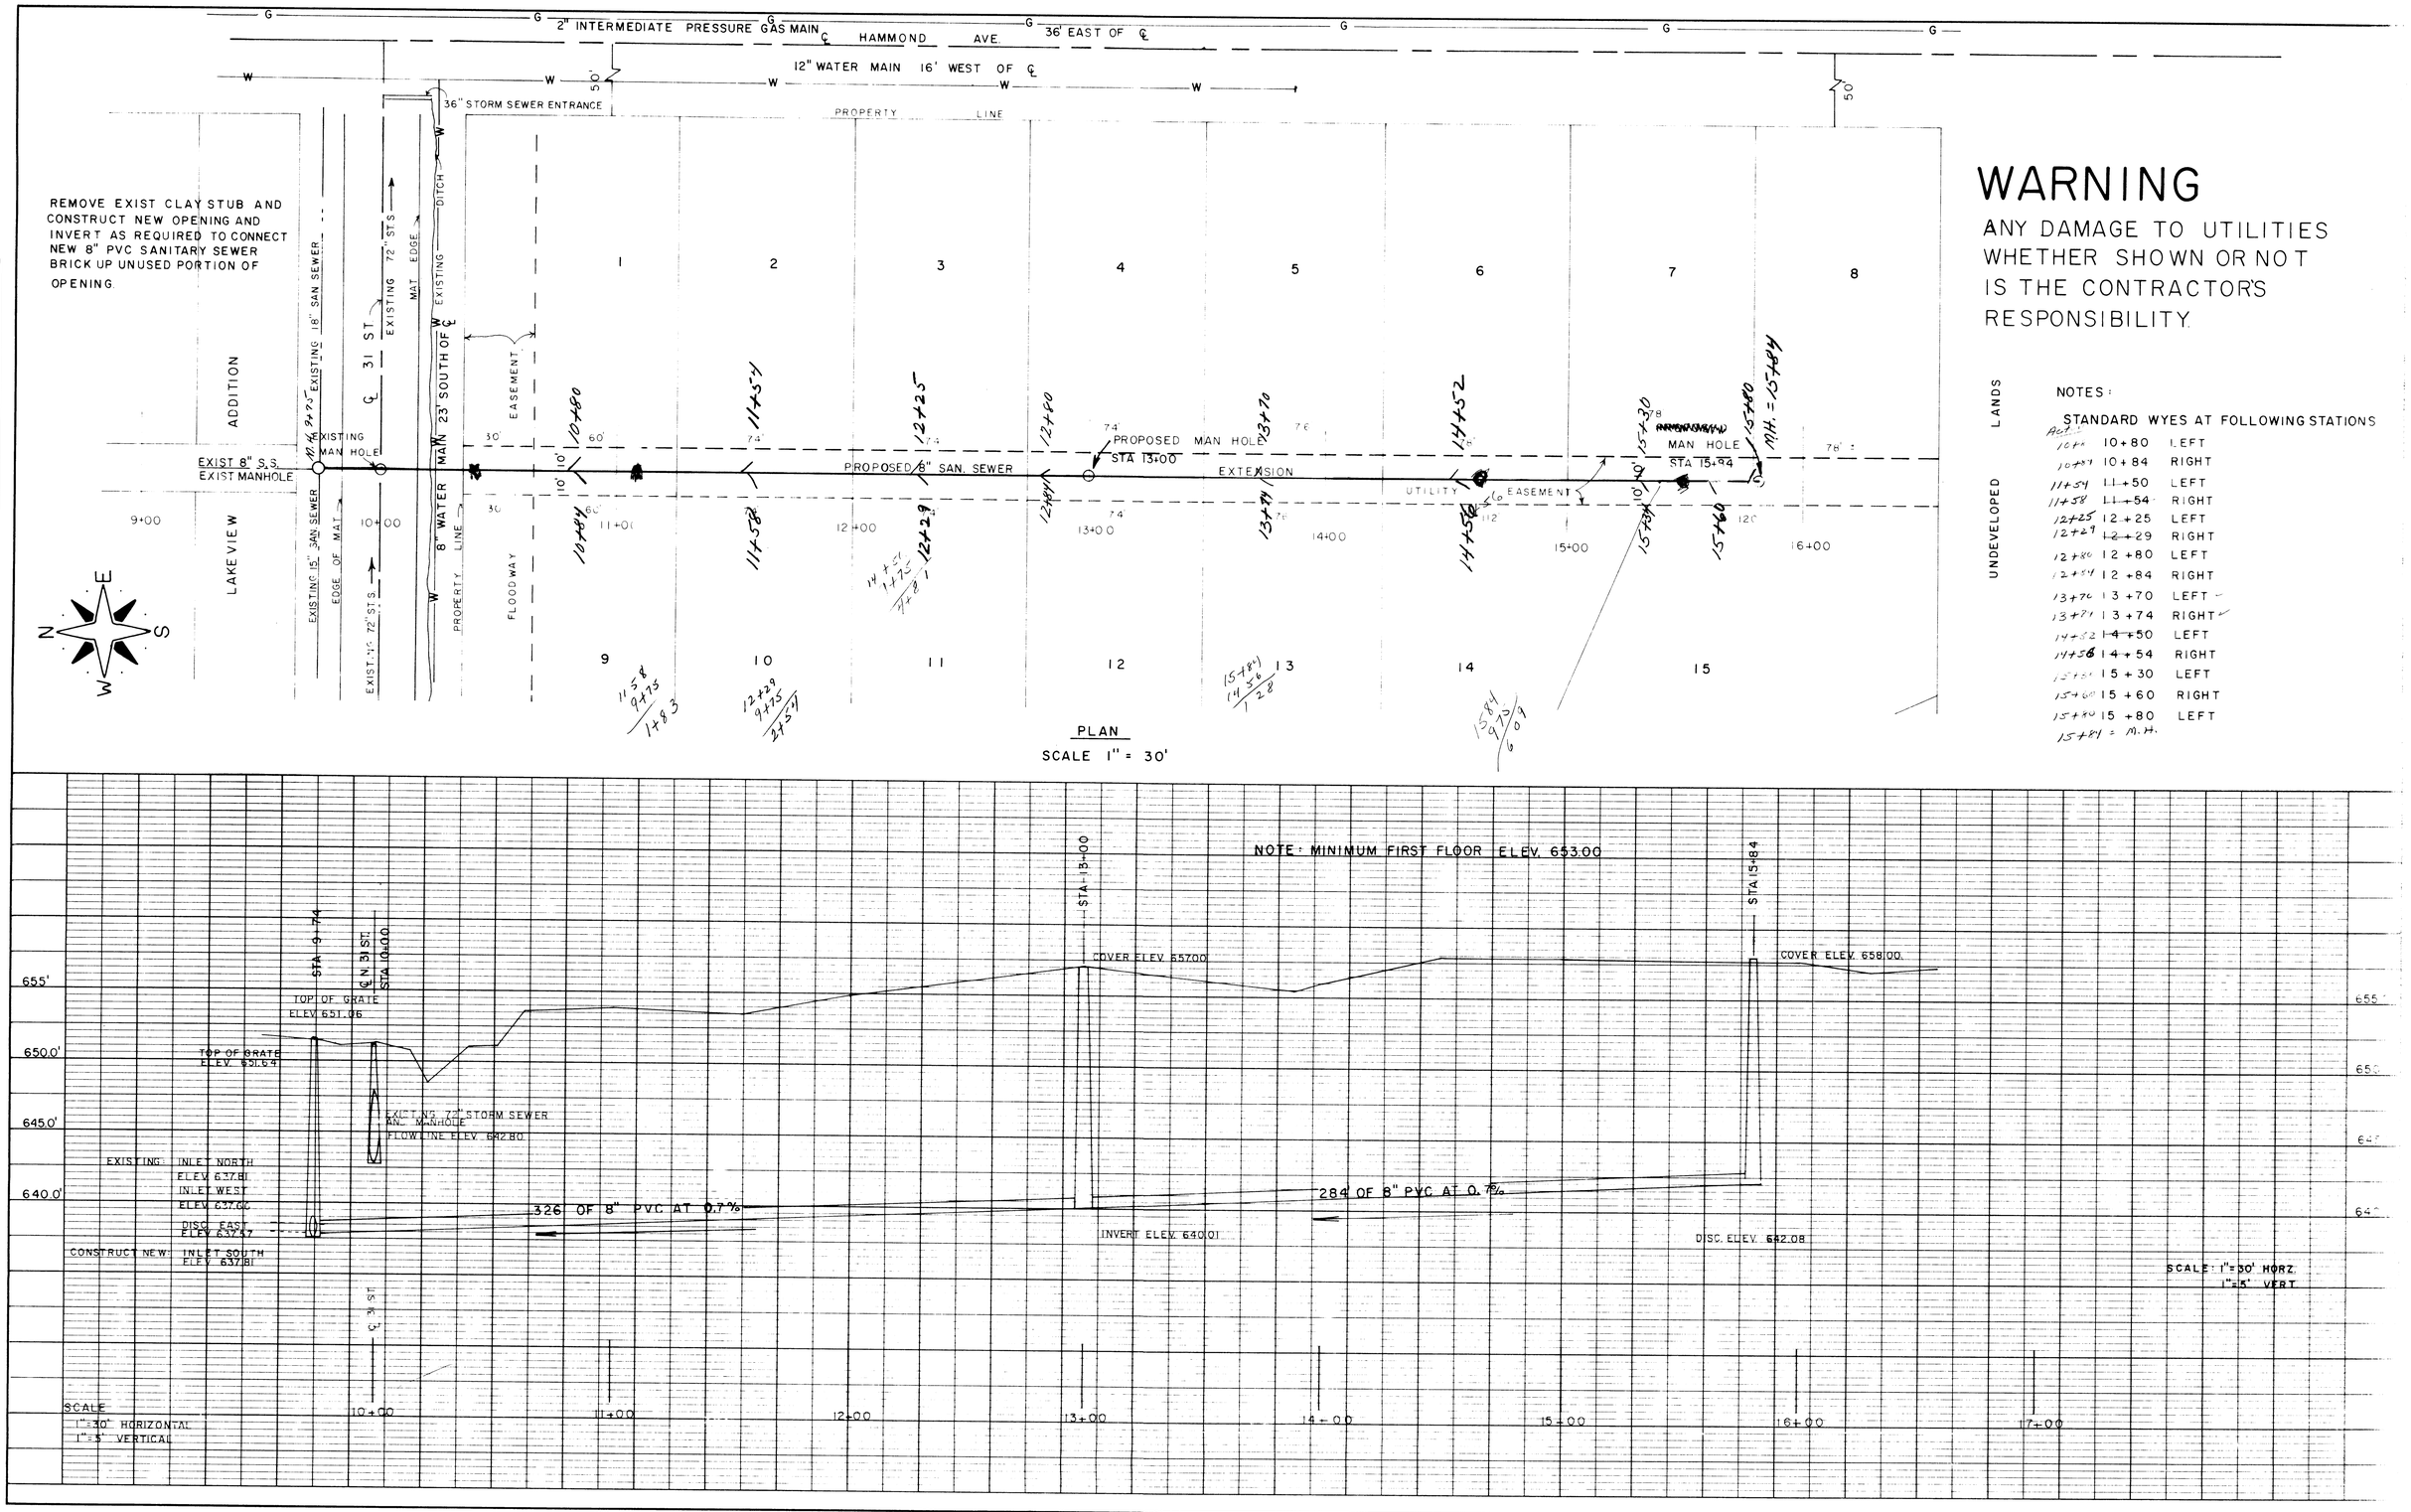

WARNING

ANY DAMAGE TO UTILITIES WHETHER SHOWN OR NOT IS THE CONTRACTOR'S RESPONSIBILITY.

NOTES:

STANDARD WYES AT FOLLOWING STATIONS

Act.		
10+80	10+80	LEFT
10+84	10+84	RIGHT
11+54	11+50	LEFT
11+58	11+54	RIGHT
12+25	12+25	LEFT
12+29	12+29	RIGHT
12+80	12+80	LEFT
12+84	12+84	RIGHT
13+70	13+70	LEFT
13+74	13+74	RIGHT
14+52	14+50	LEFT
14+56	14+54	RIGHT
15+30	15+30	LEFT
15+60	15+60	RIGHT
15+80	15+80	LEFT
15+84 = M.H.		

LANDS

UNDEVELOPED

PLAN — NOTE BOOK No. — SURVEYED — PLOTTED — ALIGNMENT CHECKED — KT. OF WAY CHECKED — BY — DATE

PROFILE — NOTE BOOK No. — SURVEYED — PLOTTED — GRADES CHECKED — B. M.'s NOTED — STRUCTURE NOTATIONS CHECKED — BY — DATE

K+E PLATE 1, PLAN-PROFILE KEUFFEL & ESSER CO. 48 7008 MADE IN U.S.A.