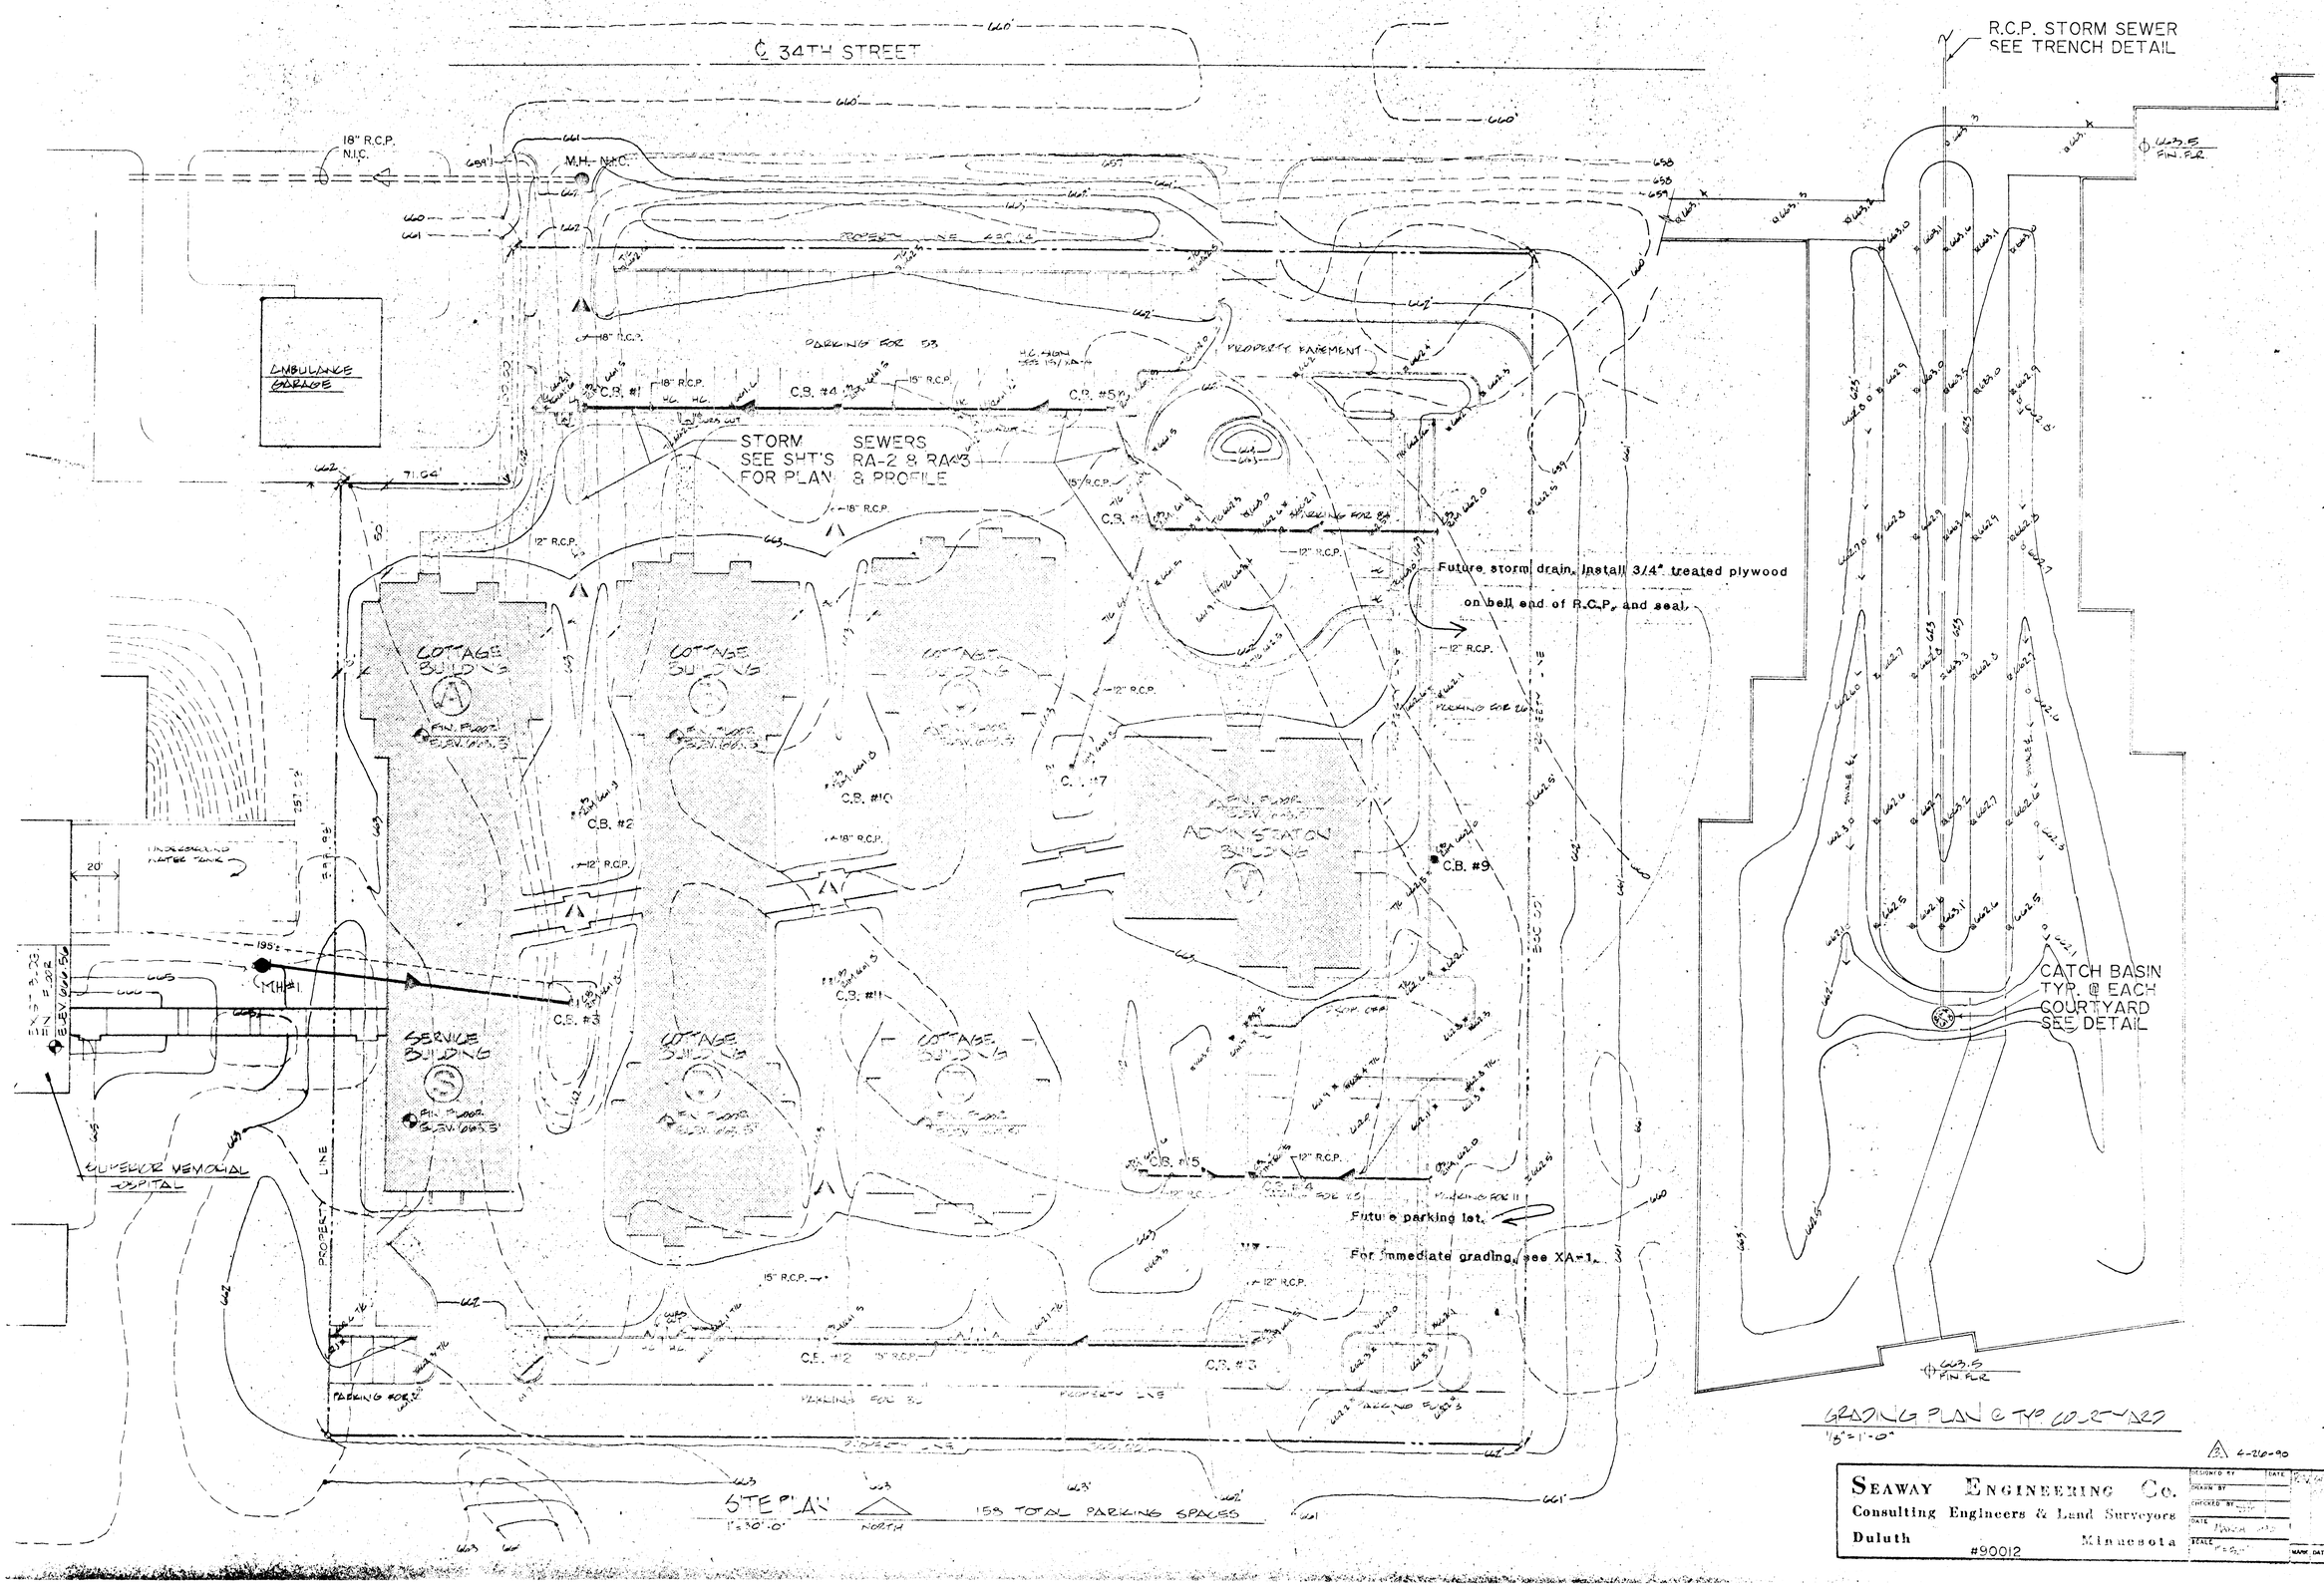

SITE PLAN 1"=30'-0" NORTH 158 TOTAL PARKING SPACES

GRADING PLAN @ TYP. COURTYARD 1/8"=1'-0"

DAMBERG, SCOTT, PECK & BOOKER, INC.

Architecture
Planning
Interior Design

Duluth
Virginia
Grand Rapids

SITE GRADING & STORM SEWERS

4-26-90

SEAWAY ENGINEERING Co.
Consulting Engineers & Land Surveyors
Duluth Minnesota
#90012