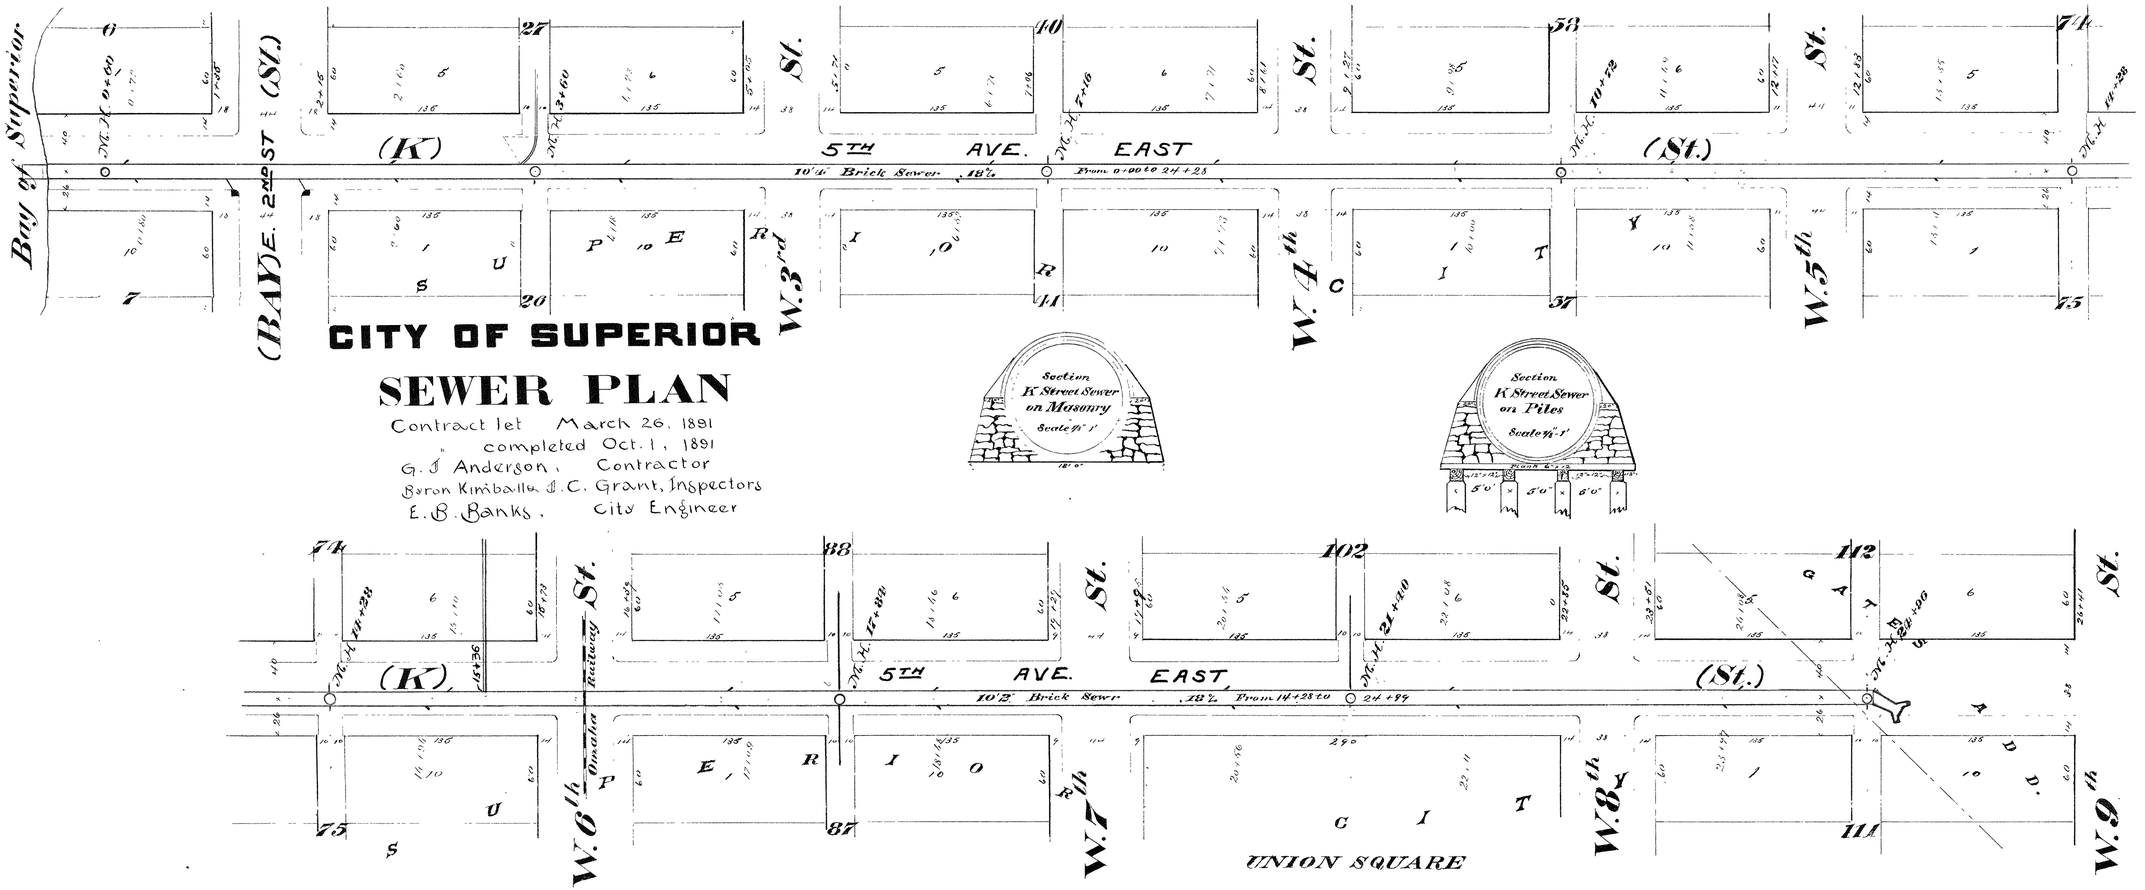

CITY OF SUPERIOR

SEWER PLAN

Contract let March 26. 1891
" completed Oct. 1, 1891
G. J Anderson, Contractor
Byron Kimball & C. Grant, Inspectors
E. B. Banks, City Engineer

Size of Sewer	Piling Begins	Piling Ends	Masonry Begins	Masonry Ends
10'4	0+00	0+36	0+36	0+39
10'4"	4+32	10+33	3+90	4+32
10'4"	11+66	13+71	13+71	14+10
10'2"	16+35	19+44	15+60	16+35
10'2"	21+36	24+99	19+44 / 20+92	19+89 / 21+36

Sewer & Established Street Grades

Outlet		Bay St.				W. 3rd St.				W. 4th St.				W. 5th St.				W. 6th St.				W. 7th St.				W. 8th St.				End	
		N. Side		S. Side		N. Side		S. Side		S. Side		S. Side		N. Side.		S. Side		N. Side		S. Side		N. Side		S. Side		N. Side		S. Side		24+00	
Street	Sewer	Street	Sewer	Street	Sewer	Street	Sewer	Street	Sewer	Street	Sewer	Street	Sewer	Street	Sewer	Street	Sewer	Street	Sewer	Street	Sewer	Street	Sewer	Street	Sewer	Street	Sewer	Street	Sewer	Street	Sewer
	3.10		3.34		2.987		4.009		4.128		4.649		4.768		5.29		5.409		5.93		6.05		6.57		6.69		7.21		7.33		7.62

5TH AVE
(K Street) Sewer

Scale: 1 inch - 100 ft.

3A-2

3A-2