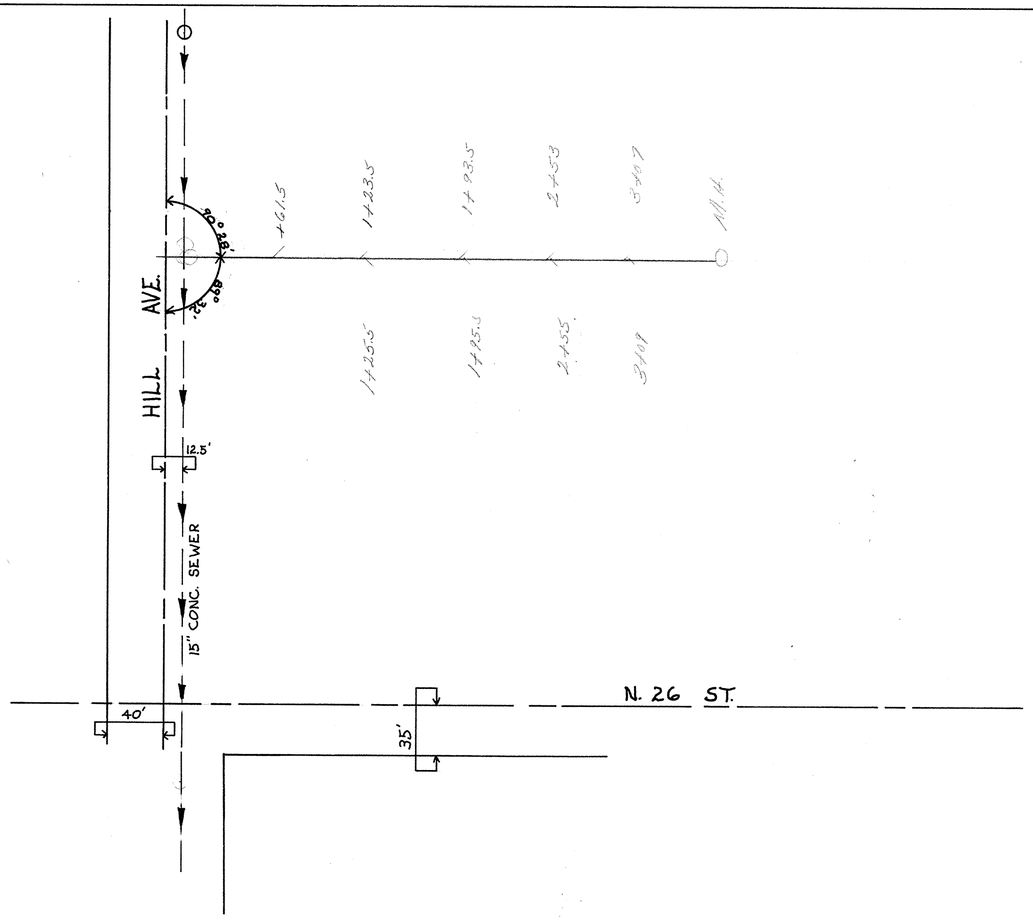
HILL AVE.
15" CONC. SEWER
12.5'
40'
35'
N. 26 ST.
+61.5
1+23.5
1+93.5
2+53
3+07
1+25.5
1+95.5
2+55
3+09

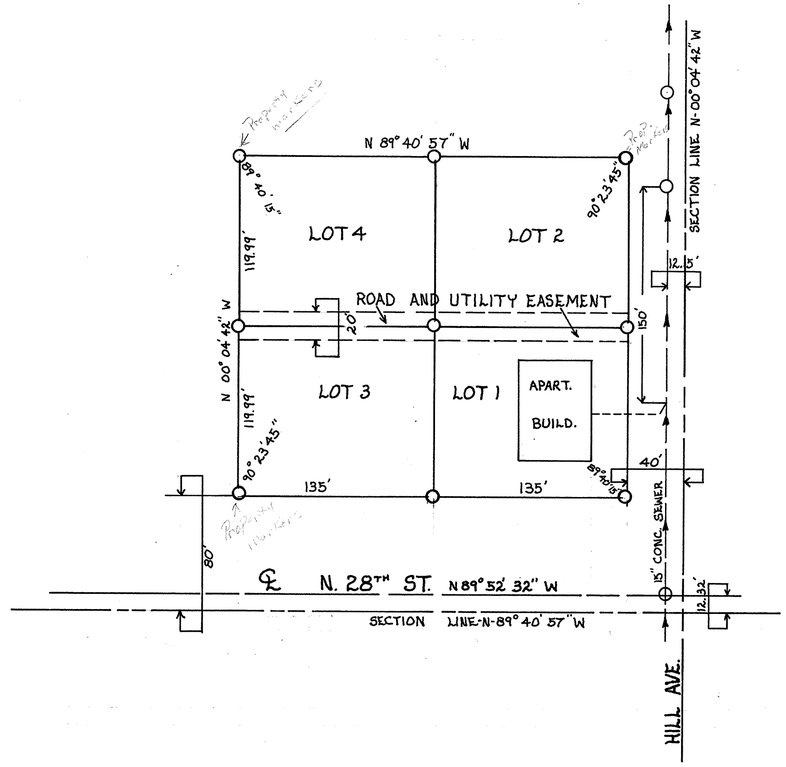
N 89° 40' 57" W
LOT 4
LOT 2
LOT 3
LOT 1
ROAD AND UTILITY EASEMENT
APART. BUILD.
N 00° 04' 42" W
119.99'
90° 23' 45"
135'
150'
20'
40'
80'
12.5'
12.32'
SECTION LINE N-00° 04' 42" W
15" CONC. SEWER
℄ N. 28TH ST. N 89° 52' 32" W
SECTION LINE-N-89° 40' 57" W
HILL AVE.

3A-37

3A-37