



5 DETAIL - CATCH BASIN/INLET  
S1 SCALE: 1/2" = 1'-0"

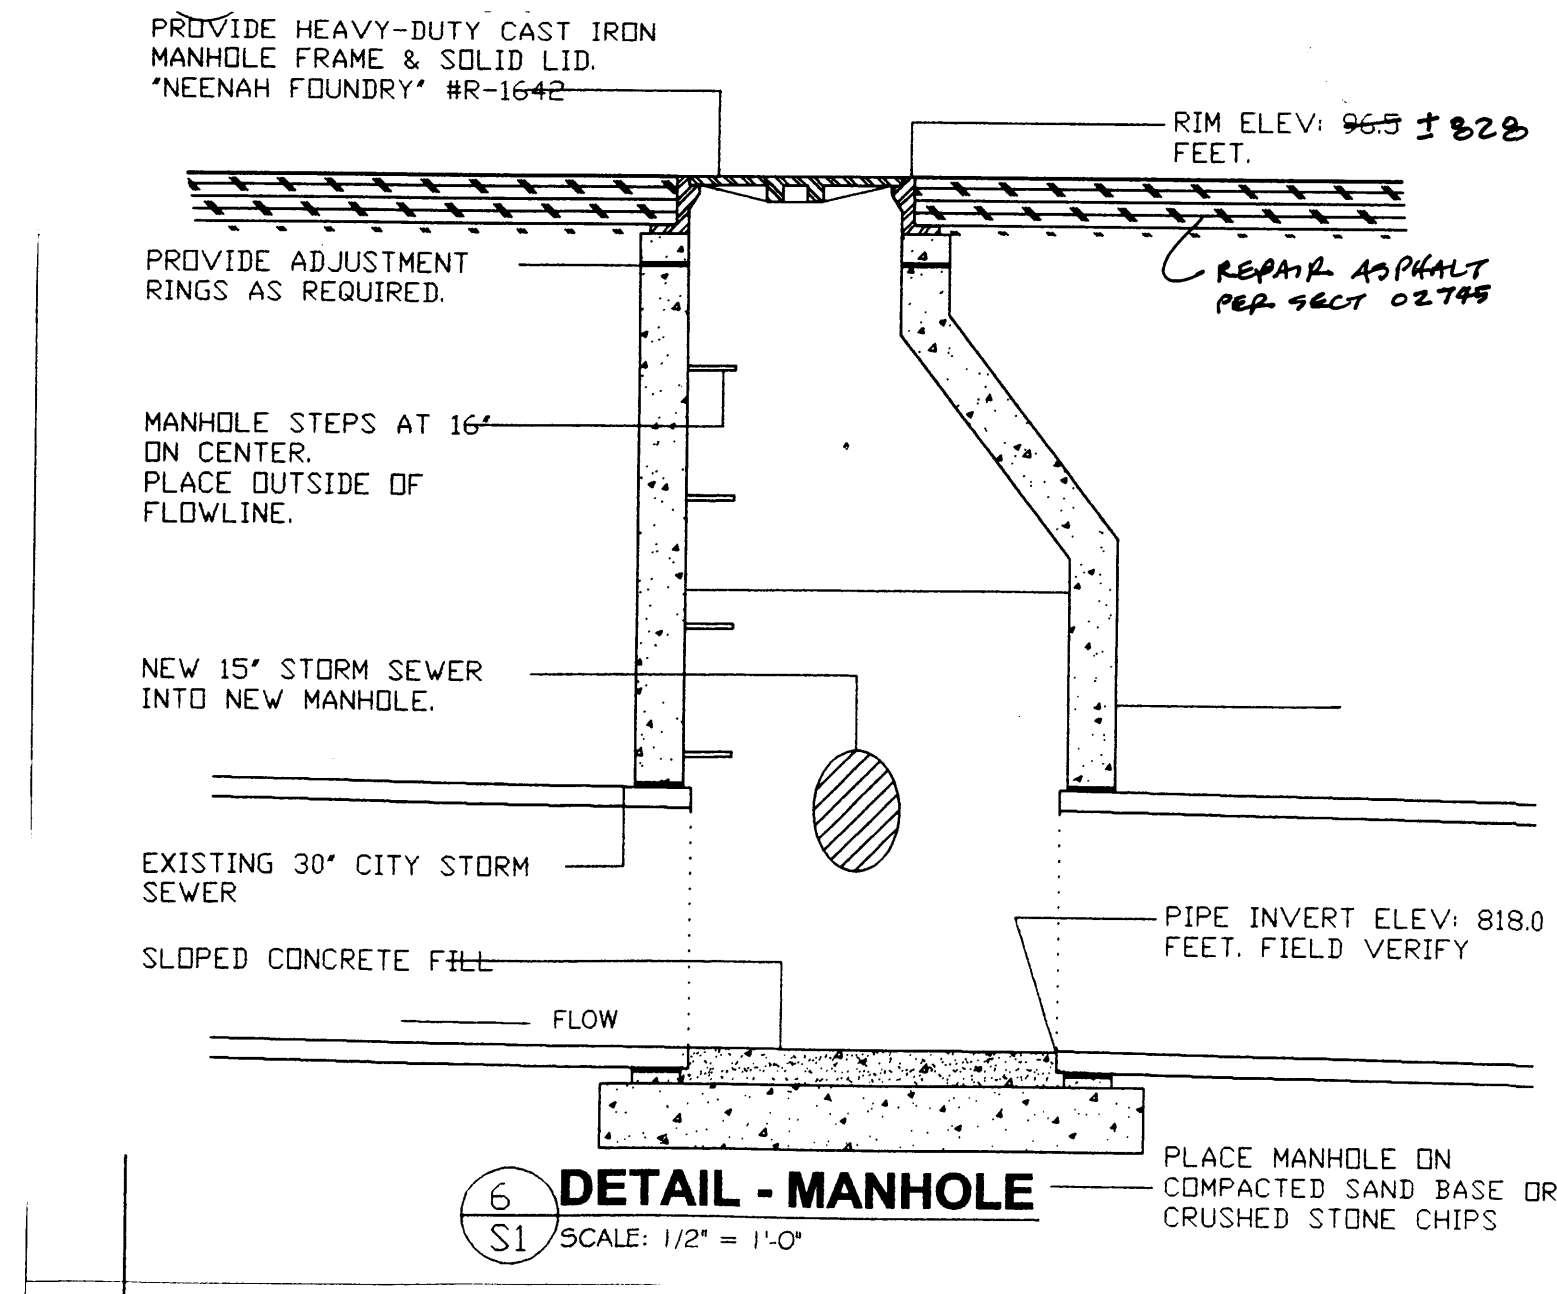


6 DETAIL - MANHOLE  
S1 SCALE: 1/2" = 1'-0"

### SITE PLAN

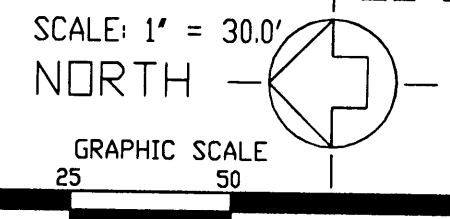

### SYMBOLS

- CHAIN LINK FENCE
- EXISTING GRADE CONTOUR LINE TO REMAIN
- EXISTING GRADE LINE TO BE CHANGED
- NEW GRADE LINE
- PROPERTY LINE W/ CORNER
- UTILITY LINE (STORM SEWER)
- DIRECTION WATER DRAINAGE
- NEW SPOT ELEVATION
- EXISTING SPOT ELEVATION
- TEST BORING MARK

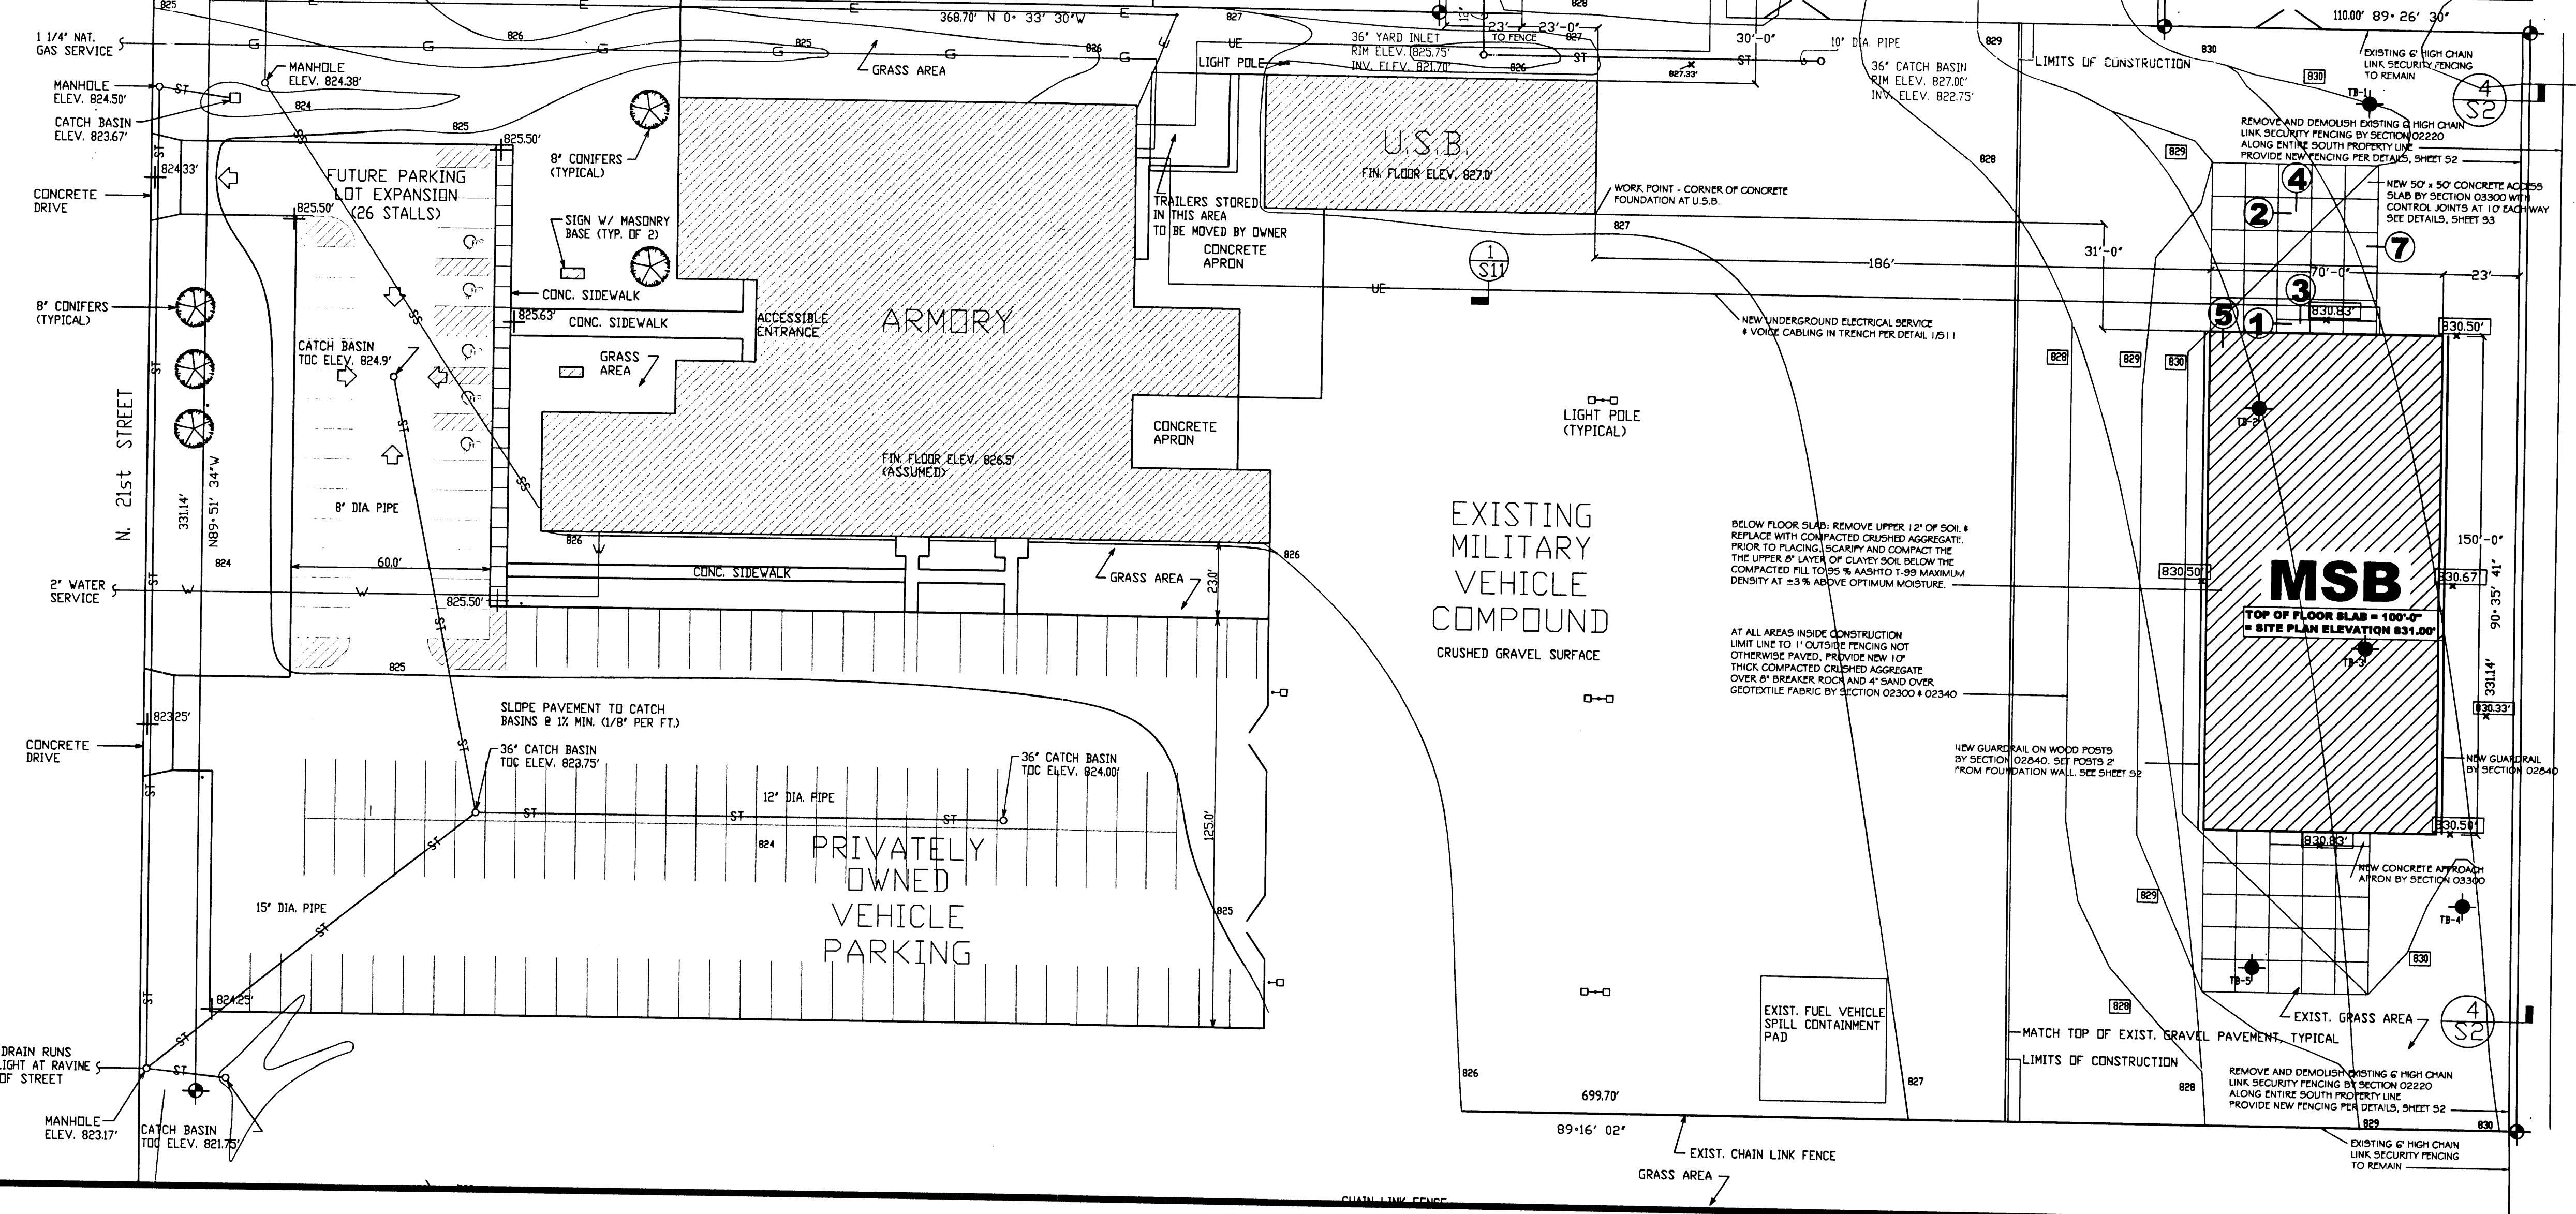

PLANS PREPARED BY:  
FACILITIES DIRECTORATE  
DEPARTMENT OF MILITARY AFFAIRS  
OFFICE OF THE ADJUTANT GENERAL  
P.O. BOX 14587  
MADISON, WISCONSIN 53714-0587

# SITE PLAN

## WISCONSIN ARMY NATIONAL GUARD

### SUPERIOR, WISCONSIN

State of Wisconsin - Department of Administration - Division of Facilities Development

STATE PROJECT NO.:	96835/00H4H
DMA PROJECT NO.:	
DRAWN BY:	pb
DATE:	1 NOV 2000
REVISIONS:	
SHEET NO.:	<b>S1</b>