NOTE

1) PAVING OF PIPE TRAYING WITHOUT A CITY INSPECTOR PRESENT IS PROHIBITED
2) [illegible] UTILITY CROSSINGS [illegible] UTILITIES
[illegible] ENGINEERING
[illegible] WATER LIGHT AND [illegible]
[illegible] TEL CO 392-6111
[illegible] ARE ON STORM SEWER PLANS
[illegible] MONUMENT

Prop. Revision 8/18/81

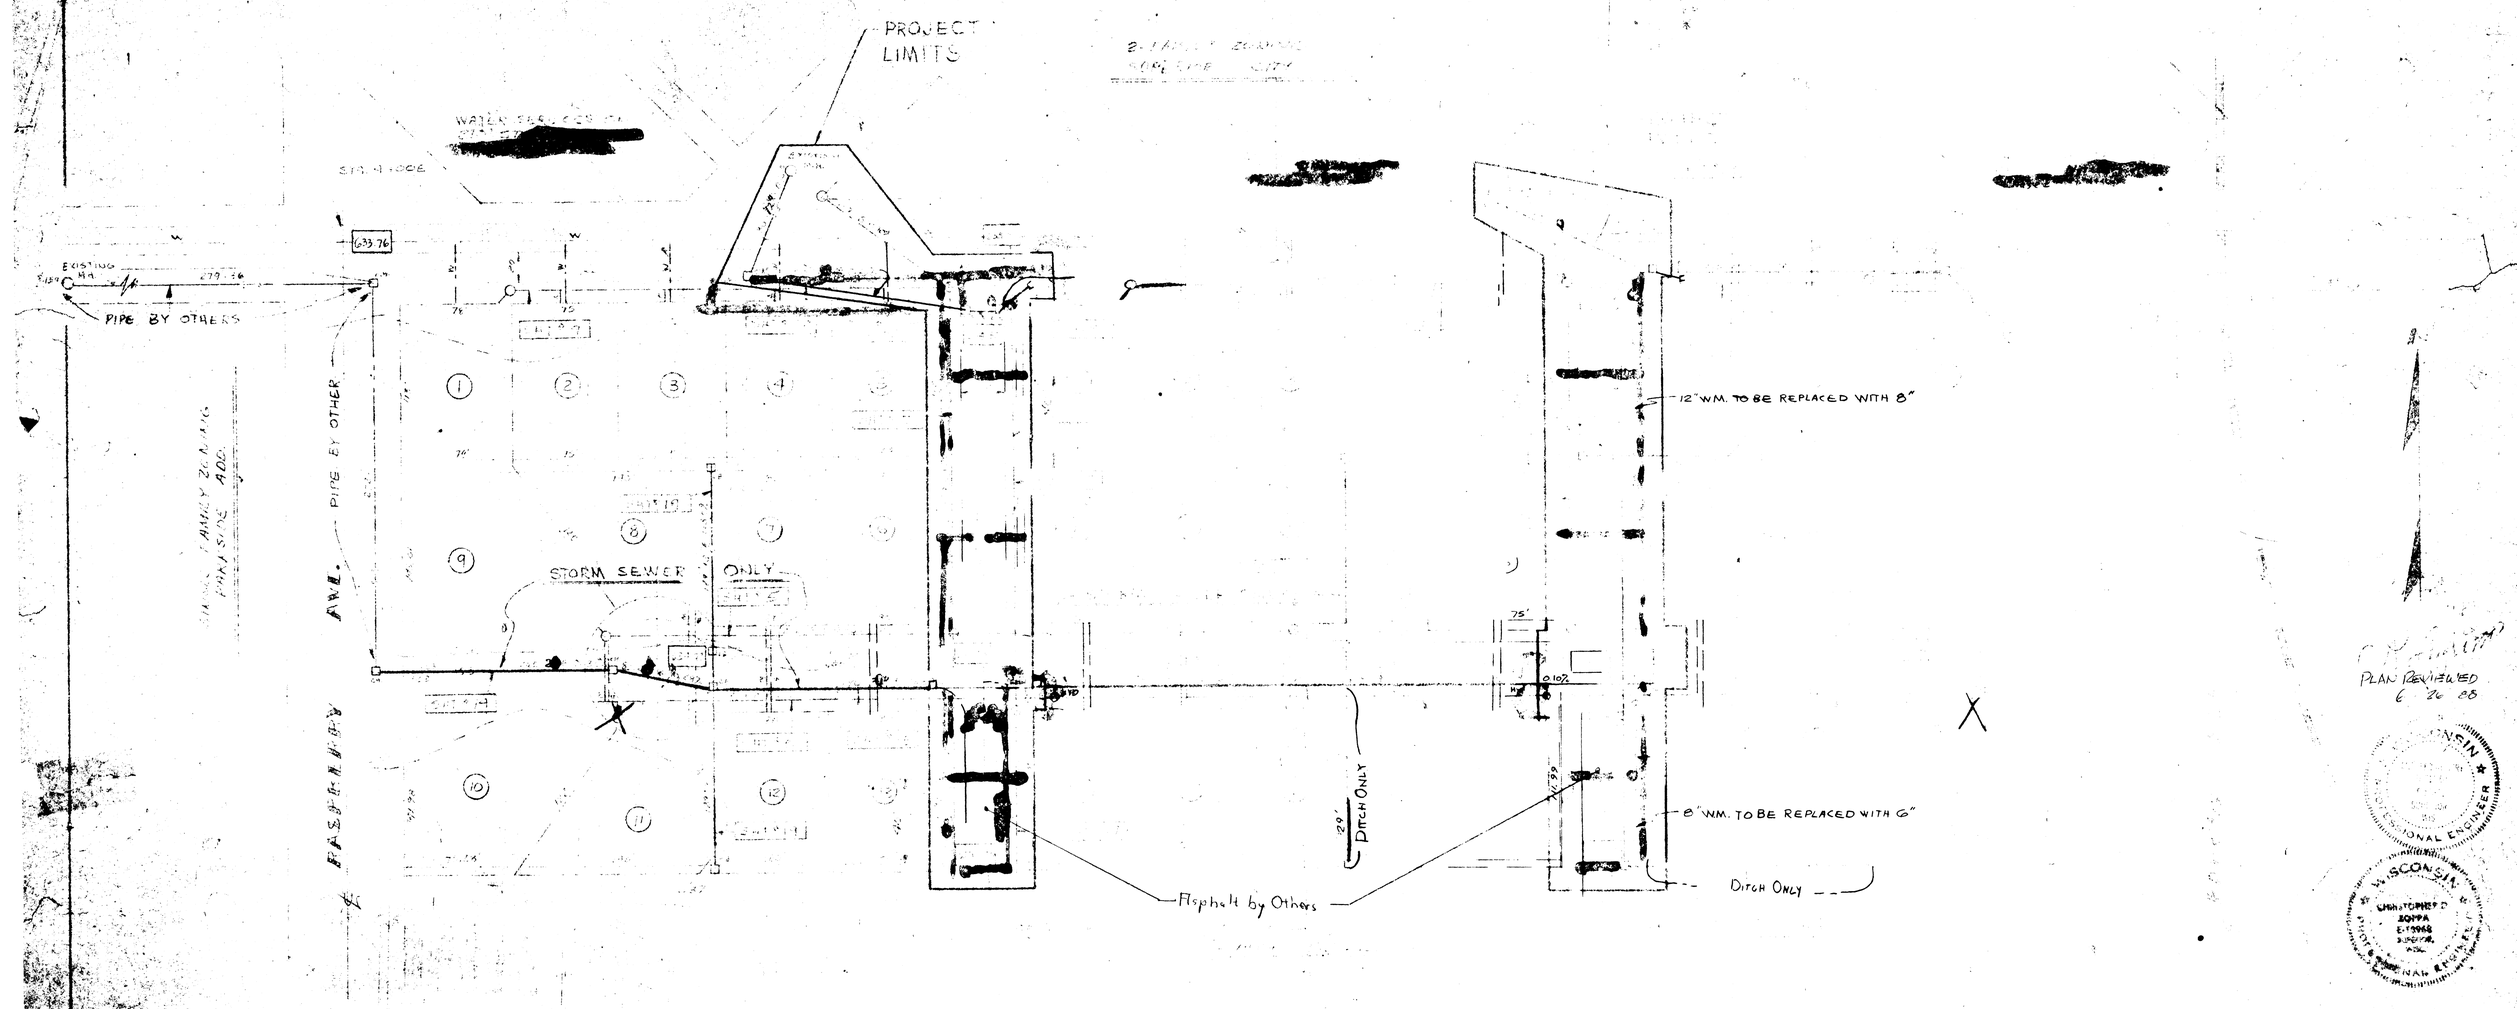

DATE 10-22-79 REVISED FOR BOTH PHASES
DATE 10-9-79 REVISED FOR PHASE I

CITY OF SUPERIOR
ENGINEERING DEPARTMENT
PASPERRY ACRES
UTILITY SYSTEM PLAN