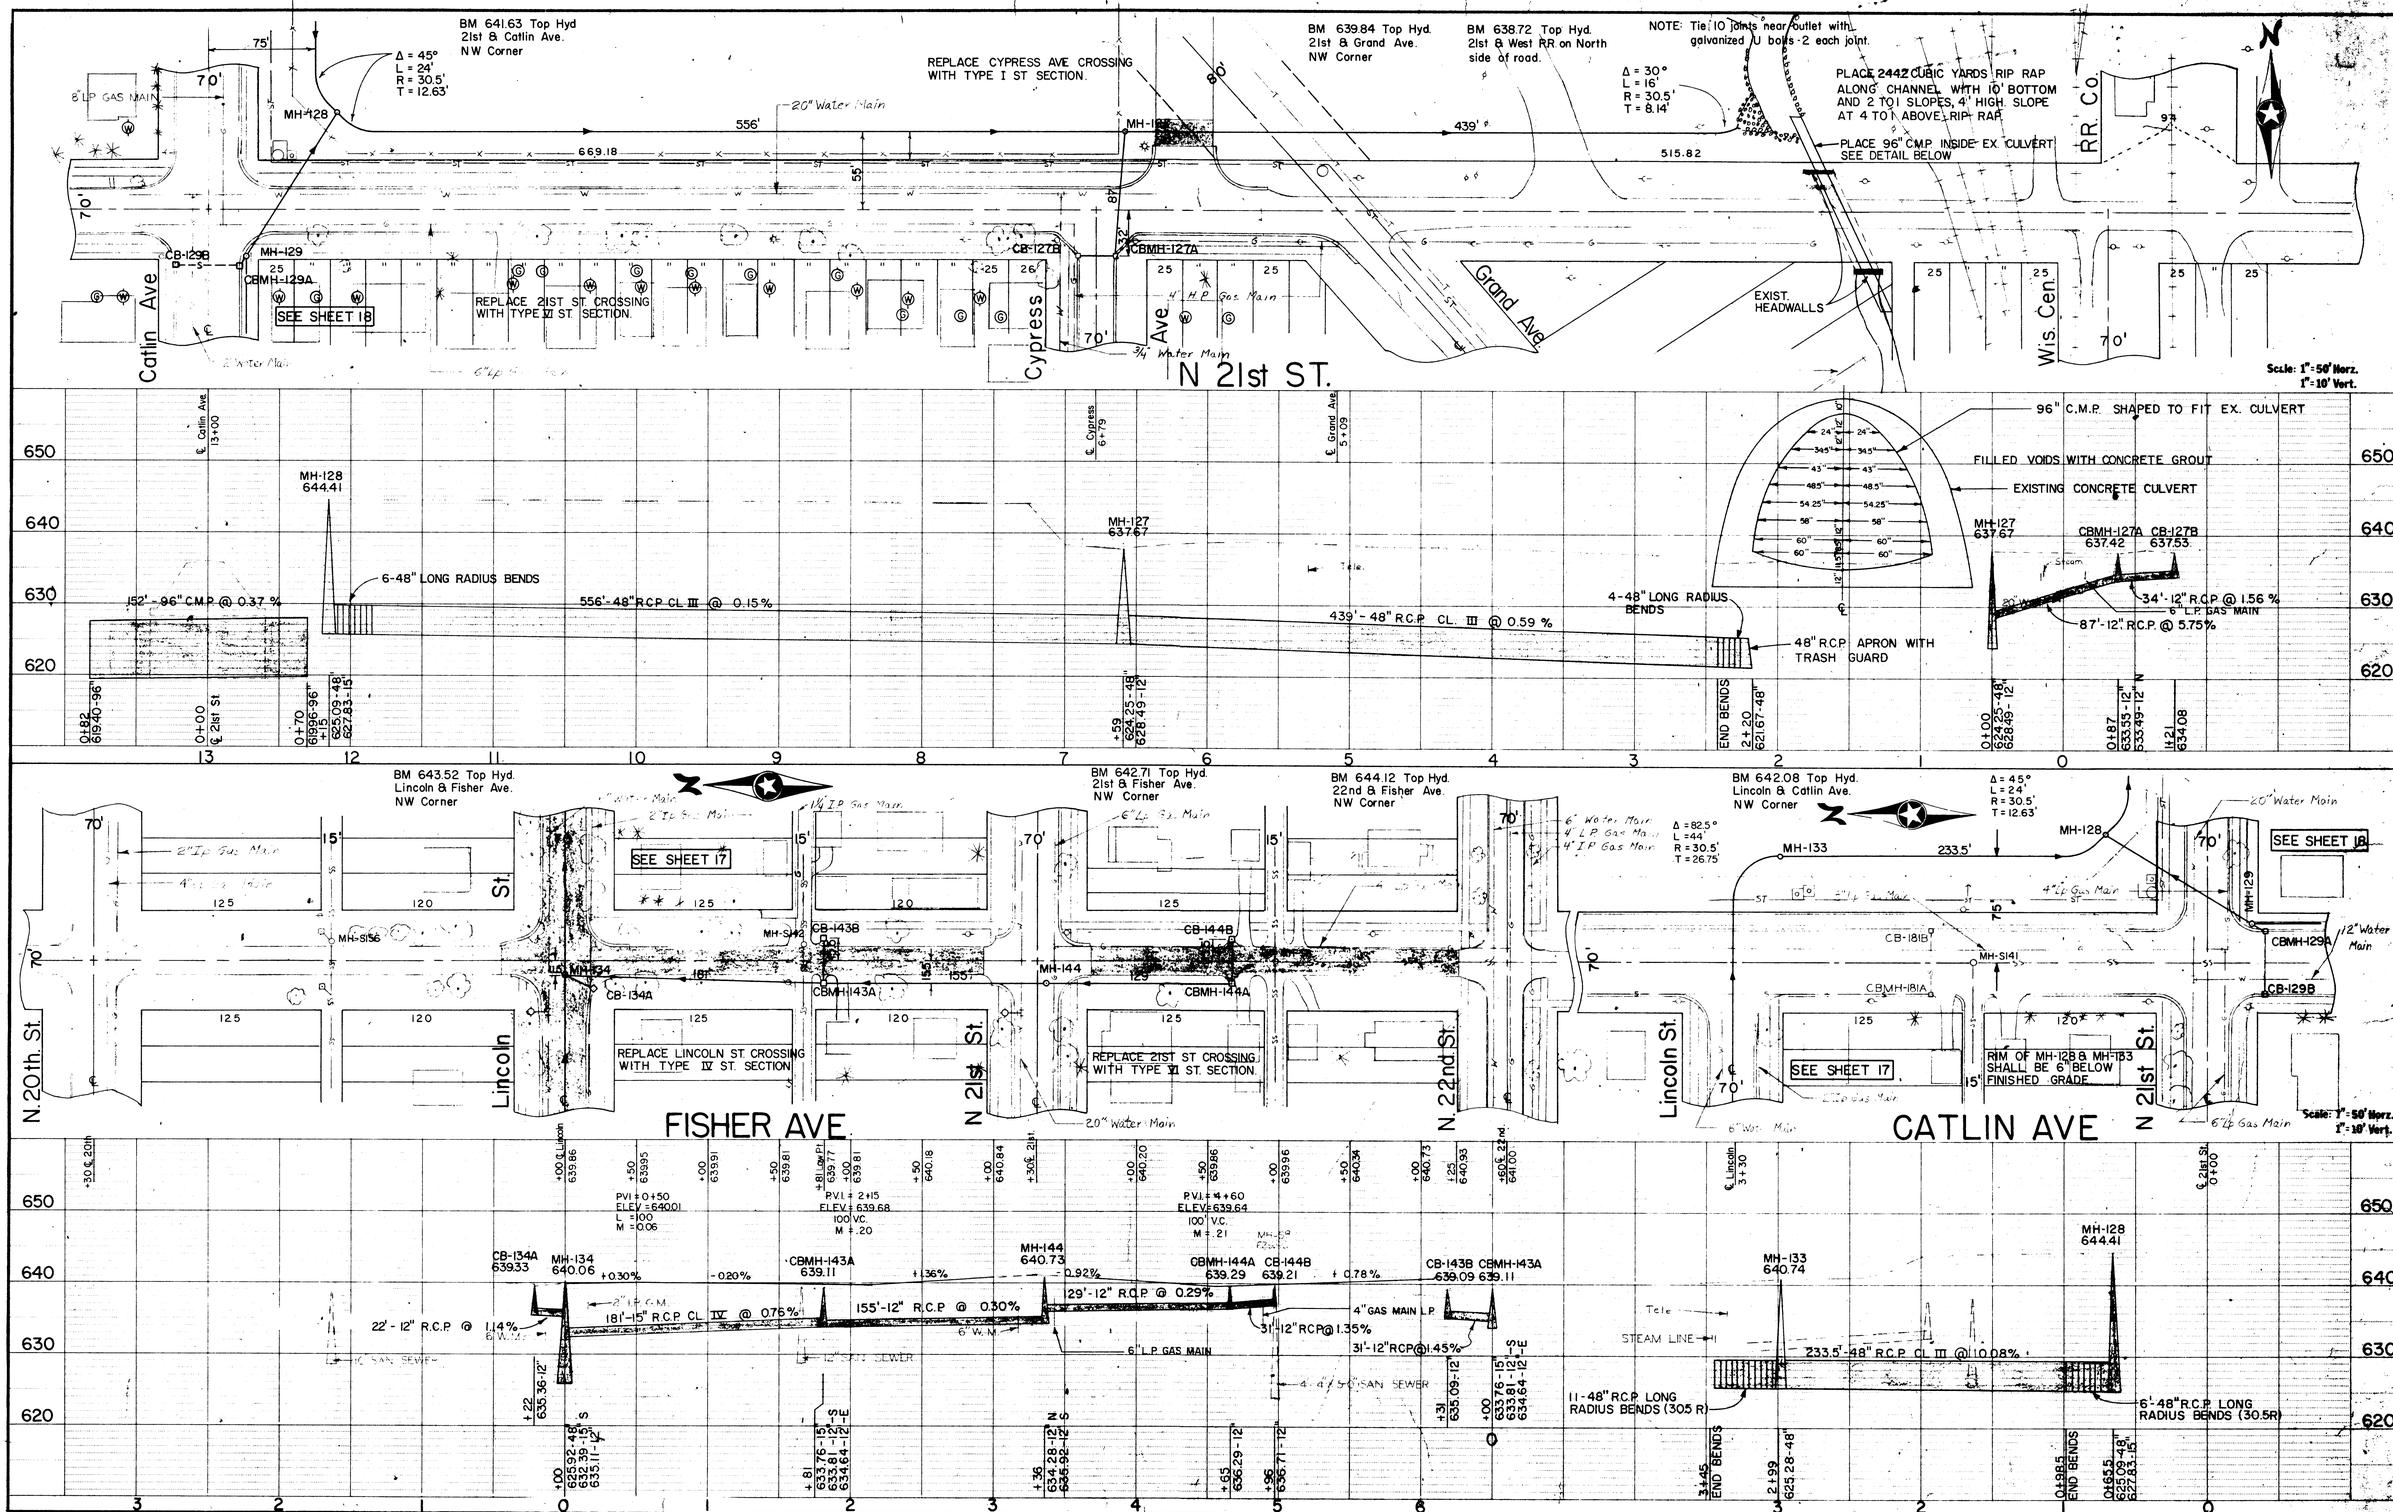

I HEREBY CERTIFY THAT THIS PLAN WAS PREPARED BY ME OR UNDER MY DIRECT SUPERVISION AND THAT I AM A DULY REGISTERED PROFESSIONAL ENGINEER UNDER THE LAWS OF THE STATE OF WISCONSIN

DATE OCT. 10, 1974 REG. NO. E06599

SURVEY	MLS	REVISIONS	
DRAWN	NJBS	RECORD PLANS	
DESIGN	DCB	7/7/78	HBR
APPROV'D	GRC		

DONESTROO, ROSENE, ANDERLIK & ASSOC., INC.
ST. PAUL, MINNESOTA

SUPERIOR, WISCONSIN
DATE: SEPT. 30, 1974 COMM. 6888J

DISTRICT 3B - FAXON
STORM SEWER SEPARATION

16/21

21st St.
Fisher Ave.
Catlin Ave.