



# 1313 Belknap St



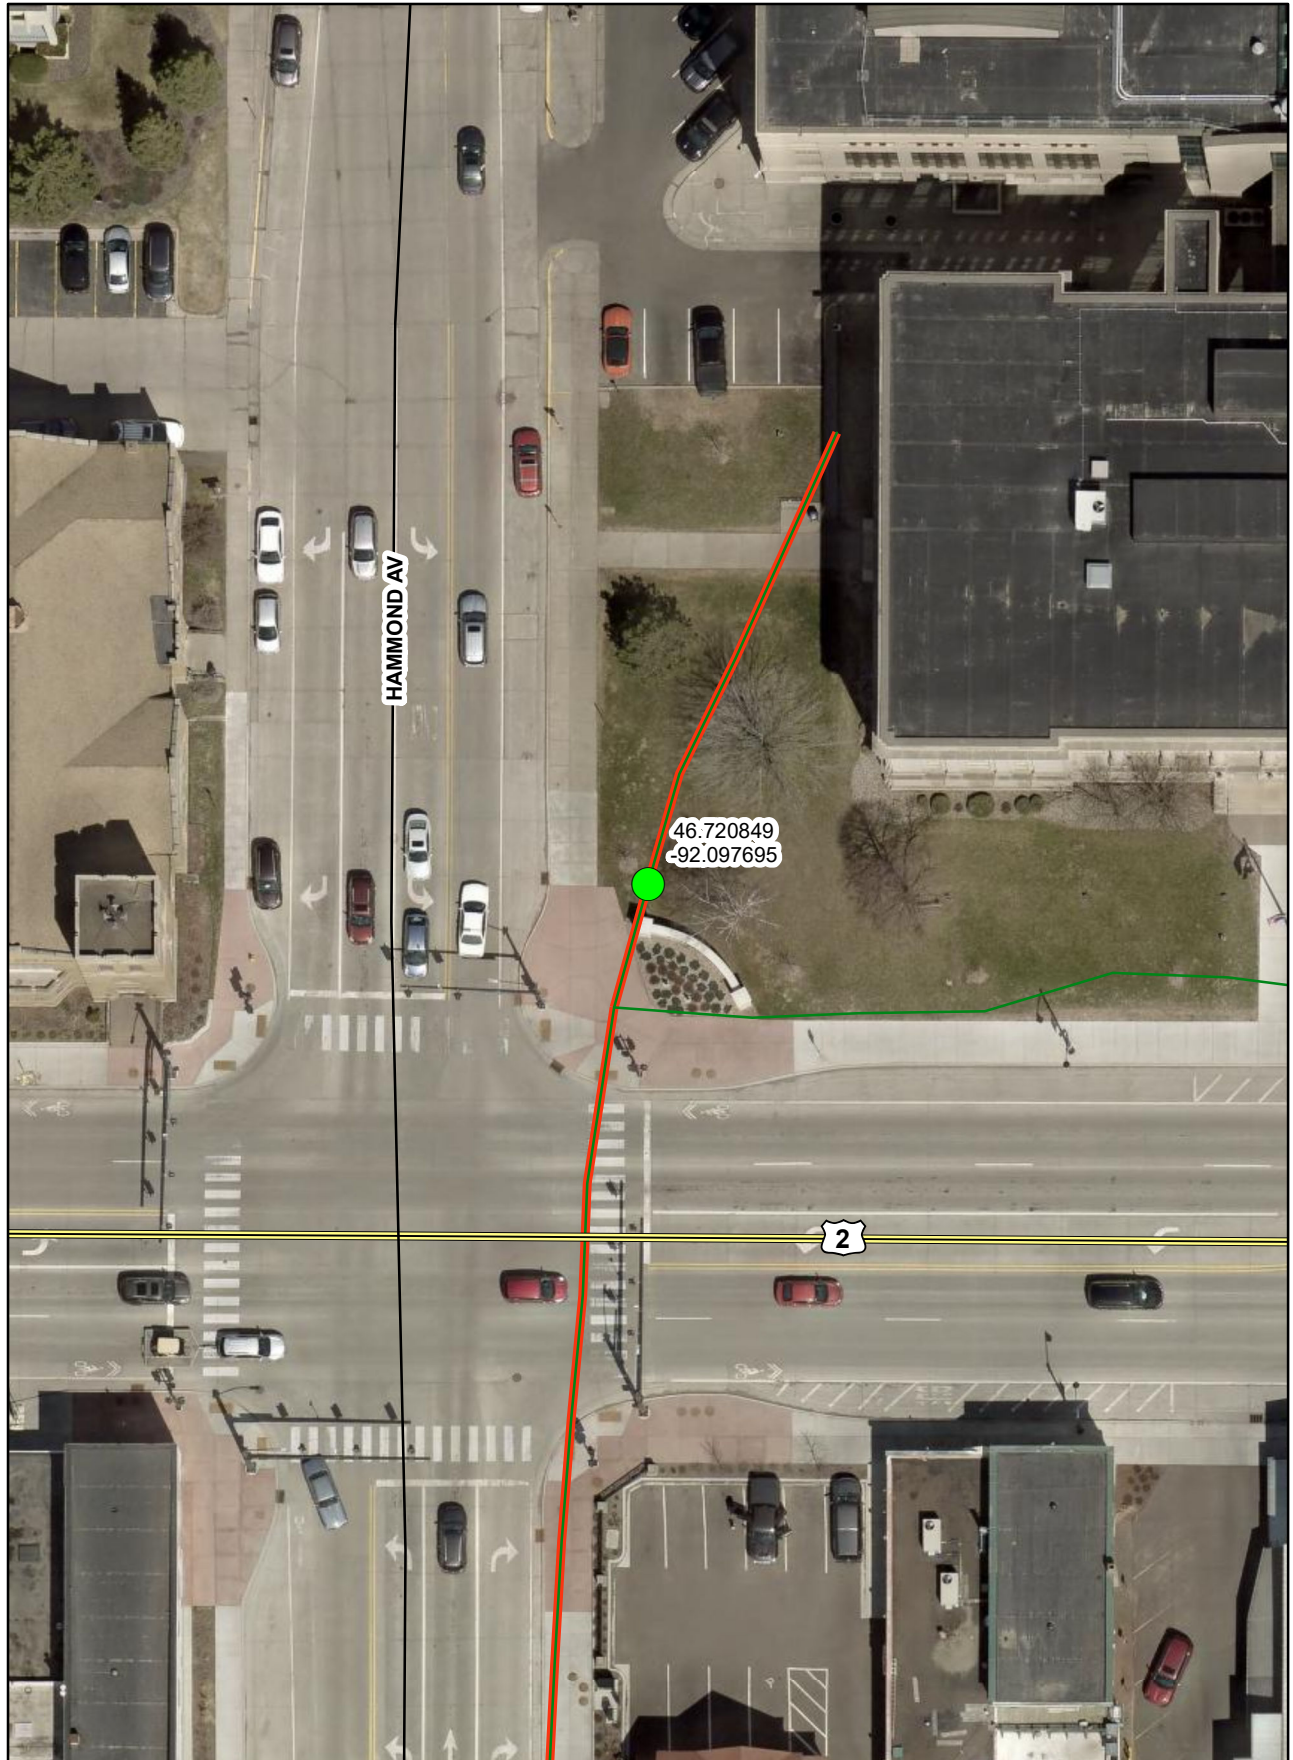

# 1800 Hammond Ave

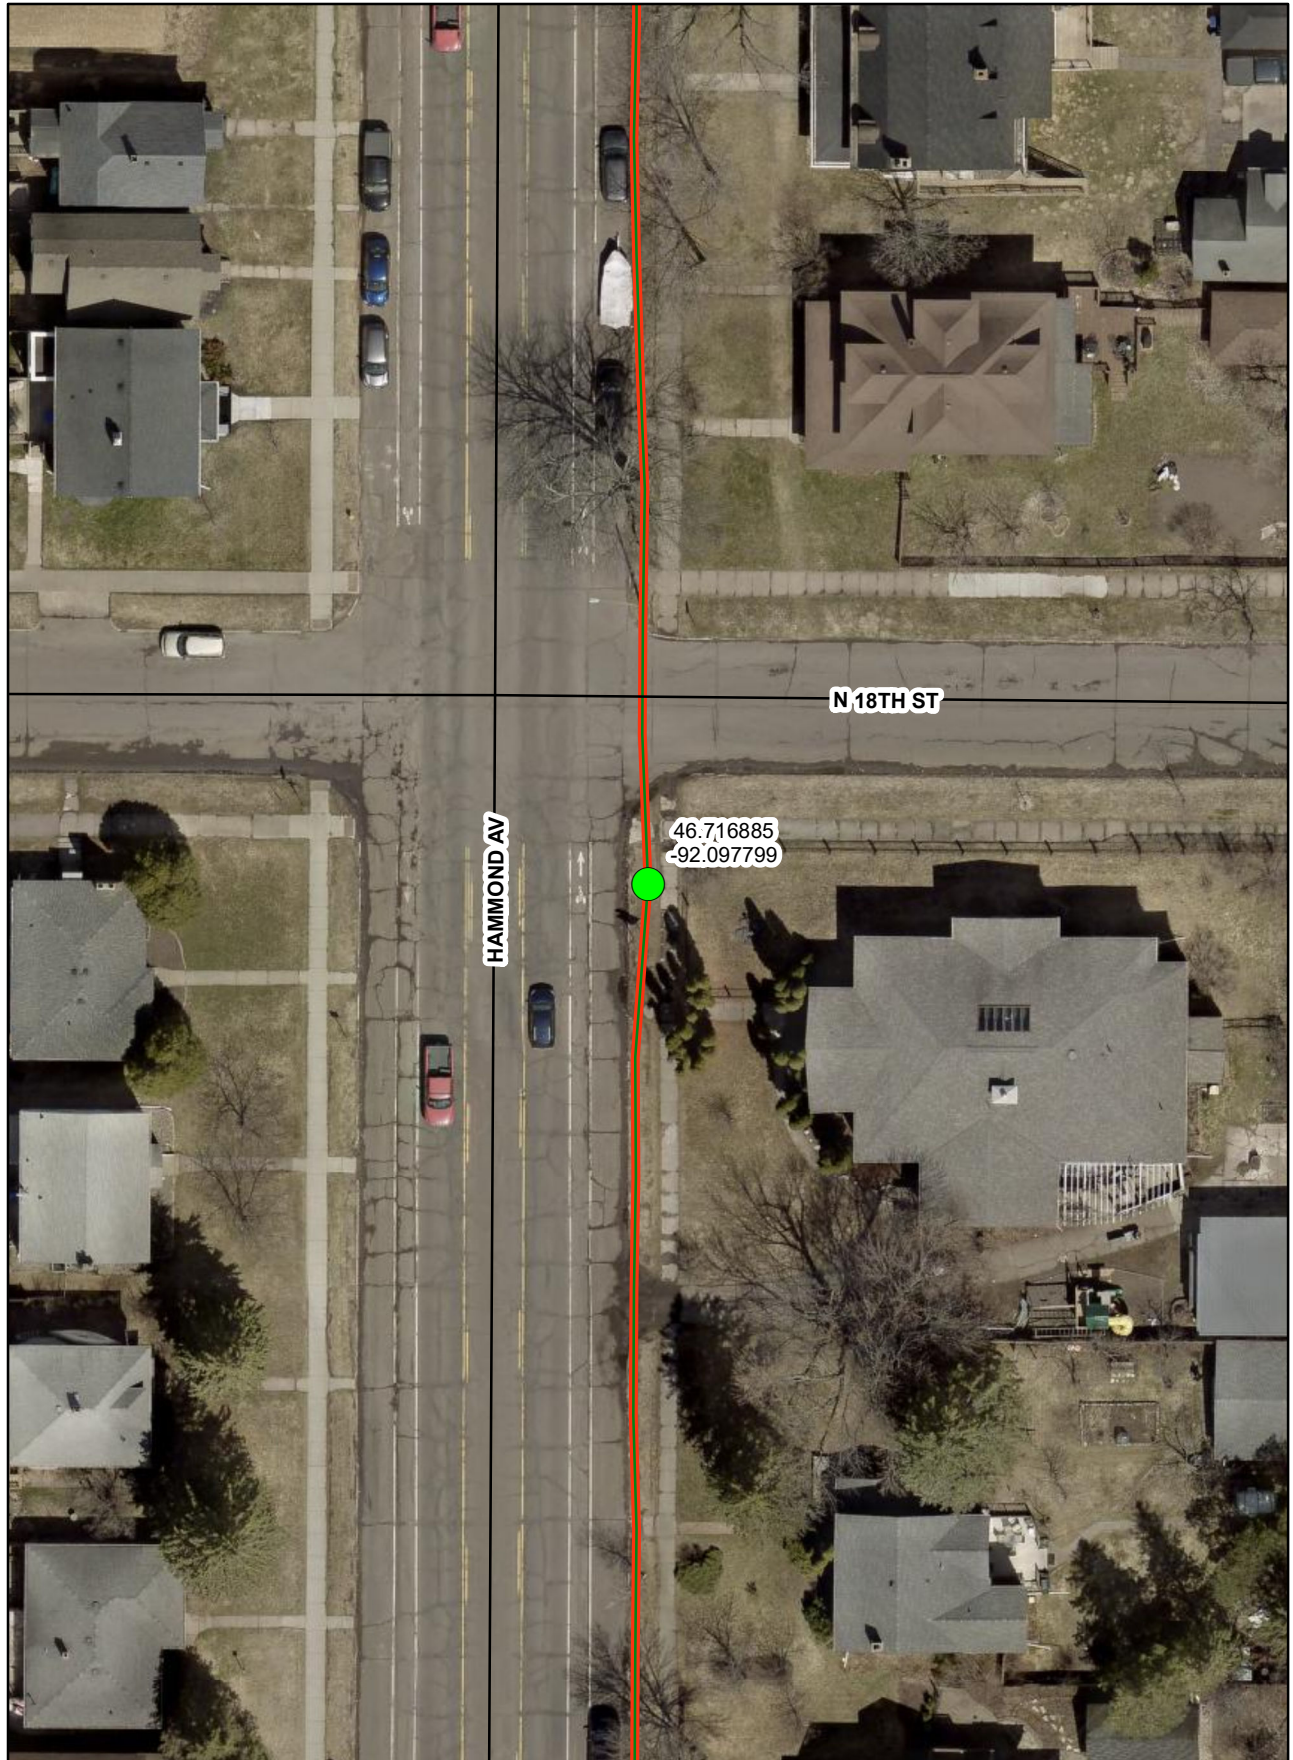


N 18TH ST

HAMMOND AV

46.716885  
-92.097799




# 2100 Hammond Ave

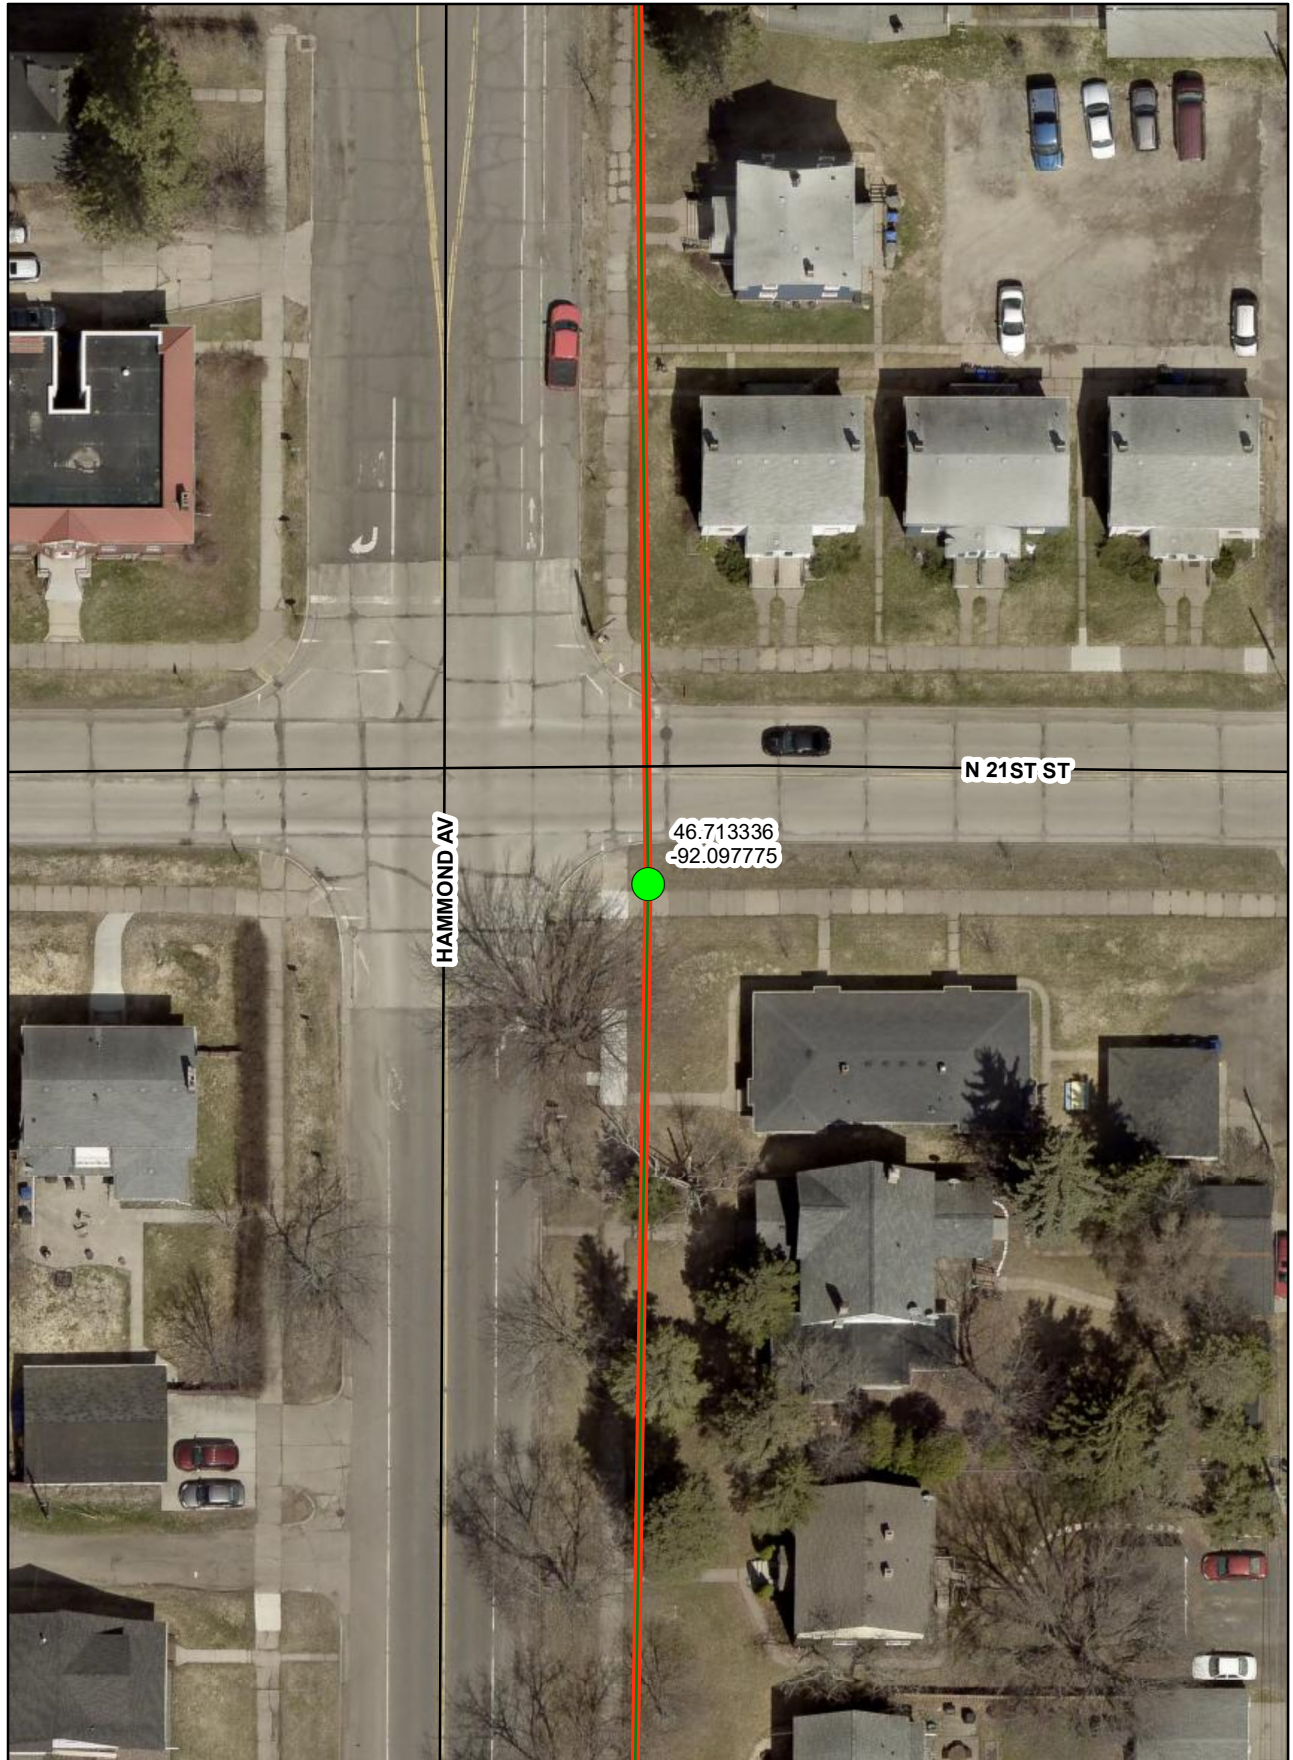




# 2331 Hammond Ave

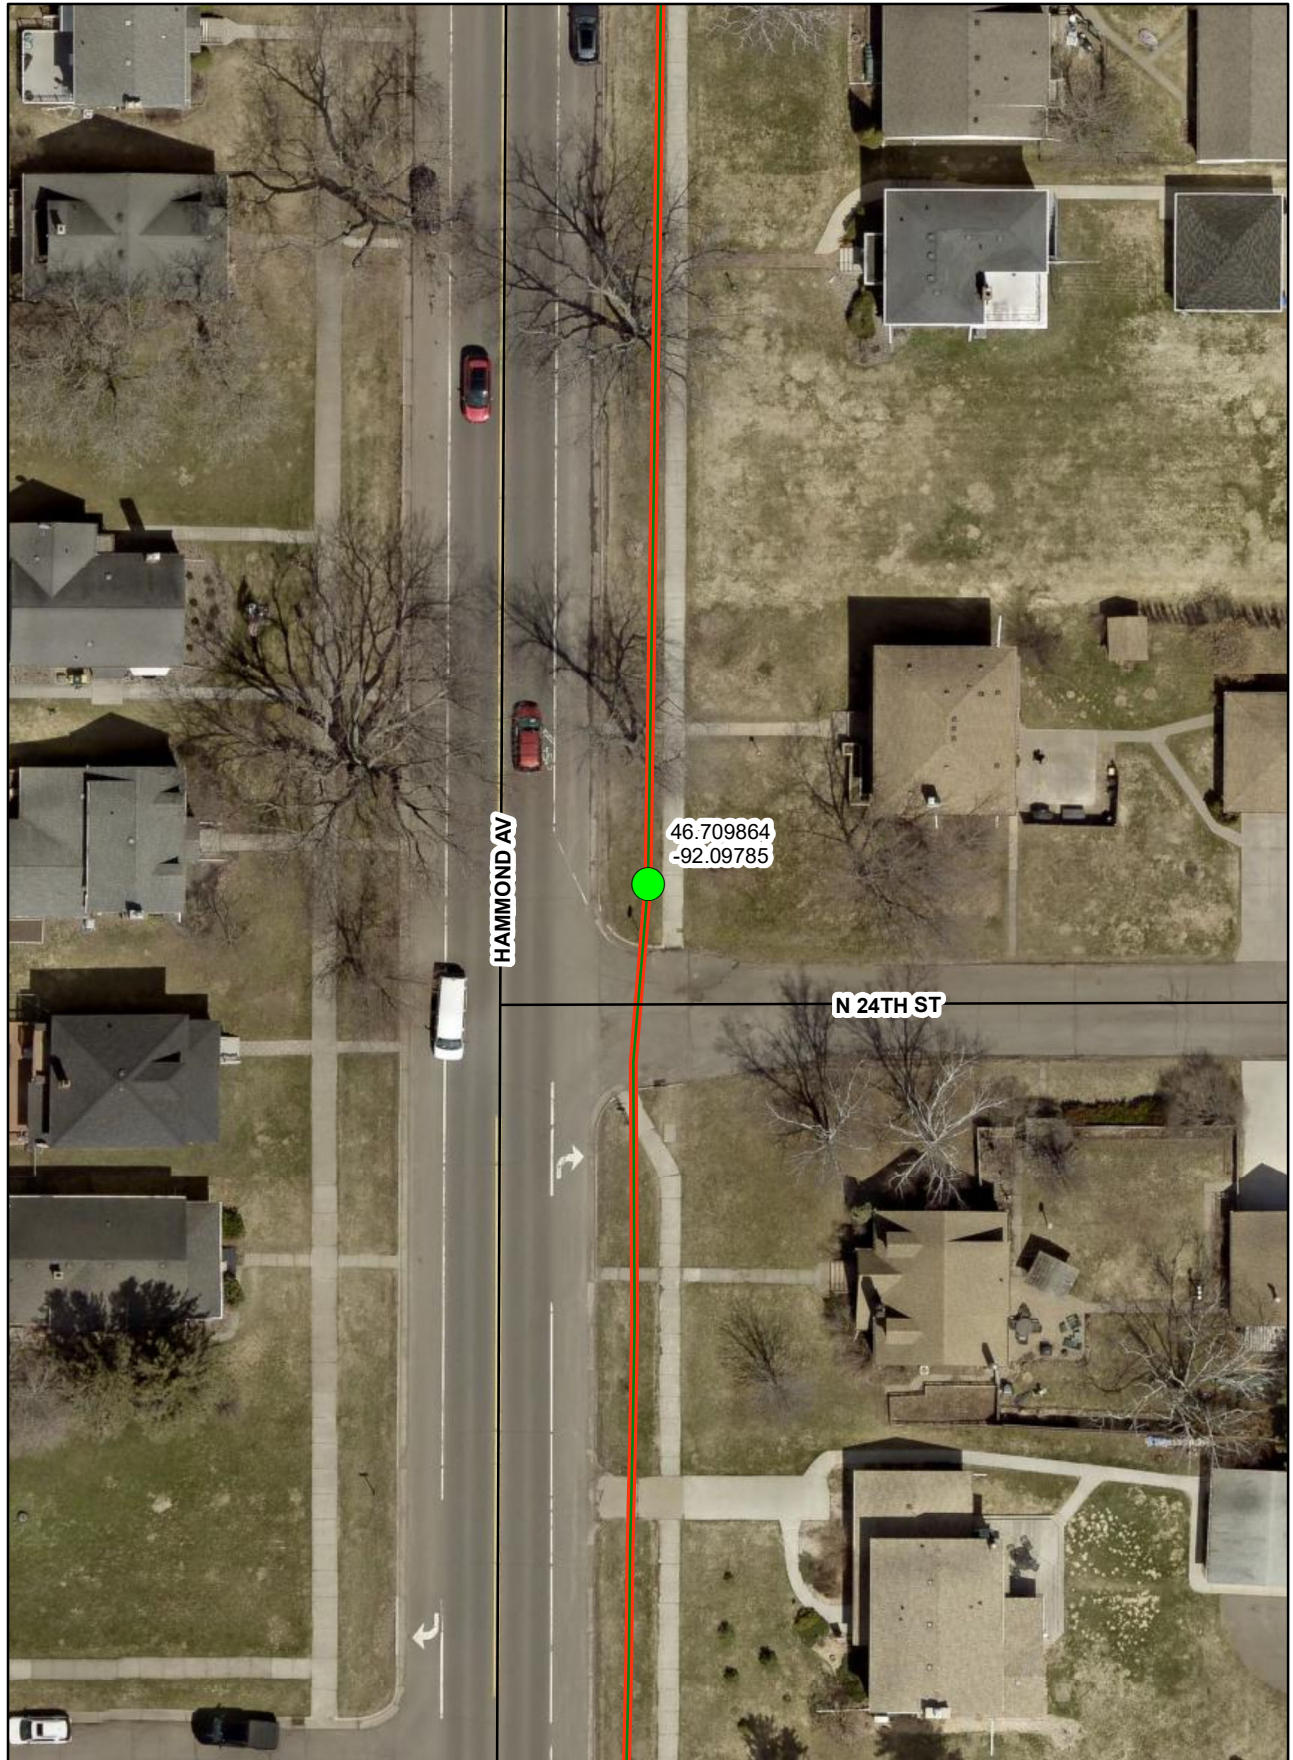




# 2800 Hammond Ave

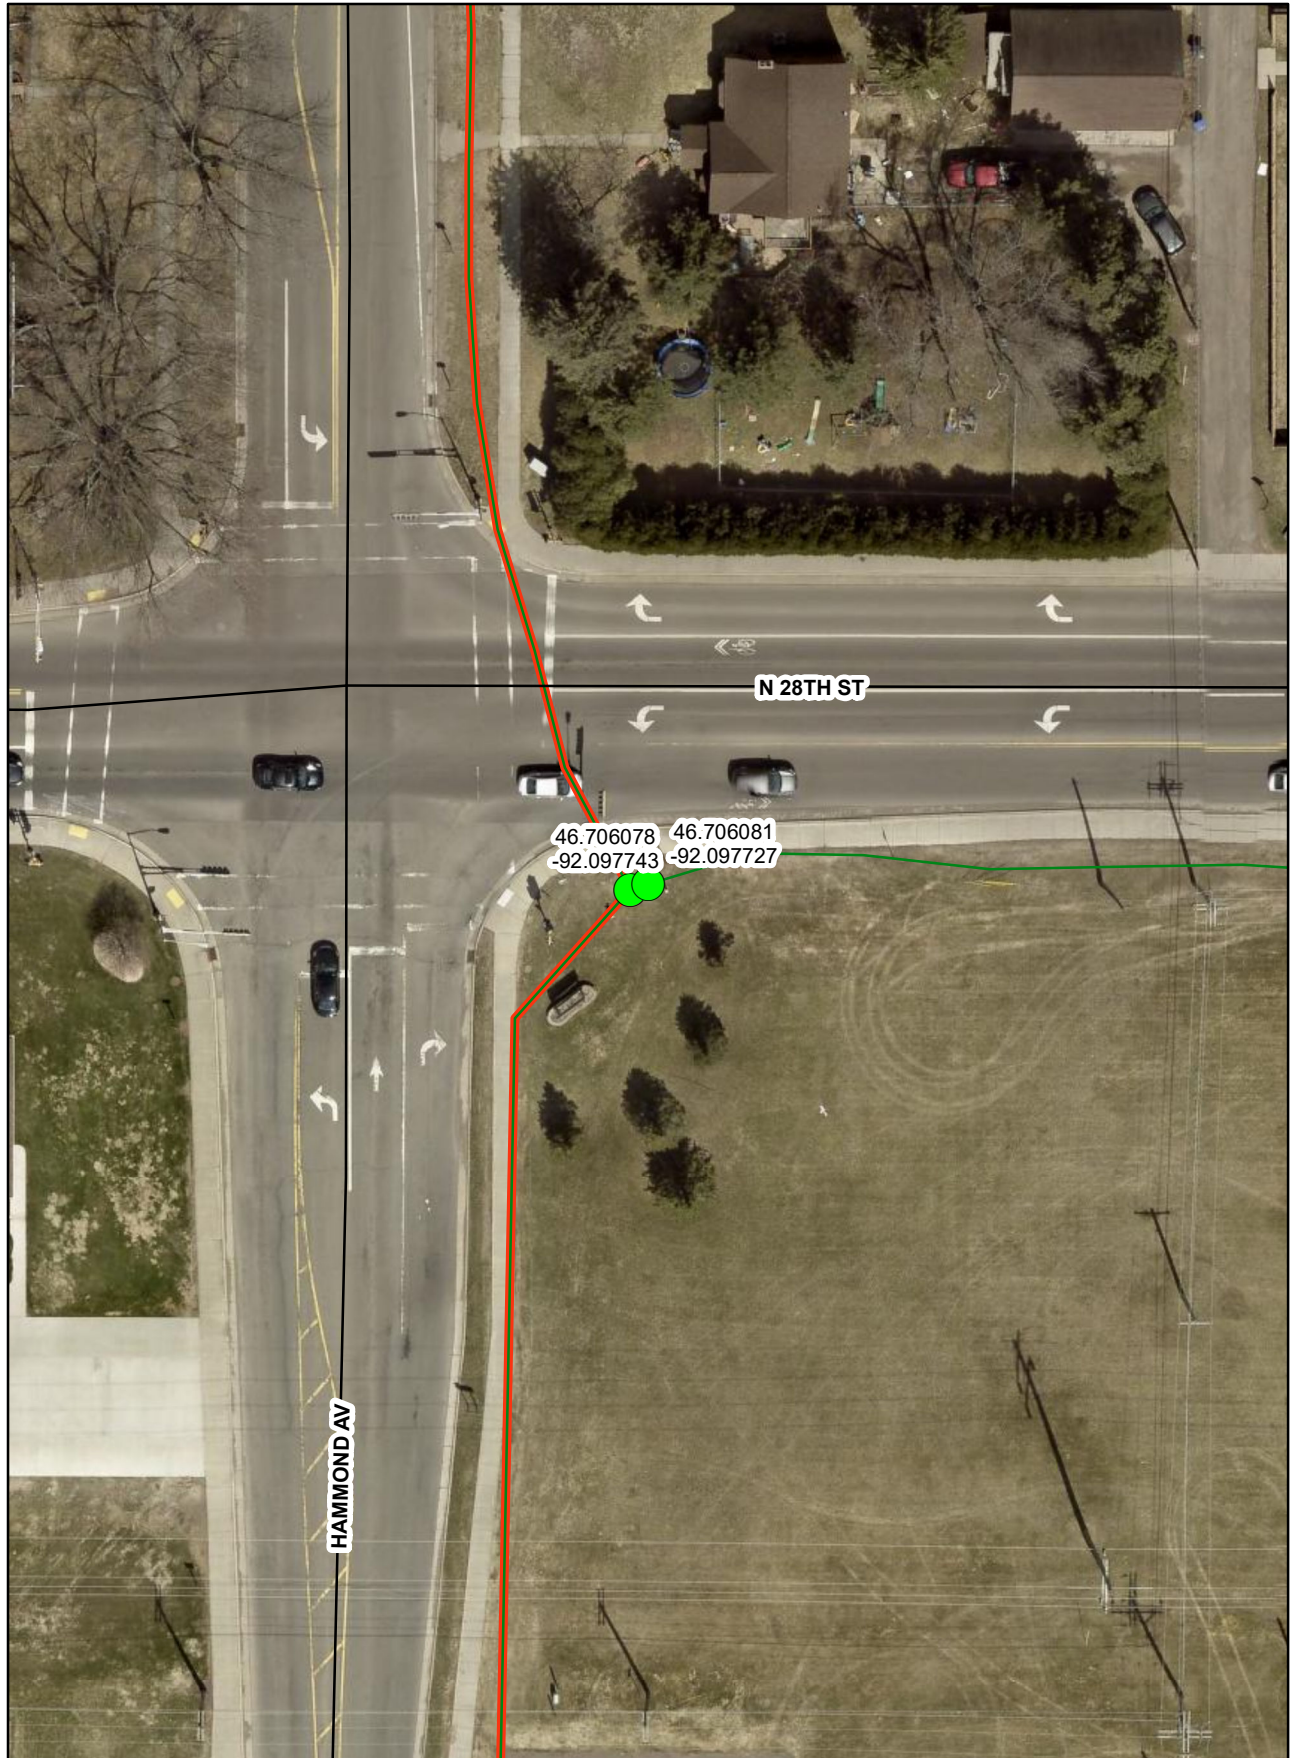




# 2800 Hammond Ave

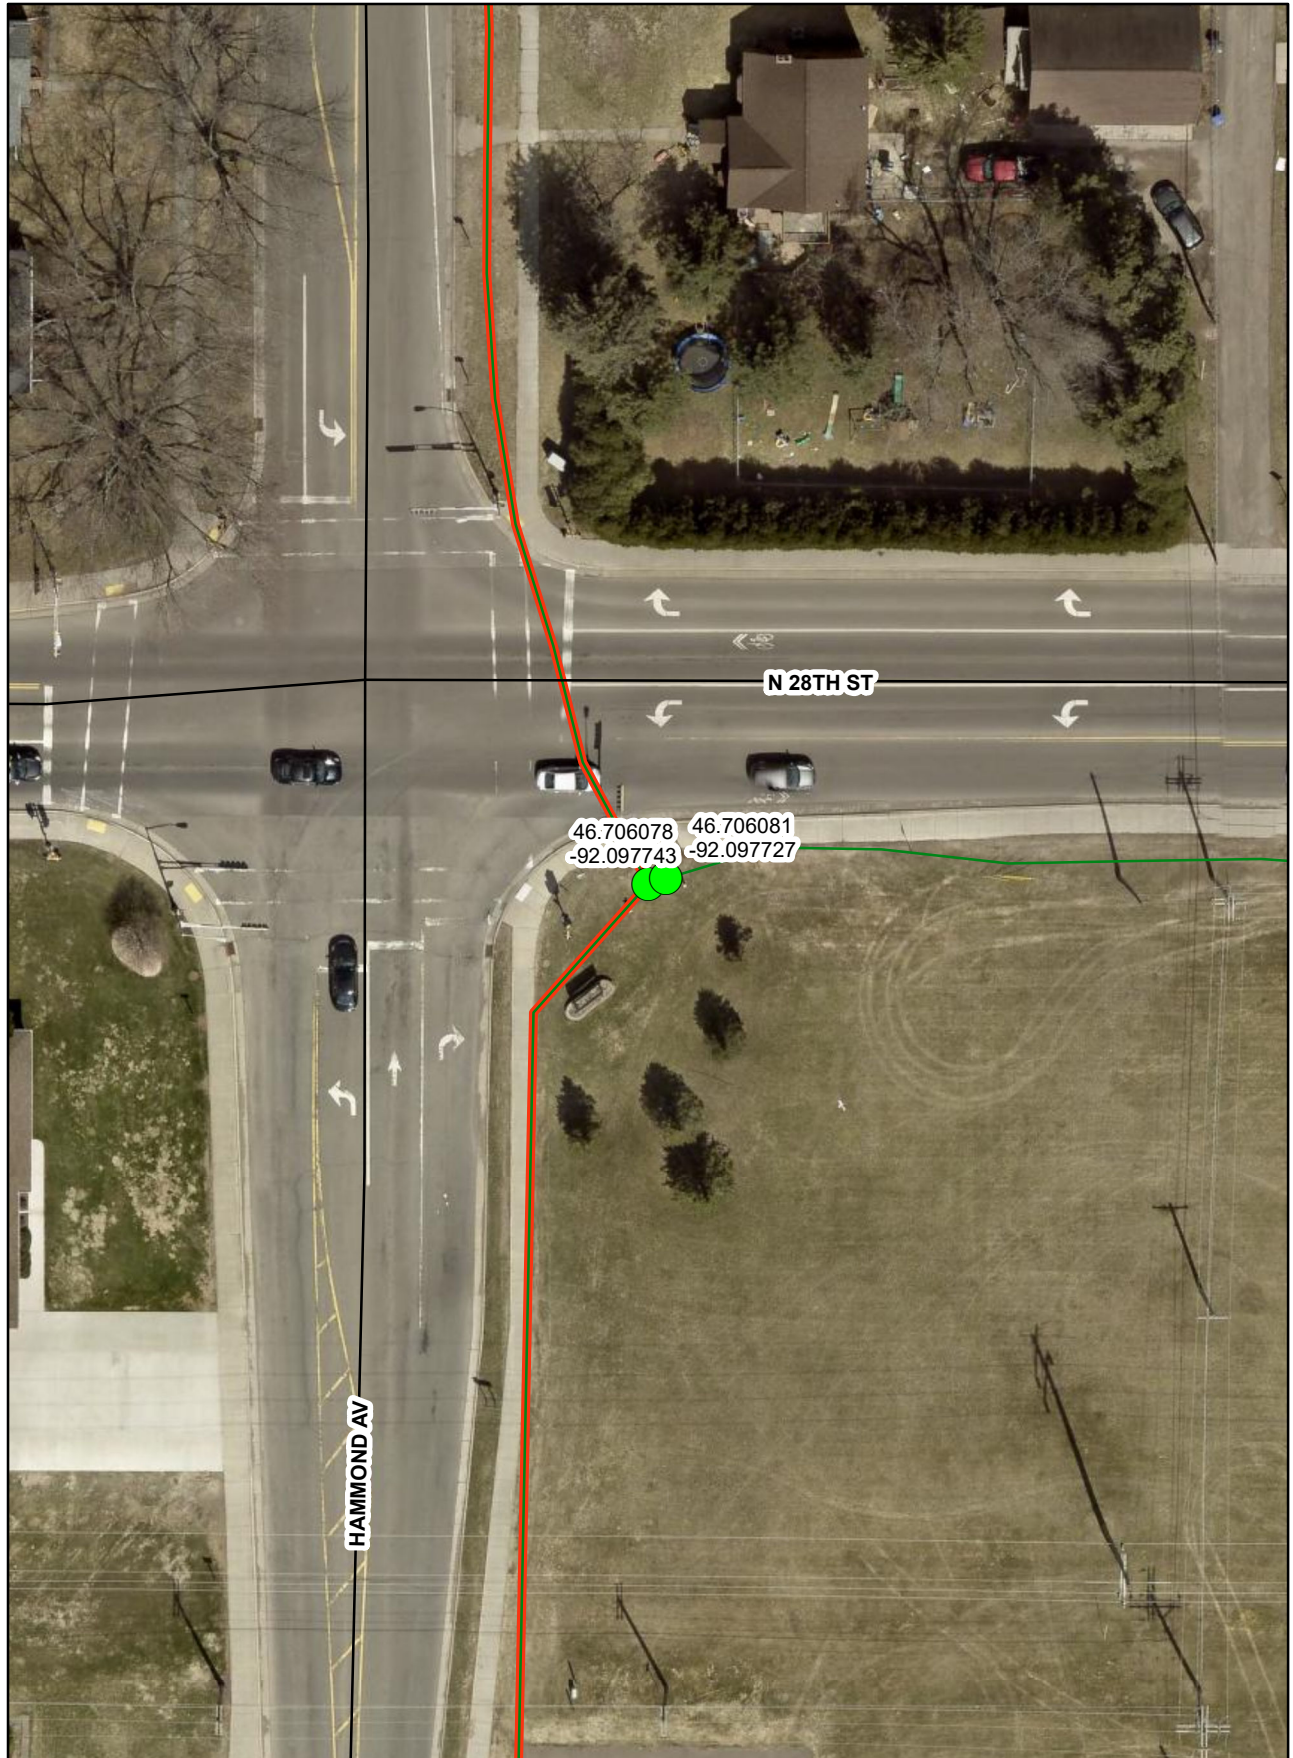




# 3100 Hammond Ave

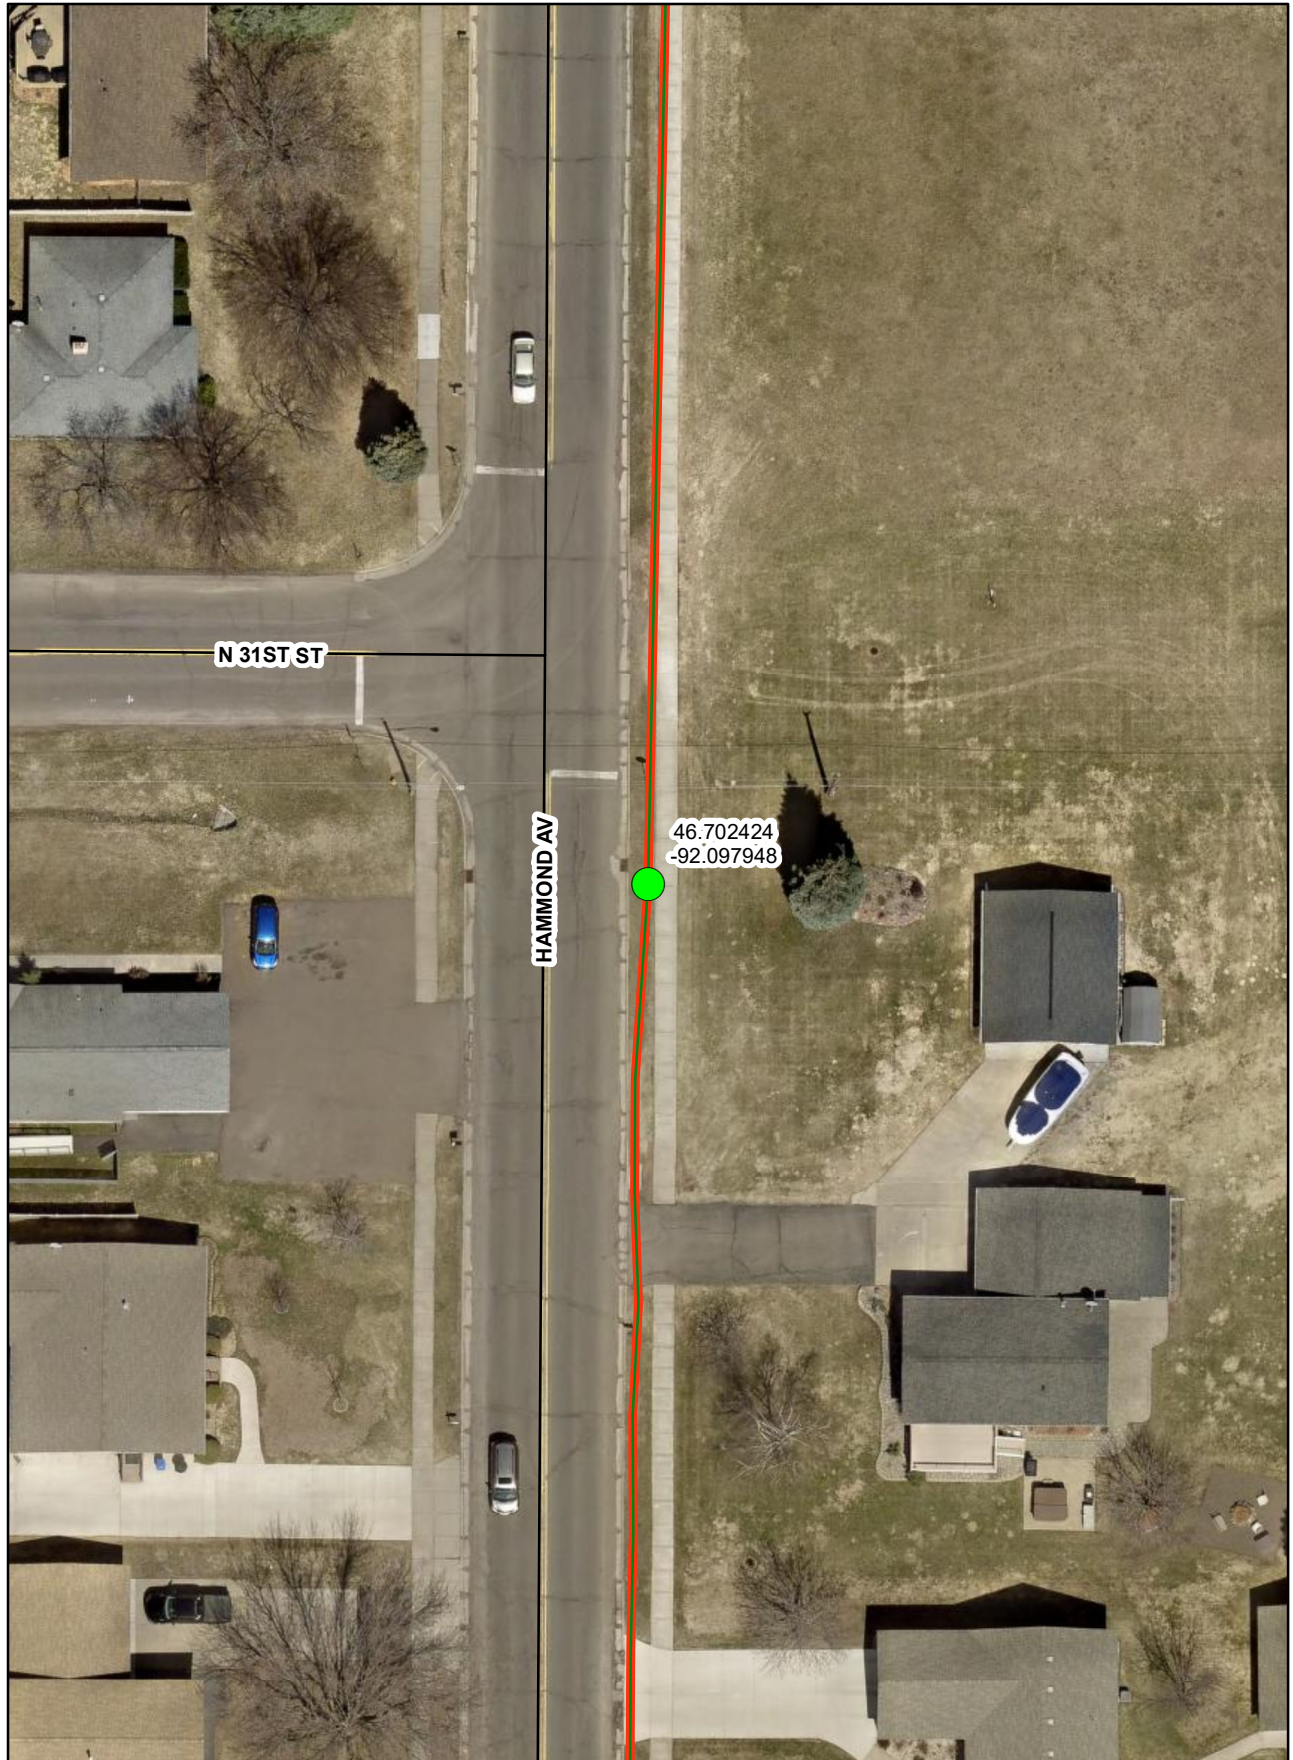




# 3400 Hammond Ave

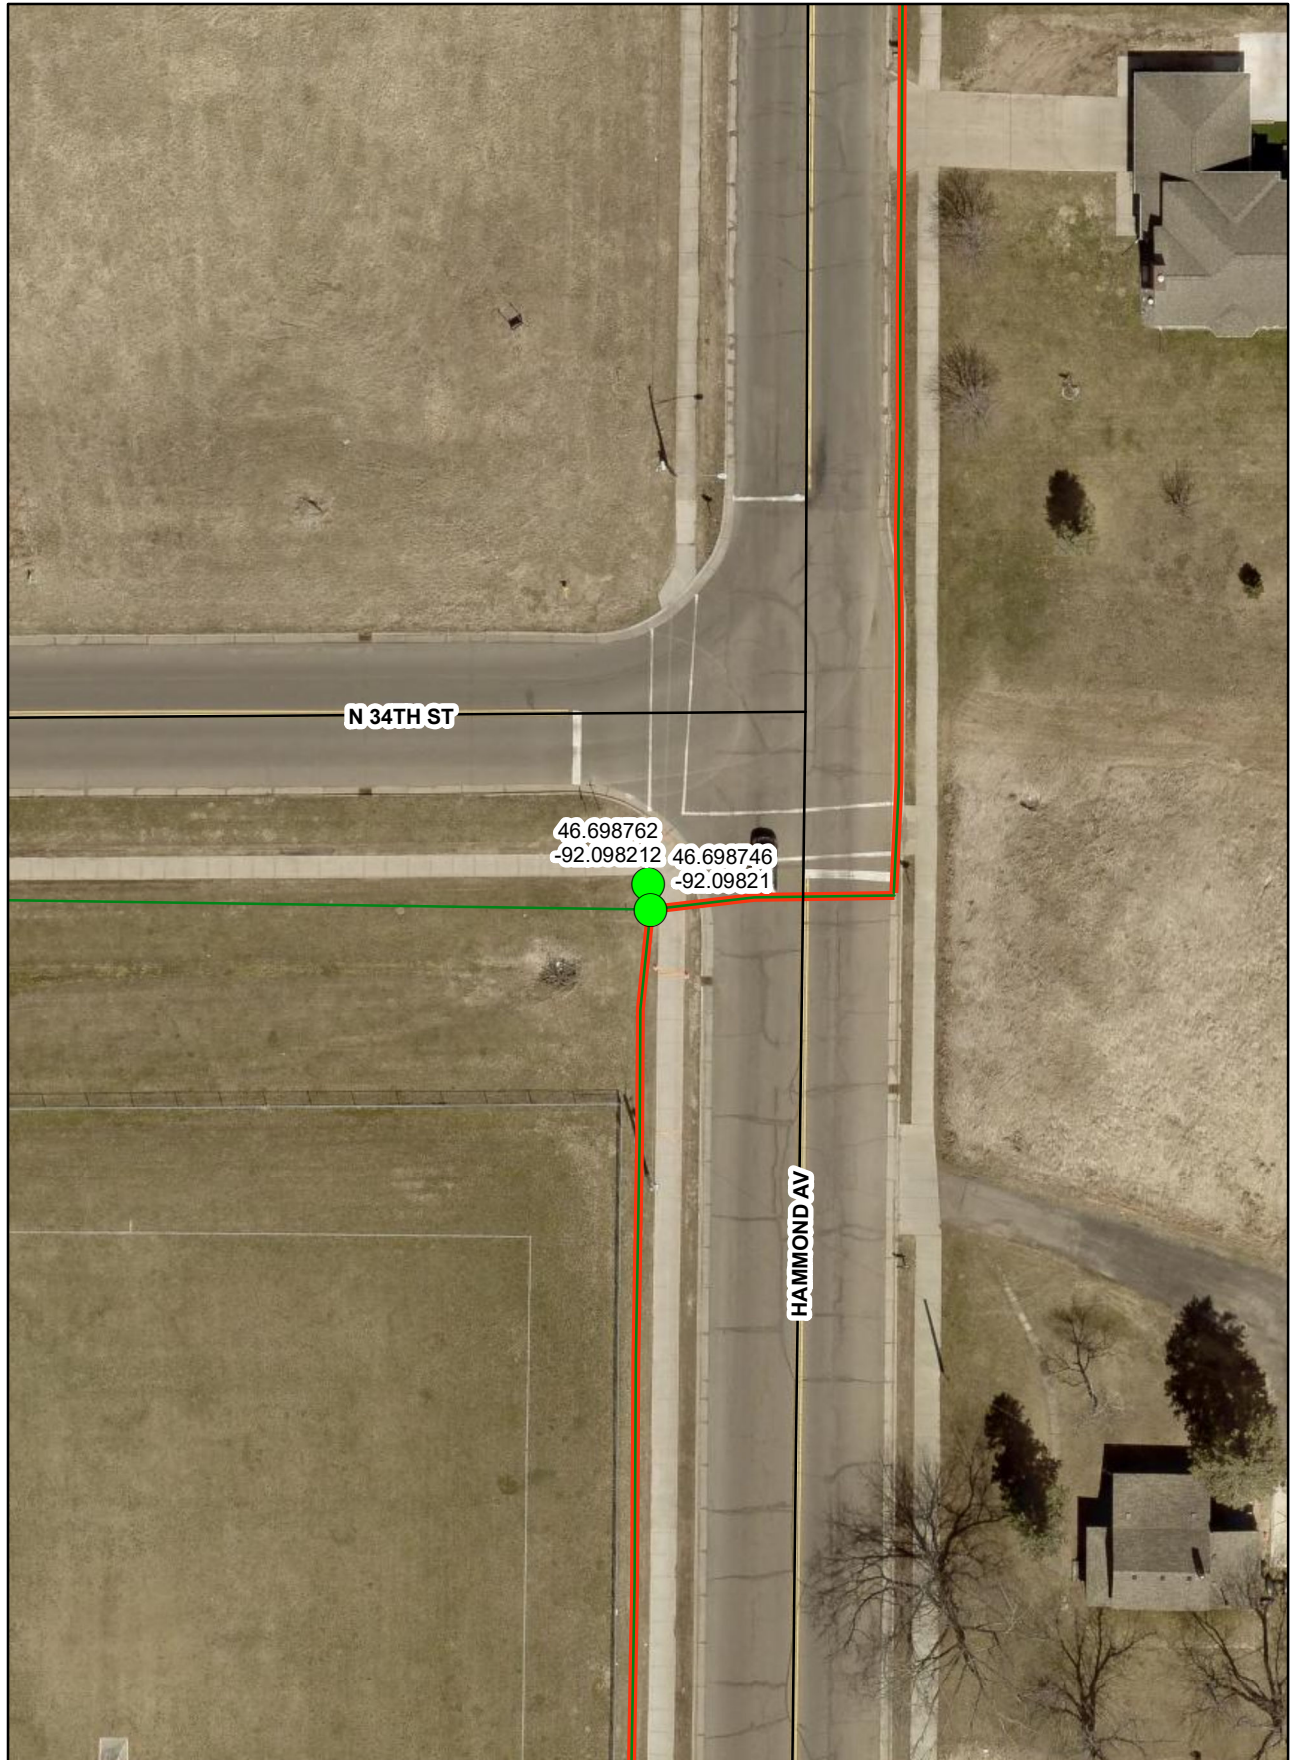




# 3400 Hammond Ave

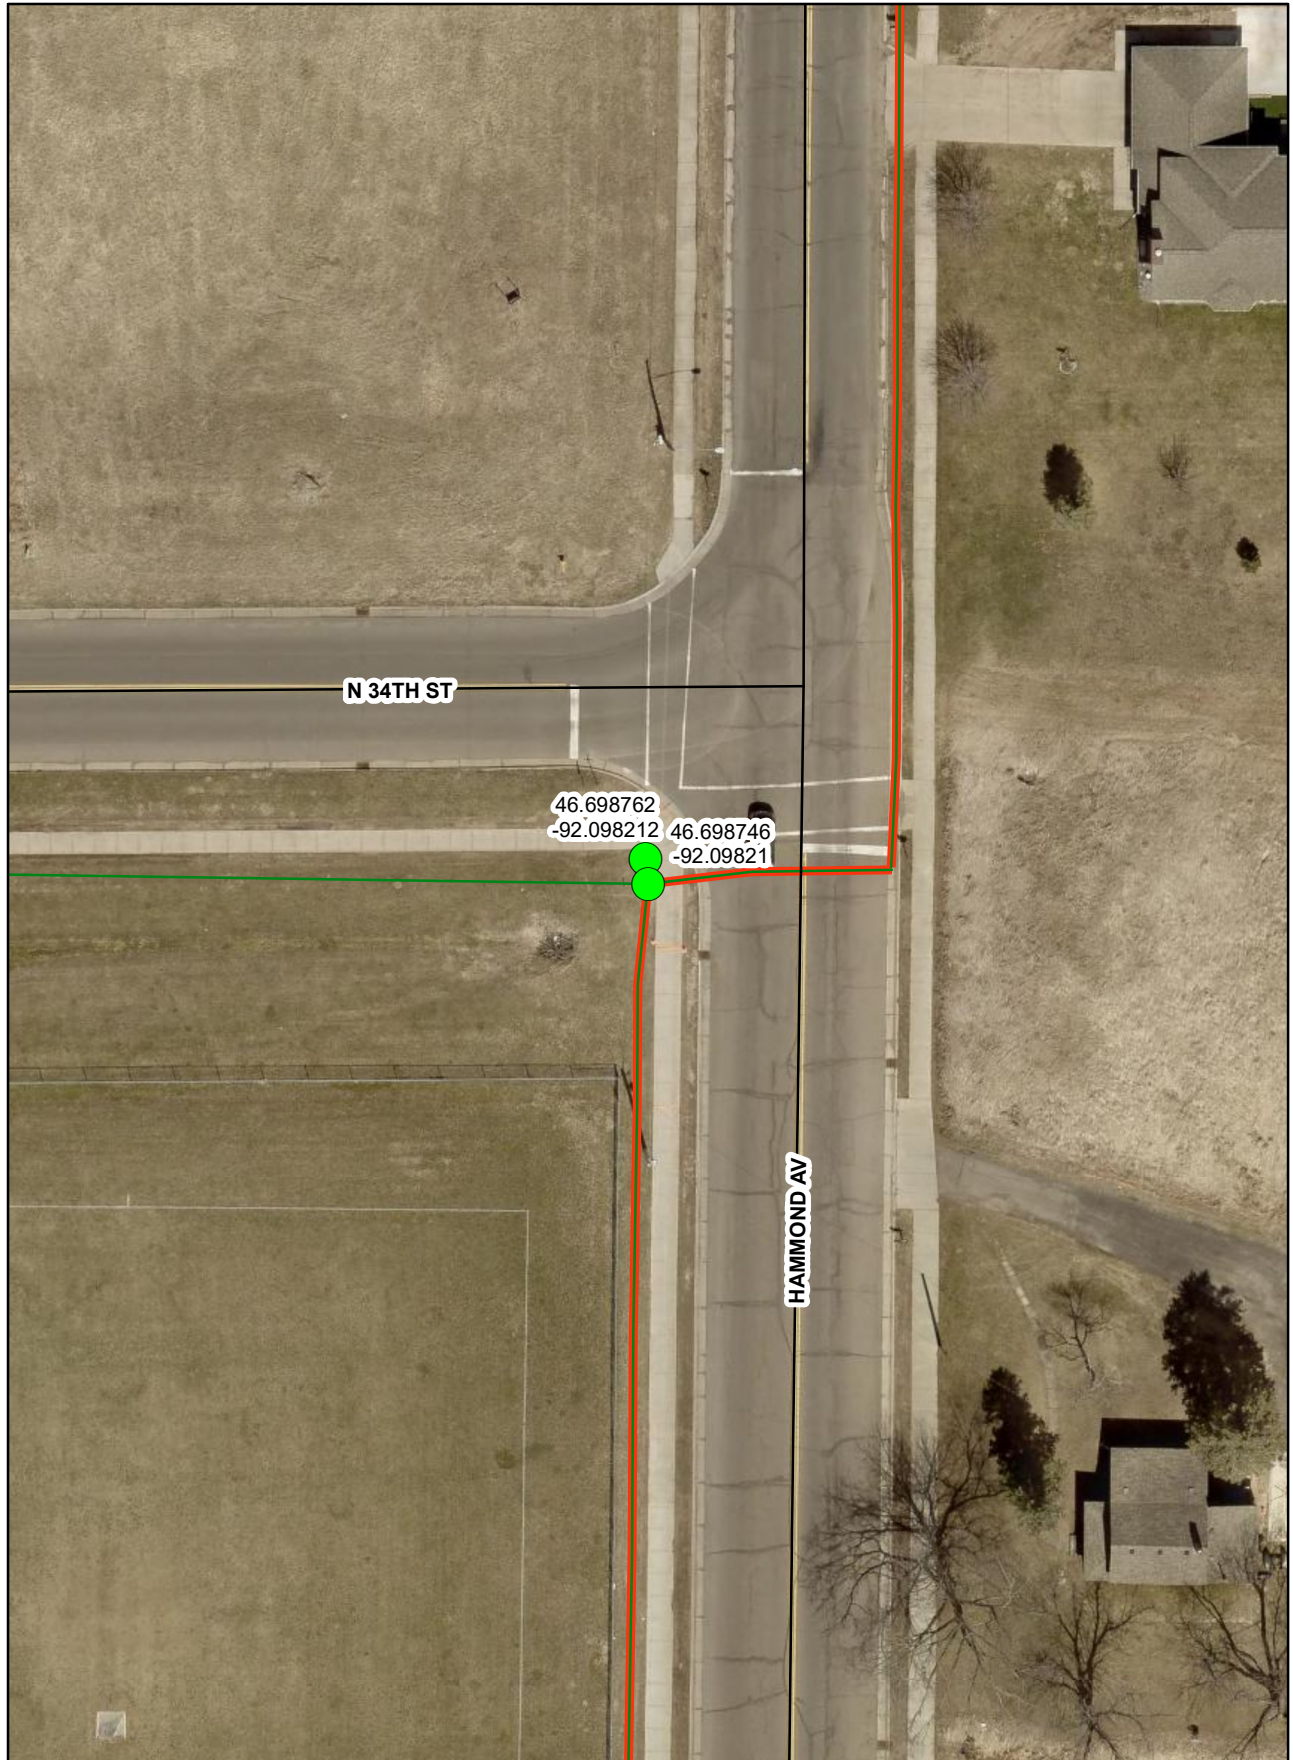



# 1725 N 37th St

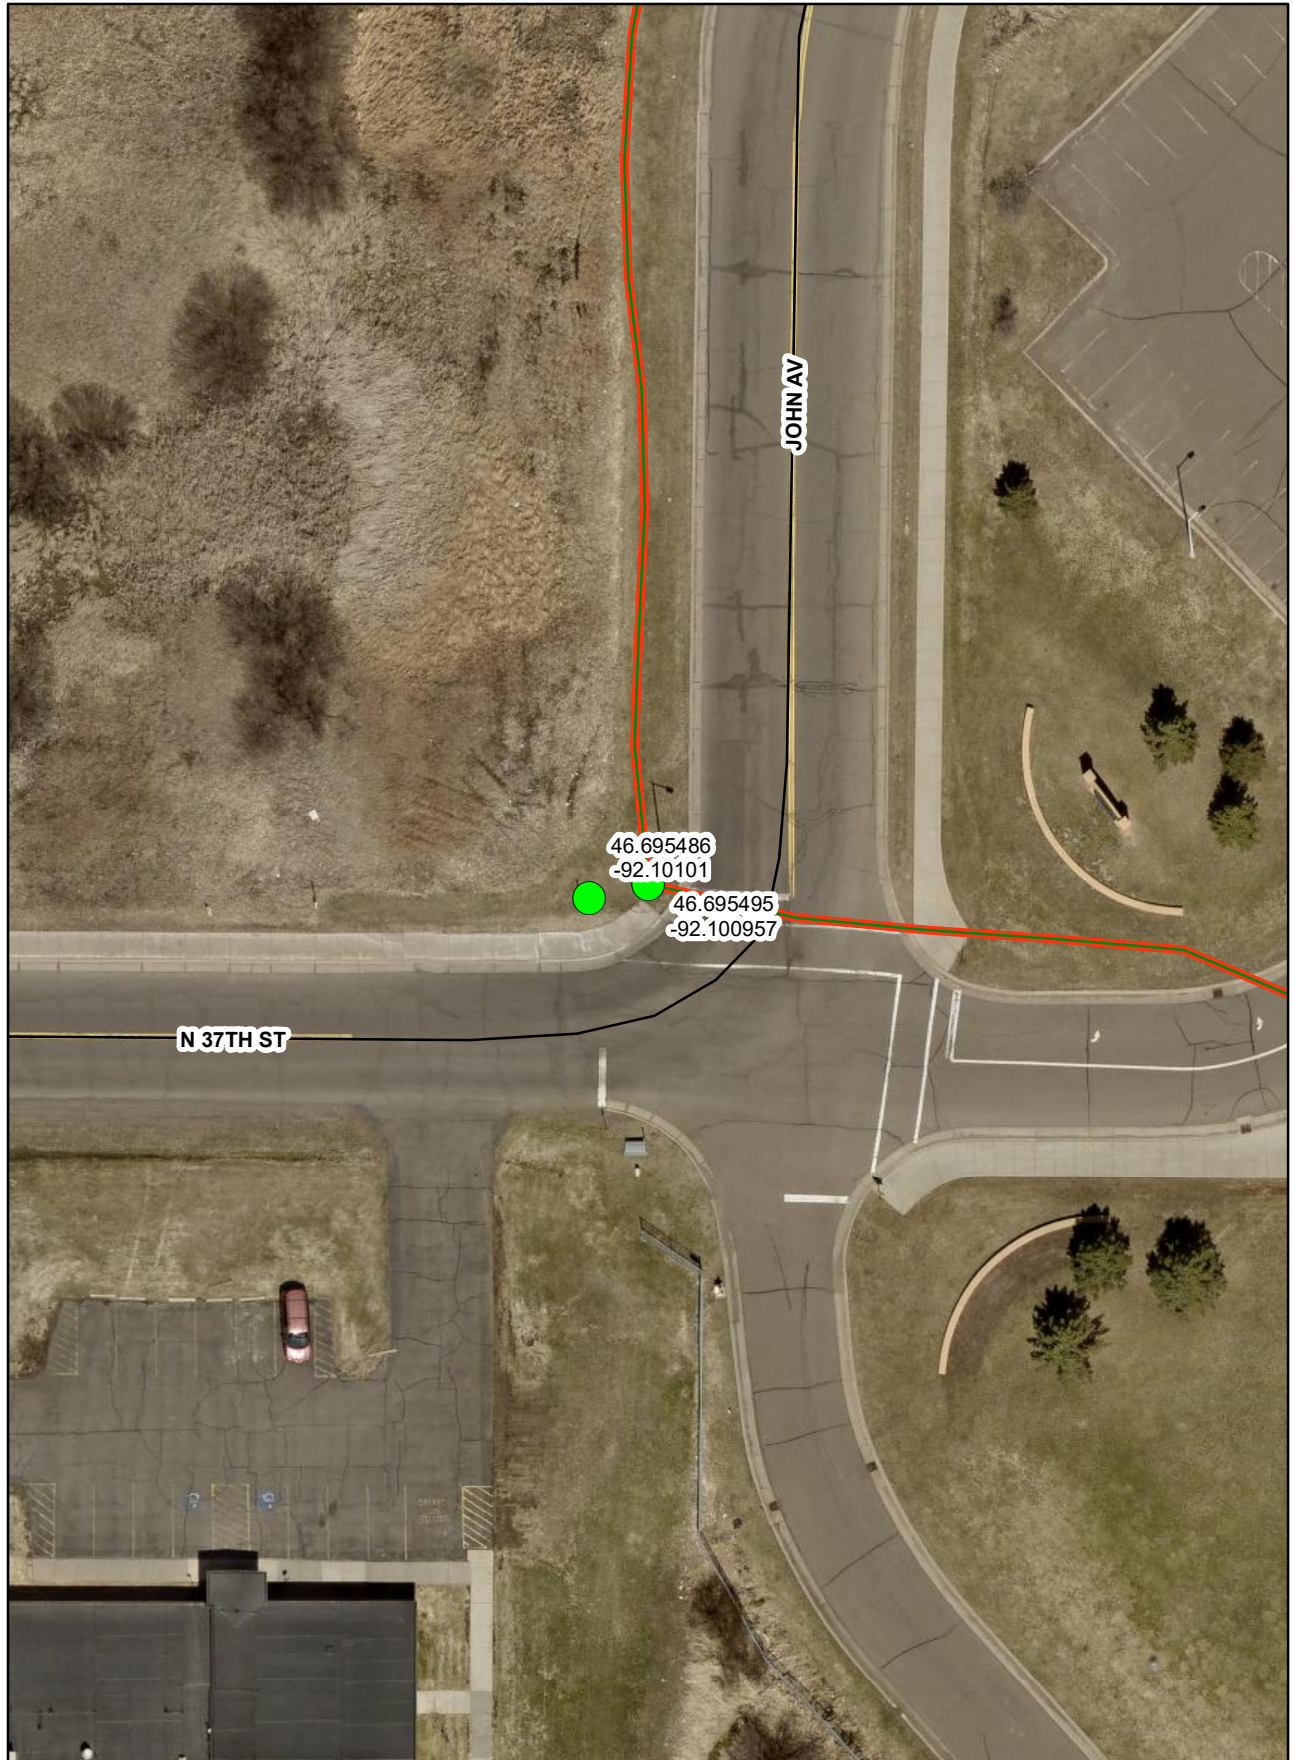



# 1725 N 37th St

