

PROFILE	SURVEYED	BY	DATE
NOTE BOOK	PLOTTED		
NO.	GRADES CHECKED		
	BY M.S. NOTED		
	STRUCTURE NOT AT NS CHECK		

PLAN	SURVEYED	BY	DATE
NOTE BOOK	PLOTTED	W.H. X M.S.	12/23/33
NO.	ALIGNMENT CHECKED	W.H. X	1/13/34
	RT. OF WAY CHECKED		

CITY OF SUPERIOR  
ENGINEERING DEPARTMENT  
**INTERCEPTING SEWER**  
SECTION 'C'

NOTE: THIS PLAN SUPERCEDES ALL PREVIOUS SUPERCEDES DRAWINGS

B.M. 1349 Arrowhead Hyd 3rd & Cumming Ave.

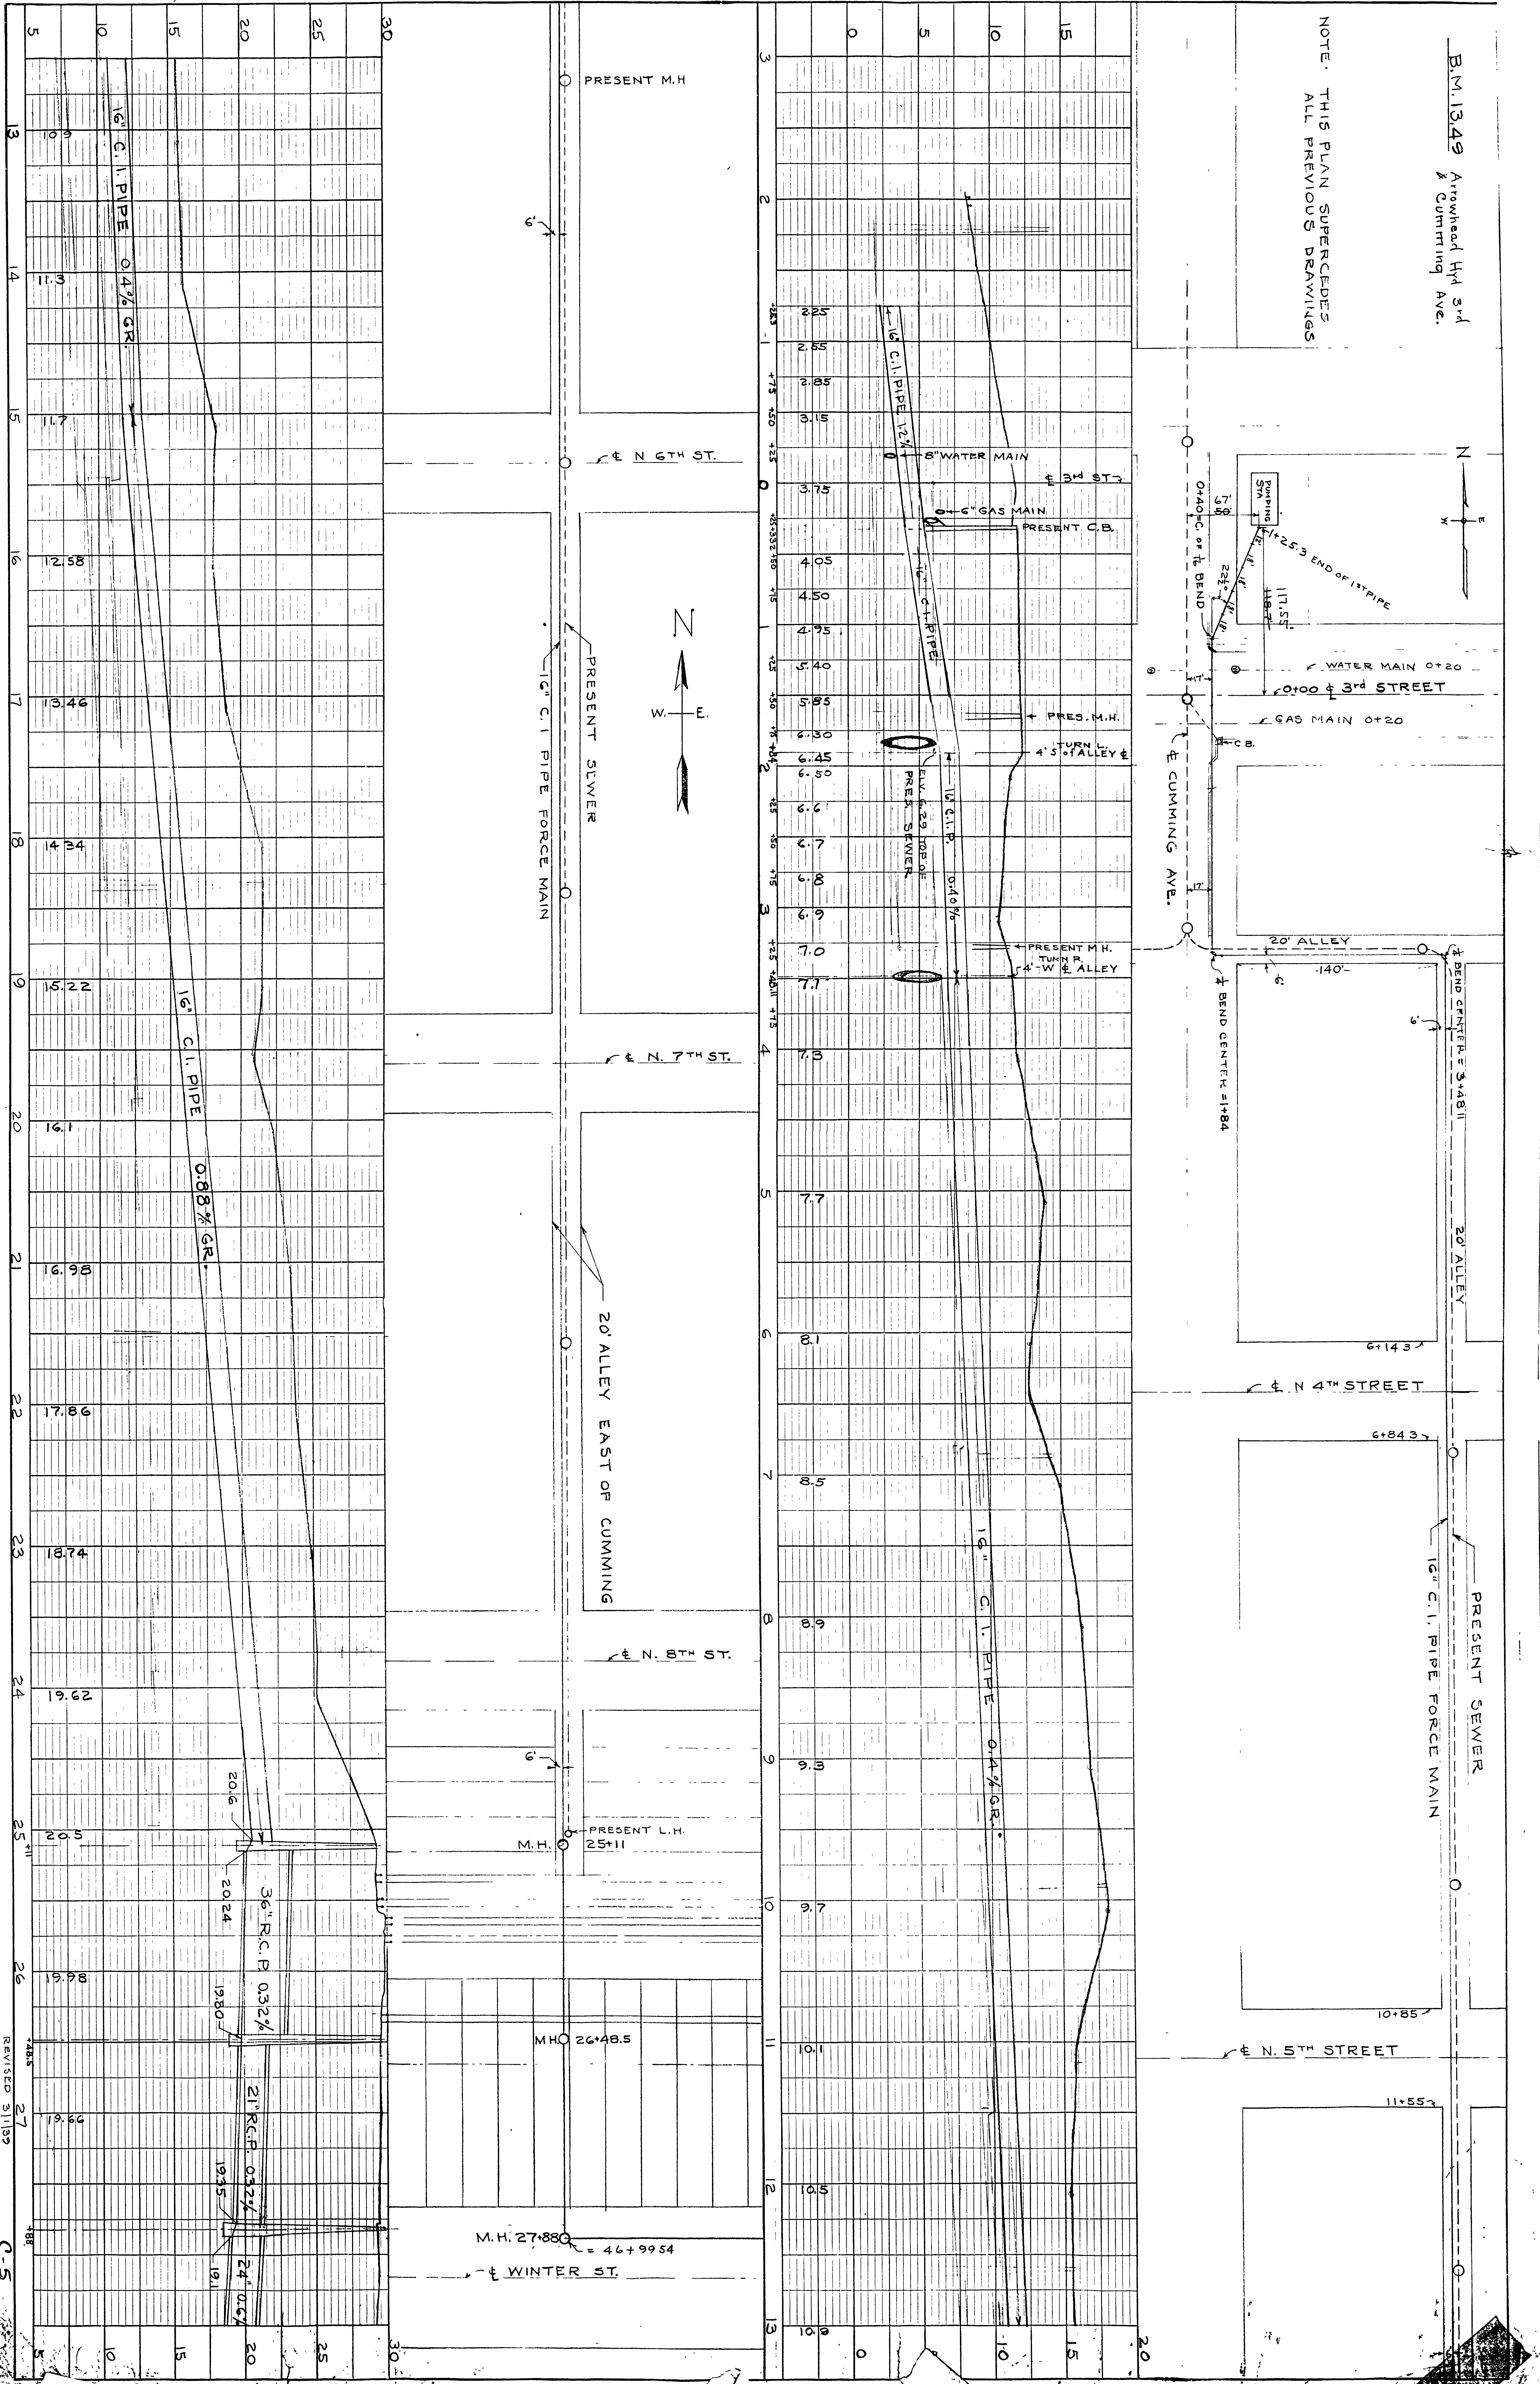



SECTION 'C' - SECTION 'C-5'

REVISED 3/1/33

700