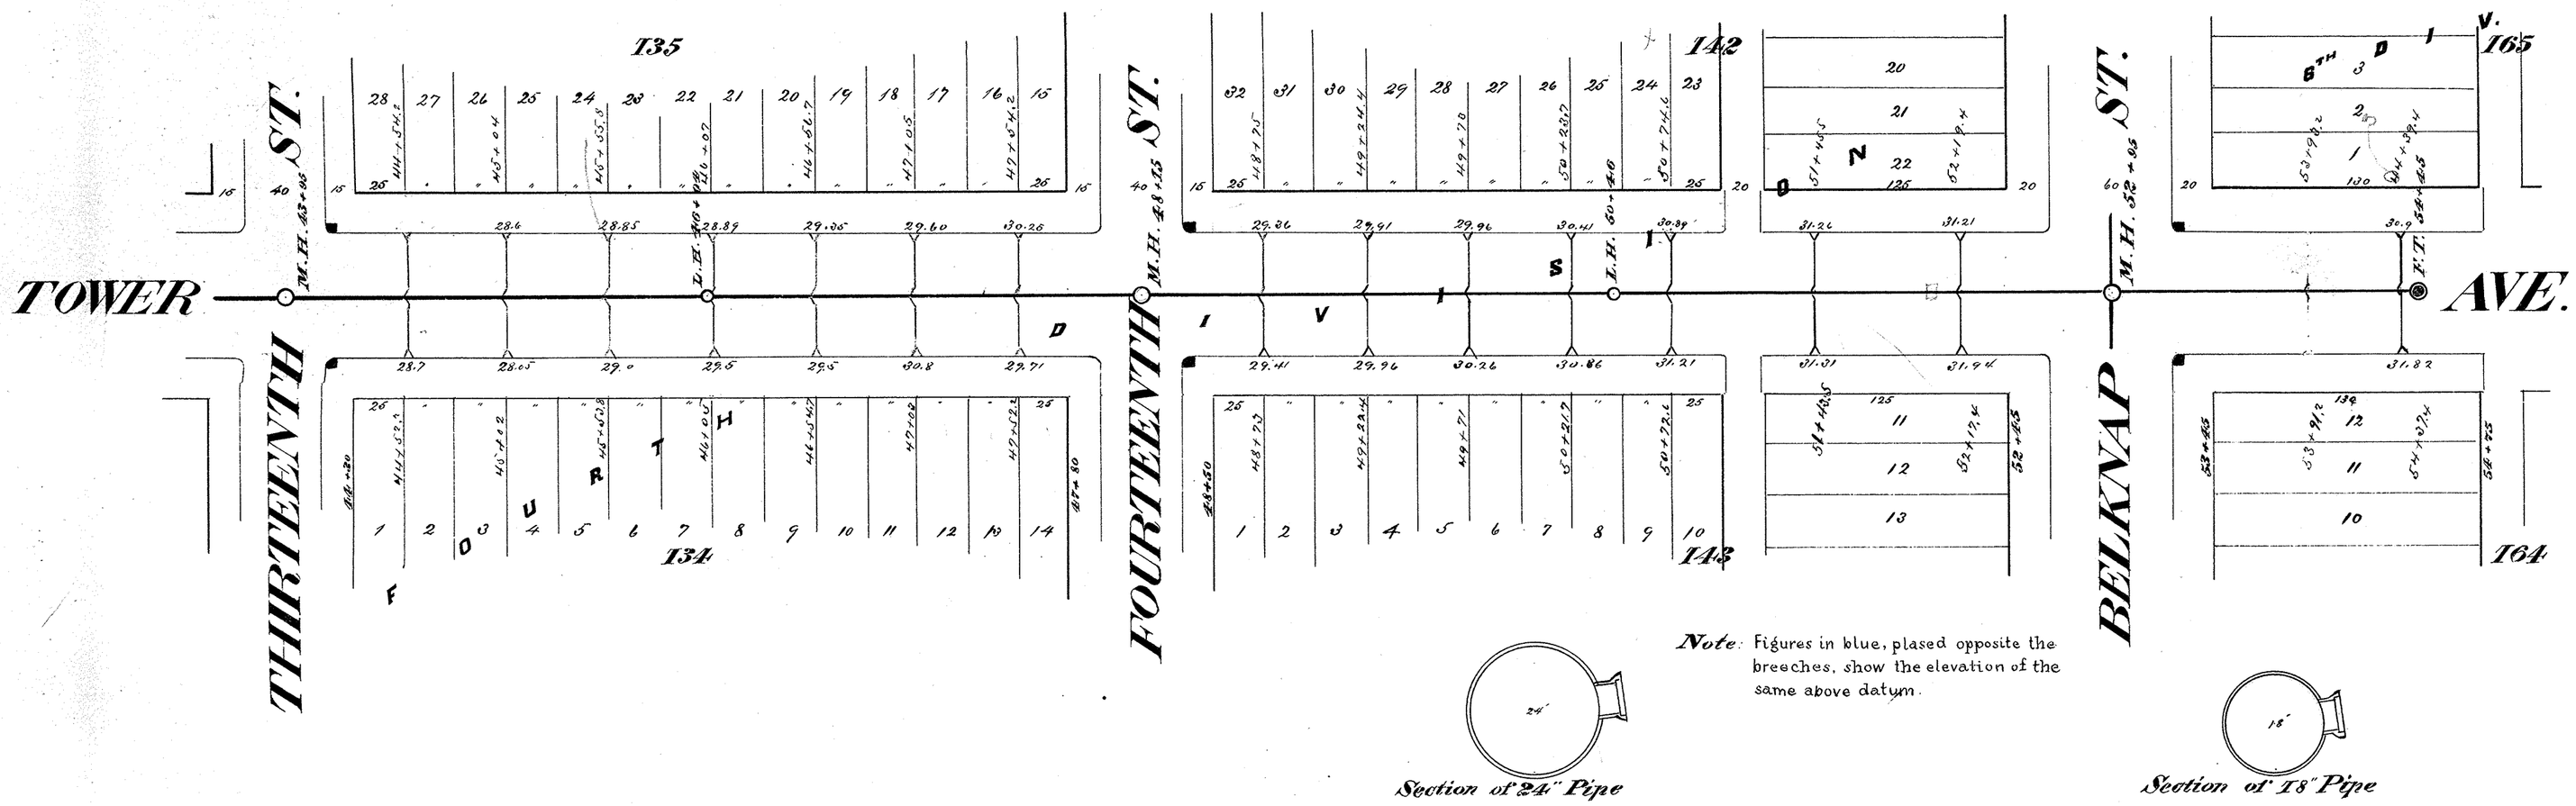

Note: Figures in blue, plased opposite the breeches, show the elevation of the same above datum.

Section of 24" Pipe

Section of 18" Pipe

Scale: Horizontal 1" = 60'
Vertical 1" = 40'
Section 1" = 2'

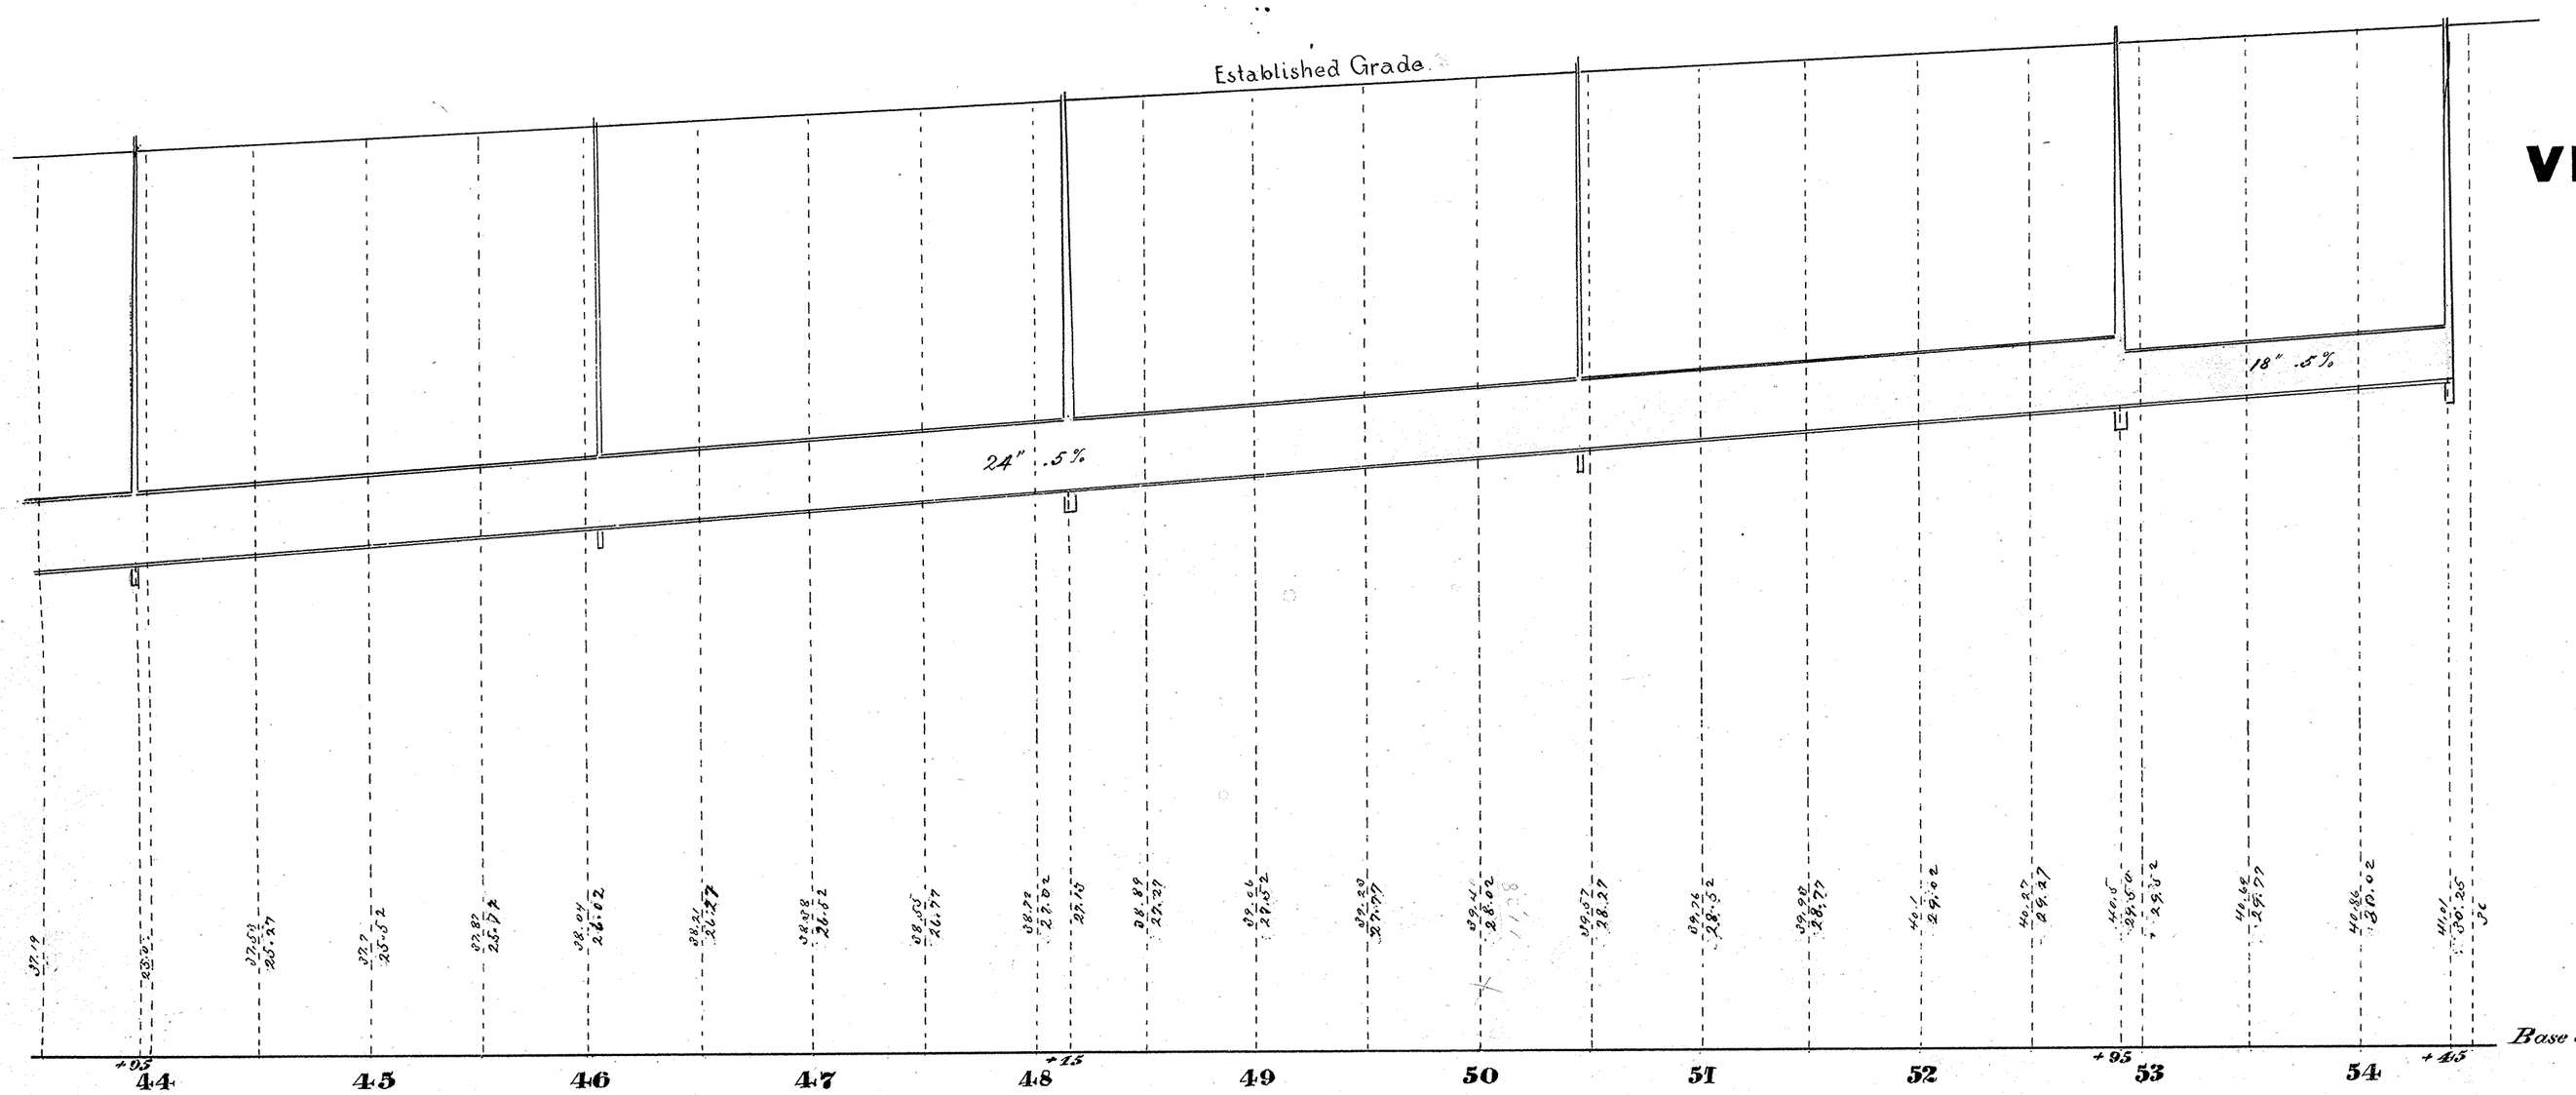

Plan & Profile of Sewer in Tower Ave. from 13th St. to End

VILLAGE OF SUPERIOR

SEWER PLAN

Contract let Feb. 3 1888
completed
Youngreen & Gleason, Contractor
Frank Grace, Inspector
E.B. Banks, Village Engineer

2A-13