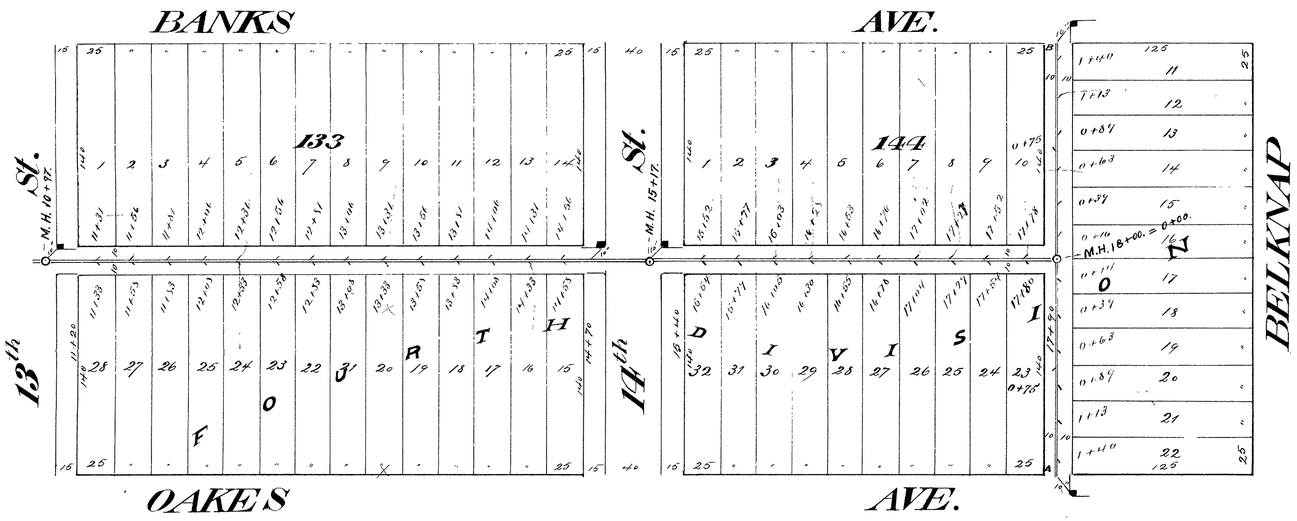

CITY OF SUPERIOR
SEWER PLAN

Contract let April 3, 1891
" completed Aug. 20, 1891
Joseph Wolf, Contractor
M. Conroy, Inspector
E. B. Banks, City Engineer

Scale { Horizontal 1" = 60'
Vertical 1" = 4"
Section 1" = 2" }

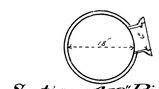
Section of 18" Pipe

Section of 12" Pipe

Section of 10" Pipe

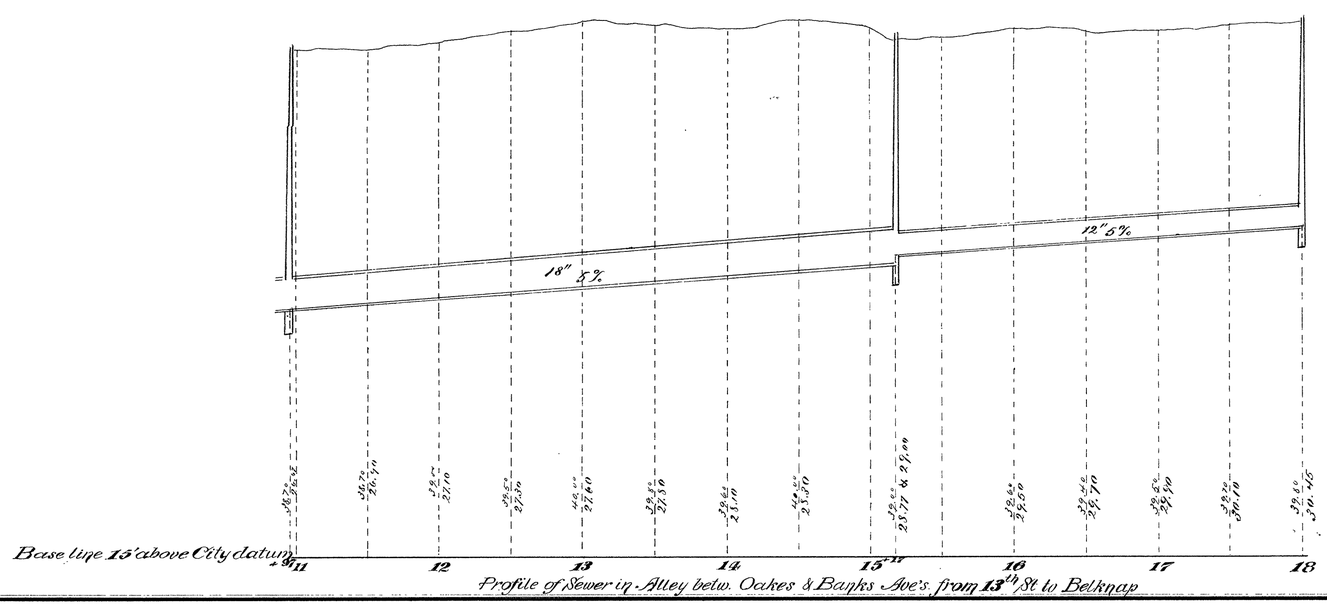

Profile of Sewer in Alley betw. Oakes & Banks Ave's. from 13th St to Belknap

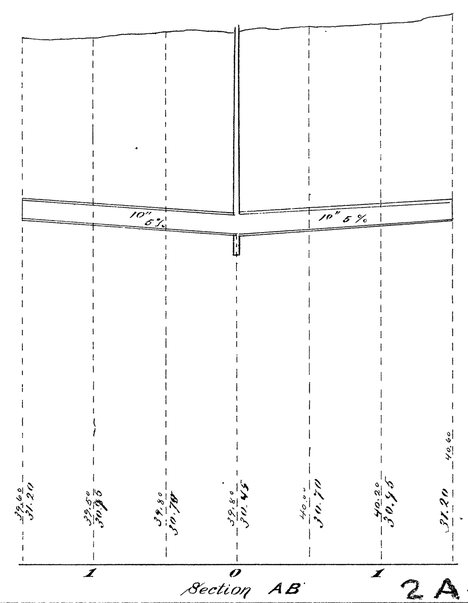

Section AB

2A-4